

SIGNAL HEAD CHART

FACE	R	Y	FYA	G
1-1, 1-2	◁	◁	◁	◁
2-1, 2-2	○	○	○	○
3-1, 3-2	◁	◁	◁	◁
4-1, 4-2	○	○	○	○
5-1, 5-2	◁	◁	◁	◁
6-1, 6-2	○	○	○	○
7-1, 7-2	◁	◁	◁	◁
8-1, 8-2	○	○	○	○

-ALL SIGNAL INDICATIONS ARE 12" LED
 -ALL SIGNAL HEADS ARE BLACK POLYCARBONITE WITH BACKGROUND SHIELDS

LOOP DETECTOR CHART


NUMBER	SIZE (FT)	LOCATION
D1-1, D5-1	2-6x6	20 & 50
D1-2, D5-2	2-6x6	5 & 35
D2-1, D6-1	6x6	250
D3-1, D7-1	2-6x6	20 & 50
D3-2, D7-2	2-6x6	5 & 35
D4-1	1-6x6	300
D4-2, D8-2	2-6x6	5 & 20
D8-1	6x6	120

-ALL LOOP DETECTORS ARE PVC
 -LOCATION: DISTANCE FROM CROSSWALK/STOP BAR IN FEET




40
 SCALE IN FEET

MATCH LINE "B"

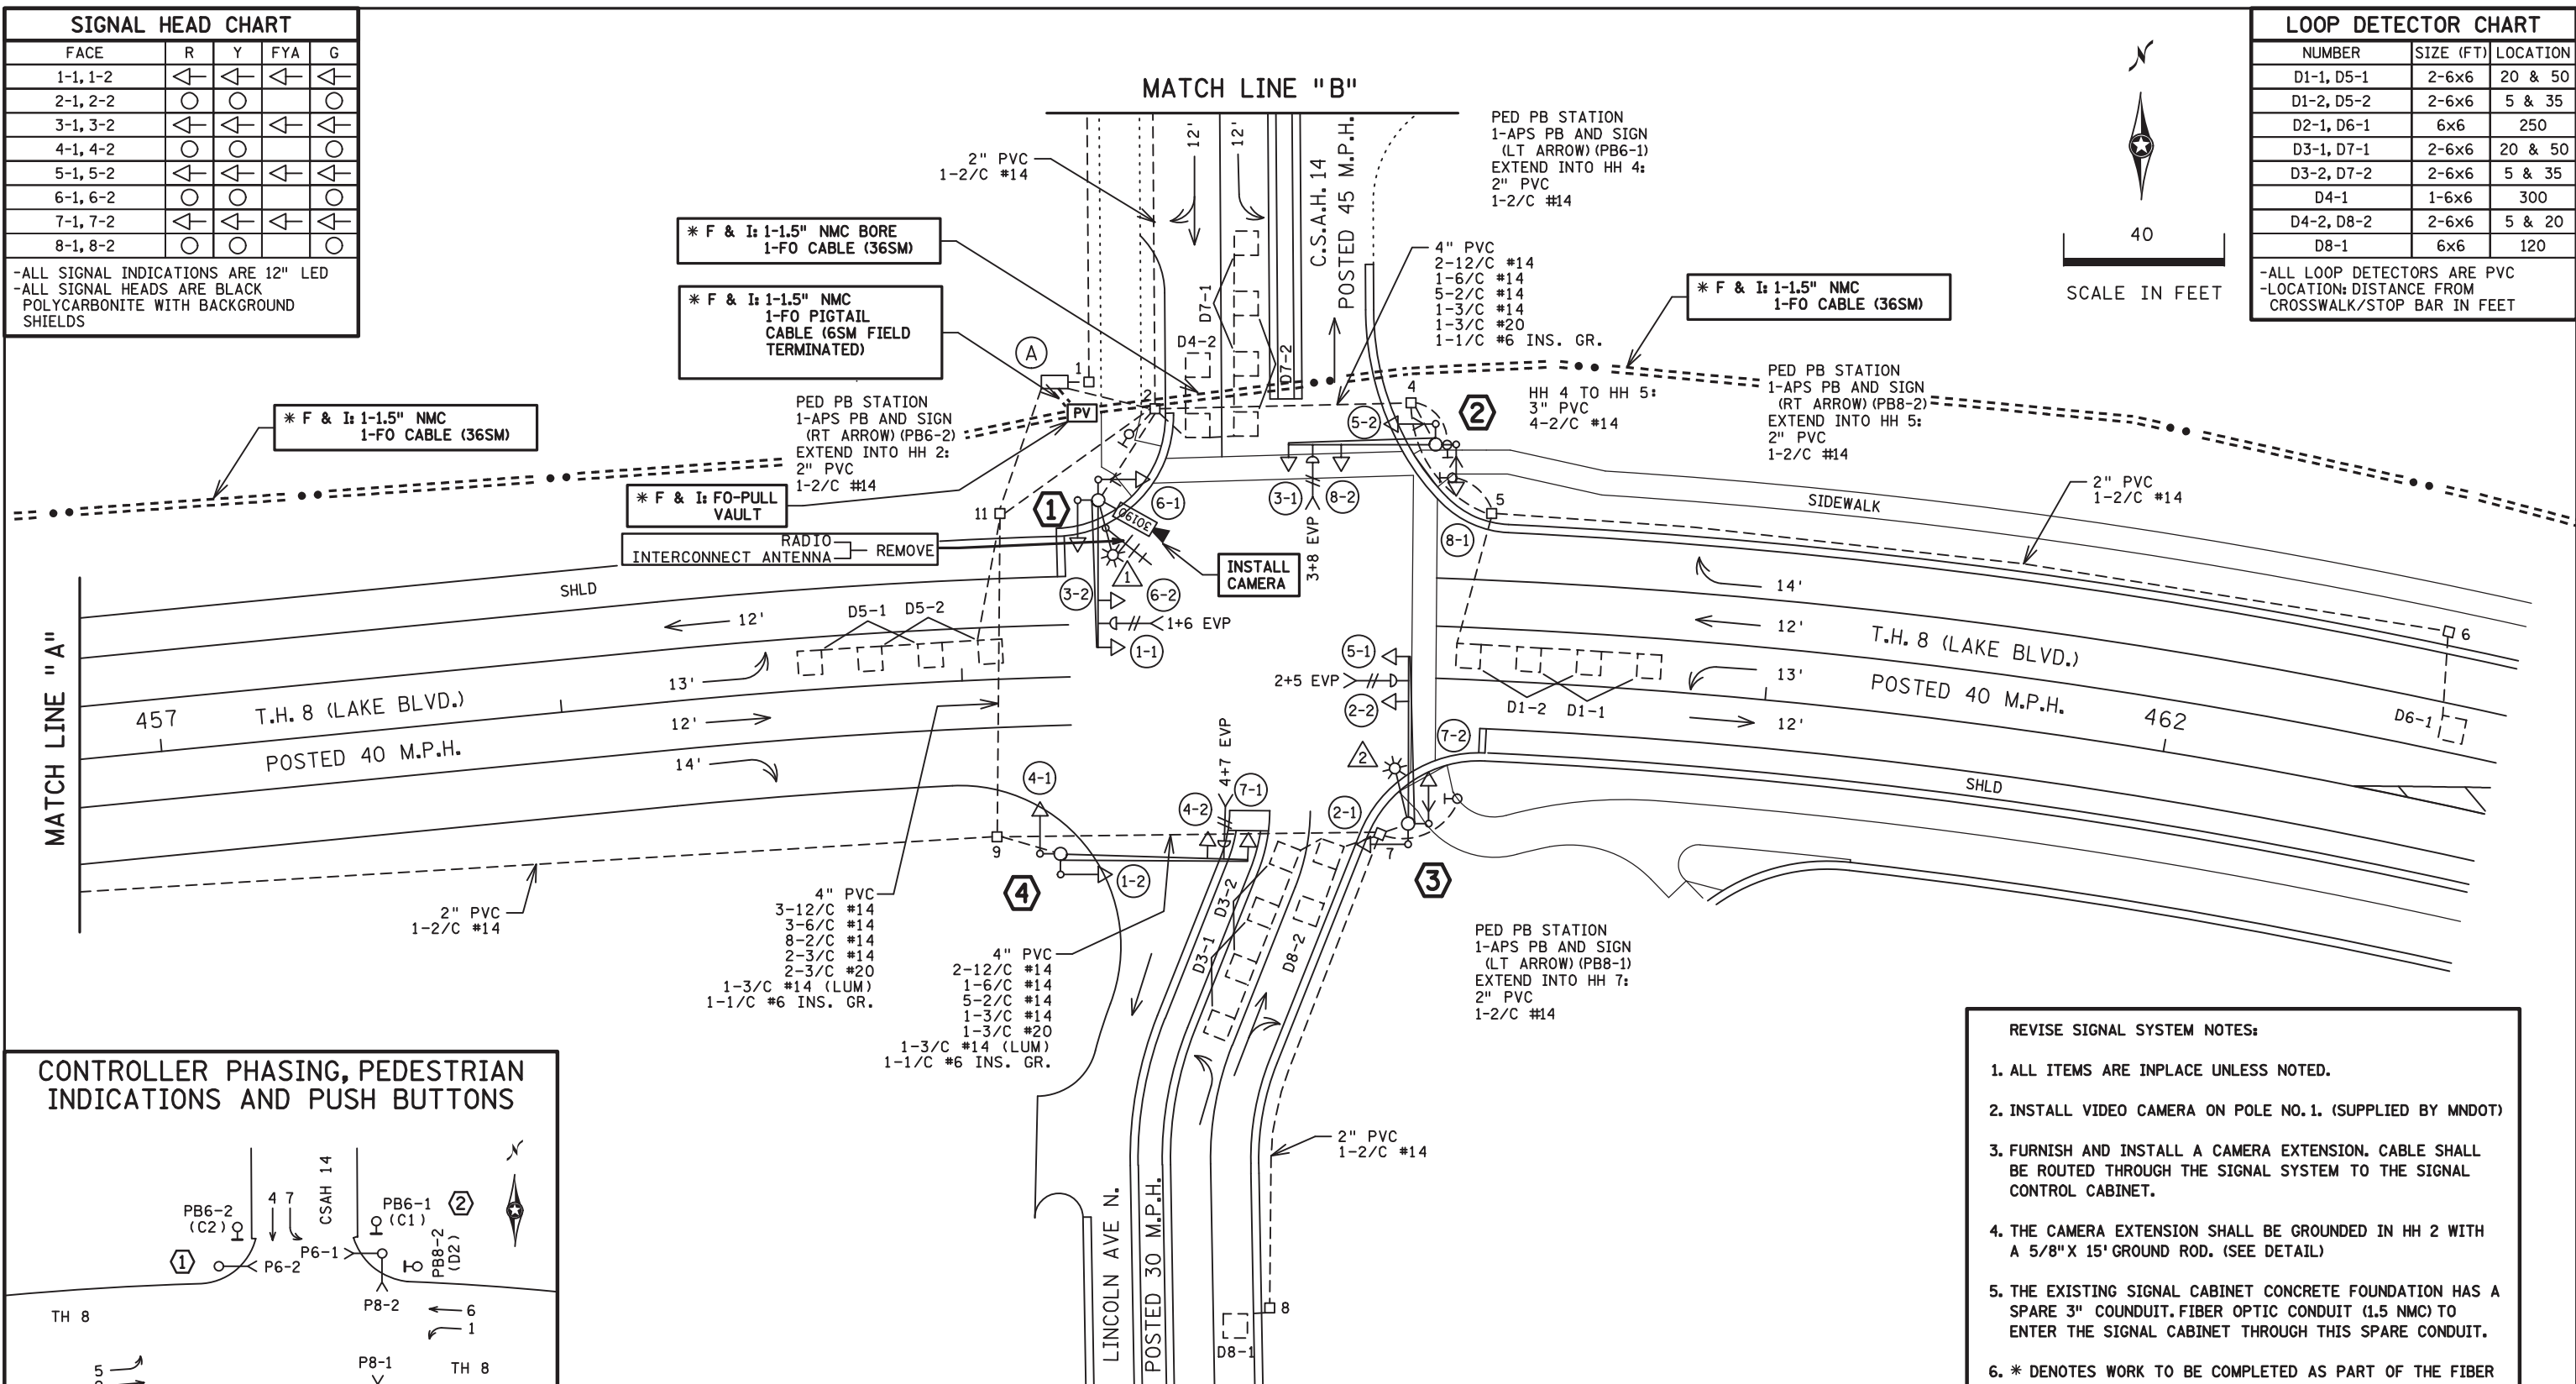

CONTROLLER PHASING, PEDESTRIAN INDICATIONS AND PUSH BUTTONS

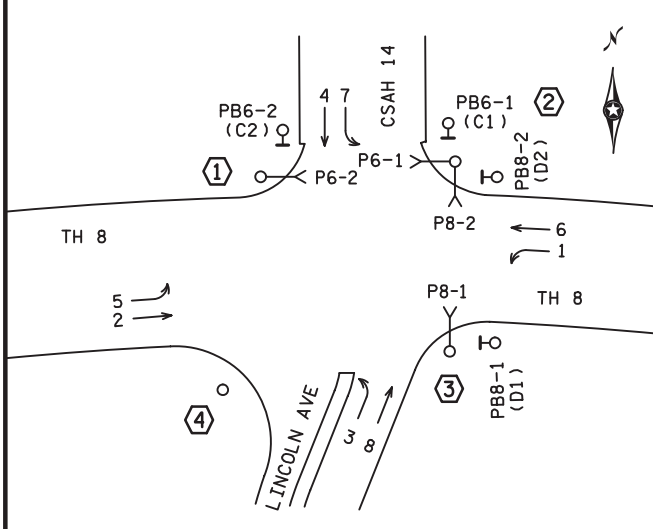

SIGNAL SYSTEM OPERATION

- THE SIGNAL SYSTEM FLASH MODE IS ALL RED.
- NORMAL OPERATION IS 8 PHASE, WITH PHASES 1, 3, 5, AND 7 BEING FLASHING YELLOW ARROWS BY TIME OF DAY.
- PHASES 2 AND 6 SHALL BE ON VEHICLE RECALL.

- REVISE SIGNAL SYSTEM NOTES:**
1. ALL ITEMS ARE INPLACE UNLESS NOTED.
 2. INSTALL VIDEO CAMERA ON POLE NO. 1. (SUPPLIED BY MNDOT)
 3. FURNISH AND INSTALL A CAMERA EXTENSION. CABLE SHALL BE ROUTED THROUGH THE SIGNAL SYSTEM TO THE SIGNAL CONTROL CABINET.
 4. THE CAMERA EXTENSION SHALL BE GROUNDED IN HH 2 WITH A 5/8" X 15' GROUND ROD. (SEE DETAIL)
 5. THE EXISTING SIGNAL CABINET CONCRETE FOUNDATION HAS A SPARE 3" CONDUIT. FIBER OPTIC CONDUIT (1.5 NMC) TO ENTER THE SIGNAL CABINET THROUGH THIS SPARE CONDUIT.
 6. * DENOTES WORK TO BE COMPLETED AS PART OF THE FIBER OPTIC PLAN.

PLOTTED/REVISED: 23-APR-2020

DISTRICT #: Metro
 IPLOT NAME: SS25_LAYOUT 20151
 PATH & FILENAME: Projects\DM罗斯\008\0000\Traffic\Signal\2015\20151_sgl.dgn

BY	DATE	REVISIONS

SYSTEM ID: 1735004
 METER ADDRESS: 12290 LAKE BLVD. N.
 MASTER ID: 20151 T.E.

INTERSECTION LAYOUT
 REVISE SIGNAL SYSTEM G
 T.H. 8 (LAKE BLVD.) AT
 C.S.A.H. 14 (LINCOLN AVE. N.)
 IN LINDSTROM, CHISAGO COUNTY

S.A.P. NO. _____ DRAWN BY: BAM CKD BY: GAK DATE: 4-9-20
 CERTIFIED BY: *Gregory Kim* LIC. NO. 26829 DATE: 4/9/20
 STATE PROJ. NO. 1301-126 (T.H.8) SHEET NO. SS25 OF SS42 SHEETS

DISTRICT #: Metro
 PLOT NAME: SS26_NOTES 20151
 PATH & FILENAME: Projects\DM罗斯008\00000\Traffic\Signal\2015\N20151_sgl.dgn
 PLOTTED/REVISED: 23-APR-2020

- ①** EB STA 459+34.80, 43.76' LT
 PA90 POLE FOUNDATION
 TYPE PA90-A-35-D40-9 (DAVIT AT 350 DEG)
- REMOVE — D40-9 (DAVIT AT 350 DEG)
 F&I — 1-X6-350/CAM 400 EXTENSION (MOUNTED AT 350 DEG) (INCLUDING LIGHTNING ROD)
 INSTALL — 7/16 GROUND BRAID
 1-VIDEO CAMERA WITH MOUNT (30190)
- 2-SWING AWAY HINGES
 1-ANGLE MOUNT SIGNAL OVERHEAD AT 0'
 1-STRAIGHT MOUNT SIGNAL OVERHEAD AT 11'
 2-ANGLE MOUNT SIGNALS AT 90 AND 180 DEG
 1-ANGLE MOUNT C.D. PED HEAD AT 180 DEG
 ONE-WAY EVP DETECTOR AND CONFIRMATORY LIGHT (PHASES 1+6)
- S&I — LUMINAIRE-250W HPS
 REMOVE — RADIO INTERCONNECT ANTENNA ON LUMINAIRE ARM
- 1-R10-X12 SIGN ADJACENT TO HEAD 1-1
 2-TYPE D SIGNS (SEE DETAIL)
 1-R9-3 SIGN (NO PED) FACING POLE 4
 3" PVC TO HH 2:
 2-12/C #14
 1-6/C #14
 1-3/C #14
 1-3/C #20
 1-3/C #14 (LUM)
 1-1/C #6 INS. GR.
- REMOVE — 1-RADIO COAXIAL CABLE
 F&I — 1-7/16" GROUND BRAID TO GROUND ROD
 1-COM CABLE (CAT 5E)


- ②** EB STA 460+15.81, 58.14' LT
 PA90 POLE FOUNDATION
 TYPE PA90-A-35
 1-ANGLE MOUNT SIGNAL OVERHEAD AT 0'
 1-STRAIGHT MOUNT SIGNAL OVERHEAD AT 11'
 2-ANGLE MOUNT SIGNALS AT 90 AND 180 DEG
 2-ANGLE MOUNT C.D. PED HEADS AT 90 AND 180 DEG
 ONE-WAY EVP DETECTOR AND CONFIRMATORY LIGHT (PHASES 3+8)
 1-R10-X12 SIGN ADJACENT TO HEAD 3-1
 1-TYPE D SIGN (SEE DETAIL)
 3" PVC TO HH 4:
 2-12/C #14
 1-6/C #14
 1-3/C #14
 1-3/C #20
 1-1/C #6 INS. GR.

- ③** EB STA 460+12.16, 36.34' RT
 PA90 POLE FOUNDATION
 TYPE PA90-A-40-D40-9 (DAVIT AT 350 DEG)
 2-SWING AWAY HINGES
 1-ANGLE MOUNT SIGNAL OVERHEAD AT 0'
 1-STRAIGHT MOUNT SIGNAL OVERHEAD AT 11'
 2-ANGLE MOUNT SIGNALS AT 90 AND 180 DEG
 1-ANGLE MOUNT C.D. PED HEAD AT 90 DEG
 ONE-WAY EVP DETECTOR AND CONFIRMATORY LIGHT (PHASES 2+5)
 LUMINAIRE-250W HPS
 1-R10-X12 SIGN ADJACENT TO HEAD 5-1
 2-TYPE D SIGNS (SEE DETAIL)
 1-R9-3 SIGN (NO PED) FACING POLE 4
 3" PVC TO HH 7:
 2-12/C #14
 1-6/C #14
 1-3/C #14
 1-3/C #20
 1-3/C #14 (LUM)
 1-1/C #6 INS. GR.


- ④** EB STA 459+23.17, 43.97' RT
 PA100 POLE FOUNDATION
 TYPE PA100-A-45
 1-ANGLE MOUNT SIGNAL OVERHEAD AT 0'
 1-STRAIGHT MOUNT SIGNAL OVERHEAD AT 11'
 2-ANGLE MOUNT SIGNALS AT 90 AND 180 DEG
 ONE-WAY EVP DETECTOR AND CONFIRMATORY LIGHT (PHASES 7+4)
 1-R10-X12 SIGN ADJACENT TO HEAD 7-1
 1-TYPE D SIGN (SEE DETAIL)
 2-R9-3 SIGNS (NO PED) FACING POLES 1 AND 3
 3" PVC TO HH 9:
 1-12/C #14
 2-6/C #14
 1-3/C #14
 1-3/C #20
 1-1/C #6 INS. GR.

* F & I: 1-1.5" NMC
 1-FO CABLE (36SM)


- (B)** SOP-GROUND MOUNTED TRANSFORMER (XCEL ENERGY)
 2" PVC INTO HH 1:
 3-1/C #2

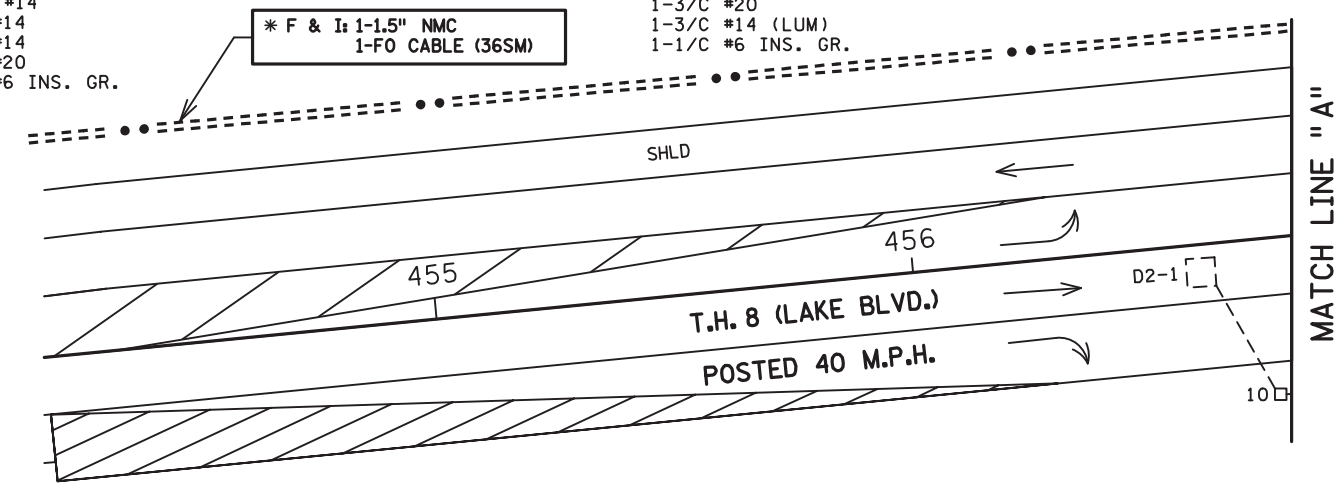

XCEL ENERGY GROUND MOUNTED TRANSFORMER

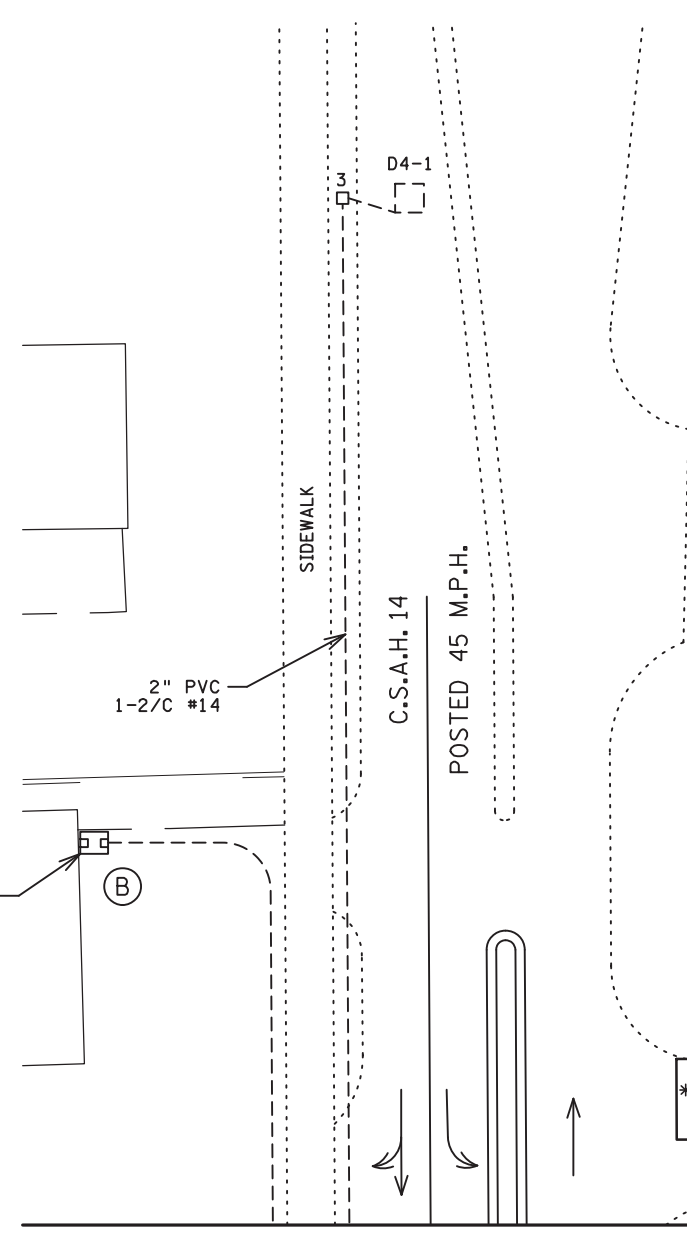

- (A)** EQUIPMENT PAD - SEE DETAIL
 SERVICE CABINET
 CONTROLLER AND CABINET
 4" PVC TO HH 11:
 3-12/C #14
 3-6/C #14
 8-2/C #14
 2-3/C #14
 2-3/C #20
 1-1/C #6 INS. GR.
 2" PVC TO SERVICE CABINET:
 2-1/C #6
 1-1/C #6 INS. GR.
 2" PVC TO SERVICE CABINET: (SPARE-COMMS)
 SERVICE CABINET TO HH 1:
 2" PVC
 3-1/C #2
 SERVICE CABINET TO HH 11:
 2" PVC
 2-3/C #14 (LUM)
 HH 11 TO HH 2:
 2" PVC
 1-3/C #14 (LUM)
- REMOVE — 1-RADIO COAXIAL CABLE
 F&I — 1-COM CABLE (CAT 5E)
 1-1/C #6 INS. GR.
- *F&I — CONTROLLER CABINET TO PULL VAULT
 1.5" NMC
 1-FO PIGTAIL (6SM FIELD TERMINATED)

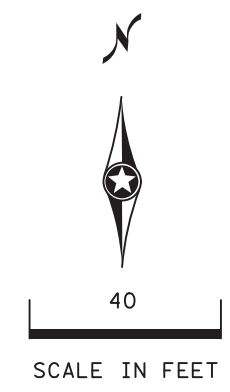


- REVISE SIGNAL SYSTEM NOTES:**
- ALL ITEMS ARE INPLACE UNLESS NOTED.
 - INSTALL VIDEO CAMERA ON POLE NO. 1. (SUPPLIED BY MNDOT)
 - FURNISH AND INSTALL A CAMERA EXTENSION. CABLE SHALL BE ROUTED THROUGH THE SIGNAL SYSTEM TO THE SIGNAL CONTROL CABINET.
 - THE CAMERA EXTENSION SHALL BE GROUNDED IN HH 2 WITH A 5/8" X 15' GROUND ROD. (SEE DETAIL)
 - THE EXISTING SIGNAL CABINET CONCRETE FOUNDATION HAS A SPARE 3" CONDUIT. FIBER OPTIC CONDUIT (1.5 NMC) TO ENTER THE SIGNAL CABINET THROUGH THIS SPARE CONDUIT.
 - * DENOTES WORK TO BE COMPLETED AS PART OF THE FIBER OPTIC PLAN.

BY	DATE	REVISIONS	SYSTEM ID: 1735004	MATCH LINES LAYOUT REVISE SIGNAL SYSTEM G T.H. 8 (LAKE BLVD.) AT C.S.A.H. 14 (LINCOLN AVE. N.) IN LINDSTROM, CHISAGO COUNTY	S.A.P. NO.	DRAWN BY: BAM	CKD BY: GAK	DATE: 4-9-20
			METER ADDRESS: 12290 LAKE BLVD. N.		CERTIFIED BY: <i>Gregory Kim</i>			LIC. NO. 26829 DATE: 4/9/20
			MASTER ID: 20151 T.E.		STATE PROJ. NO. 1301-126 (T.H. 8) SHEET NO. SS26 OF SS42 SHEETS			

PLOTTED/REVISED: 13-APR-2020

DISTRICT #: Metro
I/PLOT NAME: WIRE 20151
PATH & FILENAME: Projects\DM_R05\008\0000\Traffic\Signalis\2015\N20151_sgl.dgn

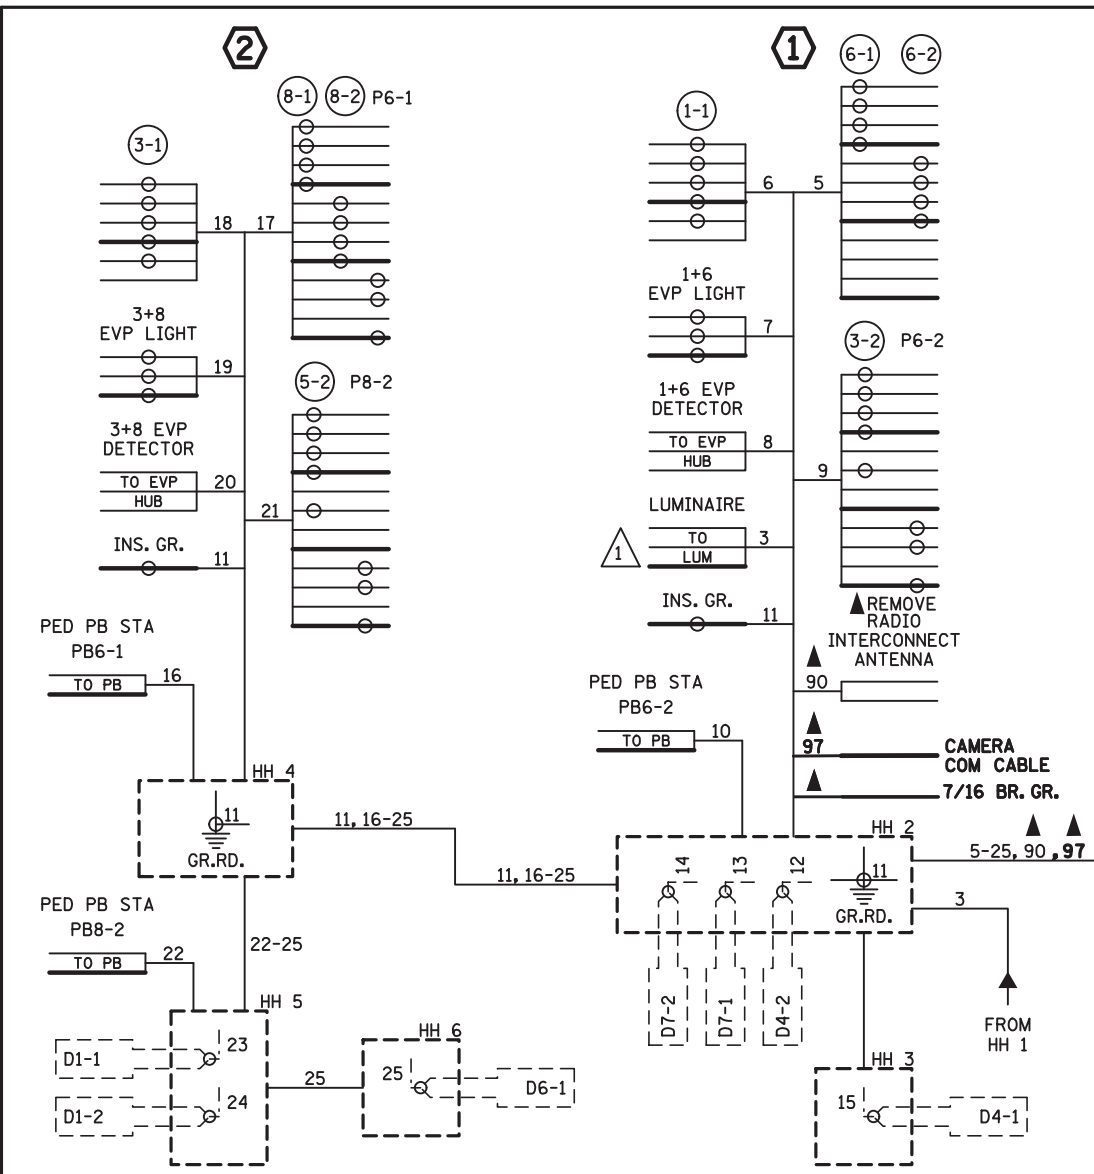


CONDUCTOR COLOR CODE (14 GAUGE)

TO SIGNAL CABINET		TO DEVICE	
1/C#6 G	R	R	RED
6PR#19	O	BL	YEL 4 & 5
COXIAL CABLE	BLK/R	WH	GRN SECTION
	BLK	BLK/R	NEU SIGNAL
	BLK	BLK	YLTA INDICATION
	BLK	BLK	GLTA
3-1/C#2	R	R	RED/DWK
	WH	BLK/R	YEL/WLK
	BLK	BLK	GRN/SPR
		WH	NEU
3-1/C#6	BLK	WH	3 SECTION
	WH	WH	& PED
	G	G	INDICATION
12/C#14	R	R	RED
	BL	BLK	YEL
	WH	WH	GRN
	R/BLK	BLK/R	NEU
	O/BLK	BLK	YLTA
	BL/BLK	BLK	GLTA
	WH/BLK	WH	
	BLK	WH	
	BLK/WH	WH OR CLR	
	BLK/R	R OR O	
	WH/R	WH OR YEL	
		BLK OR BL	
		WH OR CLR	


NOTE: ALL POLE CONNECTIONS SHALL BE ARRANGED AS SPECIFIED ABOVE.

CONTROLLER CABINET

NOTES:
1. LUMINAIRES ARE METERED.
2. SIGNAL SYSTEM INCLUDES BATTERY-BACKUP SERVICE CABINET (NO BATTERIES).

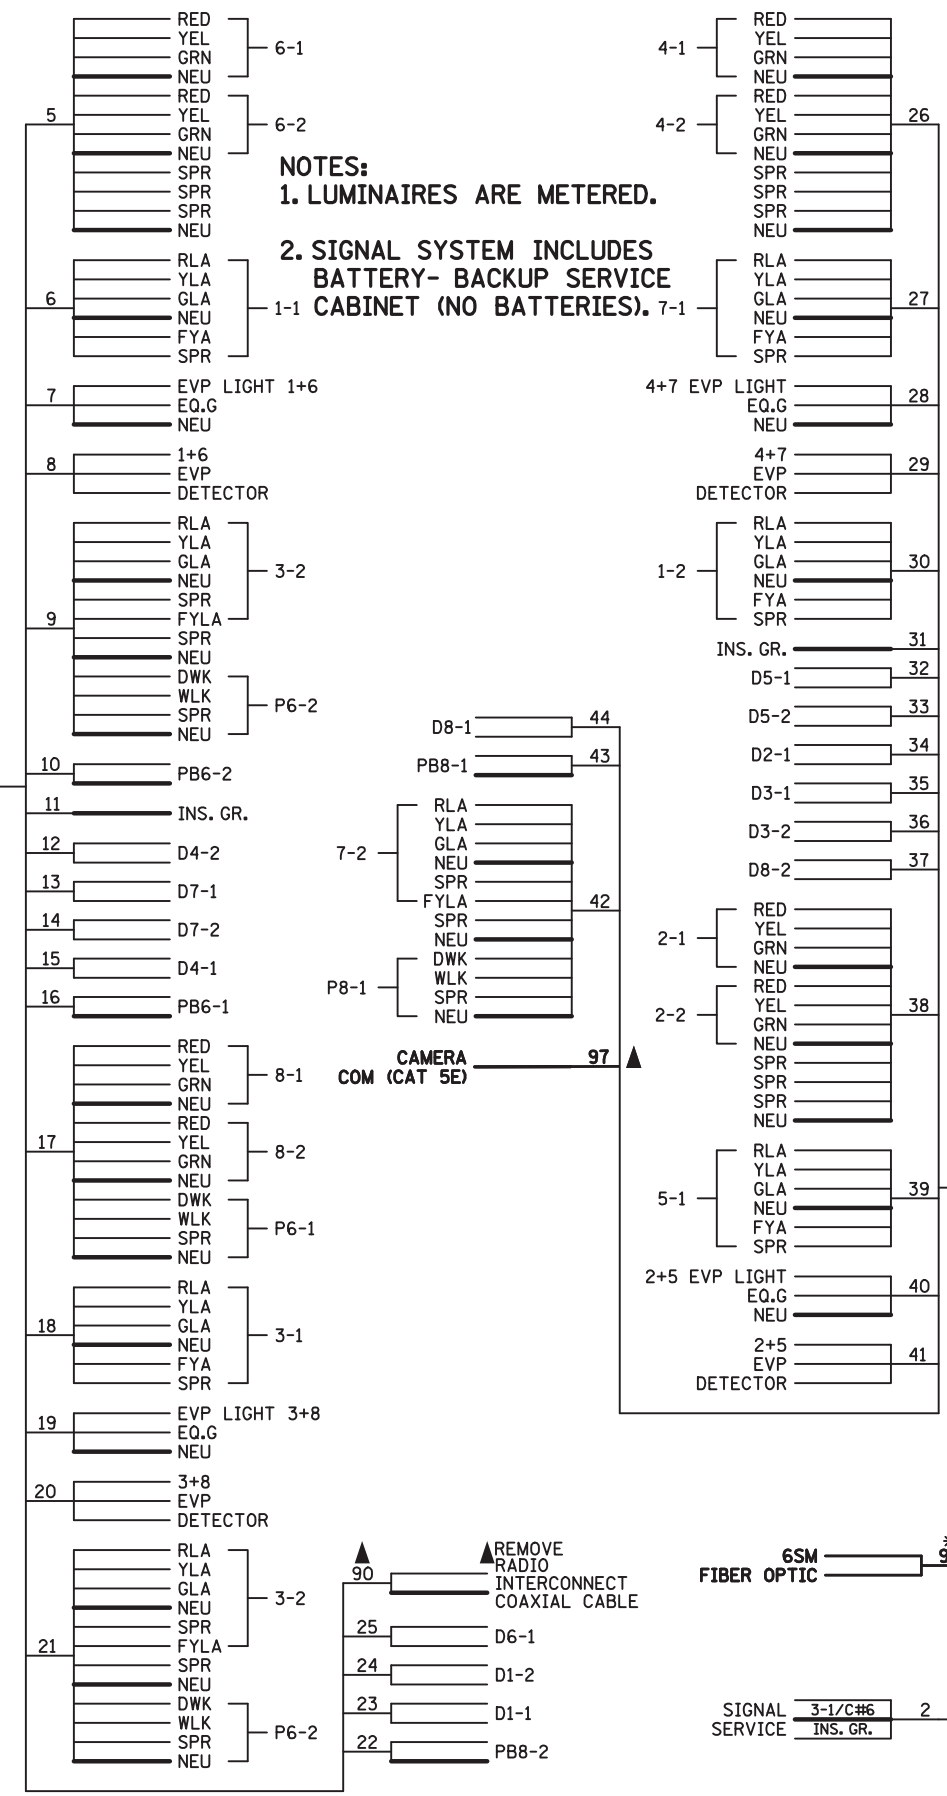

▲ DENOTES REVISE SIGNAL SYSTEM PAY ITEM WORK. ALL OTHER ITEMS SHOWN ARE INPLACE.
* DENOTES WORK TO BE COMPLETED AS PART OF THE FIBER OPTIC PLAN.

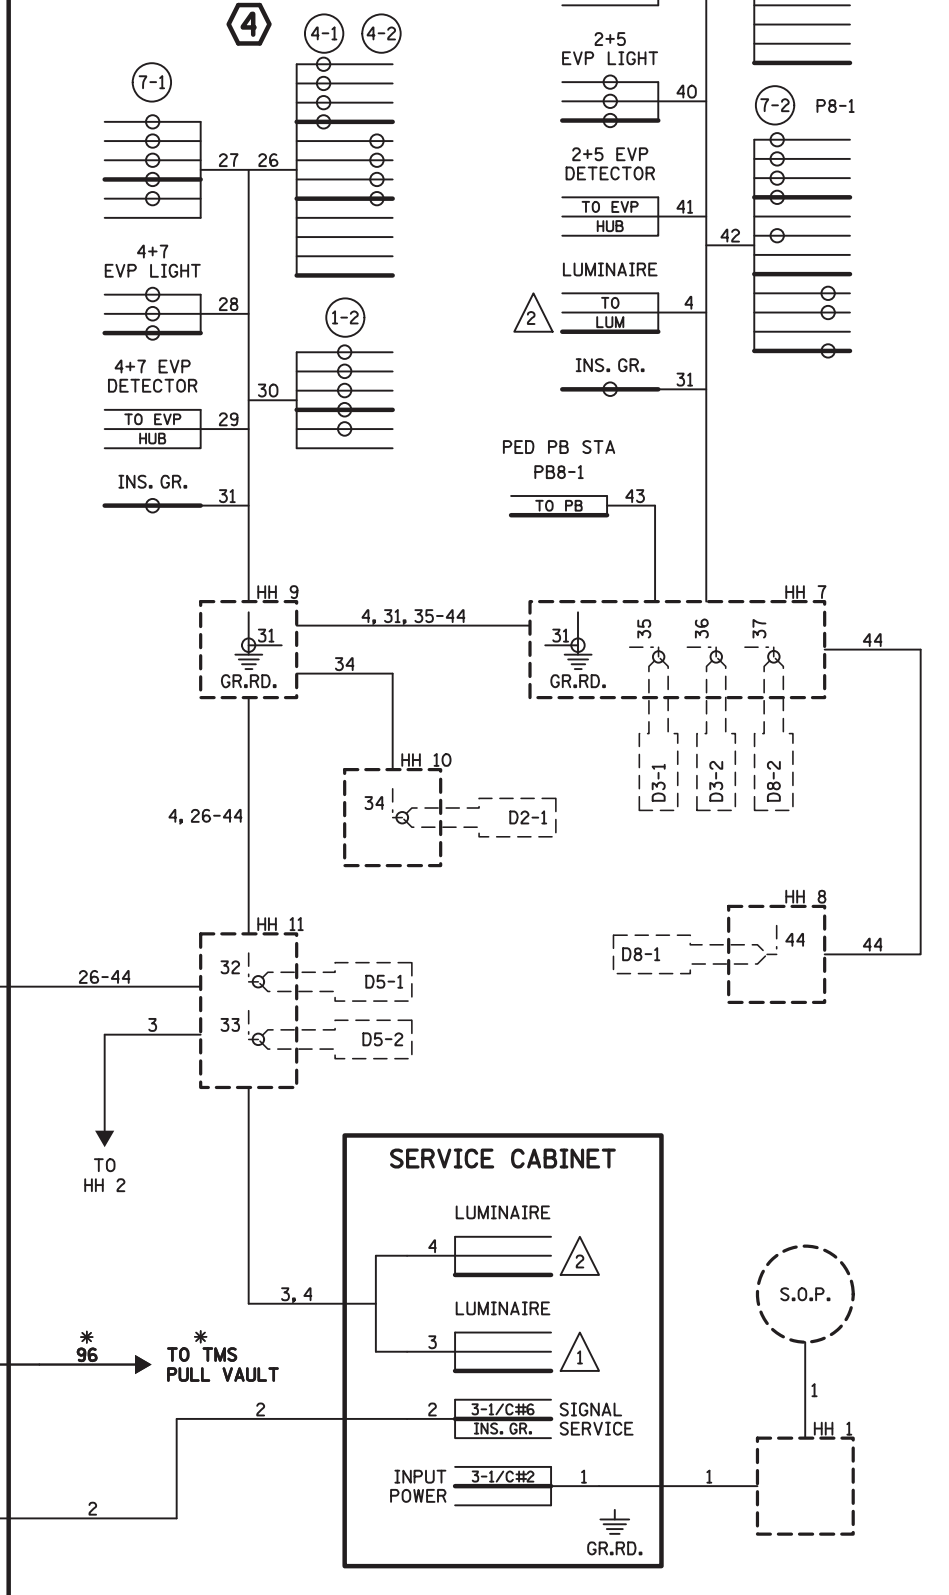


BY	DATE	REVISIONS

SYSTEM ID: 1735004
METER ADDRESS: 12290 LAKE BLVD. N.
MASTER ID: 20151 T.E.

FIELD WIRING DIAGRAM
REVISE SIGNAL SYSTEM G
T.H. 8 (LAKE BLVD.) AT
C.S.A.H. 14 (LINCOLN AVE. N.)
IN LINDSTROM, CHISAGO COUNTY

S.A.P. NO.	DRAWN BY: BAM	CKD BY: GAK	DATE: 4-9-20
CERTIFIED BY: <i>Gregory Kim</i>	LIC. NO. 26829	DATE: 4/9/20	
STATE PROJ. NO. 1301-126 (T.H.8)		SHEET NO. SS27 OF SS42 SHEETS	

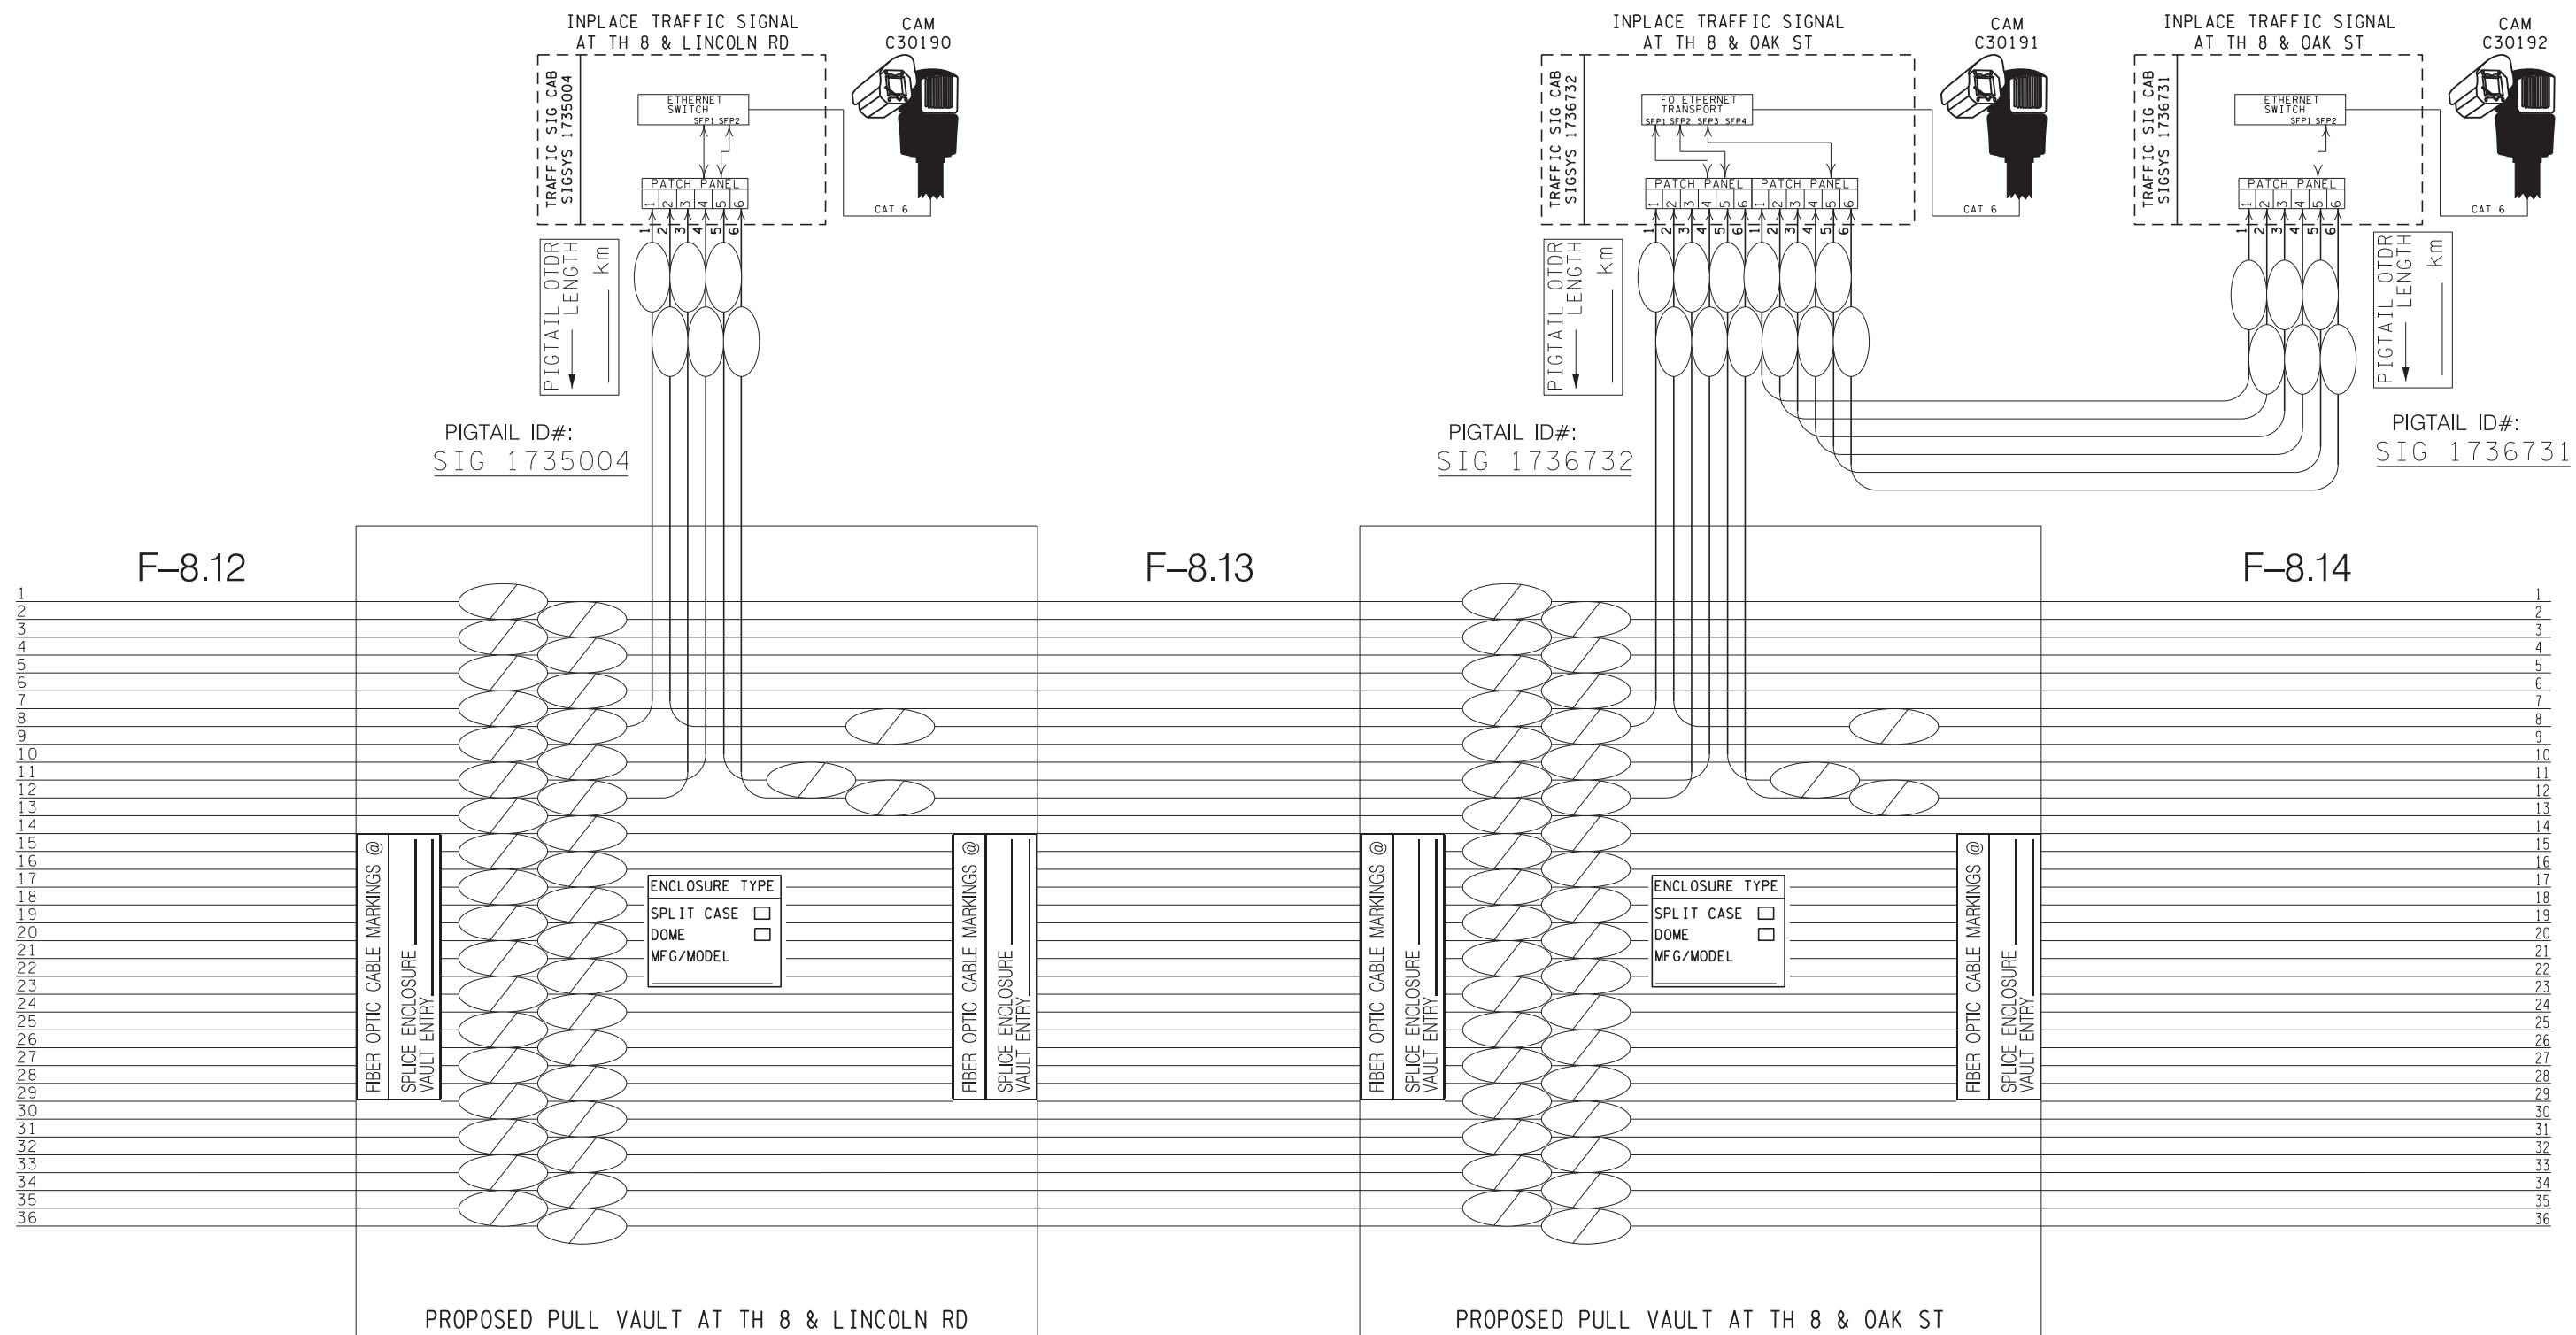

REV. NO.	DATE: / /
REV. NO.	DATE: / /

CERTIFIED BY *Michael P. Manly* LIC. NO. 43957 APR 9 2020
 LICENSED PROFESSIONAL ENGINEER

PLOTTED/REVISED: 7/21/2015

SIGNAL HEAD CHART				
FACE	R	Y	FYA	G
1-1, 1-2	←	←	←	←
2-1, 2-2	○	○	○	○
3-1, 3-2	←	←	←	←
4-1, 4-2	○	○	○	○
5-1, 5-2	←	←	←	←
6-1, 6-2	○	○	○	○
7-1, 7-2	←	←	←	←
8-1, 8-2	○	○	○	○

-ALL SIGNAL INDICATIONS ARE 12" LED
-ALL SIGNAL HEADS ARE BLACK POLYCARBONITE WITH BACKGROUND SHIELDS



1 EB STA 459+34.80, 43.76' LT
PA90 POLE FOUNDATION
TYPE PA90-A-35-D40-9 (DAVIT AT 350 DEG)
2-SWING AWAY HINGES
1-ANGLE MOUNT SIGNAL OVERHEAD AT 0'
1-STRAIGHT MOUNT SIGNAL OVERHEAD AT 11'
2-ANGLE MOUNT SIGNALS AT 90 AND 180 DEG
1-ANGLE MOUNT C.D. PED HEAD AT 180 DEG
ONE-WAY EVP DETECTOR AND
CONFIRMATORY LIGHT (PHASES 1+6)
LUMINAIRE-250W HPS
RADIO INTERCONNECT ANTENNA ON LUMINAIRE ARM
1-R10-X12 SIGN ADJACENT TO HEAD 1-1
2-TYPE D SIGNS (SEE DETAIL)
1-R9-3 SIGN (NO PED) FACING POLE 4
3" PVC TO HH 2:
2-12/C #14
1-6/C #14
1-3/C #14
1-3/C #20
1-3/C #14 (LUM)
1-RADIO COAXIAL CABLE
1-1/C #6 INS. GR.

2 EB STA 460+15.81, 58.14' LT
PA90 POLE FOUNDATION
TYPE PA90-A-35
1-ANGLE MOUNT SIGNAL OVERHEAD AT 0'
1-STRAIGHT MOUNT SIGNAL OVERHEAD AT 11'
2-ANGLE MOUNT SIGNALS AT 90 AND 180 DEG
2-ANGLE MOUNT C.D. PED HEADS
AT 90 AND 180 DEG
ONE-WAY EVP DETECTOR AND
CONFIRMATORY LIGHT (PHASES 3+8)
1-R10-X12 SIGN ADJACENT TO HEAD 3-1
1-TYPE D SIGN (SEE DETAIL)
3" PVC TO HH 4:
2-12/C #14
1-6/C #14
1-3/C #14
1-3/C #20
1-1/C #6 INS. GR.

3 EB STA 460+12.16, 36.34' RT
PA90 POLE FOUNDATION
TYPE PA90-A-40-D40-9 (DAVIT AT 350 DEG)
2-SWING AWAY HINGES
1-ANGLE MOUNT SIGNAL OVERHEAD AT 0'
1-STRAIGHT MOUNT SIGNAL OVERHEAD AT 11'
2-ANGLE MOUNT SIGNALS AT 90 AND 180 DEG
1-ANGLE MOUNT C.D. PED HEAD AT 90 DEG
ONE-WAY EVP DETECTOR AND
CONFIRMATORY LIGHT (PHASES 2+5)
LUMINAIRE-250W HPS
1-R10-X12 SIGN ADJACENT TO HEAD 5-1
2-TYPE D SIGNS (SEE DETAIL)
1-R9-3 SIGN (NO PED) FACING POLE 4
3" PVC TO HH 7:
2-12/C #14
1-6/C #14
1-3/C #14
1-3/C #20
1-3/C #14 (LUM)
1-1/C #6 INS. GR.

LOOP DETECTOR CHART		
NUMBER	SIZE (FT)	LOCATION
D1-1, D5-1	2-6x6	20 & 50
D1-2, D5-2	2-6x6	5 & 35
D2-1, D6-1	6x6	250
D3-1, D7-1	2-6x6	20 & 50
D3-2, D7-2	2-6x6	5 & 35
D4-1	1-6x6	300
D4-2, D8-2	2-6x6	5 & 20
D8-1	6x6	120

-ALL LOOP DETECTORS ARE PVC
-LOCATION: DISTANCE FROM CROSSWALK/STOP BAR IN FEET

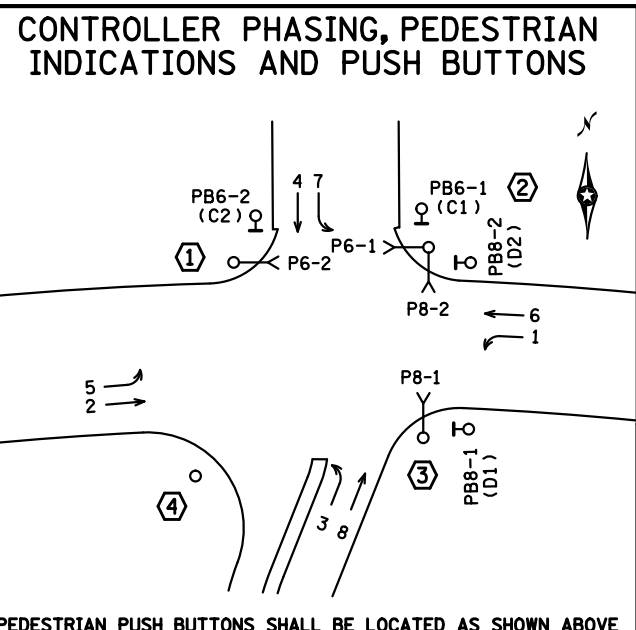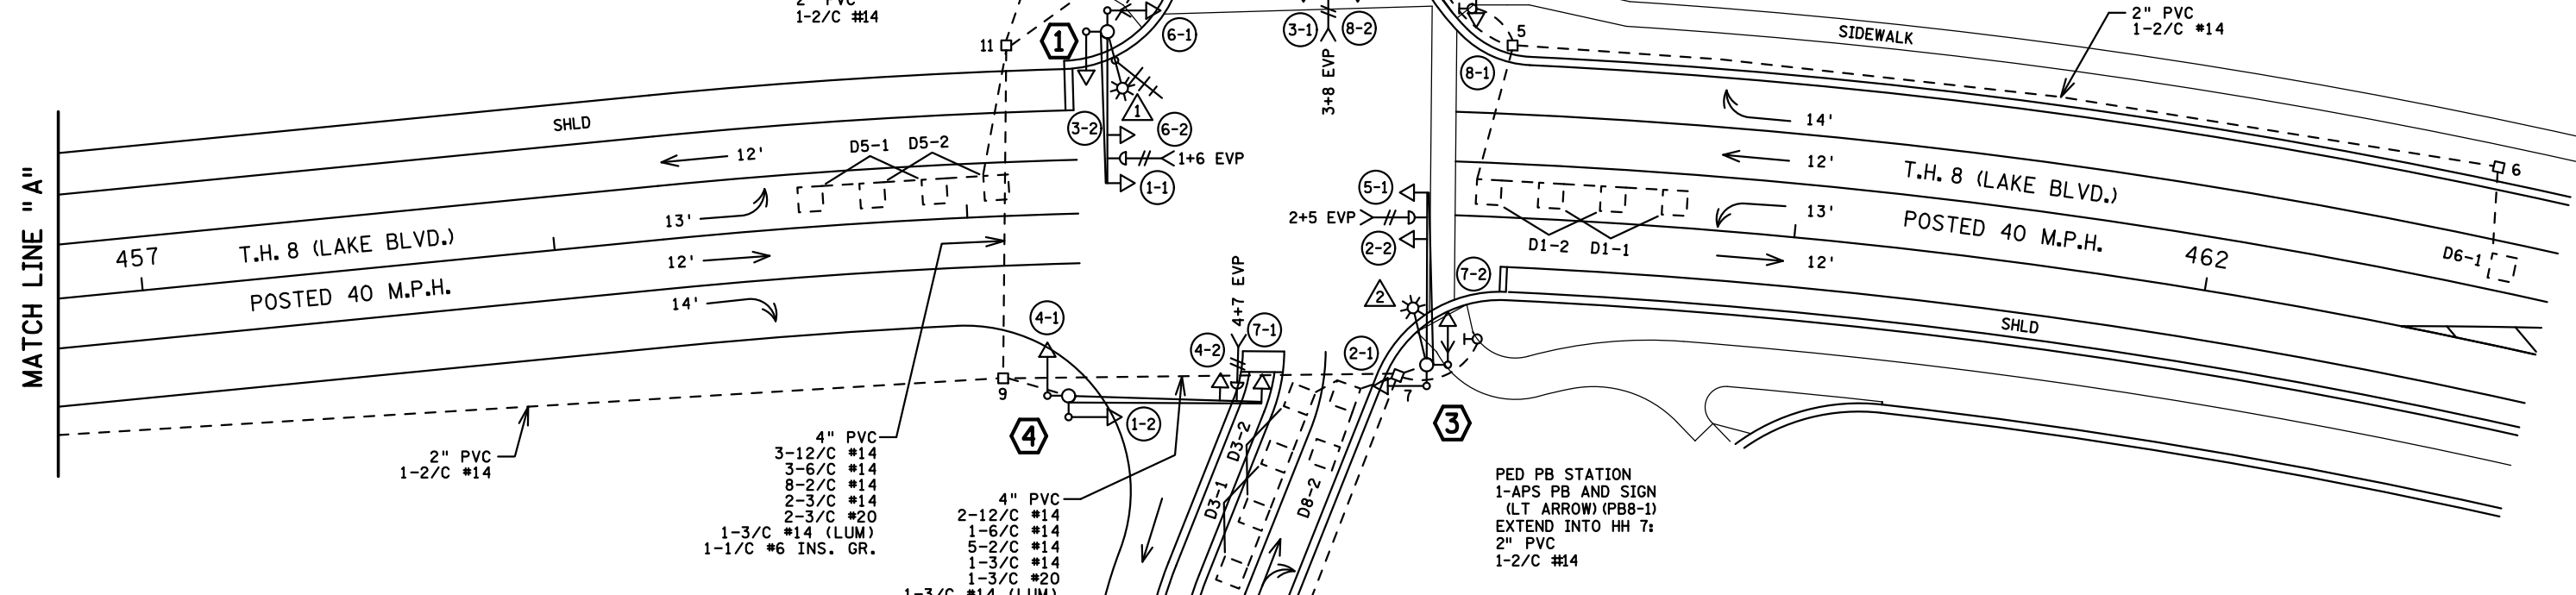

4 EB STA 459+23.17, 43.97' RT
PA100 POLE FOUNDATION
TYPE PA100-A-45
1-ANGLE MOUNT SIGNAL OVERHEAD AT 0'
1-STRAIGHT MOUNT SIGNAL OVERHEAD AT 11'
2-ANGLE MOUNT SIGNALS AT 90 AND 180 DEG
ONE-WAY EVP DETECTOR AND
CONFIRMATORY LIGHT (PHASES 7+4)
1-R10-X12 SIGN ADJACENT TO HEAD 7-1
1-TYPE D SIGN (SEE DETAIL)
2-R9-3 SIGNS (NO PED) FACING POLES 1 AND 3
3" PVC TO HH 9:
1-12/C #14
2-6/C #14
1-3/C #14
1-3/C #20
1-1/C #6 INS. GR.

SIGNAL SYSTEM OPERATION

- THE SIGNAL SYSTEM FLASH MODE IS ALL RED.
- NORMAL OPERATION IS 8 PHASE, WITH PHASES 1, 3, 5, AND 7 BEING FLASHING YELLOW ARROWS BY TIME OF DAY.
- PHASES 2 AND 6 SHALL BE ON VEHICLE RECALL.


A EQUIPMENT PAD - SEE DETAIL
SERVICE CABINET
CONTROLLER AND CABINET
4" PVC TO HH 11:
3-12/C #14
3-6/C #14
8-2/C #14
2-3/C #14
2-3/C #20
1-1/C #6 INS. GR.
2" PVC TO SERVICE CABINET:
2-1/C #6
1-1/C #6 INS. GR.
2" PVC TO SERVICE CABINET:
(SPARE-COMMS)
SERVICE CABINET TO HH 1:
2" PVC
3-1/C #2
SERVICE CABINET TO HH 11:
2" PVC
2-3/C #14 (LUM)
HH 11 TO HH 2:
2" PVC
1-3/C #14 (LUM)

DISTRICT: METRO
IPLOT: INDIRM\BAM\goulayout
PAT: HP: AF: H: E: T: A: M: E: N: A: M: E: . P: W: F: 5: 0: 7: 7: 8: 6: 6: 5: 8: 6: 5: 1: 5: 1: 2: 6: 4: 1: 0: 9: 1: . d: g: n

BY: GDS	DATE: 07-21-15	REVISIONS: AS BUILT OF SP 1301-98	SYSTEM ID: 20151	T.E.	METER ADDRESS: 12290 LAKE BLVD. N.	MASTER ID:	T.E.	INTERSECTION LAYOUT TRAFFIC CONTROL SIGNAL SYSTEM T.H. 8 (LAKE BLVD.) AT C.S.A.H. 14 (LINCOLN AVE. N.) IN LINDSTROM, CHISAGO COUNTY		S.A.P. NO.	DRAWN BY:	CKD BY:	DATE:		
										CERTIFIED BY: _____ LIC. NO. _____ DATE: _____		STATE PROJ. NO. (T.H.8)		SHEET NO. 1 OF 3 SHEETS	

PLOTTED/REVISED: 7/23/2015



DISTRICT #: METRO
 IPLOT NAME: wiring
 PATH & FILENAME: IP_PWP-d079865\T2015_lsg1.dgn

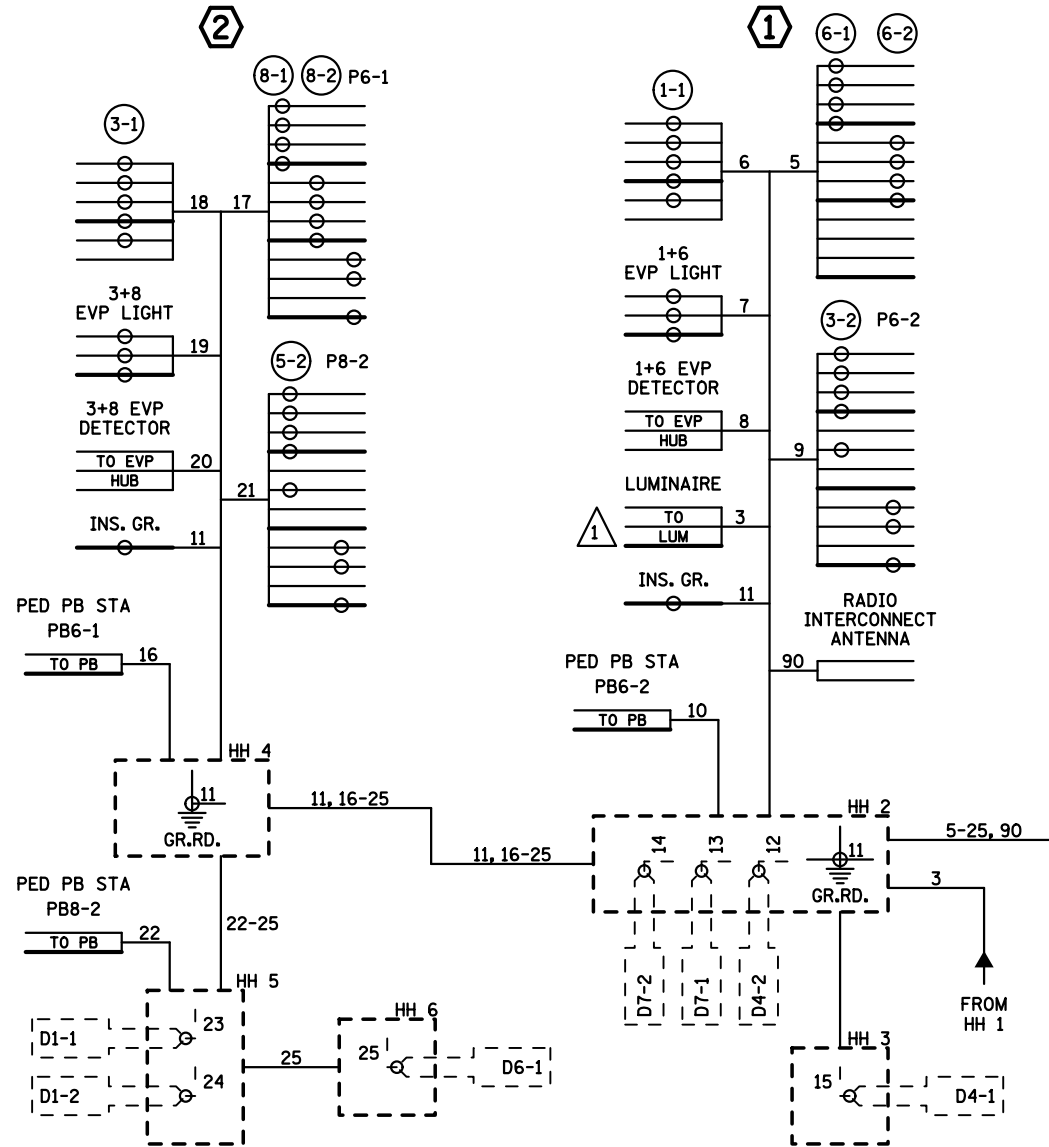

CONDUCTOR COLOR CODE (14 GAUGE)

TO SIGNAL CABINET		TO DEVICE	
1/C#6 G	R	R	RED
6PR#19	O	O	YEL
COXIAL CABLE	6/C#14 BLK/WH	6/C#14 BLK	GRN
	4/C#14 BLK/R	4 & 5 SECTION	NEU
	4/C#14 BLK	YLTA INDICATION	GLTA
	4/C#14 WH		
3-1/C#2 R	INPUT POWER	4/C#14 BLK/R	RED/DWK
3-1/C#6 BLK	SIGNAL SERVICE	4/C#14 BLK	YEL/WLK
		4/C#14 WH	GRN/SPR
		4/C#14 G	NEU
		3/C#14 BLK	EVP LIGHT
		3/C#14 G	LUM/FLASHER
		2/C#14 BLK	PED PUSH BUTTON
		2/C#14 WH OR CLR	(If Required)
		3/C#20 R OR O	
		3/C#20 WH OR YEL	
		3/C#20 BLK OR BL	

NOTE: ALL POLE CONNECTIONS SHALL BE ARRANGED AS SPECIFIED ABOVE.

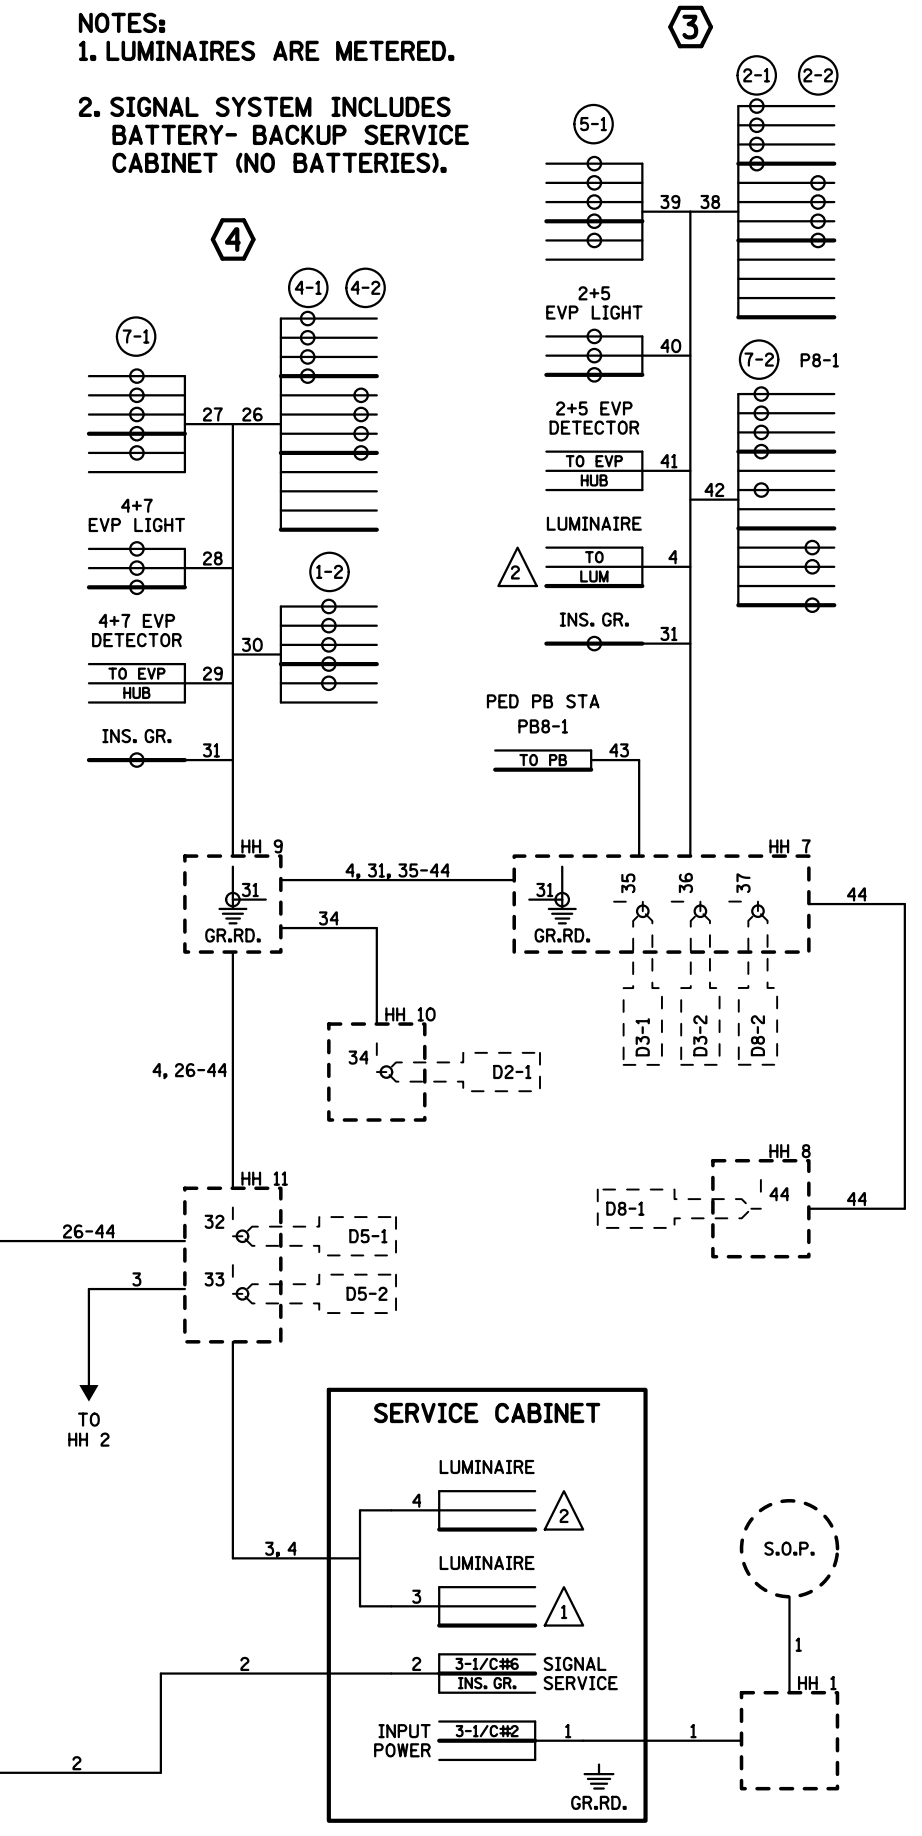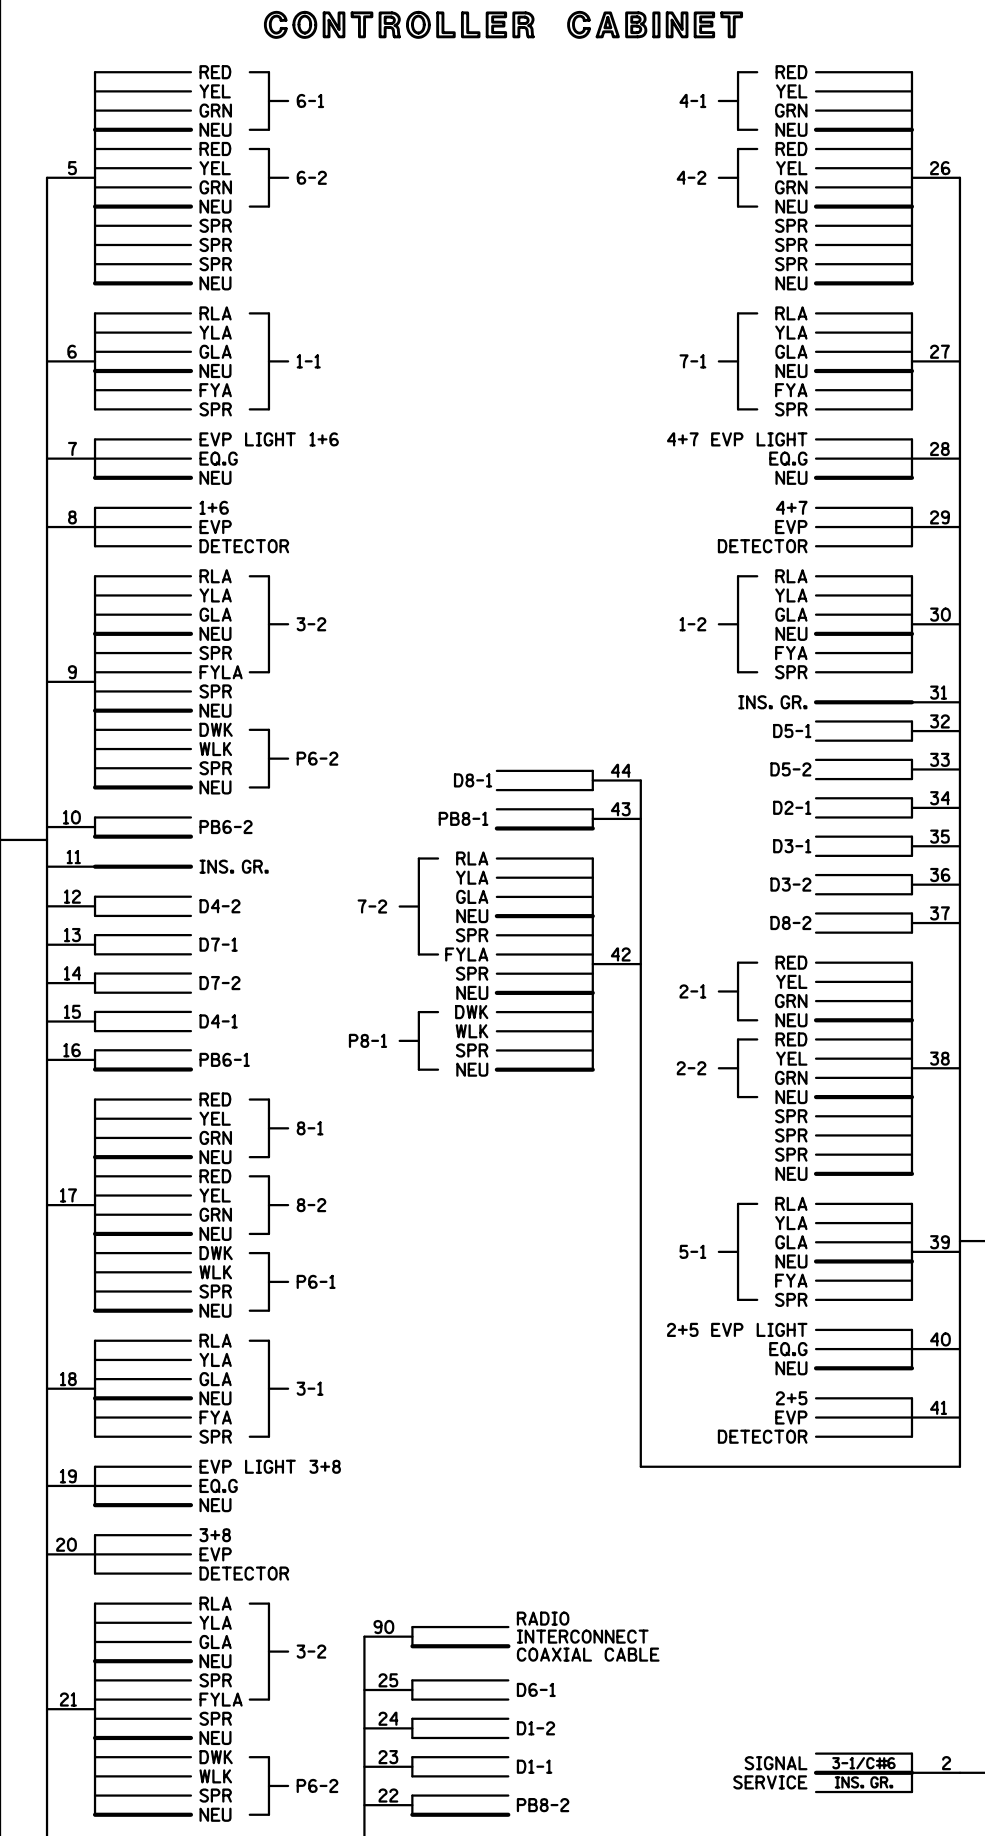

NOTES:
 1. LUMINAIRES ARE METERED.
 2. SIGNAL SYSTEM INCLUDES BATTERY- BACKUP SERVICE CABINET (NO BATTERIES).

BY	DATE	REVISIONS
GDS	07-21-15	AS BUILT OF SP 1301-98



SYSTEM ID: 20151 T.E.
 METER ADDRESS: 12290 LAKE BLVD. N.
 MASTER ID: T.E.

FIELD WIRING DIAGRAM
TRAFFIC CONTROL SIGNAL SYSTEM
 T.H. 8 (LAKE BLVD.) AT
 C.S.A.H. 14 (LINCOLN AVE. N.)
 IN LINDSTROM, CHISAGO COUNTY

S.A.P. NO. _____
 CERTIFIED BY _____ LIC. NO. _____ DATE: _____
 STATE PROJ. NO. (T.H.8) SHEET NO. 3 OF 3 SHEETS

PLOTTED/REVISED: 7/21/2015

DISTRICT #: METRO
IPLOT NAME: match lines
PATH & FILENAME: IP_PWP-d0779865T2015_lsg.dgn

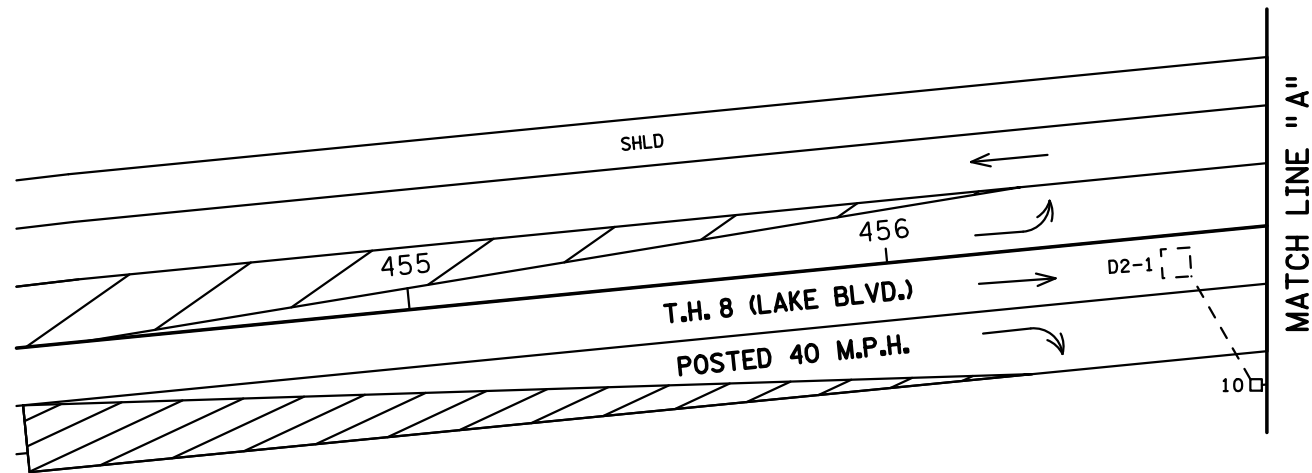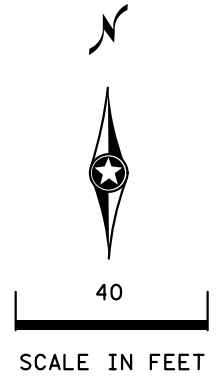

(B) SOP-GROUND MOUNTED TRANSFORMER (XCEL ENERGY)
2" PVC INTO HH 1:
3-1/C #2

XCEL ENERGY GROUND MOUNTED TRANSFORMER

2" PVC 1-2/C #14

SIDEWALK

C.S.A.H. 14

POSTED 45 M.P.H.

MATCH LINE "B"

BY	DATE	REVISIONS
GDS	07-21-15	AS BUILT OF SP 1301-98

SYSTEM ID: 20151 T.E.
METER ADDRESS: 12290 LAKE BLVD. N.
MASTER ID: T.E.

**MATCH LINES LAYOUT
TRAFFIC CONTROL SIGNAL SYSTEM
T.H. 8 (LAKE BLVD.) AT
C.S.A.H. 14 (LINCOLN AVE. N.)
IN LINDSTROM, CHISAGO COUNTY**

S.A.P. NO.	DRAWN BY:	CKD BY:	DATE:
CERTIFIED BY _____	LIC. NO. _____	DATE: _____	
STATE PROJ. NO. (T.H. 8)		SHEET NO. 2 OF 3 SHEETS	