

PLOTTED/REVISED: 8-JAN-2019

PLOT NAME: system E layout
PATH & FILENAME: Projects\DM_R05\050000Traffic\Signals\20933 Pine St\20933R_SGL.dgn

PVC LOOP DETECTOR CHART


NUMBER	SIZE (FT)	LOCATION
D1-1	6X6	5'
D1-2	6X6	25'
D2-1	6X6	120'
D2-2	6X6	120'
D4-1	6X6	120'
D4-2	6X6	25'
D4-3	6X6	0'
D4-4	6X6	10'
D5-1	6X6	5'
D5-2	6X6	25'
D6-1	6X6	140'
D6-2	6X6	140'
D8-1	6X6	120'
D8-2	6X6	25'
D8-3	6X6	5'
D8-4	6X6	0'

-LOCATION: DISTANCE FROM CROSSWALK IN FEET


SIGNAL HEAD CHART

FACE	R	Y	G	R	Y
2-2,2-3	○	○	○		
2-1,2-4	○	○	○	←	←
4-1,4-2,4-3	○	○	○		
6-2,6-3	○	○	○		
6-1,6-4	○	○	○	←	←
8-1,8-2,8-3	○	○	○		


SIGNAL HEAD PHASING

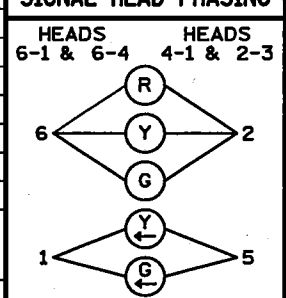

-ALL SIGNAL INDICATIONS ARE 12"
-ALL SIGNAL HEADS HAVE BACKGROUND SHIELDS

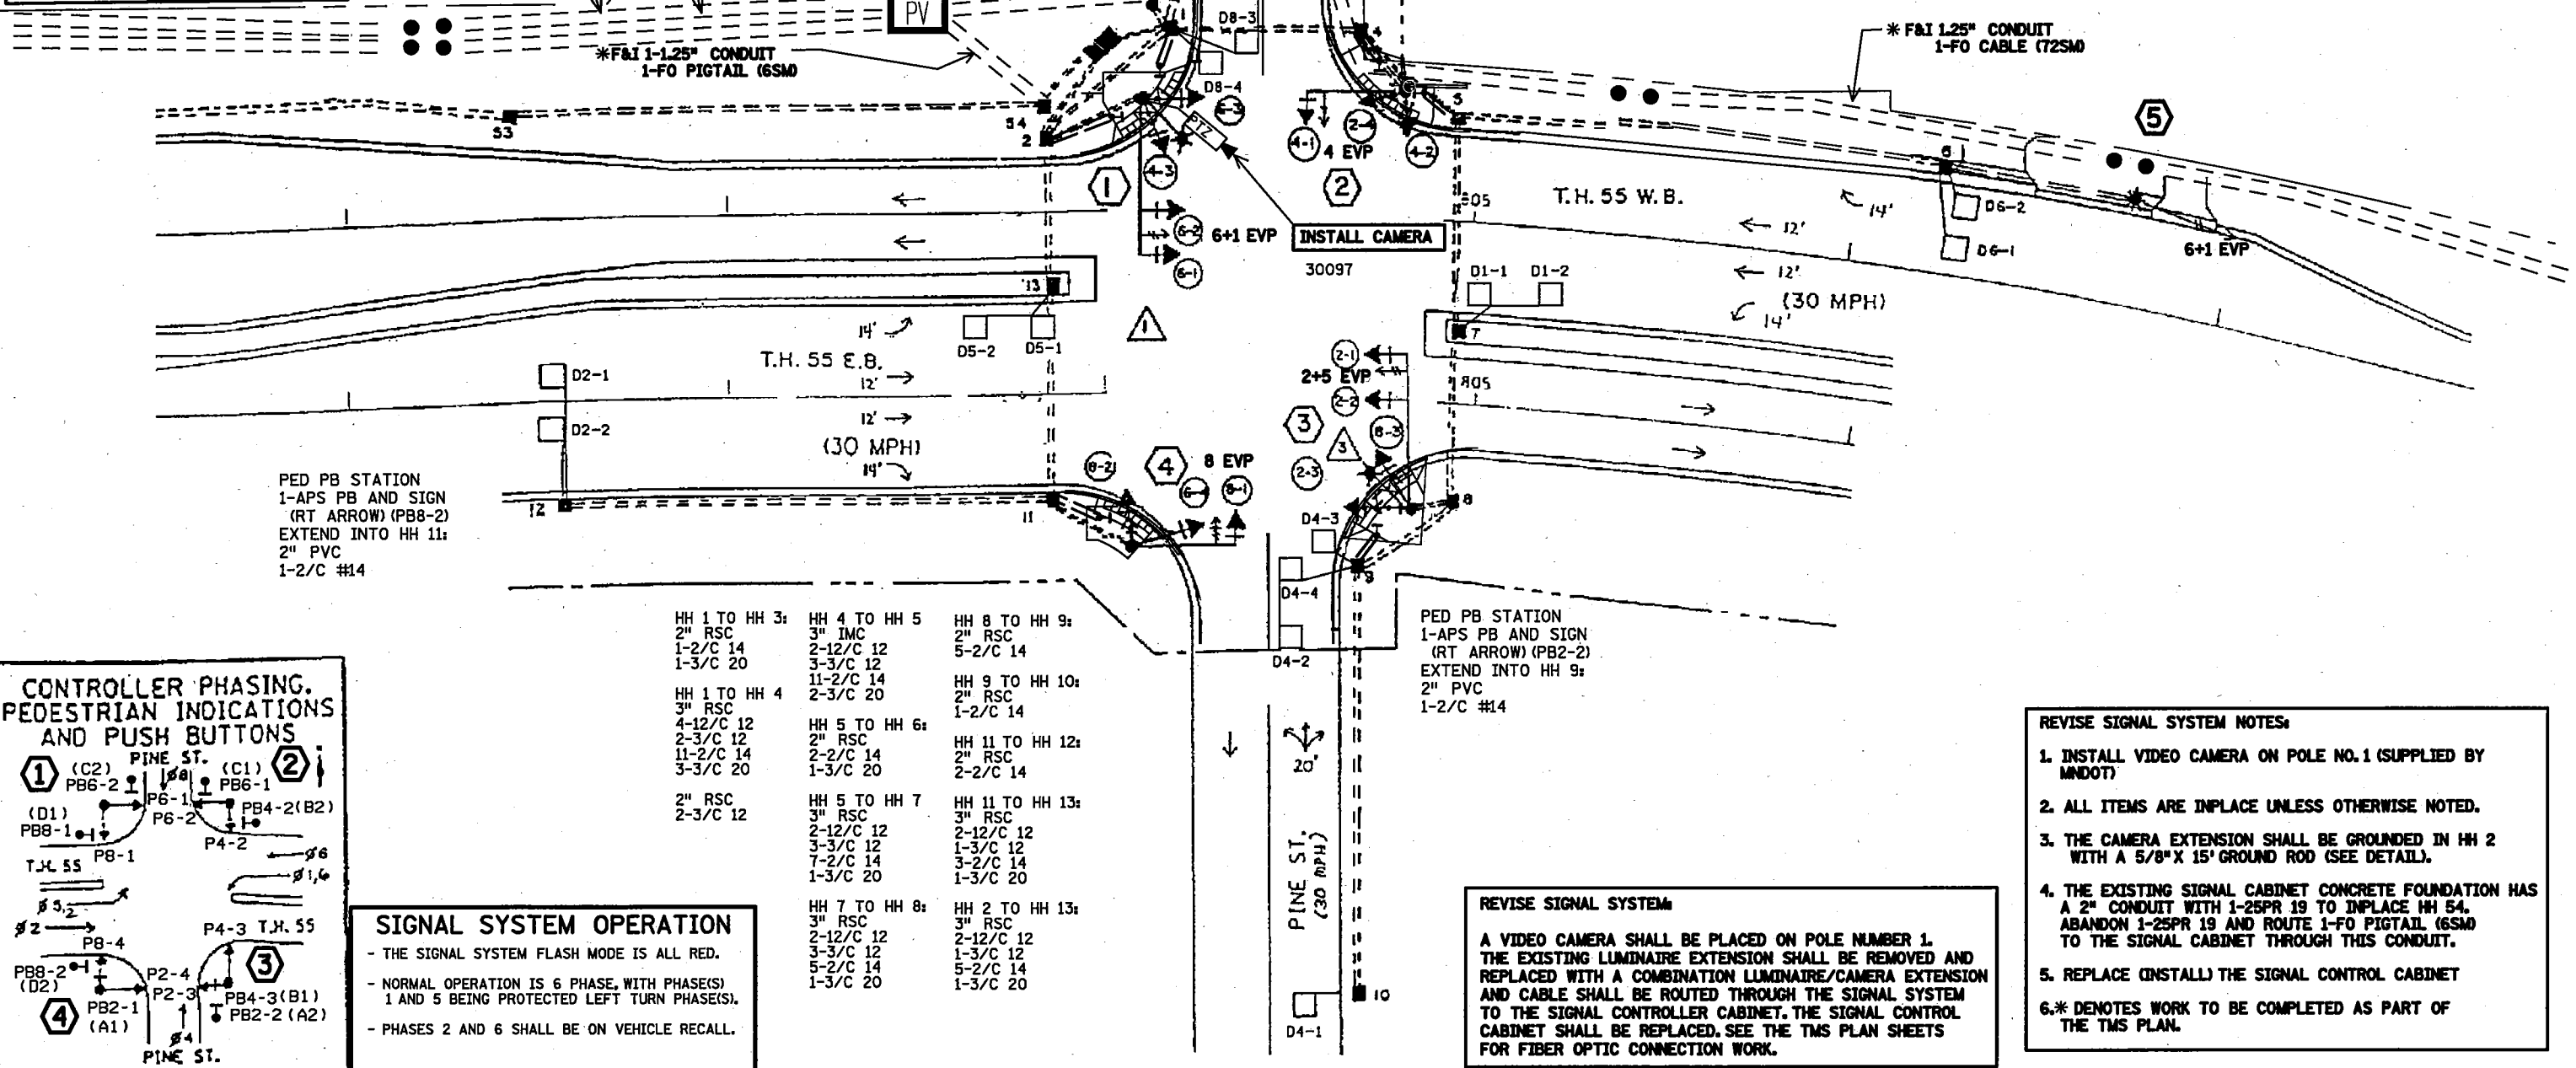

CONTROLLER PHASING, PEDESTRIAN INDICATIONS AND PUSH BUTTONS

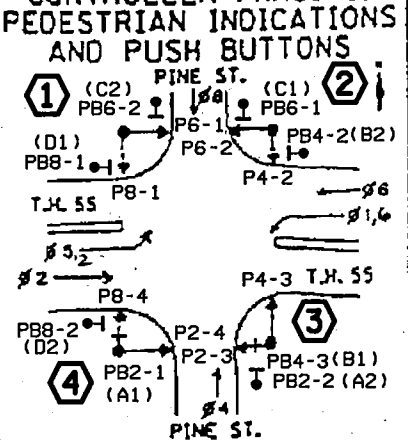

SIGNAL SYSTEM OPERATION

- THE SIGNAL SYSTEM FLASH MODE IS ALL RED.
- NORMAL OPERATION IS 6 PHASE, WITH PHASE(S) 1 AND 5 BEING PROTECTED LEFT TURN PHASE(S).
- PHASES 2 AND 6 SHALL BE ON VEHICLE RECALL.

HH 1 TO HH 3: 2" RSC 1-2/C 14 1-3/C 20	HH 4 TO HH 5: 3" IMC 2-12/C 12 3-3/C 12 11-2/C 14 2-3/C 20	HH 8 TO HH 9: 2" RSC 5-2/C 14
HH 1 TO HH 4: 3" RSC 4-12/C 12 2-3/C 12 11-2/C 14 3-3/C 20	HH 5 TO HH 6: 2" RSC 2-2/C 14 1-3/C 20	HH 9 TO HH 10: 2" RSC 1-2/C 14
2" RSC 2-3/C 12	HH 5 TO HH 7: 3" RSC 2-12/C 12 3-3/C 12 7-2/C 14 1-3/C 20	HH 11 TO HH 12: 2" RSC 2-2/C 14
	HH 7 TO HH 8: 3" RSC 2-12/C 12 3-3/C 12 5-2/C 14 1-3/C 20	HH 11 TO HH 13: 3" RSC 2-12/C 12 1-3/C 12 3-2/C 14 1-3/C 20
		HH 2 TO HH 13: 3" RSC 2-12/C 12 1-3/C 12 5-2/C 14 1-3/C 20

REVISE SIGNAL SYSTEM

A VIDEO CAMERA SHALL BE PLACED ON POLE NUMBER 1. THE EXISTING LUMINAIRE EXTENSION SHALL BE REMOVED AND REPLACED WITH A COMBINATION LUMINAIRE/CAMERA EXTENSION AND CABLE SHALL BE ROUTED THROUGH THE SIGNAL SYSTEM TO THE SIGNAL CONTROLLER CABINET. THE SIGNAL CONTROL CABINET SHALL BE REPLACED. SEE THE TMS PLAN SHEETS FOR FIBER OPTIC CONNECTION WORK.

REVISE SIGNAL SYSTEM NOTES:

1. INSTALL VIDEO CAMERA ON POLE NO. 1 (SUPPLIED BY MNDOT)
2. ALL ITEMS ARE INPLACE UNLESS OTHERWISE NOTED.
3. THE CAMERA EXTENSION SHALL BE GROUNDED IN HH 2 WITH A 5/8" X 15' GROUND ROD (SEE DETAIL).
4. THE EXISTING SIGNAL CABINET CONCRETE FOUNDATION HAS A 2" CONDUIT WITH 1-25PR 19 TO INPLACE HH 54. ABANDON 1-25PR 19 AND ROUTE 1-FO PIGTAIL (6SM) TO THE SIGNAL CABINET THROUGH THIS CONDUIT.
5. REPLACE (INSTALL) THE SIGNAL CONTROL CABINET
- 6.* DENOTES WORK TO BE COMPLETED AS PART OF THE TMS PLAN.

BY	DATE	REVISIONS	SYSTEM ID: 1735421	T.E. 9663	S.A.P. NO.	DRAWN BY: SJK	CKD BY: CDB	DATE: 12/12/18
			METER ADDRESS: 802 HWY 55		CERTIFIED BY: <i>Michael P. Sulway</i>		LIC. NO. 19863	DATE: 01/08/19
			OLD SYSTEM ID: 20933		STATE PROJ. NO. 1910-50 (T.H. 55) SHEET NO. SS17 OF SS35 SHEETS			

INTERSECTION LAYOUT
REVISE SIGNAL SYSTEM E
T.H. 55 AT PINE STREET
IN HASTINGS, DAKOTA COUNTY

PLOTTED/REVISED: 13-DEC-2018
 I/PLOT NAME: system E pole notes
 PATH & FILENAME: Projects\DM ROS\055\0000\Traffic\Signals\20933 Pine SNT 20933R_SGL.dgn

1 A100 POLE FOUNDATION
 TYPE A100-A-40-9
 REMOVE — D40-9 (DAVIT AT 350 DEG)
 F&I — 1-X6-350/CAM EXTENSION (MOUNTED AT 350 DEG)
 INCLUDED LIGHTING ROD
 7/16" GROUND BRAID
 INSTALL — 1-VIDEO CAMERA WITH MOUNT

 2-ONE WAY SIGNALS (OVERHEAD)
 2-TYPE 10B AT 0 AND 270 DEG
 2-CD PED HEADS
 S&I — LUMINAIRE - 200 WATT HPS
 ONE WAY EVP DETECTOR AND
 CONFIRMATORY LIGHT (PHASES 6+1)
 2" RSC STUB-OUT FOR CITY STREET LIGHTING
 CITY LIGHTING CABLES
 3" IMC TO HH 2 WITH
 2-12/C#12
 4-3/C#12
 1-3/C#20
 F&I — 1-7/16" GROUND BRAID
 TO GROUND ROD
 1-COM CABLE (CAT 5E)

2 P90 POLE FOUNDATION
 TYPE P90-A-25
 ONE WAY SIGNAL (OVERHEAD)
 2-TYPE 10B AT 90 AND 270 DEG
 2-CD PED HEADS
 ONE WAY EVP DETECTOR AND
 CONFIRMATORY LIGHT (PHASE 4)
 3" IMC TO HH 4 WITH
 2-12/C#12
 4-3/C#12
 1-3/C#20

3 A100 POLE FOUNDATION
 TYPE A100-A-40-9 (DAVIT AT 350 DEG)
 2-ONE WAY SIGNALS (OVERHEAD)
 2-TYPE 10B AT 0 AND 270 DEG
 2-CD PED HEADS
 1-APS PB & SIGN (PB4-3)(LT ARROW)
 LUMINAIRE - 200 WATT HPS
 ONE WAY EVP DETECTOR AND
 CONFIRMATORY LIGHT (PHASES 2+5)
 2" RSC STUB-OUT FOR STREET LIGHTING
 CITY LIGHTING CABLES
 3" IMC TO HH 8 WITH
 2-12/C#12
 3-3/C#12
 1-3/C#20

4 P90 POLE FOUNDATION
 TYPE P90-A-25
 ONE WAY SIGNAL (OVERHEAD)
 2-TYPE 10B AT 90 AND 270 DEG
 2-CD PED HEADS
 1-APS PED PB & SIGN (PB2-1)(LT ARROW)
 ONE WAY EVP DETECTOR AND
 CONFIRMATORY LIGHT (PHASE 8)
 3" IMC TO HH 11 WITH
 2-12/C#12
 2-3/C#12
 1-3/C#20

5 ONE WAY EP DETECTOR 06 MOUNTED
 NEAR TOP OF STREET LIGHT POLE
 2" RSC INTO HH 6 WITH
 1-3/C#20

6 PEDESTAL POLE AND BASE
 PEDESTAL FOUNDATION
 ONE WAY EVP DETECTOR (PHASE 8)
 MOUNTED ON TOP OF PEDESTAL
 2" RSC TO HH 3 WITH
 1-3/C#20

A REPLACE (INSTALL) — CONTROLLER AND CABINET
 CABINET FOUNDATION

 EXTEND INTO HH 1:
 4" IMC
 4-12/C 12
 4-3/C 12
 16-2/C 14
 4-3/C 20
 2-1/C 6
 1-1/C 6 INS GR

 EXTEND INTO HH 2:
 4" IMC
 4-12/C 12
 4-3/C 12
 6-2/C 14
 2-3/C 20
 F&I — 1-COM CABLE (CAT 5E)

 EXTEND INTO HH 54:
 2" RSC
 ABANDON — 1-25 PR#19

 * F&I — 1-FO PIGTAIL (6SM - FIELD TERMINATED)
 HH54 TO PULL VAULT
 1.25" CONDUIT
 1-FO PIGTAIL (6SM)

B WOOD POLE
 SERVICE EQUIPMENT
 EXTEND INTO HH 1:
 2" RSC
 2-1/C 6
 1-1/C 6 INS GR

BY	DATE	REVISIONS

SYSTEM ID: 1735421 T.E. 9663
 METER ADDRESS: 802 HWY 55
 OLD SYSTEM ID: 20933



POLE NOTES
REVISE SIGNAL SYSTEM E
T.H. 55 AT PINE STREET
IN HASTINGS, DAKOTA COUNTY

S.A.P. NO. _____ DRAWN BY: SJK CKD BY: CDB DATE: 12/12/18
 CERTIFIED BY: *Michael P. Libonaty* LIC. NO. 19863 DATE: 12/12/18
LICENSED PROFESSIONAL ENGINEER
STATE PROJ. NO. 1910-50 (T.H.55) SHEET NO. SS18 OF SS35 SHEETS

PLOTTED/REVISED: 13-DEC-2018

IPLOT NAME: system E wiring diagram
PATH & FILENAME: Projects\DW_ROS\05\0000\TrafficSignals\20933 Pine ST\20933R_SGL.dgn

CONTROLLER CABINET

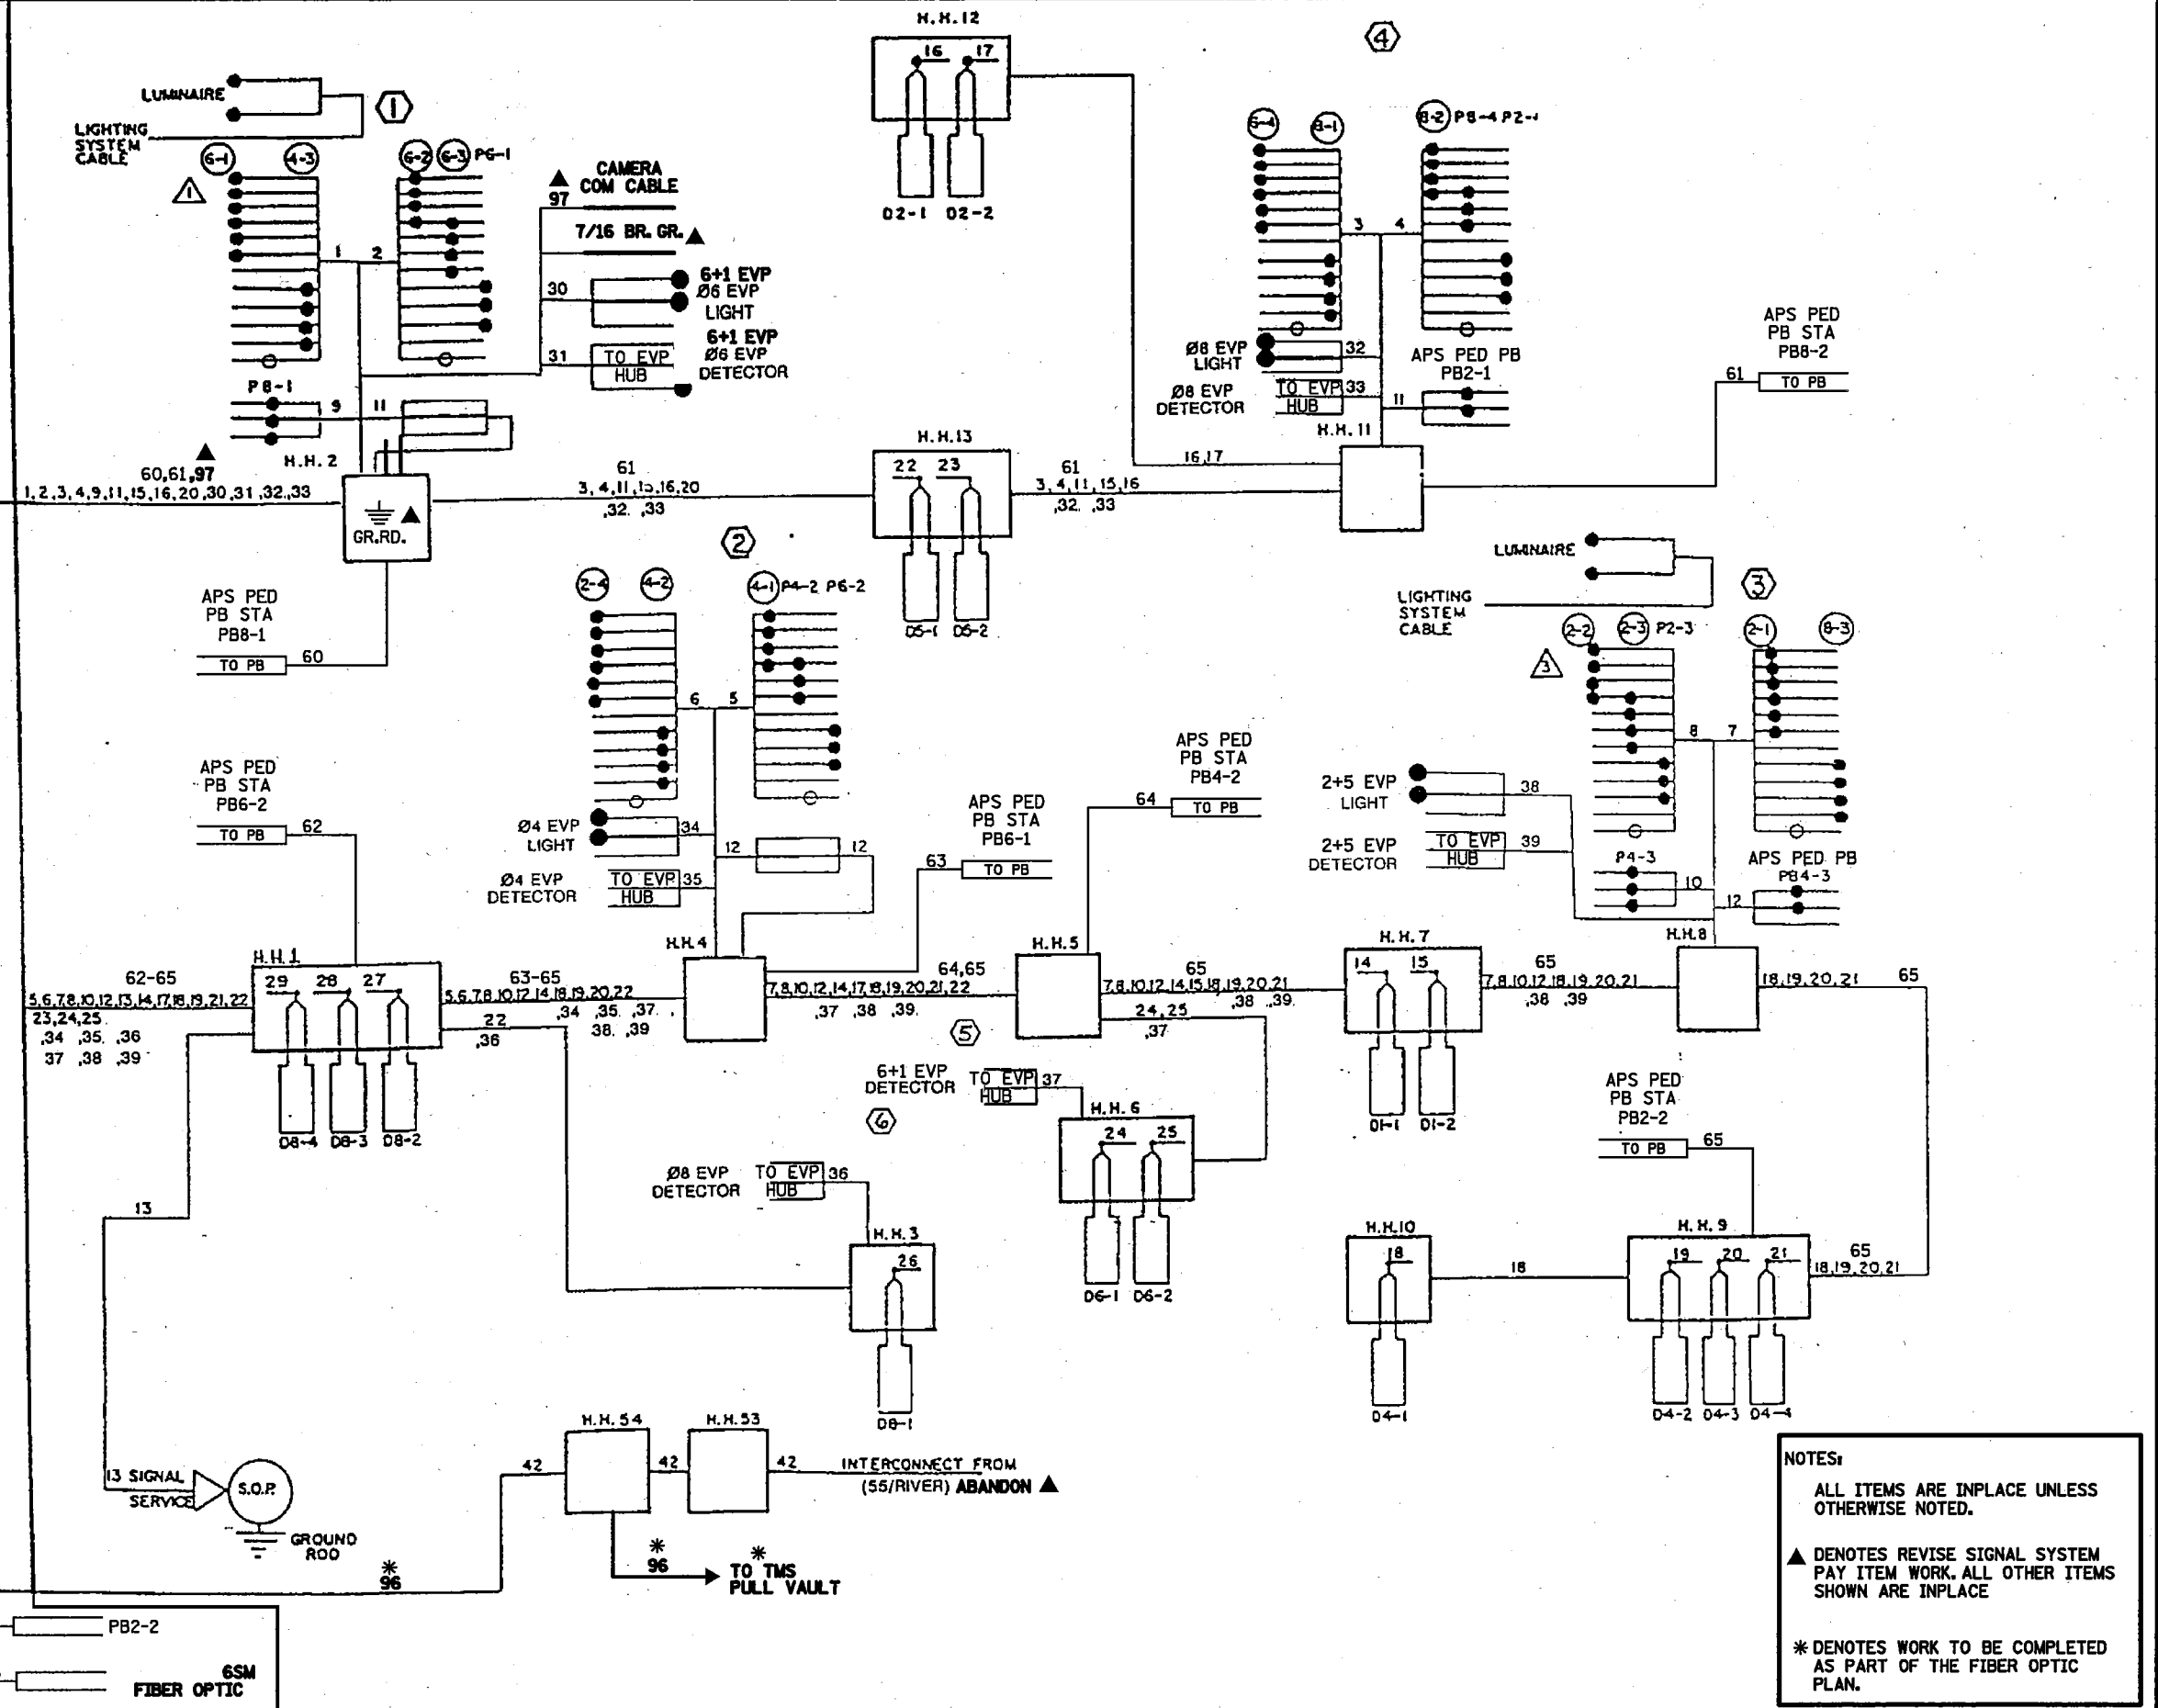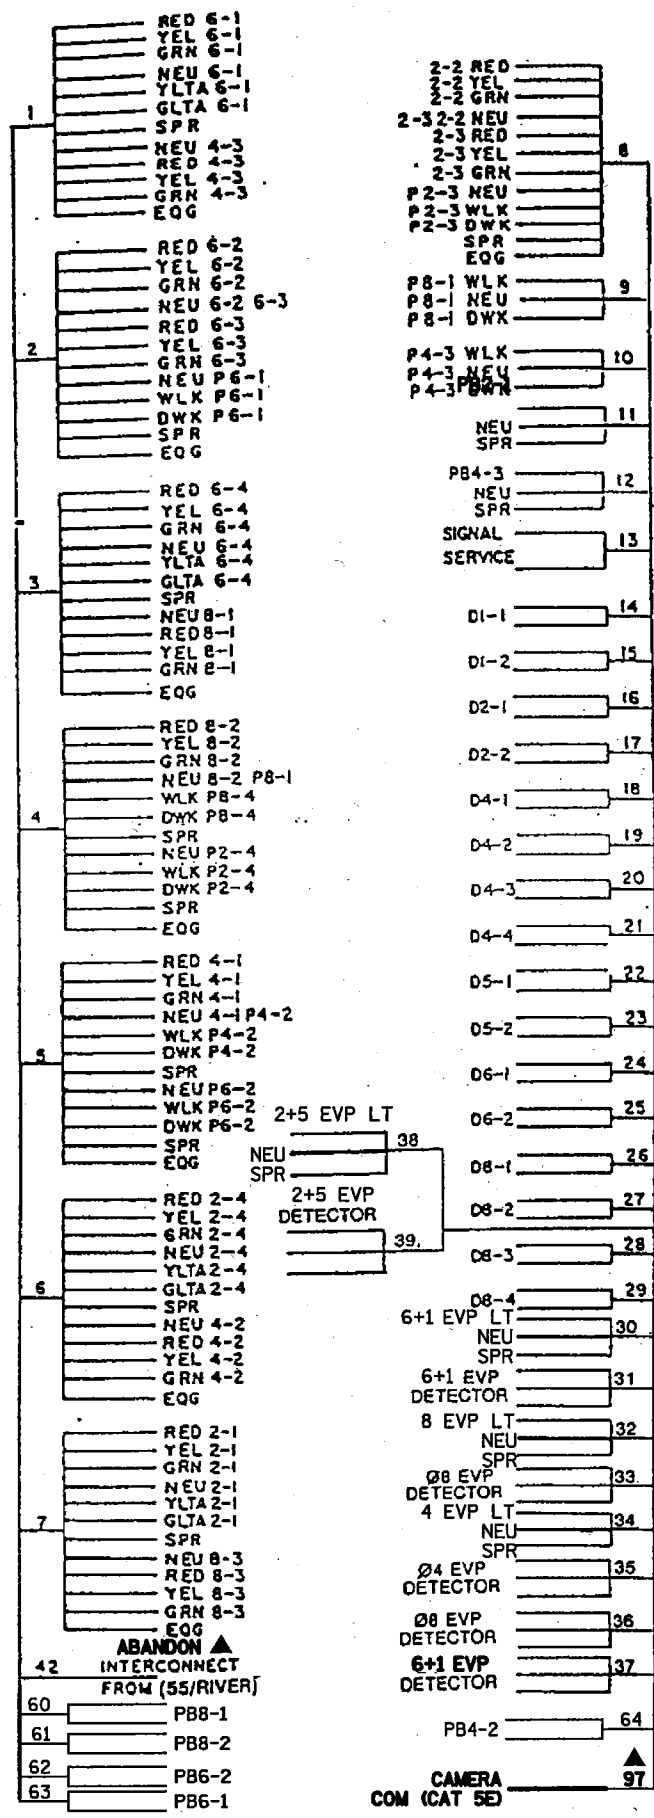

NOTES:

- ALL ITEMS ARE INPLACE UNLESS OTHERWISE NOTED.
- ▲ DENOTES REVISE SIGNAL SYSTEM PAY ITEM WORK. ALL OTHER ITEMS SHOWN ARE INPLACE
- * DENOTES WORK TO BE COMPLETED AS PART OF THE FIBER OPTIC PLAN.

BY	DATE	REVISIONS	SYSTEM ID: 1735421	T.E. 9663	S.A.P. NO.	DRAWN BY: SJK	CKD BY: CDB	DATE: 12/12/18
			METER ADDRESS: 802 HWY 55		CERTIFIED BY: <i>Michael P. Libinsky</i>			
			OLD SYSTEM ID: 20933			LIC. NO. 19863		DATE: 12/12/18
					STATE PROJ. NO. 1910-50 (T.H.55) SHEET NO. SS19 OF SS35 SHEETS			

PVC LOOP DETECTOR CHART

NUMBER	SIZE (FT)	LOCATION
D1-1	6X6	5'
D1-2	6X6	25'
D2-1	6X6	120'
D2-2	6X6	120'
D4-1	6X6	120'
D4-2	6X6	25'
D4-3	6X6	0'
D4-4	6X6	10'
D5-1	6X6	5'
D5-2	6X6	25'
D6-1	6X6	140'
D6-2	6X6	140'
D8-1	6X6	120'
D8-2	6X6	25'
D8-3	6X6	5'
D8-4	6X6	0'


-LOCATION: DISTANCE FROM CROSSWALK IN FEET

SIGNAL HEAD CHART

FACE	R	Y	G	R	Y
2-2-2-3	○	○	○		
2-1-2-4	○	○	○	◀	◀
4-1,4-2,4-3	○	○	○		
6-2,6-3	○	○	○		
6-1,6-4	○	○	○	◀	◀
8-1,8-2,8-3	○	○	○		



-ALL SIGNAL INDICATIONS ARE 12" SHIELDS
-ALL SIGNAL HEADS HAVE BACKGROUND SHIELDS

SIGNAL HEAD PHASING

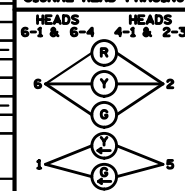

PLOTTED/REVISED: 4/29/2014

DISTRICT #: METRO
I/PLOT NAME: INTERSECTION
PATH & FILENAME: IP_PWB-0709107020933R_SGL.dgn

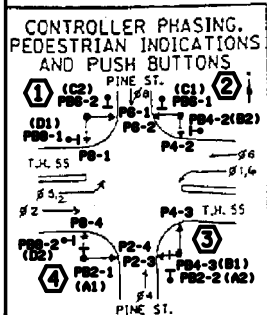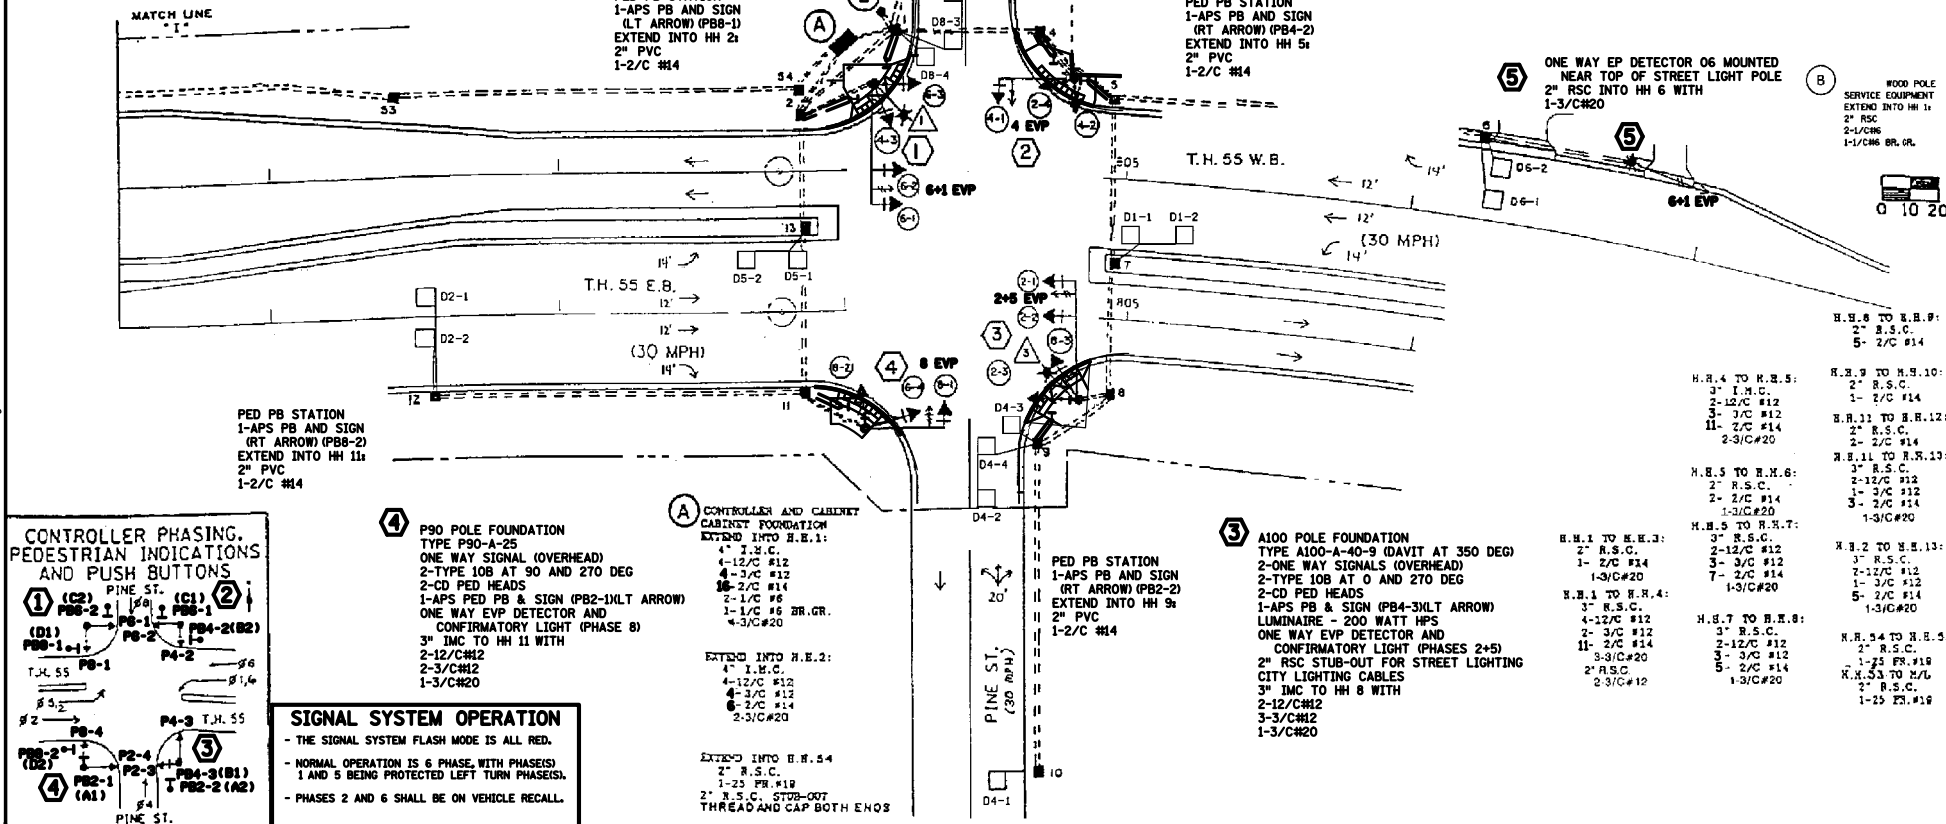

SIGNAL SYSTEM OPERATION

- THE SIGNAL SYSTEM FLASH MODE IS ALL RED.
- NORMAL OPERATION IS 6 PHASE WITH PHASES 1 AND 5 BEING PROTECTED LEFT TURN PHASES.
- PHASES 2 AND 6 SHALL BE ON VEHICLE RECALL.

4 P90 POLE FOUNDATION
TYPE P90-A-25
ONE WAY SIGNAL (OVERHEAD)
2-TYPE 10B AT 90 AND 270 DEG
2-CD PED HEADS
1-APS PED PB & SIGN (PB2-D/ILT ARROW)
ONE WAY EVP DETECTOR AND CONFIRMATORY LIGHT (PHASE 8)
3" IMC TO HH 11 WITH
2-12/C#12
2-3/C#12
1-3/C#20

A CONTROLLER AND CABINET
CABINET FOUNDATION
EXTEND INTO H.E.1:
4" I.B.C.
4-12/C #12
4-3/C #12
3-2/C #14
2-1/C #6
1-1/C #6 BR.GR.
4-3/C#20

EXTEND INTO H.E.2:
4" I.B.C.
4-12/C #12
4-3/C #12
6-2/C #14
2-3/C#20

EXTEND INTO H.E.4
2" R.S.C.
1-25 PR.#19
2" R.S.C. STUB-OUT
THREAD& CAP BOTH ENDS

6 PEDESTAL POLE AND BASE
PEDESTAL FOUNDATION
ONE WAY EVP DETECTOR (PHASE 8)
MOUNTED ON TOP OF PEDESTAL
2" RSC TO HH 3 WITH
1-3/C#20

2 P90 POLE FOUNDATION
TYPE P90-A-25
ONE WAY SIGNAL (OVERHEAD)
2-TYPE 10B AT 90 AND 270 DEG
2-CD PED HEADS
ONE WAY EVP DETECTOR AND CONFIRMATORY LIGHT (PHASE 4)

PED PB STATION
1-APS PB AND SIGN (LT ARROW) (PB6-1)
EXTEND INTO HH 4a
2" PVC
1-2/C #14

PED PB STATION
1-APS PB AND SIGN (RT ARROW) (PB4-2)
EXTEND INTO HH 5a
2" PVC
1-2/C #14

5 ONE WAY EP DETECTOR 06 MOUNTED
NEAR TOP OF STREET LIGHT POLE
2" RSC INTO HH 6 WITH
1-3/C#20

B WOOD POLE
SERVICE EQUIPMENT
EXTEND INTO HH 11:
2" RSC
2-1/CH6
1-1/CH6 BR.GR.

H.H.6 TO H.H.9:
2" R.S.C.
5- 2/C #14

H.H.4 TO H.H.5:
3" I.M.C.
2-12/C #12
3- 3/C #12
11- 2/C #14
2-3/C#20

H.H.11 TO H.H.12:
2" R.S.C.
2- 2/C #14

H.H.11 TO H.H.13:
3" R.S.C.
2-12/C #12
1- 3/C #12
3- 2/C #14
1-3/C#20

H.H.5 TO H.H.6:
2" R.S.C.
2- 2/C #14
1-3/C#20

H.H.5 TO H.H.7:
3" R.S.C.
2-12/C #12
3- 3/C #12
7- 2/C #14
1-3/C#20

H.H.1 TO H.H.3:
2" R.S.C.
1- 2/C #14
1-3/C#20

H.H.1 TO H.H.4:
3" R.S.C.
4-12/C #12
2- 3/C #12
11- 2/C #14
3-3/C#20
2" RSC
2-3/C#12

H.H.7 TO H.H.8:
3" R.S.C.
2-12/C #12
3- 3/C #12
5- 2/C #14
1-3/C#20

H.H.2 TO H.H.13:
3" R.S.C.
7-12/C #12
1- 3/C #12
5- 2/C #14
1-3/C#20

H.H.9 TO H.H.10:
2" R.S.C.
1- 2/C #14

H.H.10 TO H.H.11:
2" R.S.C.
1- 3/C #12

H.H.13 TO H.H.14:
2" R.S.C.
1-25 PR.#19

H.H.14 TO H.H.15:
2" R.S.C.
1-25 PR.#19

BY	DATE	REVISIONS
EJA	04-29-14	AS-BUILT OF SP 8825-445 (APS & CD PEDS)

SYSTEM ID:	20933	T.E. 5823
METER ADDRESS:		
MASTER ID:		T.E.

INTERSECTION LAYOUT
T.H. 55 AT PINE STREET
IN HASTINGS, DAKOTA COUNTY



S.A.P. NO.		DRAWN BY: MAS	CKD BY: GAK	DATE: 4-12-13
CERTIFIED BY:		LIC. NO. 26829	DATE:	

STATE PROJ. NO. _____ SHEET NO. 1 OF 2 SHEETS

CONTROLLER CABINET

PLOTTED/REVISED: 4/29/2014

DISTRICT #: METRO
I/PLOT NAME: WIRING
PATH & FILENAME: IP_PWP-0709107-20933R_SGL.dgn

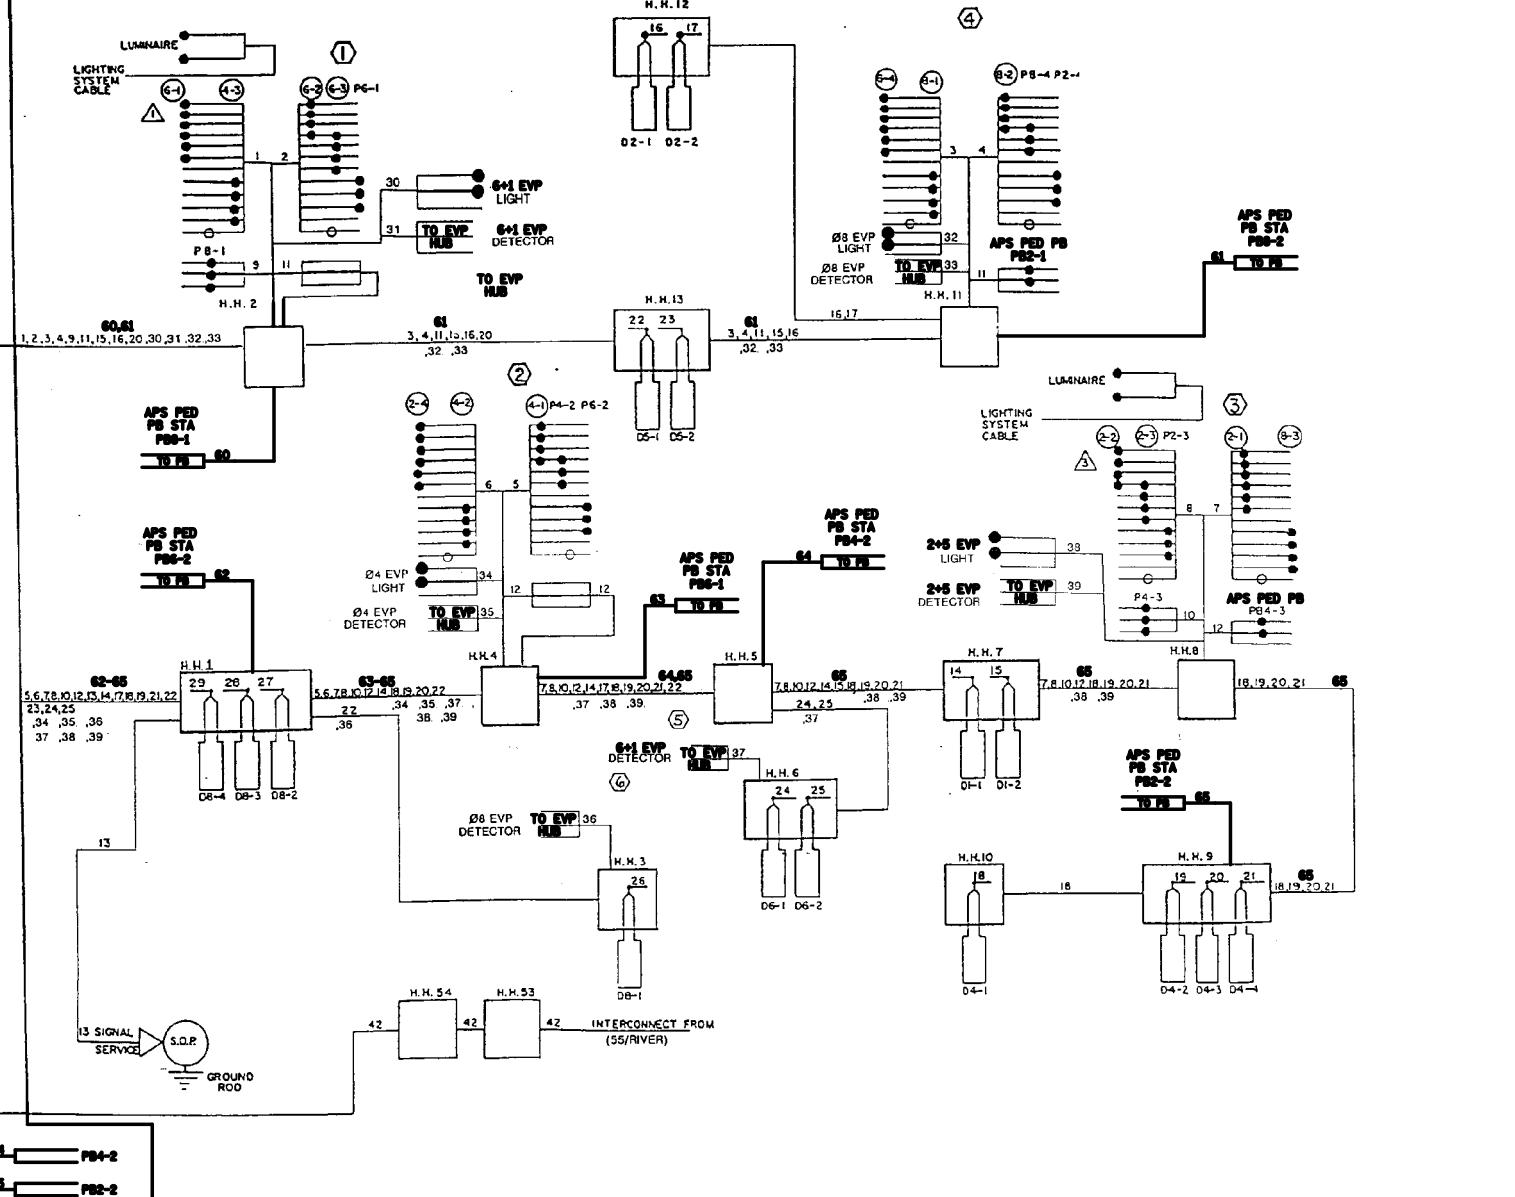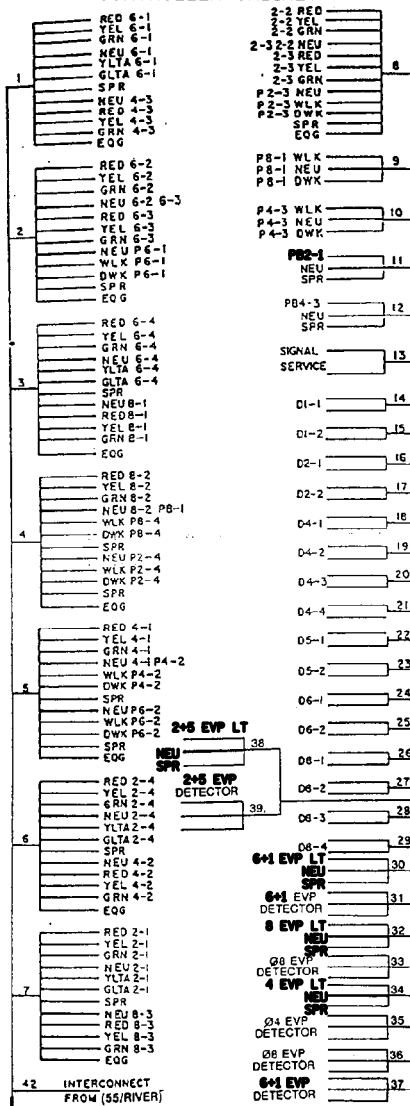

BY	DATE	REVISIONS
EJA	04-29-14	AS-BUILT OF SP 8825-445 (APS & CD PEDS)



SYSTEM ID: 20933	T. E. 5823
METER ADDRESS:	
MASTER ID:	T. E.

FIELD WIRING DIAGRAM
T.H. 55 AT PINE STREET
IN HASTINGS, DAKOTA COUNTY

S.A.P. NO.	DRAWN BY: MAS	CKD BY: GAK	DATE: 4-12-13
CERTIFIED BY: _____	LICENSED PROFESSIONAL ENGINEER		L.I.C. NO. 26829 DATE: _____
STATE PROJ. NO.			SHEET NO. 2 OF 2 SHEETS

PLOTTED/REVISED: 30-APR-2013 11:04

DISTRICT #: METRO
 IPLOT NAME: d8825445_55_Pine
 PATH & FILENAME: Projects\DM_R0S\999\8825\445\Design\PlanSheets\d8825445_55_Pine.dgn

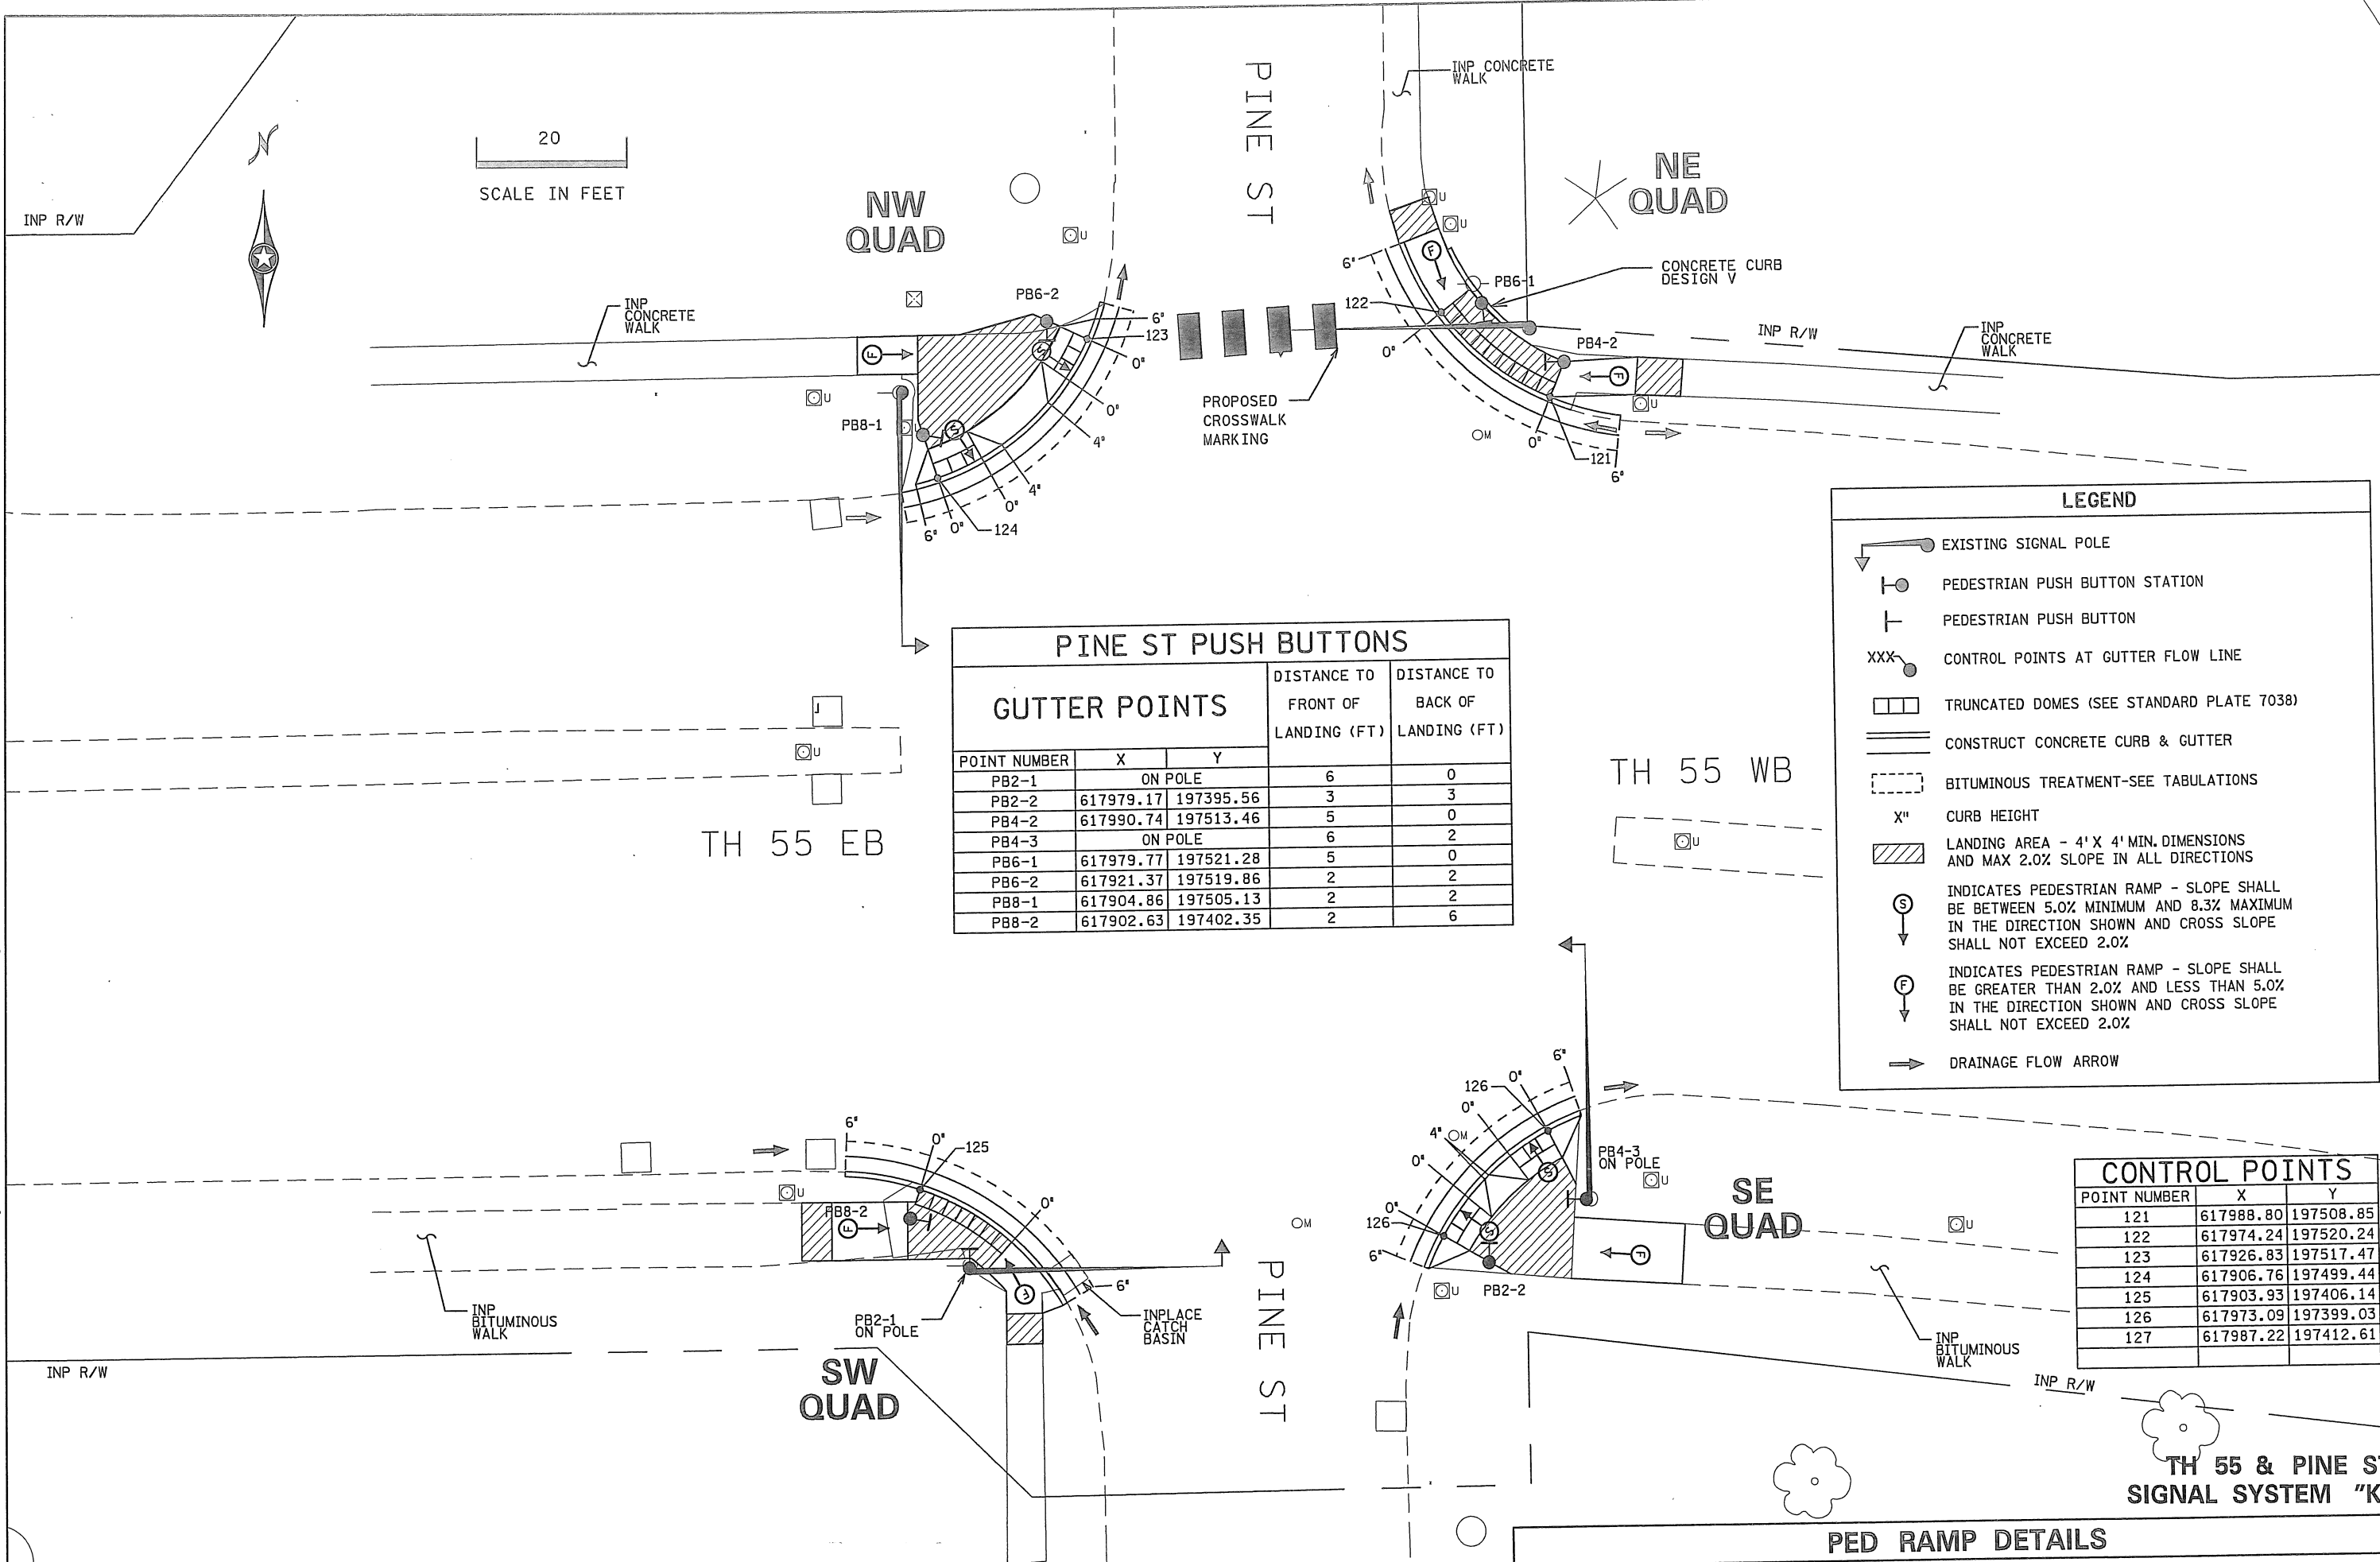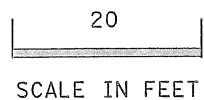

PINE ST PUSH BUTTONS				
GUTTER POINTS			DISTANCE TO FRONT OF LANDING (FT)	DISTANCE TO BACK OF LANDING (FT)
POINT NUMBER	X	Y		
PB2-1	ON POLE		6	0
PB2-2	617979.17	197395.56	3	3
PB4-2	617990.74	197513.46	5	0
PB4-3	ON POLE		6	2
PB6-1	617979.77	197521.28	5	0
PB6-2	617921.37	197519.86	2	2
PB8-1	617904.86	197505.13	2	2
PB8-2	617902.63	197402.35	2	6

LEGEND	
	EXISTING SIGNAL POLE
	PEDESTRIAN PUSH BUTTON STATION
	PEDESTRIAN PUSH BUTTON
	CONTROL POINTS AT GUTTER FLOW LINE
	TRUNCATED DOMES (SEE STANDARD PLATE 7038)
	CONSTRUCT CONCRETE CURB & GUTTER
	BITUMINOUS TREATMENT-SEE TABULATIONS
	X" CURB HEIGHT
	LANDING AREA - 4' X 4' MIN. DIMENSIONS AND MAX 2.0% SLOPE IN ALL DIRECTIONS
	INDICATES PEDESTRIAN RAMP - SLOPE SHALL BE BETWEEN 5.0% MINIMUM AND 8.3% MAXIMUM IN THE DIRECTION SHOWN AND CROSS SLOPE SHALL NOT EXCEED 2.0%
	INDICATES PEDESTRIAN RAMP - SLOPE SHALL BE GREATER THAN 2.0% AND LESS THAN 5.0% IN THE DIRECTION SHOWN AND CROSS SLOPE SHALL NOT EXCEED 2.0%
	DRAINAGE FLOW ARROW

CONTROL POINTS		
POINT NUMBER	X	Y
121	617988.80	197508.85
122	617974.24	197520.24
123	617926.83	197517.47
124	617906.76	197499.44
125	617903.93	197406.14
126	617973.09	197399.03
127	617987.22	197412.61

PED RAMP DETAILS

TH 55 & PINE ST SIGNAL SYSTEM "K"