

PLOTTED/REVISED: 6-APR-2023



DISTRICT #: Metro  
 IPLOT NAME: Street\_67  
 FILENAME: Projects\DM\_FOS\494\000\Traffic\Signals\4.0 TH494 @ TH149-DODD RD S RAMP 1735855\REVENDING\T2T24\_sgl.dgn

LOOP DETECTOR CHART		
NUMBER	SIZE (FT)	LOCATION
D1-1	2-6x6	20 & 50
D1-2	2-6x6	5 & 35
D2-1,D2-2	6x6	400
D6-1,D6-2	6x6	400
D8-1,D8-2	6x6	120
D8-3	6x6	5
D8-4,D8-5	2-6x6	10 & 30

-ALL LOOP DETECTORS SHALL BE PVC UNLESS NOTED OTHERWISE  
 -LOCATION: DISTANCE FROM CROSSWALK/STOP BAR IN FEET

SIGNAL HEAD CHART					
FACE	R	Y	FYA	G	
1-1,1-2	←	←	←	←	
2-1,2-2,2-3	○	○			○
6-1,6-2,6-3	○	○			○
8-1	○	○			○
8-2,8-3,8-4	○	←			←

-ALL SIGNAL INDICATIONS ARE 12" LED  
 -ALL SIGNAL HEADS ARE BLACK POLYCARBONITE WITH BACKGROUND SHIELDS  
 -FYA DENOTES FLASHING YELLOW ARROW

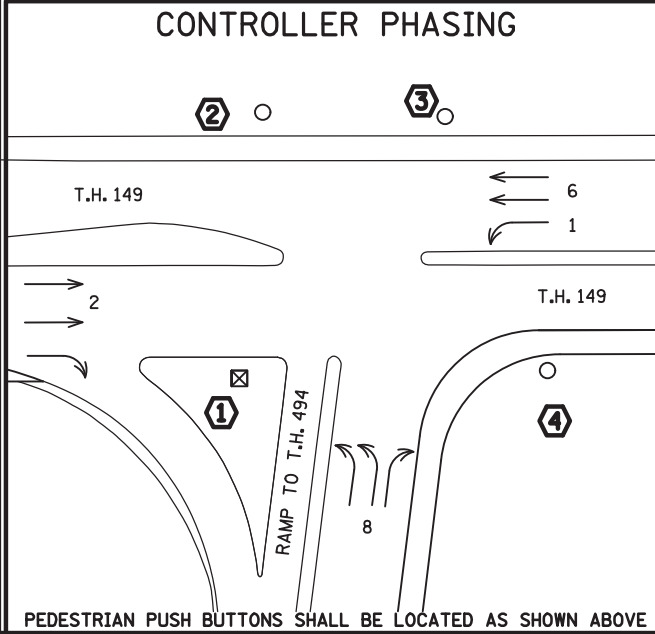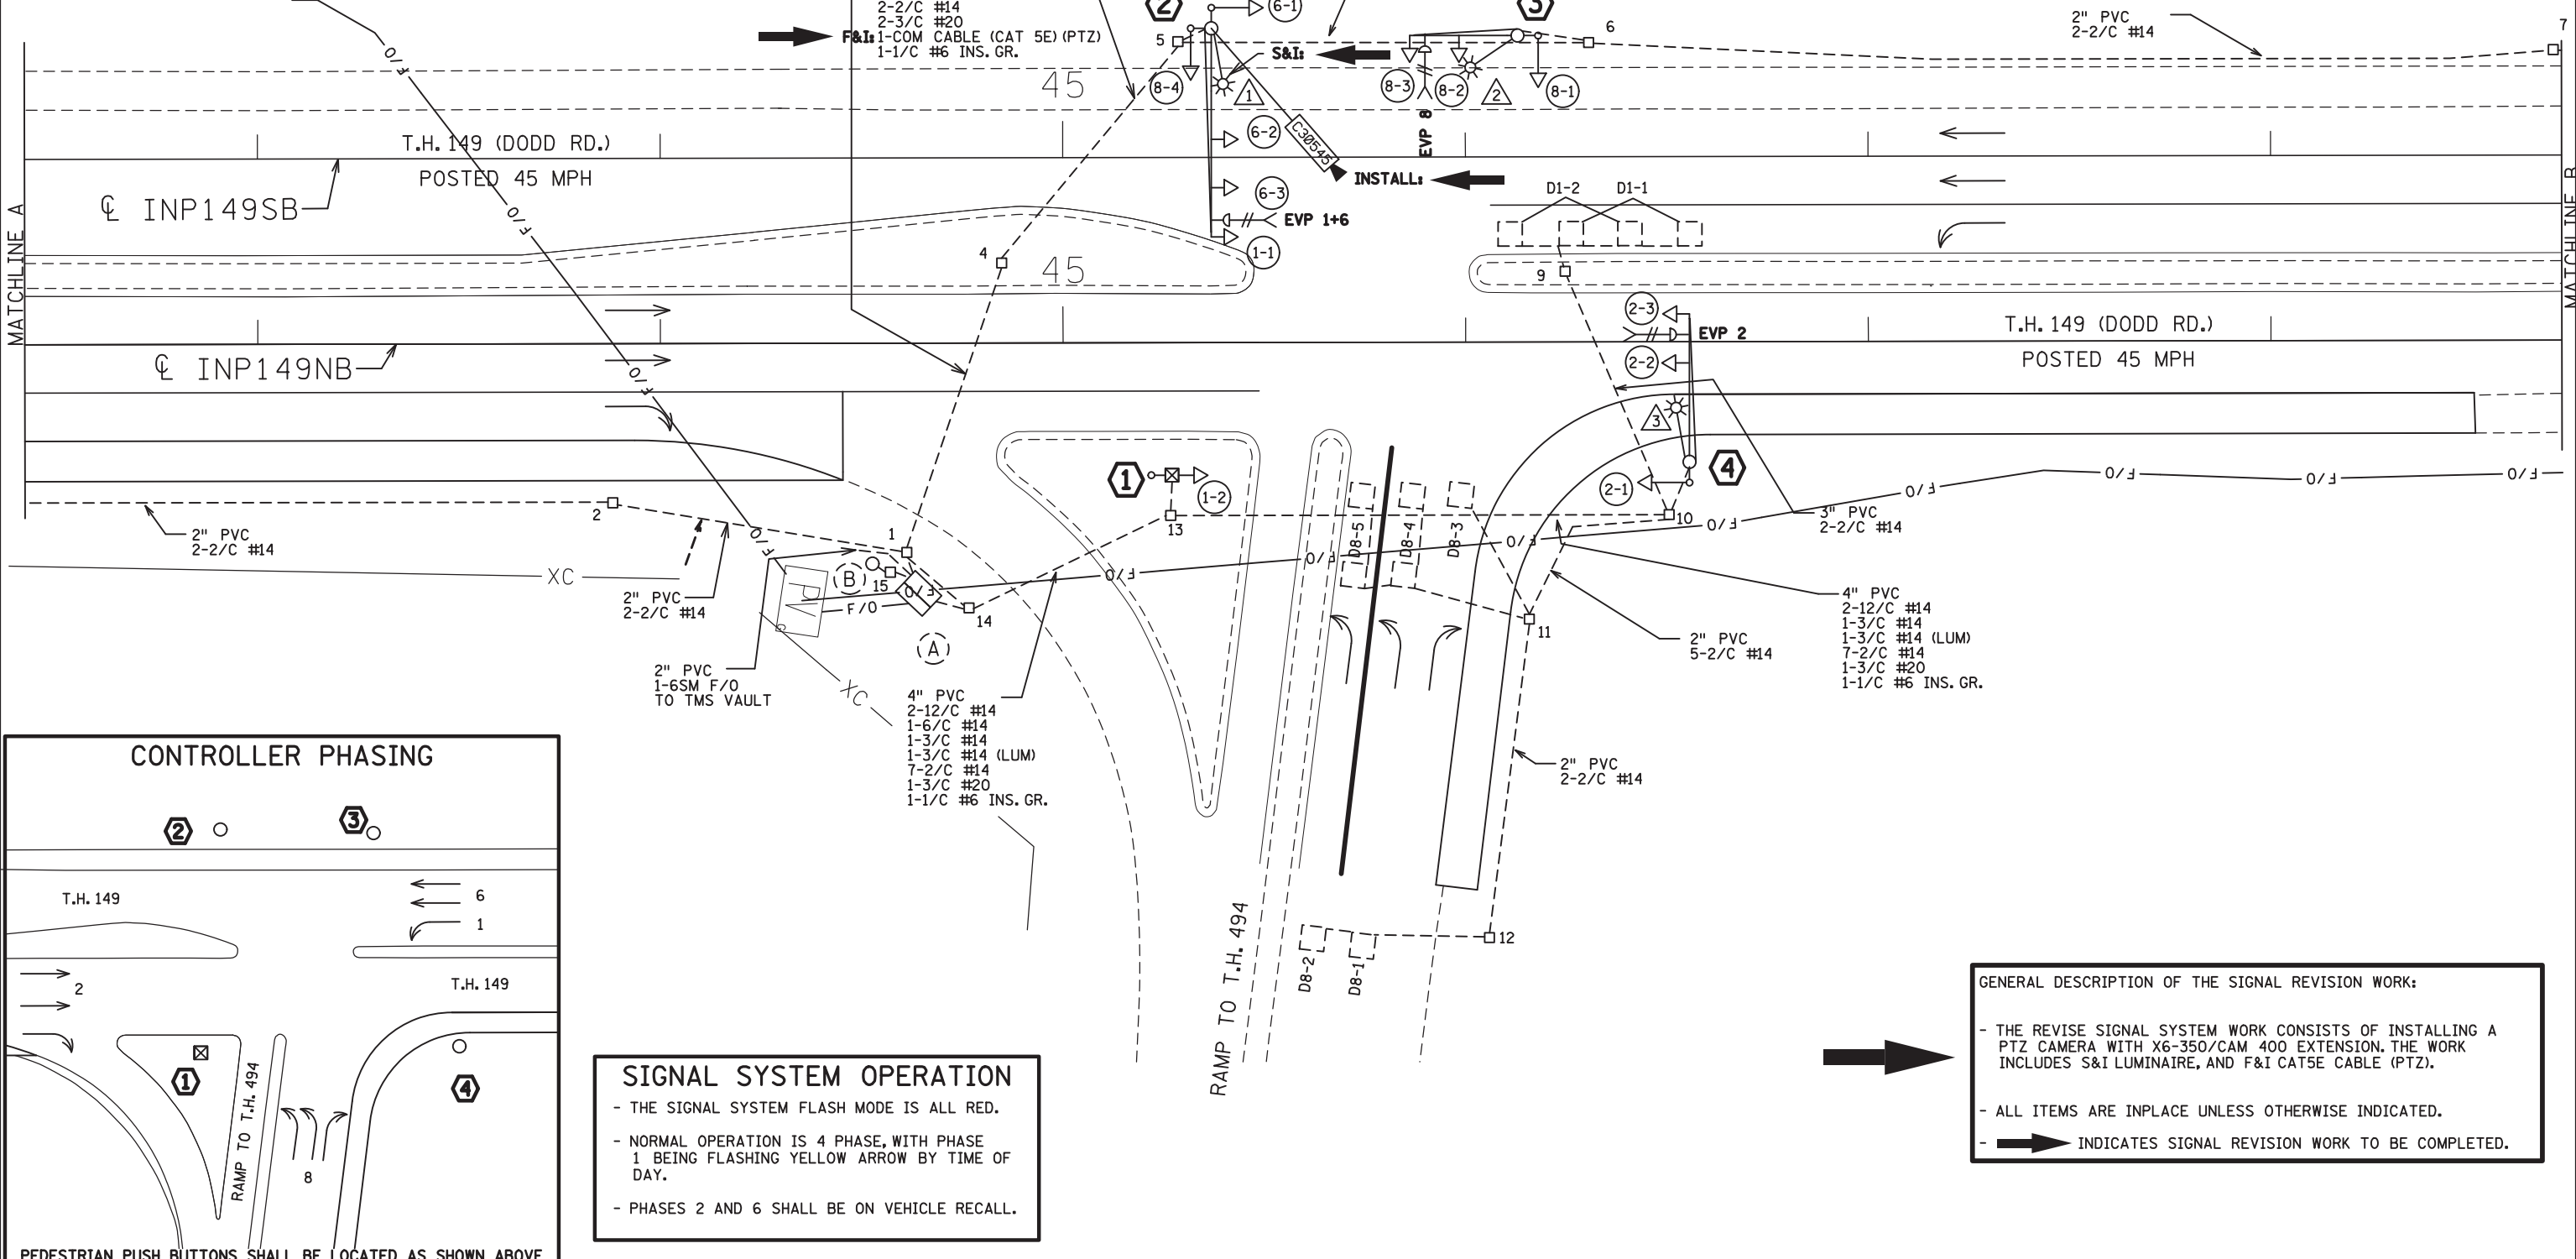

### SIGNAL SYSTEM OPERATION

- THE SIGNAL SYSTEM FLASH MODE IS ALL RED.
- NORMAL OPERATION IS 4 PHASE, WITH PHASE 1 BEING FLASHING YELLOW ARROW BY TIME OF DAY.
- PHASES 2 AND 6 SHALL BE ON VEHICLE RECALL.



### GENERAL DESCRIPTION OF THE SIGNAL REVISION WORK:

- THE REVISION SIGNAL SYSTEM WORK CONSISTS OF INSTALLING A PTZ CAMERA WITH X6-350/CAM 400 EXTENSION. THE WORK INCLUDES S&I LUMINAIRE, AND F&I CAT5E CABLE (PTZ).
- ALL ITEMS ARE IN PLACE UNLESS OTHERWISE INDICATED.
- INDICATES SIGNAL REVISION WORK TO BE COMPLETED.

BY	DATE	REVISIONS	SYSTEM ID: 1735857	T.E. 92835	S.A.P. NO.	DRAWN BY: HRL	CKD BY: CDB	DATE: 03/31/23
			METER ADDRESS: 2580 DODD RD.		CERTIFIED BY:	LIC. NO. 26829		DATE: 04/04/23
			OLD SYSTEM ID: 21724		STATE PROJ. NO. 8825-1025 (T.H. 999) SHEET NO. 67 OF 121 SHEETS			

PLOTTED/REVISED: 6-APR-2023

DISTRICT \*: Metro  
 IPLOT NAME: Street\_68  
 FILENAME: Projects\DM\_FOSV49\A0000\Traffic\Signals\4.0 TH494 @ TH149-DODD RD S RAMP 1735857\REVISING\T2T24\_sgl.dgn

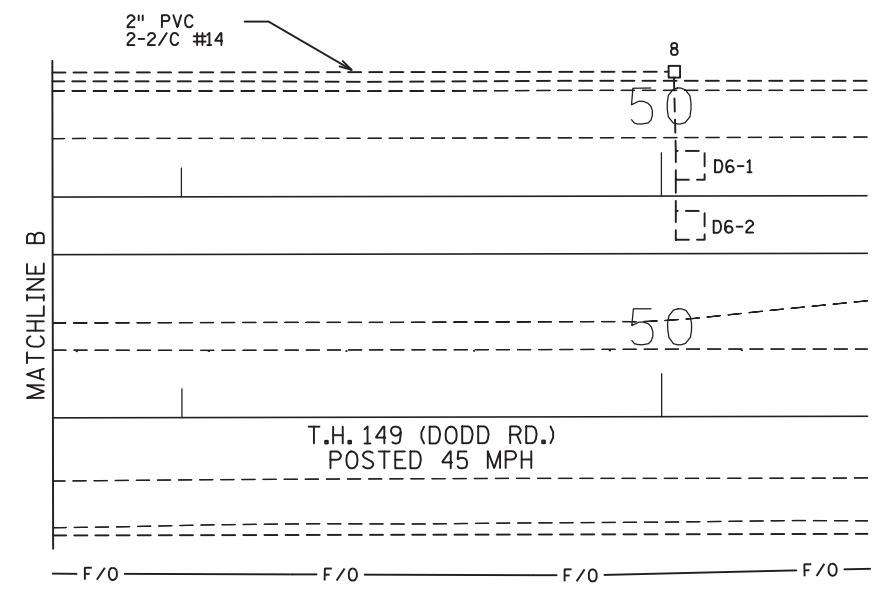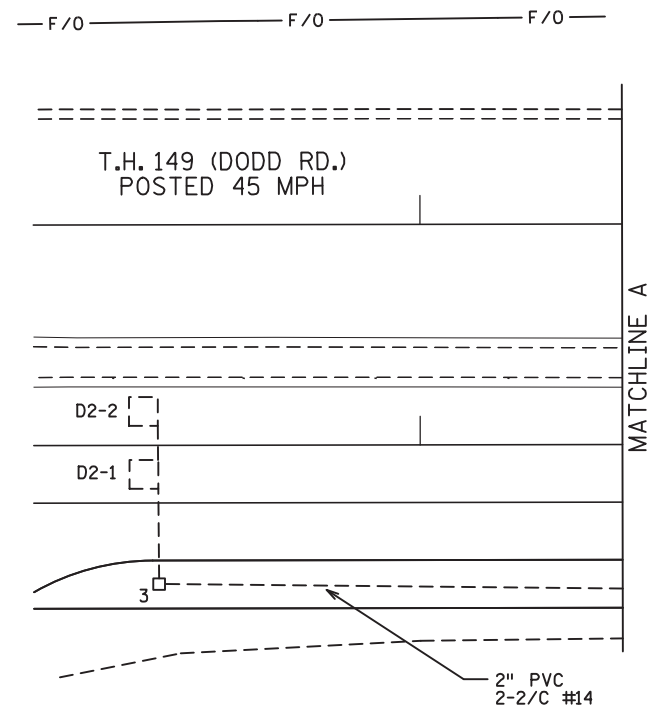

- 2** INP149NB STA. 45+37.0, 78.0' (LEFT)  
 PA100 POLE FOUNDATION  
 TYPE PA100-A-50  
**SALVAGE:** 1-D40-9 (DAVIT AT 350 DEG)  
**INSTALL:** 1-X6-350/CAM 400 EXTENSION (STATE FURNISHED) (MOUNTED AT 350 DEG) (INCLUDES LIGHTNING ROD, 7/16" GROUND BRAID AND GROUND ROD)  
 1-PTZ VIDEO CAMERA C30545 (STATE FURNISHED) (A 3/4" THREADED HALF COUPLING (FOR EVP MOUNTING), SHALL BE F&I 4.5' FROM THE END OF THE MAST ARM)  
 1-ANGLE MOUNT SIGNAL OVERHEAD AT 0'  
 2-STRAIGHT MOUNT SIGNAL OVERHEAD AT 11' AND 23'  
 2-ANGLE MOUNT SIGNALS AT 90 AND 180 DEG  
 1-ONE WAY EVP DETECTOR AND CONFIRMATORY LIGHT (PHASES 6+1)  
**S&I:** LUMINAIRE-LED  
 1-R10-X12 SIGN ADJACENT TO HEAD (1-1)  
 1-R9-3α SIGN (NO PED) FACING POLE 1  
 1-TYPE D SIGN (D-1)  
 3" PVC TO HH 5:  
 2-12/C #14  
 1-6/C #14  
 1-3/C #14  
 1-3/C #14 (LUM)  
 1-3/C #20  
**F&I:** 1-COM CABLE (CAT 5E) (PTZ)  
 1-1/C #6 INS. GR.

- 3** INP149NB STA. 46+13.0, 76.1' (LEFT)  
 PA85 POLE FOUNDATION  
 TYPE PA85-A-25-D40-9 (DAVIT AT 350 DEG)  
 (A 3/4" THREADED HALF COUPLING (FOR EVP MOUNTING), SHALL BE F&I 8.5' FROM THE END OF THE MAST ARM)  
 1-ANGLE MOUNT SIGNAL OVERHEAD AT 0'  
 1-STRAIGHT MOUNT SIGNAL OVERHEAD AT 11'  
 1-ANGLE MOUNT SIGNAL AT 180 DEG  
 1-ONE WAY EVP DETECTOR AND CONFIRMATORY LIGHT (PHASE 8)  
 LUMINAIRE-LED  
 1-R9-3α SIGN (NO PED) FACING POLE 4  
 2-TYPE D SIGNS (D-2) & (D-5)  
 3" PVC TO HH 6:  
 2-12/C #14  
 1-3/C #14  
 1-3/C #14 (LUM)  
 1-3/C #20  
 1-1/C #6 INS. GR.

- 4** INP149NB STA. 46+55.5, 29.8' (RIGHT)  
 PA90 POLE FOUNDATION  
 TYPE PA90-A-35-D40-9 (DAVIT AT 350 DEG)  
 1-ANGLE MOUNT SIGNAL OVERHEAD AT 0'  
 1-STRAIGHT MOUNT SIGNAL OVERHEAD AT 11'  
 1-ANGLE MOUNT SIGNAL AT 180 DEG  
 1-ONE WAY EVP DETECTOR AND CONFIRMATORY LIGHT (PHASE 2)  
 LUMINAIRE-LED  
 2-R9-3α SIGNS (NO PED) FACING POLES 1 AND 3  
 2-TYPE D SIGNS (D-3) & (D-4)  
 3" PVC TO HH 10:  
 2-12/C #14  
 1-3/C #14  
 1-3/C #14 (LUM)  
 1-3/C #20  
 1-1/C #6 INS. GR.

- (A)** EQUIPMENT PAD (SEE DETAIL SHEET)  
 SERVICE CABINET (SSB)  
 SIGNAL CABINET AND CONTROLLER  
 4" PVC TO HH 1:  
 4-12/C #14  
 1-6/C #14  
 2-3/C #14  
 4-2/C #14  
 2-3/C #20  
**F&I:** 1-COM CABLE (CAT 5E) (PTZ)  
 1-1/C #6 INS. GR.  
 4" PVC TO HH 14:  
 2-12/C #14  
 1-6/C #14  
 1-3/C #14  
 7-2/C #14  
 1-3/C #20  
 1-1/C #6 INS. GR.  
 SERVICE CABINET TO POLE MOUNTED TRANSFORMER:  
 2" PVC  
 3-1/C #2  
 SERVICE CABINET TO HH 1:  
 2" PVC  
 3-3/C #14 (LUM)  
 HH 1 TO HH 14:  
 2" PVC  
 1-3/C #14 (LUM)

**GENERAL DESCRIPTION OF THE SIGNAL REVISION WORK:**

- THE REVISE SIGNAL SYSTEM WORK CONSISTS OF INSTALLING A PTZ CAMERA WITH X6-350/CAM 400 EXTENSION. THE WORK INCLUDES S&I LUMINAIRE, AND F&I CAT5E CABLE (PTZ).
- ALL ITEMS ARE INPLACE UNLESS OTHERWISE INDICATED.
- **➔** INDICATES SIGNAL REVISION WORK TO BE COMPLETED.

SOP  
 WOOD POLE  
 EXTEND INTO HH 15:  
 2" PVC AND WEATHERHEAD  
 WITH 3-1/C #2


BY	DATE	REVISIONS	SYSTEM ID: 1735857	T.E. 92835	S.A.P. NO.	DRAWN BY: HRL	CKD BY: CDB	DATE: 03/31/23
			METER ADDRESS: 2580 DODD RD.		CERTIFIED BY: <i>Gregory Kern</i>	LIC. NO. 26829		DATE: 04/04/23
			OLD SYSTEM ID: 21724		STATE PROJ. NO. 8825-1025 (T.H. 999) SHEET NO. 68 OF 121 SHEETS			

**REVISE SIGNAL SYSTEM "S"  
 MATCHLINE AND POLE NOTES  
 T.H. 494 AT T.H. 149 (DODD RD.) SOUTH RAMP  
 IN EAGAN, DAKOTA COUNTY**

PLOTTED/REVISED: 6-APR-2023


DISTRICT \*: Metro  
PLOT NAME: Sheet\_69  
FILENAME: Projects\DM\_FOS\4940000\Traffic\Signals\4.0 T.H.494 @ T.H.149-DODD RD S RAMP (735855)\PENDING\T21724\_sgl.dgn

### CONTROLLER CABINET

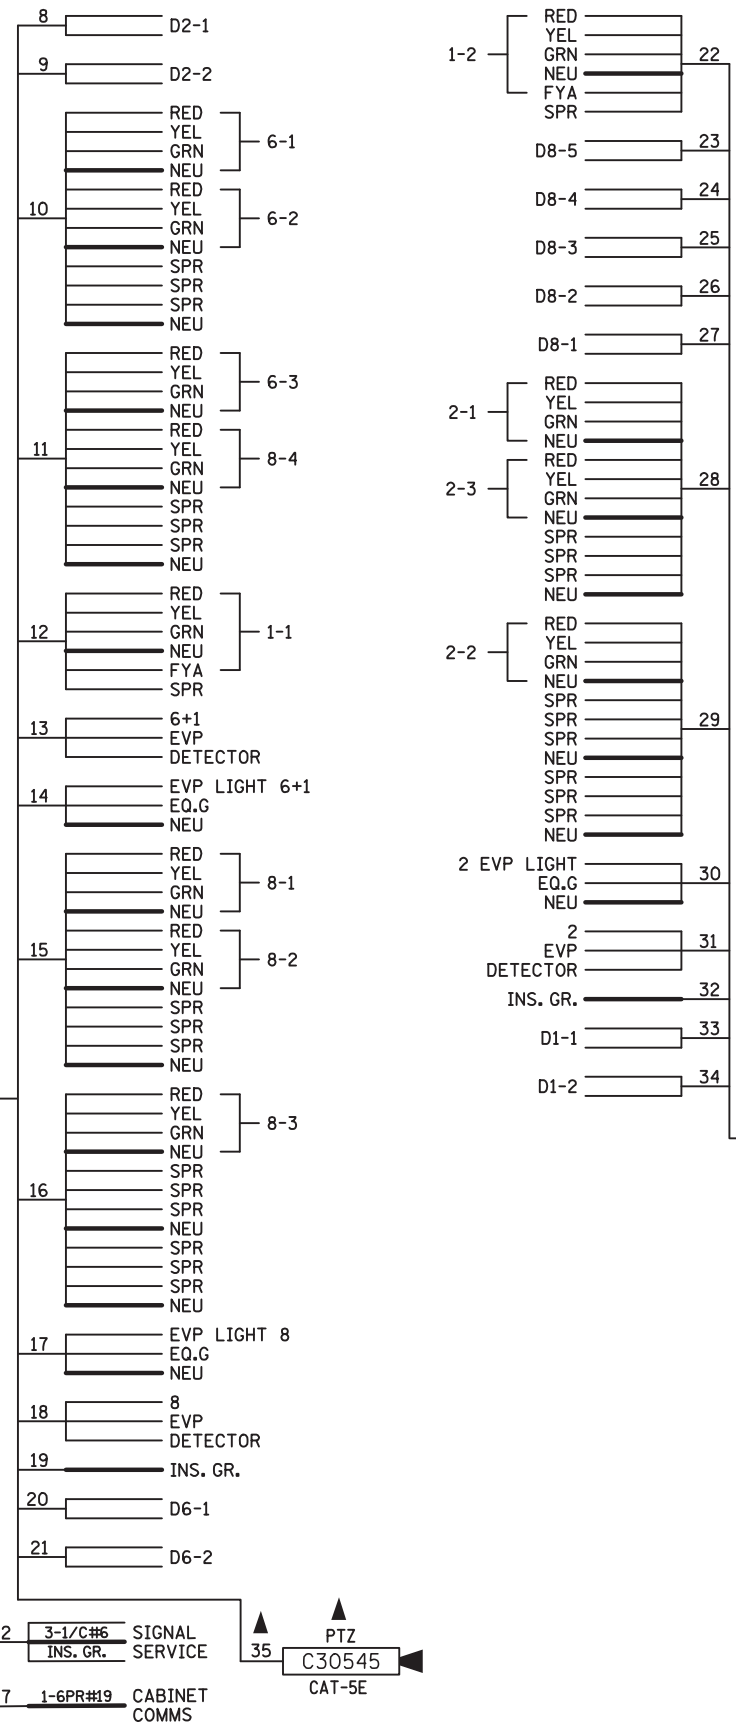

- NOTES:**  
 1. LUMINAIRES ARE METERED.  
 2. SIGNAL SYSTEM INCLUDES BATTERY- BACKUP SERVICE CABINET (NO BATTERIES).  
 3. FOR CONDUCTOR COLOR CODE SEE TRAFFIC SIGNAL POLE WIRING CONNECTOR DETAIL.

▲ DENOTES REVISE SIGNAL SYSTEM PAY ITEM WORK. ALL OTHER ITEMS SHOWN ARE INPLACE.

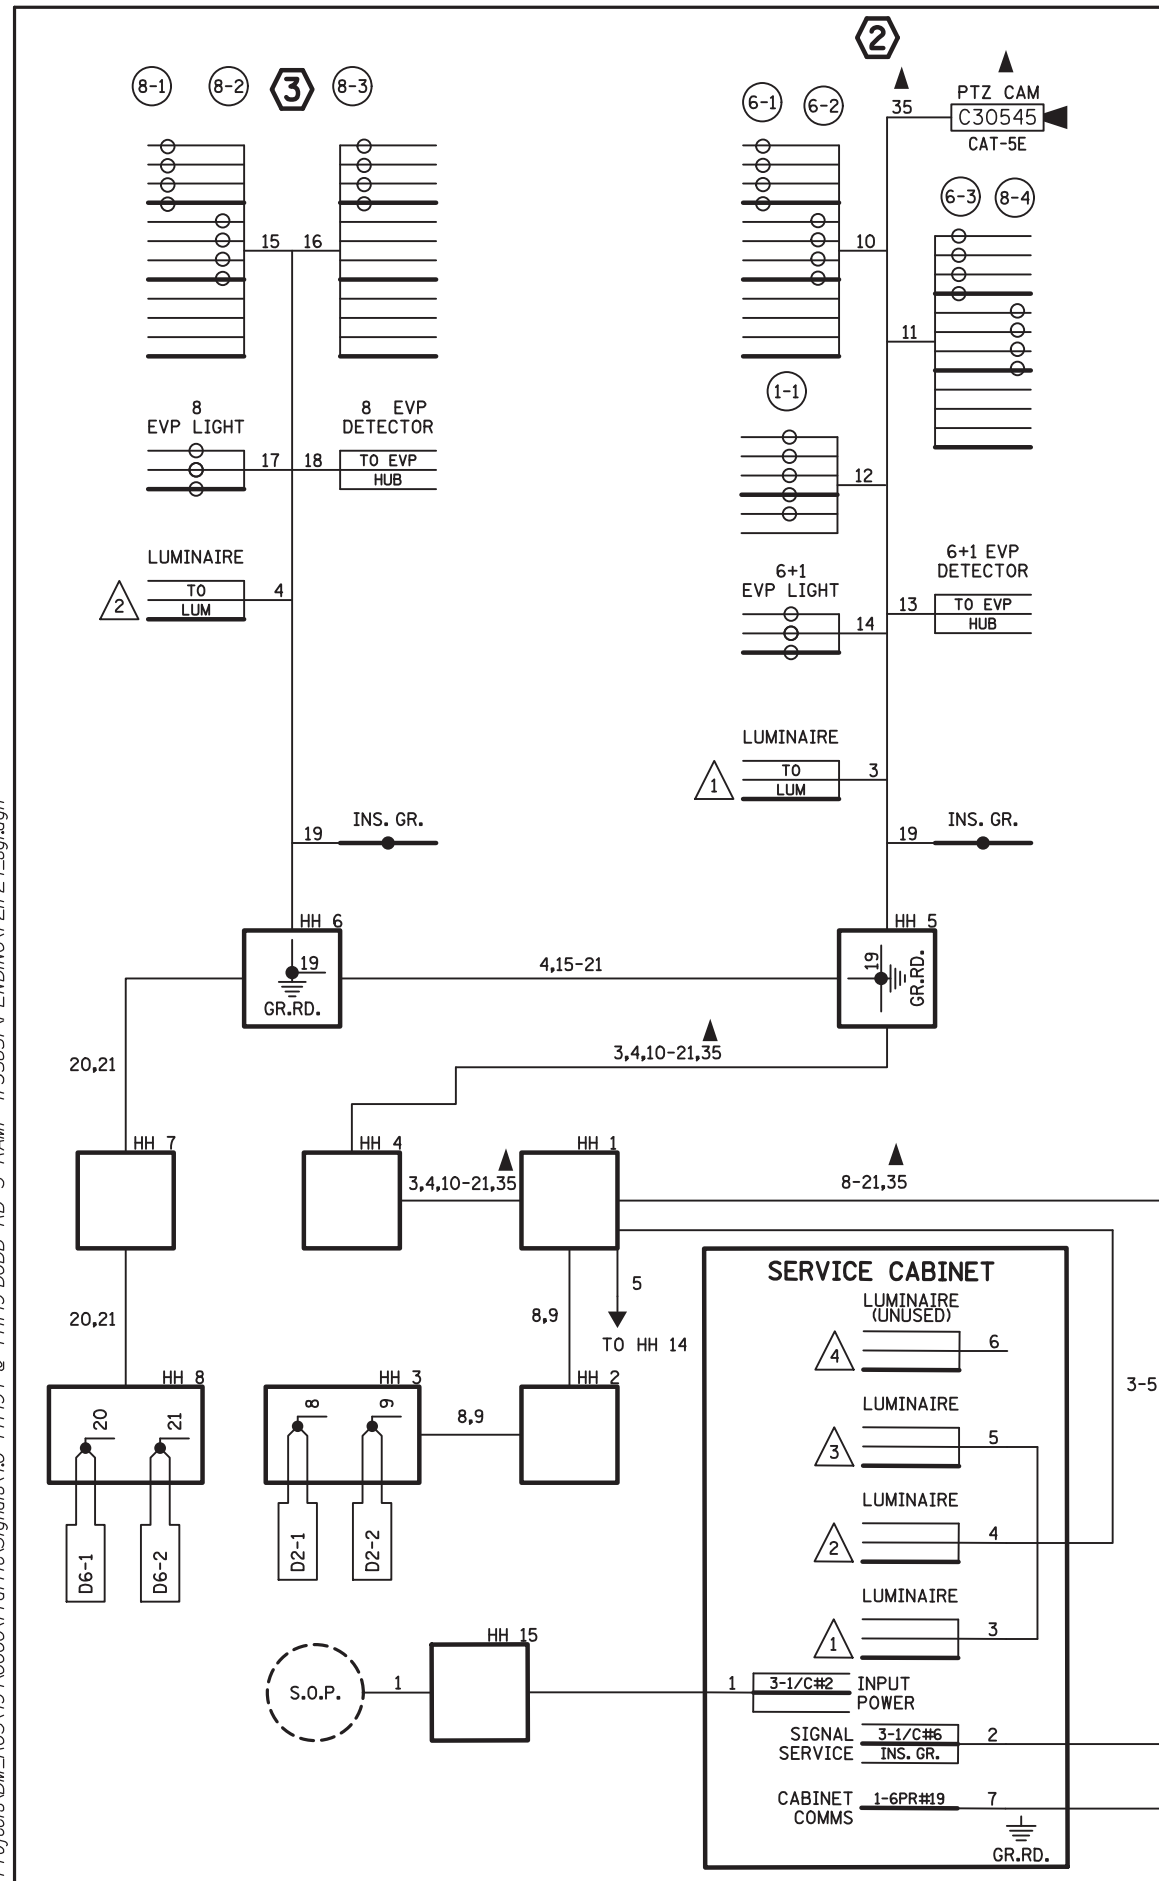

BY	DATE	REVISIONS

SYSTEM ID: 1735857 T.E. 92835  
 METER ADDRESS: 2580 DODD RD.  
 OLD SYSTEM ID: 21724

**REVISE SIGNAL SYSTEM "S"  
 FIELD WIRING DIAGRAM  
 T.H. 494 AT T.H. 149 (DODD RD.) SOUTH RAMP  
 IN EAGAN, DAKOTA COUNTY**

S.A.P. NO. \_\_\_\_\_ DRAWN BY:HRL CKD BY:CDB DATE:03/31/23  
 CERTIFIED BY *Gregory Kern* LIC. NO. 26829 DATE: 04/04/23  
 STATE PROJ.NO. 8825-1025(T.H.999) SHEET NO. 69 OF 121 SHEETS

LOOP DETECTOR CHART		
NUMBER	SIZE (FT)	LOCATION
D1-1	2-6x6	20 & 50
D1-2	2-6x6	5 & 35
D2-1,D2-2	6x6	400
D6-1,D6-2	6x6	400
D8-1,D8-2	6x6	120
D8-3	6x6	5
D8-4,D8-5	2-6x6	10 & 30

-ALL LOOP DETECTORS SHALL BE PVC UNLESS NOTED OTHERWISE  
-LOCATION: DISTANCE FROM CROSSWALK/STOP BAR IN FEET



SIGNAL HEAD CHART					
FACE	R	Y	FYA	G	
1-1,1-2	←	←	←	←	
2-1,2-2,2-3	○	○		○	
6-1,6-2,6-3	○	○		○	
8-1	○	○		○	
8-2,8-3,8-4	○	←		←	

-ALL SIGNAL INDICATIONS ARE 12" LED  
-ALL SIGNAL HEADS ARE BLACK POLYCARBONITE WITH BACKGROUND SHIELDS  
-FYA DENOTES FLASHING YELLOW ARROW

PLOTTED/REVISED: 6/23/2015

MATCHLINE A

DISTRICT #: METRO  
IPLOT NAME: layout  
PATH & FILENAME: IP\_PWP-d07823\3\T21724\_sgl.dgn

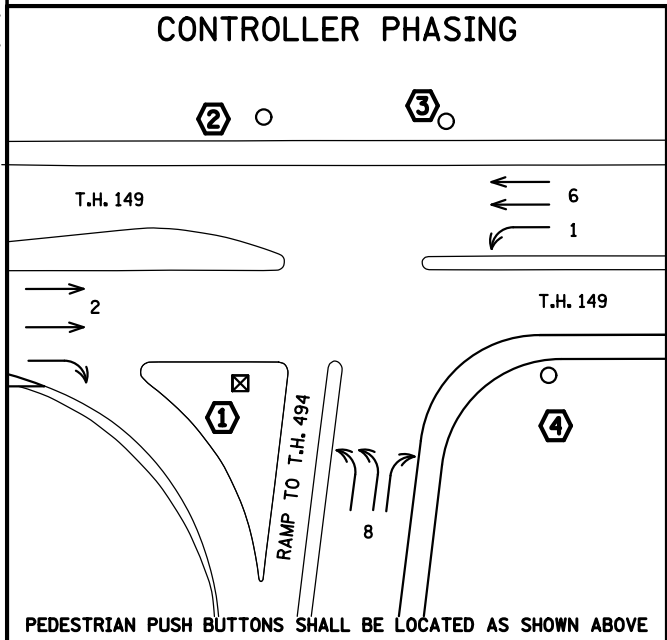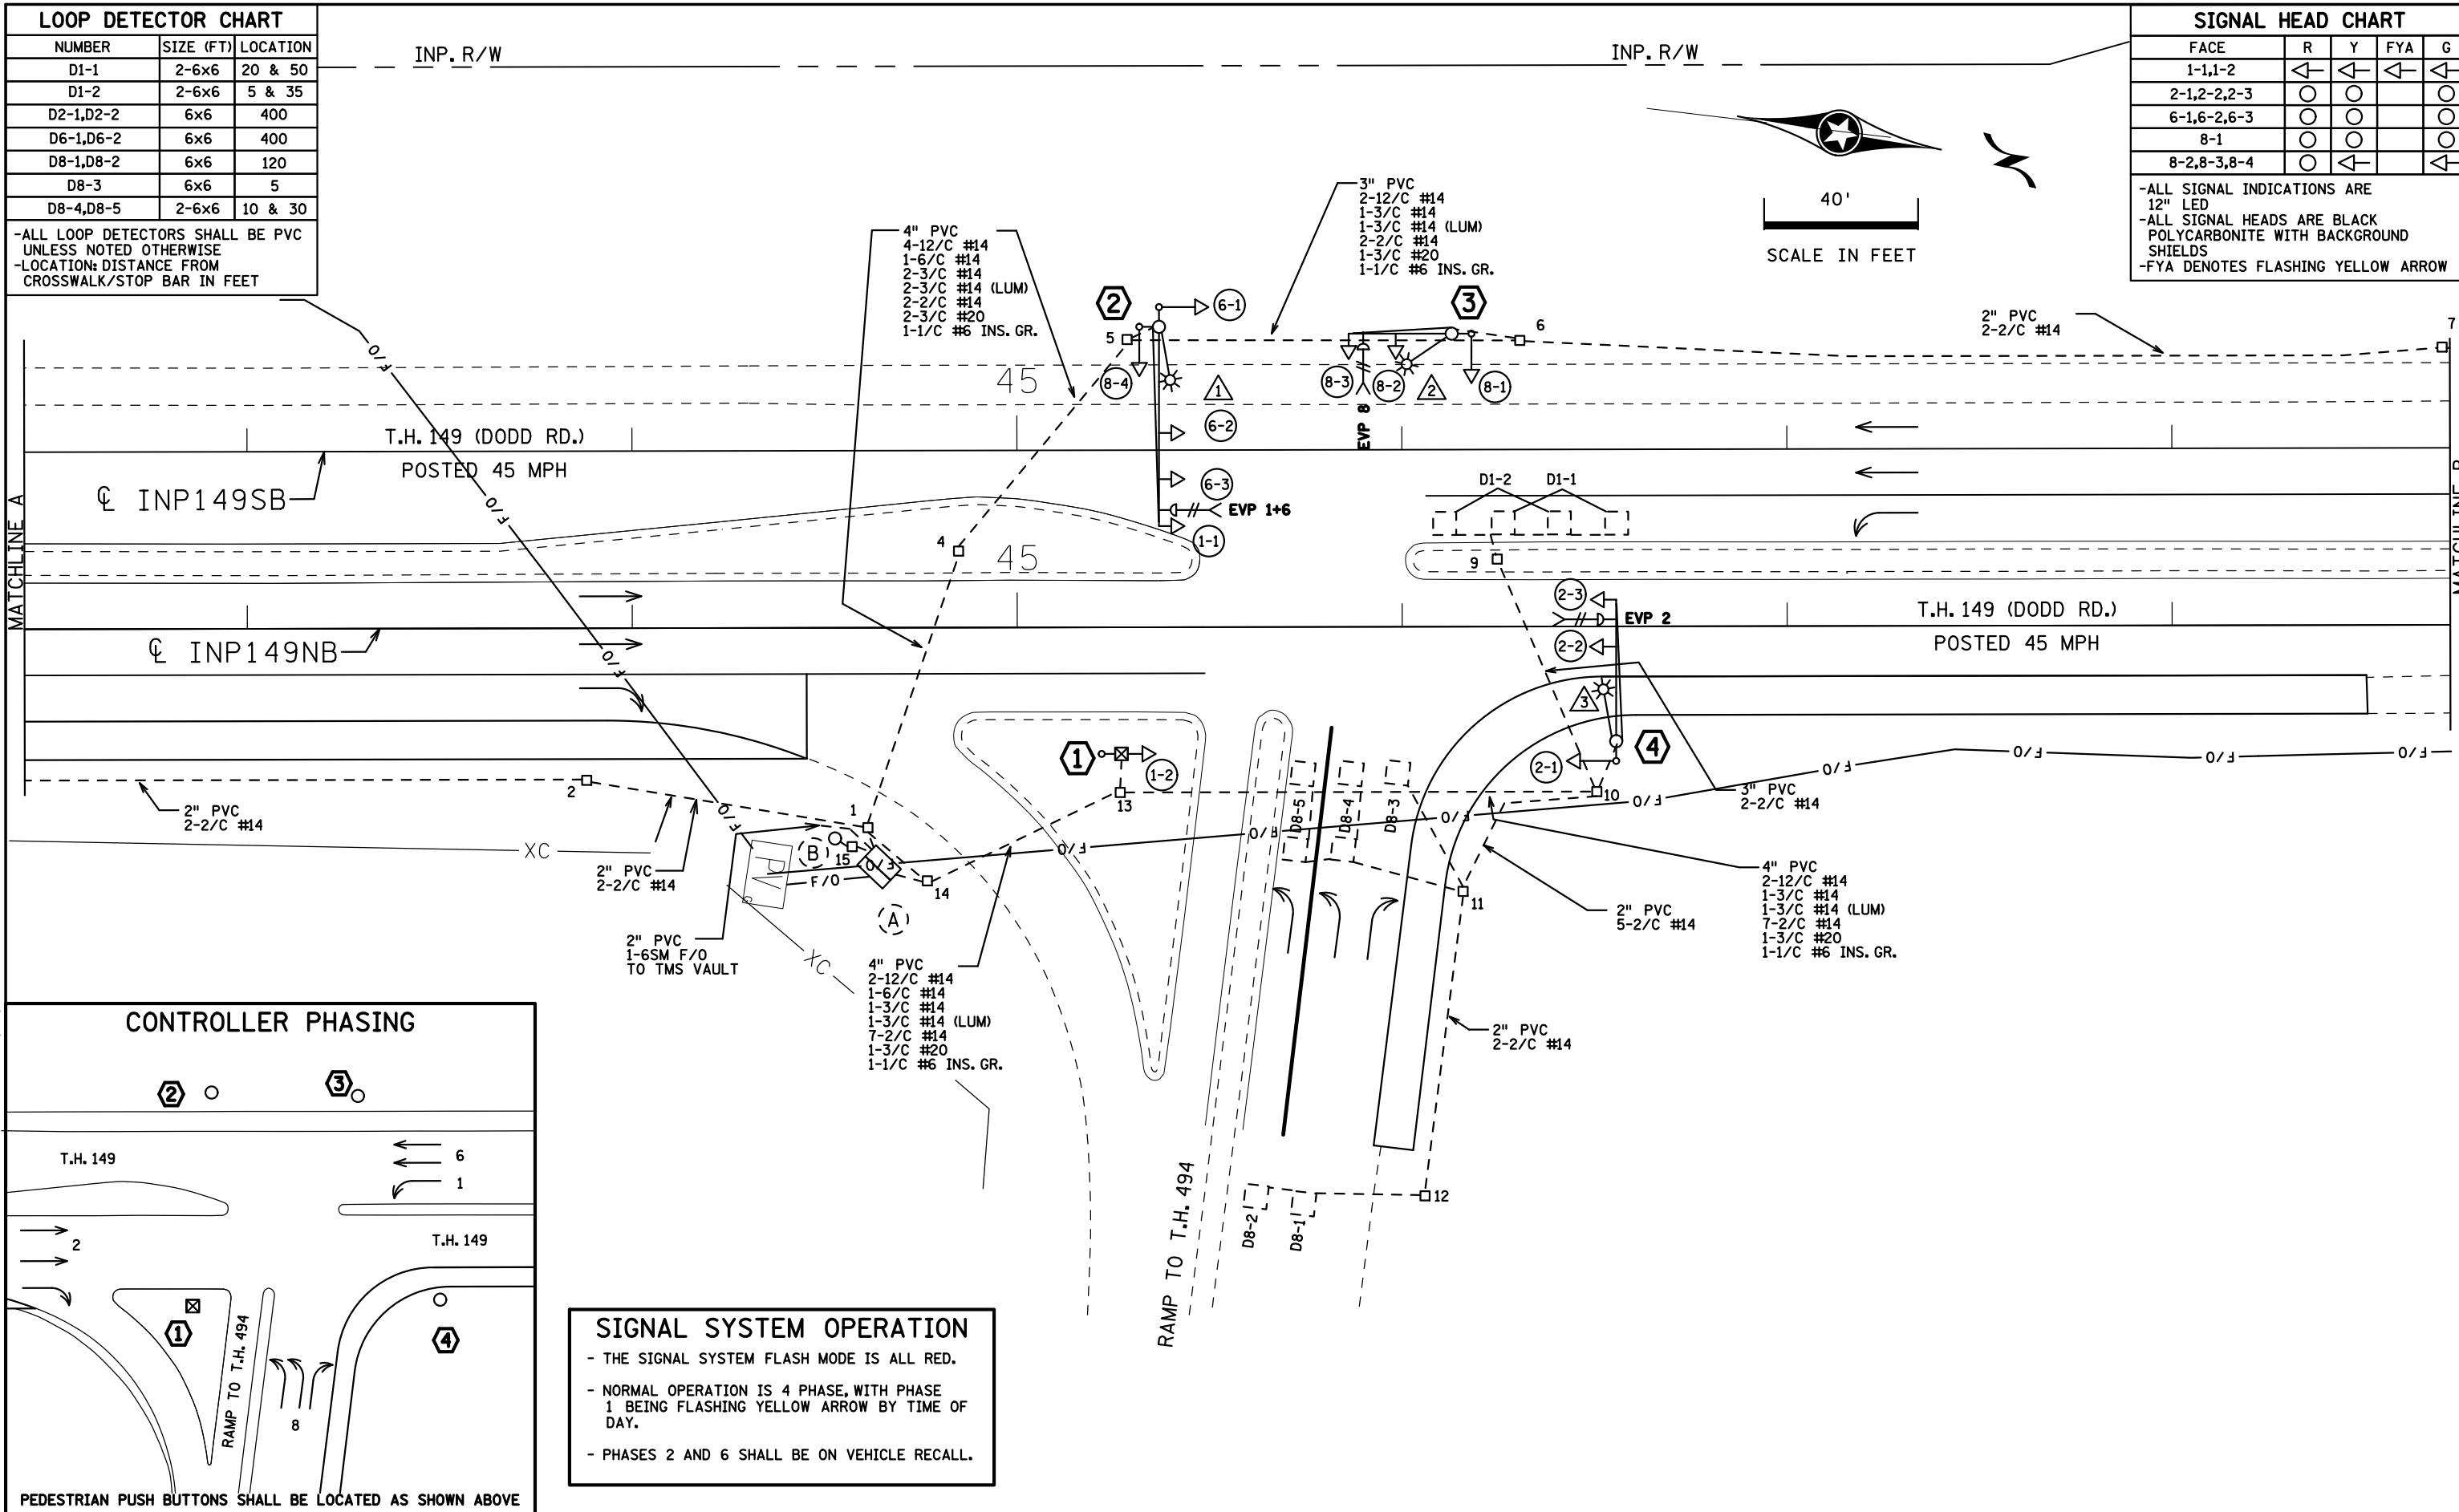

### SIGNAL SYSTEM OPERATION




- THE SIGNAL SYSTEM FLASH MODE IS ALL RED.
- NORMAL OPERATION IS 4 PHASE, WITH PHASE 1 BEING FLASHING YELLOW ARROW BY TIME OF DAY.
- PHASES 2 AND 6 SHALL BE ON VEHICLE RECALL.

BY	DATE	REVISIONS
EJA	12-11-14	AS-BUILT OF SP 1917-44

SYSTEM ID: 21724 T.E. 5945  
METER ADDRESS: 2580 DODD RD.  
MASTER ID: T.E.

**INTERSECTION LAYOUT**  
T.H. 494 AT T.H. 149 (DODD RD.) SOUTH RAMP  
IN EAGAN, DAKOTA COUNTY

DRAWN BY: BAM CKD BY: CDB DATE: 12/20/13  
CERTIFIED BY: *Michael P. Gelinsky* L.C. NO. 19863 DATE: 12/20/13  
(T.H. 494) SHEET NO. 1 OF 4 SHEETS

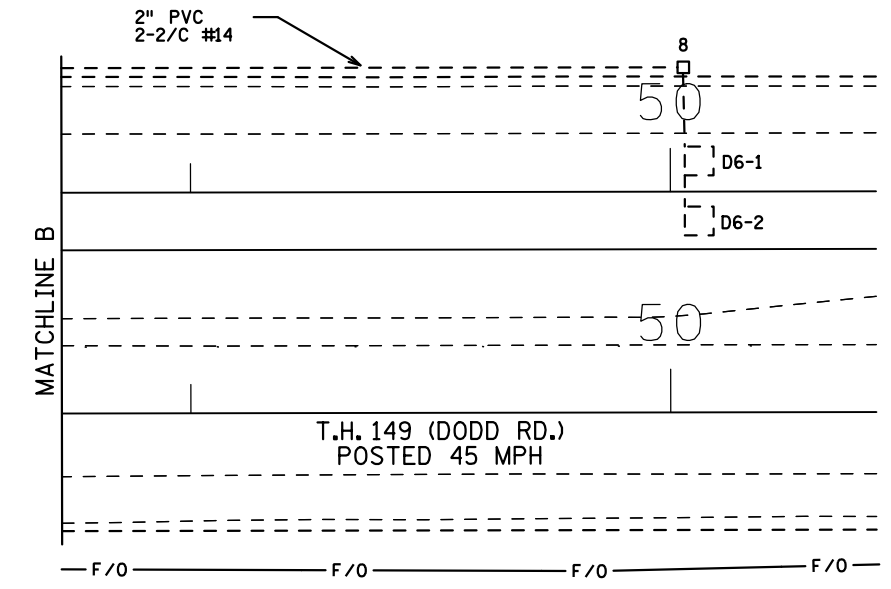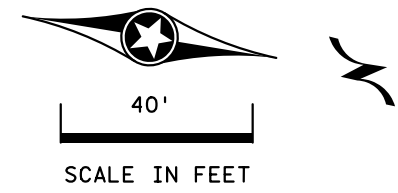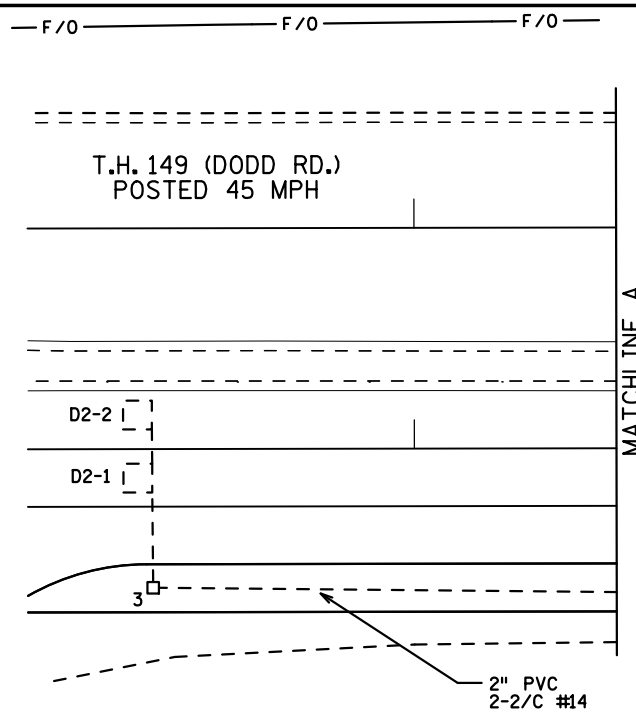

- ② INP149NB STA. 45+37.0, 78.0' (LEFT)  
PA100 POLE FOUNDATION  
TYPE PA100-A-50-D40-9 (DAVIT AT 350 DEG)  
① (A 3/4" THREADED HALF COUPLING (FOR EVP MOUNTING), SHALL BE F&I 4.5' FROM THE END OF THE MAST ARM)  
1-ANGLE MOUNT SIGNAL OVERHEAD AT 0'  
2-STRAIGHT MOUNT SIGNAL OVERHEAD AT 11' AND 23'  
2-ANGLE MOUNT SIGNALS AT 90 AND 180 DEG  
1-ONE WAY EVP DETECTOR AND CONFIRMATORY LIGHT (PHASES 6+1)  
LUMINAIRE-LED  
1-R10-X12 SIGN ADJACENT TO HEAD (1-1)  
1-R9-3α SIGN (NO PED) FACING POLE 1  
1-TYPE D SIGN (D-1)  
3" PVC TO HH 5:  
2-12/C #14  
1-6/C #14  
1-3/C #14  
1-3/C #14 (LUM)  
1-3/C #20  
1-1/C #6 INS. GR.

- ③ INP149NB STA. 46+13.0, 76.1' (LEFT)  
PA85 POLE FOUNDATION  
TYPE PA85-A-25-D40-9 (DAVIT AT 350 DEG)  
① (A 3/4" THREADED HALF COUPLING (FOR EVP MOUNTING), SHALL BE F&I 8.5' FROM THE END OF THE MAST ARM)  
1-ANGLE MOUNT SIGNAL OVERHEAD AT 0'  
1-STRAIGHT MOUNT SIGNAL OVERHEAD AT 11'  
1-ANGLE MOUNT SIGNAL AT 180 DEG  
1-ONE WAY EVP DETECTOR AND CONFIRMATORY LIGHT (PHASE 8)  
LUMINAIRE-LED  
1-R9-3α SIGN (NO PED) FACING POLE 4  
2-TYPE D SIGNS (D-2) & (D-5)  
3" PVC TO HH 6:  
2-12/C #14  
1-3/C #14  
1-3/C #14 (LUM)  
1-3/C #20  
1-1/C #6 INS. GR.

(A)

EQUIPMENT PAD (SEE DETAIL SHEET)  
SERVICE CABINET (SSB)

SIGNAL CABINET AND CONTROLLER  
4" PVC TO HH 1:  
4-12/C #14  
1-6/C #14  
1-3/C #14  
2-3/C #14  
4-2/C #14  
2-3/C #20  
1-1/C #6 INS. GR.

2-2" AND 1-3" PVC STUBBED OUT (CAPPED BOTH ENDS)  
3/4" PVC STUBBED OUT (FOR TELEPHONE LINE)  
1-2" PVC

CONTROLLER CABINET TO SERVICE CABINET:  
2" PVC  
2-1/C #6  
1-1/C #6 INS. GR.

CONTROLLER CABINET TO SERVICE CABINET (COMMS):  
2" PVC  
1-6PR #19

4" PVC TO HH 14:  
2-12/C #14  
1-6/C #14  
1-3/C #14  
7-2/C #14  
1-3/C #20  
1-1/C #6 INS. GR.

SERVICE CABINET TO POLE MOUNTED TRANSFORMER:  
2" PVC  
3-1/C #2

SERVICE CABINET TO HH 1:  
2" PVC  
3-3/C #14 (LUM)

HH 1 TO HH 14:  
2" PVC  
1-3/C #14 (LUM)

SOP  
WOOD POLE  
EXTEND INTO HH 15:  
2" PVC AND WEATHERHEAD  
WITH 3-1/C #2

- ① INP149NB STA. 45+27.0, 32.9' (RIGHT)  
PEDESTAL FOUNDATION  
TYPE 5A -13' PEDESTAL POLE AND BASE  
(ALL ALUMINUM COMPONENTS)  
1-SIGNAL  
2-R9-3α SIGNS (NO PED) FACING POLES 2 AND 4  
3" PVC TO HH 13:  
1-6/C #14  
1-1/C #6 INS. GR.

- ④ INP149NB STA. 46+55.5, 29.8' (RIGHT)  
PA90 POLE FOUNDATION  
TYPE PA90-A-35-D40-9 (DAVIT AT 350 DEG)  
1-ANGLE MOUNT SIGNAL OVERHEAD AT 0'  
1-STRAIGHT MOUNT SIGNAL OVERHEAD AT 11'  
1-ANGLE MOUNT SIGNAL AT 180 DEG  
1-ONE WAY EVP DETECTOR AND CONFIRMATORY LIGHT (PHASE 2)  
LUMINAIRE-LED  
2- R9-3α SIGNS (NO PED) FACING POLES 1 AND 3  
2-TYPE D SIGNS (D-3) & (D-4)  
3" PVC TO HH 10:  
2-12/C #14  
1-3/C #14  
1-3/C #14 (LUM)  
1-3/C #20  
1-1/C #6 INS. GR.




DISTRICT #: METRO  
 IPLOT NAME: matchline  
 PATH & FILENAME: IP\_PWP-d07823\3\T21724\_sgl.dgn  
 PLOTTED/REVISED: 6/23/2015

BY	DATE	REVISIONS	SYSTEM ID: 21724	T.E. 5945	<b>MATCHLINE AND POLE NOTES</b> <b>T.H. 494 AT T.H. 149 (DODD RD.) SOUTH RAMP</b> <b>IN EAGAN, DAKOTA COUNTY</b>	DRAWN BY: BAM	CKD BY: CDB	DATE: 12/20/13
EJA	12-11-14	AS-BUILT OF SP 1917-44	METER ADDRESS: 2580 DODD RD.			CERTIFIED BY: <i>Michael P. Gelinsky</i>	LIC. NO. 19863	DATE: 12/20/13
			MASTER ID:	T.E.		(T.H. 149)	SHEET NO. 2 OF 4 SHEETS	

PLOTTED/REVISED: 6/23/2015

DISTRICT #: METRO  
PLOT NAME: wire  
PATH & FILENAME: IP\_PWP-d078233\T21724\_sgl.dgn

# CONTROLLER CABINET

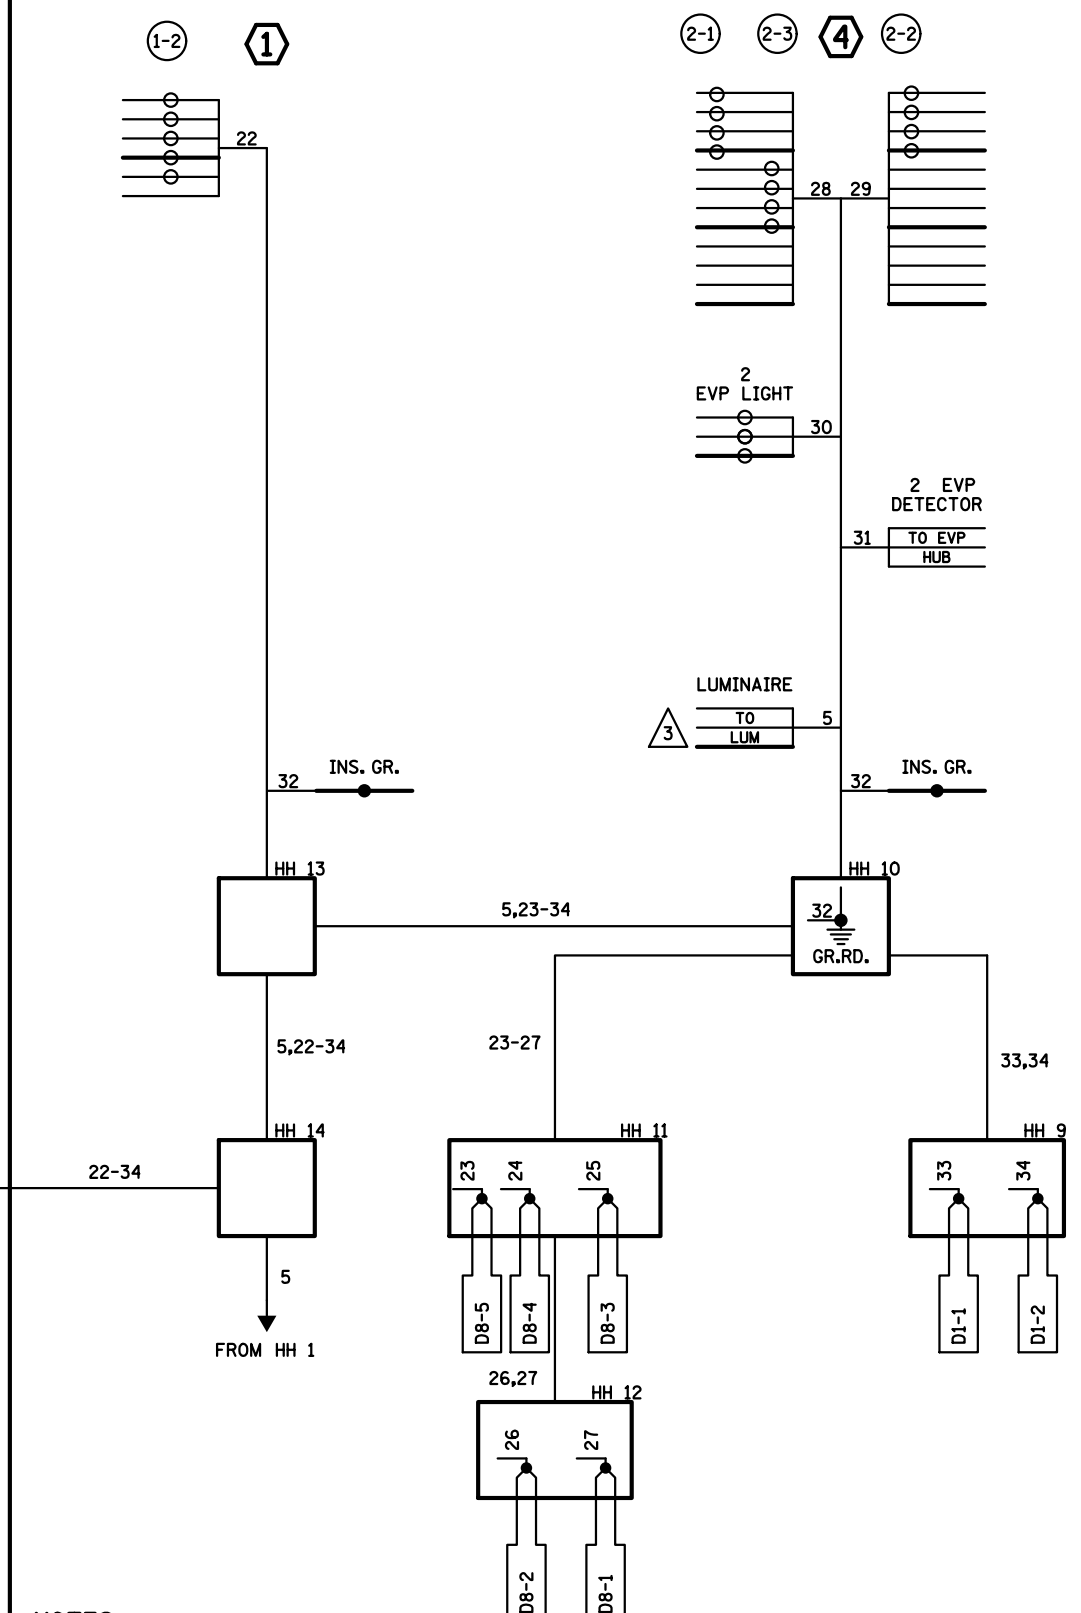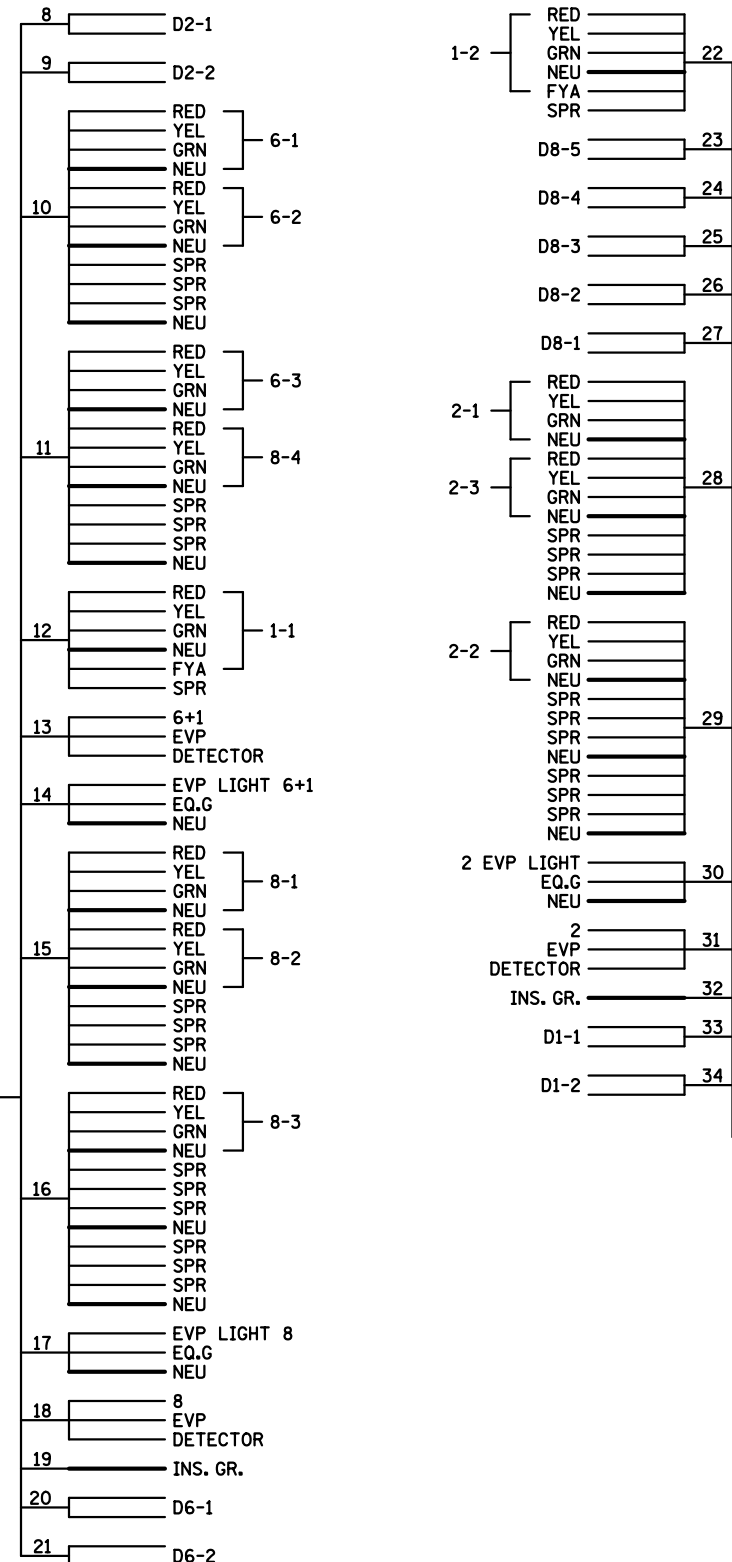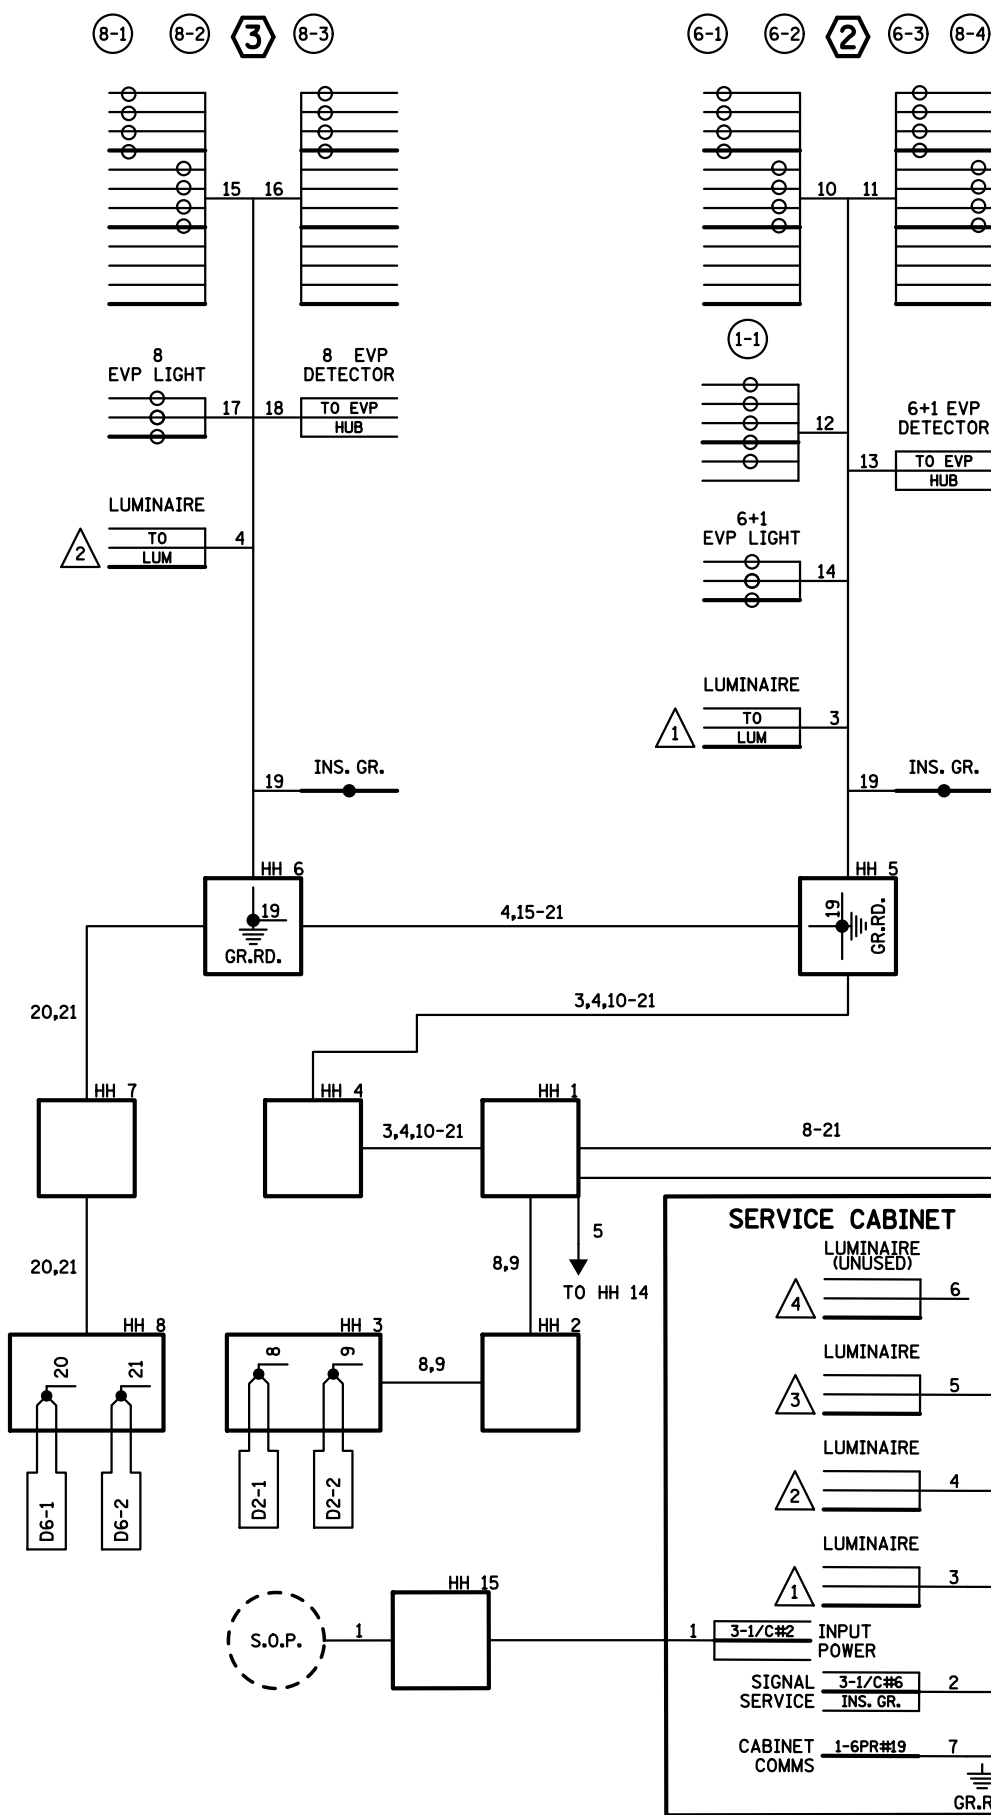


**NOTES:**  
 1. LUMINAIRES ARE METERED.  
 2. SIGNAL SYSTEM INCLUDES BATTERY- BACKUP SERVICE CABINET (NO BATTERIES).  
 3. FOR CONDUCTOR COLOR CODE SEE TRAFFIC SIGNAL POLE WIRING CONNECTOR DETAIL.

BY	DATE	REVISIONS	SYSTEM ID: 21724	T.E. 5945	FIELD WIRING DIAGRAM T.H. 494 AT T.H. 149 (DODD RD.) SOUTH RAMP IN EAGAN, DAKOTA COUNTY	CERTIFIED BY <i>Michael P. Gelinsky</i> LIC. NO. 19863 DATE: 12/20/13 (T.H. 149)	DRAWN BY: BAM	CKD BY: CDB	DATE: 12/20/13
EJA	12-11-14	AS-BUILT OF SP 1917-44	METER ADDRESS: 2580 DODD RD.	T.E.			SHEET NO. 3 OF 4 SHEETS		
			MASTER ID:						


# TYPICAL PAD WITH CONTROLLER CABINET AND SERVICE CABINET

SEE INTERSECTION LAYOUT FOR CABLE INFORMATION (NOT TO SCALE)


## PLAN VIEW

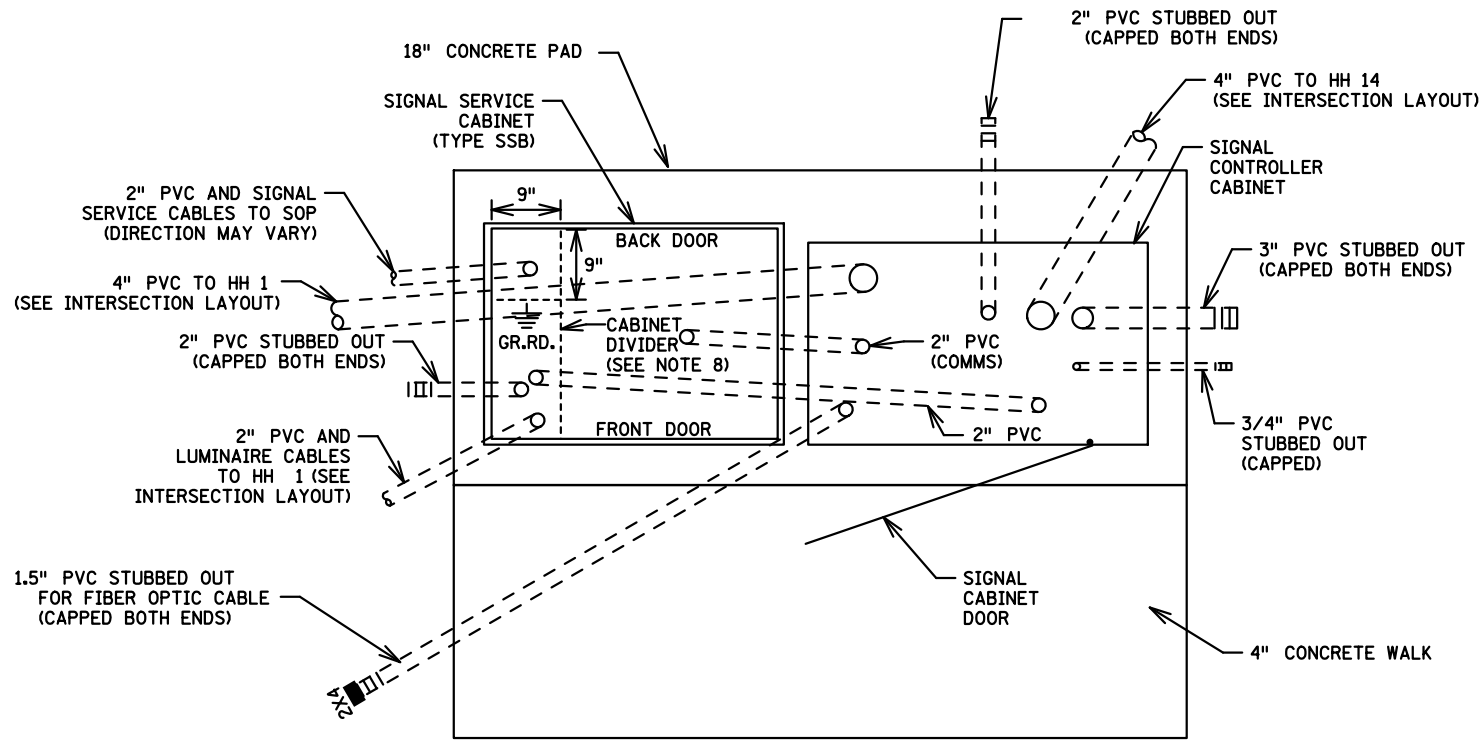


## SIDE VIEW

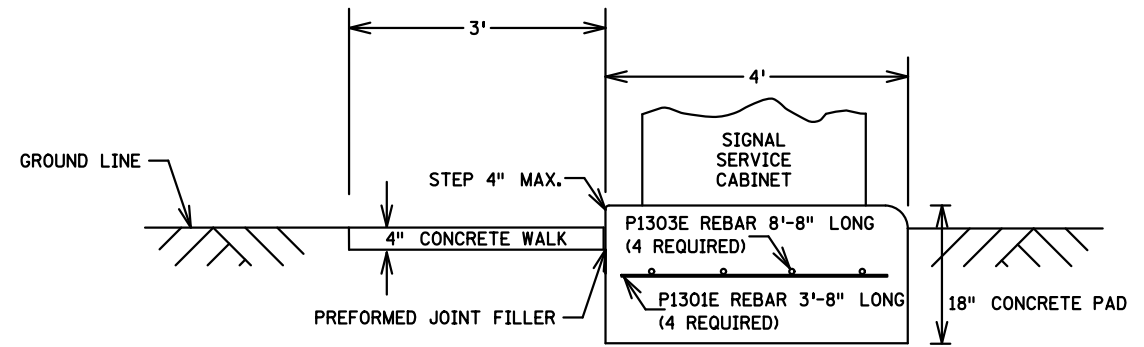

## FRONT VIEW

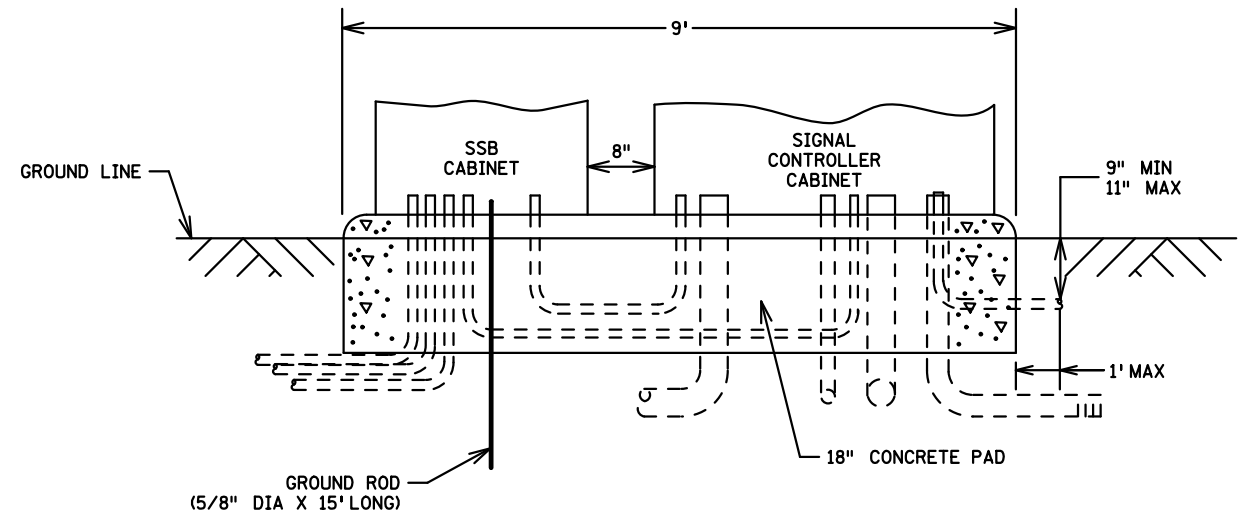


### S.S.B. SERVICE CABINET BOLT PATTERN

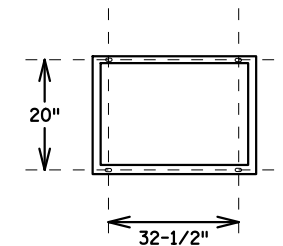

DIMENSION SHOWN ARE CENTER ROD TO CENTER ROD

### CONTROLLER CABINET TYPE "P" & "R" BOLT PATTERN

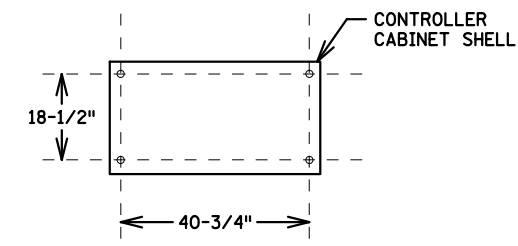

DIMENSION SHOWN ARE CENTER ROD TO CENTER ROD

PLOTTED/REVISED: 6/23/2015

DISTRICT #: METRO  
IPLOT NAME: pad detail  
PATH & FILENAME: IP\_PWP-d07823\3\T21724\_sgl.dgn

BY	DATE	REVISIONS
EJA	12-11-14	AS-BUILT OF SP 1917-44

SYSTEM ID: 21724 T.E. 5945  
METER ADDRESS: 2580 DODD RD.  
MASTER ID: T.E.

EQUIPMENT PAD LAYOUT  
T.H. 494 AT T.H. 149 (DODD RD.) SOUTH RAMP  
IN EAGAN, DAKOTA COUNTY

CERTIFIED BY: <i>Michael P. Gelinsky</i> LICENSED PROFESSIONAL ENGINEER	DRAWN BY: BAM	CKD BY: CDB	DATE: 12/20/13
(T.H. 494)	SHEET NO. 4	OF 4	SHEETS