

 
 





 
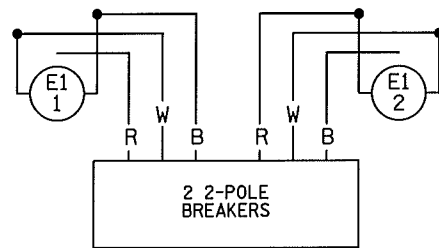


LEGEND


-  LIGHTING UNIT TYPE 9-40 & LIGHT BASE DESIGN E
-  ARMORED CABLE 4 CONDUCTOR NO. 4
-  3" NON-METALLIC CONDUIT DIRECTIONAL BORE (UNLESS OTHERWISE NOTED).
-  PERMANENT GROUND ROD (25 OHMS OR LESS)
-  PAD MOUNTED FEEDPOINT 120/240 VOLT
-  -OHP- OVERHEAD POWER LINES
-  40' WOOD POLE
-  - - - - INPLACE CONDUIT
-  ○ ○ ○ ○ INPLACE WOOD POLE
-  ○ ○ ○ ○ INPLACE LIGHTING UNIT



B AND R DENOTE CURRENT CARRYING CONDUCTORS
 W DENOTES NEUTRAL CONDUCTOR
 FD. PT. 13E1
 120/240 VOLT



LIGHTING STANDARDS AND BASES						
NO.	STA.	ALI	LT.	RT.	LOCATION	WATTAGE
1	INPLACE	SB 95	---		SE QUADRANT	250
2	1284+80	NB 95		---	NW QUADRANT	250

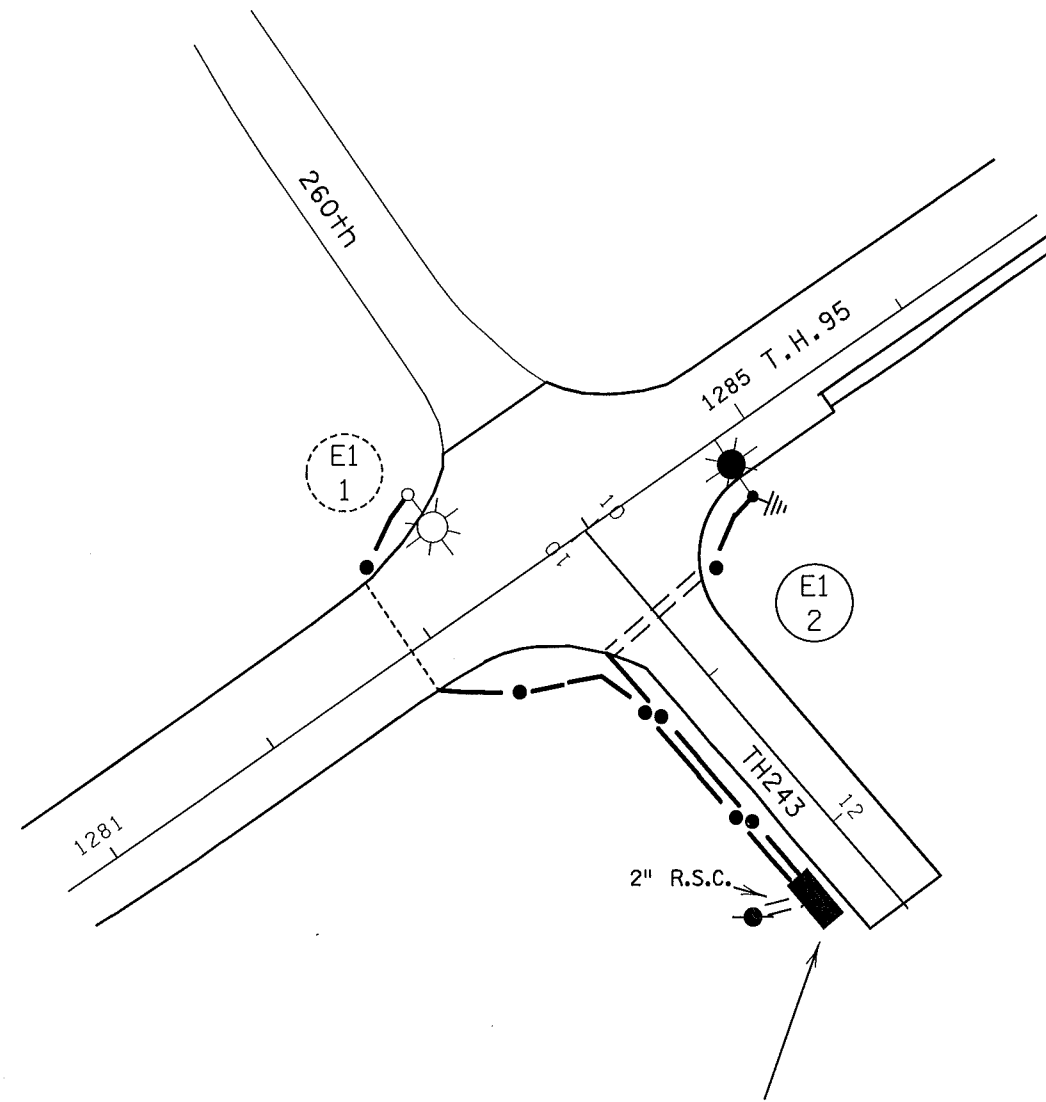

FD. PT. 13E1
 PAD MOUNTED SERVICE CABINET
 SECONDARY TYPE PB-10-RLF
 120/240V (METERED)
 GROUND MOUNTED CAB. FOUNDATION.
 2" R.S.C. 3-1/2" #2 TO WOOD POLE.

AS BUILT 10/10/2011

PLOTTED/REVISED: 10/19/2011

DISTRICT #: METRO
 I/PLOT NAME: 1305-23AB
 PATH & FILENAME: IP_PWP-10718822\1305-23AB.dgn

BY	DATE	REVISIONS	FEEDPOINT: 13E1	LOCATION: T.H.95 at T.H. 243	LIGHTING PLAN
			METER ADDRESS: Scandia		
DRAWN BY: PB			CERTIFIED BY: <i>Michael P. Libinsky</i>	LIC. NO. 19863	DATE: 10/19/2011
CKD BY: GB			STATE PROJ. NO. 1305-23 (T.H. 95)		SHEET NO. 134 OF 144 SHEETS