
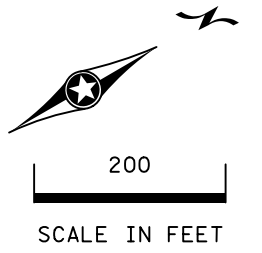



LEGEND

- LIGHTING UNIT
- PERMANENT GROUND ROD (25 OHMS OR LESS)
- DIRECT BURIED LIGHTING CABLE 4/C 4 AWG
- 3" PVC DIRECTIONAL BORED (UNLESS OTHERWISE NOTED)
- FD. PT. CABINET
- INPLACE HANDHOLE
- RIGHT OF WAY
- LIGHTING UNIT IDENTIFIER
- AREA OF ENVIRONMENTAL SENSITIVITY

W DENOTES NEUTRAL CONDUCTOR
 B AND R DENOTE CURRENT CARRYING CONDUCTORS
 FD. PT. E01S
 240/480 VOLT

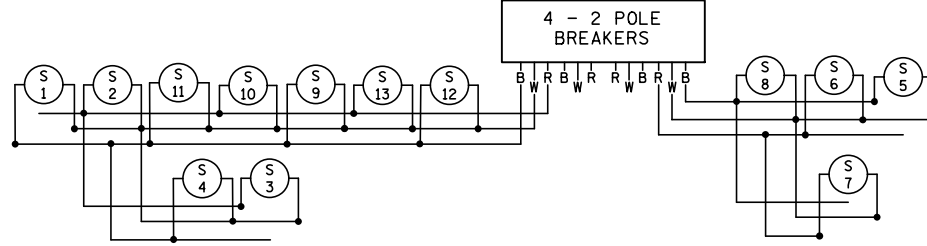

DISTRICT #: Metro
 PLOT NAME: 1982-204_Lit_0
 PATH & FILENAME: Projects\DM_POS\035E\1982\204\Traffic\Lighting\1982-204_Lit_0.dgn
 PLOTTED/REVISED: 1-MAY-2020

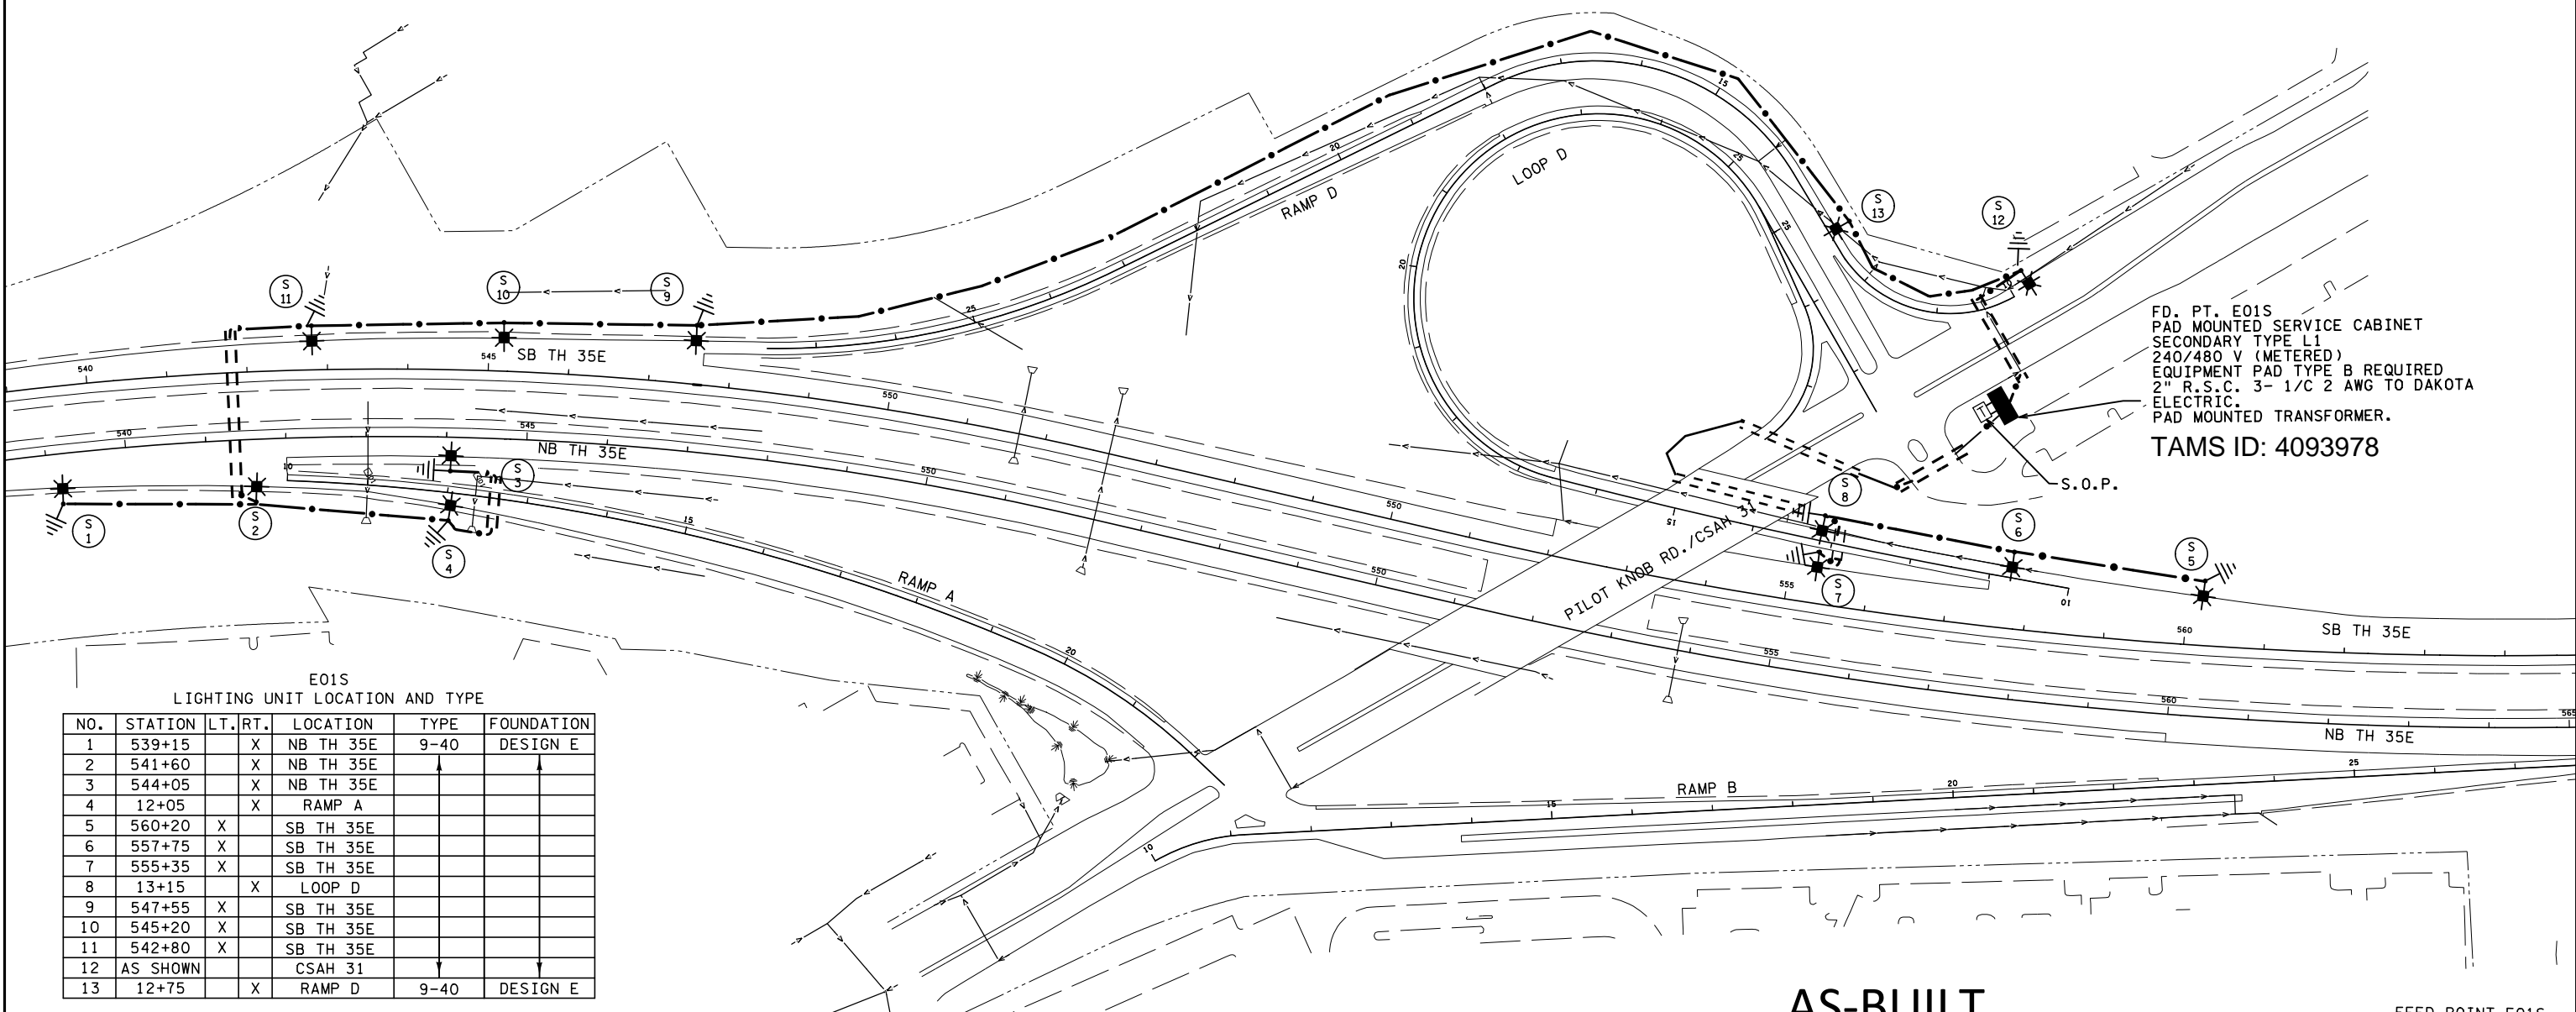

FD. PT. E01S
 PAD MOUNTED SERVICE CABINET
 SECONDARY TYPE L1
 240/480 V (METERED)
 EQUIPMENT PAD TYPE B REQUIRED
 2" R.S.C. 3- 1/C 2 AWG TO DAKOTA
 ELECTRIC.
 PAD MOUNTED TRANSFORMER.
TAMS ID: 4093978

E01S
 LIGHTING UNIT LOCATION AND TYPE

NO.	STATION	LT.	RT.	LOCATION	TYPE	FOUNDATION
1	539+15	X		NB TH 35E	9-40	DESIGN E
2	541+60	X		NB TH 35E		
3	544+05	X		NB TH 35E		
4	12+05	X		RAMP A		
5	560+20	X		SB TH 35E		
6	557+75	X		SB TH 35E		
7	555+35	X		SB TH 35E		
8	13+15	X		LOOP D		
9	547+55	X		SB TH 35E		
10	545+20	X		SB TH 35E		
11	542+80	X		SB TH 35E		
12	AS SHOWN			CSAH 31		
13	12+75	X		RAMP D	9-40	DESIGN E

AS-BUILT

FEED POINT E01S

BY	DATE	REVISIONS	FEEDPOINT: E01S	LOCATION: 3501 PILOT KNB ROAD.
			METER ADDRESS: 3501 PILOT KNOB ROAD, EAGAN 55122	
			CERTIFIED BY <i>Michael P. Dubinsky</i> LIC. NO. 19863 DATE: 1-MAY-2020	
DRAWN BY: HL CKD BY: PB			STATE PROJ. NO. 1982-204 (T.H. 35E) SHEET NO. 9 OF 15 SHEETS	