


| SIGNAL HEAD CHART | | | | | |
|-------------------|---|---|---|---|---|
| FACE | R | Y | G | Y | G |
| 1-1, 1-2 | ← | ← | ← | | |
| 2-1, 2-2, 2-3 | ○ | ○ | ○ | | |
| 4-1, 4-2, 4-3 | ○ | ○ | ○ | | |
| 4-4, 4-5 | ○ | ○ | ○ | ← | ← |
| 5-1, 5-2 | ← | ← | ← | | |
| 6-1, 6-2 | ○ | ○ | ○ | | |
| 8-1, 8-2, 8-3 | ○ | ○ | ○ | | |
| 8-4, 8-5 | ○ | ○ | ○ | ← | ← |

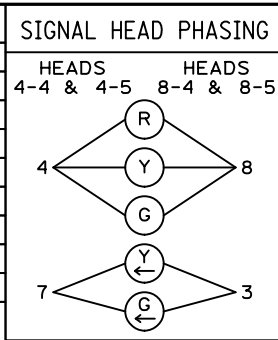

(1) INPLACE: PA85 POLE FOUNDATION
 TYPE PA85-A-25-D40-9 (DAVIT AT 350 DEG)
 2-ONE WAY SIGNALS OVERHEAD AT 0' AND 11'
 2-ONE WAY SIGNALS POLE MOUNTED AT 45 AND 225 DEG
 1-ONE WAY EVP DETECTOR AND LIGHT (PHASES 1+6)
 LUMINAIRE-200 WATT W/ HPS
 1-R6-1L SIGN PANEL POLE MOUNTED AT 0 DEG
 2-TYPE D SIGN PANELS OVERHEAD (D-5) (D-6)
 REMOVE: 1-R9-3 (NO PED XING) SIGN FACING POLE 6
 F&I: 1-ANGLE MOUNT C.D. PED HEAD AT 225 DEG
 INPLACE: EXTEND INTO HH 1:
 3" CONDUIT
 2-12/C 12
 1-3/C 12
 1-3/C 12 (LUM)
 1-4/C 14
 1-3/C 20

(2) INPLACE: PEDESTAL FOUNDATION
 14' PEDESTAL POLE AND BASE
 1-WIND COLLAR FOR PEDESTAL POLE
 1-ONE WAY SIGNAL POLE MOUNTED
 1-PED INDICATION POLE MOUNTED
 REMOVE: 1-PED PB AND SIGN
 1-R9-3a SIGN PANEL FACING POLE 6
 INPLACE: EXTEND INTO HH 1:
 2" CONDUIT
 1-12/C 12
 1-3/C 12

| LOOP DETECTOR CHART | | | | |
|---------------------|-----------|----------|----------|--|
| NUMBER | SIZE (FT) | LOCATION | FUNCTION | |
| D1-1 | 6x6 | 40 | 1 | |
| D1-2 | 6x6 | 10 | 1 | |
| D2-1, D2-2 | 6x6 | 400 | 1 | |
| D3-1 | 2-6x6 | 15 & 45 | 7 | |
| D3-2 | 2-6x6 | 0 & 30 | 7 | |
| D4-1 | 6x6 | 180 | 3, 8 | |
| D4-2 | 2-6x6 | 0 & 15 | 7 | |
| D5-1 | 6x6 | 40 | 1 | |
| 5-2 | 6x6 | 10 | 1 | |
| D6-1 | 6x6 | 400 | 1 | |
| D7-1 | 2-6x6 | 15 & 45 | 7 | |
| D7-2 | 2-6x6 | 0 & 30 | 7 | |
| D8-1 | 6x6 | 300 | 3, 8 | |
| D8-2 | 2-6x6 | 0 & 15 | 7 | |
| D8-3 | 2-6x6 | 0 & 15 | 1 | |

-LOCATION: DISTANCE FROM CROSSWALK /STOP BAR IN FEET
 LOOP DETECTOR FUNCTION:
 1) CALL AN D EXTEND
 3) EXTEND ONLY
 7) DELAYED CALL - IMMEDIATE EXTEND
 8) CARRY OVER (STRETCH)

(A) INPLACE: CONTROLLER AND CABINET
 CABINET FOUNDATION
 EXTEND INTO HH 1:
 4" CONDUIT 4" CONDUIT
 3-12/C 12 2-12/C 12
 4-3/C 12 1-3/C 12
 8-2/C 14 1-4/C 14
 1-3/C 20 1-3/C 20
 EXTEND INTO HH 15:
 4" CONDUIT 4" CONDUIT
 3-12/C 12 2-12/C 12
 2-3/C 12 3-3/C 12
 3-4/C 14 10-2/C 14
 5-2/C 14 1-3/C 20
 1-3/C 20
 EXTEND INTO HH 16:
 METERED SIGNAL SERVICE
 2" CONDUIT
 3-1/C 6
 HH 1 TO HH 16:
 2" CONDUIT
 2-3/C 12 (LUM)
 HH 15 TO HH 16:
 2" CONDUIT
 2-3/C 12 (LUM)
 2-3" CONDUITS STUBBED OUT
 FROM CABINET TO NORTH
 (THREAD AND CAP BOTH
 ENDS FOR FUTURE USE)

(6) INPLACE: PA90 POLE FOUNDATION
 TYPE PA90-A-30-D40-9 (DAVIT AT 350 DEG)
 2-ONE WAY SIGNALS OVERHEAD AT 0' AND 11'
 2-ONE WAY SIGNALS POLE MOUNTED AT 45 AND 225 DEG
 1-ONE WAY EVP DETECTOR AND LIGHT (PHASE 4)
 LUMINAIRE-200 WATT W/ HPS
 1-R10-12 SIGN PANEL ADJACENT TO HEAD 4-4
 1-TYPE D SIGN PANEL OVERHEAD (D-7) (D-8)
 REMOVE: 2-R9-3 SIGN PANELS FACING POLES 1 AND 5
 F&I: 2-STRAIGHT MOUNT C.D. PED HEADS AT 225 AND 315 DEG
 1-APS PB AND SIGN (LT ARROW) (PB2-1)
 AND APS PB MOUNTING SPACERS
 INPLACE: EXTEND INTO HH 11:
 3" CONDUIT
 2-12/C 12
 1-3/C 12
 1-3/C 12 (LUM)
 2-4/C 14
 1-2/C 14
 1-3/C 20

(C) INPLACE: WOOD POLE - SOP (XCEL ENERGY)
 2" CONDUIT RISER AND WEATHERHEAD
 3-1/C 2
 EXTEND INTO HH 17:
 2" CONDUIT
 3-1/C 2

(2) INPLACE: PEDESTAL FOUNDATION
 14' PEDESTAL POLE AND SIGN
 (RT ARROW) (PB6-2)
 EXTEND INTO HH 1:
 1" CONDUIT
 1-2/C 14
 1-1/C 6 INS. GR.

(3) INPLACE: PA90 POLE FOUNDATION
 TYPE PA90-A-30-D40-9 (DAVIT AT 350 DEG)
 2-ONE WAY SIGNALS OVERHEAD AT 0' AND 11'
 2-ONE WAY SIGNALS POLE MOUNTED AT 45 AND 225 DEG
 1-PED HEAD MOUNTED AT 45 DEG
 1-ONE WAY EVP DETECTOR AND LIGHT (PHASE 8)
 LUMINAIRE-200 WATT W/ HPS
 1-R10-12 SIGN PANEL ADJACENT TO HEAD 8-4
 2-TYPE D SIGN PANELS OVERHEAD (D-3) (D-4)
 REMOVE: 1-PED INDICATION (PB-2)
 1-PED PB AND SIGN
 F&I: 1-C.D. PED INDICATION (PB-2)
 INPLACE: EXTEND INTO HH 3:
 3" CONDUIT
 2-12/C 12
 3-3/C 12
 1" CONDUIT
 1-2/C 14
 1-3/C 12 (LUM)
 1-3/C 20

NOTES:
 1. ALL ITEMS ON THIS SHEET ARE INPLACE AND SHALL REMAIN INPLACE UNLESS NOTED OTHERWISE.
 2. SEE INTERSECTION DETAILS FOR ADA PED RAMP CONSTRUCTION AND APS PUSH BUTTON LOCATIONS.
 3. ADJUST INPLACE CONDUIT AND HANDHOLES 1, 3, 7, 8, 11, 14 & 15 TO FINISH GRADE AS NECESSARY.

(B) INPLACE: SIGNAL SERVICE CABINET
 CABINET FOUNDATION
 EXTEND INTO HH 16:
 2" CONDUIT
 METERED SIGNAL SERVICE
 3-1/C 6
 UNMETERED STREET LIGHT SERVICE
 4-3/C 12 (LUM)
 EXTEND INTO HH 17:
 2" CONDUIT
 3-1/C 2


(6) INPLACE: PA90 POLE FOUNDATION
 TYPE PA90-A-30-D40-9 (DAVIT AT 350 DEG)
 2-ONE WAY SIGNALS OVERHEAD AT 0' AND 11'
 2-ONE WAY SIGNALS POLE MOUNTED AT 45 AND 225 DEG
 1-ONE WAY EVP DETECTOR AND LIGHT (PHASE 8)
 LUMINAIRE-200 WATT W/ HPS
 1-R10-12 SIGN PANEL ADJACENT TO HEAD 8-4
 2-TYPE D SIGN PANELS OVERHEAD (D-3) (D-4)
 REMOVE: 1-PED INDICATION (PB-2)
 1-PED PB AND SIGN
 F&I: 1-C.D. PED INDICATION (PB-2)
 INPLACE: EXTEND INTO HH 3:
 3" CONDUIT
 2-12/C 12
 3-3/C 12
 1" CONDUIT
 1-2/C 14
 1-3/C 12 (LUM)
 1-3/C 20

(C) INPLACE: WOOD POLE - SOP (XCEL ENERGY)
 2" CONDUIT RISER AND WEATHERHEAD
 3-1/C 2
 EXTEND INTO HH 17:
 2" CONDUIT
 3-1/C 2

(2) INPLACE: PEDESTAL FOUNDATION
 14' PEDESTAL POLE AND SIGN
 (RT ARROW) (PB4-2)
 EXTEND INTO HH 14:
 1" CONDUIT
 1-2/C 14
 1-1/C 6 INS. GR.

(3) INPLACE: PA90 POLE FOUNDATION
 TYPE PA90-A-30-D40-9 (DAVIT AT 350 DEG)
 2-ONE WAY SIGNALS OVERHEAD AT 0' AND 11'
 2-ONE WAY SIGNALS POLE MOUNTED AT 45 AND 225 DEG
 1-PED HEAD MOUNTED AT 45 DEG
 1-ONE WAY EVP DETECTOR AND LIGHT (PHASE 8)
 LUMINAIRE-200 WATT W/ HPS
 1-R10-12 SIGN PANEL ADJACENT TO HEAD 8-4
 2-TYPE D SIGN PANELS OVERHEAD (D-3) (D-4)
 REMOVE: 1-PED INDICATION (PB-2)
 1-PED PB AND SIGN
 F&I: 1-C.D. PED INDICATION (PB-2)
 INPLACE: EXTEND INTO HH 3:
 3" CONDUIT
 2-12/C 12
 3-3/C 12
 1" CONDUIT
 1-2/C 14
 1-3/C 12 (LUM)
 1-3/C 20

NOTES:
 1. ALL ITEMS ON THIS SHEET ARE INPLACE AND SHALL REMAIN INPLACE UNLESS NOTED OTHERWISE.
 2. SEE INTERSECTION DETAILS FOR ADA PED RAMP CONSTRUCTION AND APS PUSH BUTTON LOCATIONS.
 3. ADJUST INPLACE CONDUIT AND HANDHOLES 1, 3, 7, 8, 11, 14 & 15 TO FINISH GRADE AS NECESSARY.

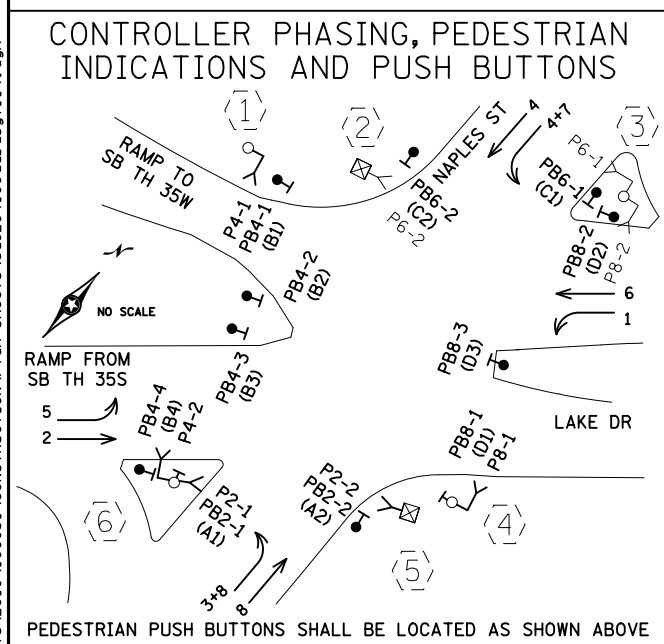

(6) INPLACE: PA90 POLE FOUNDATION
 TYPE PA90-A-30-D40-9 (DAVIT AT 350 DEG)
 2-ONE WAY SIGNALS OVERHEAD AT 0' AND 11'
 2-ONE WAY SIGNALS POLE MOUNTED AT 45 AND 225 DEG
 1-ONE WAY EVP DETECTOR AND LIGHT (PHASE 8)
 LUMINAIRE-200 WATT W/ HPS
 1-R10-12 SIGN PANEL ADJACENT TO HEAD 8-4
 2-TYPE D SIGN PANELS OVERHEAD (D-3) (D-4)
 REMOVE: 1-PED INDICATION (PB-2)
 1-PED PB AND SIGN
 F&I: 1-C.D. PED INDICATION (PB-2)
 INPLACE: EXTEND INTO HH 3:
 3" CONDUIT
 2-12/C 12
 3-3/C 12
 1" CONDUIT
 1-2/C 14
 1-3/C 12 (LUM)
 1-3/C 20

(2) INPLACE: PEDESTAL FOUNDATION
 14' PEDESTAL POLE AND SIGN
 (RT ARROW) (PB4-3)
 EXTEND INTO HH 14:
 1" CONDUIT
 1-2/C 14
 1-1/C 6 INS. GR.

(3) INPLACE: PA90 POLE FOUNDATION
 TYPE PA90-A-30-D40-9 (DAVIT AT 350 DEG)
 2-ONE WAY SIGNALS OVERHEAD AT 0' AND 11'
 2-ONE WAY SIGNALS POLE MOUNTED AT 45 AND 225 DEG
 1-PED HEAD MOUNTED AT 45 DEG
 1-ONE WAY EVP DETECTOR AND LIGHT (PHASE 8)
 LUMINAIRE-200 WATT W/ HPS
 1-R10-12 SIGN PANEL ADJACENT TO HEAD 8-4
 2-TYPE D SIGN PANELS OVERHEAD (D-3) (D-4)
 REMOVE: 1-PED INDICATION (PB-2)
 1-PED PB AND SIGN
 F&I: 1-C.D. PED INDICATION (PB-2)
 INPLACE: EXTEND INTO HH 3:
 3" CONDUIT
 2-12/C 12
 3-3/C 12
 1" CONDUIT
 1-2/C 14
 1-3/C 12 (LUM)
 1-3/C 20

(4) INPLACE: PA100 POLE FOUNDATION
 TYPE PA100-A-45-D40-9 (DAVIT AT 350 DEG)
 3-ONE WAY SIGNALS OVERHEAD AT 0', 11' AND 23'
 2-ONE WAY SIGNALS POLE MOUNTED AT 45 AND 225 DEG
 1-ONE WAY EVP DETECTOR AND LIGHT (PHASES 2+5)
 LUMINAIRE-200 WATT W/ HPS
 1-R6-1L SIGN PANEL POLE MOUNTED AT 0 DEG
 2-TYPE D SIGN PANELS OVERHEAD (D-5) (D-6)
 F&I: 1-ANGLE MOUNT C.D. PED HEAD AT 90 DEG
 1-APS PB AND SIGN (LT ARROW) (PB8-1)
 AND APS PB MOUNTING SPACERS
 INPLACE: EXTEND INTO HH 8:
 3" CONDUIT
 2-12/C 12
 1-3/C 12
 1-3/C 12 (LUM)
 1-4/C 14
 1-2/C 14
 1-3/C 20

(5) INPLACE: PEDESTAL FOUNDATION
 14' PEDESTAL POLE AND BASE
 1-WIND COLLAR FOR PEDESTAL POLE
 1-ONE WAY SIGNAL POLE MOUNTED
 REMOVE: 1-PED INDICATION (PB-1)
 1-PED PB AND SIGN
 1-R9-3 SIGN PANEL FACING POLE 6
 F&I: 1-C.D. PED INDICATION (PB-1)
 AND ROTATE HEAD TO FACE POLE 6
 INPLACE: EXTEND INTO HH 8:
 3" CONDUIT
 1-12/C 12
 1-3/C 12

SIGNAL SYSTEM OPERATION
 - THE SIGNAL SYSTEM FLASH MODE IS ALL RED.
 - NORMAL OPERATION IS 8 PHASE, WITH PHASES 1 AND 5 BEING PROTECTED LEFT TURN PHASES AND PHASES 3 AND 7 BEING PROTECTED/PERMISSIVE LEFT TURN PHASES.
 - PHASES 2 AND 6 SHALL BE ON VEHICLE RECALL.

| NO | DATE | DWN | CKD | REVISIONS |
|----|----------|-----|-----|----------------|
| 1 | 03/06/20 | YAA | AJR | NDC 029 |
| 2 | 06/25/21 | KAS | MPM | FDC 379 |
| 3 | 12/03/21 | | | RECORD DRAWING |



RECORD DRAWING NOTE: THESE RECORD DRAWINGS WERE DEVELOPED BASED ON THE PREVIOUS DRAWING REVISIONS AND INFORMATION TRANSMITTED FROM THE FIELD BY OTHERS. THE INFORMATION CONTAINED WITHIN THIS RECORD AS-BUILT PLAN REPRESENTS THE ACTUAL CONDITIONS FOR ALL CHANGES OF WHICH ALLIANT IS AWARE. FUTURE USERS OF THESE DRAWINGS SHOULD VERIFY AS-BUILT CONDITIONS IN THE FIELD IN ALL CIRCUMSTANCES.

REVISE SIGNAL SYSTEM "H" LAYOUT
 CSAH 23 (LAKE DR) & NAPLES ST

I-35W NORTH MNPASS DB (S.P. 6284-180)
 SHEET NO. SGL28 OF SGL45 SHEETS

8:25:31 AM 12/3/2021 \\projects\2018\180051\CONSTRUCTION\Plan Sheets\cd6284180_cd_sg1114.dgn

- NOTES:**
- 1) LOCATION OF POLES, CONTROLLER CABINET, SERVICE CABINET, LOOP DETECTORS AND HANDHOLES SHALL BE DETERMINED IN THE FIELD BY THE ENGINEER.
 - 2) SEE SPECIAL PROVISIONS FOR COUNTY FURNISHED MATERIALS.
 - 3) LOOP DETECTOR WIRES SHALL BE CROSS-LINKED POLYETHYLENE (XLP) IN 3/4" N.M.C. SEE SPECIAL PROVISIONS.
 - 4) NEW HANDHOLES SHALL BE PVC HANDHOLES WITH METAL FRAMES AND COVERS.
 - 5) EACH SIGNAL FACE SHALL HAVE BACKGROUND SHIELD.
 - 6) EACH PEDESTRIAN INDICATION SHALL BE ONE SECTION "FILLED" HAND/WALKING PERSON INDICATIONS.
 - 7) ALL VEHICLE SIGNAL INDICATIONS, AND ALL PEDESTRIAN SIGNAL INDICATIONS SHALL BE LED.
 - 8) SEE SPECIAL PROVISIONS AND DETAILS REGARDING SIGNS TO BE FURNISHED & INSTALLED BY CONTRACTOR (INCIDENTAL).
 - 9) CONTRACTOR SHALL PROVIDE EXTENDED BRACKETS FOR EACH POLE MOUNTED VEHICLE AND PEDESTRIAN SIGNAL FACE.
 - 10) A 3/4" HALF COUPLING, 3/4" PIPE NIPPLE AND CONDUIT OUTLET BODY SHALL BE FURNISHED AND INSTALLED 6 FEET FROM THE END OF EACH MAST ARM (FOR EVP).
 - 11) CONTRACTOR SHALL COORDINATE ALL TRAFFIC SIGNAL INSTALLATION WORK WITH ROAD CONSTRUCTION TO BE COMPLETED BY OTHERS AS PART OF ENTIRE PROJECT.
 - 12) ALL MAST ARM POLE AND PEDESTAL POLE MOUNTED VEHICLE AND PEDESTRIAN SIGNAL INDICATIONS SHALL BE MOUNTED USING ONE-WAY SIGNAL HEAD MOUNTS. SEE SPECIAL PROVISIONS.

| N.M.C. LOOP DETECTORS | | | |
|-----------------------|------------|-----------|----------|
| NUMBER | SIZE (FT.) | LOCATION | FUNCTION |
| D1-1 | 6x6 | 40' | 1 |
| D1-2 | 6x6 | 10' | 1 |
| D2-1 | 6x6 | 400' | 1 |
| D2-2 | 6x6 | 400' | 1 |
| D3-1 | 2-6x6 | 15' & 45' | 7 |
| D3-2 | 2-6x6 | 0' & 30' | 7 |
| D4-1 | 6x6 | 180' | 3,8 |
| D4-2 | 2-6x6 | 0' & 15' | 7 |
| D5-1 | 6x6 | 40' | 1 |
| D5-2 | 6x6 | 10' | 1 |
| D6-1 | 6x6 | 400' | 1 |
| D7-1 | 2-6x6 | 15' & 45' | 7 |
| D7-2 | 2-6x6 | 0' & 30' | 7 |
| D8-1 | 6x6 | 300' | 3,8 |
| D8-2 | 2-6x6 | 0' & 15' | 7 |
| D8-3 | 2-6x6 | 0' & 15' | 1 |

- LOOP DETECTORS FUNCTIONS:**
- 1) CALL AND EXTEND
 - 2) CALL ONLY
 - 3) EXTEND ONLY
 - 4) CALL ONLY DENSITY
 - 5) DELAYED CALL ONLY
 - 6) DELAYED CALL ONLY DENSITY
 - 7) DELAYED CALL- IMMEDIATE EXTEND
 - 8) CARRY OVER (STRETCH)
 - 9) ADVISORY DETECTOR
 - 10) SAMPLING DETECTOR
 - 11) SPECIAL DETECTOR


H.H.1 TO H.H.16:
2"R.S.C.
2-3/c#12 (LUM)

H.H.15 TO H.H.16:
2"R.S.C.
2-3/c#12 (LUM)

NOTE: LOCATION = DISTANCE FROM STOP BAR TO FRONT OF LOOP DETECTOR.

(B) SIGNAL SERVICE CABINET
CABINET FOUNDATION
EXTEND INTO H.H.16:
2"R.S.C.
METERED SIGNAL SERVICE
3-1/c#6
UNMETERED STREET LIGHT SERVICE
4-3/c#12 (LUM)
EXTEND INTO H.H.17:
2"R.S.C.
3-1/c#2


4"R.S.C.
2-12/c#12
3-3/c#12
1-3/c#20
4-2/c#14
1-3/c#12 (LUM)
4"R.S.C.
3-12/c#12
2-3/c#12
1-3/c#20
5-2/c#14
1-3/c#12 (LUM)

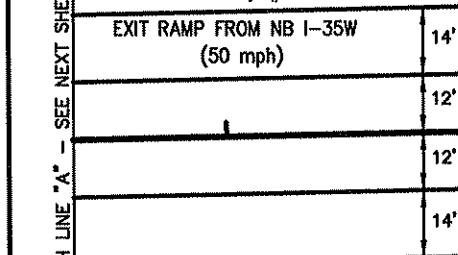

SIGNAL SYSTEM OPERATIONS:

- SIGNAL SYSTEM FLASH MODE SHALL BE ALL RED.
- NORMAL OPERATION SHALL BE 8 PHASE, WITH PHASES 1 & 5 BEING PROTECTED LEFT TURN PHASES, AND PHASES 3 & 7 BEING PROTECTED/PERMISSIVE LEFT TURN PHASES.
- VEHICLE SIGNAL PHASES 2 AND 6 SHALL OPERATE ON RECALL.

CONTROLLER PHASING, PEDESTRIAN INDICATIONS AND PUSH BUTTONS

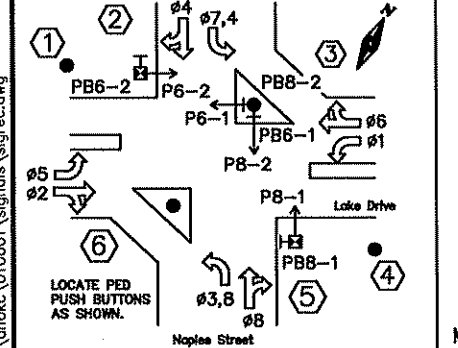

FINAL PLAN
CONFORMING TO
CONST. RECORDS
DATE JMG, 01-19-07


MN/DOT SYSTEM ID = 38478

| DESIGN TEAM | NO. | BY | DATE | REVISIONS |
|-------------|-----|-----|----------|----------------------------|
| JMG | 2 | JMG | 10/21/05 | REVISED PER STATE COMMENTS |
| JMG | 3 | JMG | 3/16/06 | COUNTY, STATE COMMENTS |
| JMG | 4 | JMG | 04/24/06 | STATE COMMENTS |
| JMG | 5 | JMG | 01/19/07 | RECORD DRAWING |

I hereby certify that this plan was prepared by me or under my direct supervision and that I am a duly Licensed Professional Engineer under the laws of the State of Minnesota.

Certified By: John M. Gray Lic. No. 22457


Printed Name: JOHN M. GRAY Date: 04/24/08

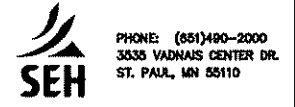

ANOKA COUNTY, MINNESOTA
INTERSECTION IMPROVEMENTS:
CSAH 23 @ INTERSTATE HIGHWAY 35W

TRAFFIC SIGNAL SYSTEM
INTERSECTION LAYOUT
CSAH 23 (LAKE DRIVE) AT NAPLES STREET
STATE PROJECT NO. 02-823-014

FILE NO. **52**
ANOKC0106.0
DATE 04/24/08
57

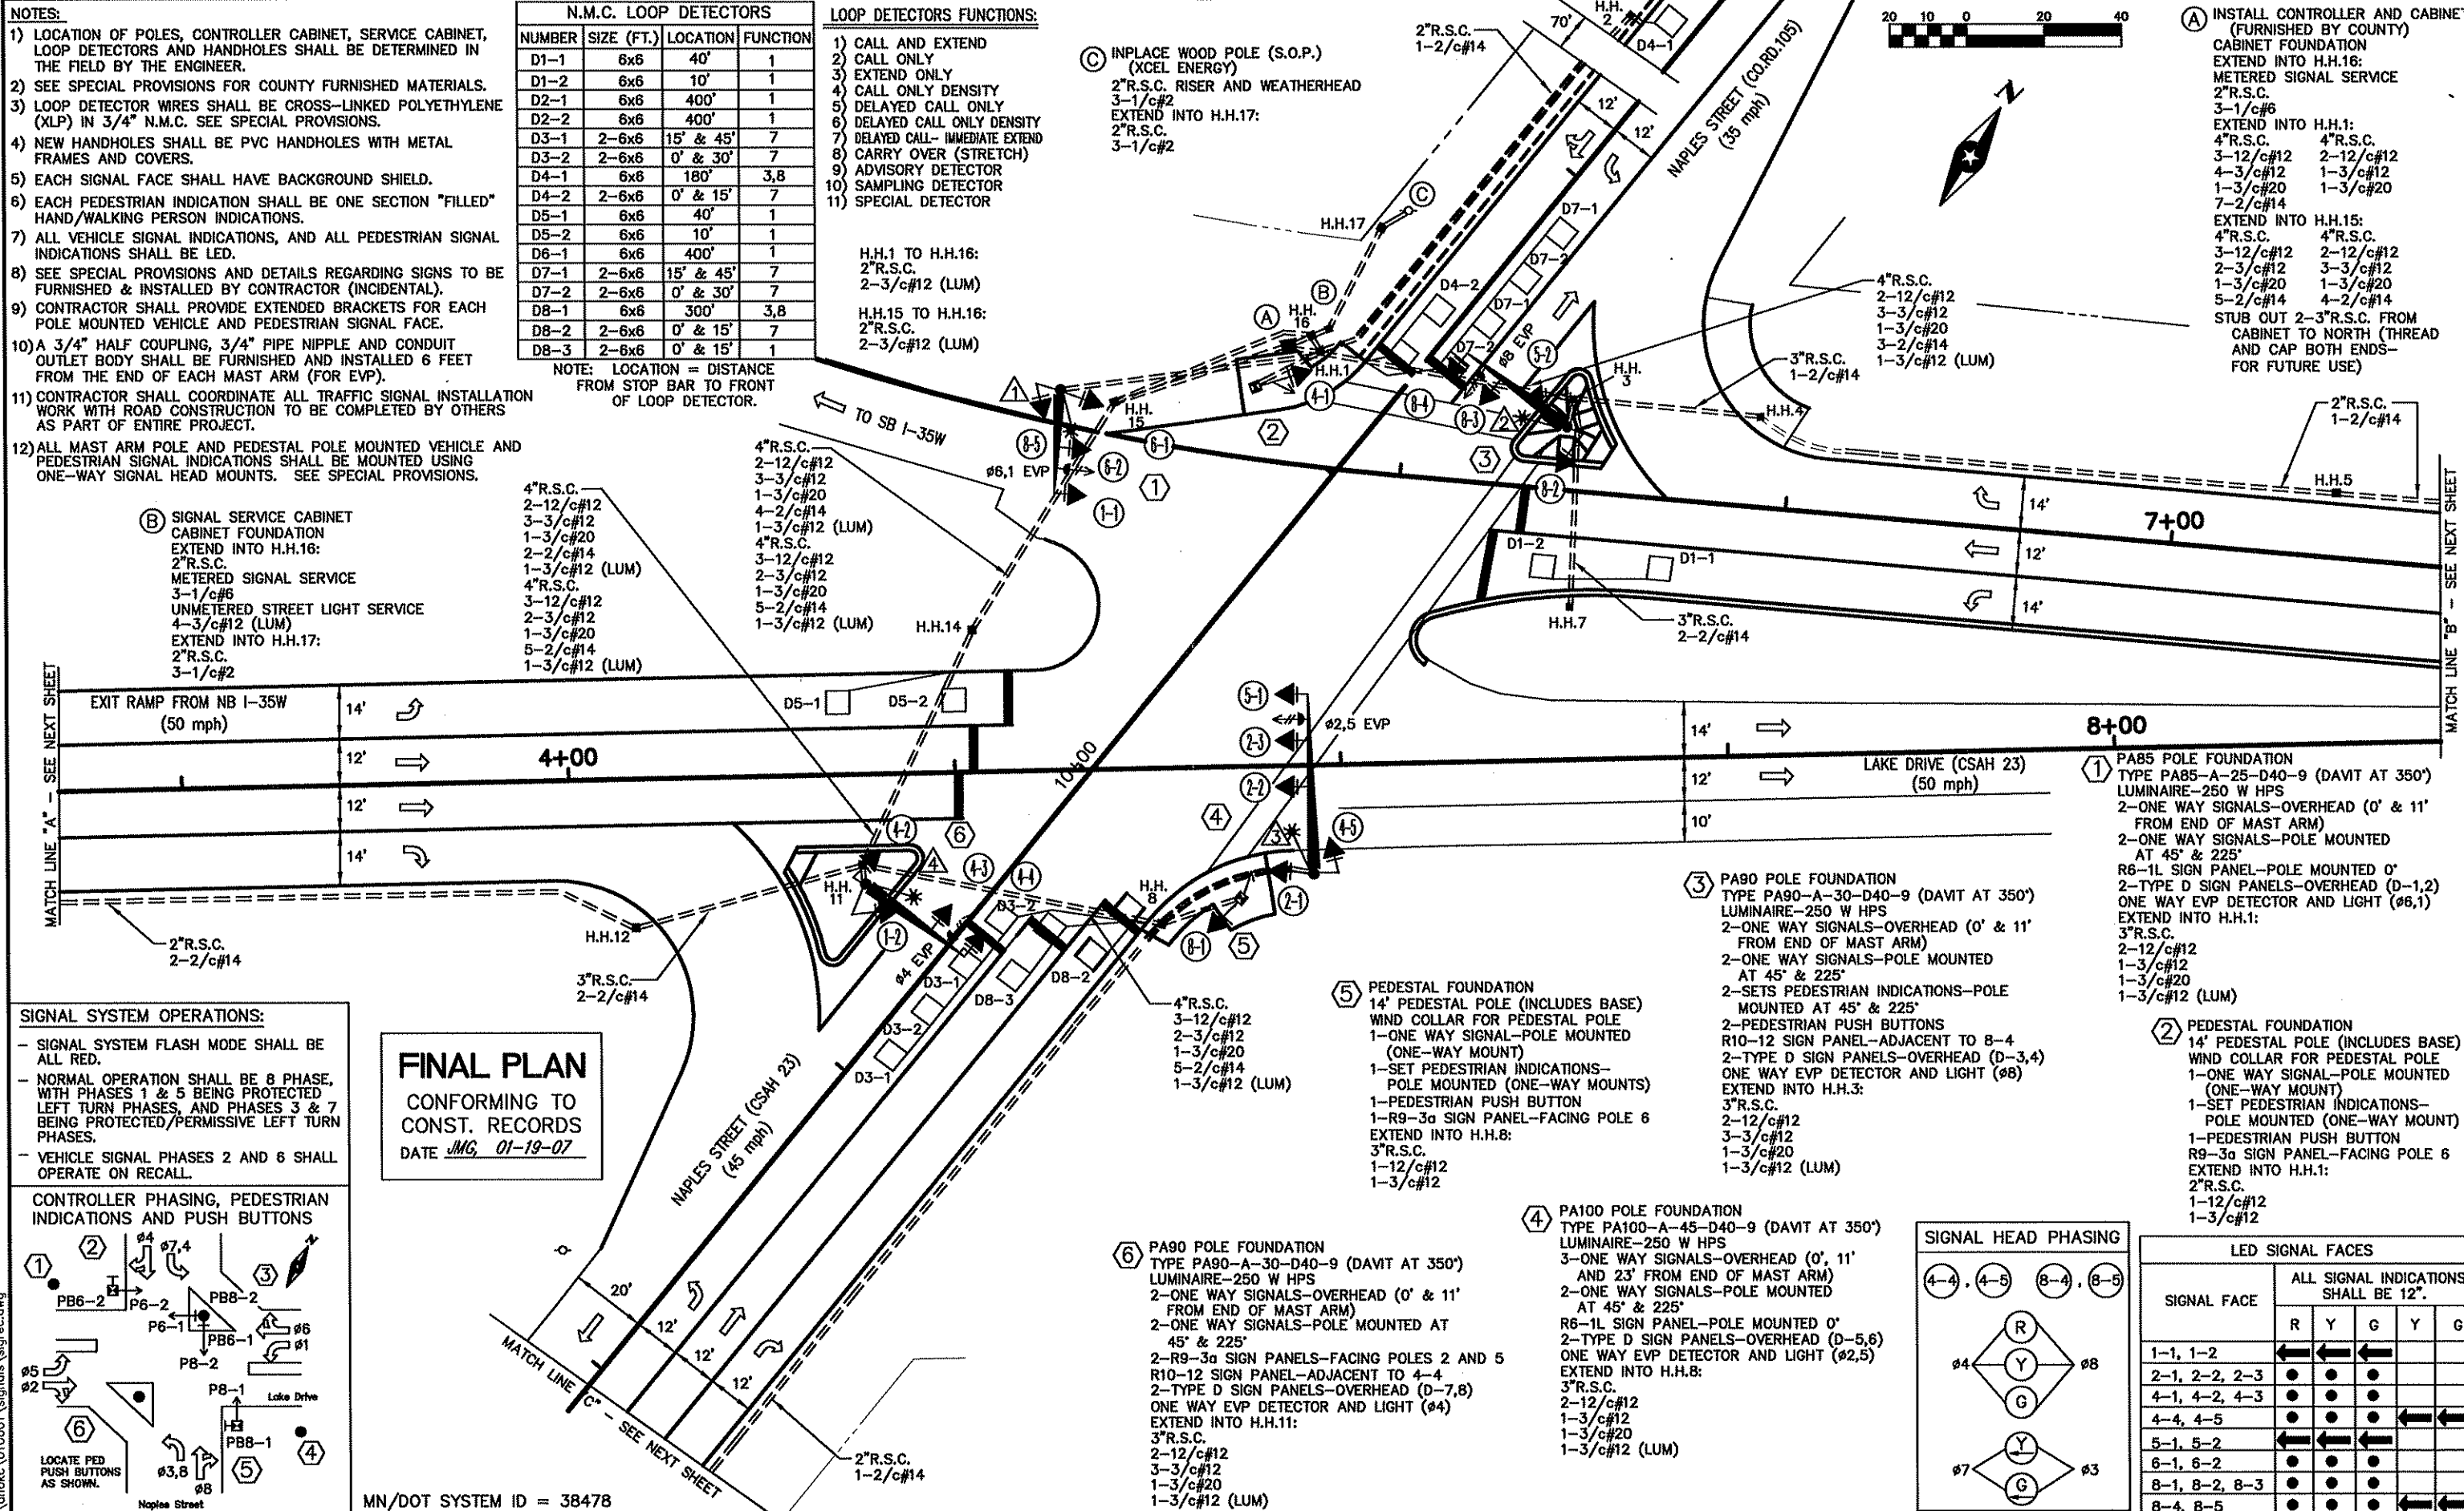

- (A) INSTALL CONTROLLER AND CABINET**
(FURNISHED BY COUNTY)
CABINET FOUNDATION
EXTEND INTO H.H.16:
METERED SIGNAL SERVICE
2"R.S.C.
3-1/c#6
EXTEND INTO H.H.1:
4"R.S.C. 4"R.S.C.
3-12/c#12 2-12/c#12
4-3/c#12 1-3/c#12
1-3/c#20 1-3/c#20
7-2/c#14
EXTEND INTO H.H.15:
4"R.S.C. 4"R.S.C.
3-12/c#12 2-12/c#12
2-3/c#12 3-3/c#12
1-3/c#20 1-3/c#20
5-2/c#14 4-2/c#14
STUB OUT 2-3"R.S.C. FROM CABINET TO NORTH (THREAT AND CAP BOTH ENDS- FOR FUTURE USE)


- (1) PA85 POLE FOUNDATION**
TYPE PA85-A-25-D40-9 (DAVIT AT 350')
LUMINAIRE-250 W HPS
2-ONE WAY SIGNALS-OVERHEAD (0' & 11' FROM END OF MAST ARM)
2-ONE WAY SIGNALS-POLE MOUNTED AT 45' & 225'
R6-1L SIGN PANEL-POLE MOUNTED 0'
2-TYPE D SIGN PANELS-OVERHEAD (D-1,2)
ONE WAY EVP DETECTOR AND LIGHT (#6,1)
EXTEND INTO H.H.1:
3"R.S.C.
2-12/c#12
1-3/c#12
1-3/c#20
1-3/c#12 (LUM)

- (2) PEDESTAL FOUNDATION**
14' PEDESTAL POLE (INCLUDES BASE)
WIND COLLAR FOR PEDESTAL POLE
1-ONE WAY SIGNAL-POLE MOUNTED (ONE-WAY MOUNT)
1-SET PEDESTRIAN INDICATIONS-POLE MOUNTED (ONE-WAY MOUNT)
1-PEDESTRIAN PUSH BUTTON
R9-3a SIGN PANEL-FACING POLE 6
EXTEND INTO H.H.1:
2"R.S.C.
1-12/c#12
1-3/c#12




- (3) PA90 POLE FOUNDATION**
TYPE PA90-A-30-D40-9 (DAVIT AT 350')
LUMINAIRE-250 W HPS
2-ONE WAY SIGNALS-OVERHEAD (0' & 11' FROM END OF MAST ARM)
2-ONE WAY SIGNALS-POLE MOUNTED AT 45' & 225'
2-SETS PEDESTRIAN INDICATIONS-POLE MOUNTED AT 45' & 225'
2-PEDESTRIAN PUSH BUTTONS
R10-12 SIGN PANEL-ADJACENT TO 8-4
2-TYPE D SIGN PANELS-OVERHEAD (D-3,4)
ONE WAY EVP DETECTOR AND LIGHT (#8)
EXTEND INTO H.H.3:
3"R.S.C.
2-12/c#12
3-3/c#12
1-3/c#20
1-3/c#12 (LUM)

- (4) PA100 POLE FOUNDATION**
TYPE PA100-A-45-D40-9 (DAVIT AT 350')
LUMINAIRE-250 W HPS
3-ONE WAY SIGNALS-OVERHEAD (0', 11' AND 23' FROM END OF MAST ARM)
2-ONE WAY SIGNALS-POLE MOUNTED AT 45' & 225'
R6-1L SIGN PANEL-POLE MOUNTED 0'
2-TYPE D SIGN PANELS-OVERHEAD (D-5,6)
ONE WAY EVP DETECTOR AND LIGHT (#2,5)
EXTEND INTO H.H.8:
3"R.S.C.
2-12/c#12
1-3/c#12
1-3/c#20
1-3/c#12 (LUM)

- (6) PA90 POLE FOUNDATION**
TYPE PA90-A-30-D40-9 (DAVIT AT 350')
LUMINAIRE-250 W HPS
2-ONE WAY SIGNALS-OVERHEAD (0' & 11' FROM END OF MAST ARM)
2-ONE WAY SIGNALS-POLE MOUNTED AT 45' & 225'
2-R9-3a SIGN PANELS-FACING POLES 2 AND 5
R10-12 SIGN PANEL-ADJACENT TO 4-4
2-TYPE D SIGN PANELS-OVERHEAD (D-7,8)
ONE WAY EVP DETECTOR AND LIGHT (#4)
EXTEND INTO H.H.11:
3"R.S.C.
2-12/c#12
3-3/c#12
1-3/c#20
1-3/c#12 (LUM)

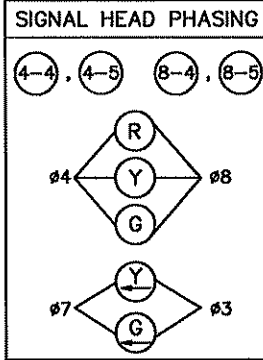

| LED SIGNAL FACES | | | | | |
|------------------|--------------------------------------|---|---|---|---|
| SIGNAL FACE | ALL SIGNAL INDICATIONS SHALL BE 12". | | | | |
| | R | Y | G | Y | G |
| 1-1, 1-2 | ● | ● | ● | ● | ● |
| 2-1, 2-2, 2-3 | ● | ● | ● | ● | ● |
| 4-1, 4-2, 4-3 | ● | ● | ● | ● | ● |
| 4-4, 4-5 | ● | ● | ● | ● | ● |
| 5-1, 5-2 | ● | ● | ● | ● | ● |
| 6-1, 6-2 | ● | ● | ● | ● | ● |
| 8-1, 8-2, 8-3 | ● | ● | ● | ● | ● |
| 8-4, 8-5 | ● | ● | ● | ● | ● |

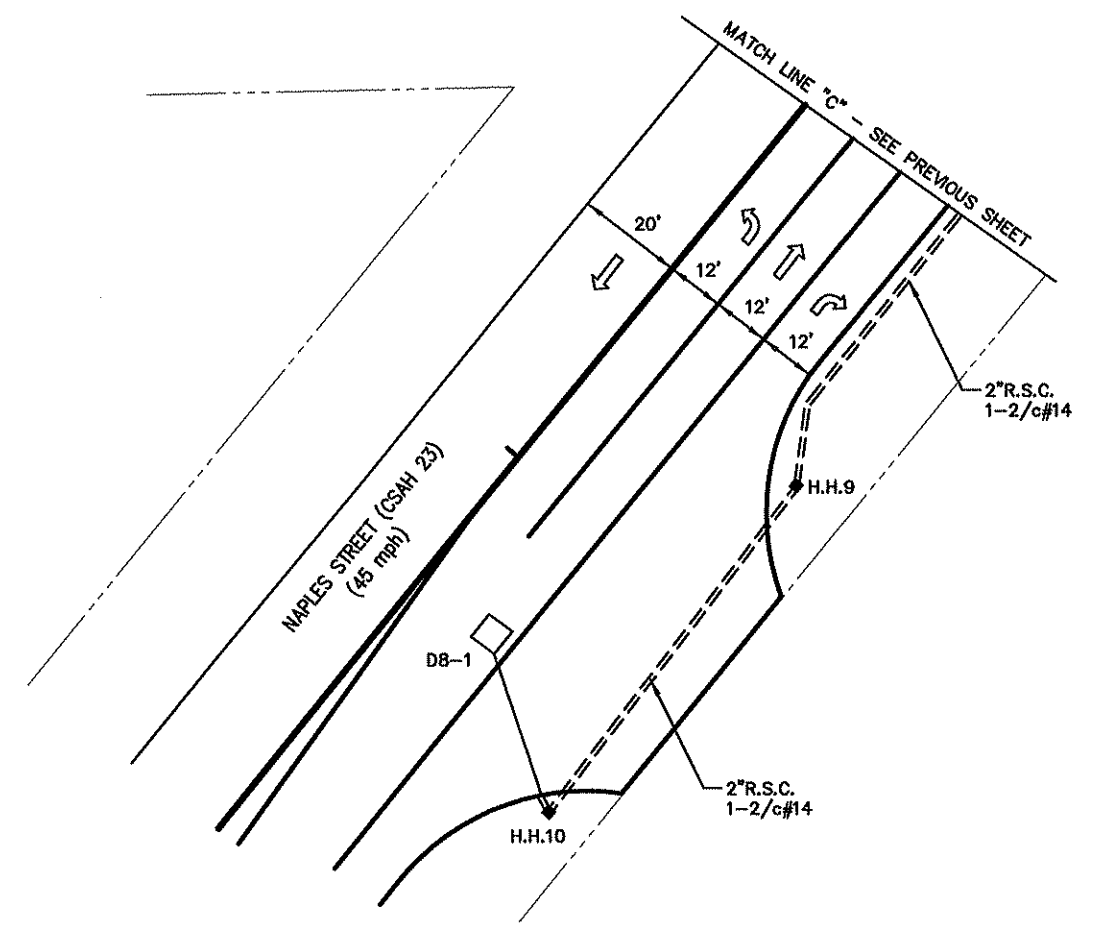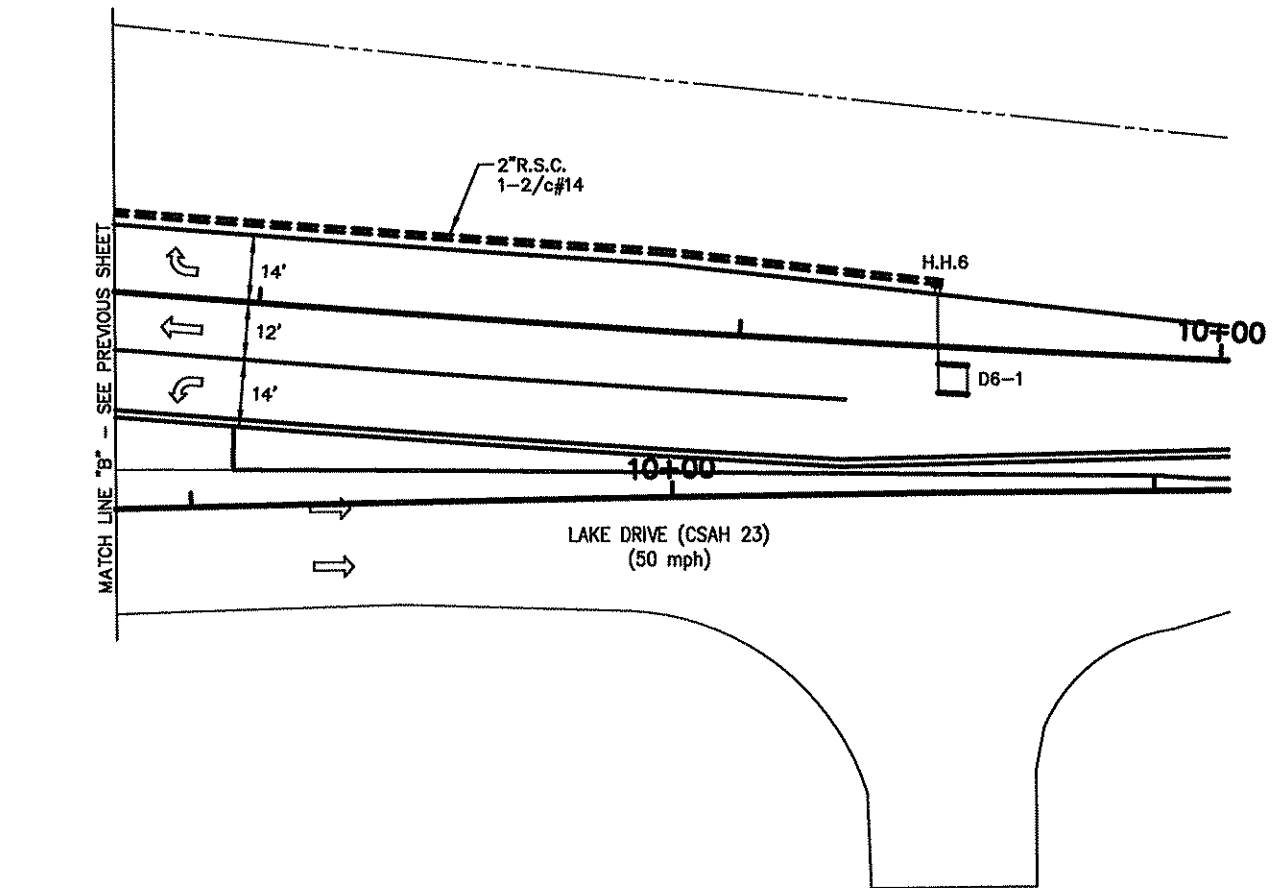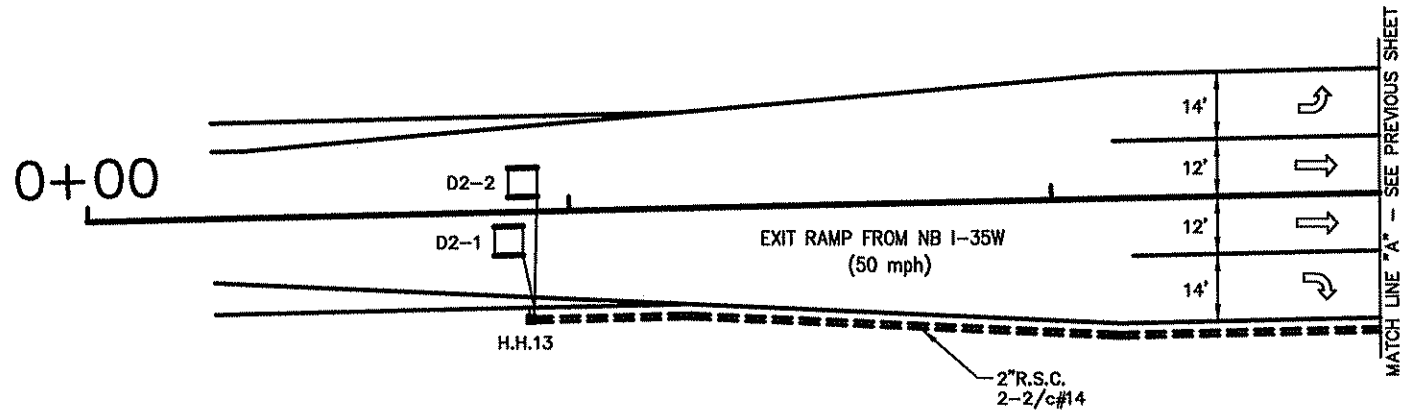

FINAL PLAN
 CONFORMING TO
 CONST. RECORDS
 DATE *JMG, 01-19-07*

MN/DOT SYSTEM ID = 38478

S:\oe\ad\amokc\010601\signals\sigrec.dwg

| | | | | |
|-------------|-----|------|-----------|----------------|
| DESIGN TEAM | 1 | JMG | 01/19/07 | RECORD DRAWING |
| DRAWN BY: | JMG | | | |
| DESIGNER: | JMG | | | |
| CHECKED BY: | JMG | | | |
| NO. | BY | DATE | REVISIONS | |

I hereby certify that this plan was prepared by me or under my direct supervision and that I am a duly Licensed Professional Engineer under the laws of the State of Minnesota.
 Certified By: *John M. Gray* Lic. No. 22457
 Printed Name: JOHN M. GRAY Date: 03/16/06


PHONE: (851)490-2000
 3535 VADNAIS CENTER DR.
 ST. PAUL, MN 55110

ANOKA COUNTY, MINNESOTA
 INTERSECTION IMPROVEMENTS:
 CSAH 23 @ INTERSTATE HIGHWAY 35W

TRAFFIC SIGNAL SYSTEM
 INTERSECTION LAYOUT
 CSAH 23 (LAKE DRIVE) AT NAPLES STREET
 STATE PROJECT NO. 02-623-014

| | |
|-------------|-----------|
| FILE NO. | 53 |
| ANOKC0106.0 | |
| DATE | 03/16/06 |
| | 57 |

CONTROLLER CABINET

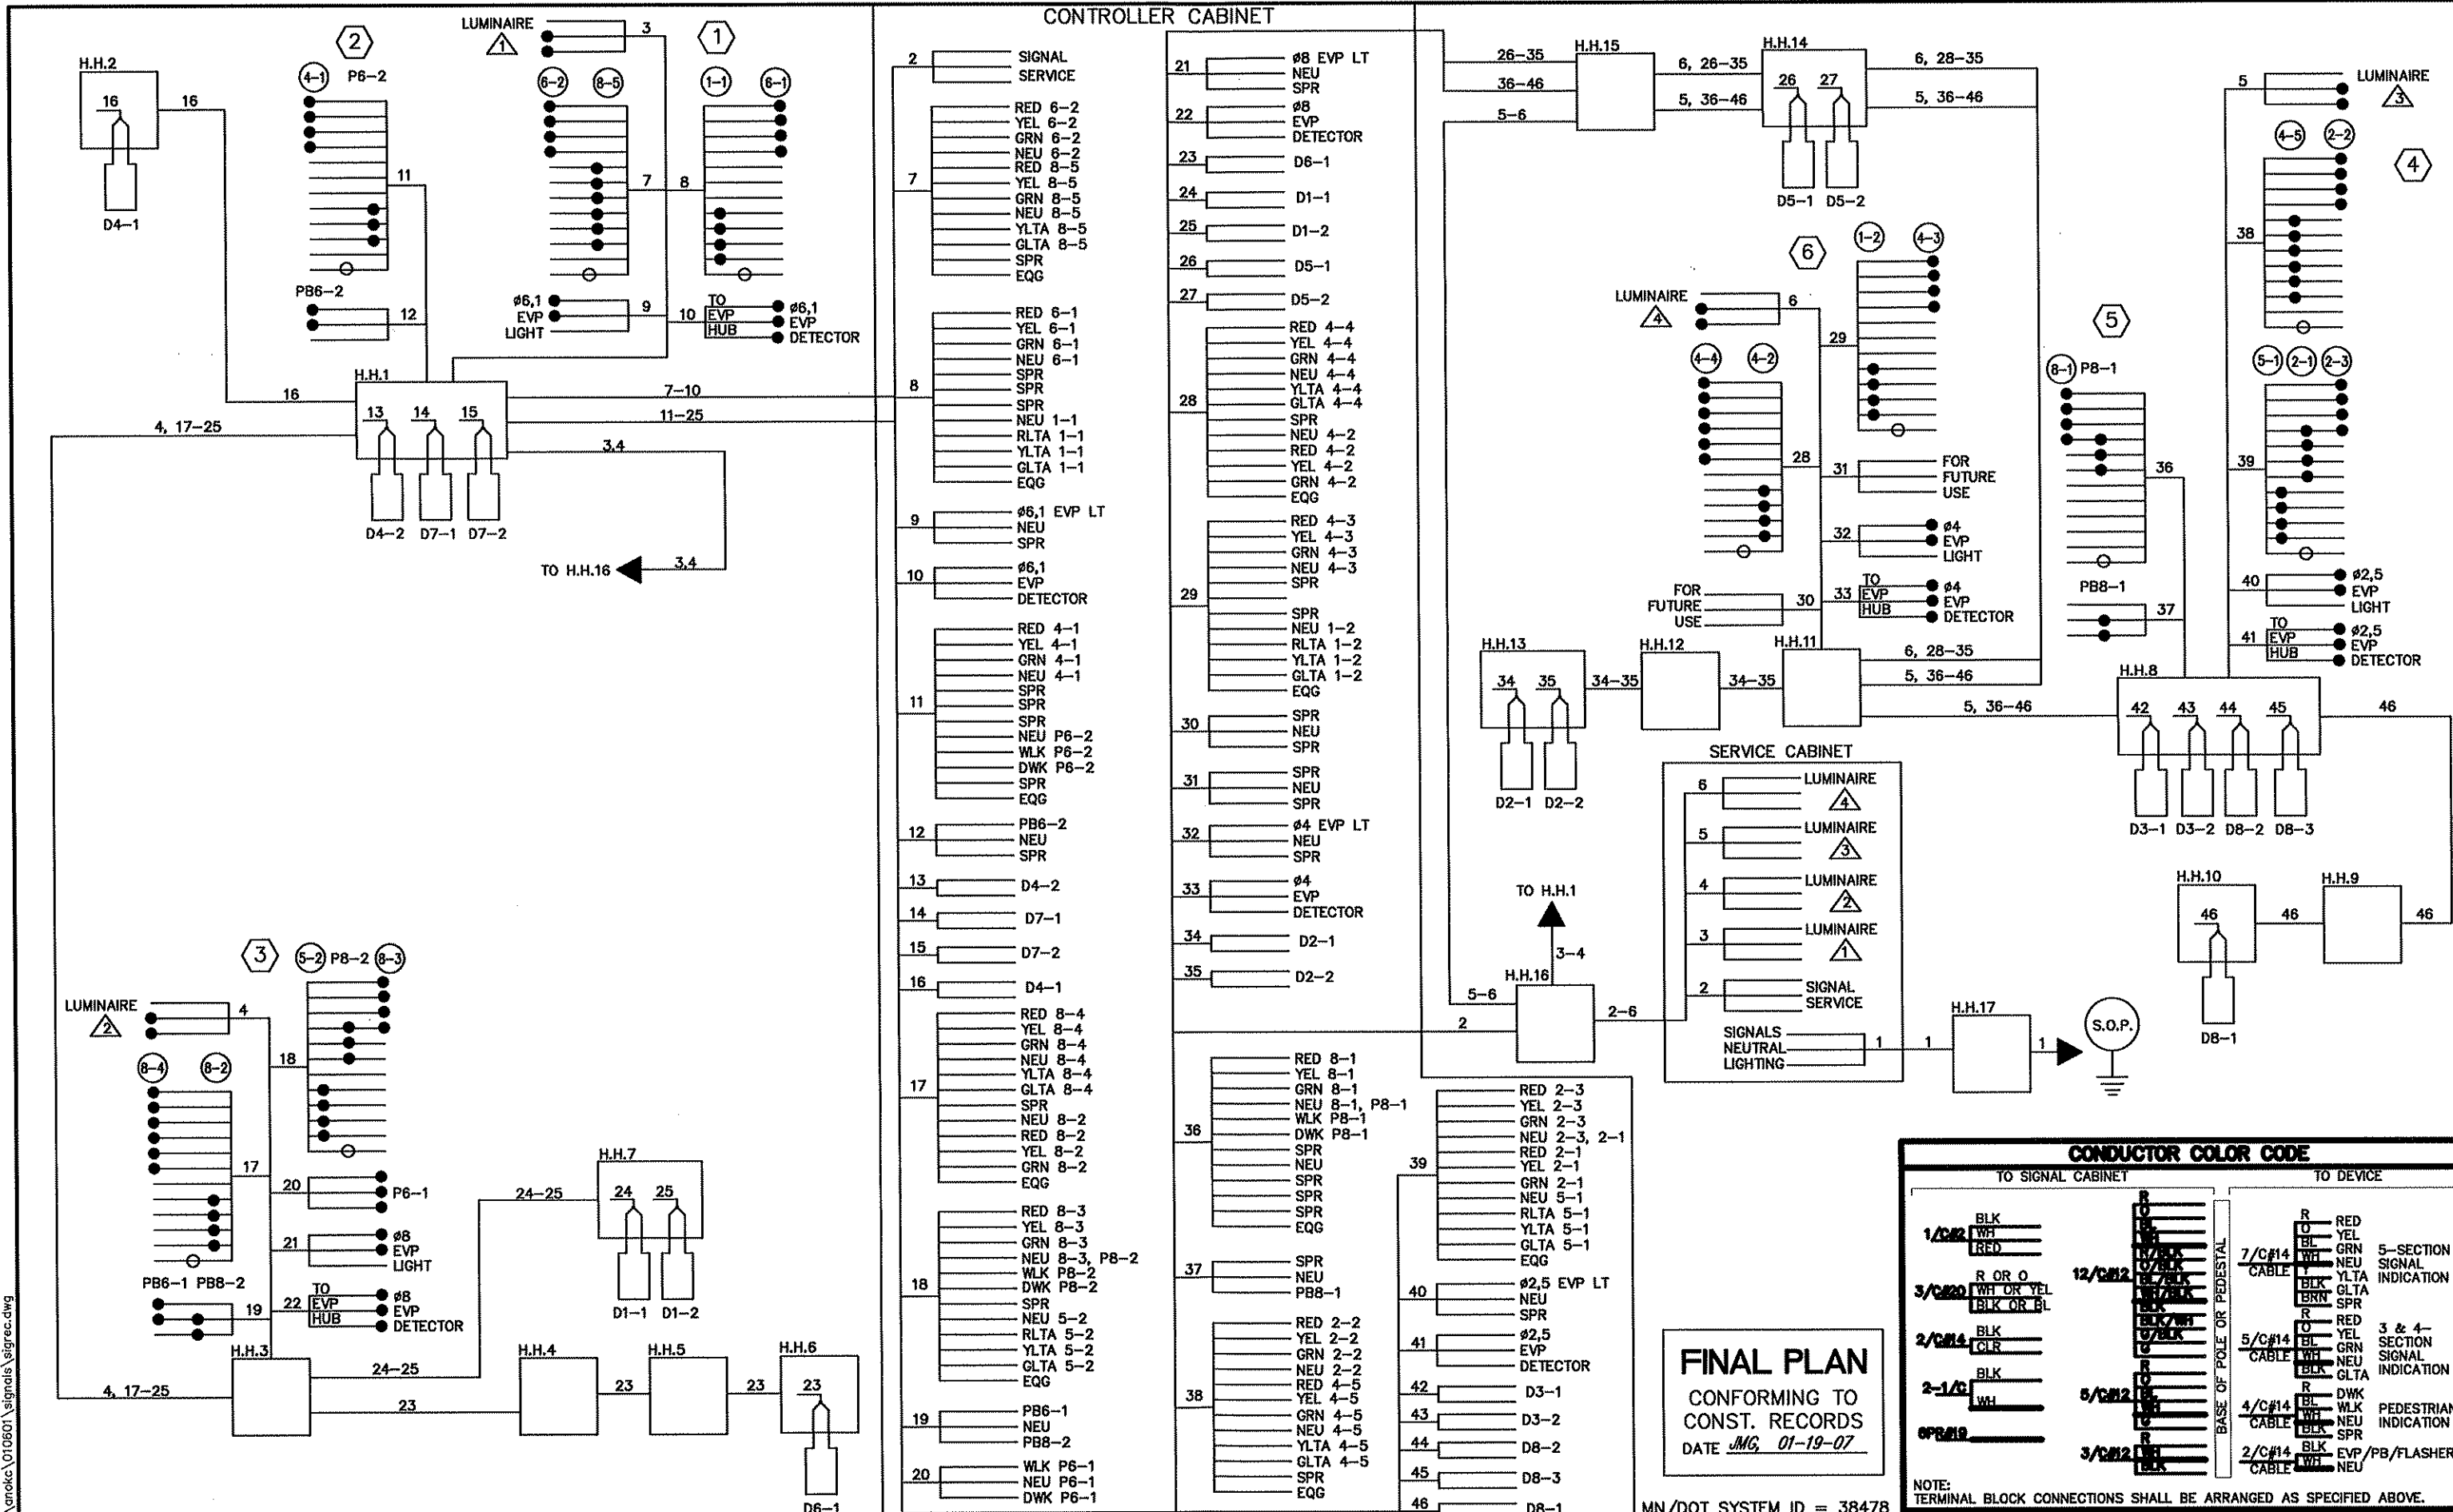

- CONTROLLER CABINET**
- 2 SIGNAL SERVICE
 - 7 RED 6-2, YEL 6-2, GRN 6-2, NEU 6-2, RED 8-5, YEL 8-5, GRN 8-5, NEU 8-5, YLTA 8-5, GLTA 8-5, SPR, EQG
 - 8 RED 6-1, YEL 6-1, GRN 6-1, NEU 6-1, SPR, EQG
 - 9 #6,1 EVP LT, NEU, SPR
 - 10 #6,1 EVP DETECTOR
 - 11 RED 4-1, YEL 4-1, GRN 4-1, NEU 4-1, SPR, EQG
 - 12 PB6-2, NEU, SPR
 - 13 D4-2
 - 14 D7-1
 - 15 D7-2
 - 16 D4-1
 - 17 RED 8-4, YEL 8-4, GRN 8-4, NEU 8-4, YLTA 8-4, GLTA 8-4, SPR, EQG
 - 18 RED 8-3, YEL 8-3, GRN 8-3, NEU 8-3, WLK PB-2, RED 8-2, YEL 8-2, GRN 8-2, EQG
 - 19 PB6-1, NEU, PB8-2, WLK P6-1, NEU P6-1, DWK P6-1
 - 20
 - 21 #8 EVP LT, NEU, SPR
 - 22 #8 EVP DETECTOR
 - 23 D5-1
 - 24 D1-1
 - 25 D1-2
 - 26 D5-1
 - 27 D5-2
 - 28 RED 4-4, YEL 4-4, GRN 4-4, NEU 4-4, YLTA 4-4, GLTA 4-4, SPR, EQG
 - 29 RED 4-3, YEL 4-3, GRN 4-3, NEU 4-3, SPR
 - 30 SPR, NEU 1-2, RLTA 1-2, YLTA 1-2, GLTA 1-2, EQG
 - 31 SPR, NEU, SPR
 - 32 #4 EVP LT, NEU, SPR
 - 33 #4 EVP DETECTOR
 - 34 D2-1
 - 35 D2-2
 - 36 RED 8-1, YEL 8-1, GRN 8-1, NEU 8-1, P8-1, DWK P8-1, NEU, SPR, EQG
 - 37 SPR, NEU, P88-1
 - 38 RED 2-2, YEL 2-2, GRN 2-2, NEU 2-2, RED 4-5, YEL 4-5, GRN 4-5, NEU 4-5, YLTA 4-5, GLTA 4-5, SPR, EQG
 - 39 RED 2-3, YEL 2-3, GRN 2-3, NEU 2-3, 2-1, RED 2-1, YEL 2-1, GRN 2-1, NEU 5-1, RLTA 5-1, YLTA 5-1, GLTA 5-1, EQG
 - 40 #2,5 EVP LT, NEU, SPR
 - 41 #2,5 EVP DETECTOR
 - 42 D3-1
 - 43 D3-2
 - 44 D8-2
 - 45 D8-3
 - 46 D8-1

FINAL PLAN
 CONFORMING TO
 CONST. RECORDS
 DATE JMG, 01-19-07

CONDUCTOR COLOR CODE

| TO SIGNAL CABINET | | TO DEVICE | |
|-------------------|-----|-----------|------|
| 1/C#12 | BLK | R | RED |
| | WH | BL | YEL |
| | RED | GRN | GRN |
| | | NEU | NEU |
| | | YLTA | YLTA |
| | | GLTA | GLTA |
| | | SPR | SPR |
| | | BLK | BLK |
| | | BLN | BLN |
| | | R | RED |
| | | BL | YEL |
| | | GRN | GRN |
| | | NEU | NEU |
| | | YLTA | YLTA |
| | | GLTA | GLTA |
| | | R | DWK |
| | | BL | WLK |
| | | GRN | GRN |
| | | NEU | NEU |
| | | YLTA | YLTA |
| | | GLTA | GLTA |
| | | R | RED |
| | | BL | YEL |
| | | GRN | GRN |
| | | NEU | NEU |
| | | YLTA | YLTA |
| | | GLTA | GLTA |
| | | R | RED |
| | | BL | YEL |
| | | GRN | GRN |
| | | NEU | NEU |
| | | YLTA | YLTA |
| | | GLTA | GLTA |
| | | R | RED |
| | | BL | YEL |
| | | GRN | GRN |
| | | NEU | NEU |
| | | YLTA | YLTA |
| | | GLTA | GLTA |

NOTE: TERMINAL BLOCK CONNECTIONS SHALL BE ARRANGED AS SPECIFIED ABOVE.

| DESIGN TEAM | 1 | JMG | 10/21/05 | REVISED PER STATE COMMENTS |
|-------------|-----|------|-----------|----------------------------|
| DRAWN BY: | JMG | JMG | 3/16/06 | COUNTY, STATE COMMENTS |
| DESIGNER: | JMG | JMG | 01/19/07 | RECORD DRAWING |
| CHECKED BY: | JMG | | | |
| NO. | BY | DATE | REVISIONS | |

I hereby certify that this plan was prepared by me or under my direct supervision and that I am a duly Licensed Professional Engineer under the laws of the State of Minnesota.

Printed Name: JOHN M. GRAY Lic. No. 22457 Date: 03/16/08



ANOKA COUNTY, MINNESOTA
 INTERSECTION IMPROVEMENTS:
 CSAH 23 @ INTERSTATE HIGHWAY 35W

TRAFFIC SIGNAL SYSTEM
 FIELD WIRING DIAGRAM
 CSAH 23 (LAKE DRIVE) AT NAPLES STREET
 STATE PROJECT NO. 02-623-014

| | |
|-------------|----------|
| FILE NO. | 54 |
| ANCKC0108.0 | |
| DATE | 03/16/06 |
| | 57 |