


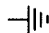
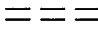
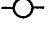
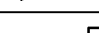
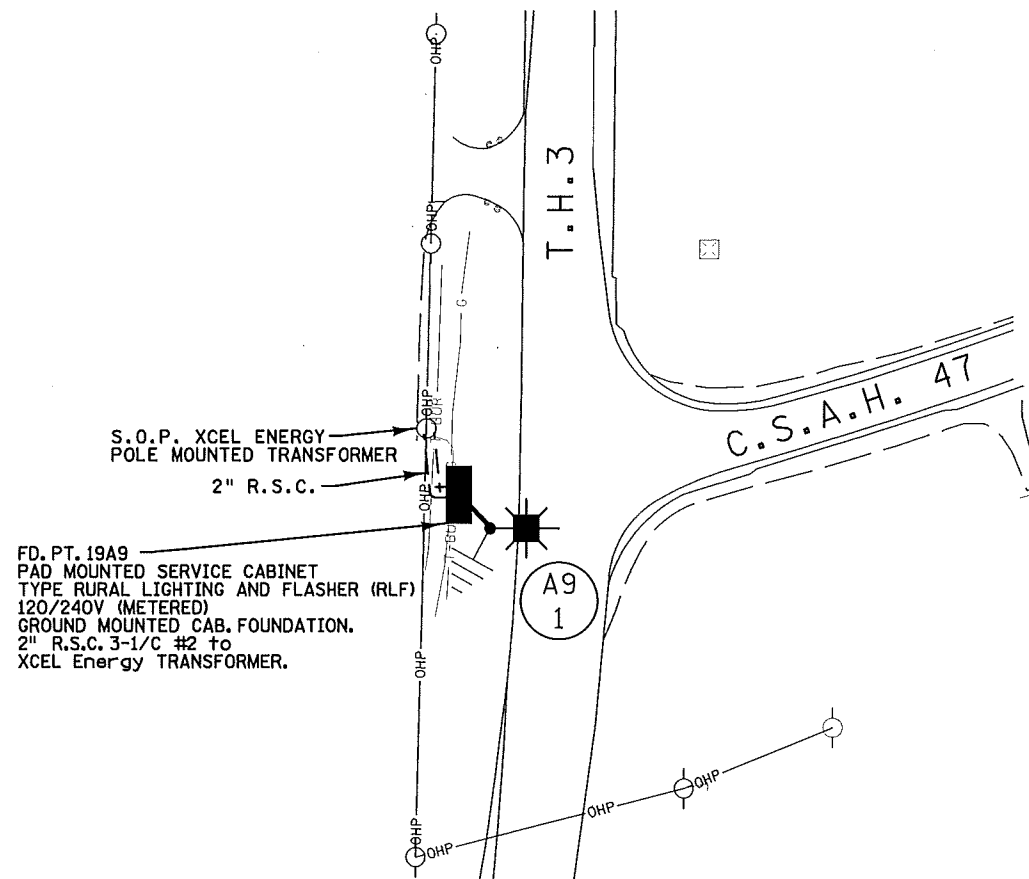
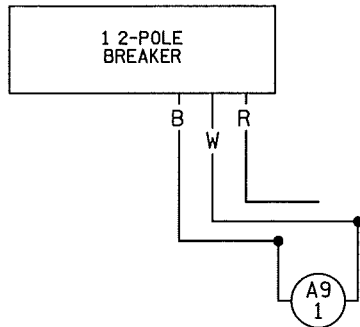


LEGEND

-  LIGHTING UNIT
-  PAD MOUNTED FD. PT. CABINET 120/240 VOLT
-  DIRECT BURIED CABLE 4 CONDUCTOR NO. 4
-  PERMANENT GROUND ROD (25 OHMS OR LESS)
-  2" RIGID STEEL CONDUIT (R.S.C.)
-  INPLACE POWER POLE
-  OVERHEAD POWER LINES

UTILITY OWNERSHIP	
OVERHEAD ELECTRIC — OHP —	XCEL ENERGY
BURIED GAS — G —	XCEL ENERGY
BURIED TELEPHONE — T-BUR —	CENTURYLINK

B AND R DENOTE CURRENT CARRYING CONDUCTORS
W DENOTES NEUTRAL CONDUCTOR
FD. PT. 19A9
120/240 VOLT



FEEDPOINT 19A9
LIGHTING STANDARDS AND FOUNDATIONS

NO.	STATION	LT.	RT.	LOCATION	TYPE
1	AS SHOWN		X	SB TH 13	9-40 LED

PLOTTED/REVISED: 2/5/2015

DISTRICT #: METRO
PLOT NAME: 18825-389-AS_BUILT
PATH & FILENAME: IP_FWP-d1562293V8825-389-AS_BUILT.dgn

BY: EK	DATE: 02/2015	REVISIONS: ASBUILTS: MOVED LIGHT POLE	FEEDPOINT: 19A9	LOCATION: T.H. 3 at C.S.A.H. 47	LIGHTING PLAN
			METER ADDRESS: 32297 MINNESOTA 3, NORTHFIELD 55057		
DRAWN BY: PB CKD BY: GB DATE: 10/2013			CERTIFIED BY: <i>Michael P. Gubinsky</i> LIC. NO. 19863 DATE: 2/5/2015		STATE PROJ. NO. 8825-389
					SHEET NO. 4 OF 13 SHEETS