



CONSTRUCTION PROJECT LOG

Prepared by
Office of Transportation System Management

Last updated on: 10-7-2022

Control Section 3007

TRUNK HIGHWAY: MN95

COUNTY: Isanti

DISTRICT: 3 (Brainerd)

LIMITS:
Cambridge MSAS-113 to Isanti-Chisago County Line
Ref. Pt. 041+00.695 - 052+01.046


NOTES: CONTROL SECTION NOTES FROM SDW

Symbology:

Stick Map Legend				
Highway	State-Aid	Non State-Aid	City Limit	Bridge

DISCLAIMER: If you encounter broken hyperlinks, please fill out Data Practice Form:

<http://www.dot.state.mn.us/information/datapractices/index.html>

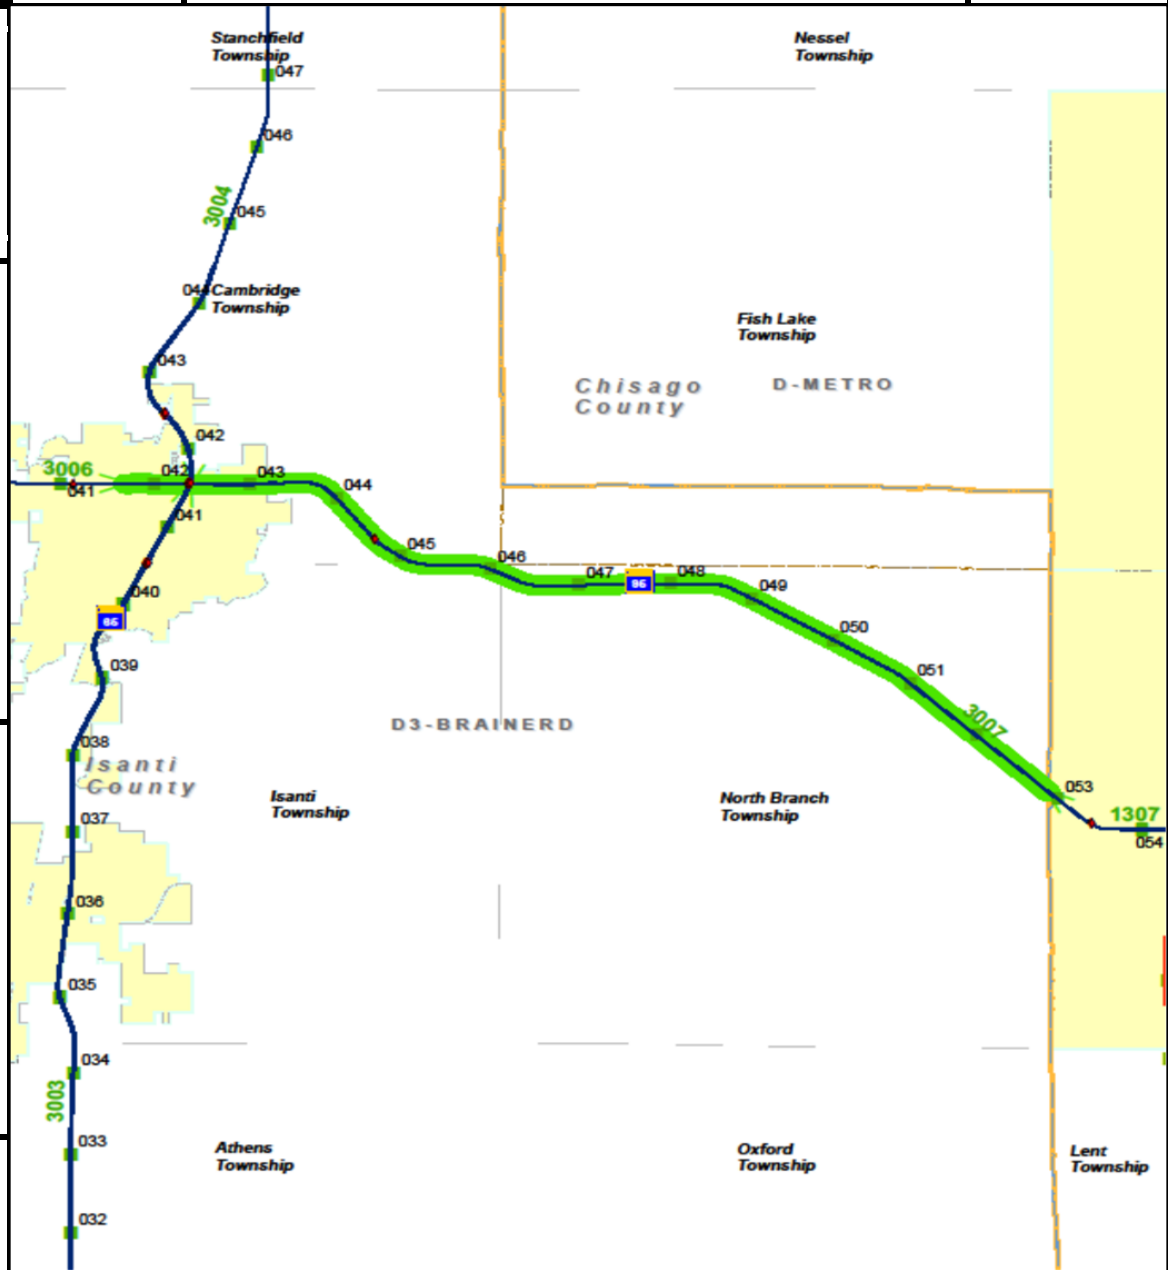


PREPARED BY
HIGHWAY PLANNING SURVEY
IN COOPERATION WITH
U.S. PUBLIC ROADS ADMINISTRATION


STATE OF MINNESOTA
DEPARTMENT OF HIGHWAYS
ROAD LIFE STUDIES
CONSTRUCTION PROJECT LOG RECORD

CONTROL SECTION 3007
TRUNK HIGHWAY 95
COUNTY Isanti
DISTRICT 3B

LMNTS: Jct. T.H. 85 in Cambridge - E. Co. Line.

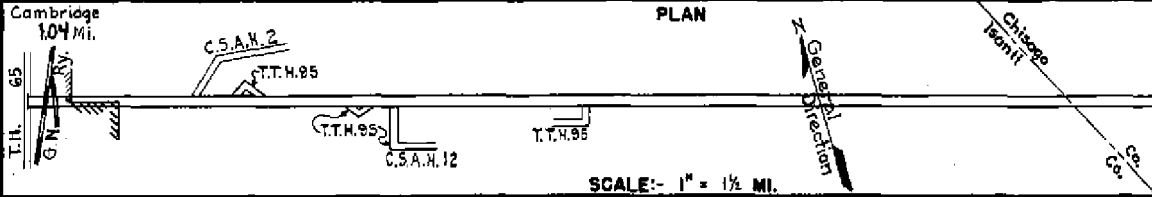

YEAR BUILT	PROJECT N°	DESCRIPTION			CODE N°
		TYPE	WIDTH	THICK-NESS	
					No Record of Constr.
		Gravel	22'	1'-2"	
		Grading	24'		Added in 1934.
1925		Gravel	22'	3 1/2"	1800 C.Y. / Mile. Added in 1934.
		Grading	24'		Co. Job 2604.
1926		Gravel	22'	3 1/2"	1800 C.Y. / Mile. Added in 1934.
		Grading	40'		
1937	A.F.E. 48	Gravel	40'	1"	Maint. Dept.
		Grading	32'		
1938	3007-03 (1)	Gravel	32'	5/8"	Maint. Dept.
		Grading	32'		
1939	3007-04	Gravel	32'	1"	
		Mixed Bitum.	22'	1"	
1939	A.F.E. 37				Maint. Dept.
		Seeding			
1940	3007-06 A.F.E. 4				Maint. Dept.
		Sand Lift.		3"	
1940	A.F.E. 56	Mixed Bitum.	24'	1"	
					Maint. Dept.
		Spot Treat.			MC-3, 1527 Gal. / Mi.
1942	A.F.E. 4	Bit. Surf. Repair			Grav. 291 C.Y. / Mi. Maint. Dept.
		Regraveling & Spot Gray Lifts			1180 C.Y. / Mi. Maint. Dept.
		Spot Treat.			MC-3, 474 Gal. / Mi.
1943	A.F.E. 4	Bit. Surf. Repair	236		Grav. 42 C.Y. / Mi. Maint. Dept.
		Spot Treat.			MG-2, 2144 Gal. / Mi.
1944	A.F.E. 4	Bit. Surf. Treat.	267		Agg. 92 C.Y. / Mi. Maint. Div.
		Spot Treat.			RT-6, 1068 Gal. / Mi.
1945	A.F.E. 4	Bit. Surf. Repair	26		Grav. 48 C.Y. / Mi. Maint. Div.

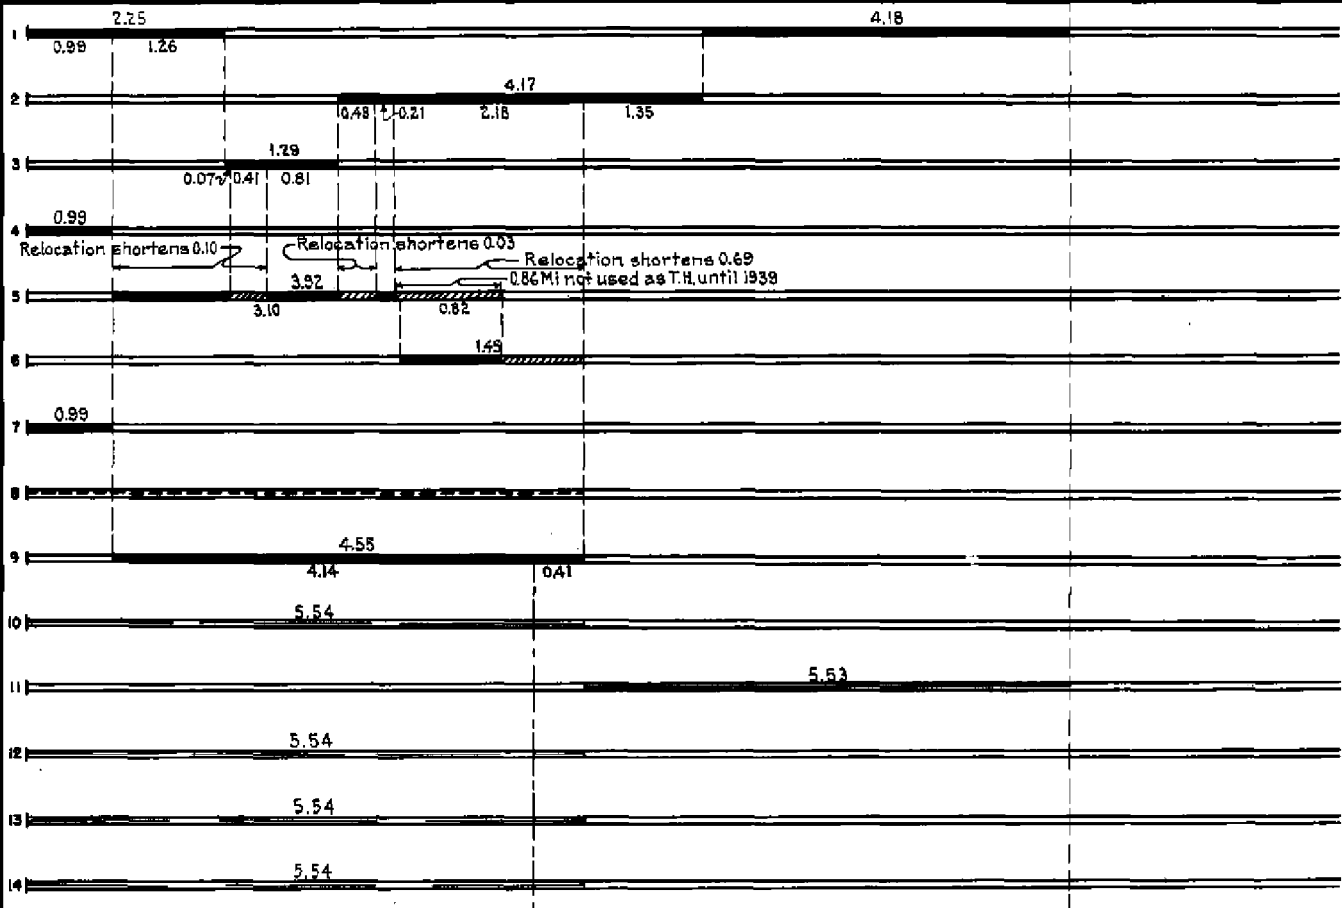

YEARS FROM	TO	TOTAL MILES	UNINCORPORATED		INCORPORATED		RURAL		URBAN	
			RDWY. MI.	BR. MI.	RDWY. MI.	BR. MI.	RDWY. MI.	BR. MI.	RDWY. MI.	BR. MI.
1934	1937	11.89	11.40	0.00	0.49	0.00	11.40	0.00	0.49	0.00
1938	1938	11.76	11.27	0.00	0.49	0.00	11.27	0.00	0.49	0.00
1939	1942	11.07	10.58	0.00	0.49	0.00	10.58	0.00	0.49	0.00
1947	1962	11.33	10.84	0.00	0.49	0.00	10.84	0.00	0.49	0.00
1963	1973	11.14	10.65	0.00	0.49	0.00	10.65	0.00	0.49	0.00
1974		11.14	10.10		1.04		10.10		1.04	

REMARKS: Layout is to scale as of 1934.


(1) 1938 A.F.E. 40 & 1939 A.F.E. 36 & 39

PREPARED BY
HIGHWAY PLANNING SURVEY
IN COOPERATION WITH
U.S. PUBLIC ROADS ADMINISTRATION


STATE OF MINNESOTA
DEPARTMENT OF HIGHWAYS
ROAD LIFE STUDIES
CONSTRUCTION PROJECT LOG RECORD

CONTROL SECTION 3007
TRUNK HIGHWAY 95
COUNTY Isanti
DISTRICT 3B

LIMITS: Jct. T.H. 65 in Cambridge - E. Co. Line

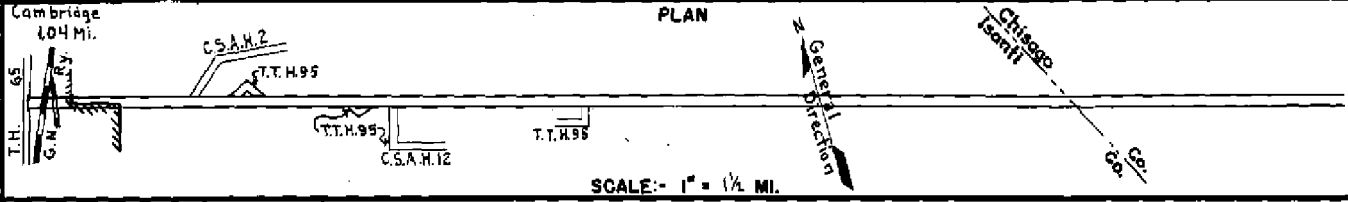

YEAR BUILT	PROJECT N°	DESCRIPTION			CODE N°
		TYPE	WIDTH	THICKNESS	
M 1946	A.F.E. 4	Spot Treat. Bit. Surf. Repair	16'		RT-6, 4187 Gal. Agg. 109 C.Y.
M 1947	A.F.E. 4	Spot Treat. Bit. Surf. Repair	24'		SC3&MC-3, 20222 Gal. Agg. 1021 C.Y.
C 1947	3007-08	Grading Stab. Gravel	32'	14"	1200 C.Y./MI.
C 1947	A.F.E. 50	Bit. Surfacing Bit. Surf. Treat. (Mixed Prime)	24'		SC-3, 7691 Gal.
M 1948	A.F.E. 4	Spot Treat. Bit. Surf. Repair	24'		SC-3, 9434 Gal. Agg. 623 Tons
C 1948	3007-09	Gravel Base Mixed Bit.	32'	6"-12" 12"	
M 1949	A.F.E. 4	Spot Treat. Bit. Surf. Repair Bit. Fog Seal	25'		MC3&RC-0, 25506 Gal. Agg. 1765 Tons
M 1950	A.F.E. 4	Spot Treat. Bit. Surf. Repair	24'		SC4, 6448 Gal. Agg. 340 C.Y.
M 1951	A.F.E. 4	Spot Treat. Bit. Surf. Repair	24'		SC-3, 6729 Gal. Agg. 404 C.Y.
M 1952	A.F.E. 4	Spot Treat. Bit. Surf. Repair	24'		SC4, 6222 Gal. Agg. 408 C.Y.
M 1954	A.F.E. 605	Fog Seal Coat Light Bit. Seal	24'		RC2&MC1, 11404 Gal. Agg. 324 C.Y.
C 1954	A.F.E. 820	Bit. Resurfacing Mixed Bit.	24'	1" added	SC4, 37938 Gal. Agg. 3423 Tons
M 1955	A.F.E. 604	Spot Treat. Bit. Surf. Repair	24'		SC-4, 7743 Gal. Agg. 665 Tons
C 1955	3007-11	Bit. Stab. Base Plant Mix Bit.	44'	6" 3"	

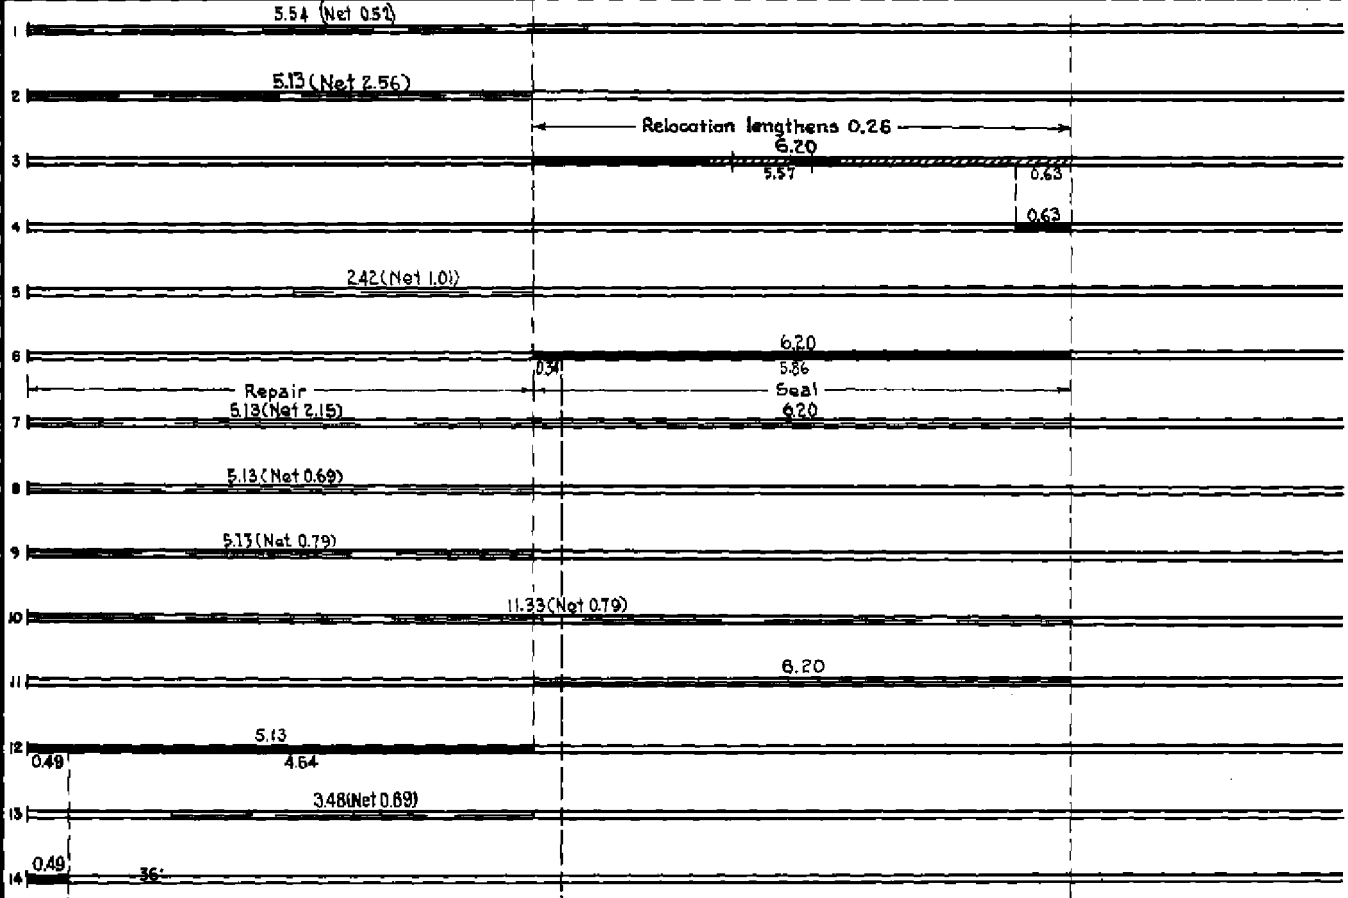


YEARS FROM	TOTAL TO	MILES	UNINCORPORATED		INCORPORATED		RURAL		URBAN		REMARKS
			RDWY. MI.	BR. MI.	RDWY. MI.	BR. MI.	RDWY. MI.	BR. MI.	RDWY. MI.	BR. MI.	
											See Sheet No. 1

PREPARED BY
HIGHWAY PLANNING SURVEY
IN COOPERATION WITH
U.S. PUBLIC ROADS ADMINISTRATION


STATE OF MINNESOTA
DEPARTMENT OF HIGHWAYS
ROAD LIFE STUDIES
CONSTRUCTION PROJECT LOG RECORD

CONTROL SECTION 3007
TRUNK HIGHWAY 95
COUNTY Isanti
DISTRICT 3B

LIMITS: Jct. T.H. 65 in Cambridge - E. Co. Line
Ref. Pts. 42+00.385 - 52+01.045

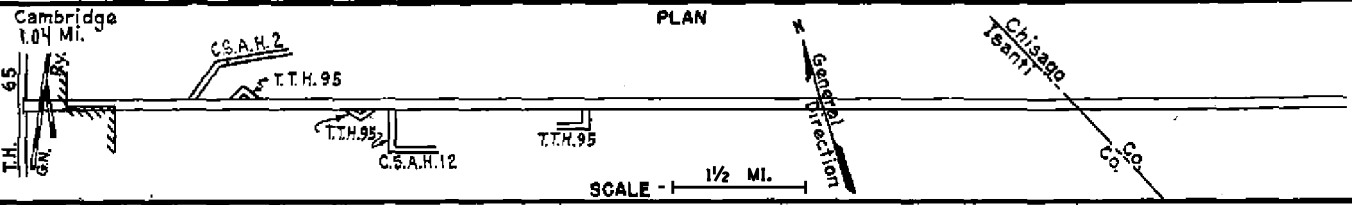

YEAR BUILT	PROJECT N ^o	DESCRIPTION				CODE N ^o
		TYPE	WIDTH	THICKNESS	REMARKS	
M	1957 A.F.E. 604	Spot Treat. Bit. Surf. Repair	24'		SC-4, 13874 Gal. Agg. 833 Tons	
M	1958 A.F.E. 822 A.F.E. 604	Spot Grade Lifts Spot Treat. Bit. Surf. Repair	30' 24'		Gravel 602 Tons SC-4, 7467 Gal. Bit. Mix 672 Tons	
M	1959 A.F.E. 605	Bit. Seal Coat	25'		RS-2K, 19325 Gal. Agg. 695 C.Y.	
M	1963 c	Light Bit. Seal	26'		RS-2K, 9414 Gal. Agg. 360 c.y.	
C	1963 3007-17	Grading Sub-base Plant Mix Bit. (Base)		12" 1"	Sub-base is 9" sand gravel & sandy bit. & 3" Road mix bit.	
C	1971 3007-16	Grading Agg. Base Bit. Base Plant Mix Bit Surf	30' 25' 24'	18" 1 1/2" 3"	691 Mi. Bit. Overlay 3.74 Mi. Reconstruct Gravel Should. 9' RT<	
C	1979 3007-18	Bituminous Surface	47'	1 1/2"	Sp 2341	
M	1983 3007	Bituminous Overlay Turn Lanes Agg & Bit. Shoulders	28' 12' 6'	1 1/2" 1 1/2" 1 1/2"	Sp 2331, 2958.7 Ton 295.8 T. Bit., 803.6 Agg.	
C	1989 3007-21	Mill & Bit. Overlay	24'	2 1/2"	Spec 2341, 2361	
M	1990 M4398	Bit. Crack Repair				
C	1997 3007-22	Grading Surfacing Bituminous	35' 31' 27'	18" 18" 7"	Spec. 2331, 2341	
M	2000 8823-11	Aggregate Seal				
S	2004 3006-33	Milling Bit. Overlay	36' 36'	1.75' 1.75'	Spec. 2360	
R	2009 3007-32	Grading Milling Bit. Overlay	24' 24'	3' var	Spec. 2360	

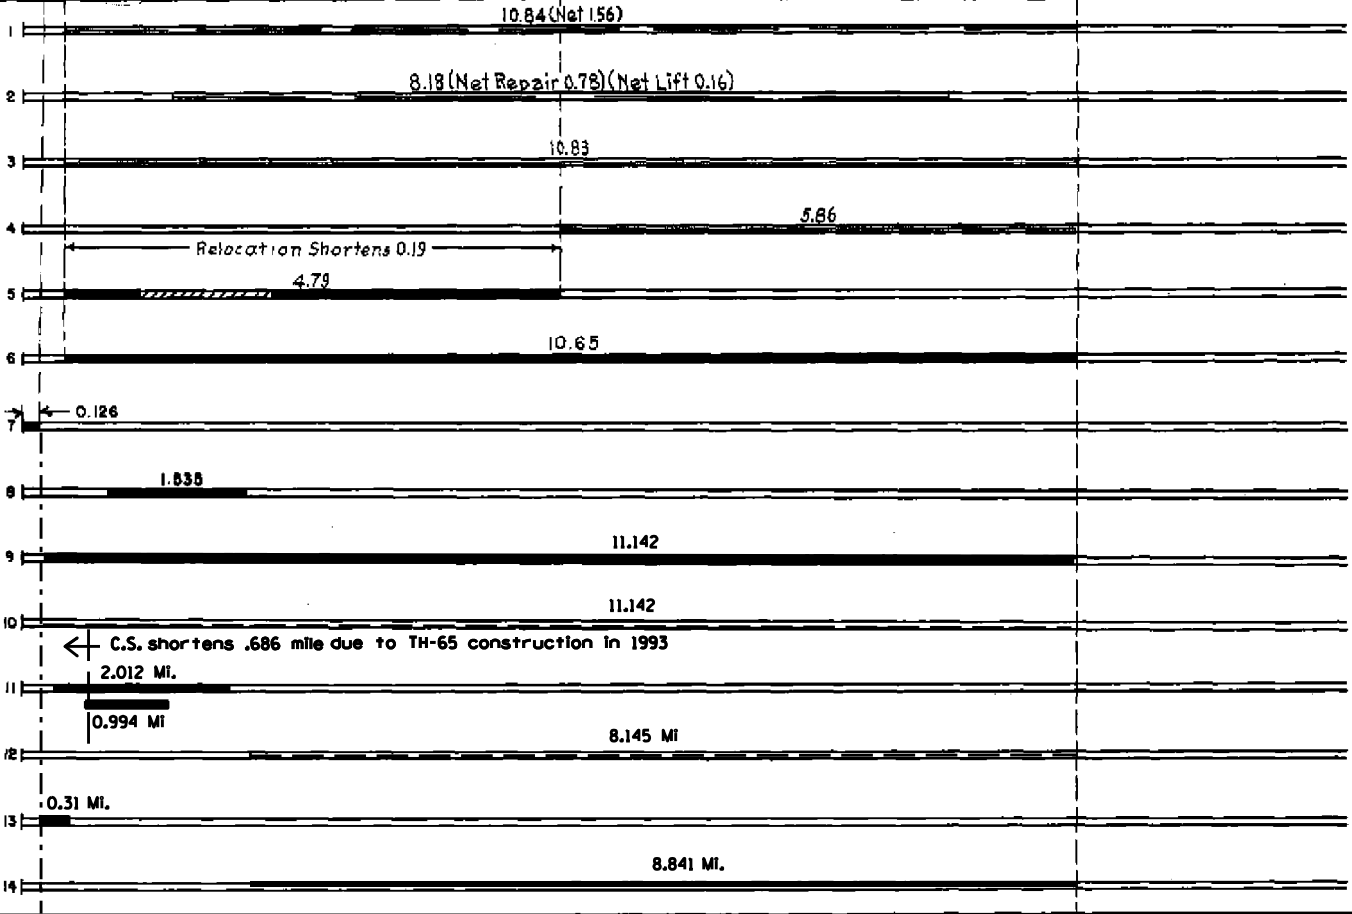

YEARS FROM	TOTAL TO	UNINCORPORATED		INCORPORATED		RURAL		URBAN	
		RDWY. MI.	BR. MI.	RDWY. MI.	BR. MI.	RDWY. MI.	BR. MI.	RDWY. MI.	BR. MI.

REMARKS: See Sheet No. 1
C.S. shortens due to the Cambridge by-pass construction in 1993.
(3003-19, 3004-34)

