



CONSTRUCTION PROJECT LOG

Prepared by
Office of Transportation System Management

Last updated on: 10-7-2022

Control Section 7323

TRUNK HIGHWAY: MN238

COUNTY: Stearns

DISTRICT: 3 (Brainerd)

LIMITS:
Stearns-Morrison County Line to JCT S RAMPS I-94
Ref. Pt. 000+00.000 - 012+00.904


NOTES: CONTROL SECTION NOTES FROM SDW

Symbology:

Stick Map Legend				
Highway	State-Aid	Non State-Aid	City Limit	Bridge
			■ ■ ■ ■ ■ ■ ■ ■	◆

DISCLAIMER: If you encounter broken hyperlinks, please fill out Data Practice Form:

<http://www.dot.state.mn.us/information/datapractices/index.html>

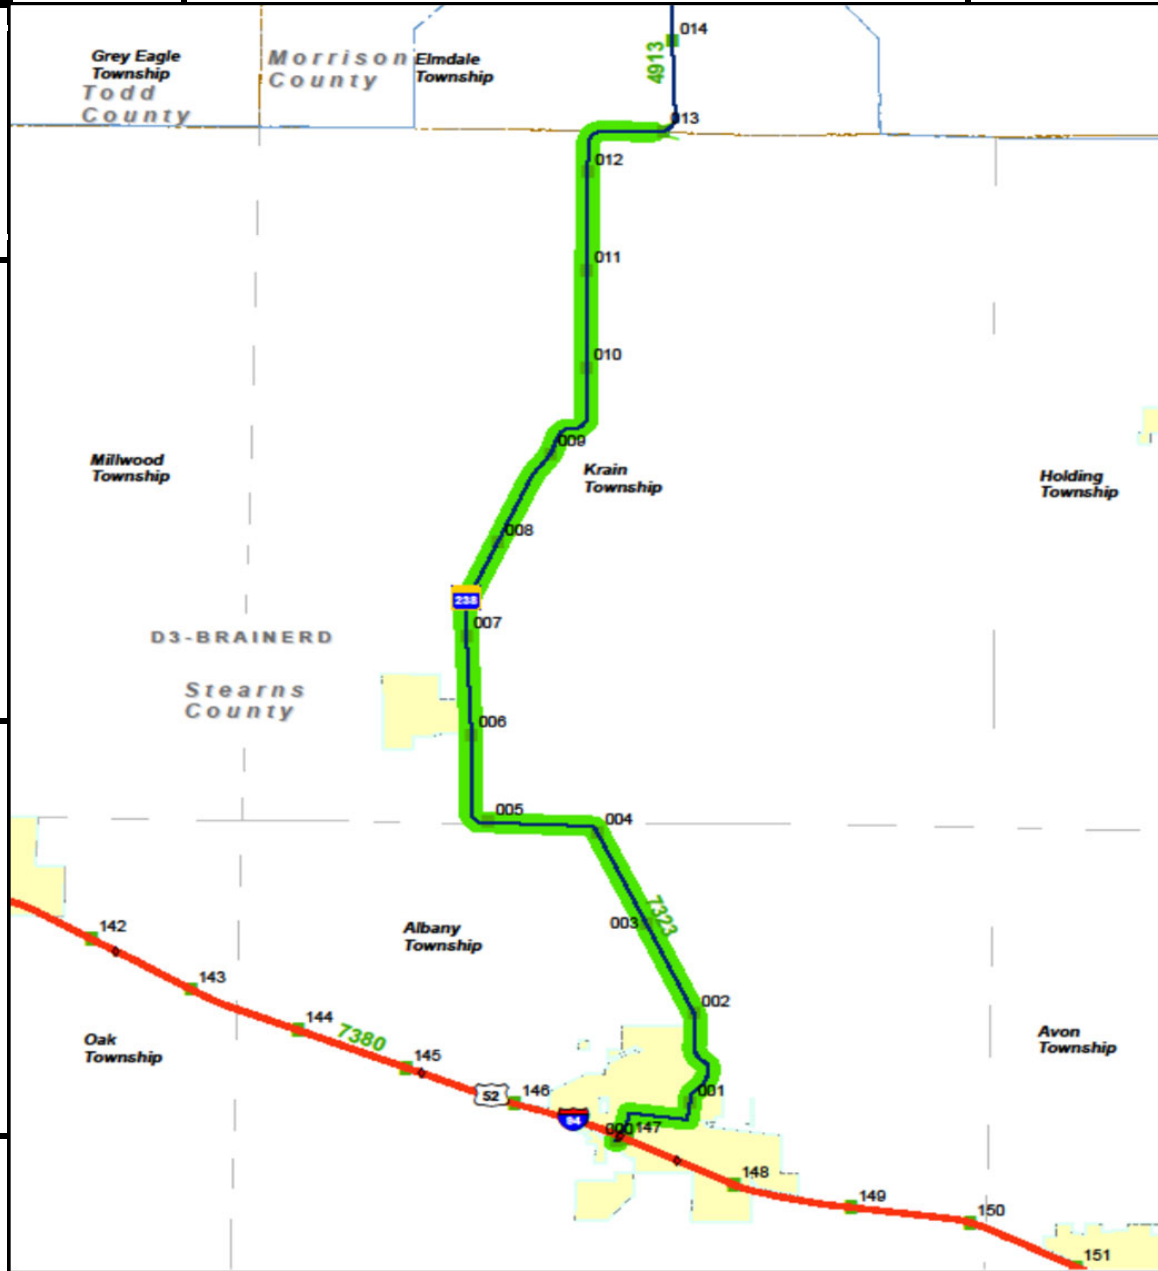


PREPARED BY
HIGHWAY PLANNING SURVEY
IN COOPERATION WITH
U.S. PUBLIC ROADS ADMINISTRATION


STATE OF MINNESOTA
DEPARTMENT OF HIGHWAYS
ROAD LIFE STUDIES
CONSTRUCTION PROJECT LOG RECORD

CONTROL SECTION 7323
TRUNK HIGHWAY 238
COUNTY Stearns
DISTRICT 3B

LIMITS: Jct. T.H. 52 - N. Co. Line

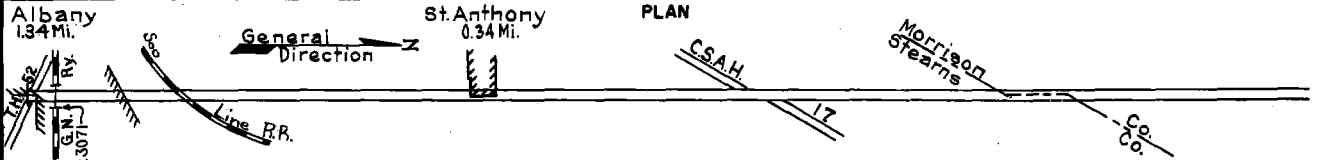

YEAR BUILT	PROJECT N°	DESCRIPTION		REMARKS	CODE N°
		TYPE	WIDTH THICKNESS		
		Gravel	24"	No Record of Const. Added in 1949	
M	1951 A.F.E. 6	Grav. Resurfacing	24"	3595 C.Y.	
M	1952 A.F.E. 6	Grav. Resurfacing	27"	11284 Tons	
	A.F.E. 28	Spot Sand-Grav Lifts		Lifts from MP 055-0.86	
C	1950 City	Grading	44"		
		Stab. Gravel Base	44"		
		Hot Plant Mix	44"		
C	1954 A.F.E. 833	Bit. Surfacing	24"	SC-4, 126320 Gal.	
		Mixed Bit.	24" 1-1/2"	Agg. 9487 Tons	
		Relay Port. Culv's		Spot Grav. Lifts	
M	1955 A.F.F. 604	Spot Treat.	24"	SC-4, 31179 Gal.	
		Bit. Surf. Repair	24"	Agg. 2891 Tons	
C	1956 A.F.E. 817	Gravel Base	28" 0'-9"	MC-01 SC-4, 109168 Gal.	
		Bit. Surfacing		Agg. 8192 Tons	
		Mixed Bit. (Mixed Pr.)	24" 1"		
C	A.F.F. 828	Grading	36"		
1956	A.F.E. 829	Gravel Base	36" 8 1/2"	Grav. 2814 Tons	
		Br. 3071 (In place)	25"	B.S.-U.P.	
1926	52-3-45-3	Concrete	8-8 1/2"	Transferred from C.S. 7311 (T.H. 52) in 1956	
C	1957 A.F.E. 829	Bit. Stab. Base	36" 2 1/2"	Added thickness	
		Mixed Bit.	24" 1"	Bit. 6212 Gal. Surr. Agg. 217 Tons	
M	1958 A.F.F. 605	Bit. Seal Coat	25"	RG-2, 23072 Gal. Agg. 901 C.Y.	
M	1963	Light Bit. Seal	24"	RS-2K, 21061 Gal. Agg. 828 C.Y.	
C	1970 7323-00	Bit. Seal Coat	24" 5/8"		
C	1977 7323-05	Bit. Resurfacing	24" 2 1/2"		
		Agg. Shoulders	4 1/2" Yes		

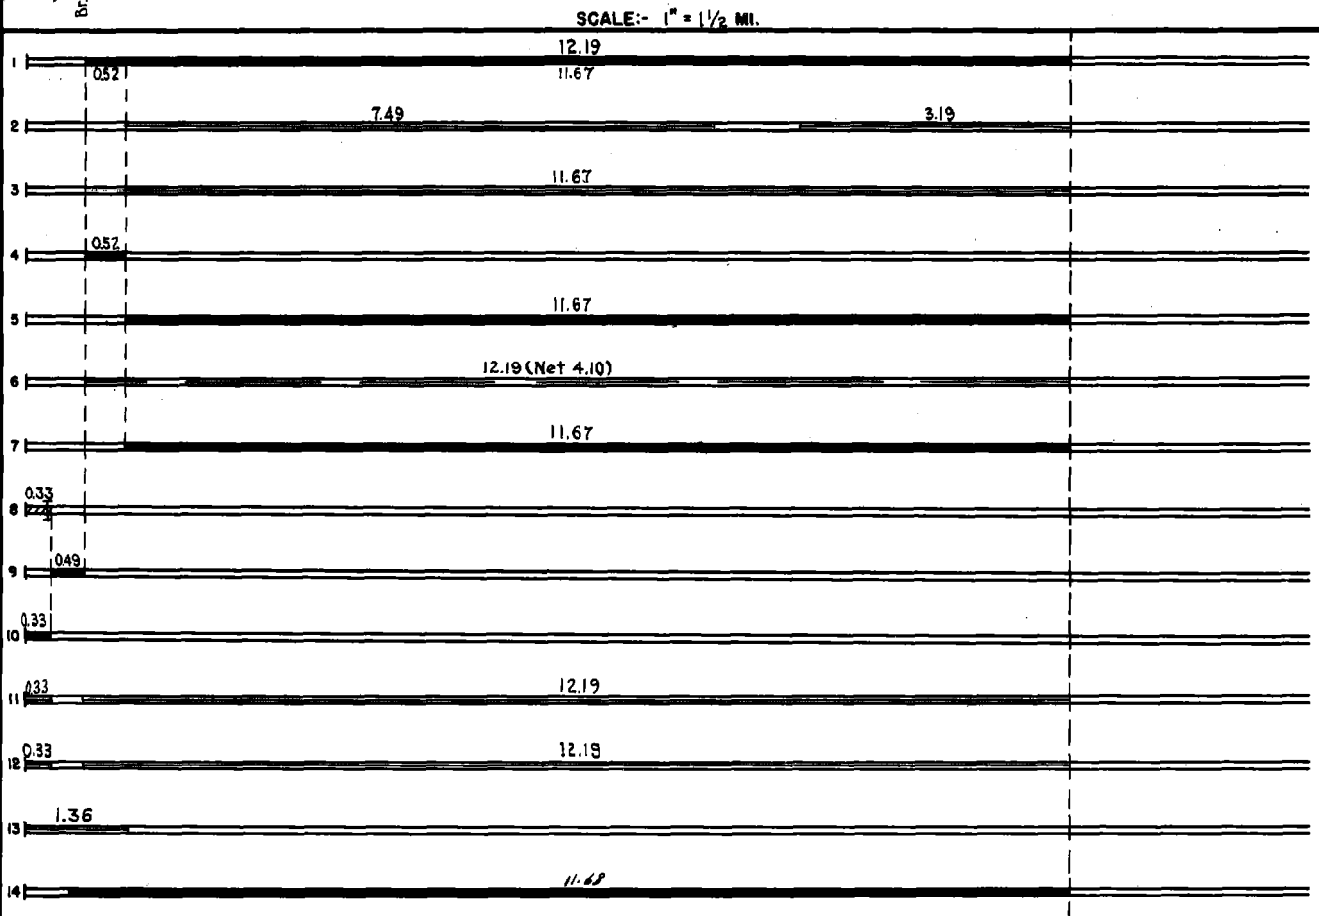

YEARS		TOTAL MILES	UNINCORPORATED		INCORPORATED		RURAL		URBAN	
FROM	TO		RDWY. MI.	BR. MI.	RDWY. MI.	BR. MI.	RDWY. MI.	BR. MI.	RDWY. MI.	BR. MI.
1949	1950	12.19	11.52	0.00	0.67	0.00	12.19	0.00	0.00	0.00
1951	1955	12.19	11.31	0.00	0.88	0.00	11.65	0.00	0.54	0.00
1956	1965	13.01	11.4	0.00	1.60	0.00	11.75	0.00	1.24	0.00
1966		13.01	11.33	0.00	1.68	0.00	11.67	0.00	1.34	0.00

REMARKS: Layout is to scale as of 1949

