



**Map of CS# LIMITS:**

0 1/2 1 2  
Mile

**CONSTRUCTION PROJECT LOG**

Prepared by

Office of Transportation System Management

Last updated on: 10-12-2022

**Control Section** 8680

**TRUNK HIGHWAY:** 194

**COUNTY:** Wright

**DISTRICT:** 3 (Brainerd)

**LIMITS:**  
W End BR-27942 to Stearns-Wright County Line  
Ref. Pt. 178+00.163 - 205+00.392


**NOTES:** CONTROL SECTION NOTES FROM SDW

**Symbology:**

| Stick Map Legend |           |               |            |        |
|------------------|-----------|---------------|------------|--------|
| Highway          | State-Aid | Non State-Aid | City Limit | Bridge |
|                  |           |               |            |        |

**DISCLAIMER:** If you encounter broken hyperlinks, please fill out Data Practice Form:

<http://www.dot.state.mn.us/information/datapractices/index.html>

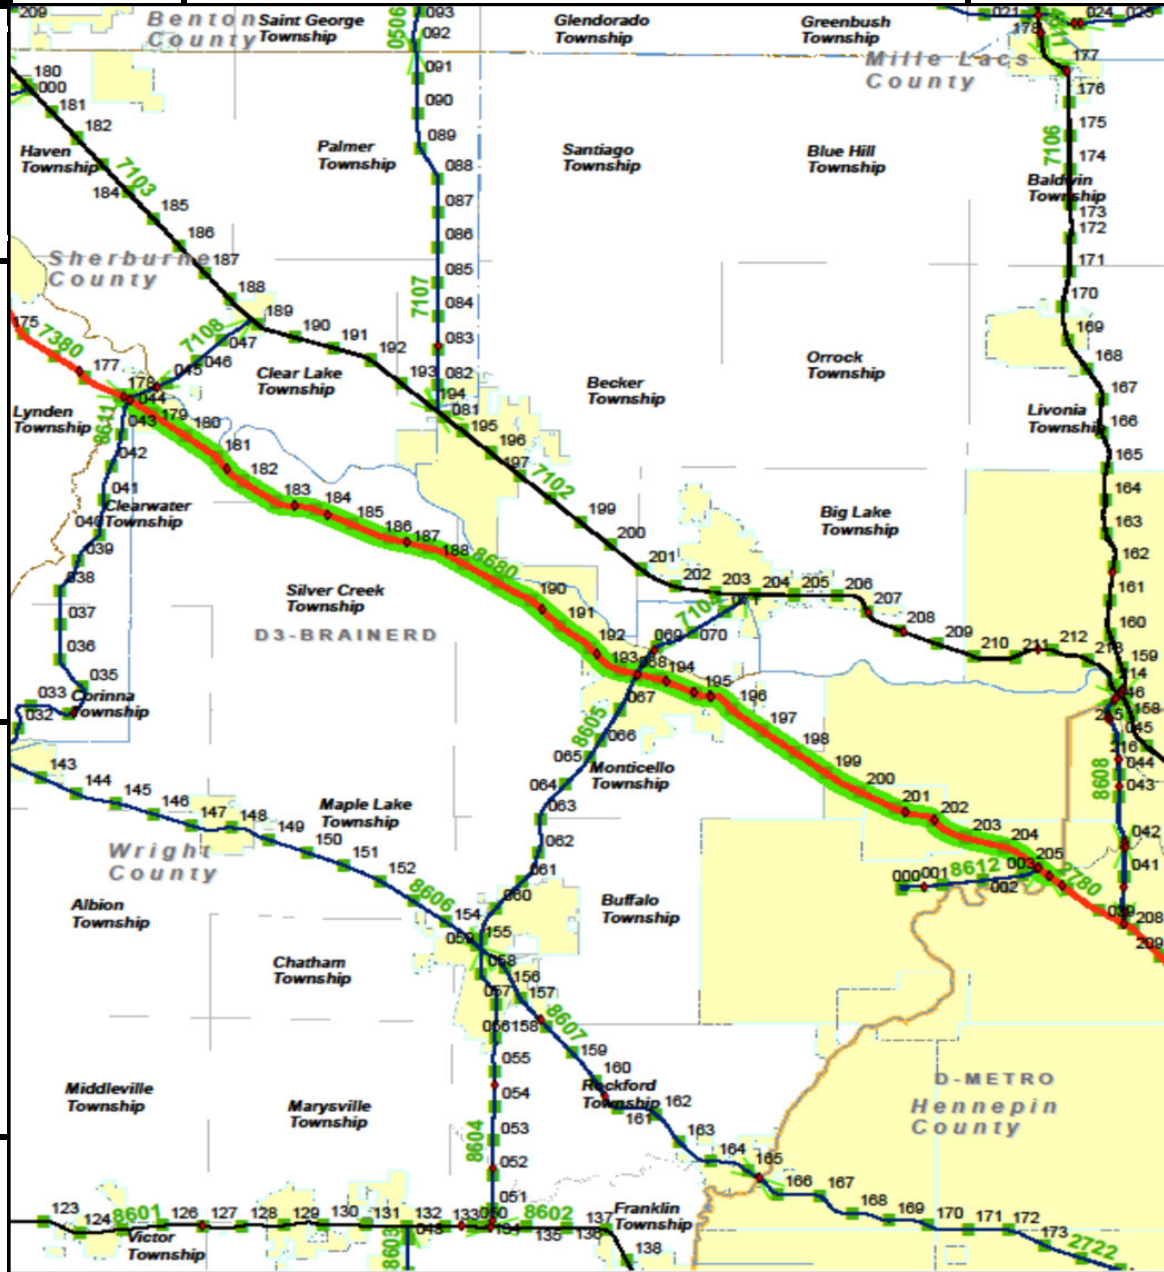


PREPARED BY  
TRANSPORTATION & TRANSIT PLANNING & PROGRAMMING DIVISION  
IN COOPERATION WITH  
U.S. DEPARTMENT OF TRANSPORTATION - FEDERAL HIGHWAY ADMINISTRATION


STATE OF MINNESOTA  
DEPARTMENT OF HIGHWAYS  
ROAD LIFE STUDIES  
CONSTRUCTION PROJECT LOG RECORD

CONTROL SECTION 8680  
TRUNK HIGHWAY 94  
COUNTY Wright  
DISTRICT 3

LIMITS: Stearns-Wright Co. Line to N.W. end Crow River Bridge

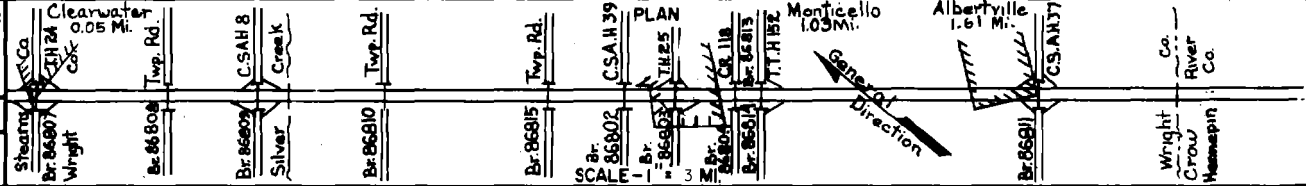

| YEAR BUILT | PROJECT NO.                        | DESCRIPTION  |       |           |                                    |
|------------|------------------------------------|--|-------|-----------|------------------------------------|
|            |                                    | TYPE   | WIDTH | THICKNESS | REMARKS                            |
| C 1973     | 8680-18<br>I 094-3<br>(180) 178    | Grading<br>Br. 86807<br>Br. 86808                    |       |           | 292' PPG<br>324' PPG               |
| C 1973     | 8680-13<br>I 094-3<br>(171)-183    | Grading<br>Bridge                                    |       |           | C100P                              |
| C 1973     | 8680-37<br>I 094-3<br>(179)        | Grading  |       |           |                                    |
| C 1973     | 8680-38<br>I-IG-094-3<br>(181) 192 | Grading<br>Br. 86802<br>Br. 86804                    |       |           | 314' PPG<br>373' B.S.              |
| C 1973     | 8680-34<br>I 094-3<br>(203)-197    | Grading<br>Asph. Concrete<br>Pl. Mix. Bit. Shoulders | 24'   |           | E.B. Rdway only                    |
| C 1973     | 8680-12<br>I 094-3<br>(183) 197    | Grading  |       |           | W.B. Roadway Only                  |
| C 1973     | 8680-32<br>I 094-3<br>(184)-201    | Grading  |       |           |                                    |
| C 1973     | 8680-33<br>I 094-3<br>(185) 203    | Grading  |       |           | W.B. Roadway Only                  |
| C 1973     | 8680-68<br>I 094-3<br>(213) 202    | Grading<br>Asph. Concrete<br>Pl. Mix. Bit. Shoulders | 24'   |           | E.B. Roadway Only                  |
| C 1973     | 8680-41<br>I 094-3<br>(171) 183    | Br. 86809  |       |           | 281' PPG                           |
| C 1973     | 8680-47<br>I 094-3<br>(213) 202    | Br. 86811  |       |           | 334' PPG                           |
| C 1973     | 8680-868034<br>094-3(I) 192        | Br. 86803<br>Br. 86813<br>Br. 86814                  |       |           | 286' PPG<br>480' B.S.<br>493' B.S. |
| C 1973     | 8680-48<br>I 094-3<br>(171) 183    | Br. 86810  |       |           | 286' PPG                           |
| C 1973     | 8680-49<br>I 094-3<br>(179) 187    | Br. 86815  |       |           | 312' PPG                           |

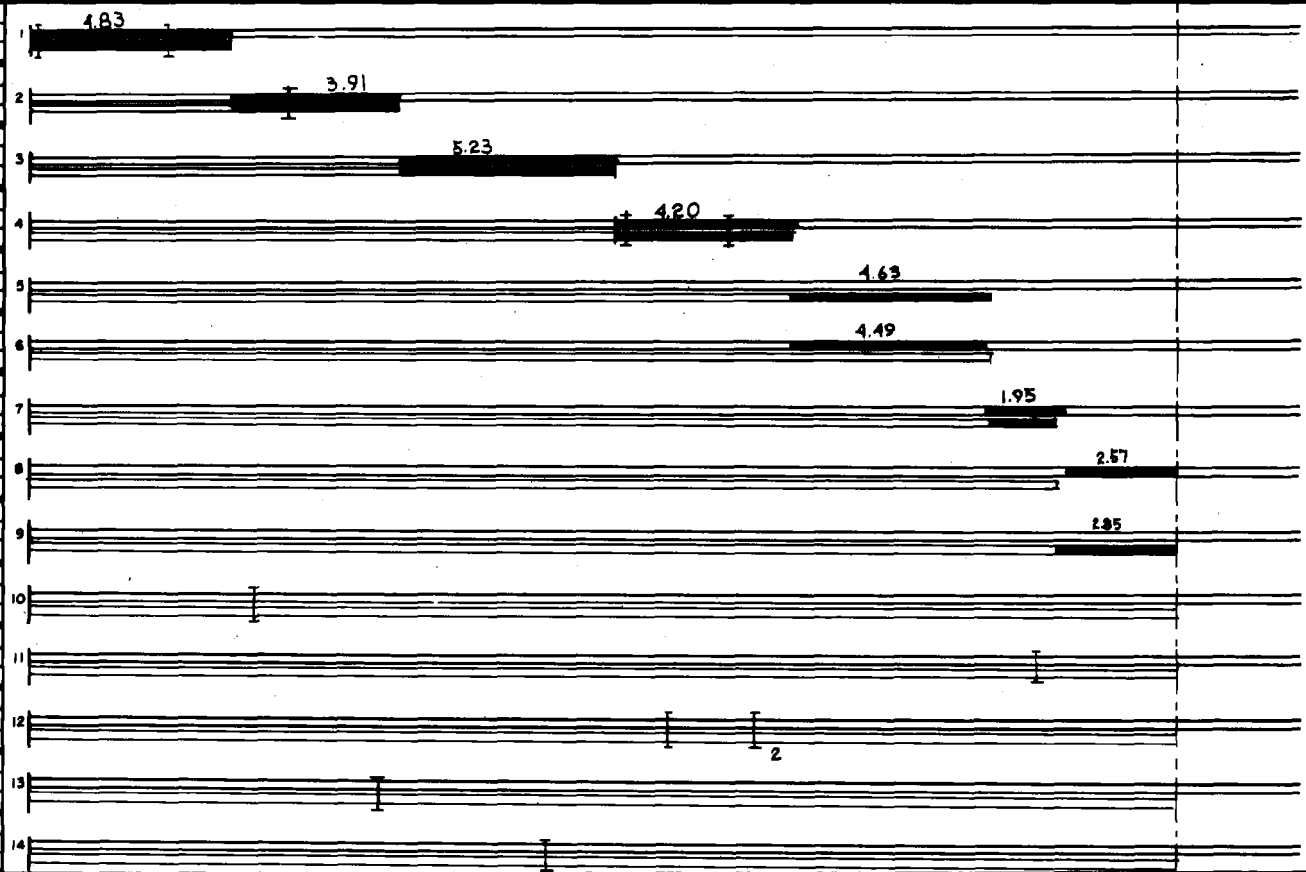

| FROM | TO   | TOTAL MILES | UNINCORPORATED |         | INCORPORATED |         | RURAL     |         | URBAN     |         |
|------|------|-------------|----------------|---------|--------------|---------|-----------|---------|-----------|---------|
|      |      |             | RDWY. MI.      | BR. MI. | RDWY. MI.    | BR. MI. | RDWY. MI. | BR. MI. | RDWY. MI. | BR. MI. |
| 1973 | 1975 | 23.97       | 21.96          | 0.14    | 1.87         | 0.00    | 23.83     | 0.14    | 0.00      | 0.00    |
| 1974 | 1974 | 27.18       | 26.06          | 0.20    | 1.92         | 0.00    | 27.04     | 0.14    | 0.00      | 0.00    |
| 1974 | 1974 | 27.18       | 24.24          | 0.15    | 2.24         | 0.05    | 27.04     | 0.14    | 0.00      | 0.00    |

REMARKS: Layout is to scale as of 1973





