



SEE LEGEND SHEET 435

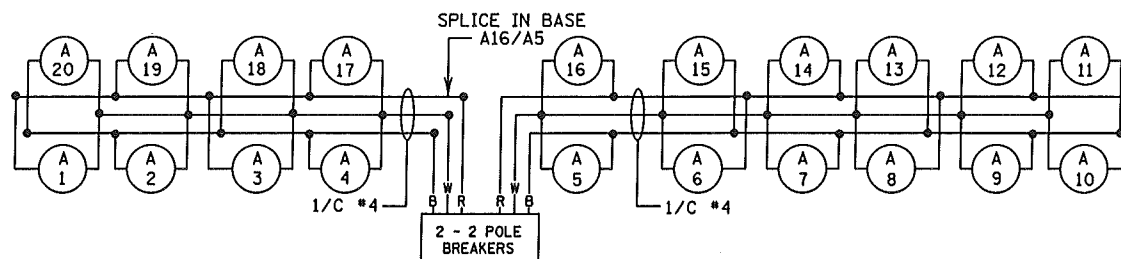

FD. PT. A5A 240/480 VOLT  
 W DENOTES NEUTRAL CONDUCTOR  
 B AND R DENOTE CURRENT CARRYING CONDUCTORS  
 DASHED LINES INDICATE INPLACE ITEMS

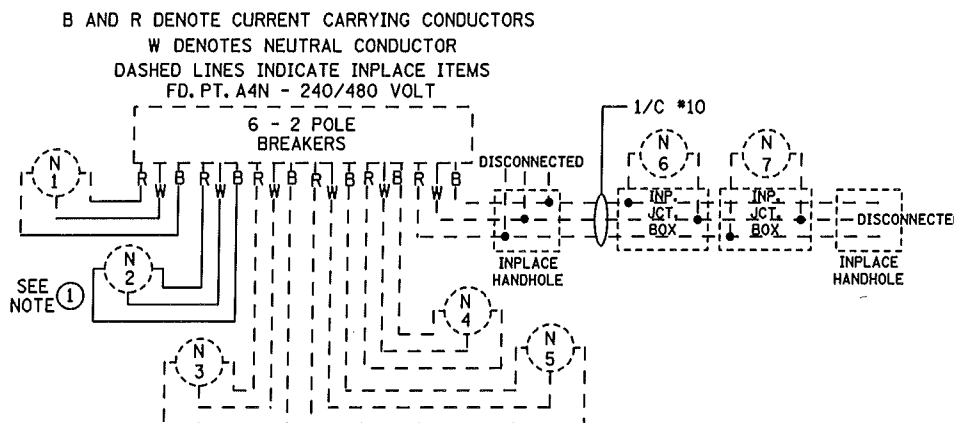

B AND R DENOTE CURRENT CARRYING CONDUCTORS  
 W DENOTES NEUTRAL CONDUCTOR  
 DASHED LINES INDICATE INPLACE ITEMS  
 FD. PT. A4N - 240/480 VOLT



SERVICE CABINET SECONDARY TYPE L1  
 240/480 VOLT (METERED) FD. PD. A5A  
 2" R.S.C. & 3-1/C #2 AND WEATHERHEAD  
 TO XCEL ENERGY POLE AND TRANSFORMER  
 EQUIPMENT PAD B REQUIRED

INP. FD PT. A4N  
 CABINET TYPE L2  
 240/480 VOLT  
 F&I 6 - 2 POLE  
 BREAKERS

FEEDPOINT A5A

LIGHTING STANDARDS AND BASES					
NO.	STA.	ALI	LOCATION	TYPE	WATTAGE
20	175+50	TH94	MEDIAN BARRIER	9BD-49	400
1	178+10				
2	180+70				
3	183+45				
4	185+85				
5	188+40				
6	191+00				
7	193+50				
8	196+10				
9	198+31	TH94	MEDIAN BARRIER	9BD-49	400
10					

FEEDPOINT A4N

LIGHTING STANDARDS AND BASES					
NO.	STA.	ALI	LOCATION	TYPE	WATTAGE
1			INPLACE	4-120	1000
2	207+35	EB TH94	SEE NOTE	3-100	
3			INPLACE	4-120	
4-5			INPLACE	3-100	1000
6-7			INPLACE	L	250

① PLACE SALVAGED TOWER  
 LOCATE 80' LEFT OF C L394EB  
 F & I TOWER BASE T-100

FEEDPOINT: A5A LOCATION: EB 94 AT PED BRIDGE  
 METER ADDRESS: 1633 TH94 SE, MINNEAPOLIS 55414  
 FEEDPOINT: A4N LOCATION: EUSTIS  
 METER ADDRESS: 2505 WABASHA Ave., St. Paul 55114

AS-BUILT 3/2012

FEEDPOINTS A5A, A4N

LIGHTING PLAN

BY	DATE	REVISIONS
EK	3/2012	3" BORE TO A4/17

CERTIFIED BY *Michael P. Guberny* L.I.C. NO. 19863 DATE: 3/7/2012

STATE PROJ. NO. 2781-415 (T.H. 94) SHEET NO. 439 OF 532 SHEETS

DISTRICT #: METRO  
 PLOT NAME: 12781415\_JITAB  
 PATH & FILENAME: IP\_PWP-d0692145V2781415\_JITAB.dgn

PLOTTED/REVISED: 3/7/2012