

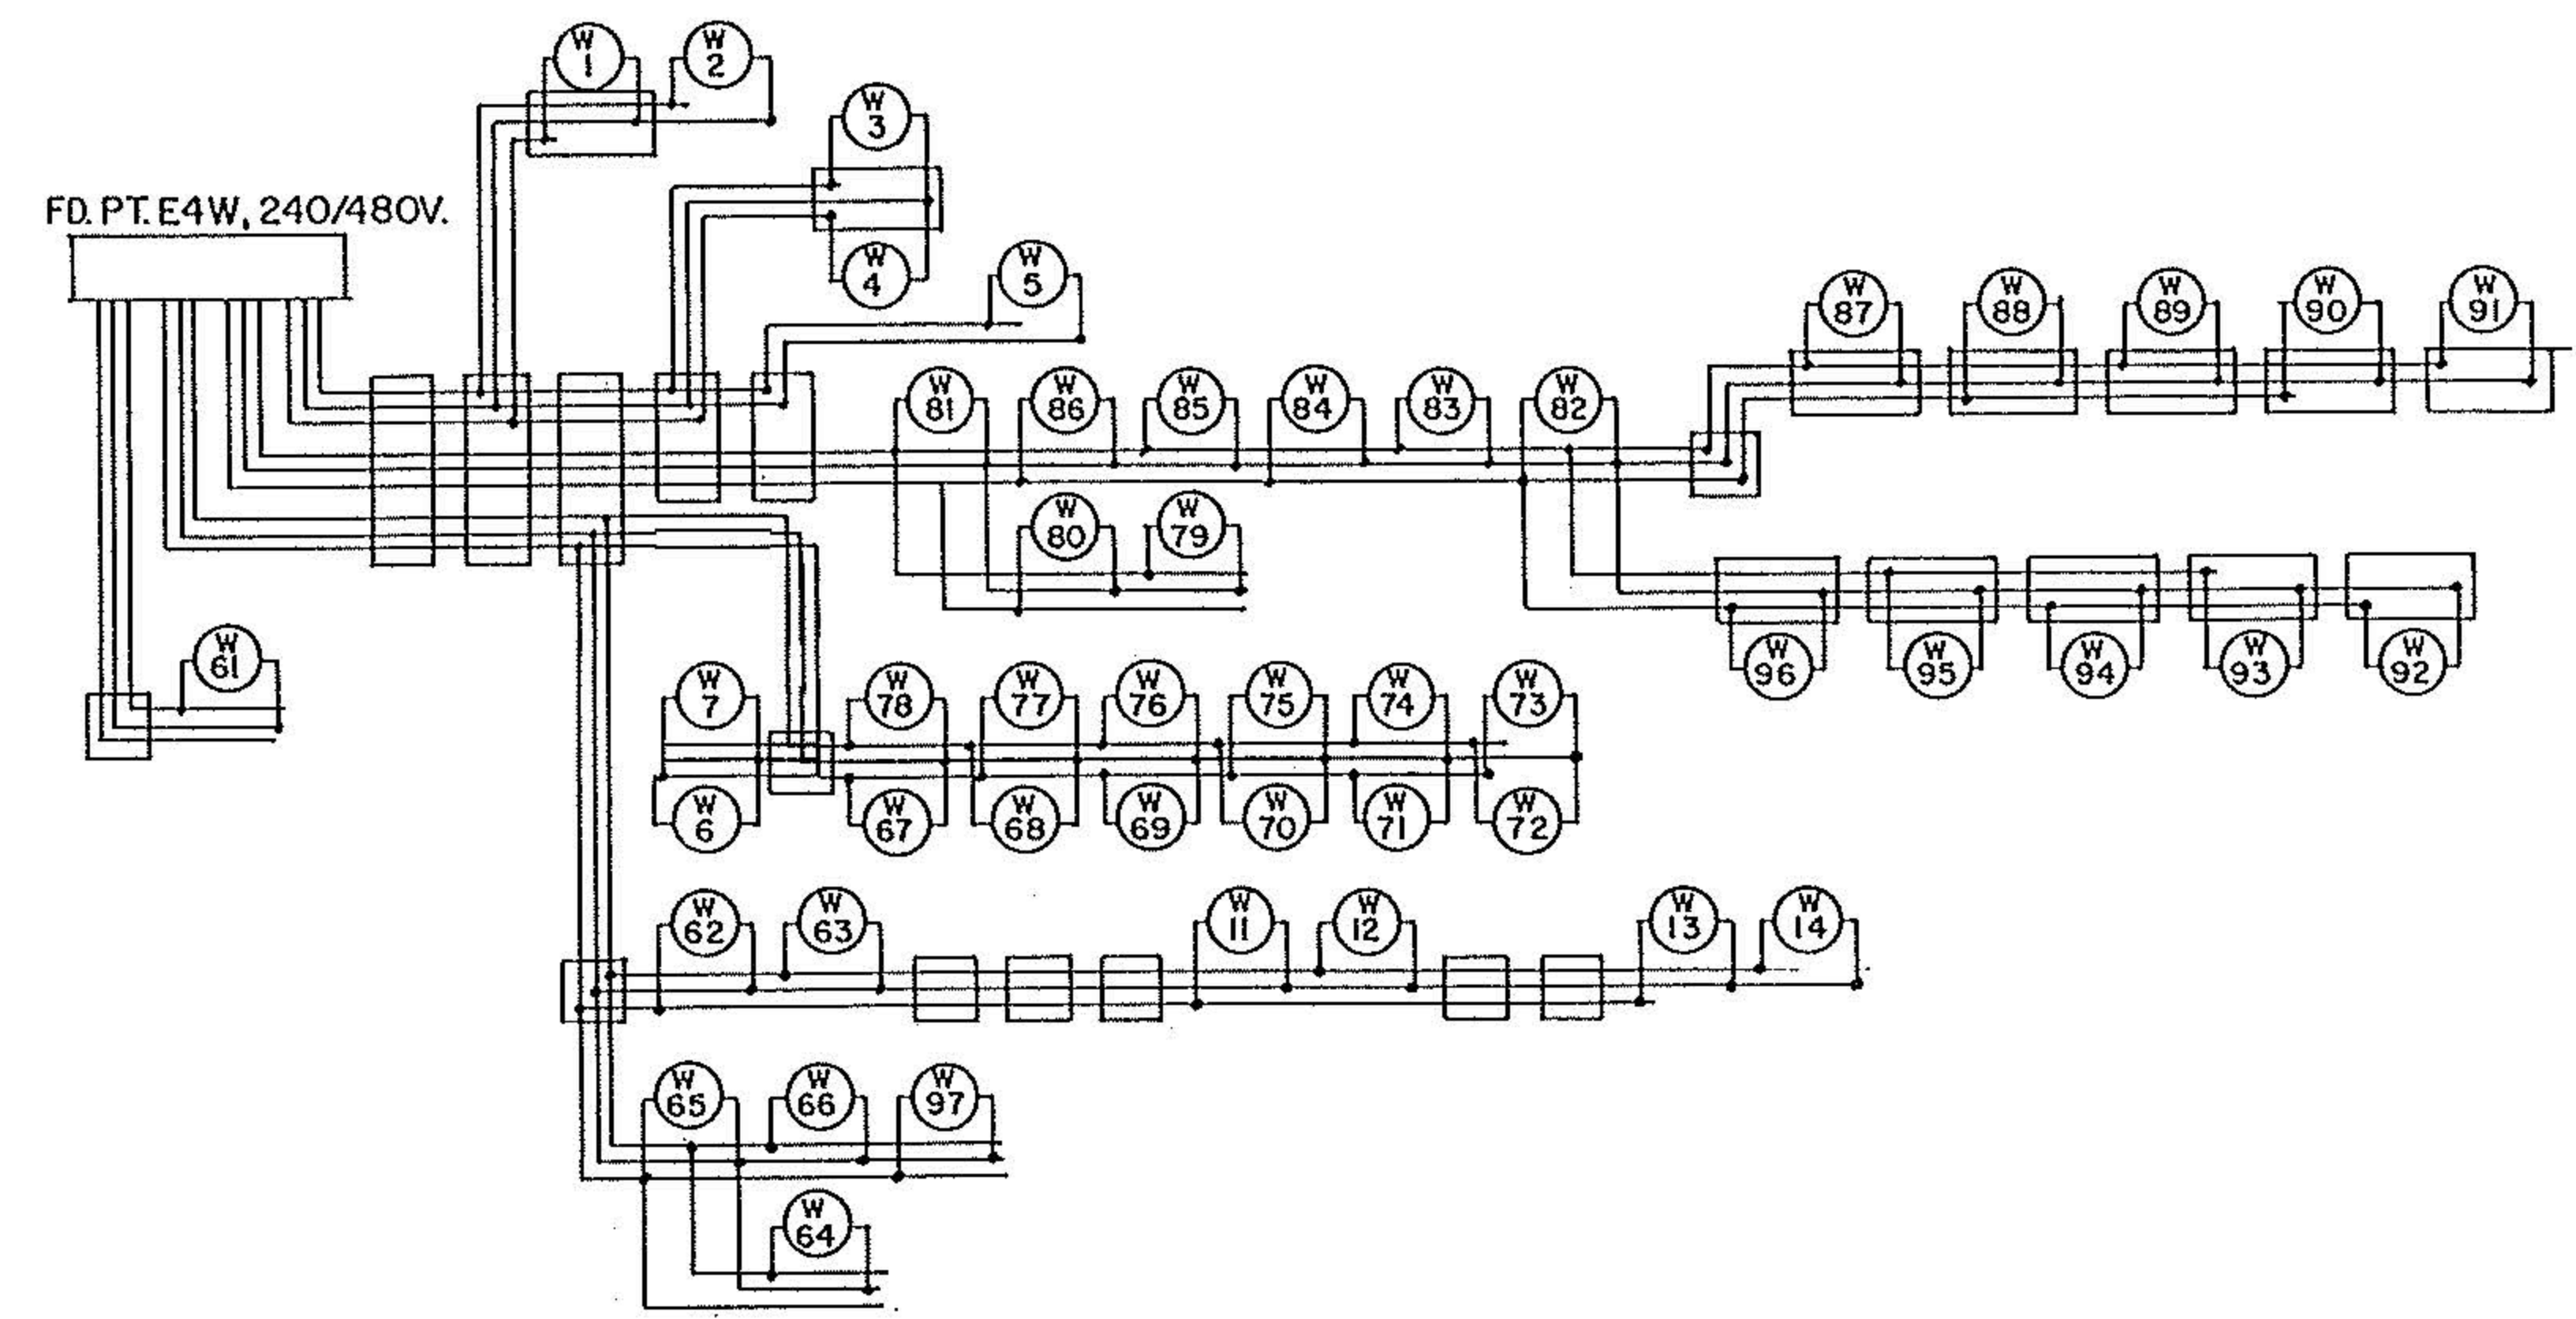


NO	STATION	LT	RT	LOCATION	JTYPE	NO	STATION	LT	RT	LOCATION	TYPE
1	596+35	-	-	EAST ABUT	L	81	496+80	-	-	RAMP W-SB	6-40
2	496+15	-	-	RAMP N-EB		82	102+60	-	-	RAMP W-IOA	
3	496+53	-	-	RAMP N-EB		83	104+90	-	-		
4	495+85	-	-	BRIDGE PIER		84	107+05	-	-		
5	498+45	-	-	BRIDGE PIER		85	109+20	-	-		
11	0+77.61	-	-	SO. FR. RD.	6-40MOD	86	111+40	-	-		6-40
12	2+87.61	-	-			87	101+90	-	-	RAMP W-IOA	L
13	4+37.61	-	-			88	23+30	-	-	LANE W-E2	
14	6+17.61	-	-	SO. FR. RD.		89	23+40	-	-	LANE W-E2	
61	15+00	-	-	RAMP S.F.R.	6-40MOD	90	21+30	-	-	LANE E-WA	
62	17+10	-	-	RAMP S.F.R.	6-40	91	20+90	-	-		
63	19+20	-	-	RAMP S.F.R.		92	21+70	-	-		
64	1+60	-	-	RAMP N-EB	6-40	93	22+10	-	-	LANE E-WA	
65	3+50	-	-	RAMP N-EB	6-40	94	22+70	-	-	LANE W-E2	
66	5+50	-	-	RAMP N-EB	6-40	95	22+60	-	-	LANE W-E2	
67	499+50	-	-	TH.35E N.B.	6D-40	96	101+15	-	-	RAMP W-IOA	L
68	501+10	-	-			97	39+30	-	-	LANE W-E2	6-40
69	503+00	-	-								
70	504+30	-	-								
71	506+30	-	-								
72	508+70	-	-	T.H.35E N.B.	6D-40						
73	501+30	-	-	RAMP W-SB	6-40						
79	499+10	-	-	RAMP W-SB	6-40						
80	497+88	-	-	TH.35E N.B.	4DBP-35						

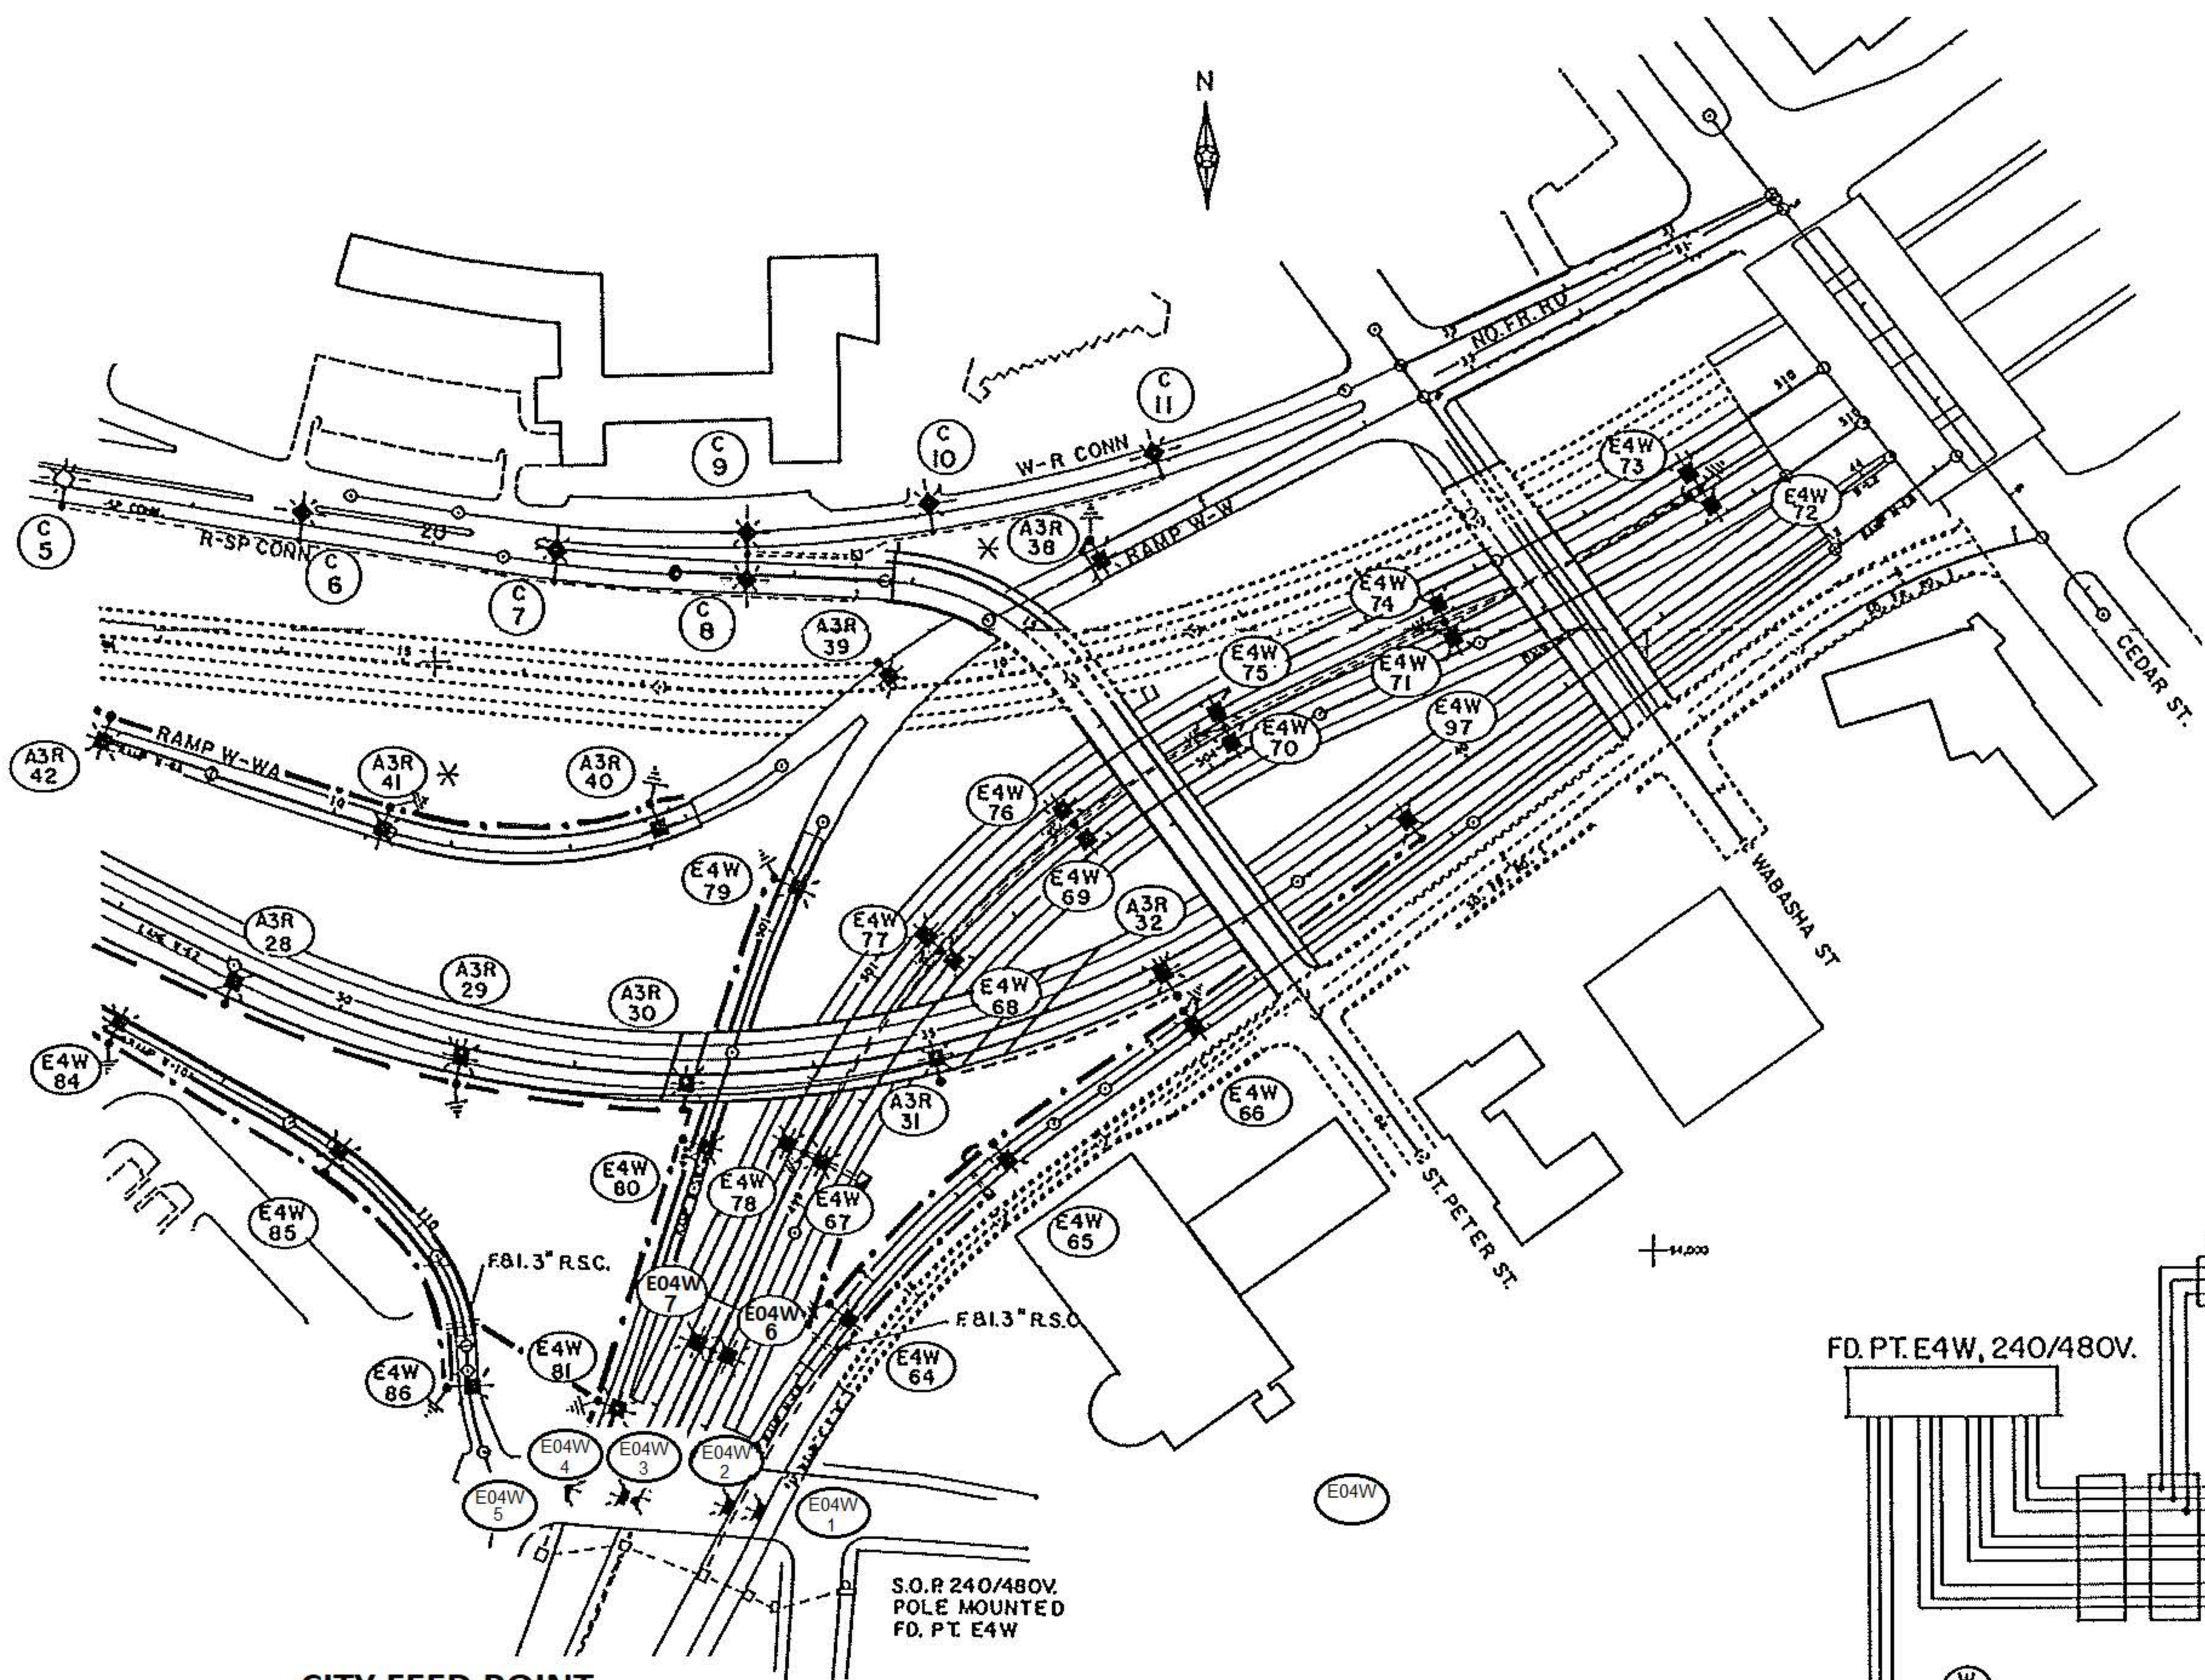

CITY FEED POINT

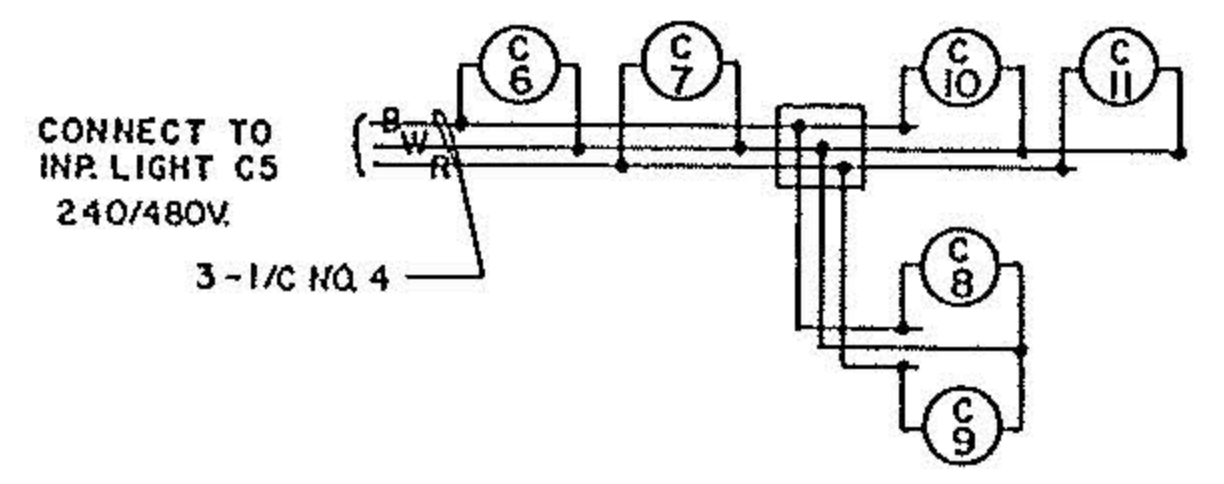

B AND R DENOTE CURRENT CARRYING CONDUCTOR  
W DENOTES NEUTRAL CONDUCTOR

NO.	STATION	LT.	RT.	LOCATION	TYPE
C5	23+10 INP.	-	-	R-SP CONN	
C6	21+10	-	-		6P-35S
C7	19+00	-	-		6P-35S
C8	17+40	-	-	R-SP CONN	6DP-35S
C10	4+11	-	-	W-R CONN.	6P-35S
C11	2+19	-	-	W-R CONN	6P-35S

AS-BUILT- UPDATED POLES/ WIRING

BY J.D.P. 1/3/19