

SEE LEGEND SHEET 8



FD. PT. E8N



LIGHTING STANDARDS AND BASES						
NO.	STATION	LT.	RT.	LOCATION	TYPE	WATTAGE
1	409+50		—	T.H. 35E N.B.	9-40	250
2	412+00		—	T.H. 35E N.B.	↑	↑
3	414+35		—	T.H. 35E N.B.	↑	↑
4	414+50		—	T.H. 35E N.B.	↑	↑
5	412+00	—		T.H. 35W S.B.	↓	↓
6	409+50	—		T.H. 35W S.B.	↓	↓
7	407+00	—		T.H. 35W S.B.	9-40	250
8				CSAH J	9-40	250
9				CSAH J	9-40	250

PLOTTED/REVISED: 2/27/2012

DISTRICT #: METRO
 IPLOT NAME: 8825-209_LOLIT.dwg
 PATH & FILENAME: IP_PWP:d0785163\8825-209_LOLIT.dwg

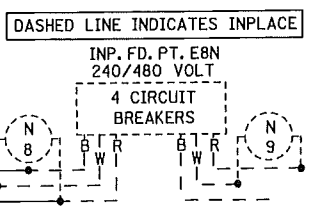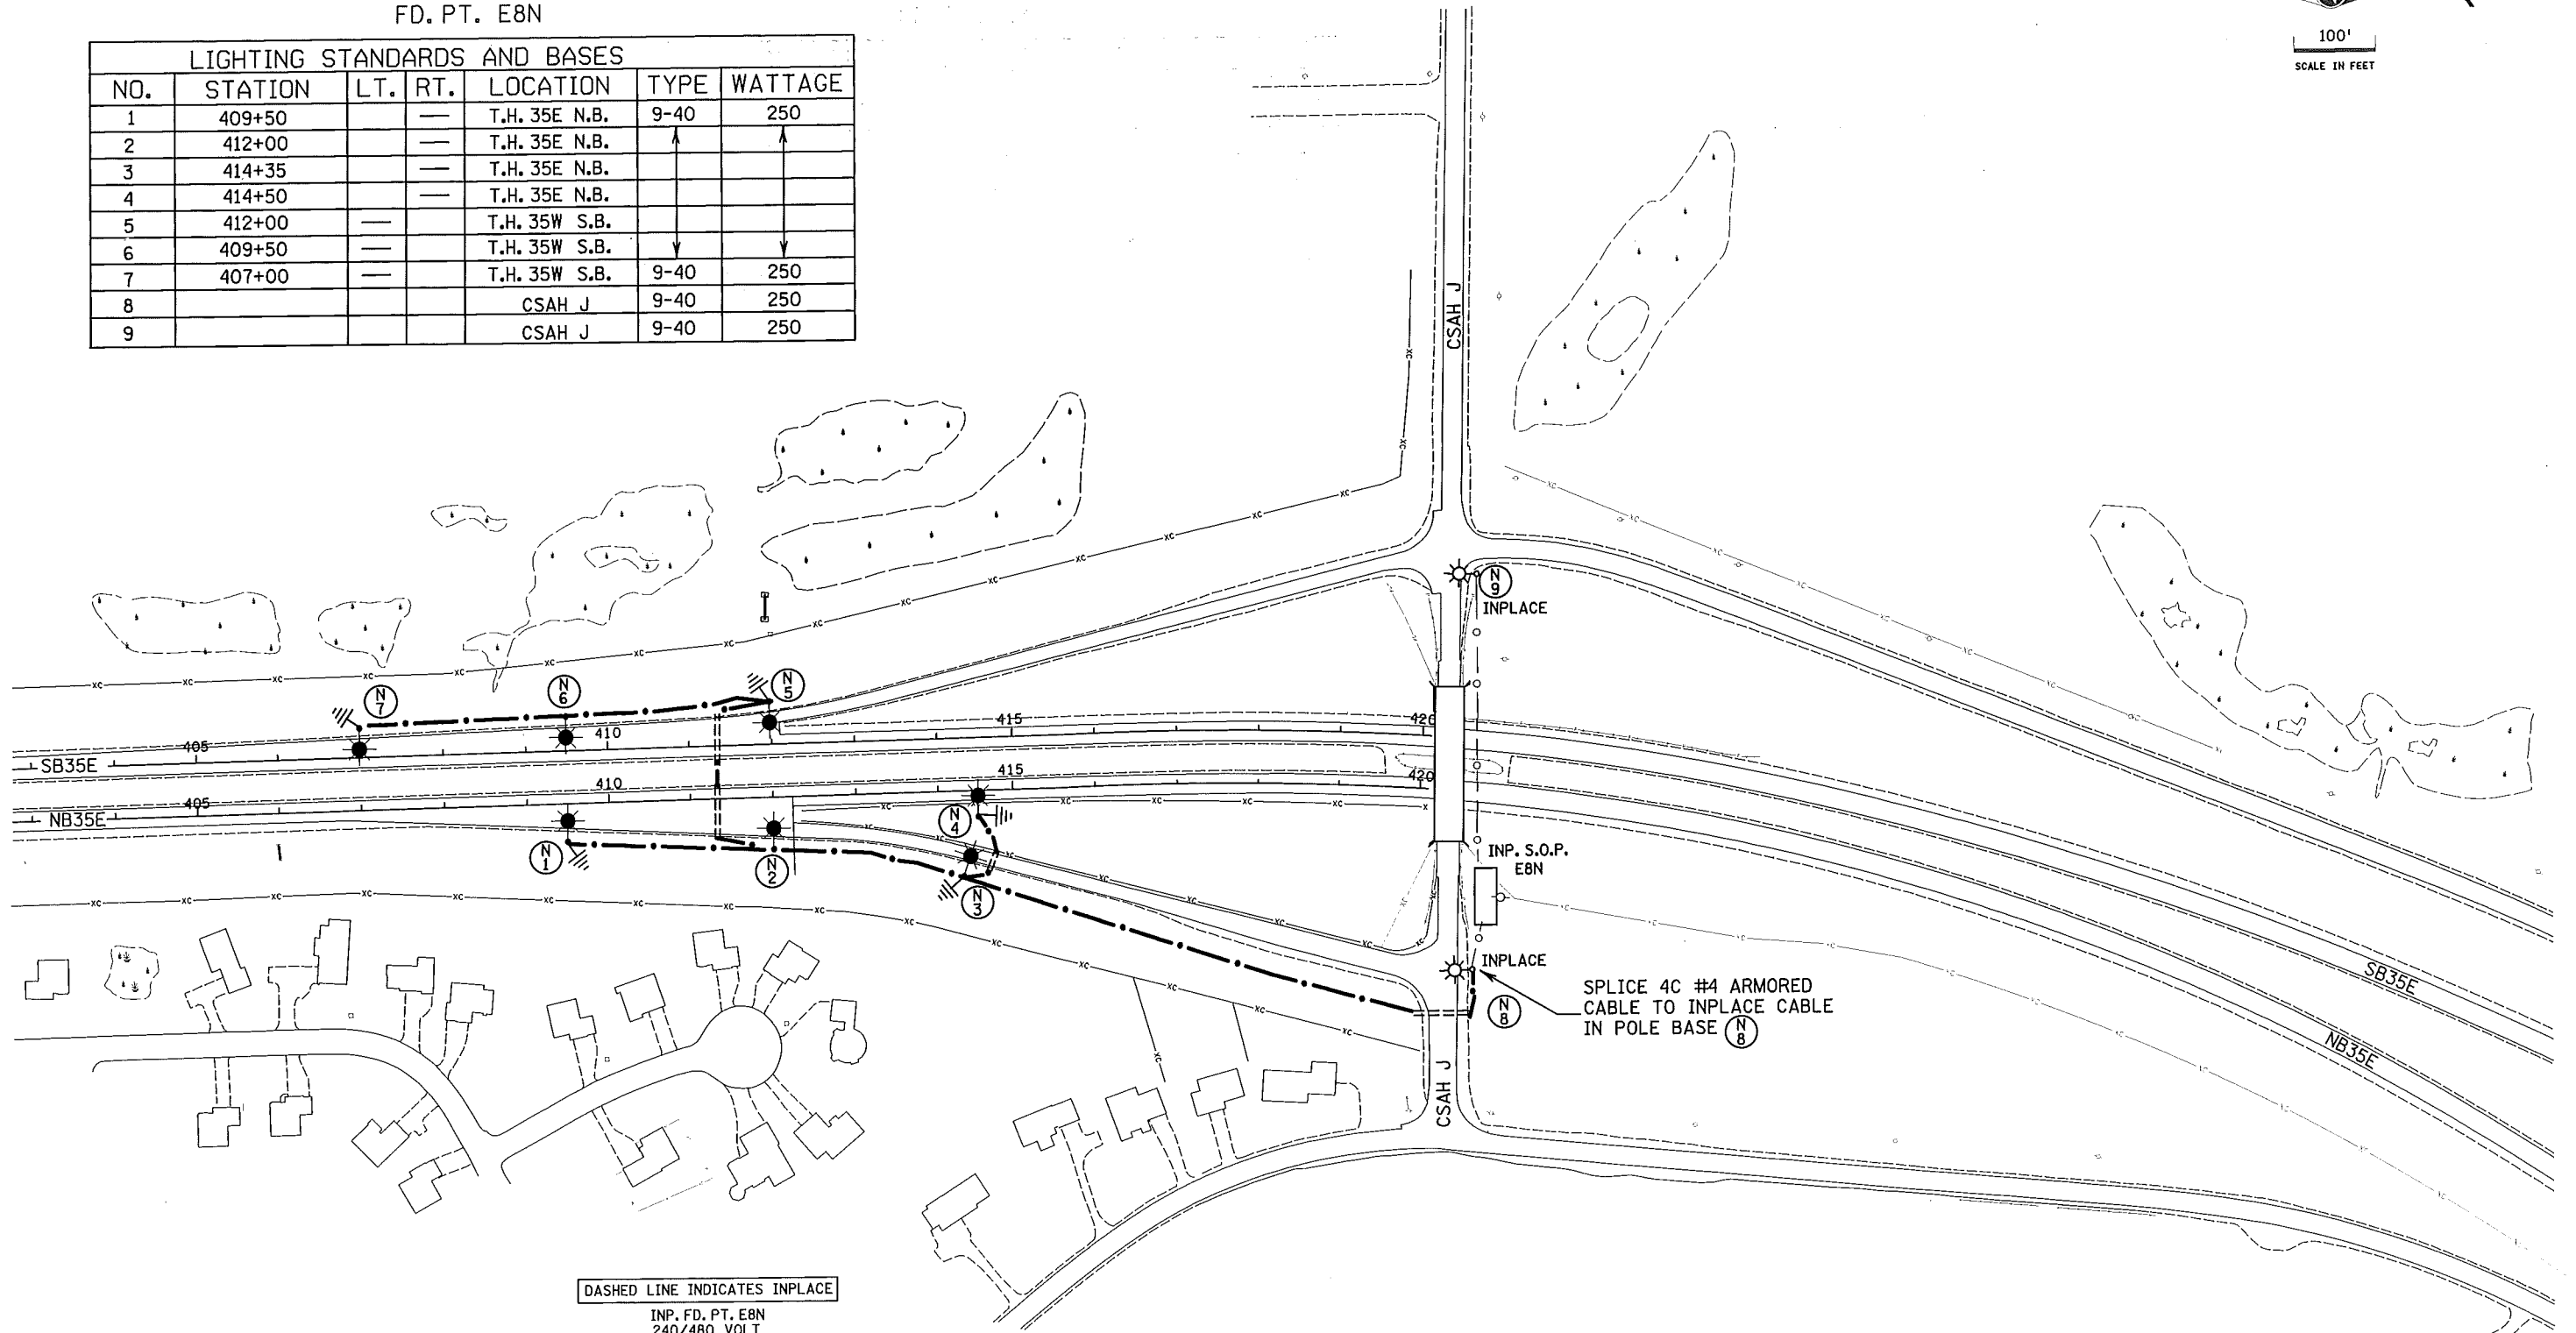

AS-BUILT 2/2012
 FEEDPOINT E8N
 TH 35E at CSAH J

LIGHTING PLAN