











LEGEND

-  250 WATT HIGH PRESSURE SODIUM VERTICAL MOUNT BACK TO BACK LIGHTING UNIT
-  250 WATT HIGH PRESSURE SODIUM VERTICAL MOUNT LIGHTING UNIT
-  DIRECT BURIED POWER CABLE 3 CONDUCTOR NO. 4 AWG ARMORED CABLE SPEC. NO. 3804 & 3805
-  INPLACED RIGID STEEL CONDUIT
-  3" RIGID STEEL CONDUIT EXCEPT AS NOTED OTHERWISE
-  PAD MOUNTED SOURCE OF POWER 240/480 V.
-  INPLACE SOURCE OF POWER
-  PERMANENT GROUND ROD (25 OHMS OR LESS)

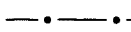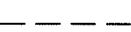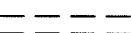

HAND HOLE LOCATED 82' FROM CABINET.
LOCATOR BALL IN HAND HOLE

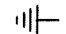FEED POINT F02R
240/480 V.
F&I SERVICE CABINET SECONDARY TYPE L1
F&I 2" R.S.C. TO INP. P.P. W/
UNDERGROUND WIRE 3-1 COND. NO. 2
F&I EQUIPMENT PAD B
METERED

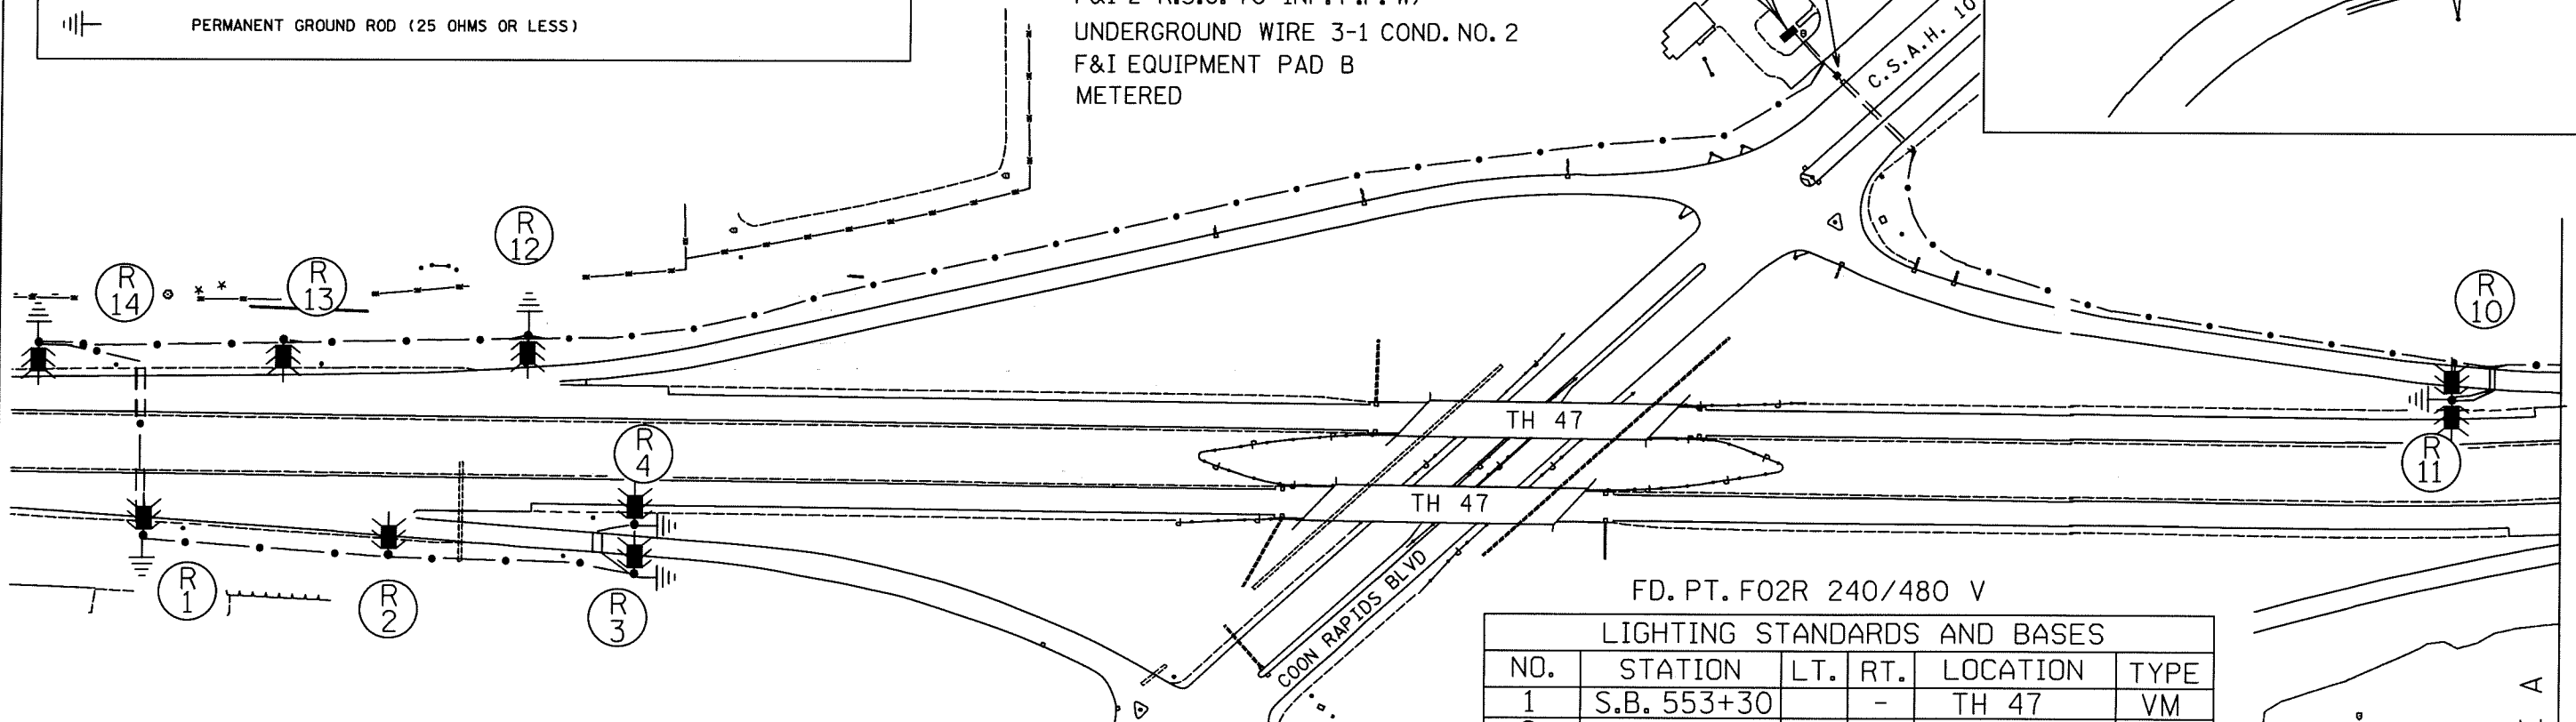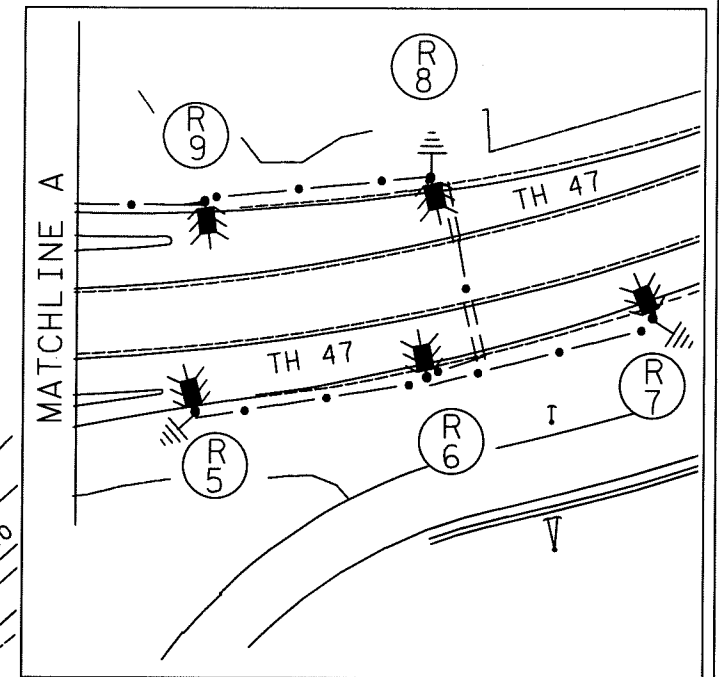


FD. PT. F02R 240/480 V

LIGHTING STANDARDS AND BASES

NO.	STATION	LT.	RT.	LOCATION	TYPE
1	S.B. 553+30	-	-	TH 47	VM
2	S.B. 555+30	-	-	TH 47	VM
3	S.B. 557+30	-	-	TH 47	VM
4	S.B. 557+30	-	-	TH 47	VM
5	S.B. 577+70	-	-	TH 47	VM
6	S.B. 579+70	-	-	TH 47	VM
7	S.B. 581+70	-	-	TH 47	VM
8	N.B. 579+85	-	-	TH 47	VM
9	N.B. 577+83	-	-	TH 47	VM
10	N.B. 575+83	-	-	TH 47	VMD
11	N.B. 575+83	-	-	TH 47	VMD
12	N.B. 556+63	-	-	TH 47	VM
13	N.B. 554+62	-	-	TH 47	VM
14	N.B. 552+60	-	-	TH 47	VM

FD. PT. F02R
240/480 VOLT
4 CIRCUIT
BREAKERS

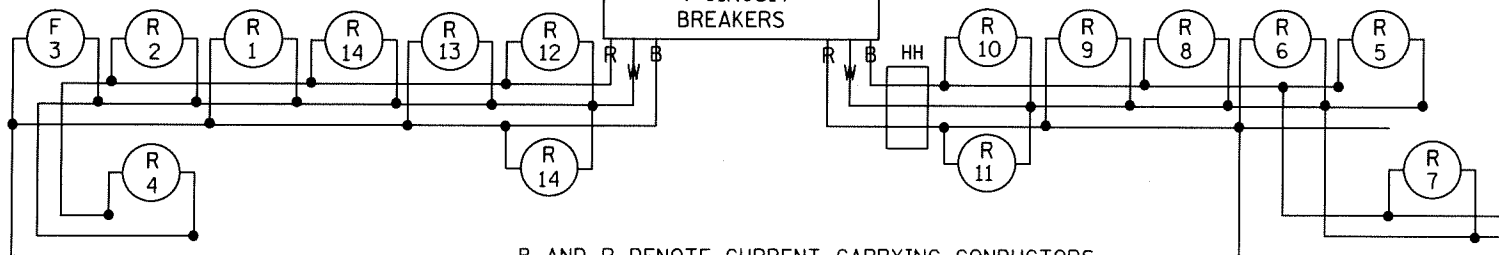

B AND R DENOTE CURRENT CARRYING CONDUCTORS
W DENOTES NEUTRAL CONDUCTOR

**AS-BUILT
FEEDPOINT F02R
LIGHTING PLAN**

CERTIFIED BY *Scott A. Johnson*
LICENSED PROFESSIONAL ENGINEER

LIC. NO. 40945

State Proj. No. 0205-79 (T.H. 47) Sheet No. 7 of 8 Sheets