


SHEET TOTAL  
7 - 200 WATT HIGH PRESSURE SODIUM LIGHTING UNITS



EXHIBIT 240C  
T.H. 110 & T.H. 52  
XCEL ENERGY

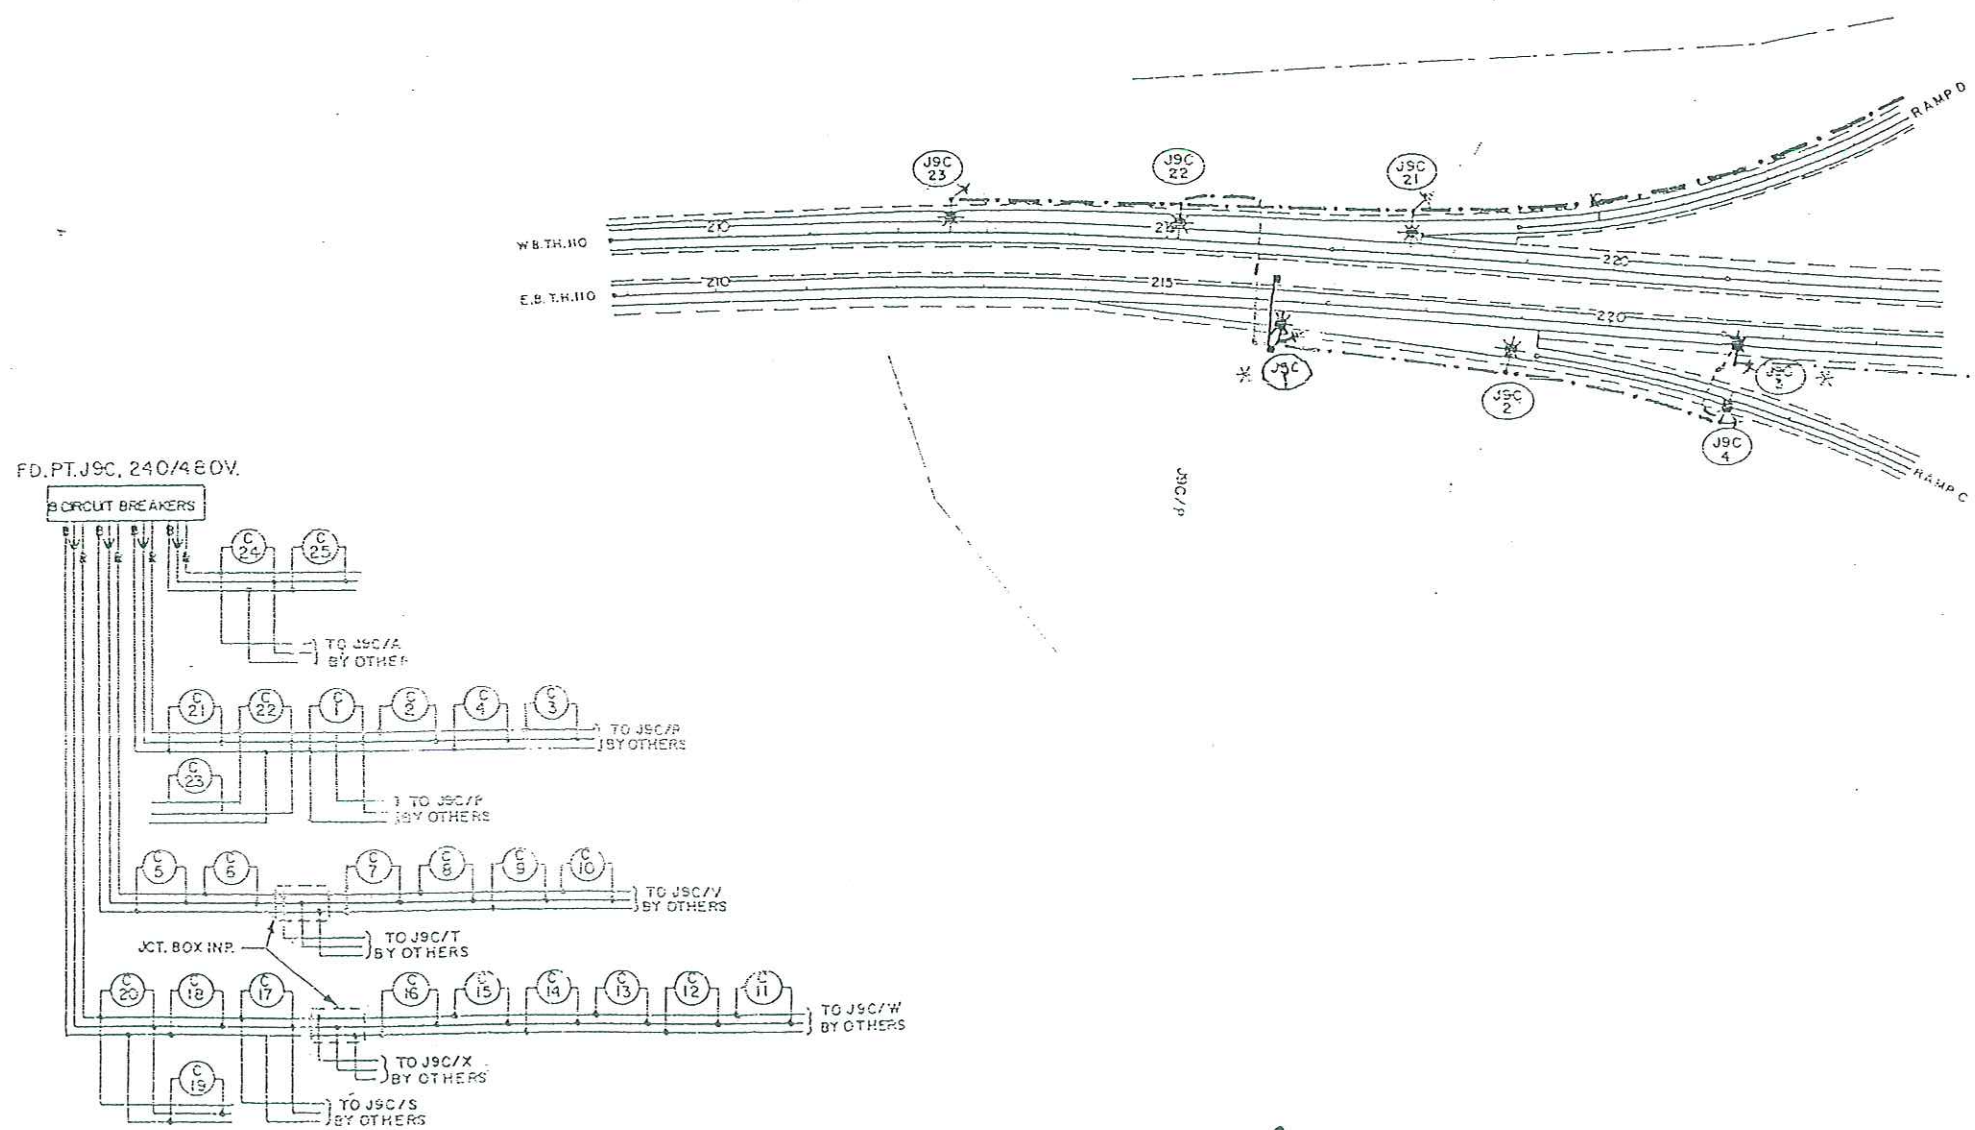

FD.PT.J9C, 240/480V.

LIGHT STANDARDS & BASES				
NO.	STATION	LT. RT.	LOCATION	TYPE
1	E.B. 216+30	-	T.H.110	9-40
2	E.B. 218+90	-	T.H.110	9-40
3	E.B. 221+50	-	T.H.110	9-40
4	2+30	-	RAMP C	6-40
5	E.B. 230+50	-	T.H.110	9-40
6	E.B. 232+95	-		68-40
7	E.B. 235+50	-		9-40
8	E.B. 238+30	-		
9	E.B. 240+80	-		
10	E.B. 243+30	-		
11	WB. 245+40	-		
12	WB. 242+90	-		
13	WB. 240+60	-		
14	WB. 238+00	-		
15	WB. 235+70	-		
16	WB. 233+40	-		
17	WB. 230+80	-		
18	WB. 228+30	-		
19	WB. 225+80	-	T.H.110	9-40
20	2+20	-	LOOP D	6-40
21	WB. 217+90	-	T.H.110	9-40
22	WB. 215+30	-	T.H.110	
23	WB. 212+70	-	T.H.110	
24	S.B. 306+60	-	T.H.52	
25	N.B. 308+00	-	T.H.52	9-40

(1) BRIDGE MOUNTED, ANCHORAGE INP.  
LOCATE 40' POLES 8' BEHIND EDGE OF SHOULDER OR FACE OF CURB OR AS DIRECTED BY THE ENGINEER.


B AND R DENOTE CURRENT CARRYING CONDUCTORS  
W DENOTES NEUTRAL CONDUCTOR

FD. PT. J09C



SHEET TOTAL  
 35 - 200 WATT HIGH PRESSURE SODIUM LIGHTING UNITS  
 5 - 250 WATT MERCURY VAPOR SIGN LIGHTS

EXHIBIT 240C  
 T.H. 110 - ROBERT ST. & T.H. 494  
 XCEL ENERGY

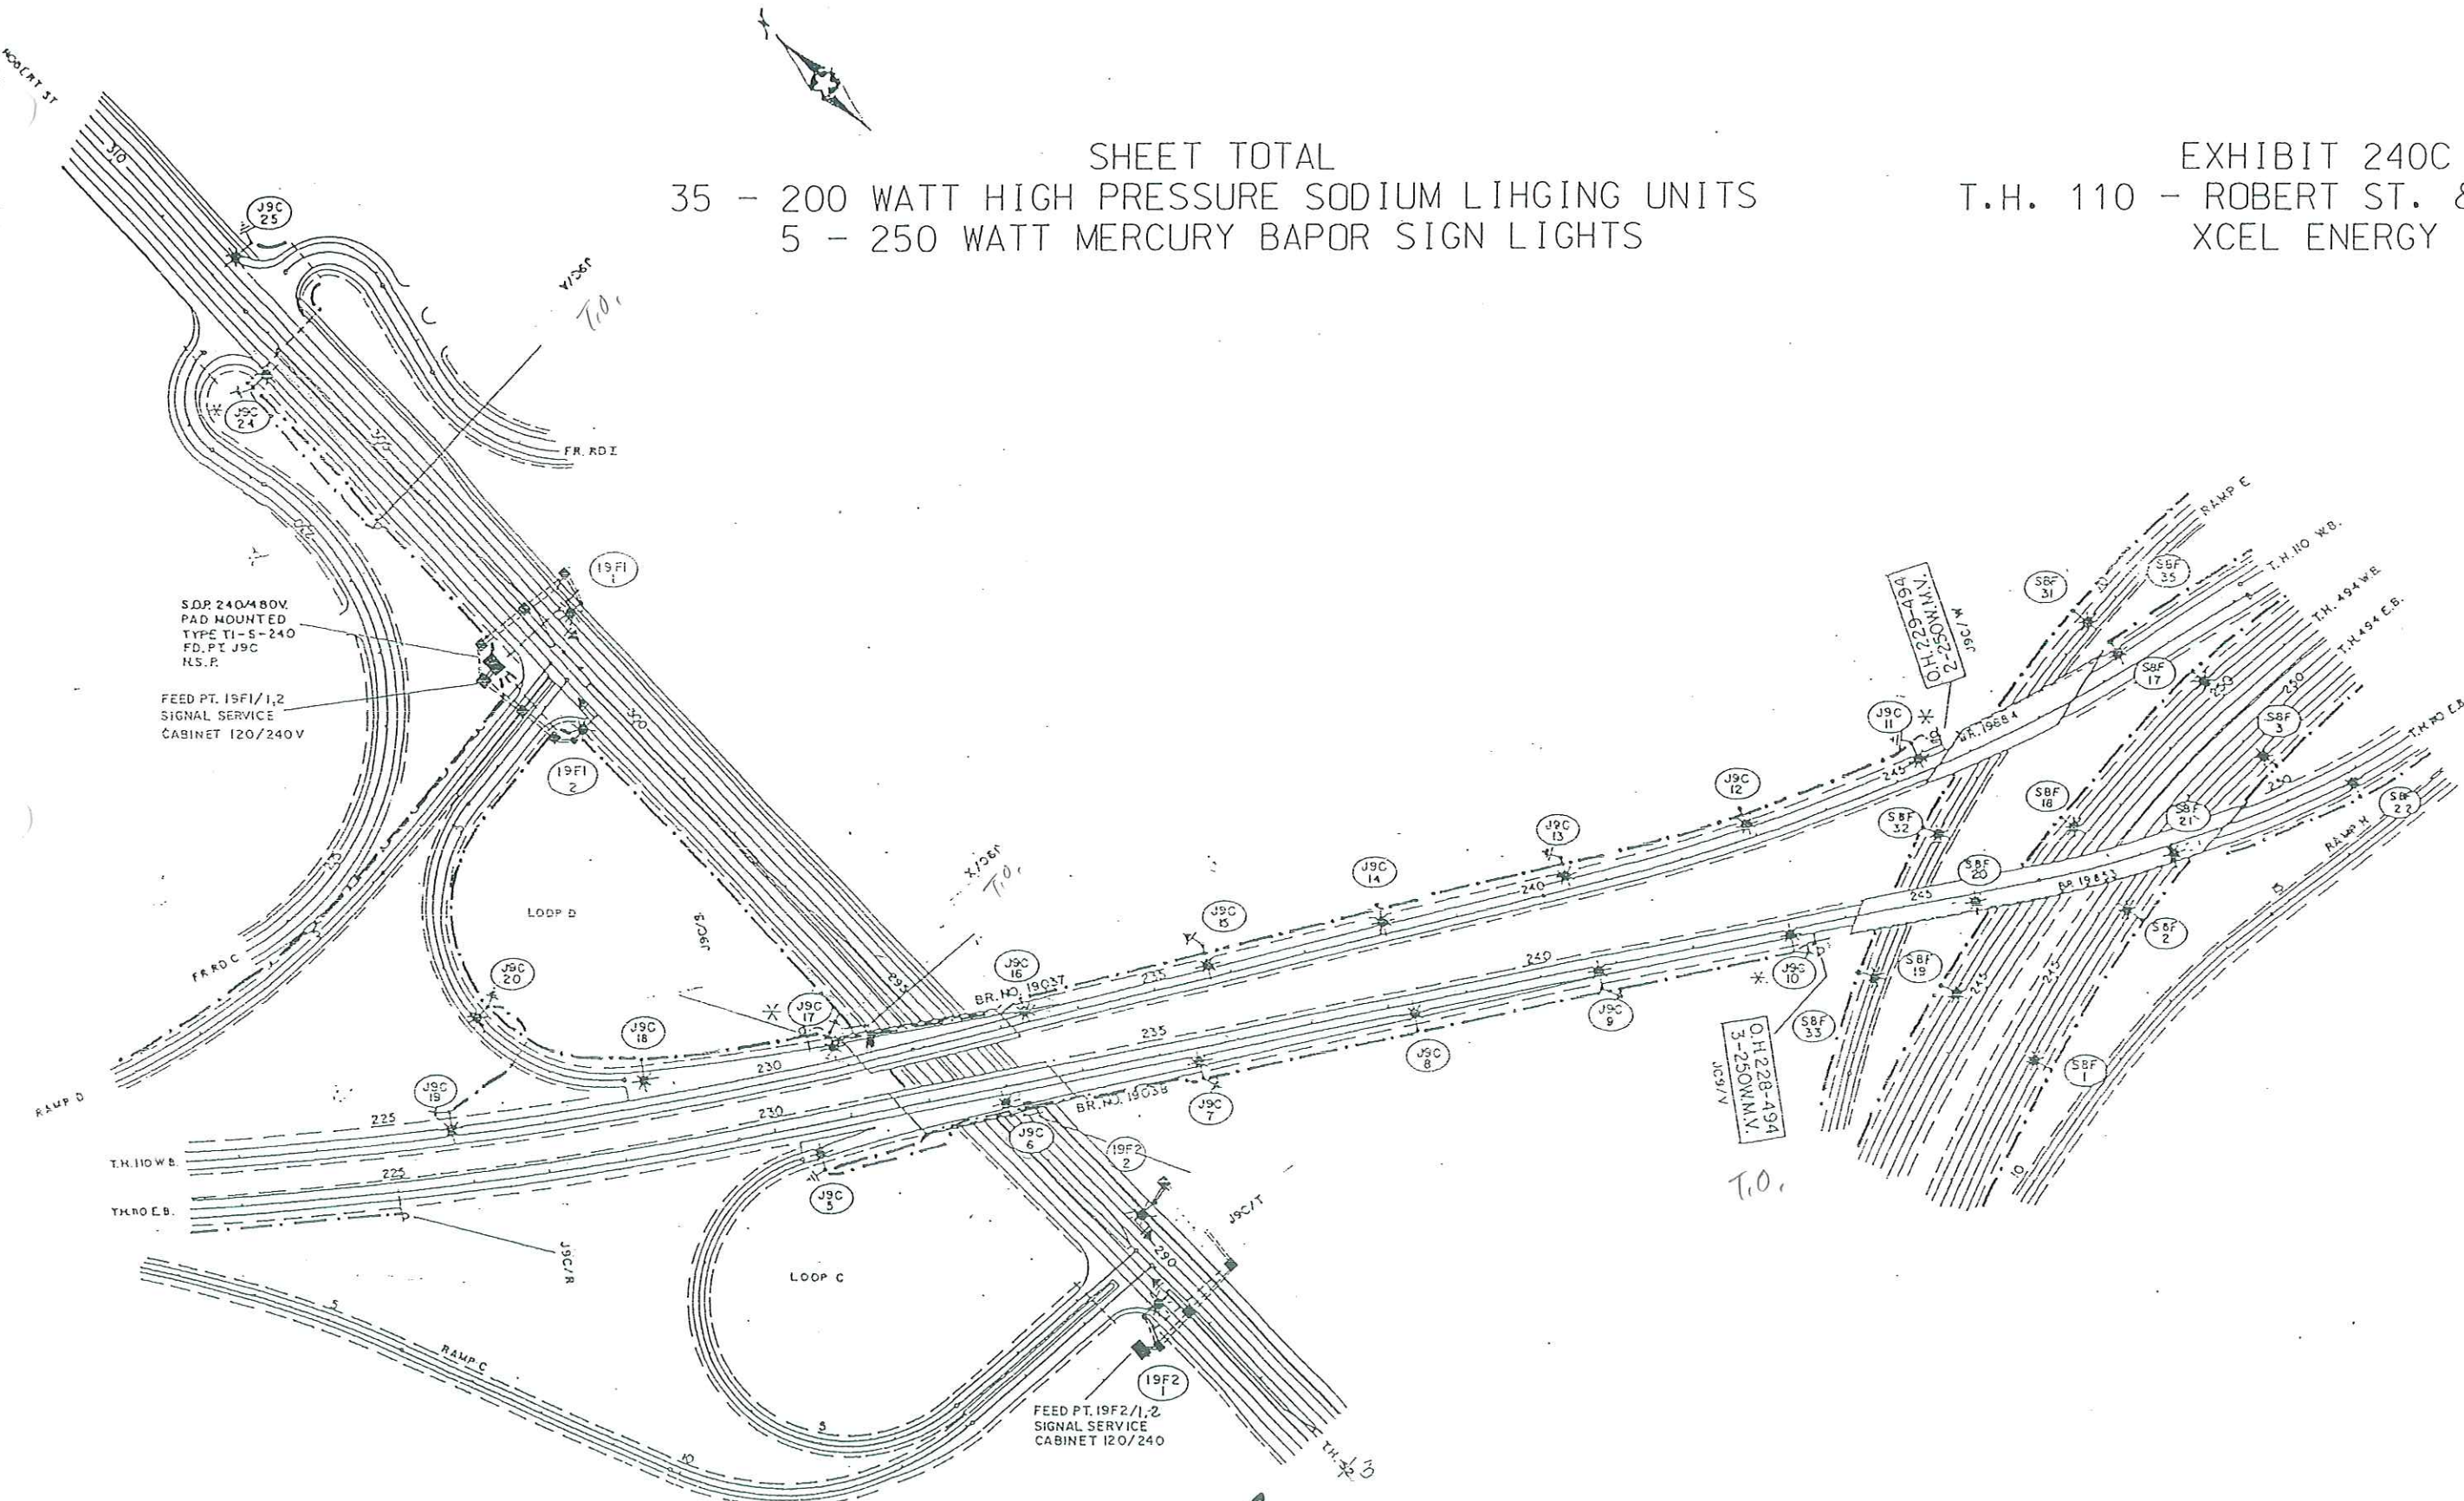

FD. PT. 19F1, 19F2, S08C, J09C