



FD. PT. L2X, 240/480V. (SEE SHEET 5A)

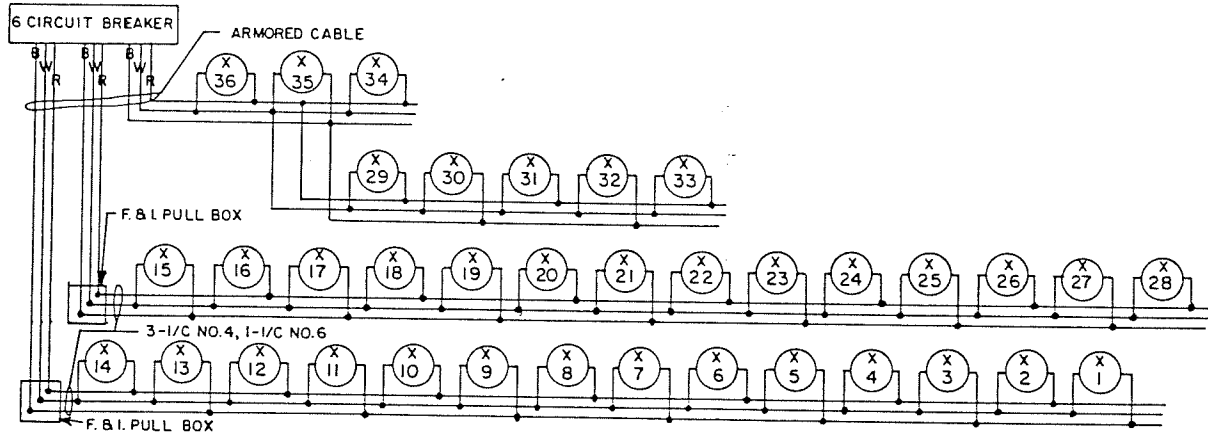

B AND R DENOTE CURRENT CARRYING CONDUCTORS
W DENOTES NEUTRAL CONDUCTOR

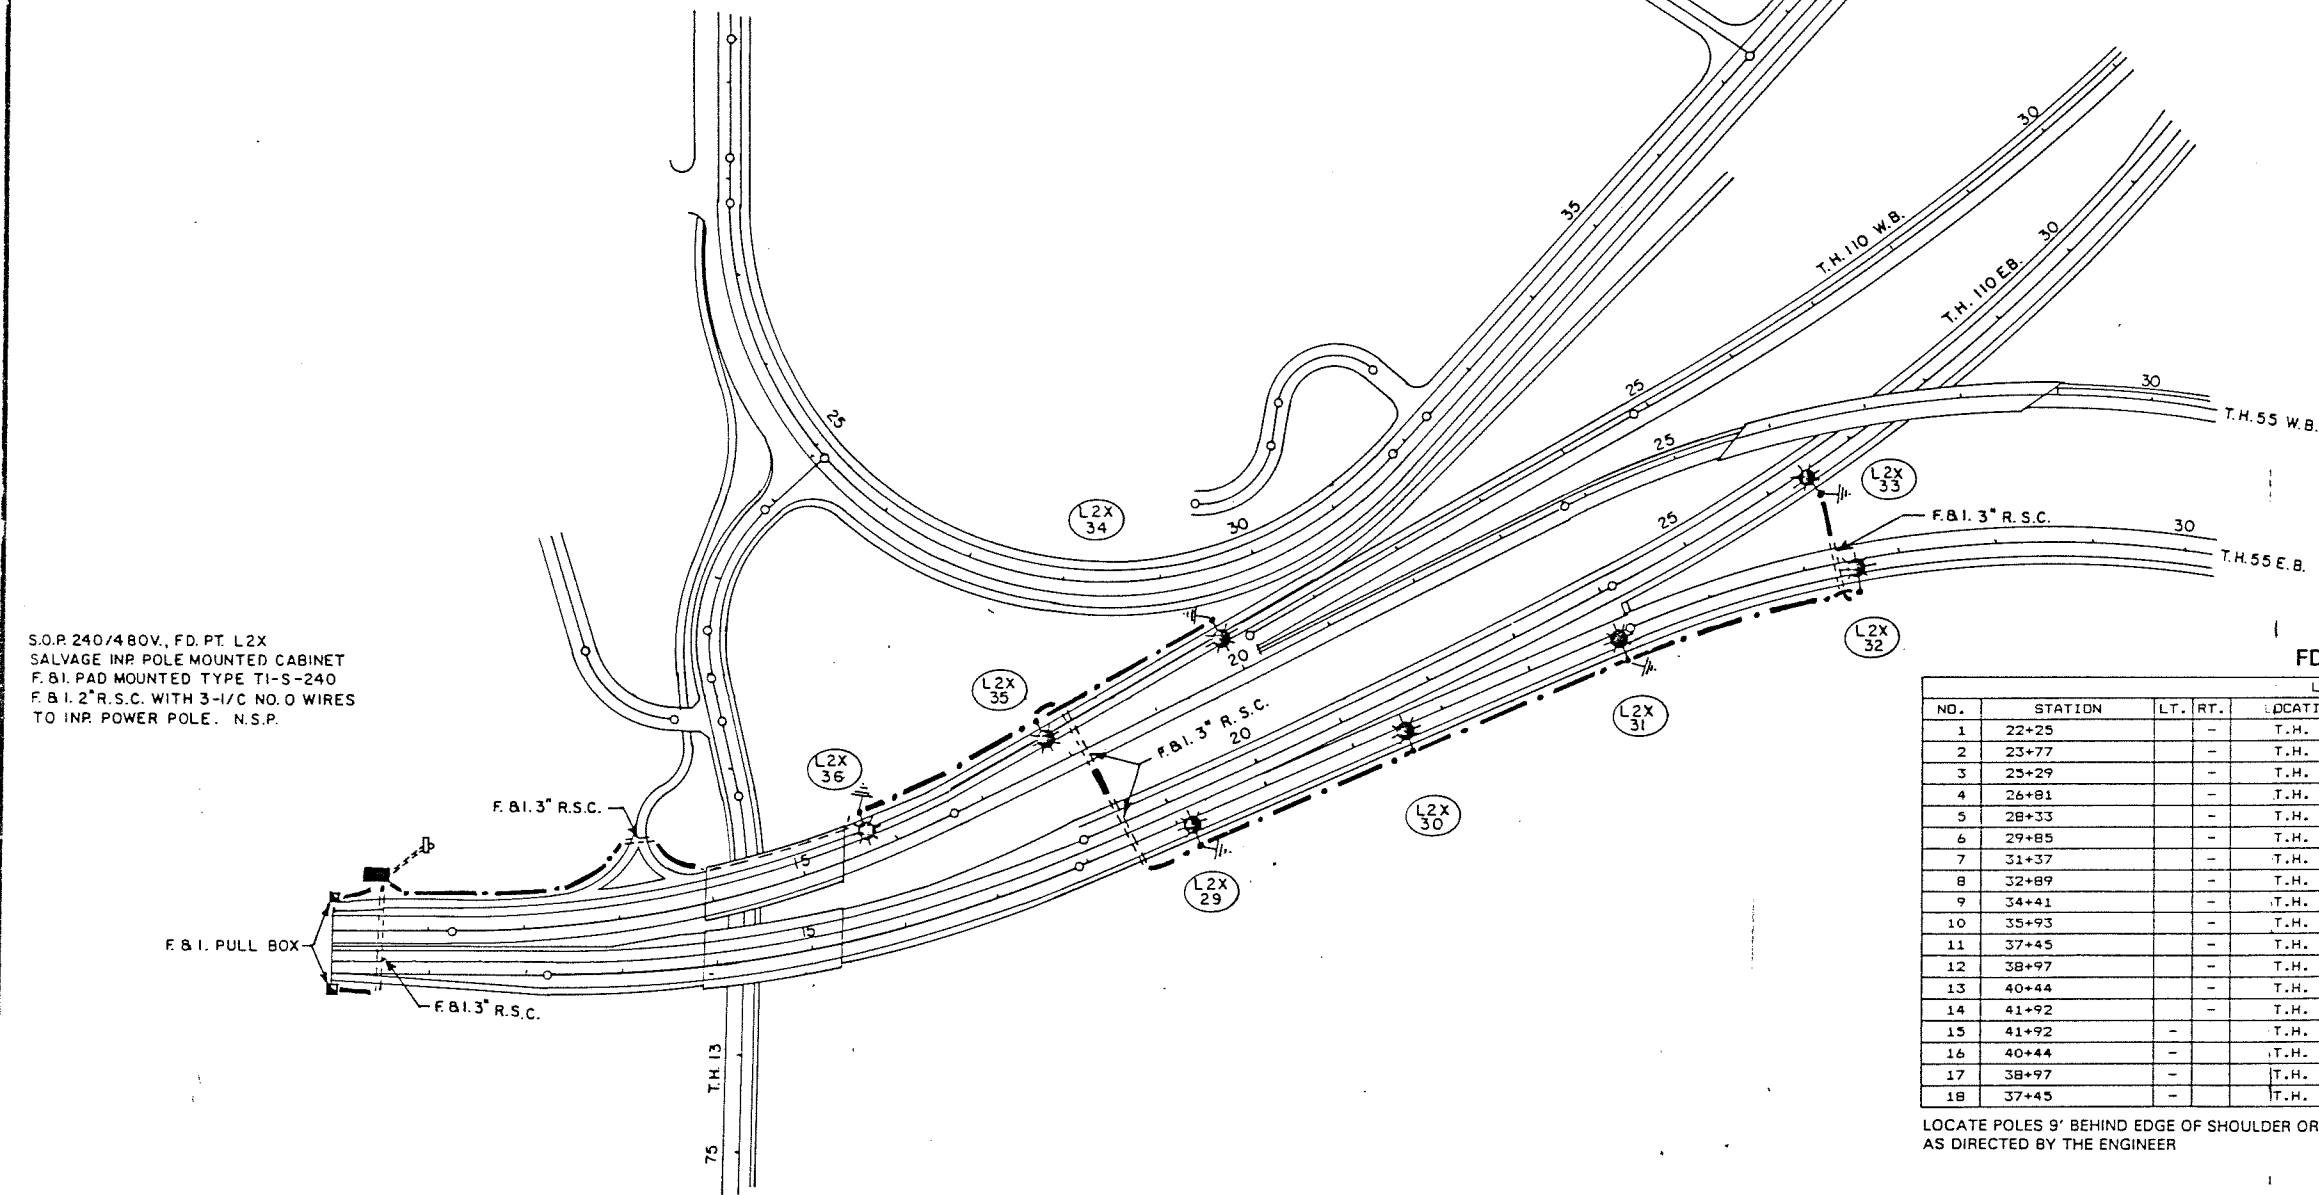


S.O.P. 240/480V., FD. PT. L2X
SALVAGE INR. POLE MOUNTED CABINET
F.B.I. PAD MOUNTED TYPE T1-S-240
F.B.I. 2" R.S.C. WITH 3-1/C NO. 0 WIRES
TO INR. POWER POLE. N.S.P.

FD. PT. L2X, 240/480V.



LIGHT STANDARD LOCATION					LIGHT STANDARD LOCATION						
NO.	STATION	LT.	RT.	LOCATION	TYPE	NO.	STATION	LT.	RT.	LOCATION	TYPE
1	22+25		-	T.H. 55	6B-40	19	35+93		-	T.H. 55	6B-40
2	23+77		-	T.H. 55	6B-40	20	34+41		-	T.H. 55	6B-40
3	25+29		-	T.H. 55	6B-40	21	32+89		-	T.H. 55	6B-40
4	26+81		-	T.H. 55	6B-40	22	31+37		-	T.H. 55	6B-40
5	28+33		-	T.H. 55	6B-40	23	29+85		-	T.H. 55	6B-40
6	29+85		-	T.H. 55	6B-40	24	28+33		-	T.H. 55	6B-40
7	31+37		-	T.H. 55	6B-40	25	26+81		-	T.H. 55	6B-40
8	32+89		-	T.H. 55	6B-40	26	25+29		-	T.H. 55	6B-40
9	34+41		-	T.H. 55	6B-40	27	23+77		-	T.H. 55	6B-40
10	35+93		-	T.H. 55	6B-40	28	22+25		-	T.H. 55	6B-40
11	37+45		-	T.H. 55	6B-40	29	19+10		-	T.H. 55 EB	9-40
12	38+97		-	T.H. 55	6B-40	30	21+60		-	T.H. 55 EB	9-40
13	40+44		-	T.H. 55	6B-40	31	24+00		-	T.H. 55 EB	9-40
14	41+92		-	T.H. 55	6B-40	32	26+50		-	T.H. 55 EB	9-40
15	41+92		-	T.H. 55	6B-40	33	26+40		-	T.H. 110 EB	9-40
16	40+44		-	T.H. 55	6B-40	34	20+00		-	T.H. 55 WB	9-40
17	38+97		-	T.H. 55	6B-40	35	17+90		-	T.H. 55 WB	9-40
18	37+45		-	T.H. 55	6B-40	36	15+80		-	T.H. 55 WB	9-40

LOCATE POLES 9' BEHIND EDGE OF SHOULDER OR AS DIRECTED BY THE ENGINEER

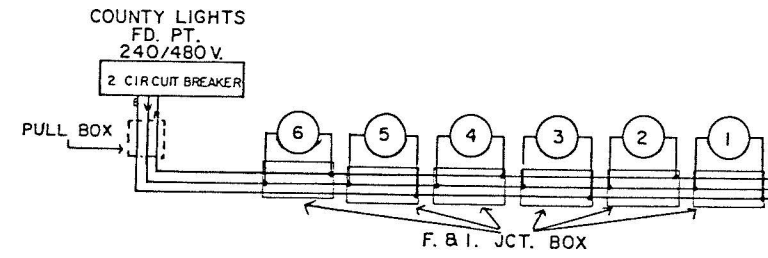


COUNTY
FD. PT.
LIGHTS

LIGHT STANDARD LOCATIONS					
NO.	STATION	LT.	RT.	LOCATION	TYPE
1	29 + 70	-	-	PED. TUNNEL	B
2	29 + 37	-	-	PED. TUNNEL	B
3	29 + 04	-	-	PED. TUNNEL	B
4	28 + 71	-	-	PED. TUNNEL	B
5	28 + 38	-	-	PED. TUNNEL	B
6	28 + 05	-	-	PED. TUNNEL	B

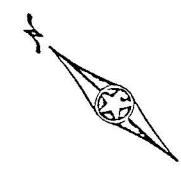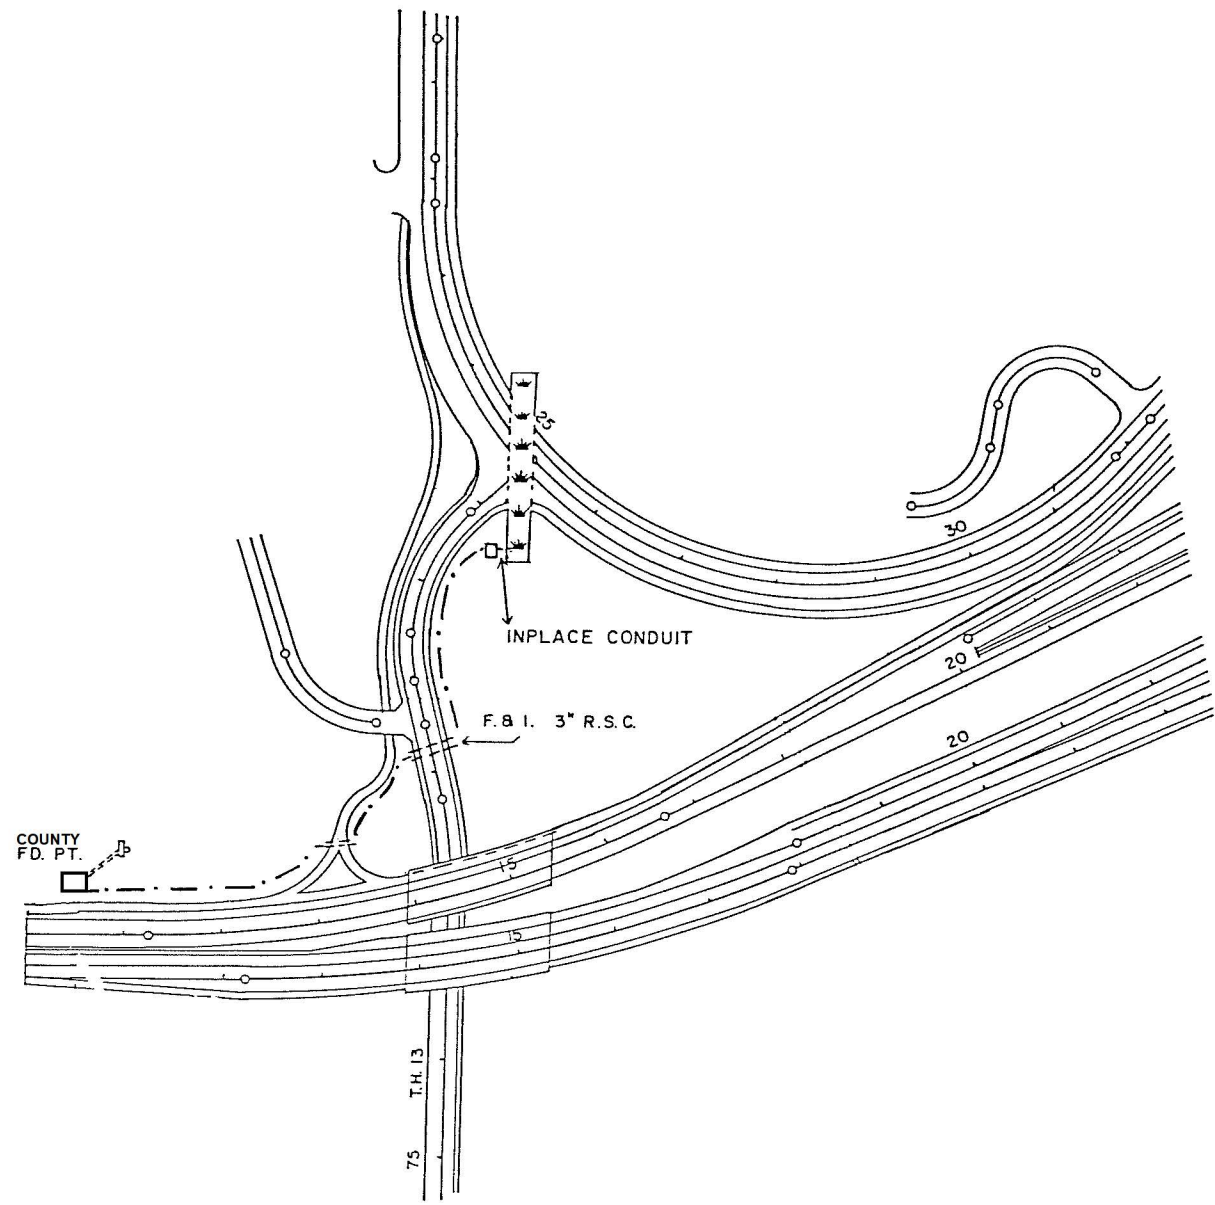

INPLACE 1" R.S.C. - F. & I. NO. 10 CONDUCTOR AS SHOWN IN WIRING DIAGRAM

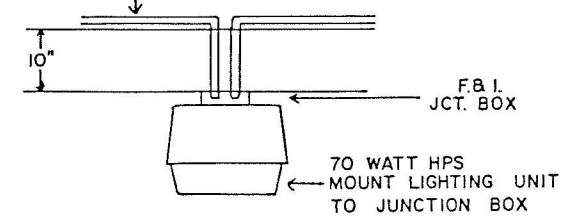

UNDERPASS LIGHTING UNIT TYPE B
HOLOPHANE PARKPAK
PARK-070-HP-24-CE-BZ-S-FI



AS-BUILT

PEDESTRIAN TUNNEL LIGHTING
(COUNTY LIGHTS)

S.O.P. JIH BY OTHERS
F&I 4-40 AMP CIRCUIT BREAKERS


LEGEND

- SOURCE OF POWER (PAD MOUNTED)
- ==== F. & I. RIGID STEEL CONDUIT (SIZE AS NOTED)
- ⊥ F. & I. PERMANENT GROUND ROD, 25 OHMS OR LESS
- ★ 40' LIGHTING UNIT, 200 WATT HIGH PRESSURE SODIUM LUMINAIRE
- DIRECT BURIED POWER CABLE, 3 CONDUCTOR NO. 4 ARMORED CABLE, SEE SPEC NO. 3804 OR 3805
- F. & I. PULL BOX
- ⊕ UNDERPASS LIGHTING UNIT, TYPE B, 70 WATT HIGH PRESSURE SODIUM
- INPLACE PULL BOX

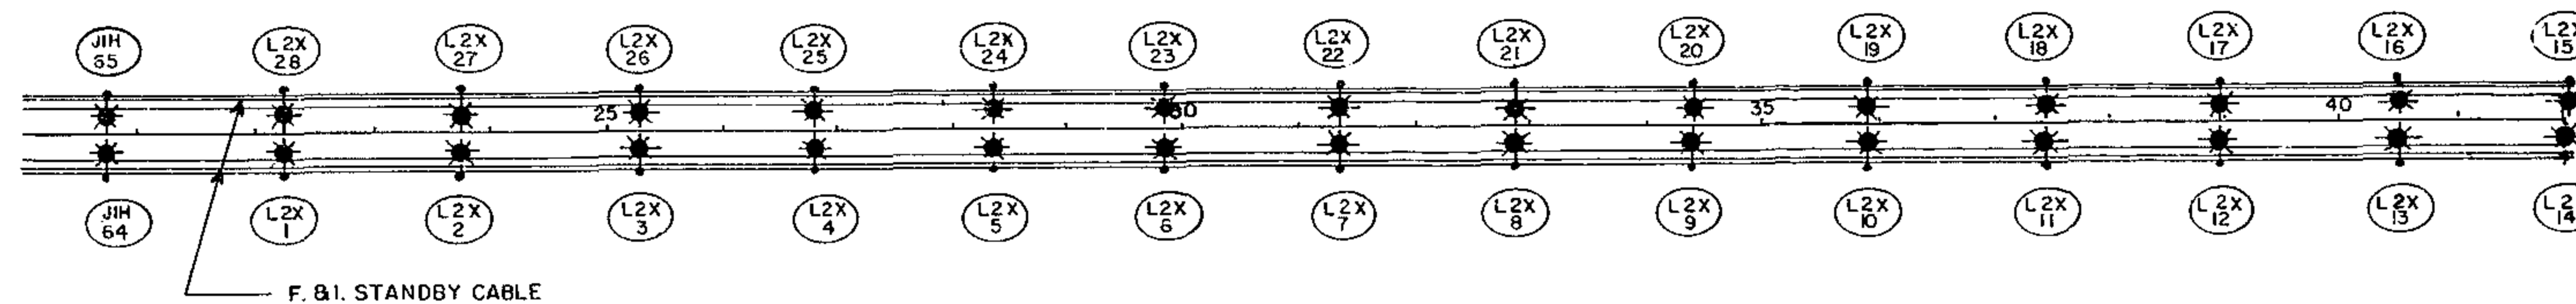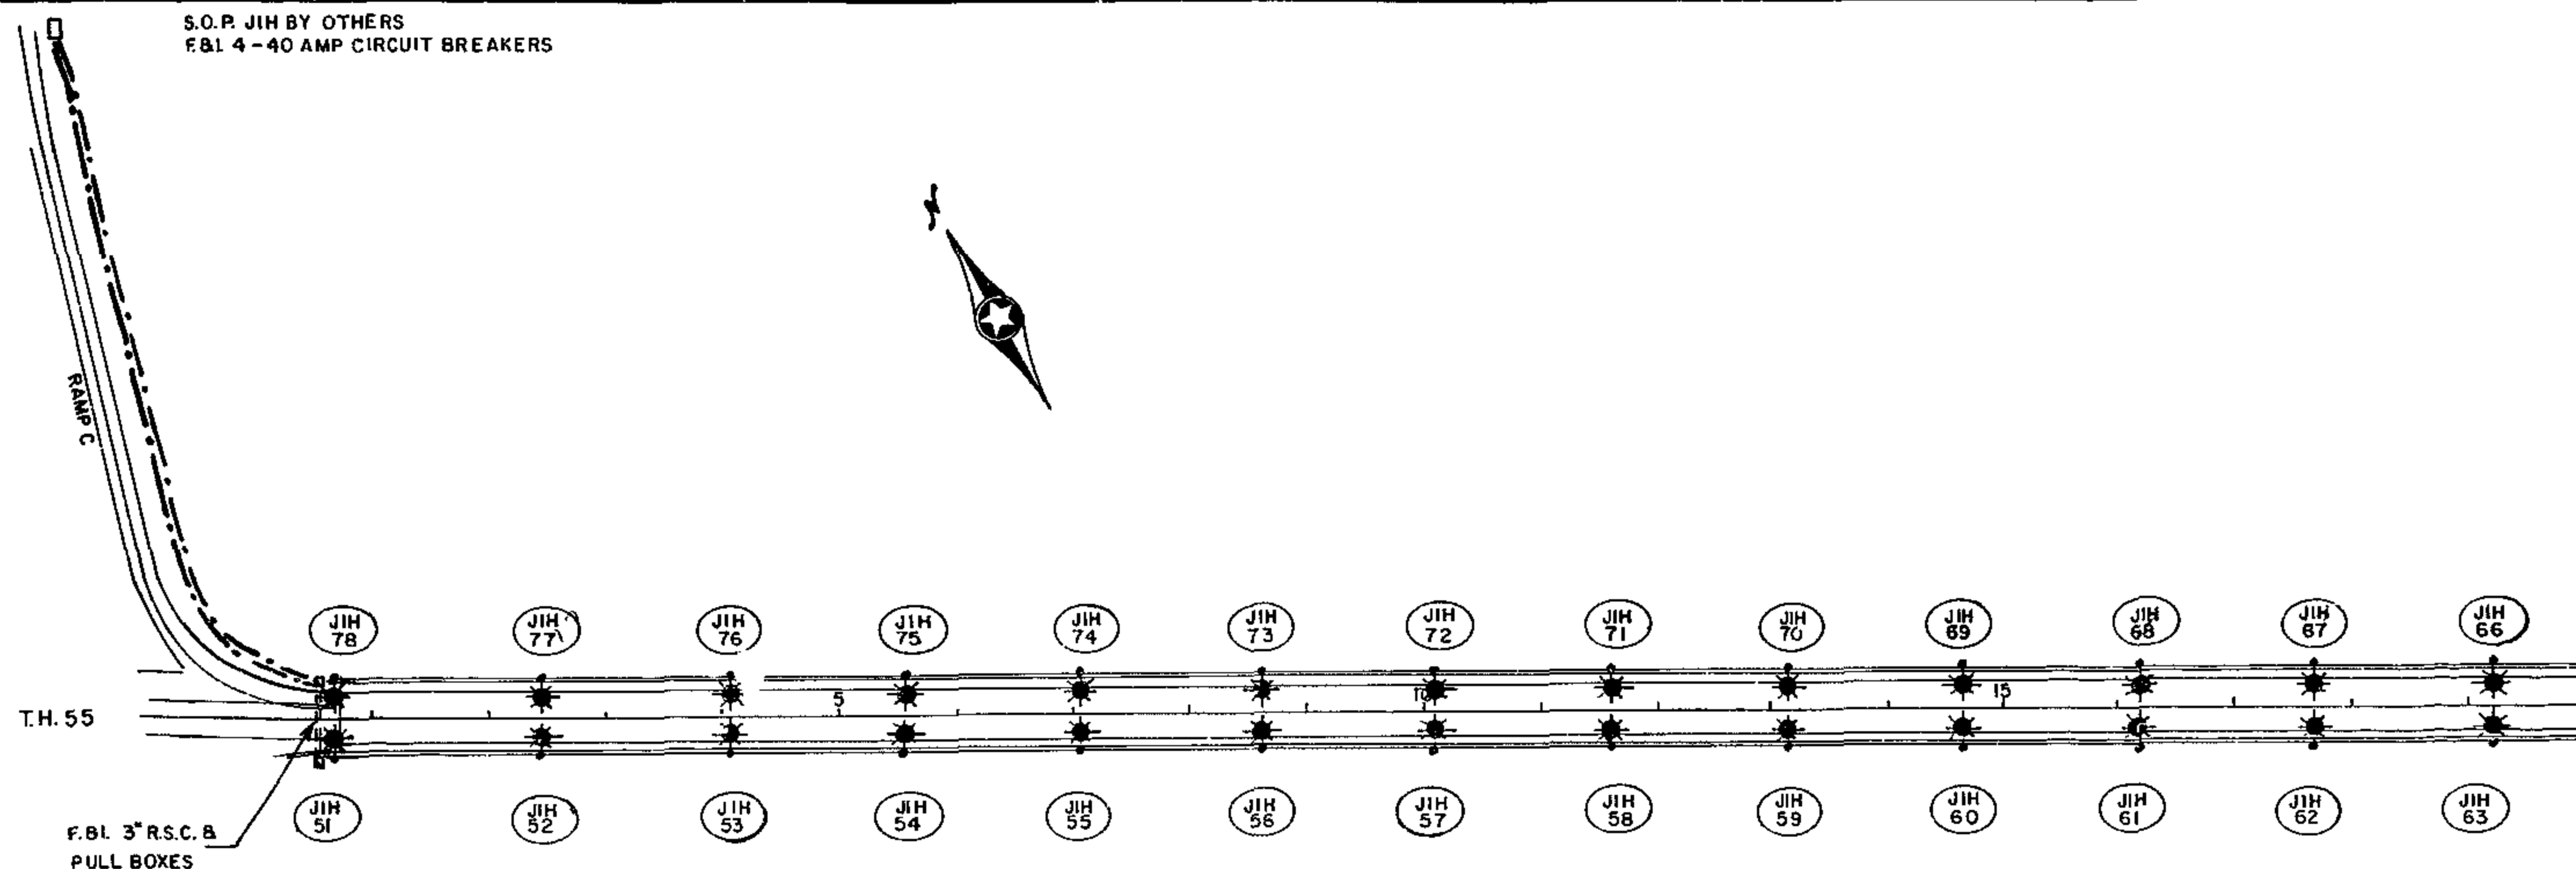

FD. PT. JIH INP., 240/480V.

LIGHT STANDARD LOCATION					
NO.	STATION	LT.	RT.	LOCATION	TYPE
51	0+79		-	T. H. 55	6B-40
52	2+49		-	T. H. 55	6B-40
53	4+01		-	T. H. 55	6B-40
54	5+53		-	T. H. 55	6B-40
55	7+05		-	T. H. 55	6B-40
56	8+57		-	T. H. 55	6B-40
57	10+09		-	T. H. 55	6B-40
58	11+61		-	T. H. 55	6B-40
59	13+13		-	T. H. 55	6B-40
60	14+65		-	T. H. 55	6B-40
61	16+17		-	T. H. 55	6B-40
62	17+69		-	T. H. 55	6B-40
63	19+21		-	T. H. 55	6B-40
64	20+73		-	T. H. 55	6B-40
65	20+73		-	T. H. 55	6B-40
66	19+21		-	T. H. 55	6B-40
67	17+69		-	T. H. 55	6B-40
68	16+17		-	T. H. 55	6B-40
69	14+65		-	T. H. 55	6B-40
70	13+13		-	T. H. 55	6B-40
71	11+61		-	T. H. 55	6B-40
72	10+09		-	T. H. 55	6B-40
73	8+57		-	T. H. 55	6B-40
74	7+05		-	T. H. 55	6B-40
75	5+53		-	T. H. 55	6B-40
76	4+01		-	T. H. 55	6B-40
77	2+49		-	T. H. 55	6B-40
78	0+77		-	T. H. 55	6B-40

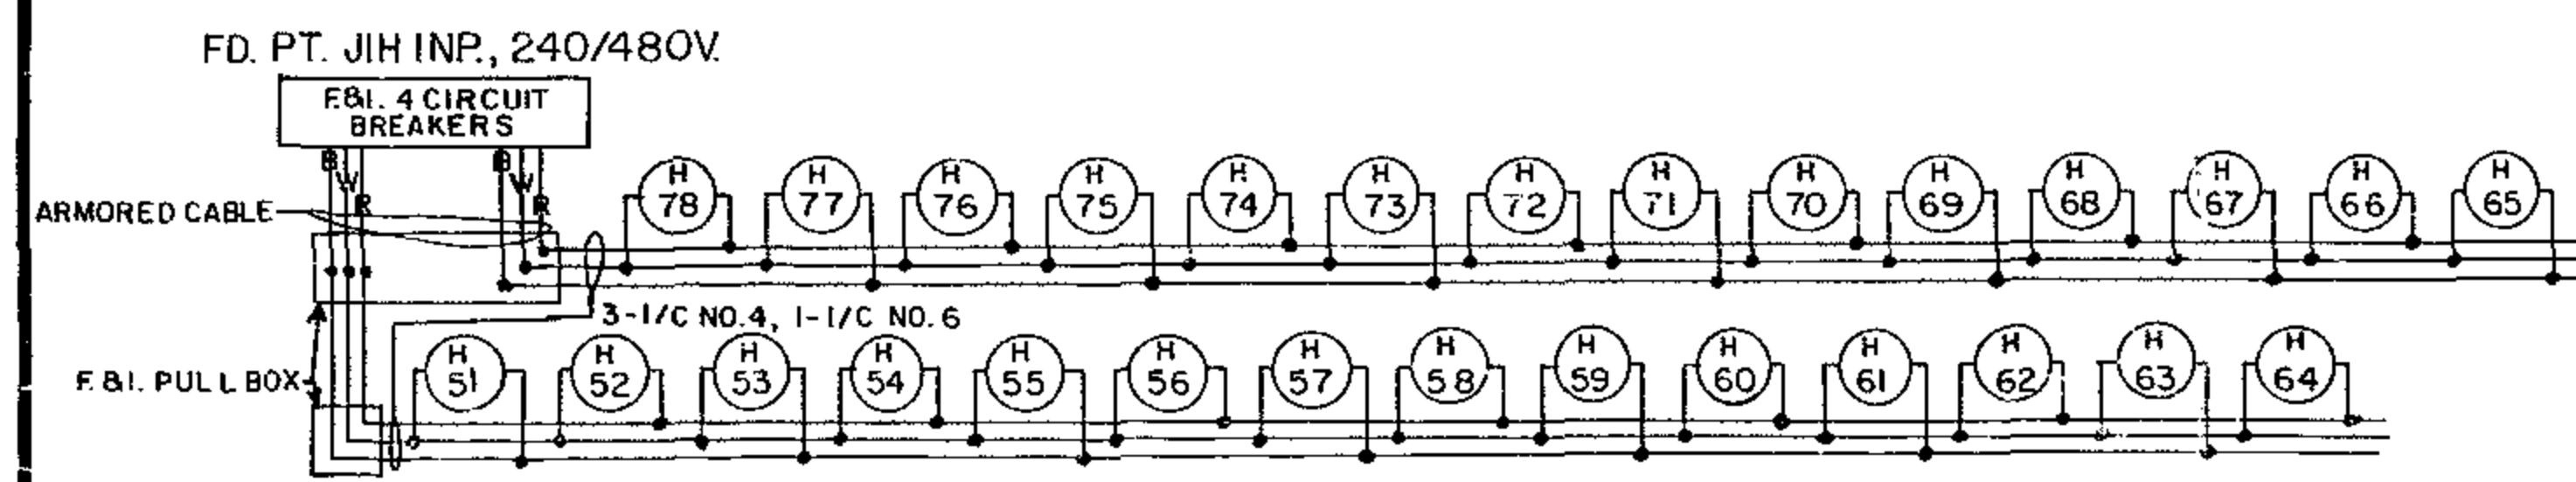

B AND R DENOTE CURRENT CARRYING CONDUCTORS
W DENOTES NEUTRAL CONDUCTOR

TELETYPE DIST. 10/4 - 10/4 - 4/81 M5127