


FD. PT. P6C LIGHTING STANDARDS & BASES				
NO.	STATION	LT. RT.	LOCATION	TYPE
(1) 1	1190 + 25		T.H. 394 MEDIAN	680-49
(1) 2	1193 + 25		T.H. 394 MEDIAN	680-49
(1) 3	1196 + 25		T.H. 394 MEDIAN	680-49
(1) 4	1199 + 25		T.H. 394 MEDIAN	680-49
(13) 5	1200 + 65		T.H. 394 E.B.	L
(13) 22	1200 + 65		T.H. 394 W.B.	L
(1) 6	1202 + 55		T.H. 394 MEDIAN	680-49
(1) 7	1205 + 55		T.H. 394 MEDIAN	680-49
(1) 8	1208 + 55		T.H. 394 MEDIAN	680-49
(1) 9	1211 + 55		T.H. 394 MEDIAN	680-49
(1) 10	1214 + 55		T.H. 394 MEDIAN	680-49
(1) 11	1217 + 55		T.H. 394 MEDIAN	680-49
(1) 16				

FD. PT. P6C LIGHTING STANDARDS & BASES				
NO.	STATION	LT. RT.	LOCATION	TYPE
(1) 12	1220 + 55		T.H. 394 MEDIAN	680-49
(1) 13	1223 + 55		T.H. 394 MEDIAN	680-49
(2) 27	1192 + 30		T.H. 394 E.B.	6-40
(2) 28	194 + 75		S.W. RAMP	6-40
(2) 29	196 + 75		S.W. RAMP	6-40
(2) 30	198 + 35		S.W. RAMP	6-40
(2) 31	202 + 55		S.E. RAMP	6-40
(2) 32	204 + 95		S.E. RAMP	6-40
(2) 33	207 + 35		S.E. RAMP	6-40
(2) 34	1209 + 75		T.H. 394 E.B.	6-40
(2) 35	1211 + 90		T.H. 394 W.B.	6-40
(2) 36	209 + 45		N.E. RAMP	6-40
(2) 37	207 + 05		N.E. RAMP	6-40
(2) 38	204 + 65		N.E. RAMP	6-40
(2) 39	202 + 25		N.E. RAMP	6-40
(2) 40	198 + 80		N.W. RAMP	6-40
(2) 41	196 + 40		N.W. RAMP	6-40
(2) 42	194 + 00		N.W. RAMP	6-40
(2) 43	1191 + 60		T.H. 394 W.B.	6-40

- (1) - 250 WATT HIGH PRESSURE SODIUM LIGHTING UNITS
- (2) - 200 WATT HIGH PRESSURE SODIUM LIGHTING UNITS
- (13) - 200 WATT HIGH PRESSURE SODIUM UNDERPASS LIGHTS

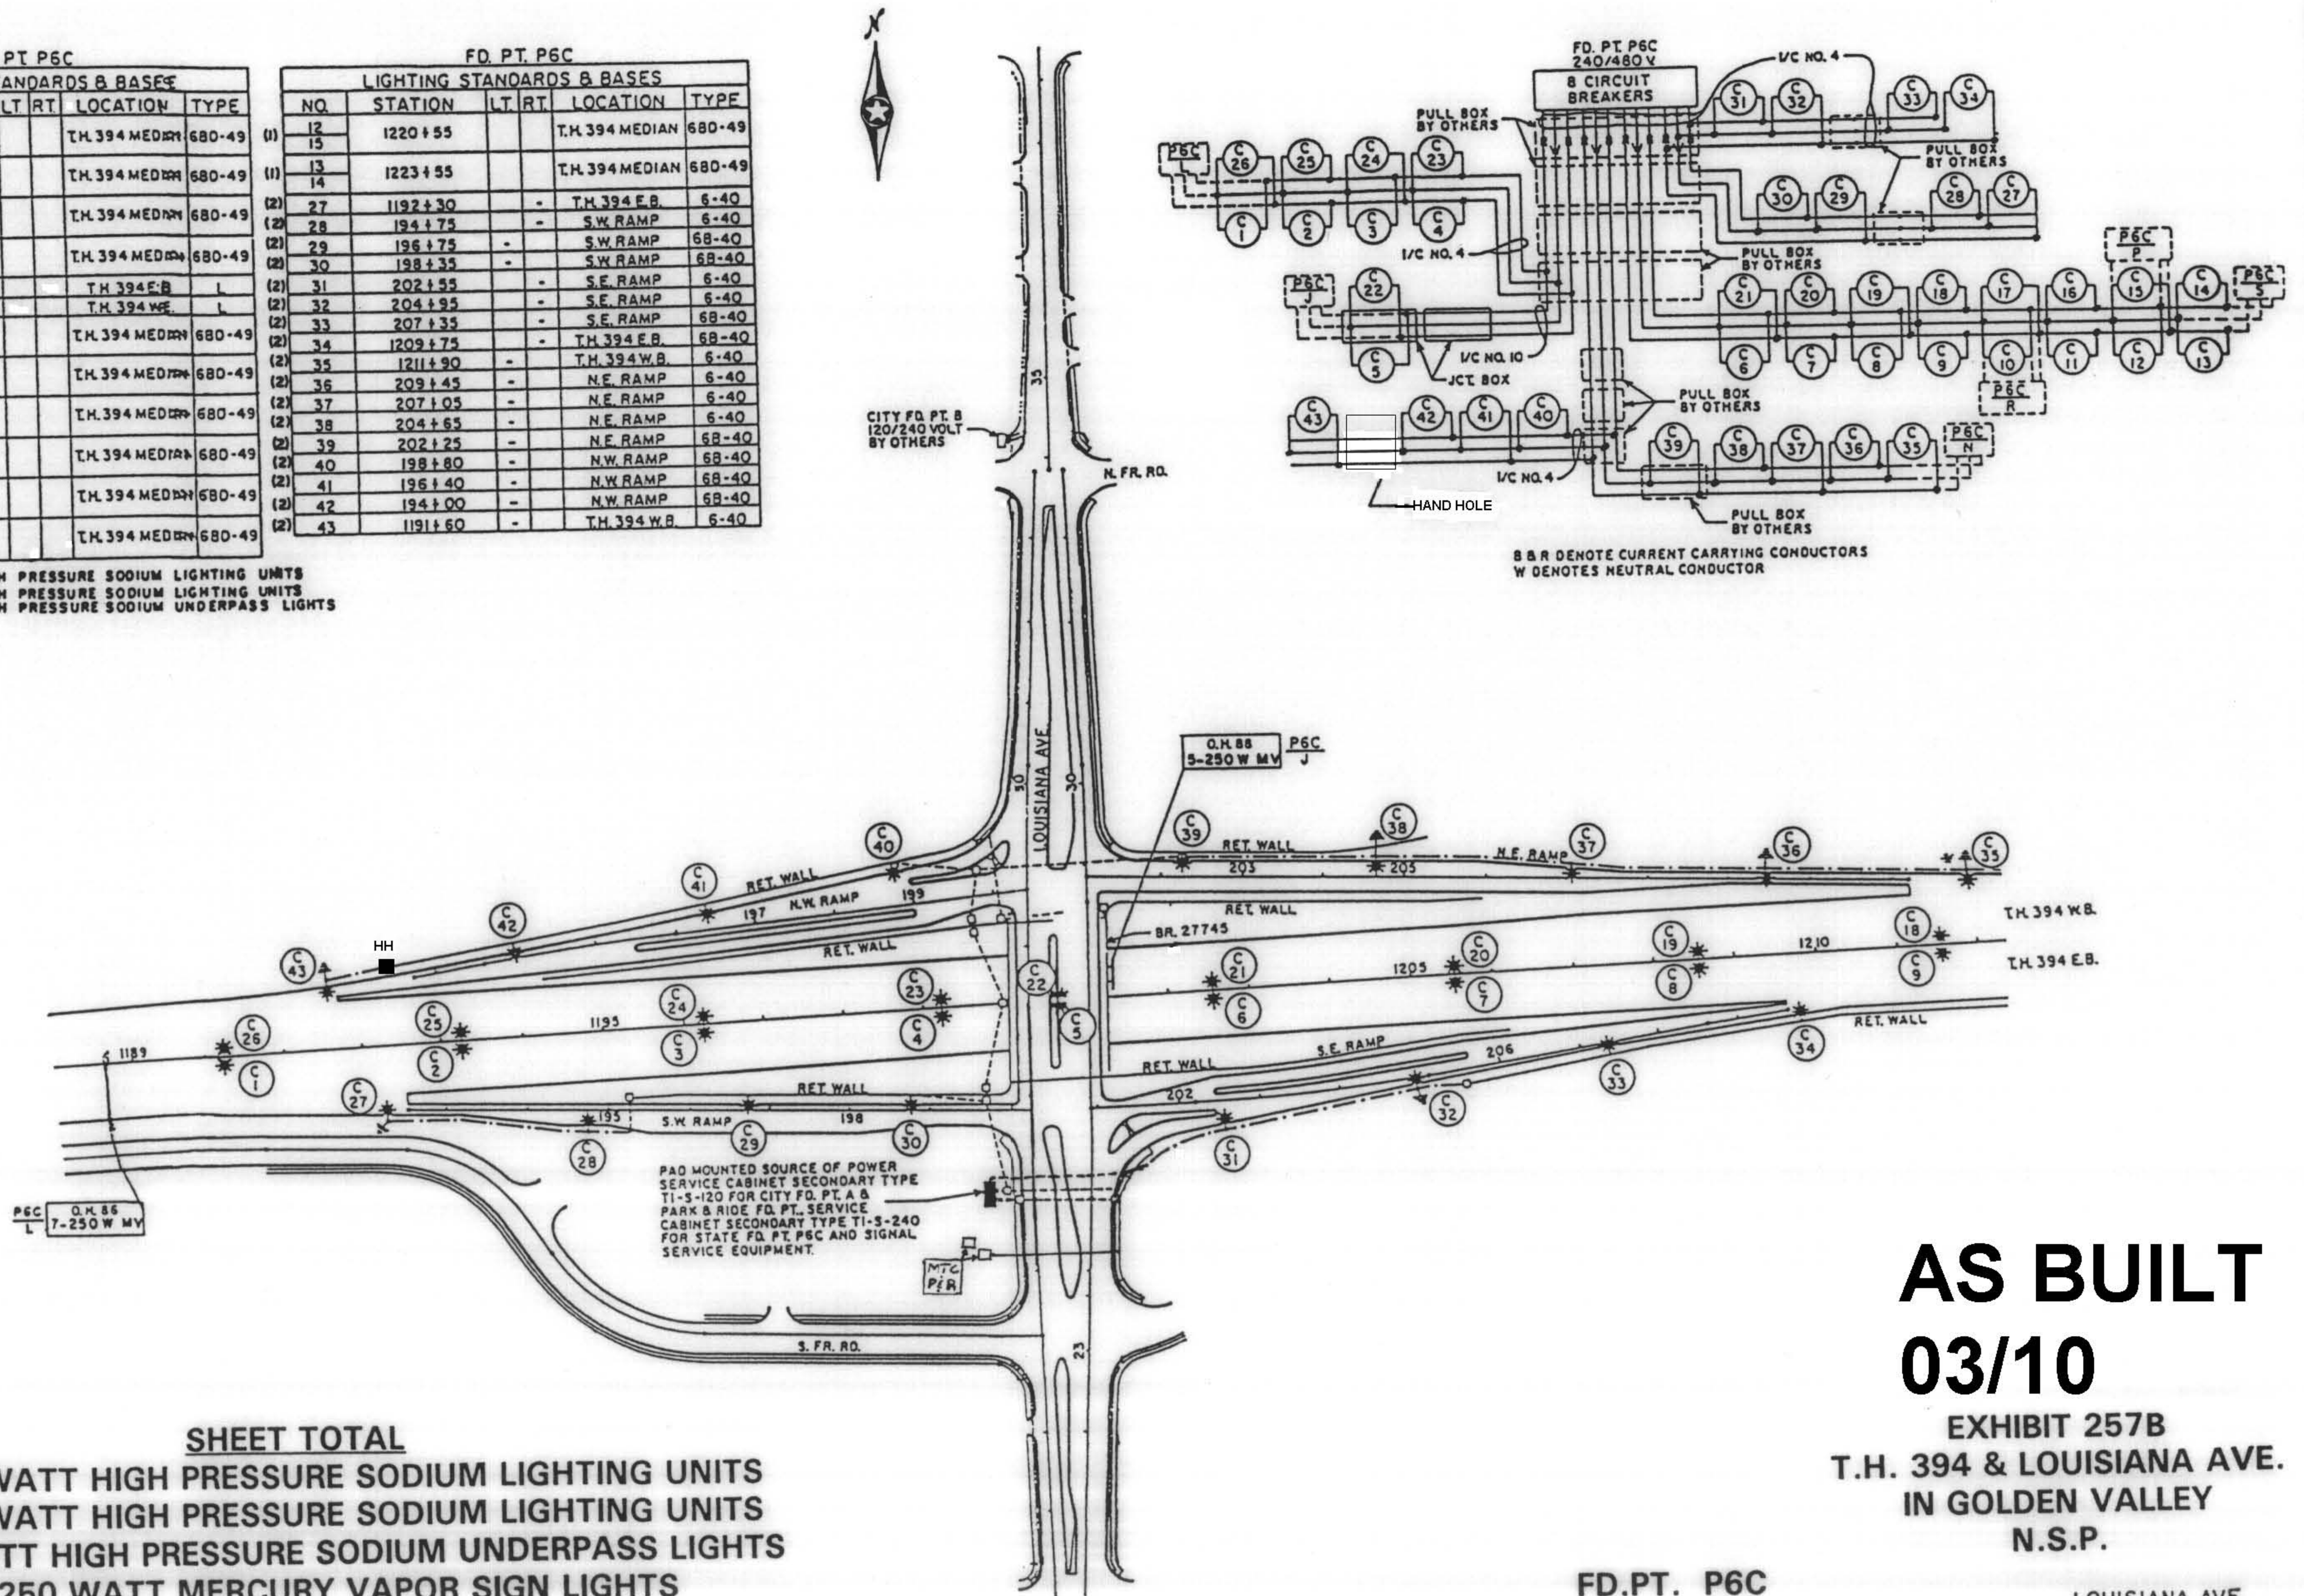


PAD MOUNTED SOURCE OF POWER SERVICE CABINET SECONDARY TYPE T1-S-120 FOR CITY FD. PT. A & PARK & RIDE FD. PT. SERVICE CABINET SECONDARY TYPE T1-S-240 FOR STATE FD. PT. P6C AND SIGNAL SERVICE EQUIPMENT.

**AS BUILT**  
**03/10**  
 EXHIBIT 257B  
 T.H. 394 & LOUISIANA AVE.  
 IN GOLDEN VALLEY  
 N.S.P.

**SHEET TOTAL**  
 16 - 250 WATT HIGH PRESSURE SODIUM LIGHTING UNITS  
 17 - 200 WATT HIGH PRESSURE SODIUM LIGHTING UNITS  
 2 - 200 WATT HIGH PRESSURE SODIUM UNDERPASS LIGHTS  
 12 - 250 WATT MERCURY VAPOR SIGN LIGHTS




EXHIBIT 257 B  
T.H. 394  
BET. LOUISIANA AVE. & XENIA AVE.  
IN GOLDEN VALLEY  
N.S.P.

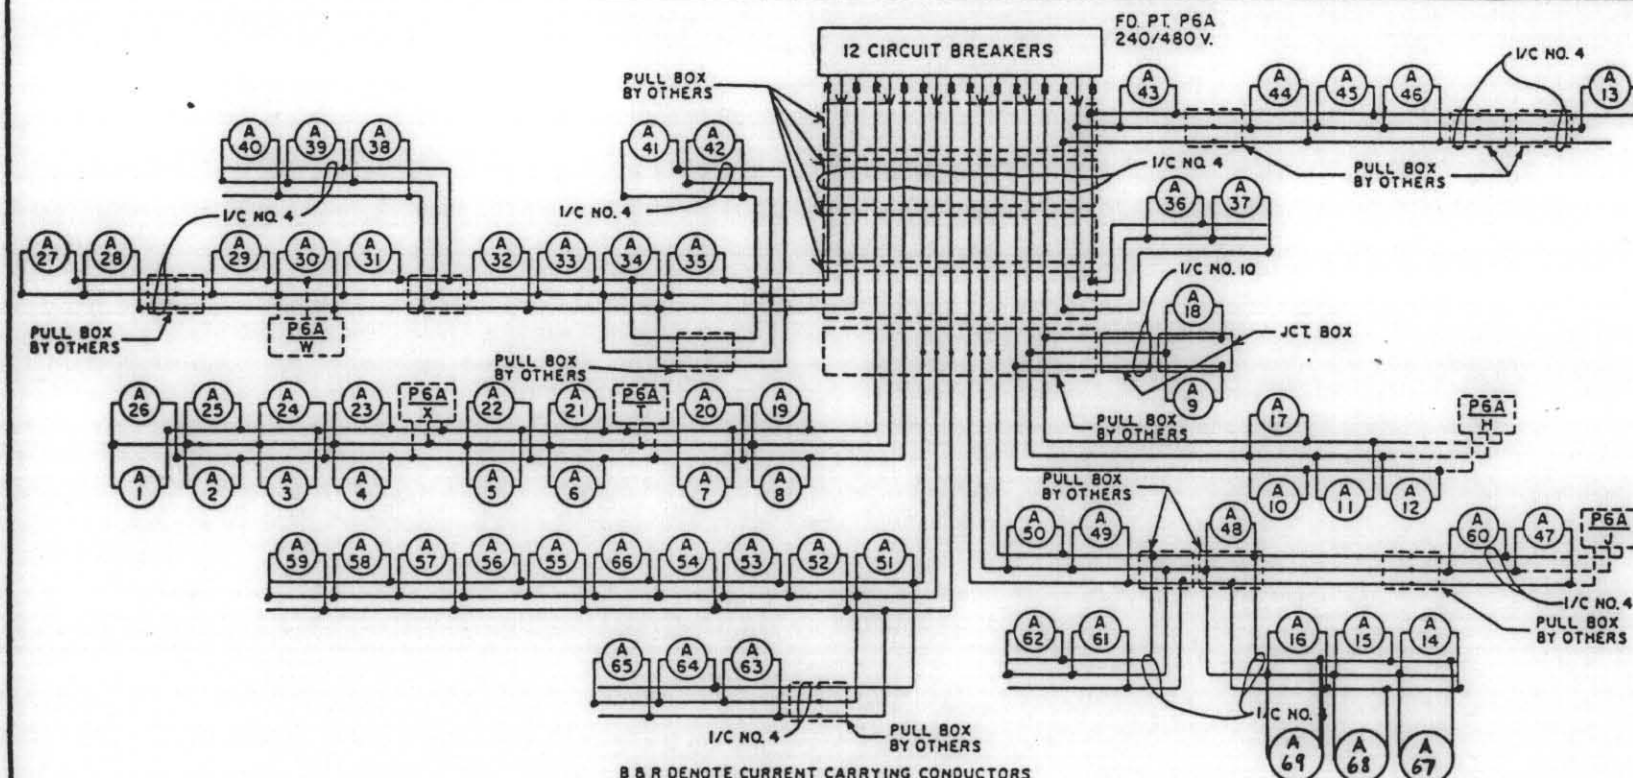

B & R DENOTE CURRENT CARRYING CONDUCTORS  
W DENOTES NEUTRAL CONDUCTOR

**SHEET TOTAL**  
18 - 250 WATT HIGH PRESSURE SODIUM LIGHTING UNITS  
10 - 200 WATT HIGH PRESSURE SODIUM LIGHTING UNITS  
11 - 250 WATT MERCURY VAPOR SIGN LIGHTS

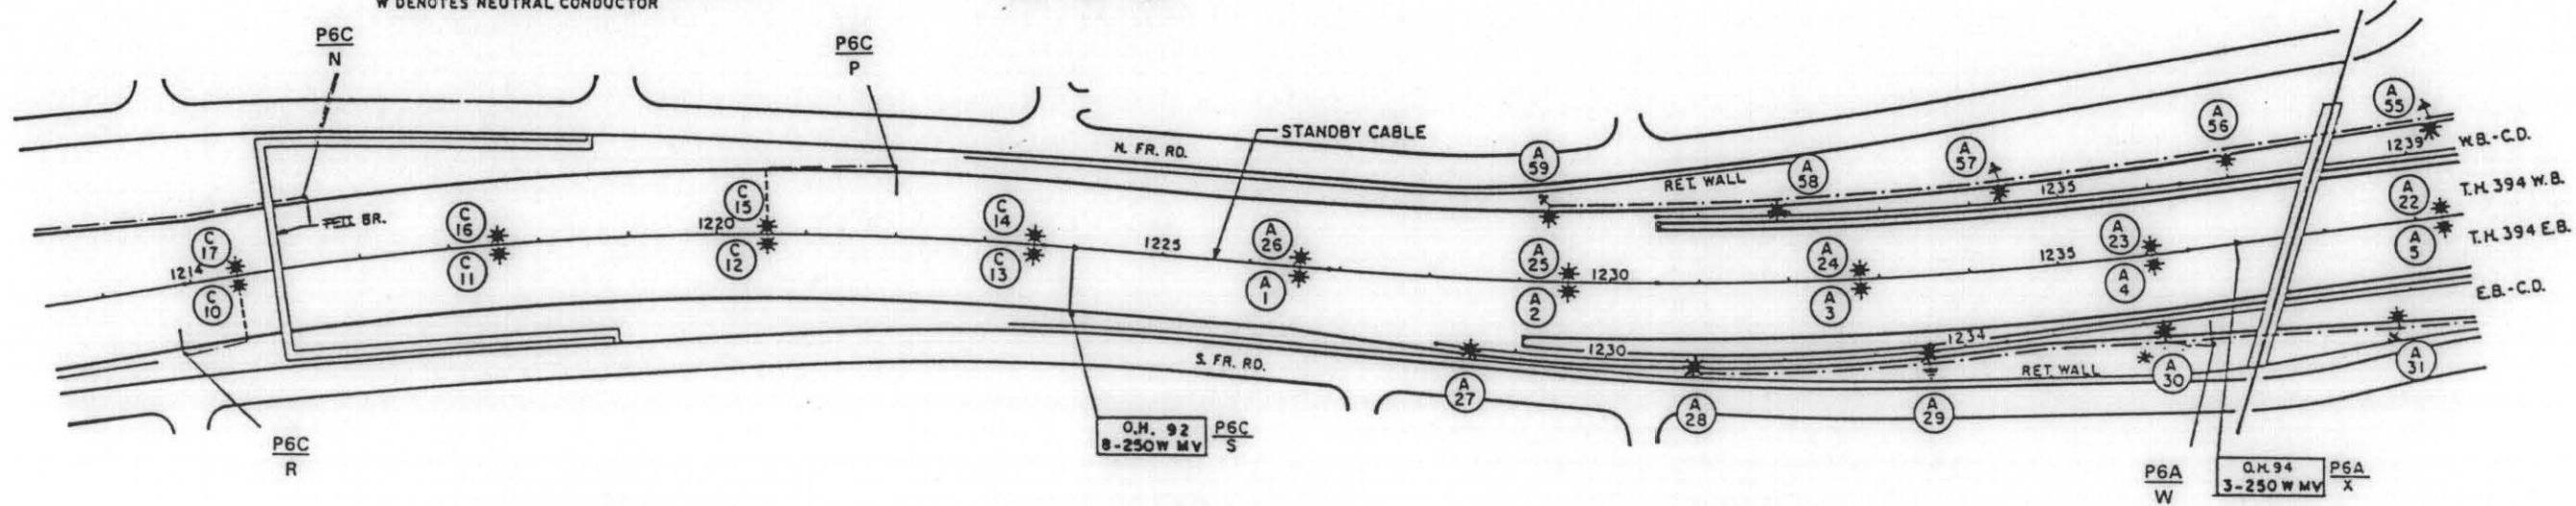

FD. PT. P6A

NO.	STATION	LT.	RT.	LOCATION	TYPE
1	1226+55			T.H. 394 MEDIAN	680-49
26	1229+55				
2	1229+55				
25	1229+55				
3	1232+80				
24	1232+80				
4	1236+05				
23	1236+05				
5	1239+30				
22	1239+30				
6	1242+55			T.H. 394 MEDIAN	
21	1242+55				
7	1245+80			T.H. 394 W.B.	
20	1245+80				
8	1249+05			T.H. 394 W.B.	680-49
19	1249+05				

FD. PT. P6A

NO.	STATION	LT.	RT.	LOCATION	TYPE
9	1251+15			T.H. 394 E.B.	L
18	1251+15			HOV LANE	L
10	1252+85			T.H. 394 E.B.	680-49
17	1252+85				
11	1255+90			T.H. 394 E.B.	68-49
12	1258+80			T.H. 394 E.B.	68-49
13	1262+15			T.H. 394 E.B.	68-49
14	1261+70			T.H. 394 W.B.	680-49
15	1258+70			T.H. 394 W.B.	680-49
16	1255+70			T.H. 394 W.B.	680-49
27	1228+50			E.B. C-D	68-40
28	1231+00				68-40
29	1233+60				6-40
30	1236+20				6-40
31	1238+80				6-40
32	1241+05			E.B. C-D	6-40

FD. PT. P6A

NO.	STATION	LT.	RT.	LOCATION	TYPE
33	1244+30			E.B. C-D	6-40
34	1247+55			E.B. C-D	6-40
35	1250+10			E.B. C-D	6-40
36	1253+40			E.B. C-D	6-40
37	1255+90			E.B. C-D	6-40
38	241+20			SW RAMP	68-40
39	243+65			SW RAMP	68-40
40	246+10			SW RAMP	68-40
41	248+55			SW RAMP	68-40
42	250+95			SW RAMP	6-40
43	253+60			SE RAMP	6-40
44	255+90			SE RAMP	68-40
45	258+30			SE RAMP	68-40
46	1260+50			SE RAMP	68-40
47	1260+25			W.B. C-D	68-40
48	1257+20			W.B. C-D	6-40
49	1254+70			W.B. C-D	6-40

FD. PT. P6A

NO.	STATION	LT.	RT.	LOCATION	TYPE
50	1252+20			W.B. C-D	6-40
51	1249+30				
52	1246+80				
53	1244+20				
54	1241+70				
55	1239+30				
56	1237+00				
57	1234+40				
58	1231+80			W.B. C-D	
59	1229+30			T.H. 394 W.B.	6-40
60	257+60			N.E. RAMP	68-40
61	255+00			N.E. RAMP	
62	252+40			N.E. RAMP	
63	249+00			N.W. RAMP	
64	246+55			N.W. RAMP	
65	244+15			N.W. RAMP	68-40
66	241+70			N.W. RAMP	6-40
67					
68					
69					

(1)-250 WATT HIGH PRESSURE SODIUM LIGHTING UNITS  
(2)-200 WATT HIGH PRESSURE SODIUM LIGHTING UNITS  
(3)-200 WATT HIGH PRESSURE SODIUM UNDERPASS LIGHTS

FD. PTS. P6C, P6A

STA. 1212+35 - 1239+50

State Proj. No. 2789-70 (T.H. 394=10)

Sheet No. 3 of 4 Sheets