



LEGEND

- PAD MOUNTED SOURCE OF POWER
- PAD MOUNTED SOURCE OF POWER BY OTHERS
- RIGID STEEL CONDUIT (SIZE AS INDICATED ON PLAN)
- CONDUIT BY OTHERS
- PULL BOX BY OTHERS
- * HIGH PRESSURE SODIUM LIGHTING UNIT (TYPE AND WATTAGE AS INDICATED)
- ** HIGH PRESSURE SODIUM TWIN MAST ARM LIGHTING UNIT (TYPE AND WATTAGE AS INDICATED)
- ‡ 200 WATT HIGH PRESSURE SODIUM UNDERPASS LIGHT
- INSTALL LIGHTING UNIT
- ⊗ TWIN MAST ARM LIGHTING UNIT BY OTHERS
- ⊕ COMBINATION SIGNAL AND LIGHTING UNIT BY OTHERS
- DIRECT BURIED POWER CABLE 3 WIRE NO. 4
- A.W.G. ARMORED CABLE SPEC. NO. 3804 & 3805
- DIRECT BURIED POWER CABLE BY OTHERS
- DIRECT BURIED UNDERGROUND WIRE 4-1/C NO. 6
- * PROVIDE ONE ADDITIONAL CONDUIT ELBOW FOR Q.H. SIGN
- ⊥ PERMANENT GROUND ROD (25 OHMS OR LESS)
- OVERHEAD SIGN BY OTHERS

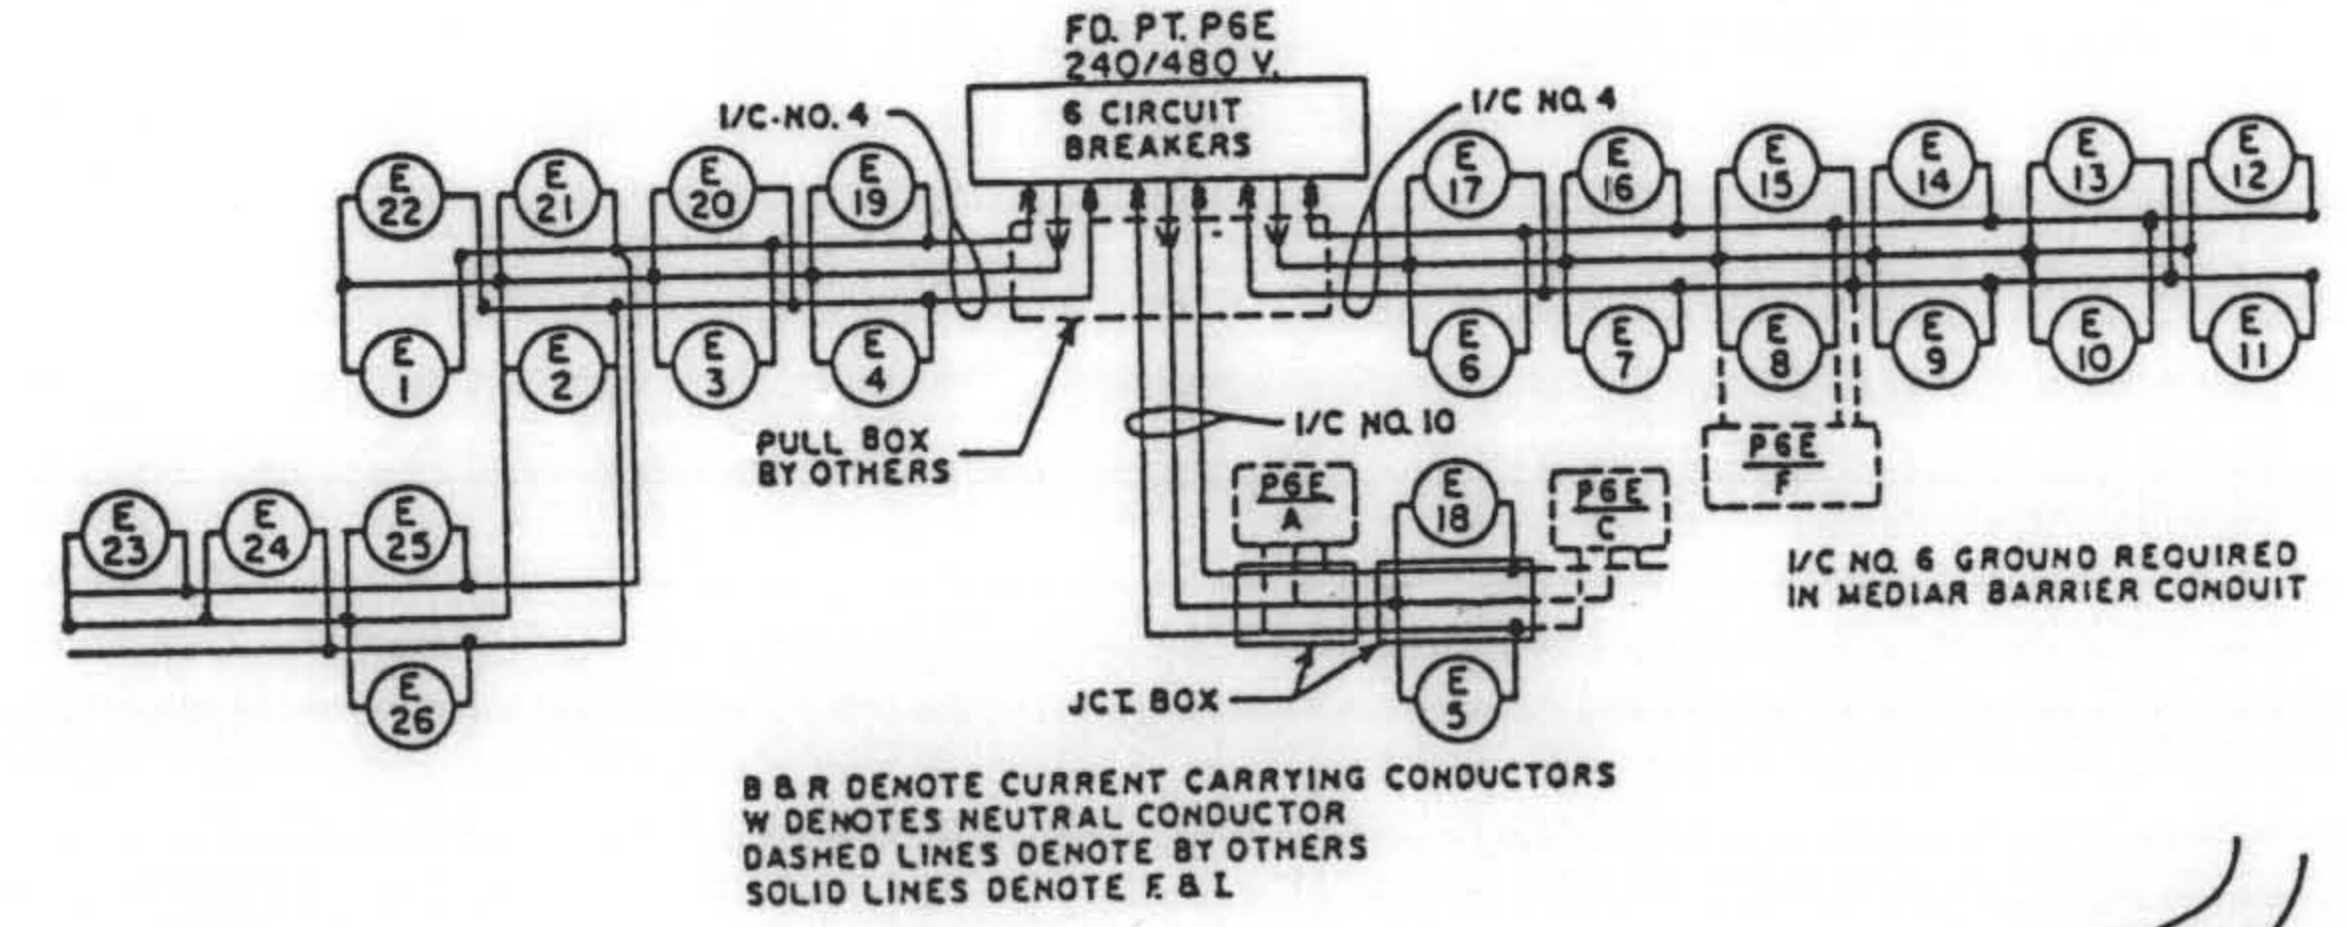

B & R DENOTE CURRENT CARRYING CONDUCTORS
 W DENOTES NEUTRAL CONDUCTOR
 DASHED LINES DENOTE BY OTHERS
 SOLID LINES DENOTE F & I

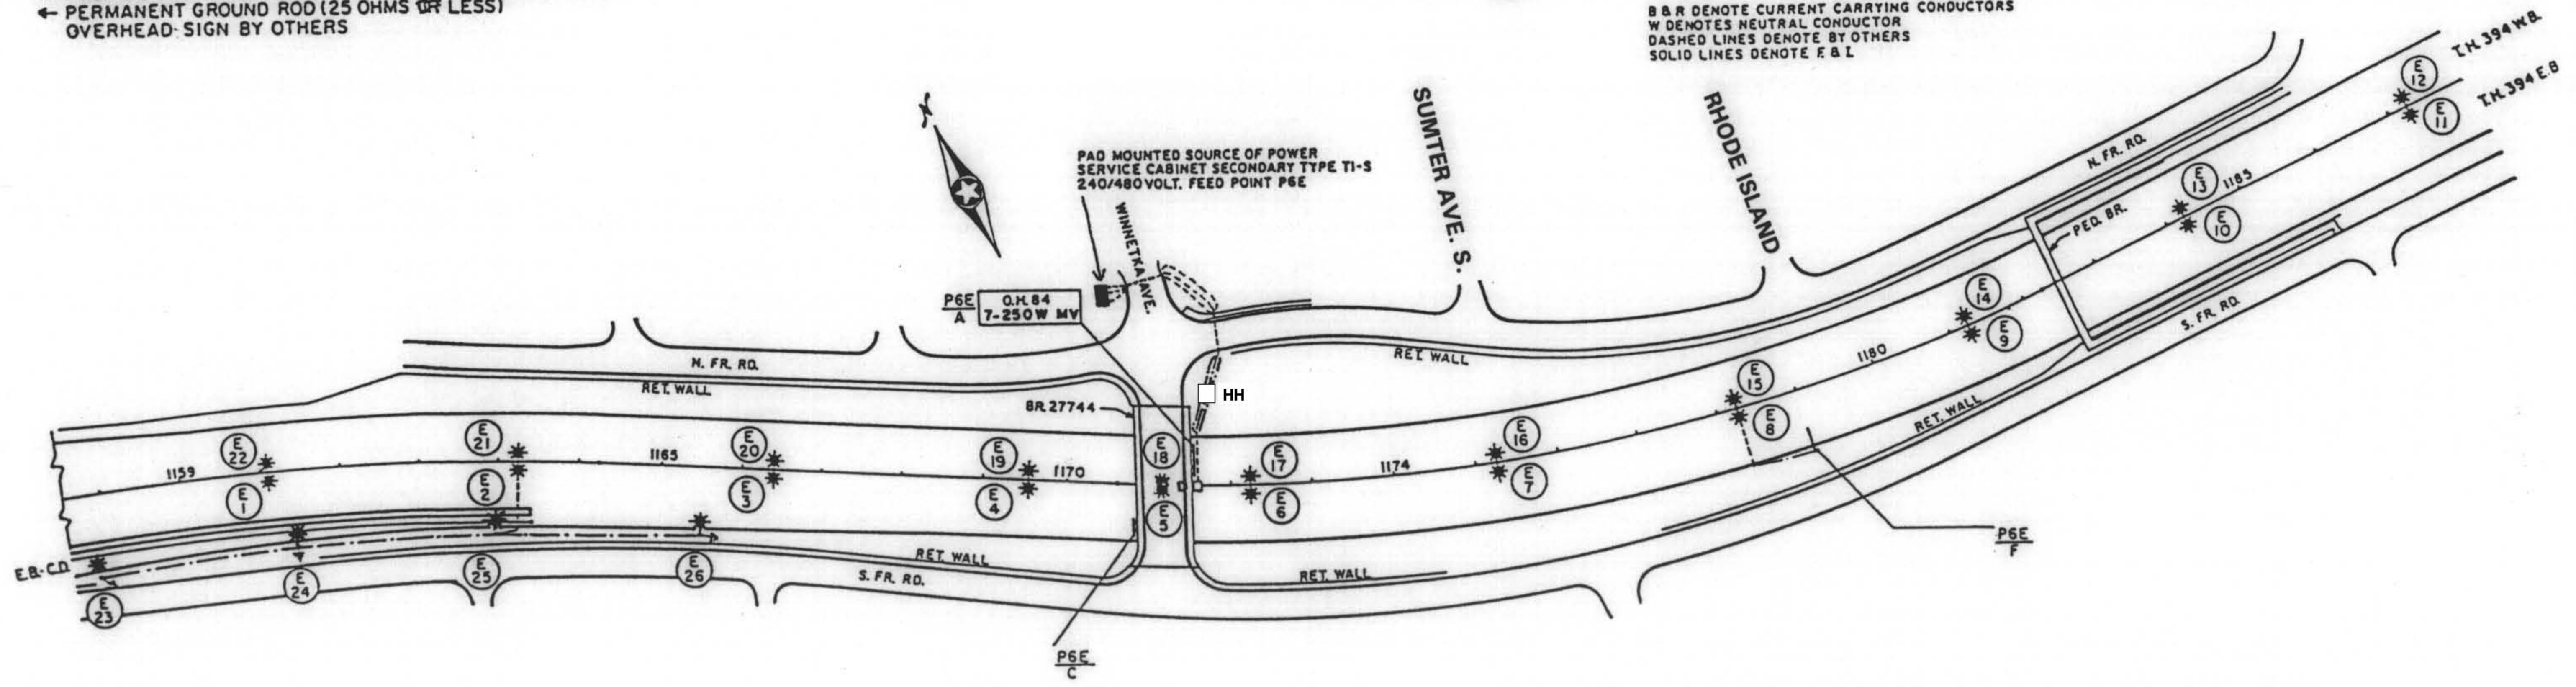

**AS BUILT
 03/10**

SHEET TOTAL

- 20 - 250 WATT HIGH PRESSURE SODIUM LIGHTING UNITS
- 4 - 200 WATT HIGH PRESSURE SODIUM LIGHTING UNITS
- 2 - 200 WATT HIGH PRESSURE SODIUM UNDERPASS LIGHTS
- 7 - 250 WATT MERCURY VAPOR SIGN LIGHTS

FD. PT. P6E LIGHTING STANDARDS & BASES					
NO.	STATION	LT	RT	LOCATION	TYPE
(1) 1	1160 + 10		-	T.H. 394 MEDIAN	680-49
(1) 2	1163 + 25			T.H. 394 MEDIAN	680-49
(1) 3	1166 + 40			T.H. 394 MEDIAN	680-49
(1) 4	1169 + 55			T.H. 394 MEDIAN	680-49
(3) 5	1171 + 15		-	T.H. 394 FB	L
(3) 18	1171 + 15		-	T.H. 394 WB	L
(1) 6	1172 + 25			T.H. 394 MEDIAN	680-49
(1) 7	1175 + 25			T.H. 394 MEDIAN	680-49

FD. PT. P6E LIGHTING STANDARDS & BASES					
NO.	STATION	LT	RT	LOCATION	TYPE
(1) 8	1178 + 25			T.H. 394 MEDIAN	680-49
(1) 9	1181 + 25			T.H. 394 MEDIAN	680-49
(1) 10	1184 + 25			T.H. 394 MEDIAN	680-49
(1) 11	1187 + 25			T.H. 394 MEDIAN	680-49
(2) 23	1157 + 85		-	T.H. 394 FB	6-40
(2) 24	1160 + 40		-	T.H. 394 FB	6-40
(2) 25	1162 + 95		-	T.H. 394 FB	6-40
(2) 26	1165 + 50		-	T.H. 394 FB	6-40

- (1) - 250 WATT HIGH PRESSURE SODIUM LIGHTING UNITS
- (2) - 200 WATT HIGH PRESSURE SODIUM LIGHTING UNITS
- (3) - 200 WATT HIGH PRESSURE SODIUM UNDERPASS LIGHTS

**EXHIBIT 257B
 T.H. 394 & WINNETKA AVE.
 IN GOLDEN VALLEY
 N.S.P.**

FD. PT. P6E

WINNETKA AVE.