


METER ADDRESS: 2595 PILOT KNOB RD

SHEET TOTAL

**19 - 200 WATT HIGH PRESSURE SODIUM LIGHTING UNITS
7 - 175 WATT MERCURY VAPOR SIGN LIGHTS**

FD. PT. S07E

LIGHTING STANDARDS AND BASES					
NO.	STATION	LT.	RT.	LOCATION	TYPE
1	EB 124+80			T.H. 494	9-40
2	EB 127+35			T.H. 494	9-40
3	EB 129+70			T.H. 494	9-40
4	2+00			SE LOOP	6-40
5	EB 132+00			T.H. 494	9-40
6	EB 140+60			T.H. 494	9-40
7	EB 142+90			T.H. 494	9-40
8	EB 145+20			T.H. 494	9-40
9	WB 141+50			T.H. 494	9-40
10	WB 139+20			T.H. 494	9-40
11	11+35			NE RAMP	6-40
12	WB 136+80			T.H. 494	9-40
13	WB 129+20			T.H. 494	9-40
14	WB 127+10			T.H. 494	9-40
15	WB 124+65			T.H. 494	9-40

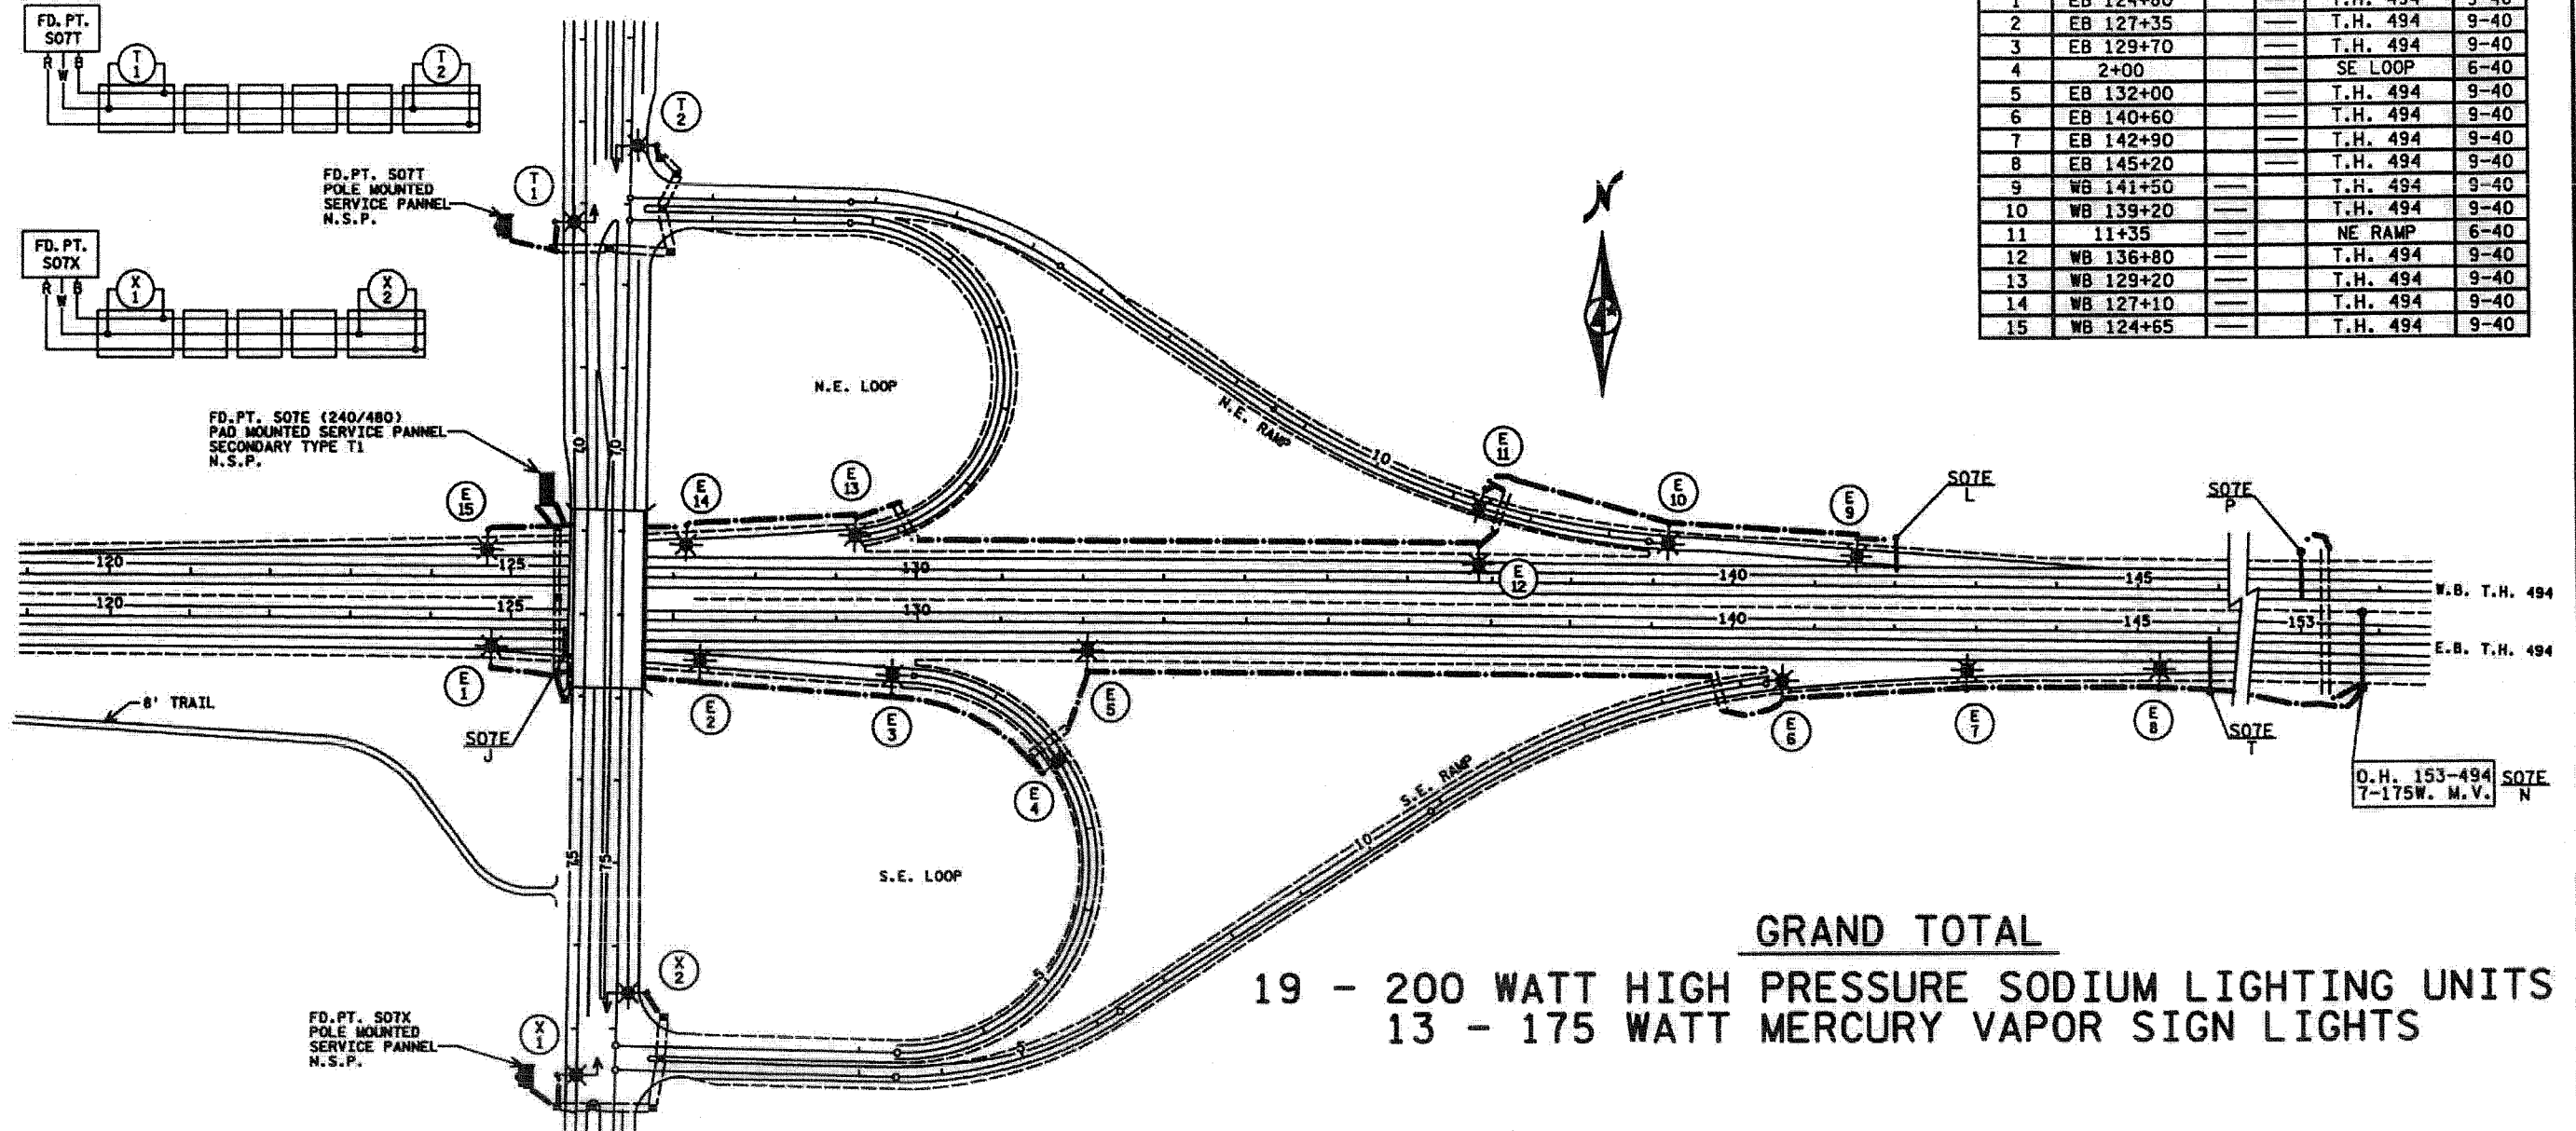

GRAND TOTAL


**19 - 200 WATT HIGH PRESSURE SODIUM LIGHTING UNITS
13 - 175 WATT MERCURY VAPOR SIGN LIGHTS**

AS-BUILT 05/2010

EXHIBIT 210E

T.H. 494 & PILOT KNOB RD
IN MENDOTA HEIGHTS

N.S.P.

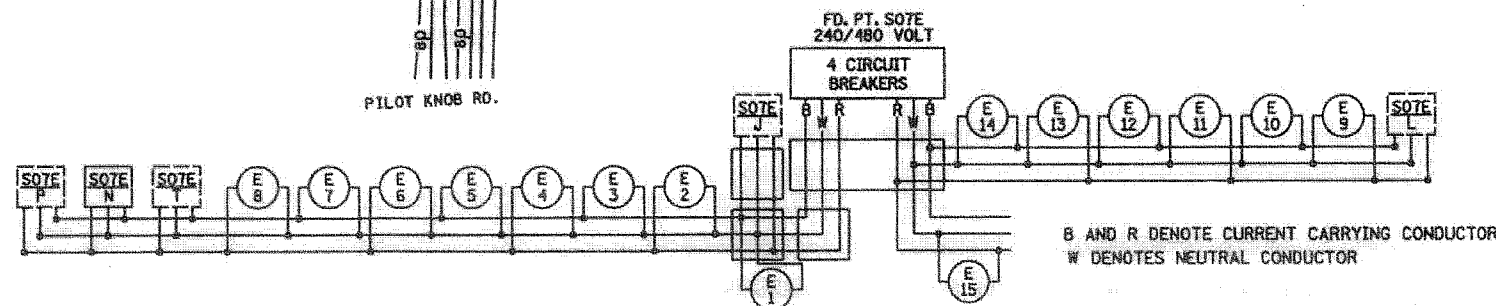

B AND R DENOTE CURRENT CARRYING CONDUCTORS
W DENOTES NEUTRAL CONDUCTOR

FD. PT. S07E, S07T, & S07X