





 
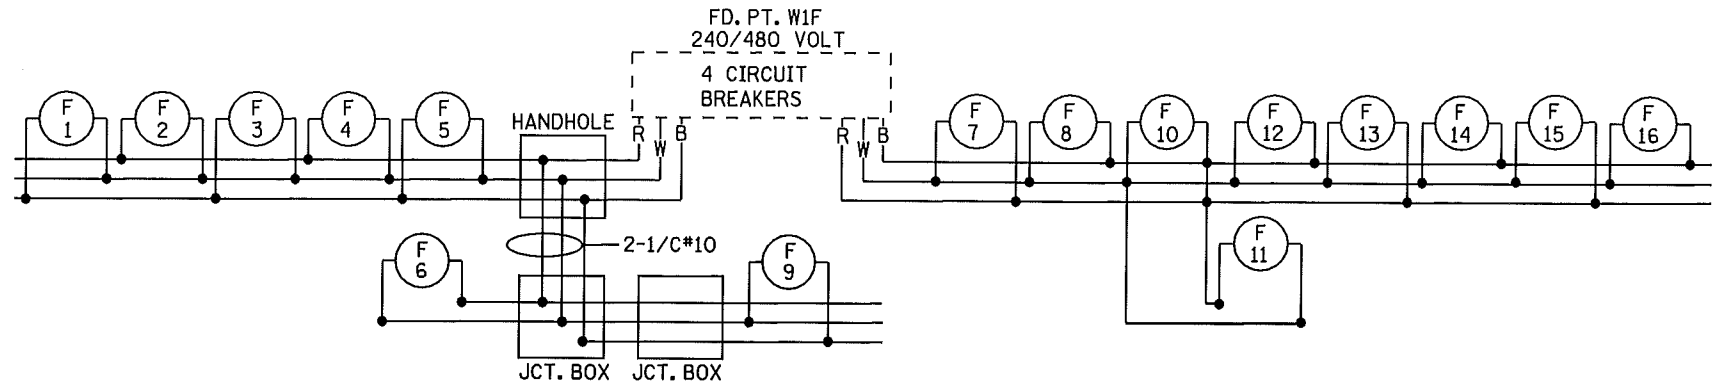


PLOTTED/REVISED: 3/5/2010



LEGEND

-  VERTICAL MOUNT LIGHTING UNIT
-  UNDERPASS LIGHTING UNIT
-  PAD MOUNTED SOURCE OF POWER
240/480 VOLT
-  ARMORED CABLE 4 CONDUCTOR NO. 4
-  HANDHOLE
-  3" NON-METALLIC CONDUIT (DIRECTIONAL BORE)
UNLESS NOTED OTHERWISE
-  PERMANENT GROUND ROD (25 OHMS OR LESS)

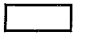B AND R DENOTE CURRENT CARRYING CONDUCTORS
W DENOTES NEUTRAL CONDUCTOR



**AS BUILT
03/2010**

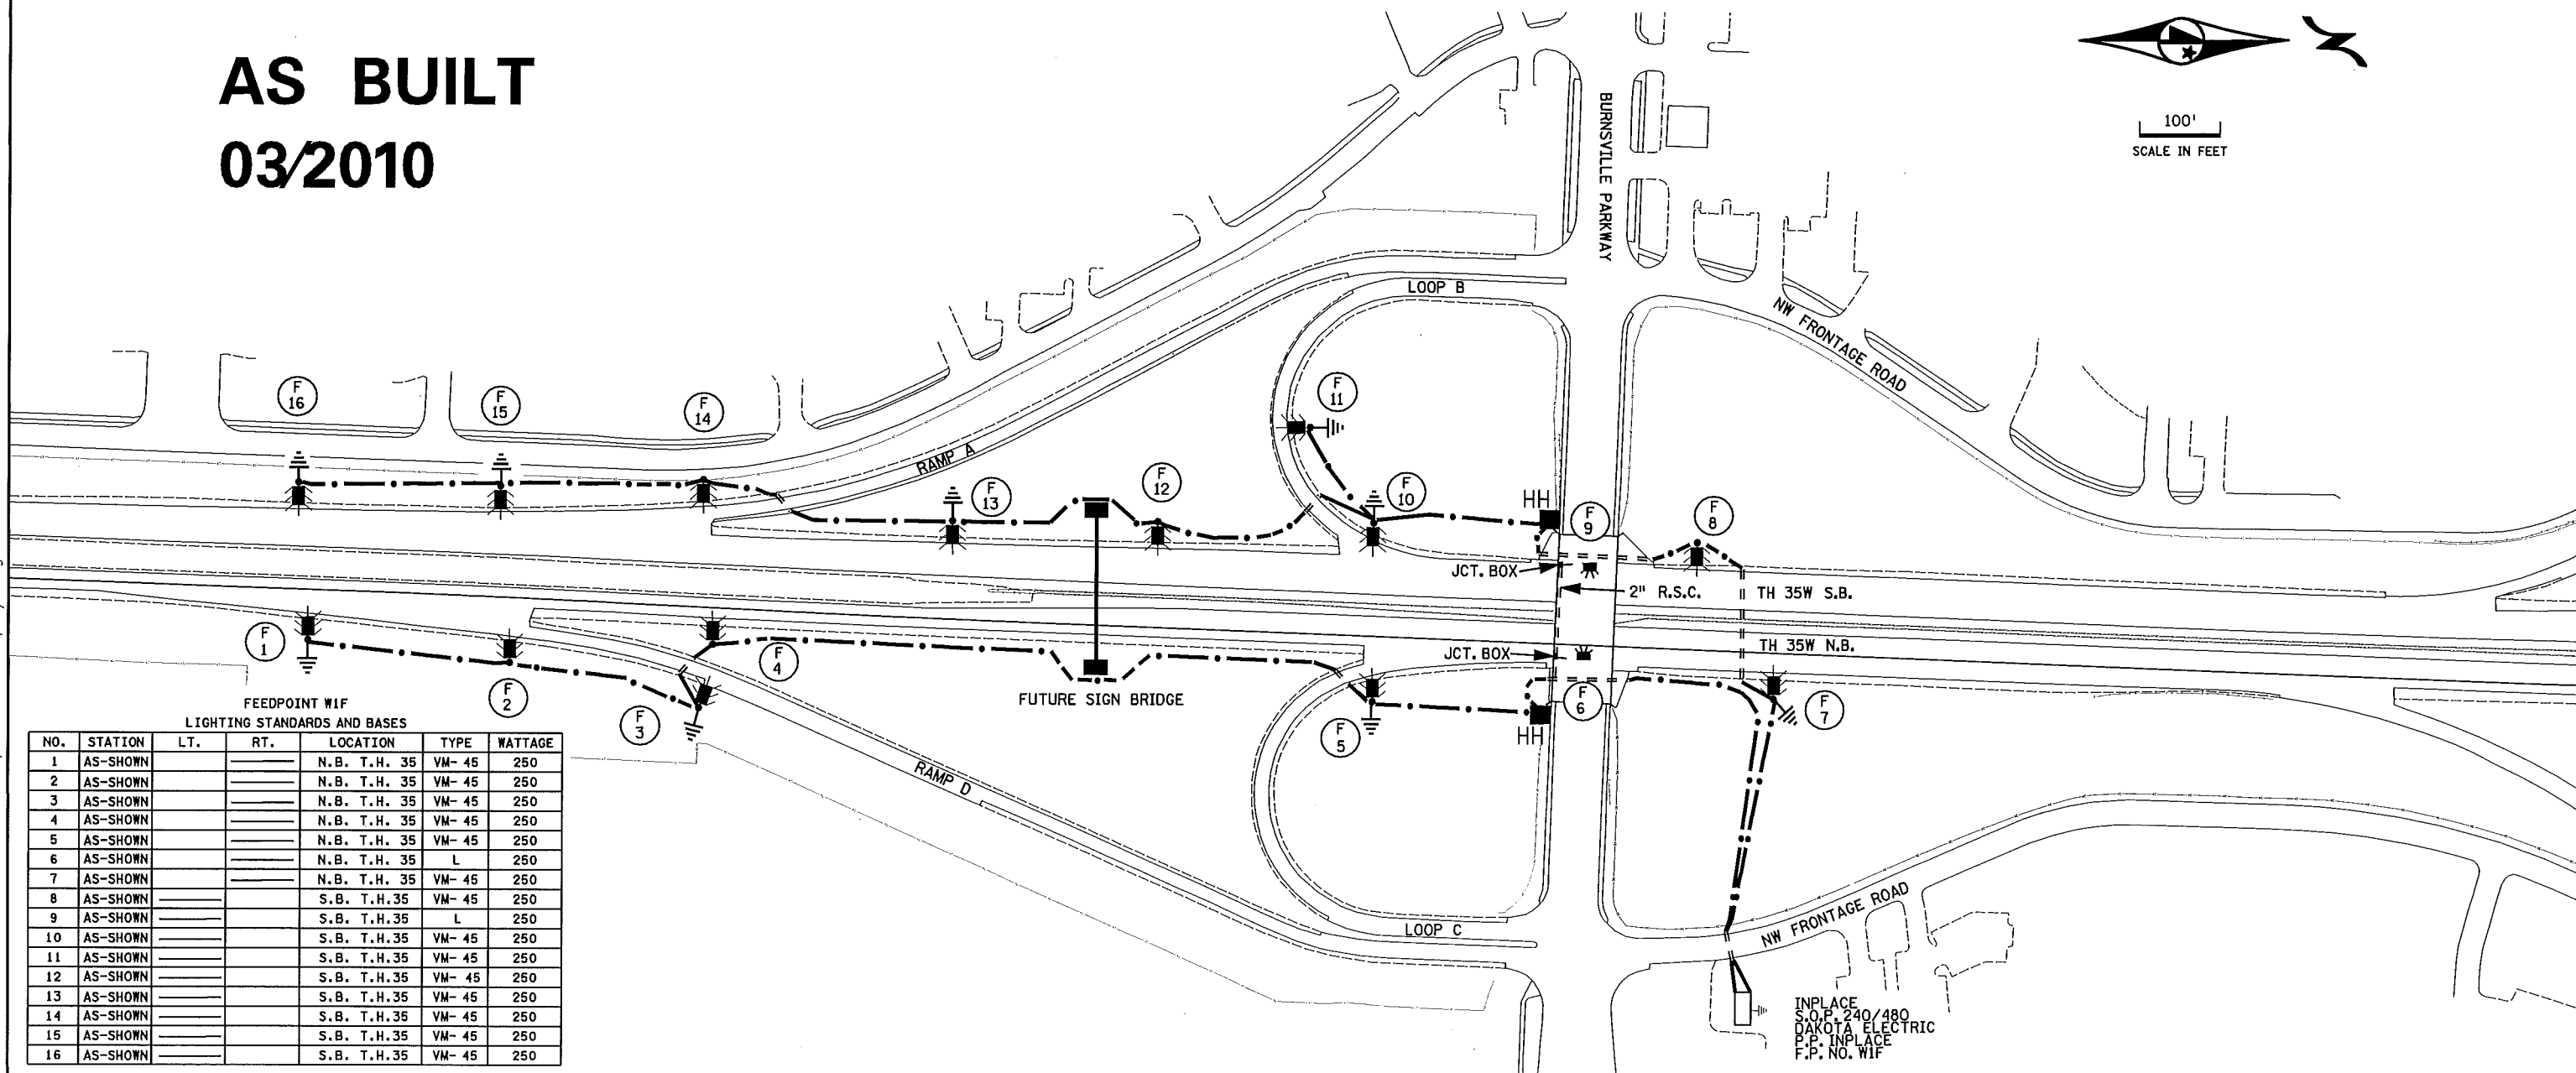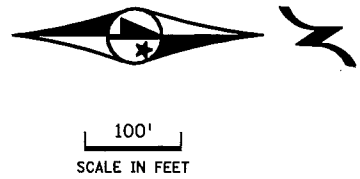

FEEDPOINT W1F
LIGHTING STANDARDS AND BASES

NO.	STATION	LT.	RT.	LOCATION	TYPE	WATTAGE
1	AS-SHOWN			N.B. T.H. 35	VM-45	250
2	AS-SHOWN			N.B. T.H. 35	VM-45	250
3	AS-SHOWN			N.B. T.H. 35	VM-45	250
4	AS-SHOWN			N.B. T.H. 35	VM-45	250
5	AS-SHOWN			N.B. T.H. 35	VM-45	250
6	AS-SHOWN			N.B. T.H. 35	L	250
7	AS-SHOWN			N.B. T.H. 35	VM-45	250
8	AS-SHOWN			S.B. T.H. 35	VM-45	250
9	AS-SHOWN			S.B. T.H. 35	L	250
10	AS-SHOWN			S.B. T.H. 35	VM-45	250
11	AS-SHOWN			S.B. T.H. 35	VM-45	250
12	AS-SHOWN			S.B. T.H. 35	VM-45	250
13	AS-SHOWN			S.B. T.H. 35	VM-45	250
14	AS-SHOWN			S.B. T.H. 35	VM-45	250
15	AS-SHOWN			S.B. T.H. 35	VM-45	250
16	AS-SHOWN			S.B. T.H. 35	VM-45	250

DISTRICT #: METRO
IPLOT NAME: 35@burnsville pkwy lit
PATH & FILENAME: C:\temp\35@burnsville pkwy lit.dgn

BY	DATE	REVISIONS	SYSTEM ID: FEEDPOINT: W1F	T.E. LOCATION: T.H. 35W AT BURNSVILLE PARKWAY	ELECTRIC LIGHT SYSTEM "B"
			METER ADDRESS:		
DRAWN BY: JP CKD BY: NS DATE: 06/25/08			CERTIFIED BY: <i>Michael P. Gubinsky</i> LIC. NO. 19863 DATE: 06/26/08		STATE PROJ. NO. 8825-302
					SHEET NO. 9 OF 10 SHEETS