

FD. PT. W6X
 PAD MOUNTED SERVICE CABINET
 SECONDARY TYPE L1
 240/480 V (METERED)
 EQUIPMENT PAD B
 2" R.S.C. & 3-1/C#2 TO XCEL
 SECONDARY PEDESTAL
 INPLACE XCEL POLE MOUNTED TRANSFORMER

W6X METER ADDRESS: 3825 CLEVELAND AVE N ARDEN HILLS 55112

2:47:22 PM
 12/31/2021
 C:\Projects\2018\18005\CONSTRUCTION\Plan Sheets\cd6284180_cb_11120.dgn

NO	DATE	DWN	CKD	REVISIONS
2	12/18/19	AKS	MPM	RFC DP T-5
3	7/22/20	AKS	MPM	FDC 249
4	12/03/21			RECORD DRAWING




RECORD DRAWING NOTE: THESE RECORD DRAWINGS WERE DEVELOPED BASED ON THE PREVIOUS DRAWING REVISIONS AND INFORMATION TRANSMITTED FROM THE FIELD BY OTHERS. THE INFORMATION CONTAINED WITHIN THIS RECORD AS-BUILT PLAN REPRESENTS THE ACTUAL CONDITIONS FOR ALL CHANGES OF WHICH ALLIANT IS AWARE. FUTURE USERS OF THESE DRAWINGS SHOULD VERIFY AS-BUILT CONDITIONS IN THE FIELD IN ALL CIRCUMSTANCES.

LIGHTING PLANS
 FD. PT. W6X LAYOUT

I-35W NORTH MNPASS DB (S.P. 6284-180)
 SHEET NO. LL38 OF LL67 SHEETS



200
SCALE IN FEET

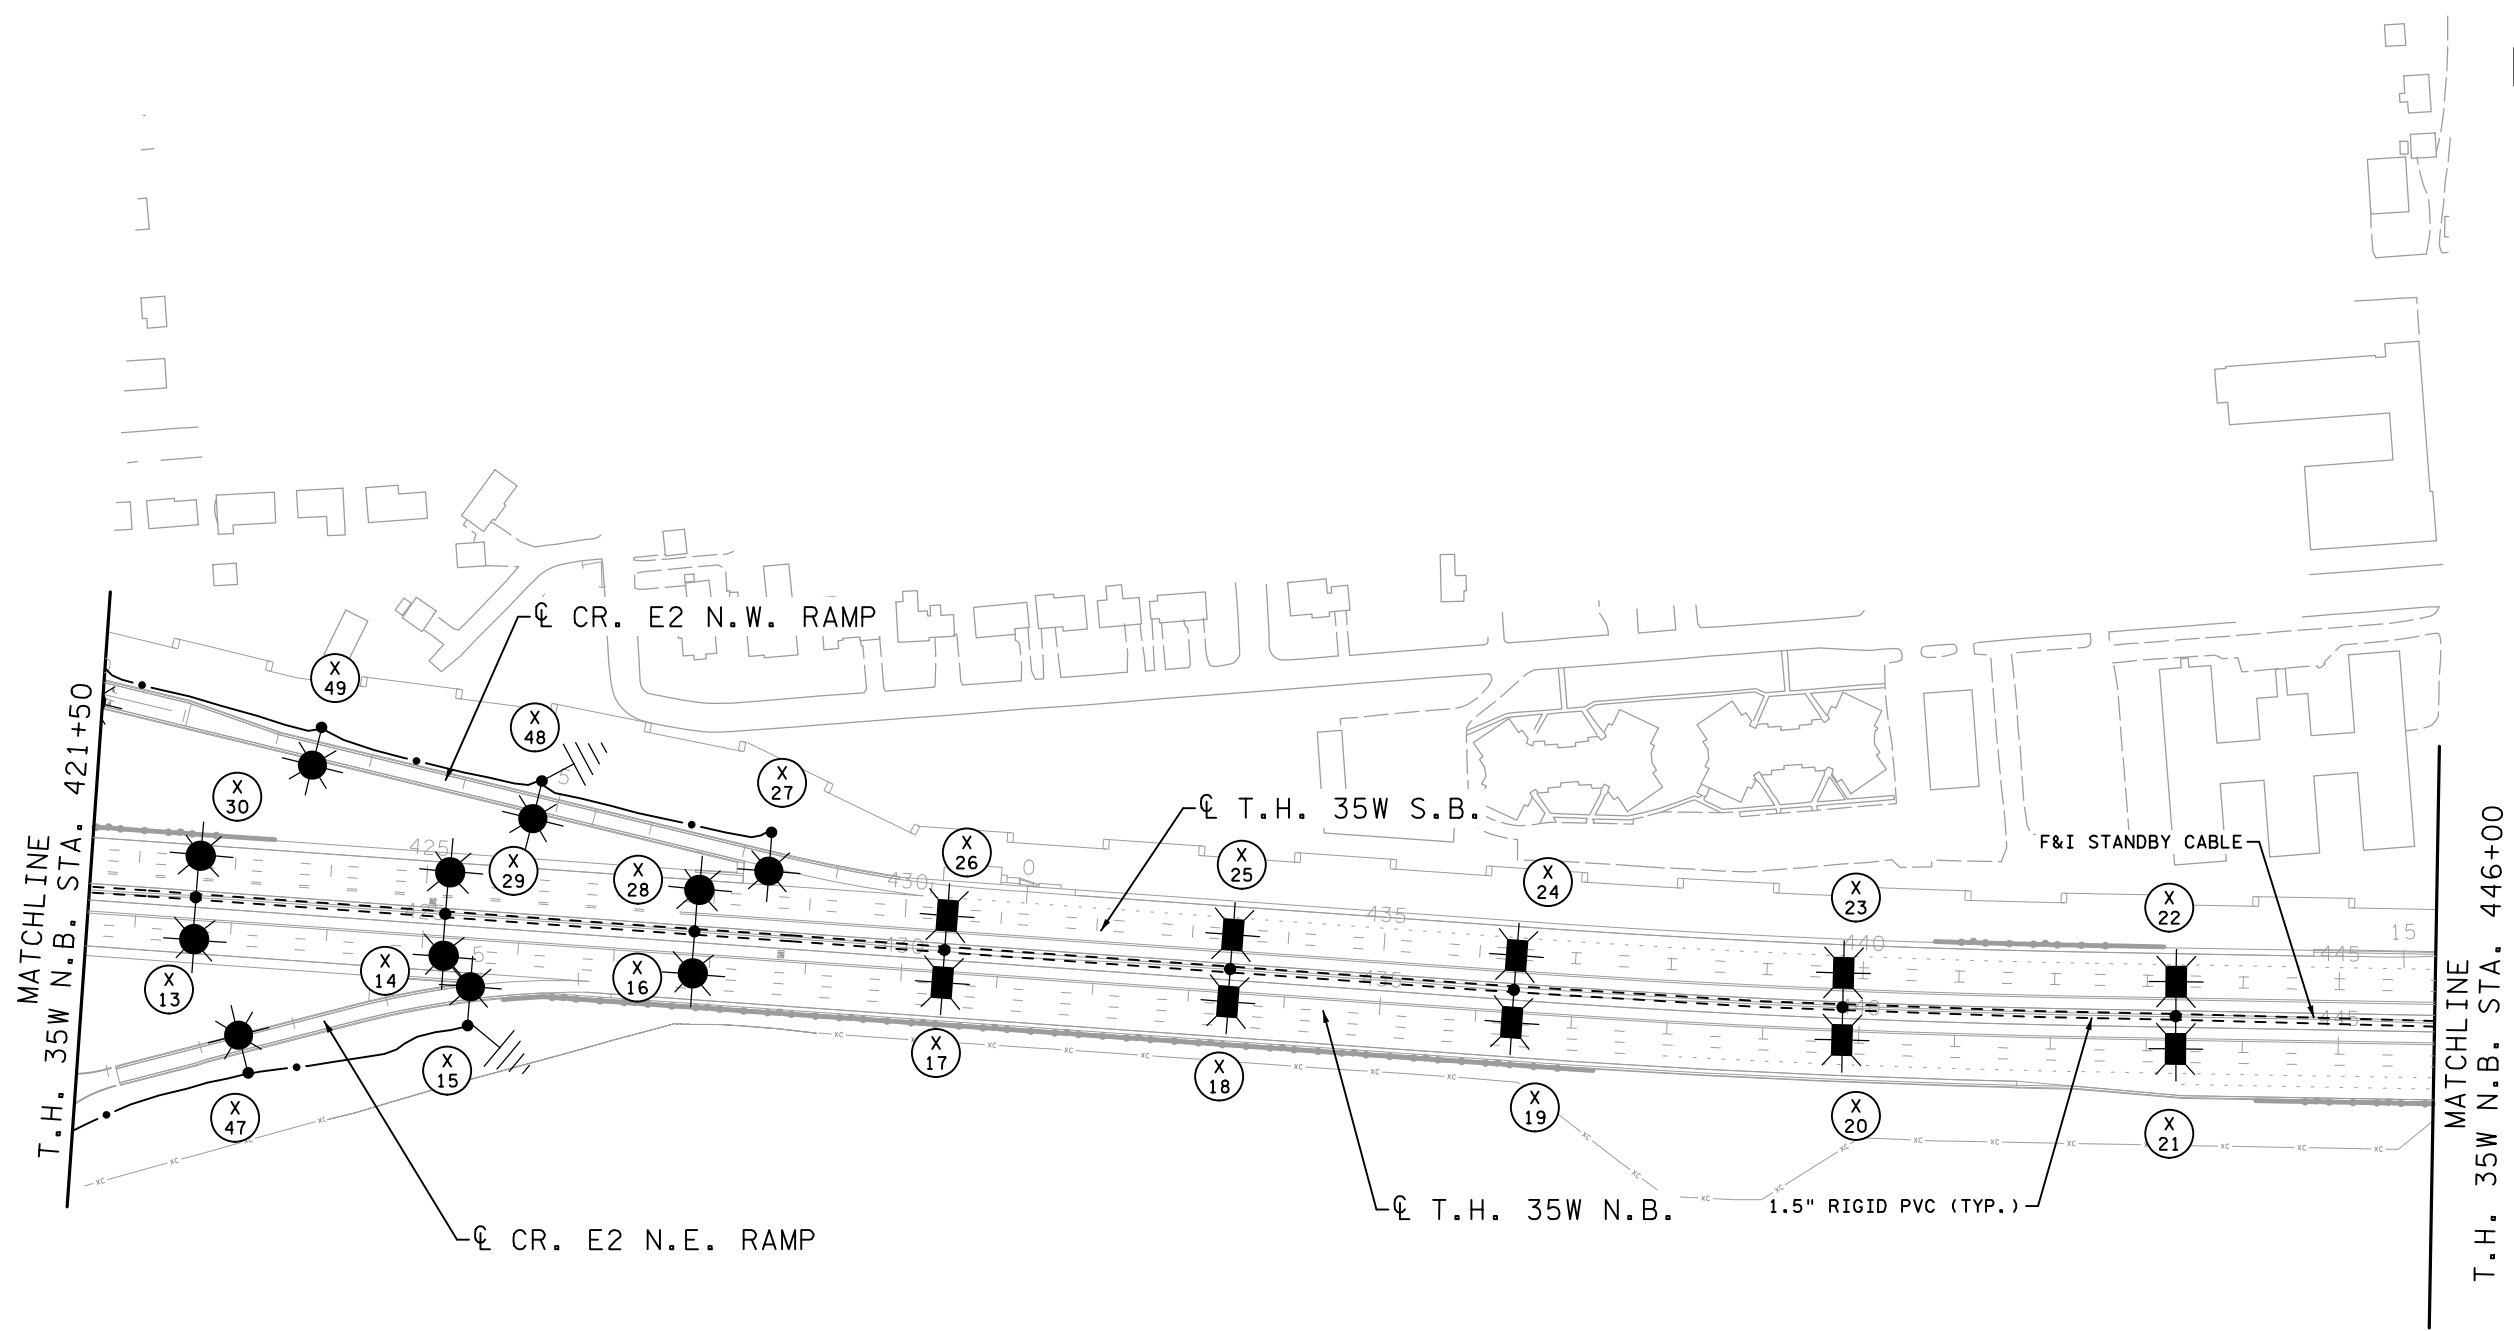

5:47:05 PM
12/1/2021
C:\Projects\2018\18005\CONSTRUCTION\Plan_Sheets\cd6284180_cb_11125.dgn

0	05/22/19	AKS	MPM	RFC DP T-6
1	12/18/19	AKS	MPM	RFC DP T-5
2	12/03/21			RECORD DRAWING
NO	DATE	DWN	CKD	REVISIONS




RECORD DRAWING NOTE: THESE RECORD DRAWINGS WERE DEVELOPED BASED ON THE PREVIOUS DRAWING REVISIONS AND INFORMATION TRANSMITTED FROM THE FIELD BY OTHERS. THE INFORMATION CONTAINED WITHIN THIS RECORD AS-BUILT PLAN REPRESENTS THE ACTUAL CONDITIONS FOR ALL CHANGES OF WHICH ALLIANT IS AWARE. FUTURE USERS OF THESE DRAWINGS SHOULD VERIFY AS-BUILT CONDITIONS IN THE FIELD IN ALL CIRCUMSTANCES.

LIGHTING PLANS
FD. PT. W6X LAYOUT

I-35W NORTH MNPASS DB (S.P. 6284-180)
SHEET NO. LL39 OF LL67 SHEETS

FEEDPOINT W6X
LIGHTING STANDARDS AND FOUNDATIONS

NO.	STATION	LT.	RT.	LOCATION	TYPE	LUMINAIRE
1	396+70	-		T.H. 35W N.B.	6BD-49	49 FOOT
42						49 FOOT
2	399+23	-		T.H. 35W N.B.	6BD-49	49 FOOT
41						49 FOOT
3	401+83	-		T.H. 35W N.B.	6BD-49	49 FOOT
40						49 FOOT
4	404+43	-		T.H. 35W N.B.	6BD-49	49 FOOT
39						49 FOOT
5	407+02	-		T.H. 35W N.B.	6BD-49	49 FOOT
38						49 FOOT
6	409+62	-		T.H. 35W N.B.	6BD-49	5 LANE
37						5 LANE
7	412+21	-		T.H. 35W N.B.	6BD-49	49 FOOT
36						49 FOOT
8	2+77	-	-	C.R. E2 S.E. RAMP	9-49	49 FOOT
9	414+81	-		T.H. 35W N.B.	6BD-49	49 FOOT
34						49 FOOT
10	417+42	-		T.H. 35W N.B.	6BD-49	49 FOOT
33						49 FOOT
11	420+02	-		T.H. 35W N.B.	6BD-49	49 FOOT
32						49 FOOT
12	420+49	-	-	T.H. 35W N.B.	UNDERPASS	LED
13	422+61	-		T.H. 35W N.B.	6BD-49	49 FOOT
30						49 FOOT
14	425+22	-		T.H. 35W N.B.	6BD-49	49 FOOT
29						49 FOOT
15	4+80	-	-	C.R. E2 N.E. RAMP	9-49	49 FOOT
16	427+82	-		T.H. 35W N.B.	6BD-49	49 FOOT
28						49 FOOT
17	430+43	-		T.H. 35W N.B.	6BD-49	5 LANE
26						5 LANE
18	433+42	-		T.H. 35W N.B.	6BD-49	5 LANE
25						5 LANE
19	436+38	-		T.H. 35W N.B.	6BD-49	5 LANE
24						5 LANE
20	439+82	-		T.H. 35W N.B.	6BD-49	5 LANE
23						5 LANE
21	443+30	-		T.H. 35W N.B.	6BD-49	5 LANE
22						5 LANE
27	2+77	-	-	C.R. E2 N.W. RAMP	9-49	49 FOOT
31	420+48	-	-	T.H. 35W S.B.	UNDERPASS	LED
35	7+53	-	-	C.R. E2 S.W. RAMP	9-49	49 FOOT
43	5+11	-	-	C.R. E2 S.E. RAMP	9-40	40 FOOT
44	7+57	-	-	C.R. E2 S.E. RAMP	9-40	40 FOOT
45	9+97	-	-	C.R. E2 S.E. RAMP	9-40	40 FOOT
46	0+38	-	-	C.R. E2 N.E. RAMP	9-40	40 FOOT
47	2+42	-	-	C.R. E2 N.E. RAMP	9-40	40 FOOT
48	5+22	-	-	C.R. E2 N.W. RAMP	9-40	40 FOOT
49	7+58	-	-	C.R. E2 N.W. RAMP	9-40	40 FOOT
50	9+98	-	-	C.R. E2 N.W. RAMP	9-40	40 FOOT
51	0+57	-	-	C.R. E2 S.W. RAMP	9-40	40 FOOT
52	2+60	-	-	C.R. E2 S.W. RAMP	9-40	40 FOOT
53	5+00	-	-	C.R. E2 S.W. RAMP	9-40	40 FOOT

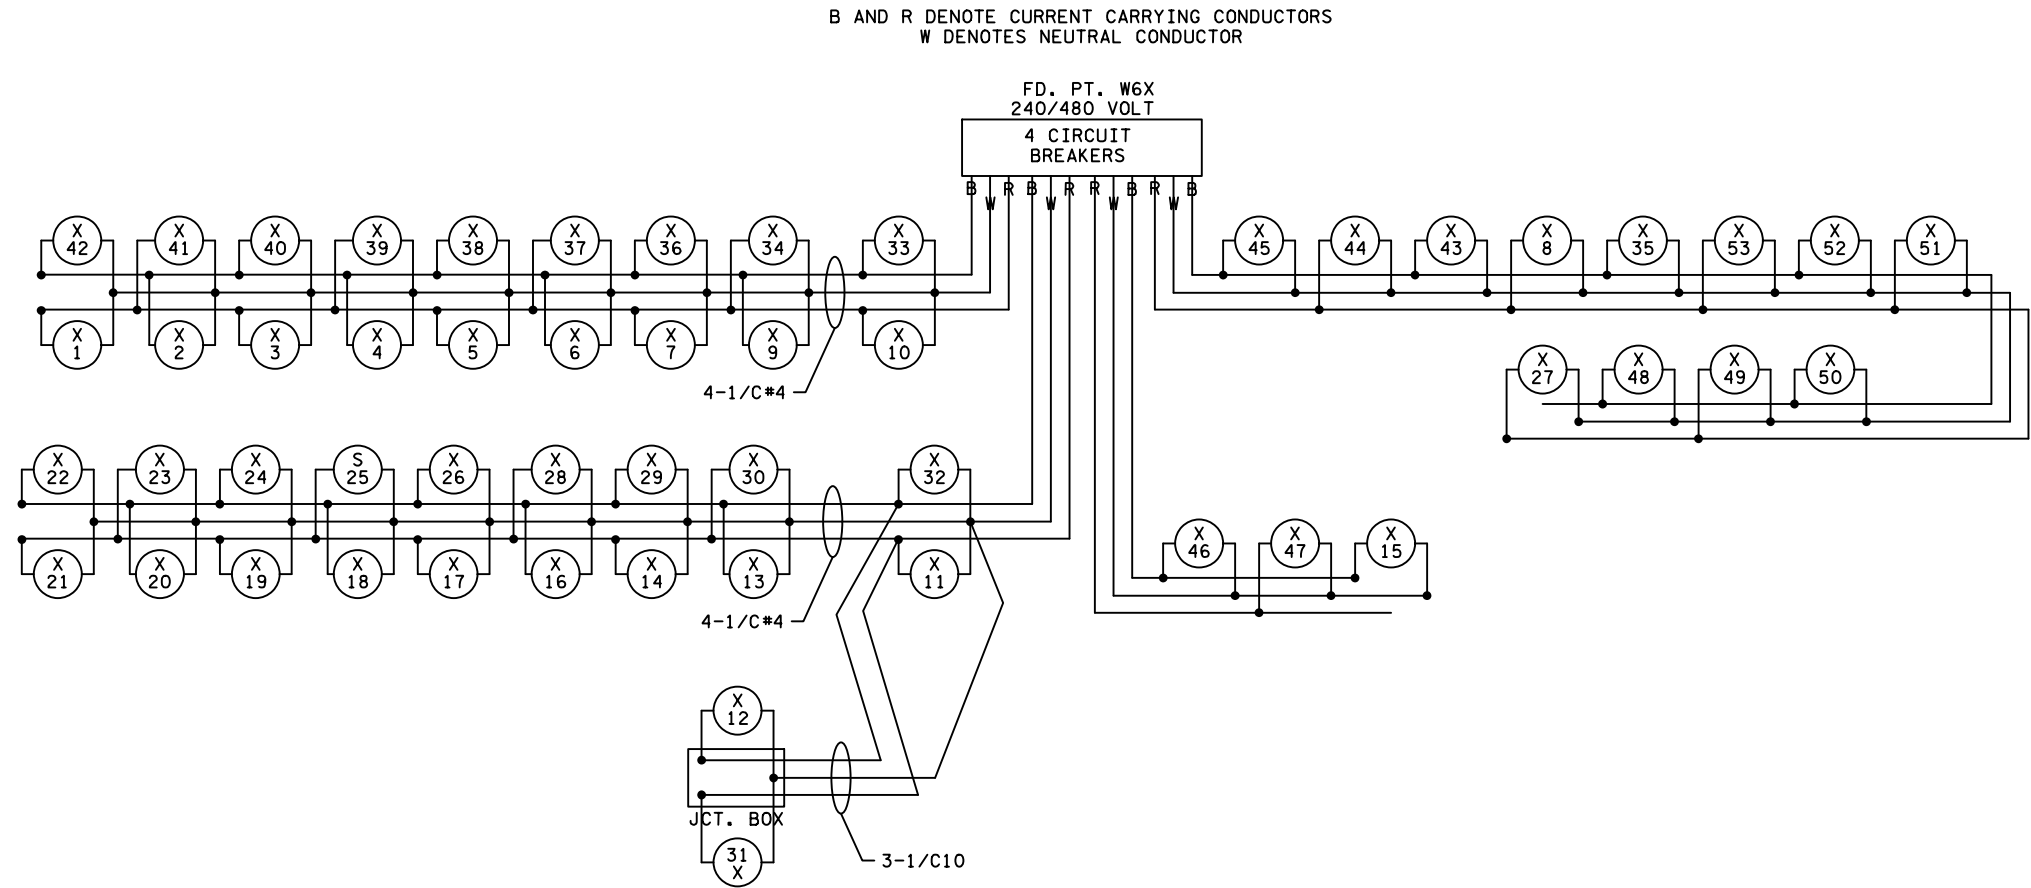

2:47:27 PM 12/3/2021 \\projects\2018\18005\CONSTRUCTION\Plan Sheets\cd6284180_cd_11126.dgn

1	12/18/19	AKS	MPM	RFCDP T-5
2	05/27/20	AKS	MPM	FDC 194
3	12/03/21			RECORD DRAWING
NO	DATE	DWN	CKD	REVISIONS



RECORD DRAWING NOTE: THESE RECORD DRAWINGS WERE DEVELOPED BASED ON THE PREVIOUS DRAWING REVISIONS AND INFORMATION TRANSMITTED FROM THE FIELD BY OTHERS. THE INFORMATION CONTAINED WITHIN THIS RECORD AS-BUILT PLAN REPRESENTS THE ACTUAL CONDITIONS FOR ALL CHANGES OF WHICH ALLIANT IS AWARE. FUTURE USERS OF THESE DRAWINGS SHOULD VERIFY AS-BUILT CONDITIONS IN THE FIELD IN ALL CIRCUMSTANCES.

LIGHTING PLANS
FD. PT. W6X CHART AND WIRING DIAGRAM

I-35W NORTH MNPASS DB (S.P. 6284-180)
SHEET NO. LL40 OF LL67 SHEETS