


Final Spill Cleanup Map - Example

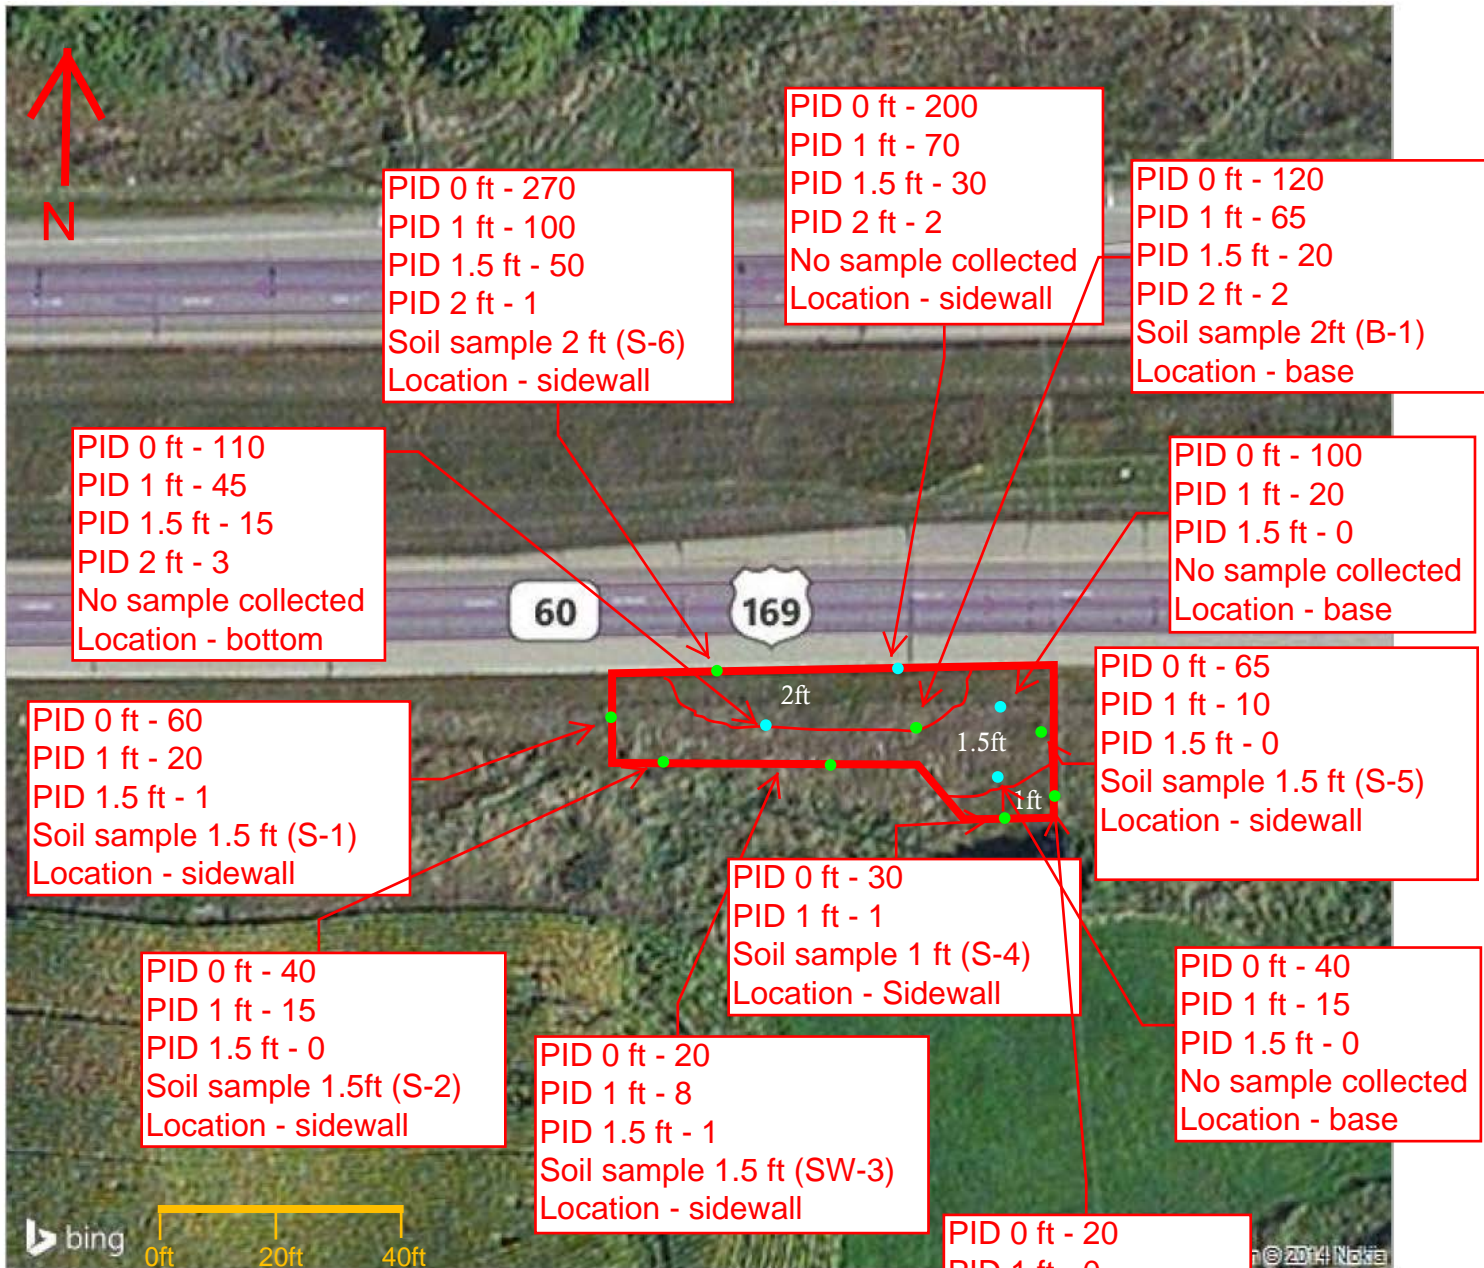

Legend

2 ft - excavation depth

— - excavation limits

● - PID screening location

● - PID screening location and soil sample location