


5:28:30 E.T.  
 10.14.22 | 1.13.22  
 1.4.21 | 8.30.22  
 8.25.21 | 1.26.23  
 File 70TH ST | 8.9.23

CELL 7001E  
 0 - 50 ft

Begin CL Kadler

0+00

0+50

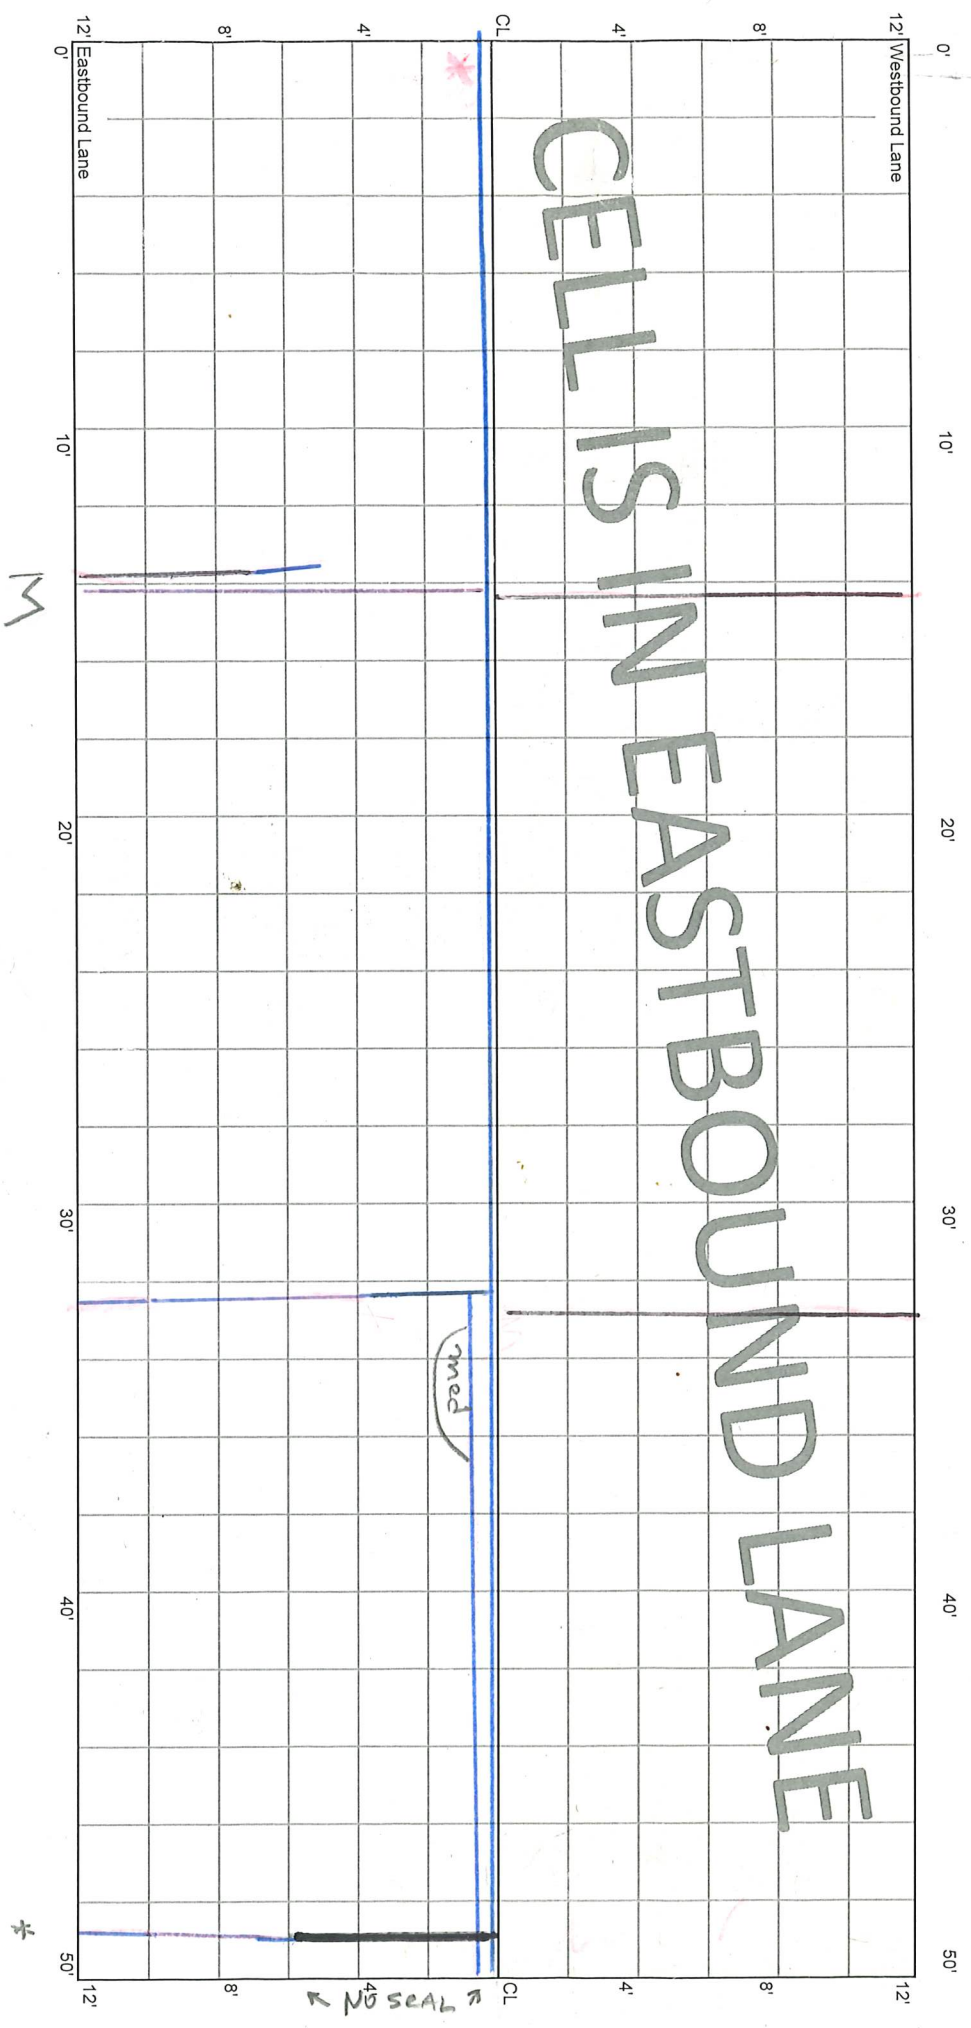

\* Rout 1 Seal  
 8/2022 - "M" Due to multiple cracks


8/22 - Sealant + debris & many stones on mat.

\* AF

CELL 7001E  
50 - 100 ft

0+50

1+00

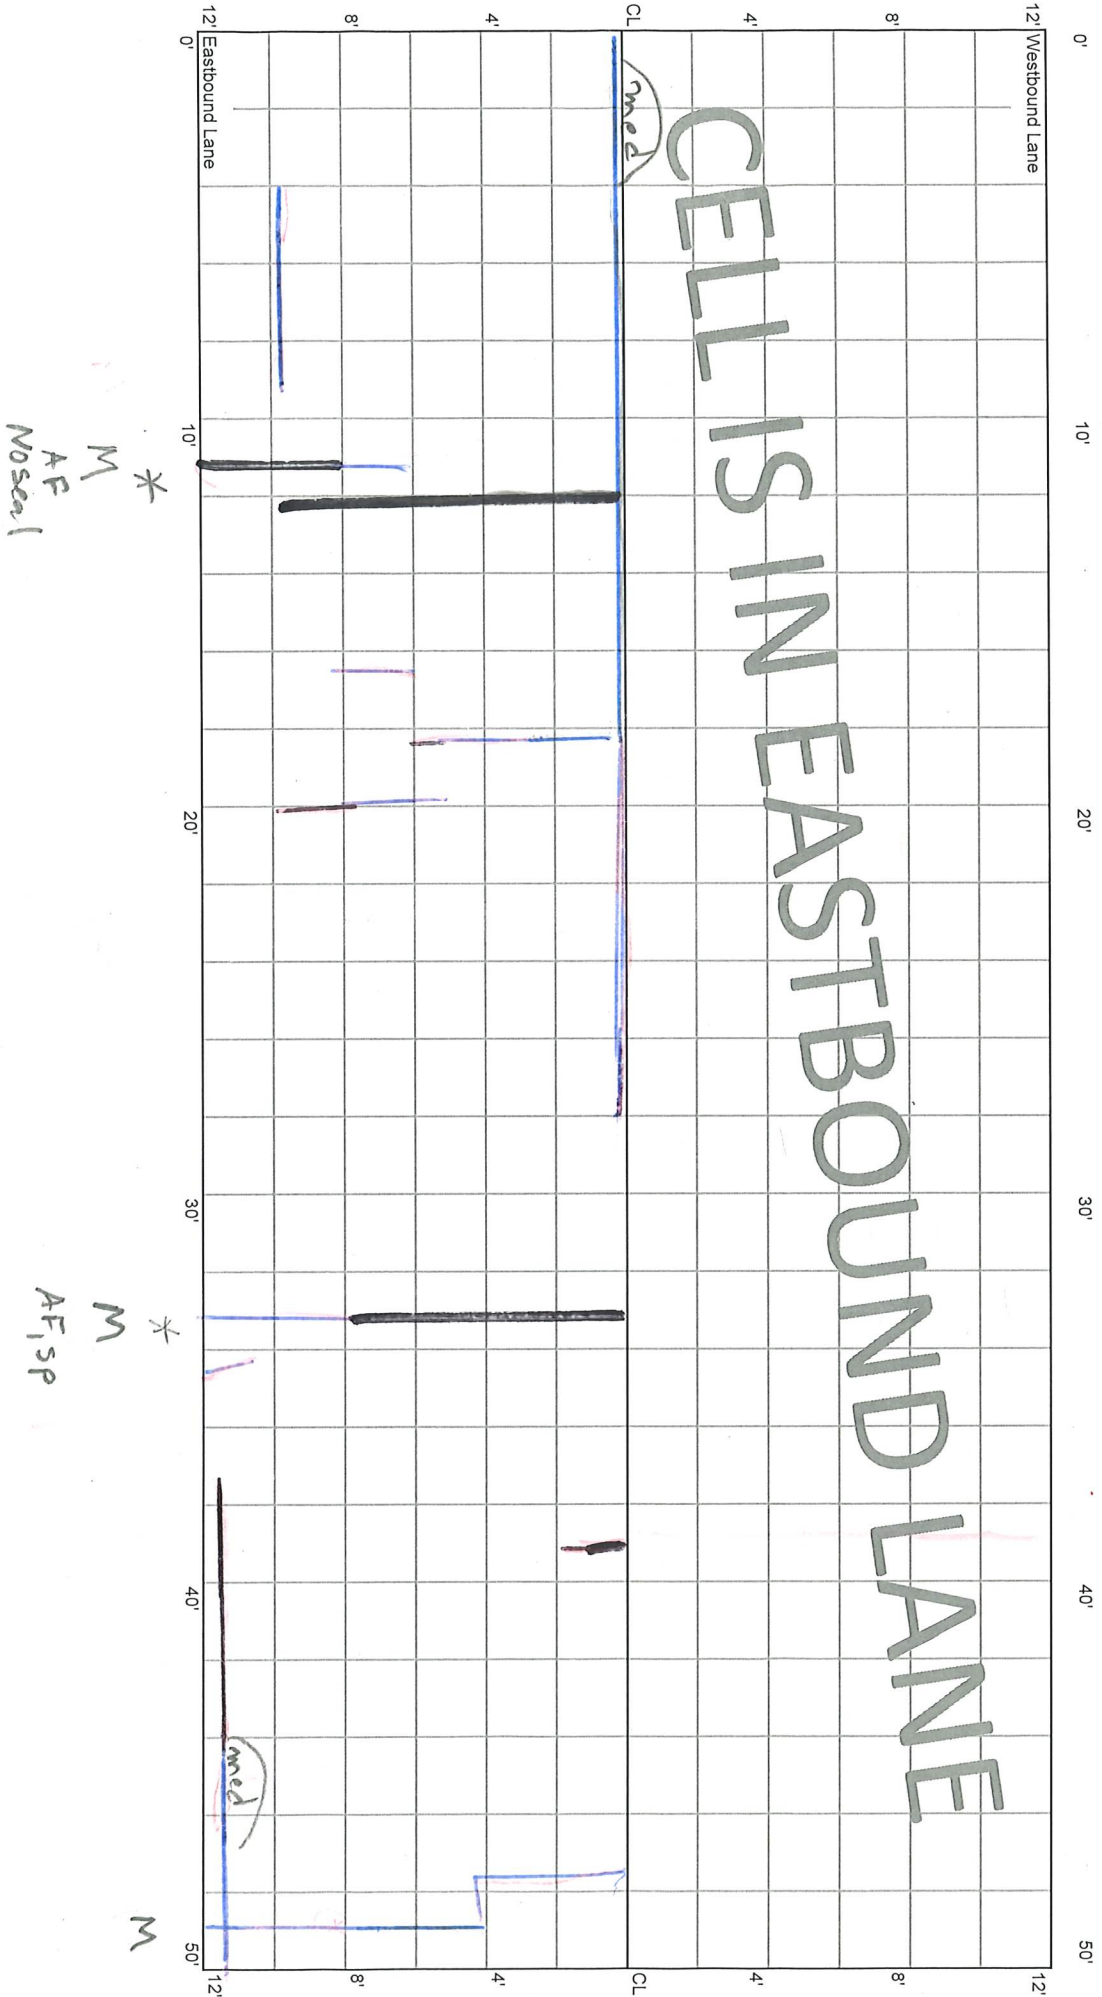


CELL 7001E  
100 - 150 ft

1+00

1+50

CELL IS IN EASTBOUND LANE

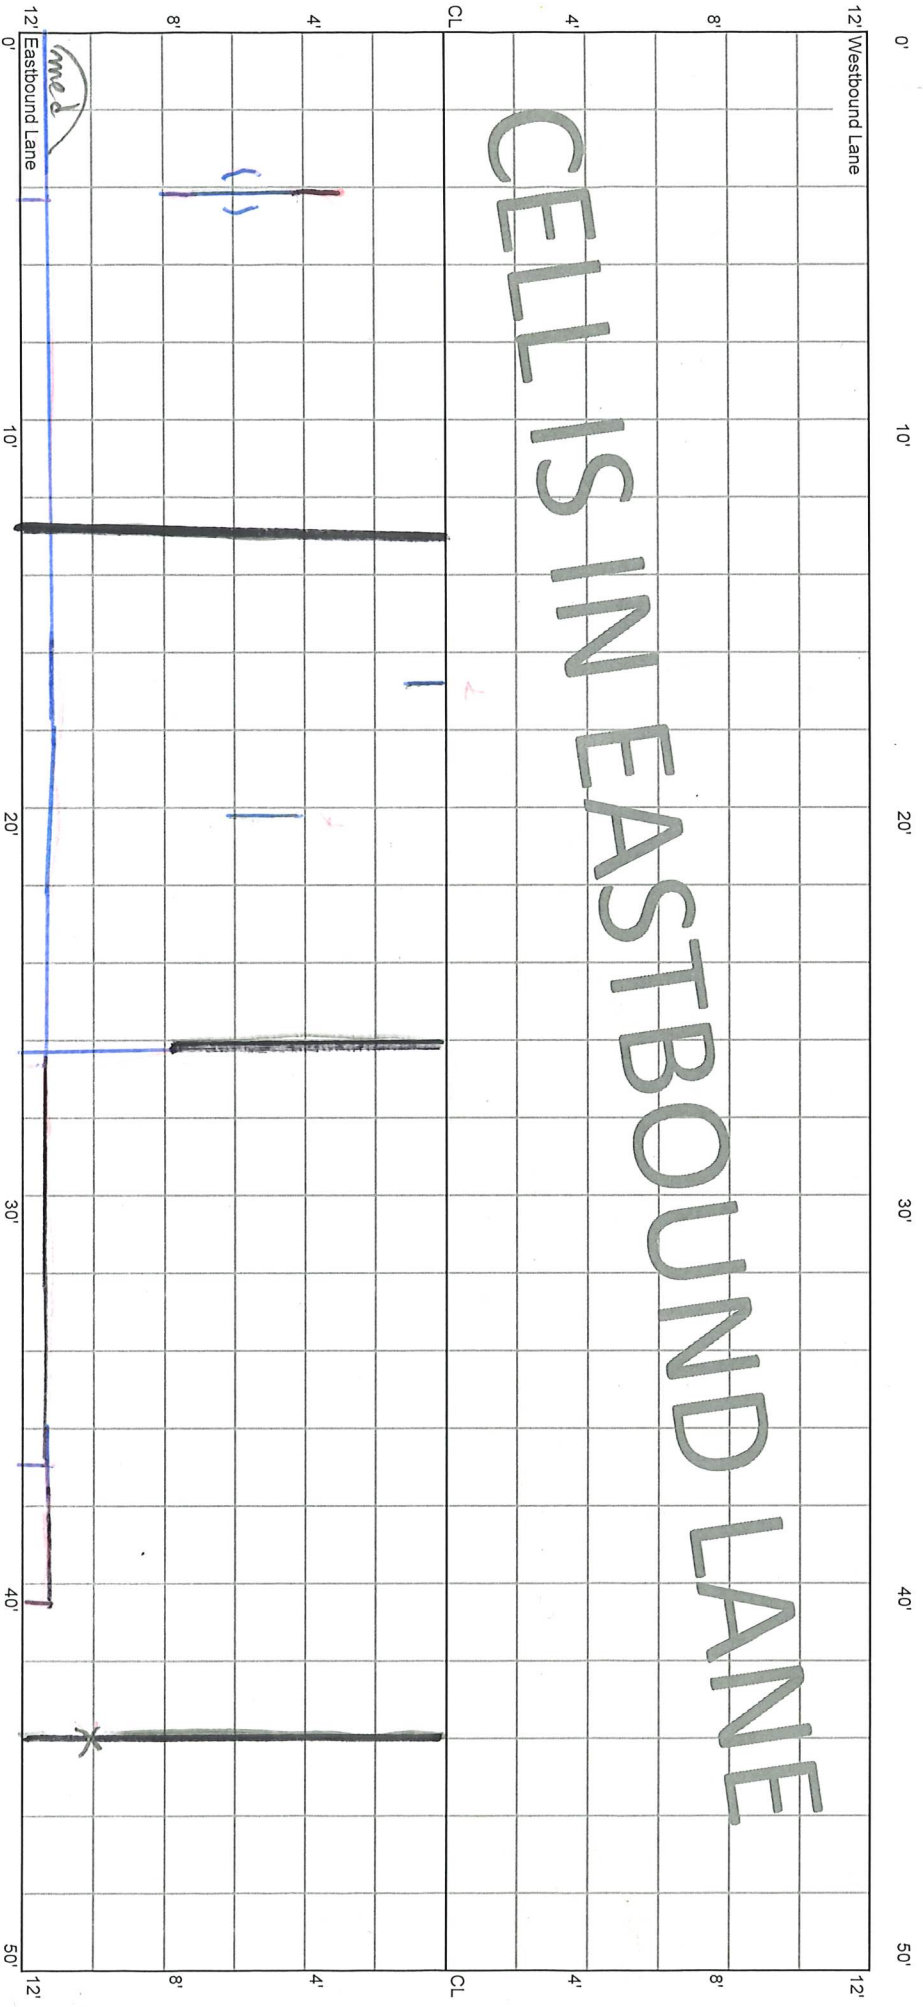

\*  
M  
AF, sp


\*  
M  
sp

\*  
M  
sp

CELL 7001E  
150 - 200 ft

1+50

2+00

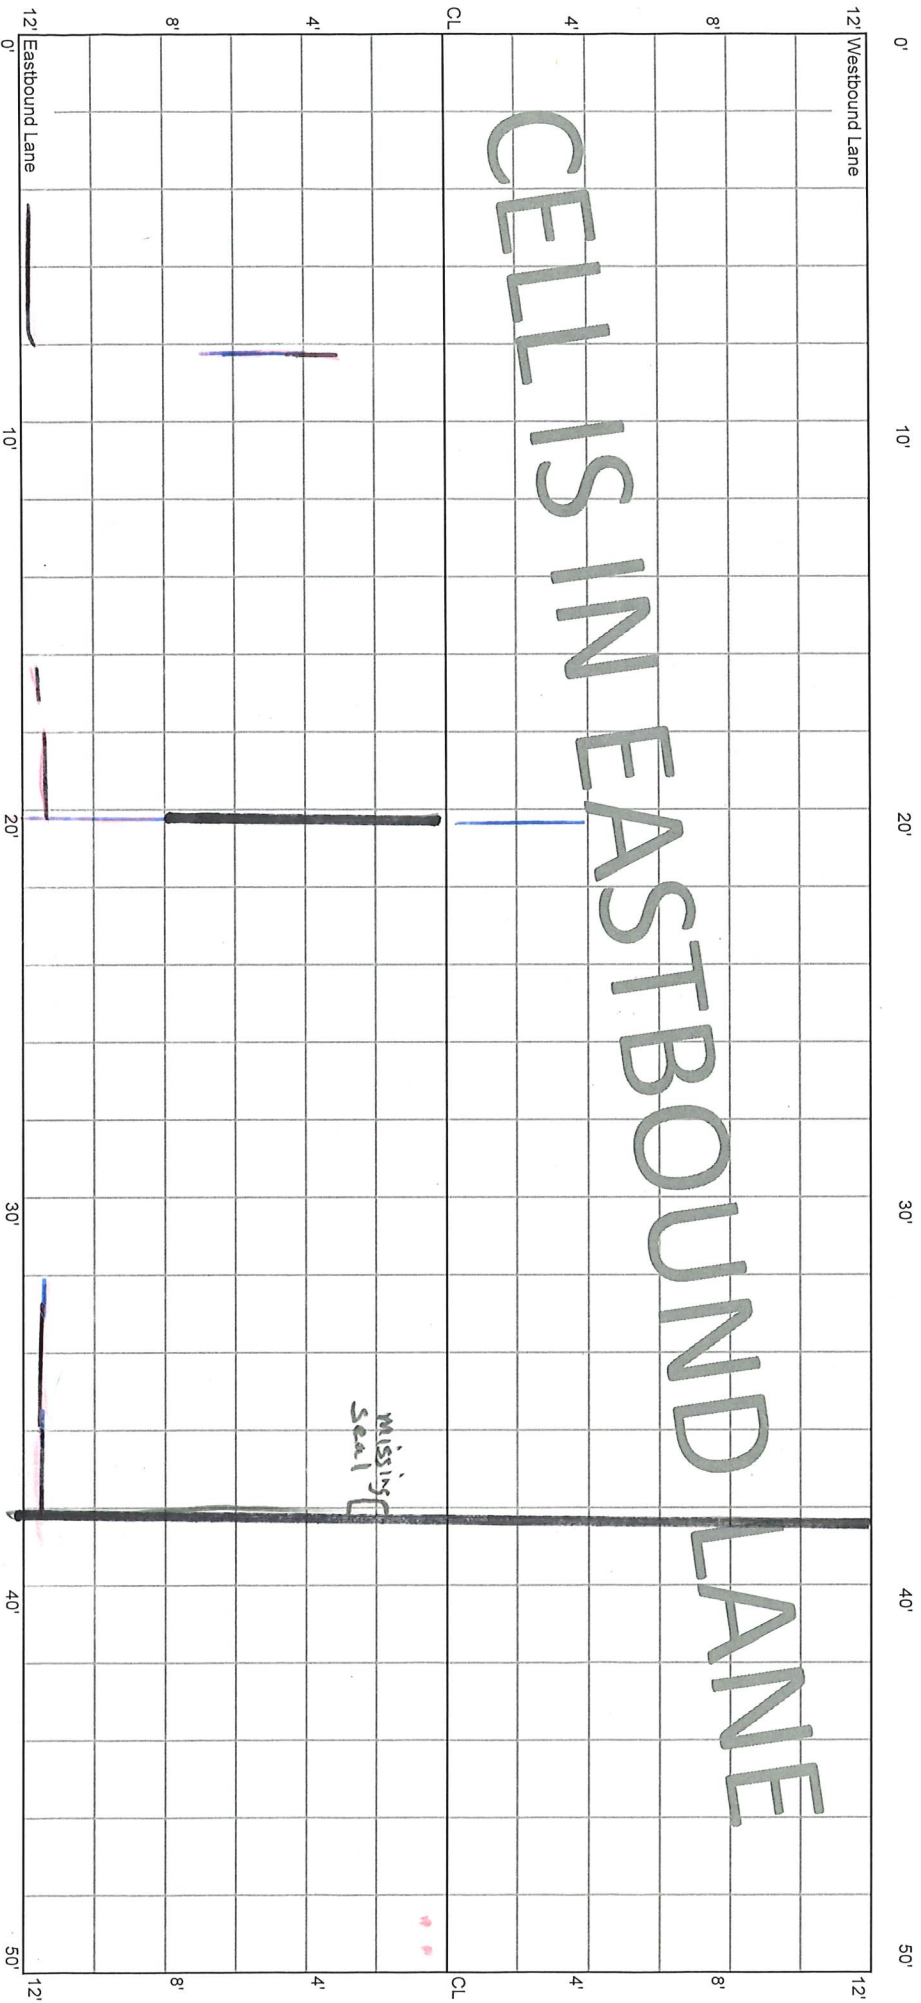

CELLS IN EASTBOUND LANE

MISSING  
Seal

\* M

8' seal


SP

\* M

CELL 7001E  
200 - 250 ft

2+00

2+50

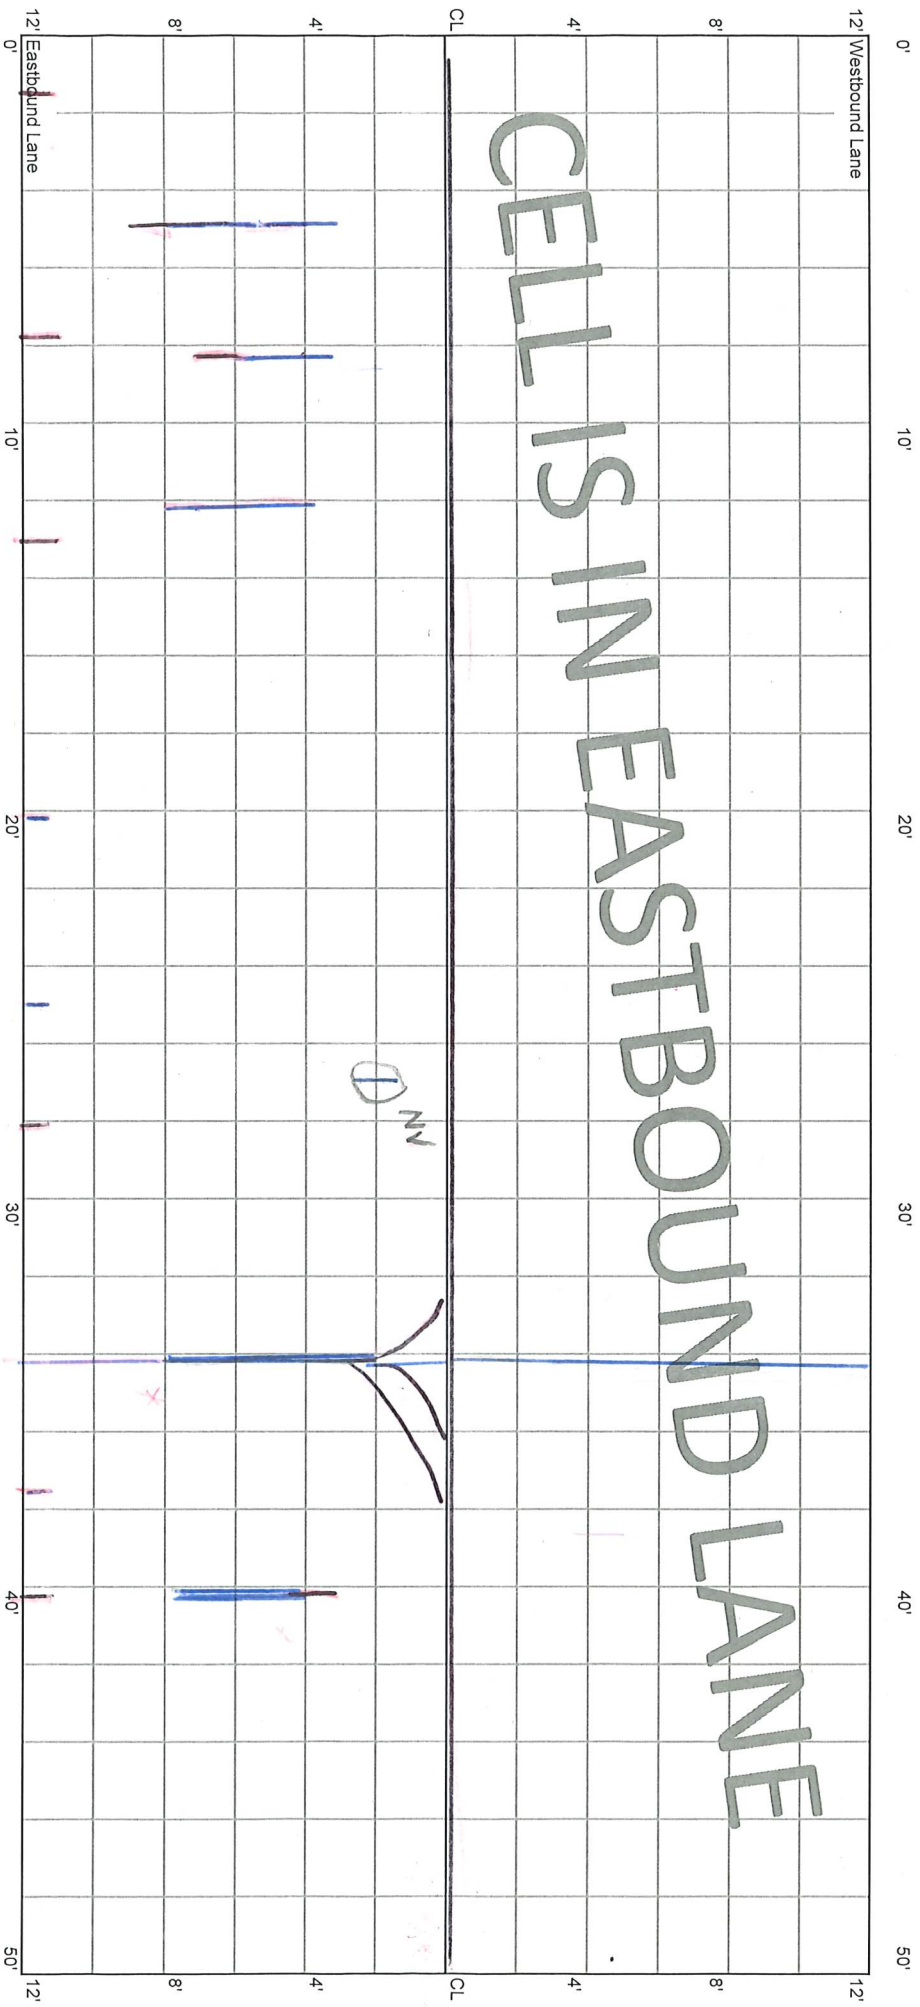

S  
M  
Debris

CELL 7001E  
250 - 300 ft

2+50


3+00

12' Westbound Lane

12' Eastbound Lane

CELL IS IN EASTBOUND LANE

0' 10' 20' 30' 40' 50'

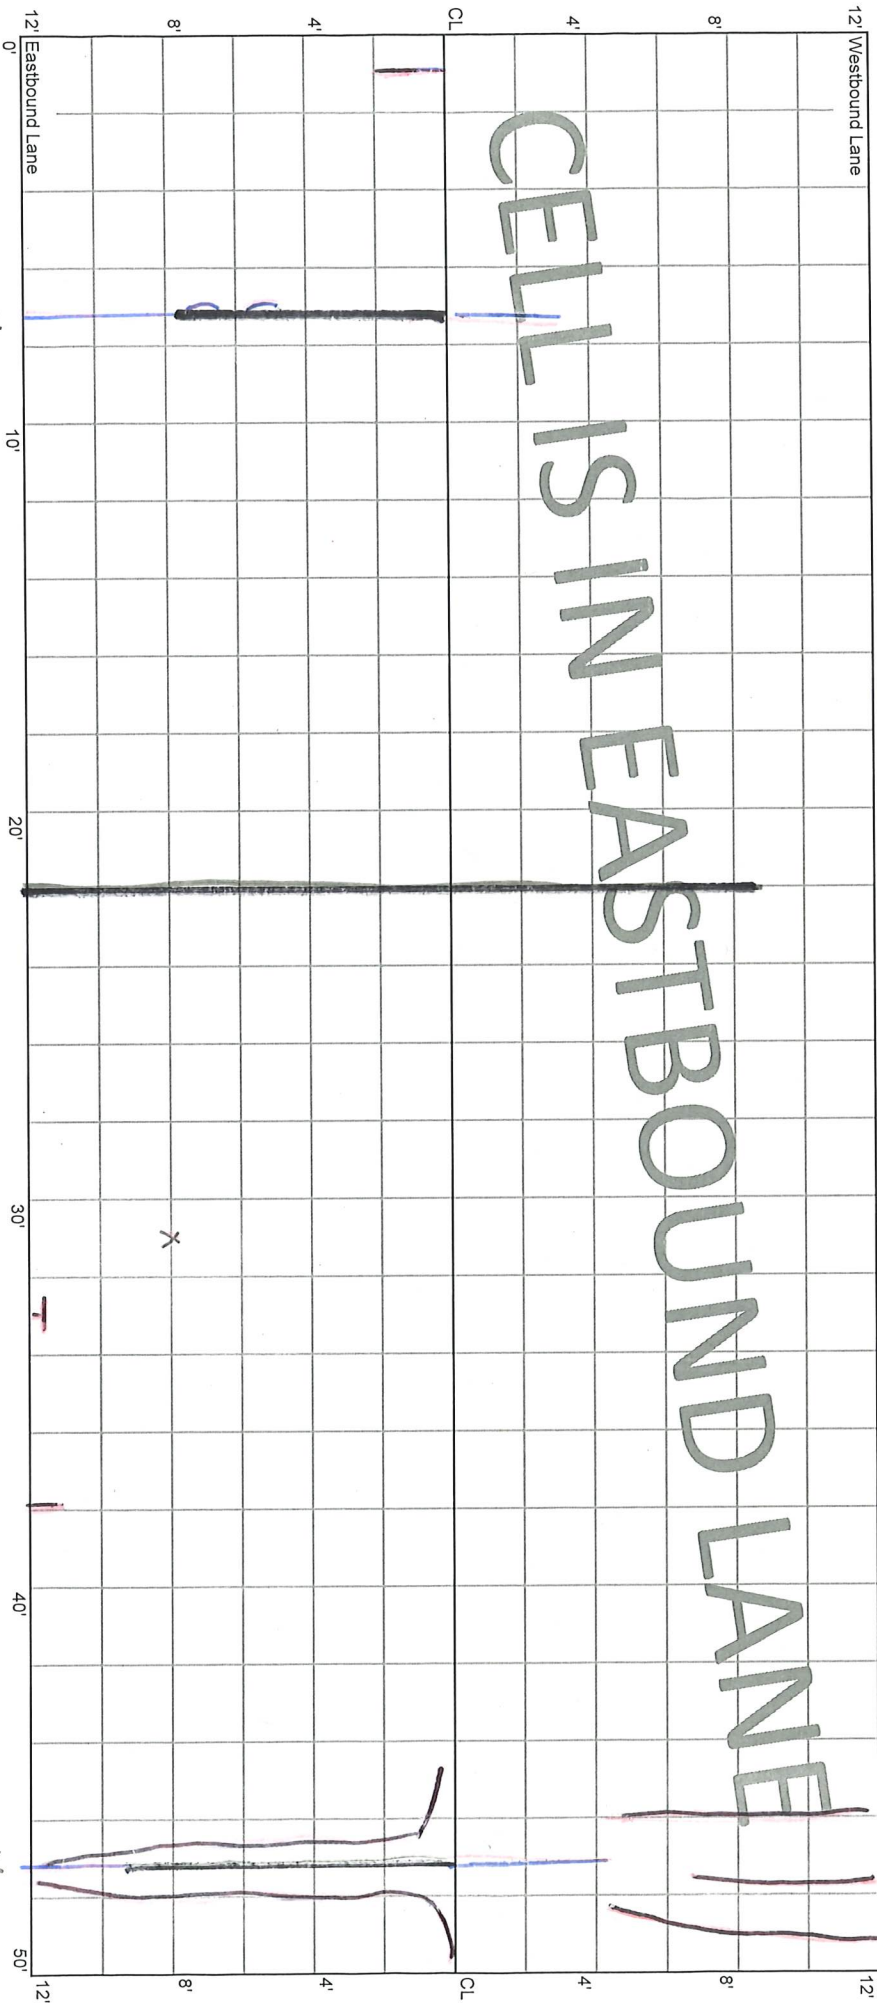

M  
8-in AF, SP

M

X

T


H  
SP

X report

CELL 7001E  
300 - 350 ft

3+00

3+50

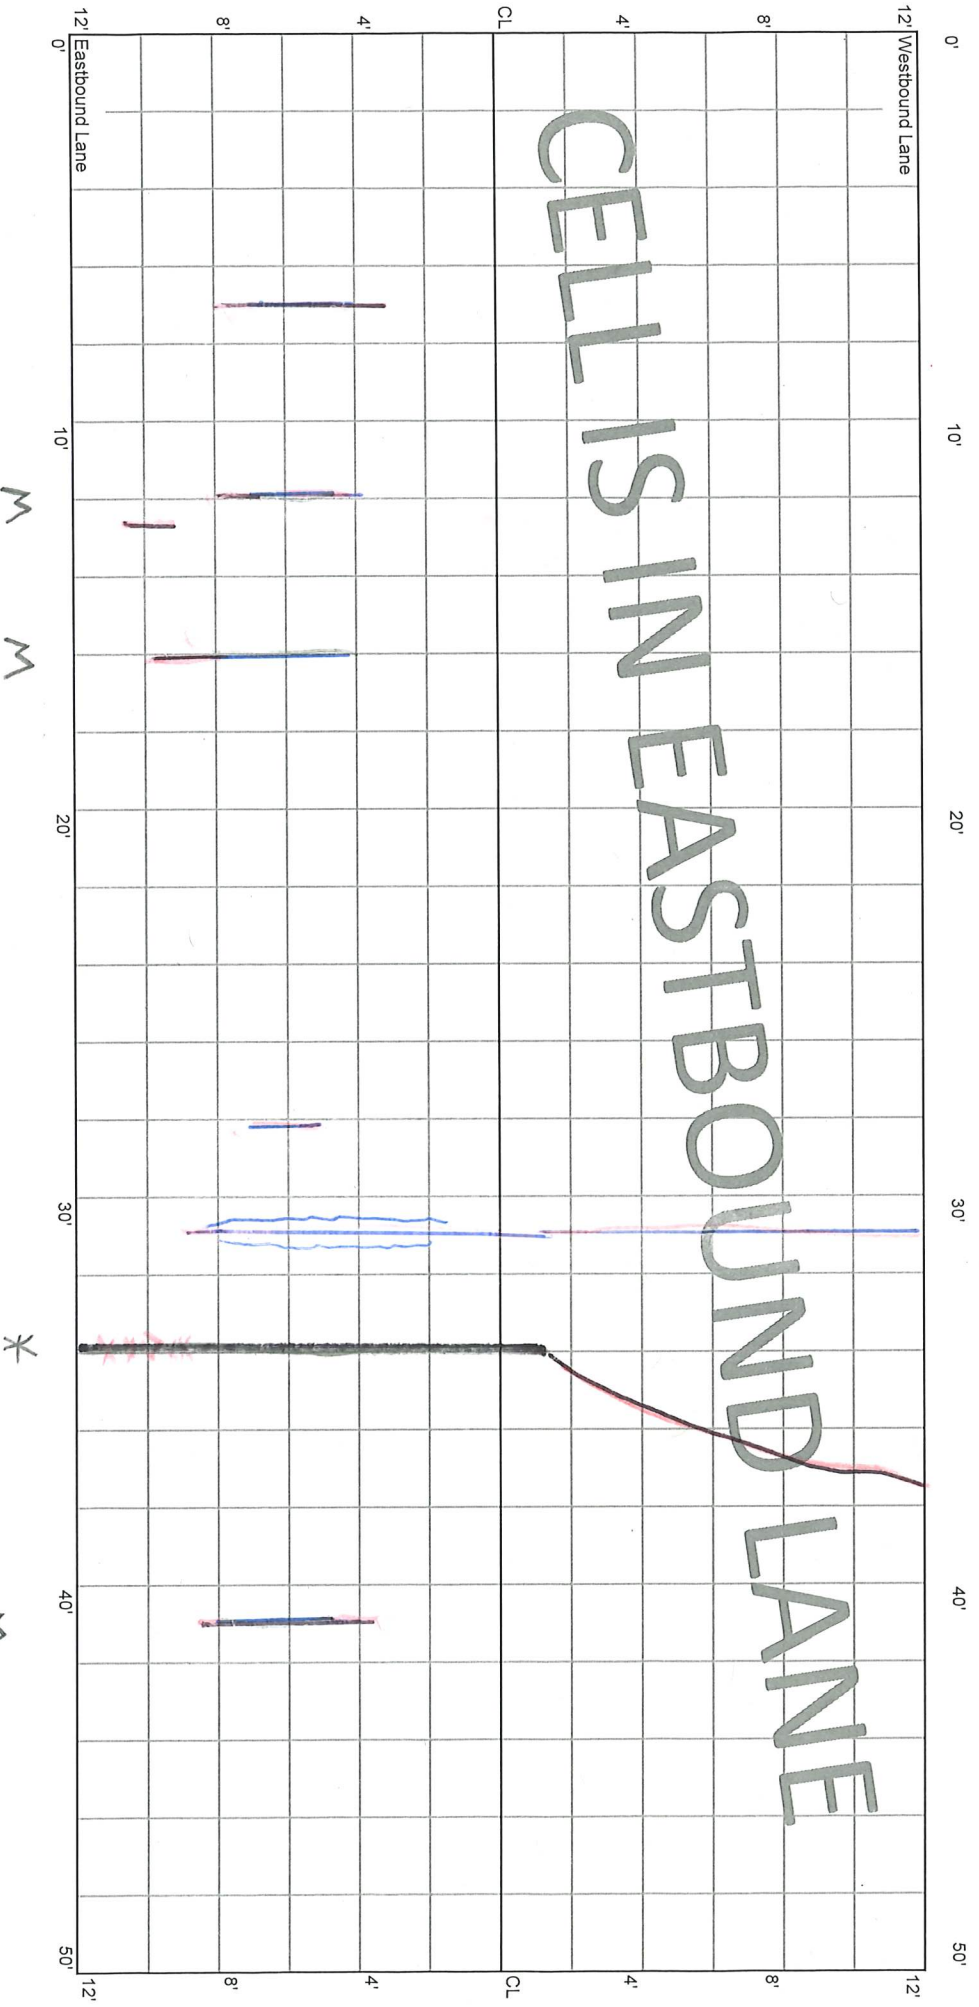

P 319

M  
P 319

M  
5'

CELL 7001E  
350 - 400 ft

3+50

4+00

12' Westbound Lane


12'

0' 10' 20' 30' 40' 50'

CELLS IN EASTBOUND LANE

CL CL

12' Eastbound Lane 0' 10' 20' 30' 40' 50'

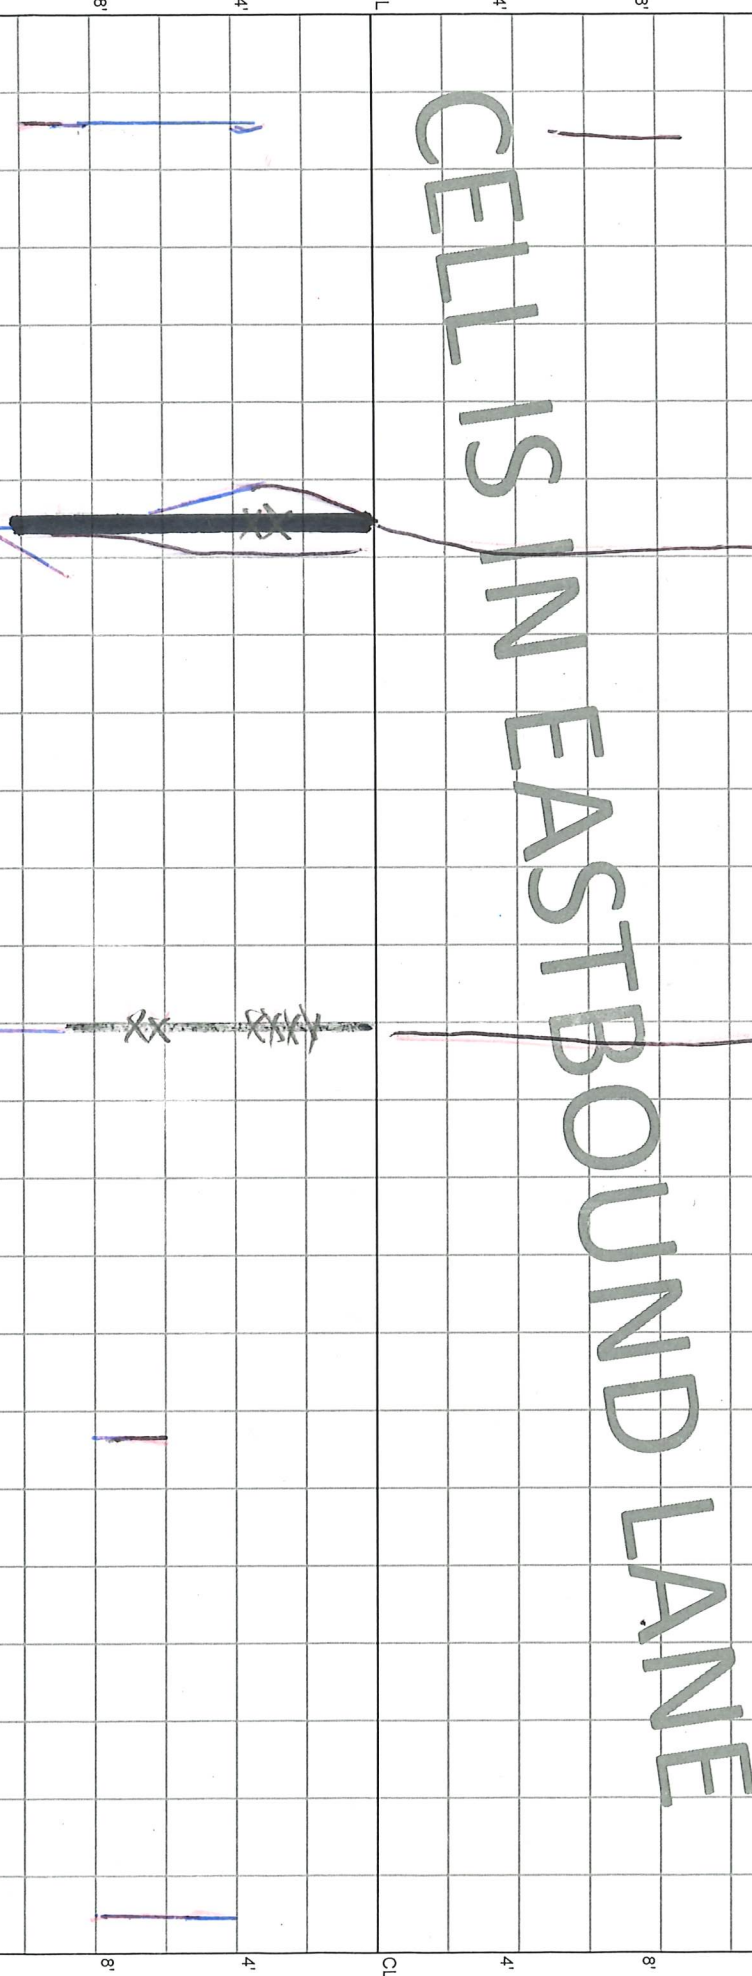

6'

\* 10-ft  
SP  
M


\*  
M



CELL 7001E  
400 - 450 ft

4+00

4+50

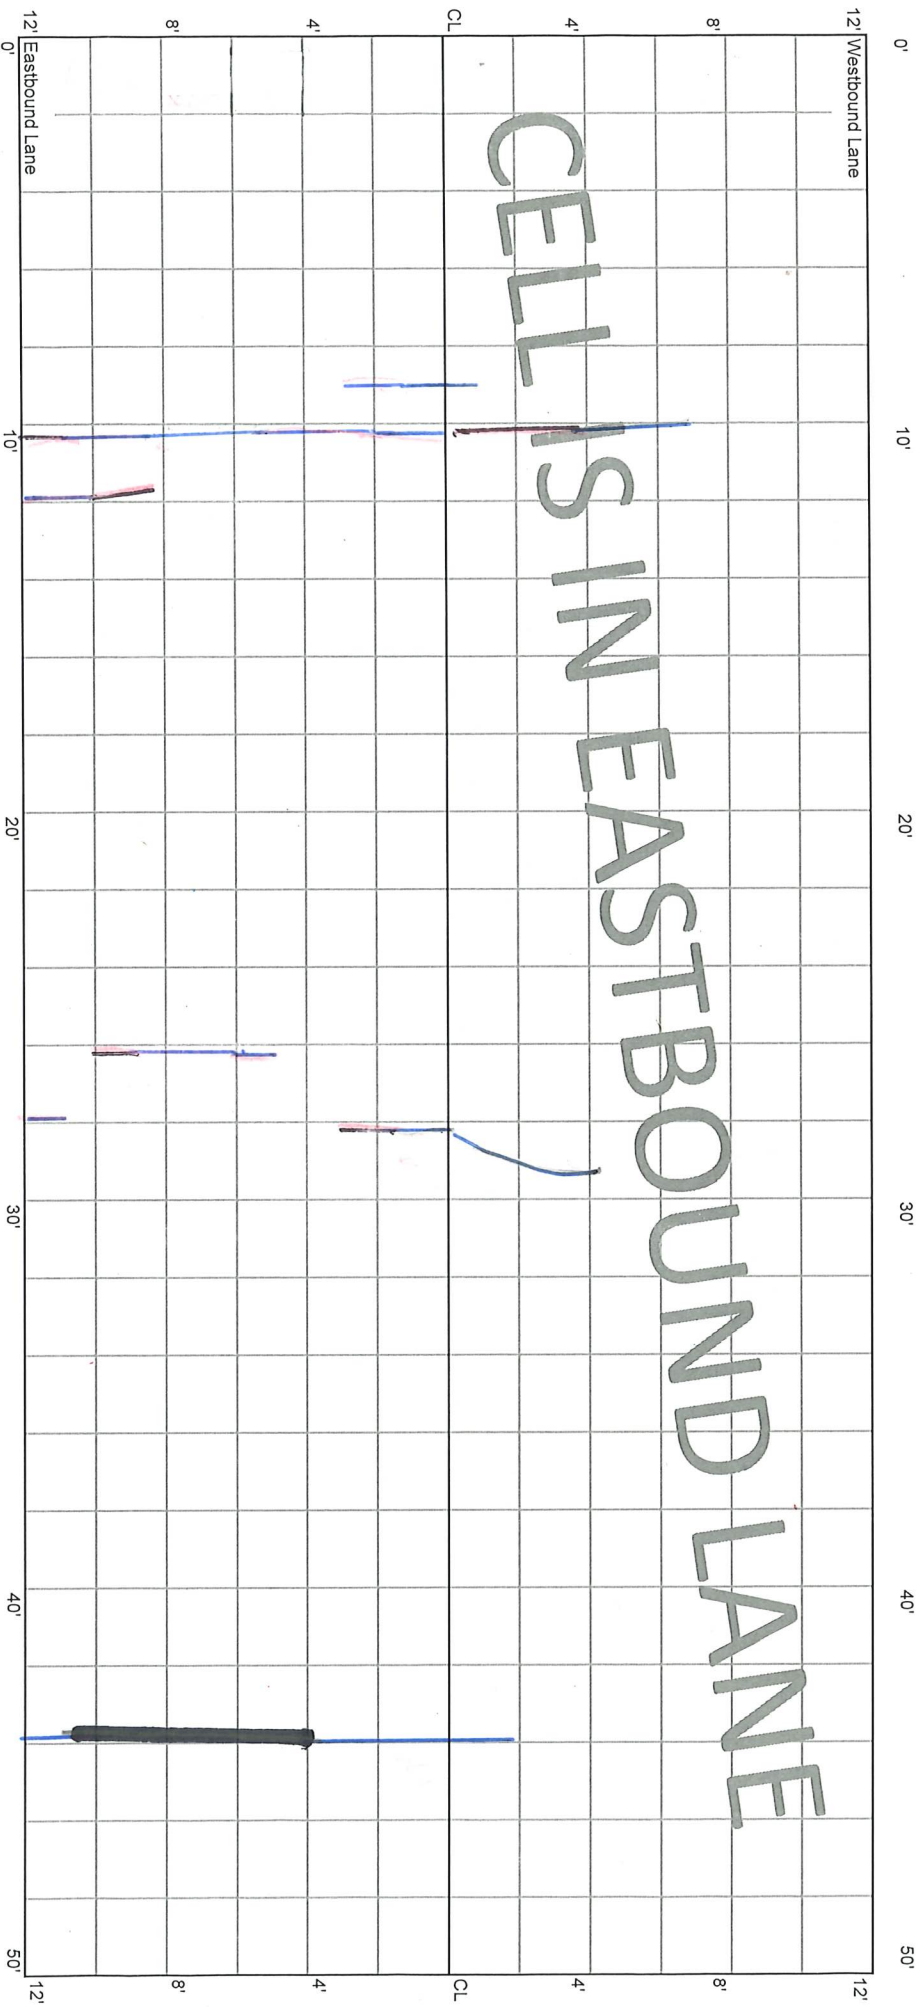

M


12' M  
1/2' S.P., 1/2' A.F.

CELL (8-05-1)

CELL 7001E  
450 - 500 ft

4+50

5+00

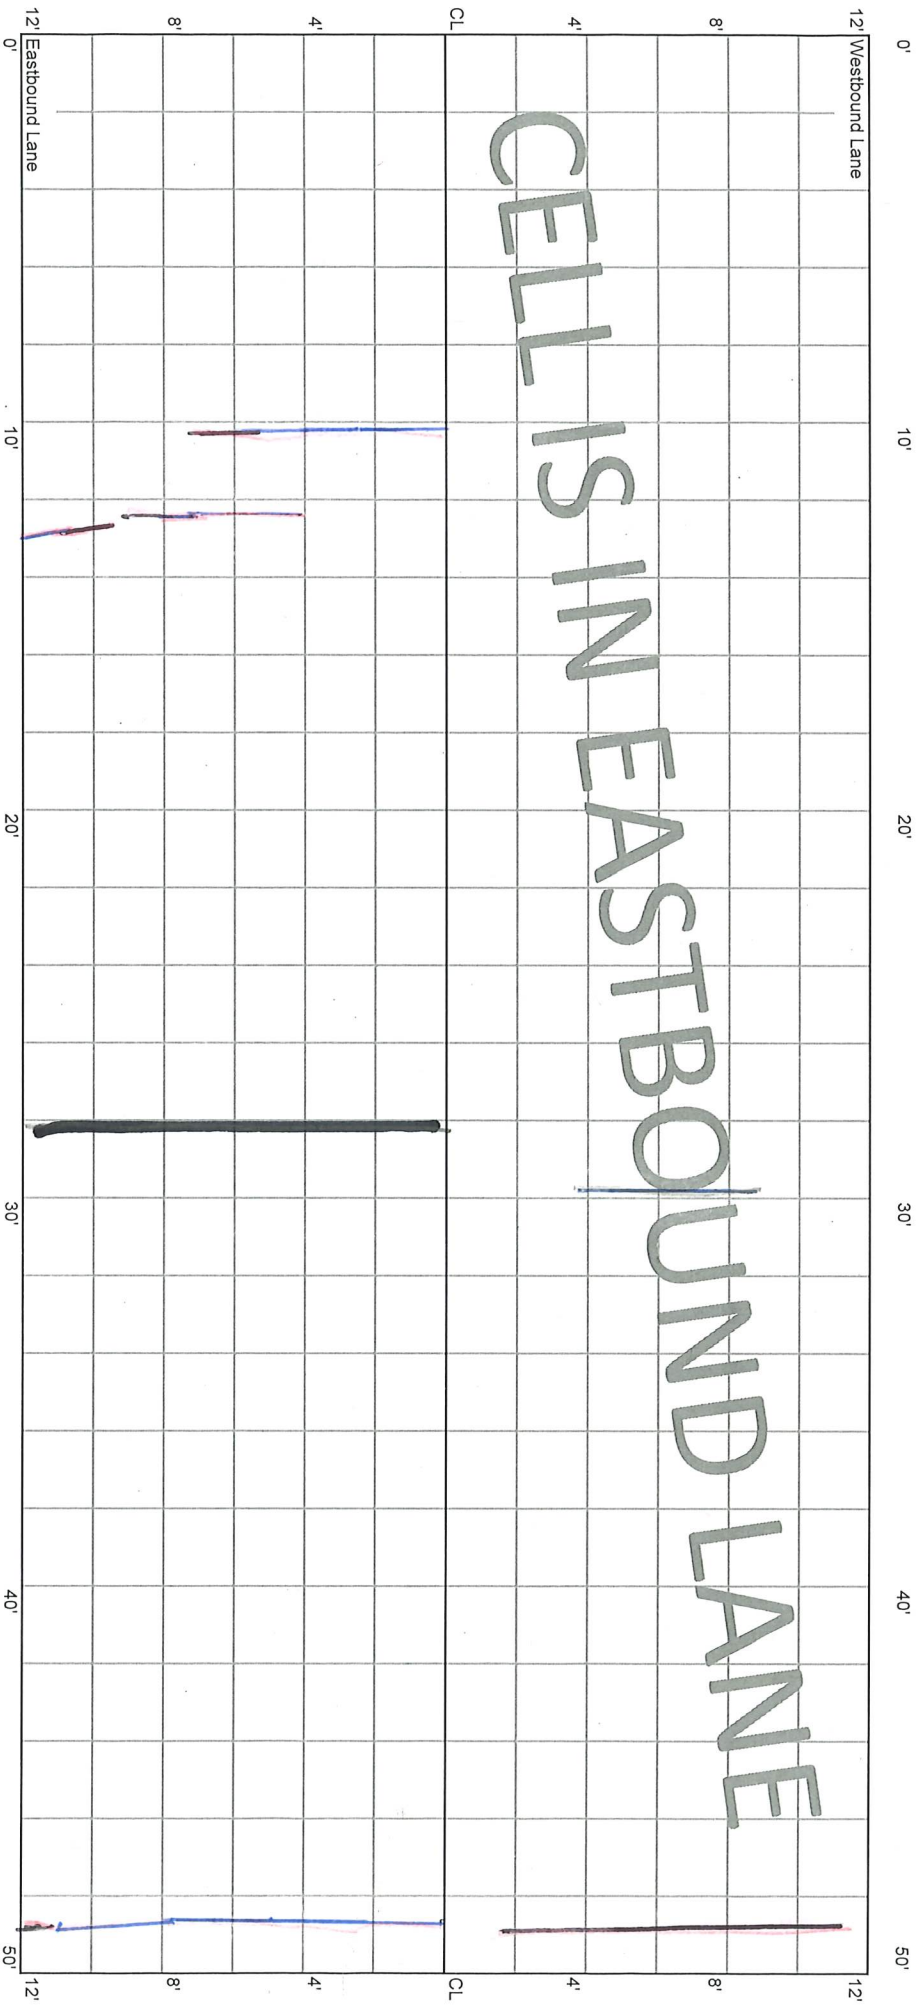

(AF, SP) - 2++


M

CELL 7001E  
500 - 550 ft

5+00

5+25

5+50

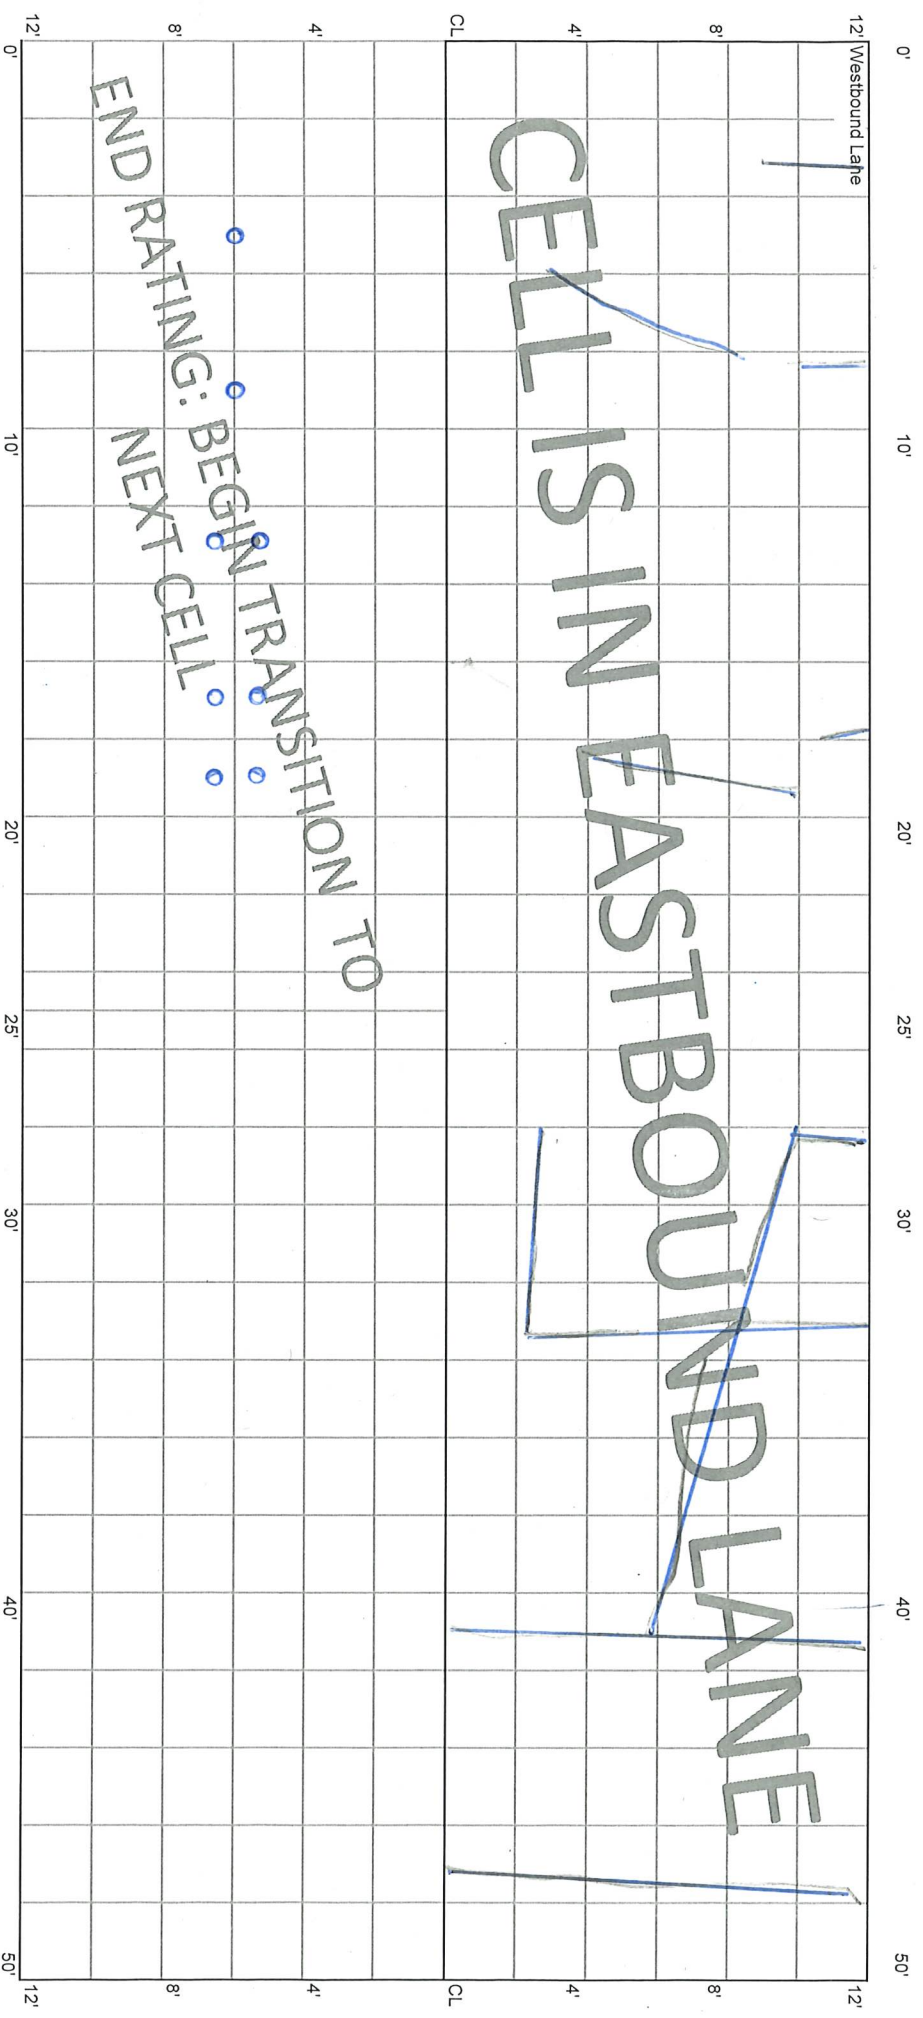

(0: out 20  
cores)



(12)