

5.28.20 E.J.

10.14.20 1.12.22

1.4.21 8.31.22

File 70TH ST 1.26.23


22+00

Ruton outside of Fogline

CELL 7005E
0 - 50 ft

8.25.21 - 36 Trans. cks outside
Fog line.

22+50

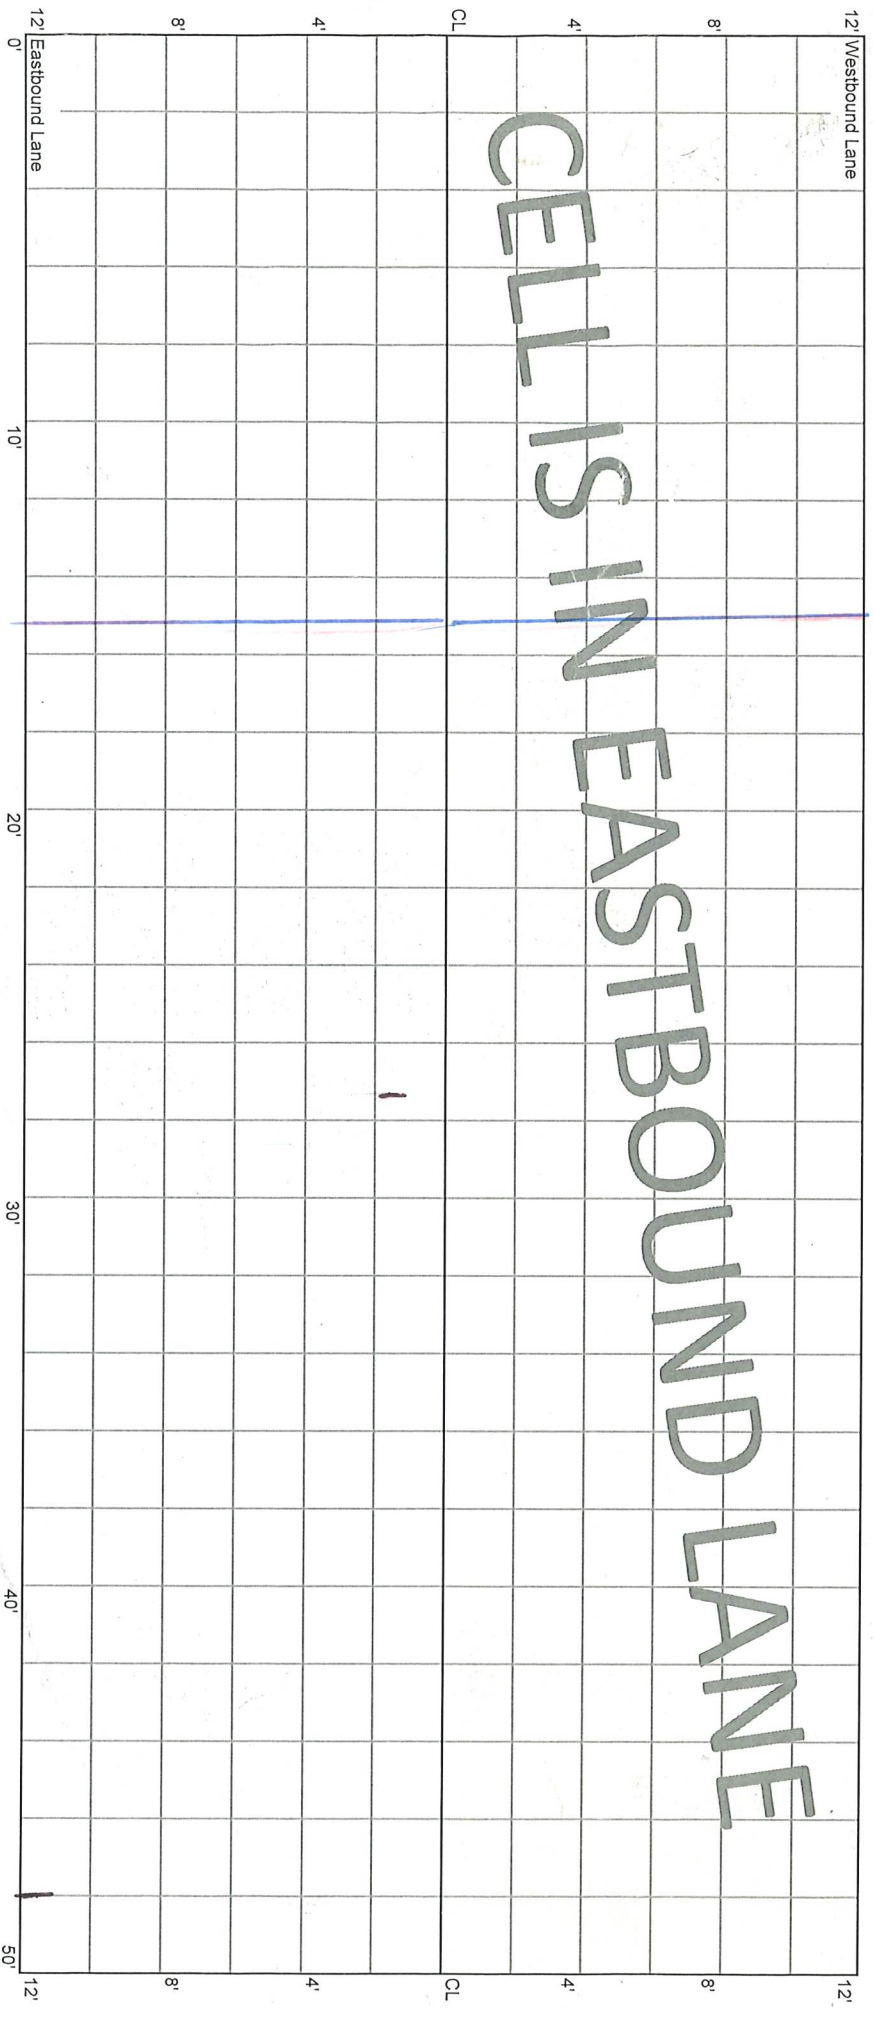


* Rut Seal

CELL 7005E
50 - 100 ft

22+50


23+00

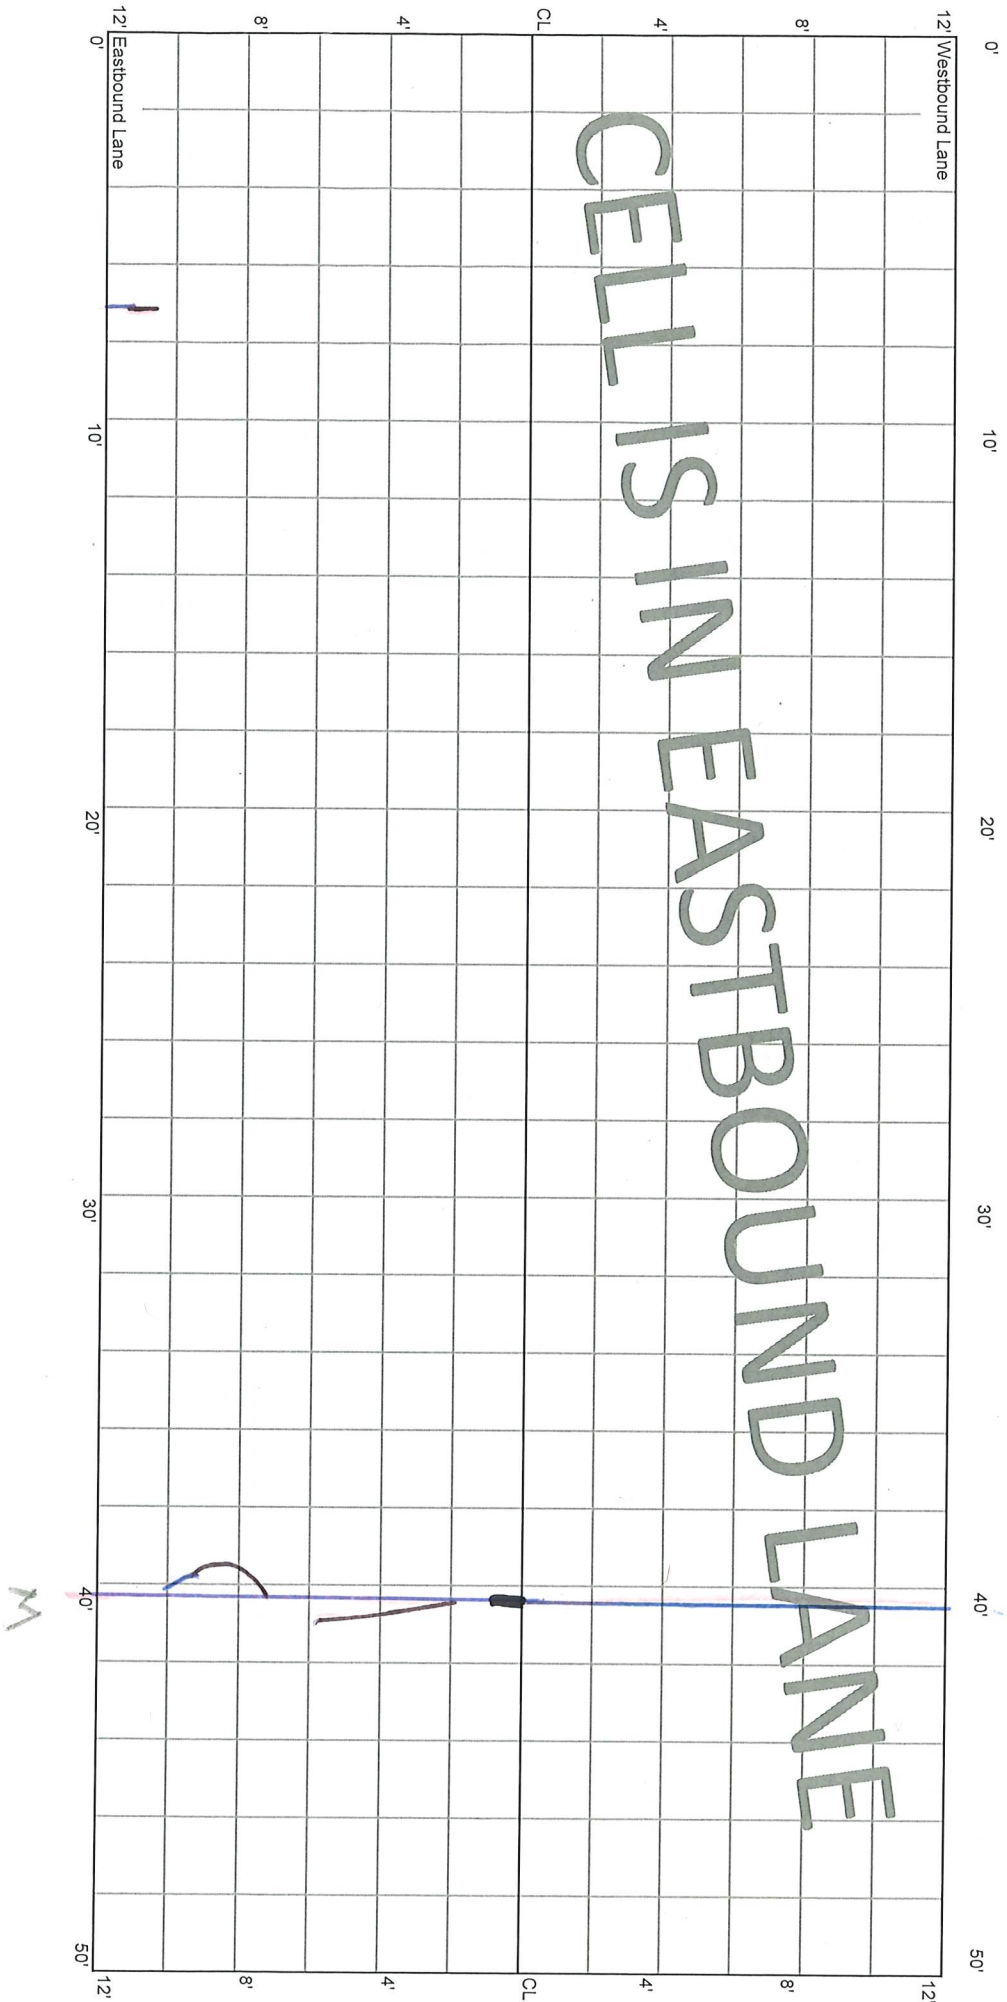

CELL 7005E
100 - 150 ft

23+00


23+50

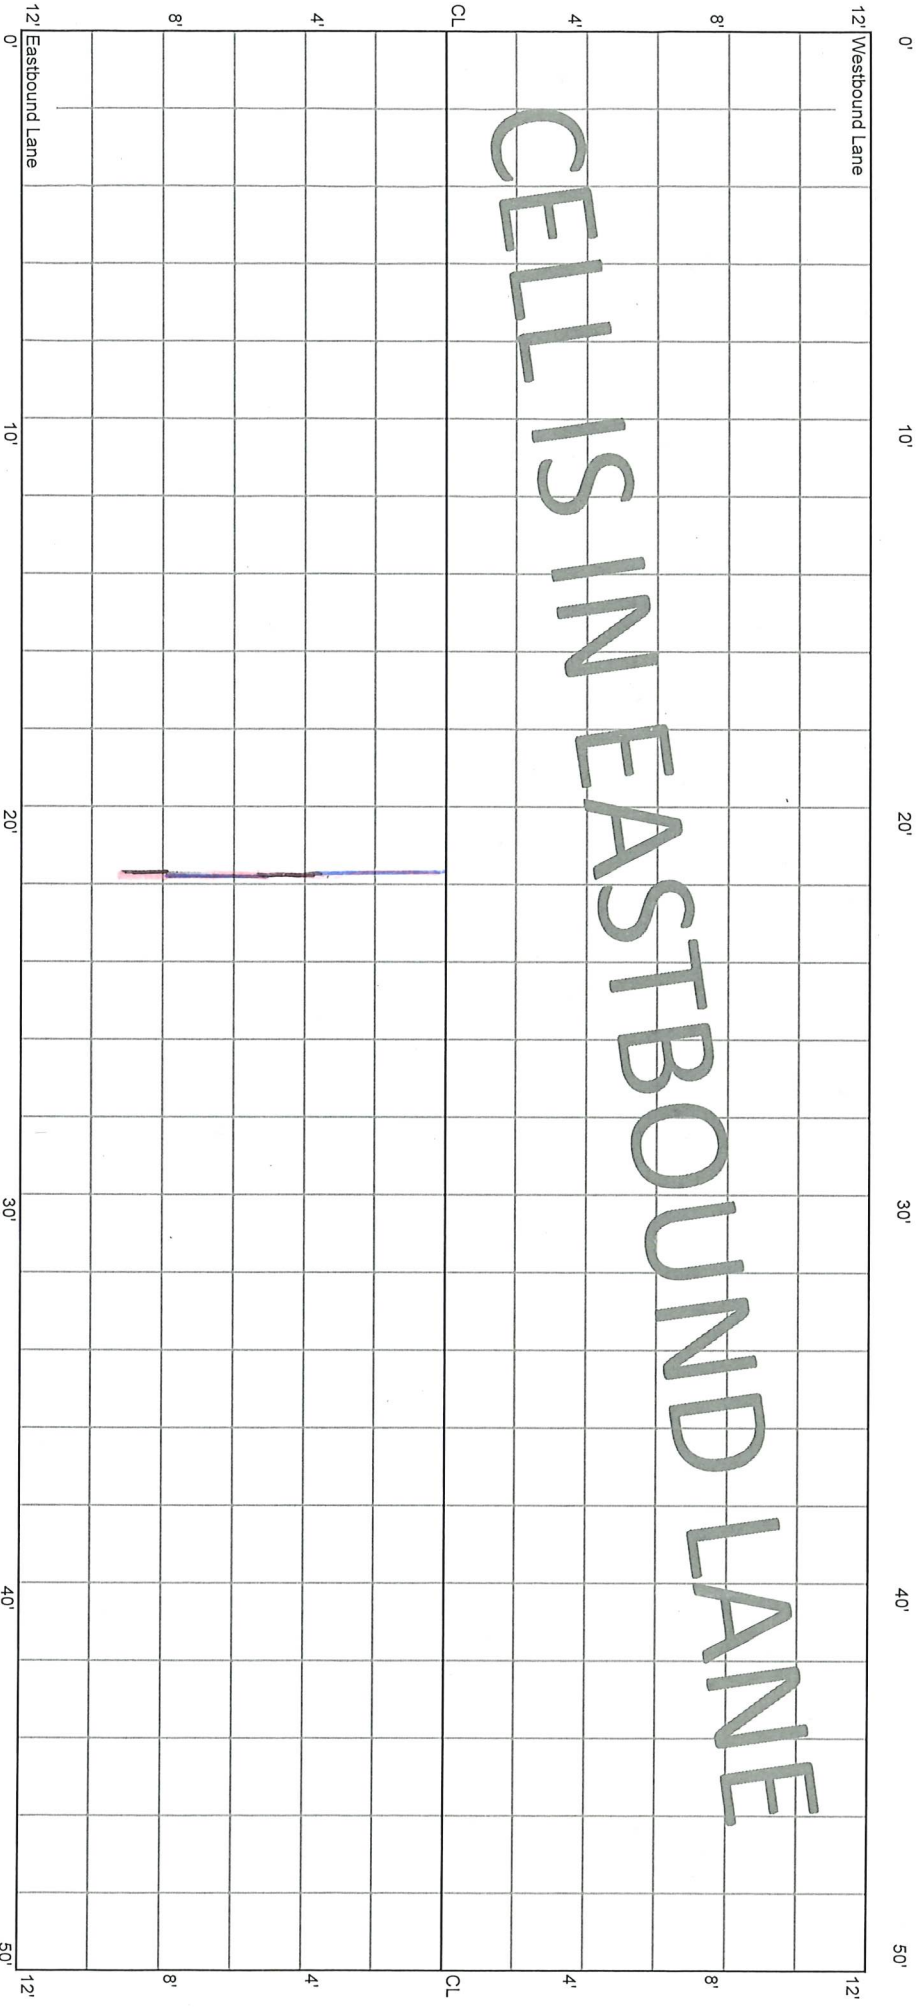

CELL 7005E
150 - 200 ft

23+50

24+00

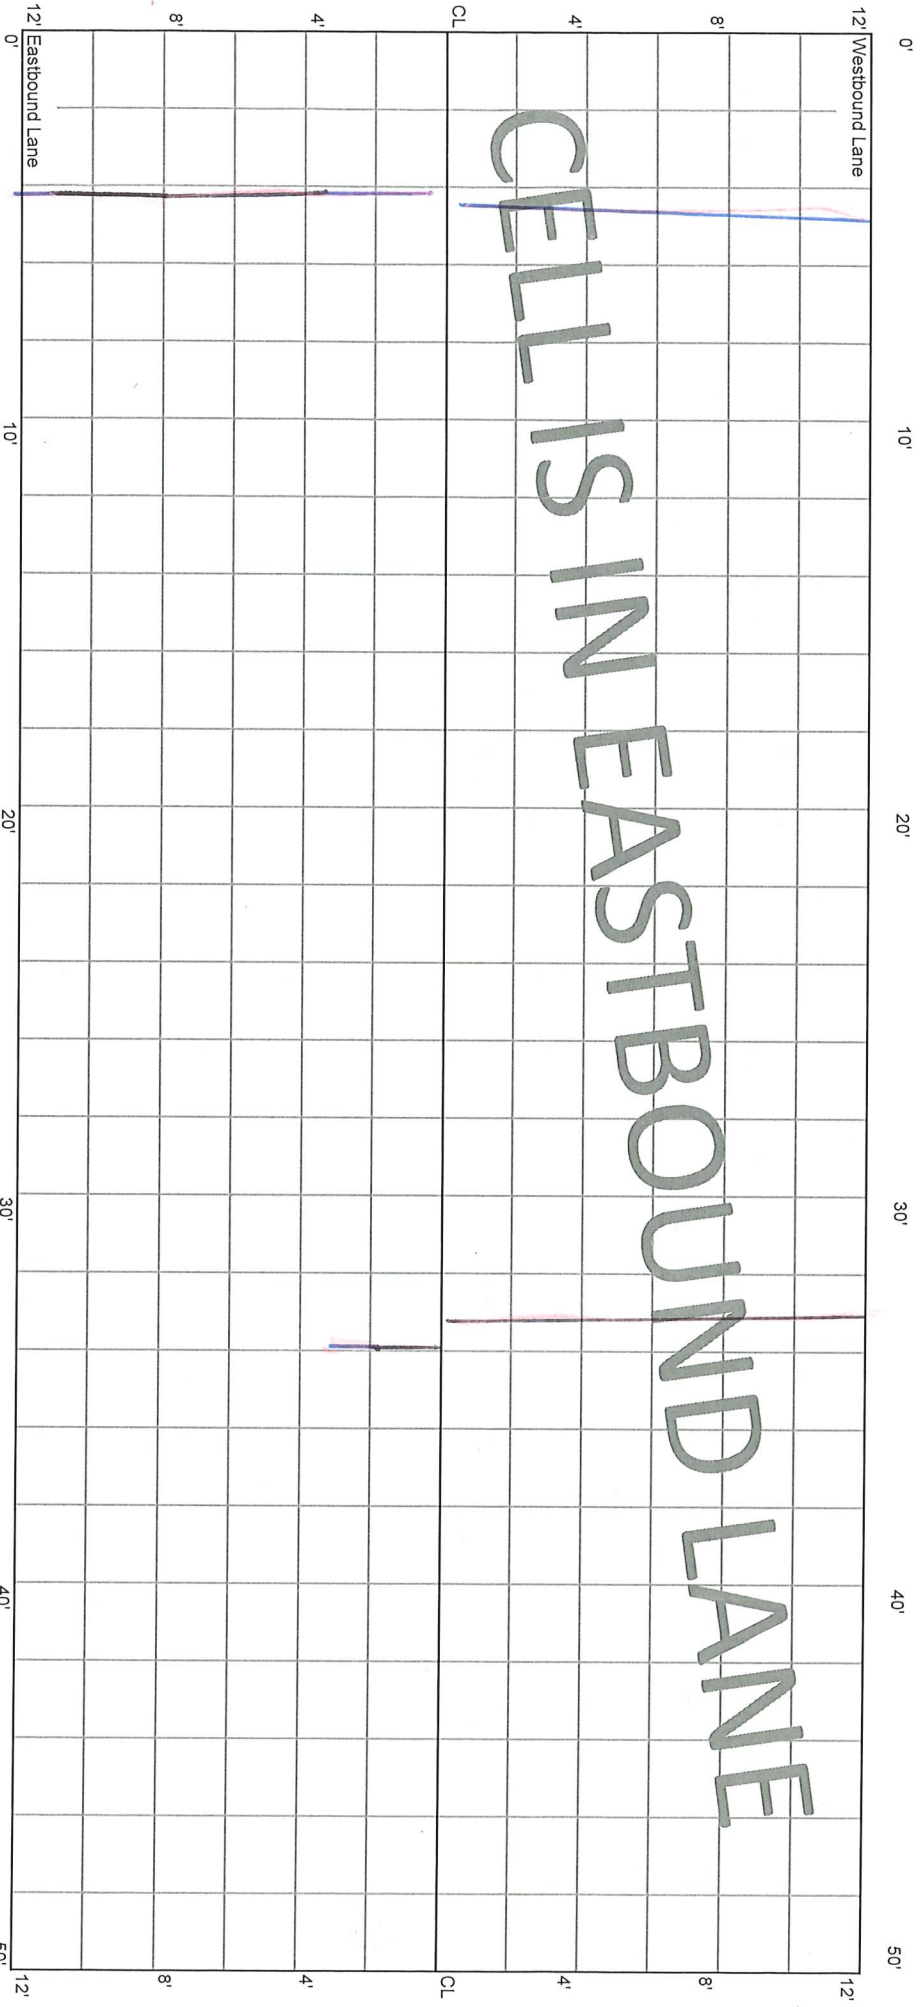


CELL IS IN EASTBOUND LANE

3 1/2

CELL 7005E
200 - 250 ft

24+00

24+50

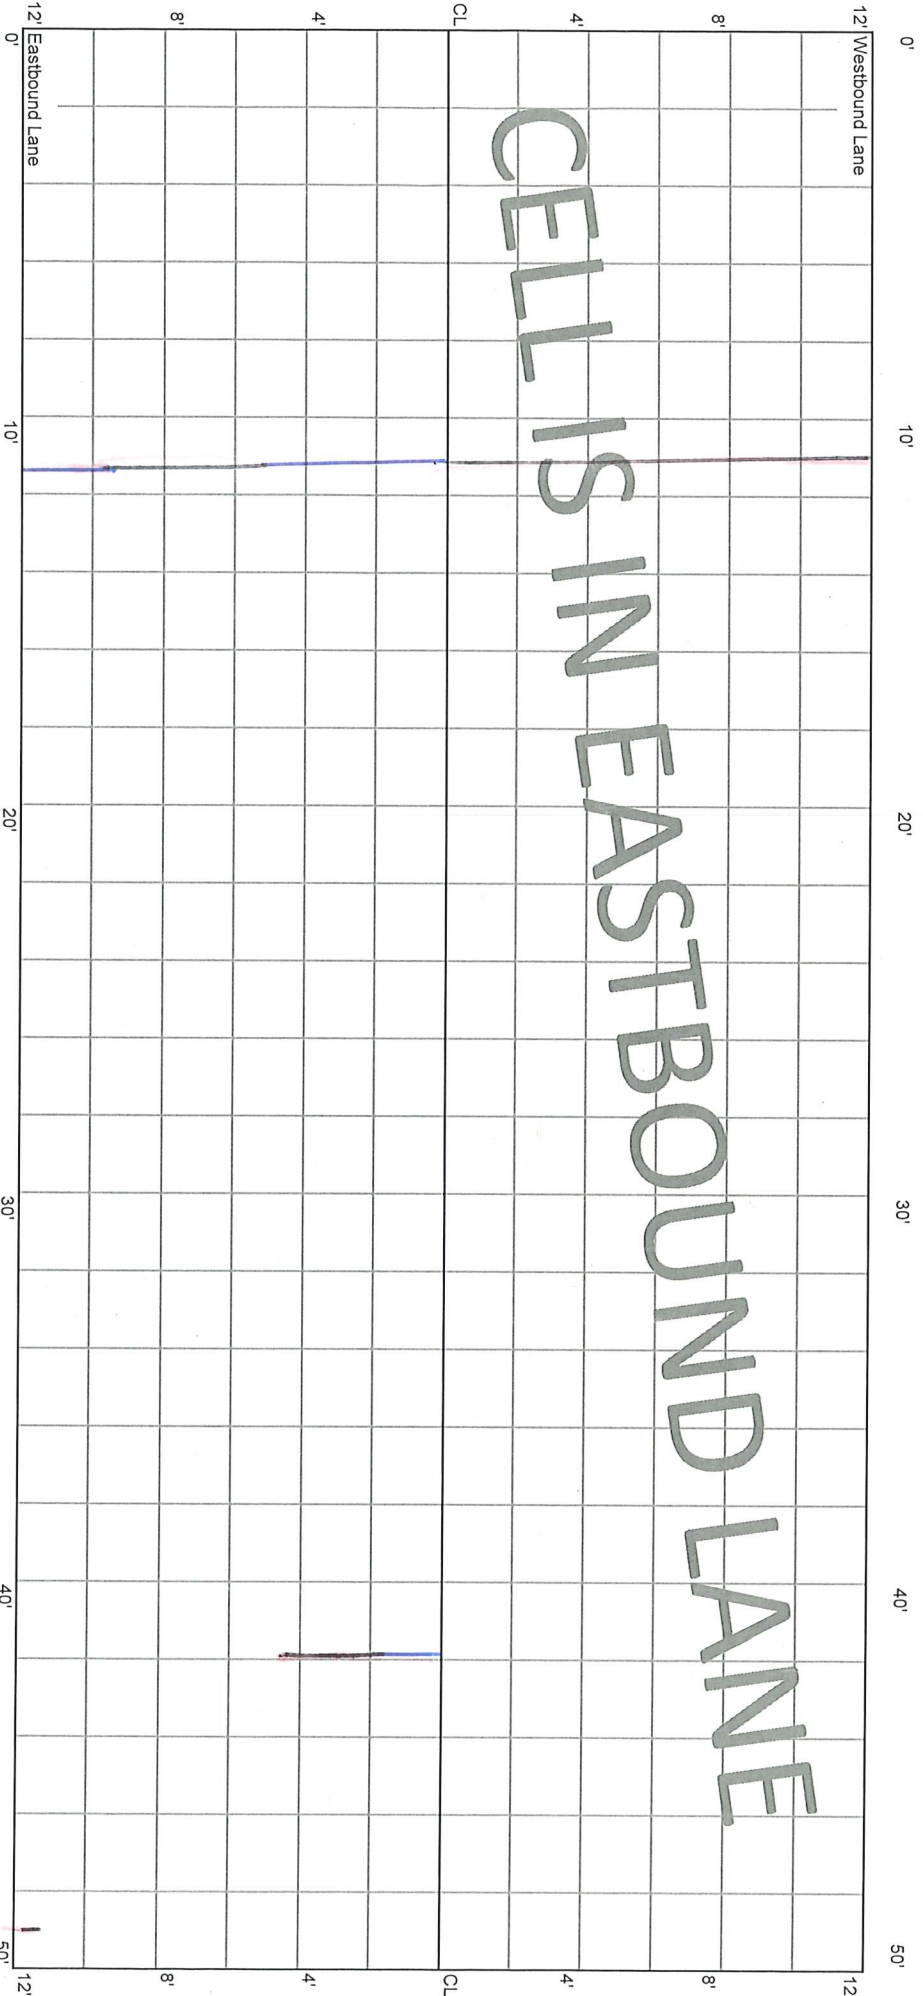

200-221
SIDE/EDGE C&K

4 1/2


1 1/2

CELL 7005E
250 - 300 ft

24+50

25+00

CELLS IN EASTBOUND LANE

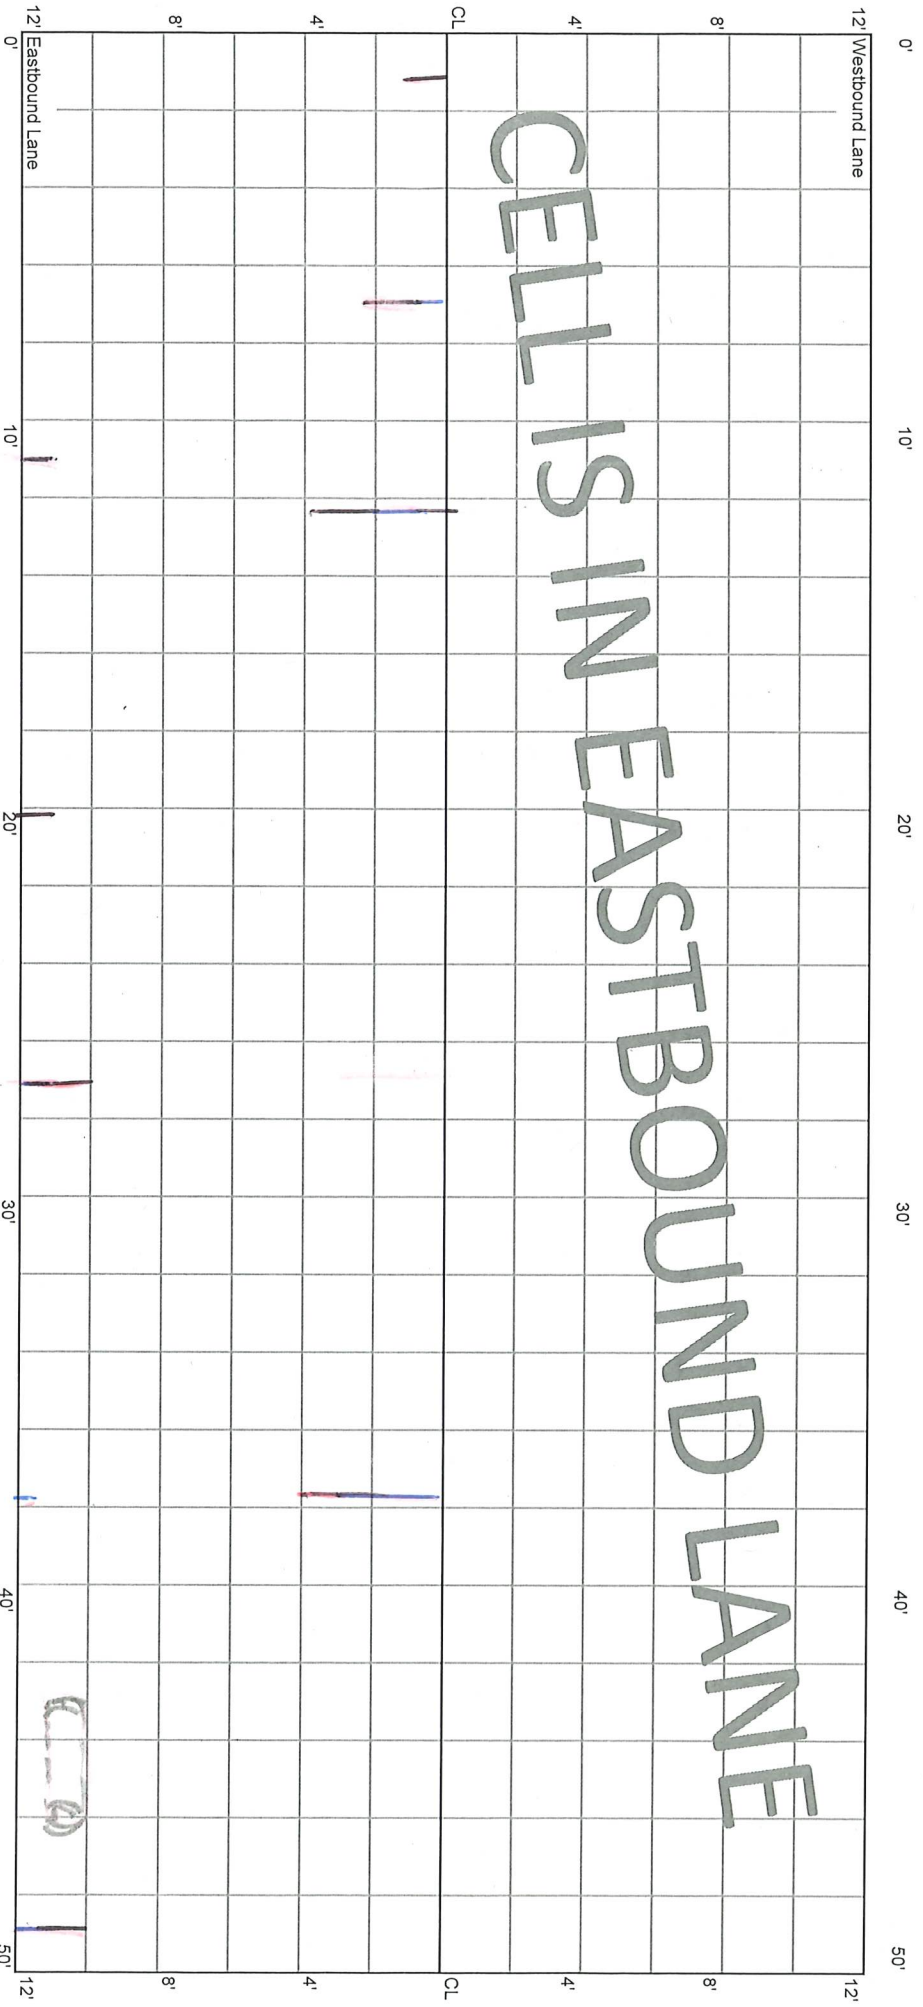


1/2

F + PH
Not Visible

CELL 7005E
300 - 350 ft

25+00

25+50

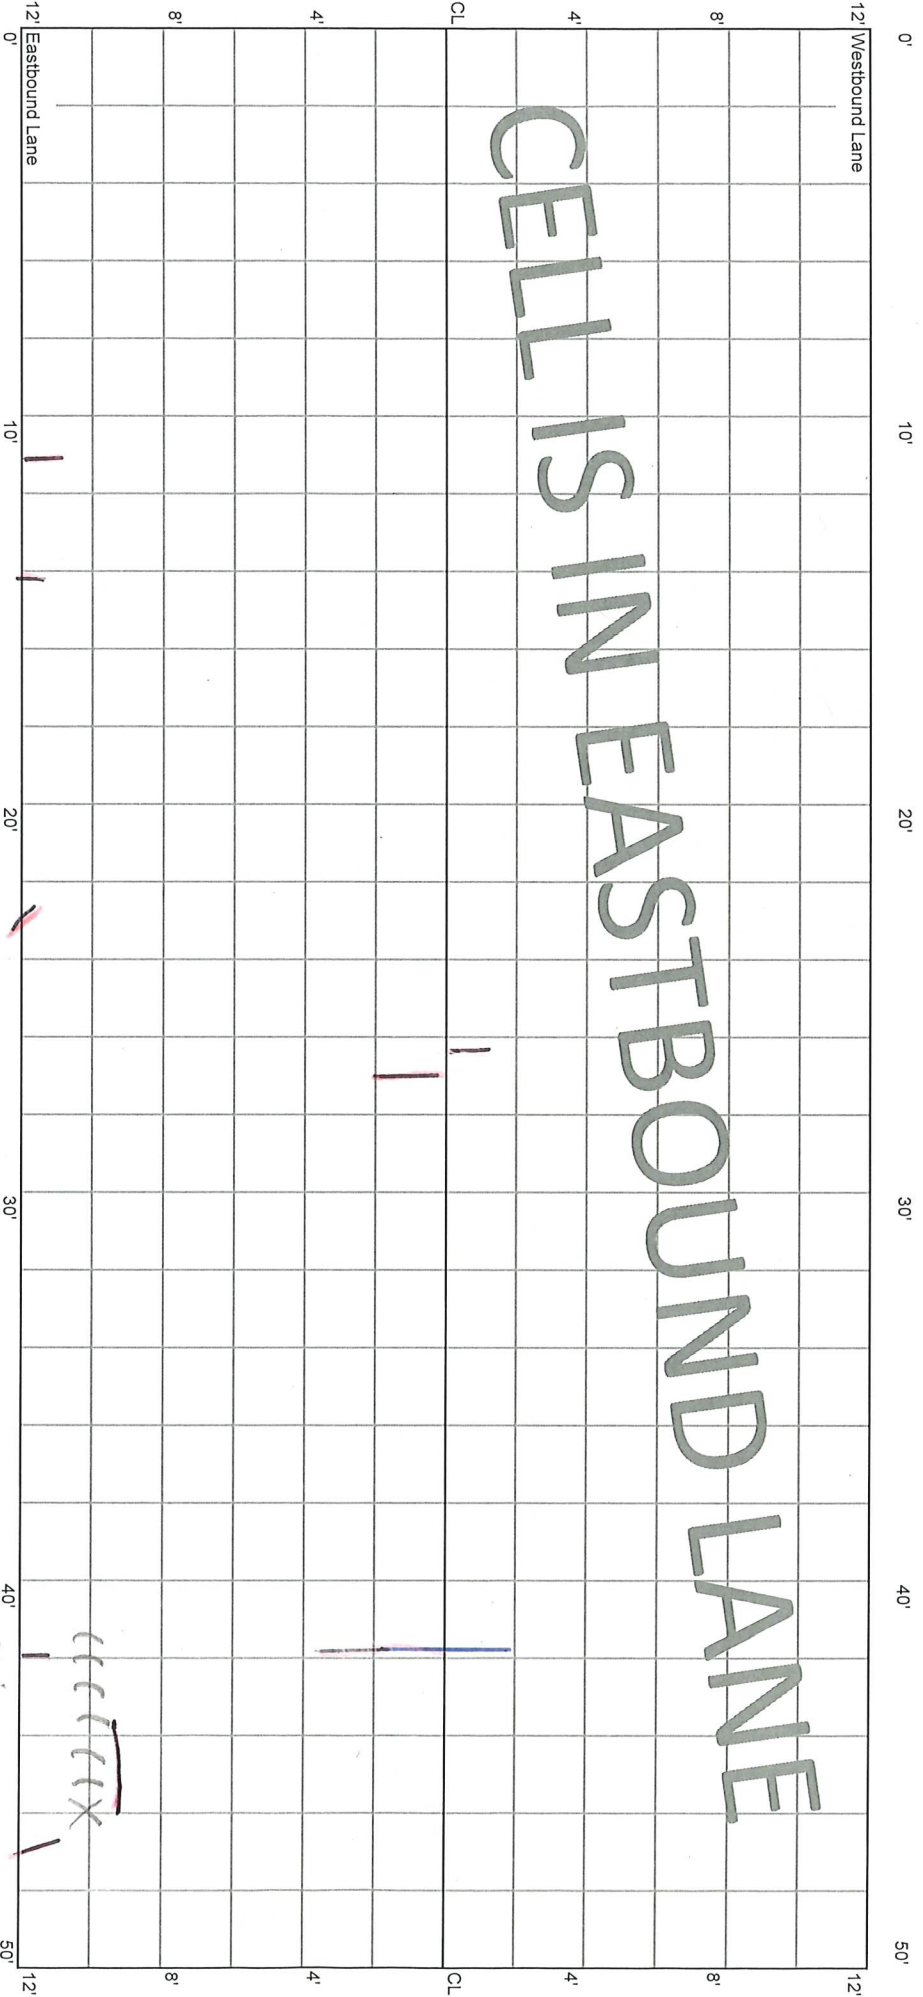

CELL 7005E


Fatigue

x 1/2 Defect
future pothole?

CELL 7005E
350 - 400 ft

25+50

26+00

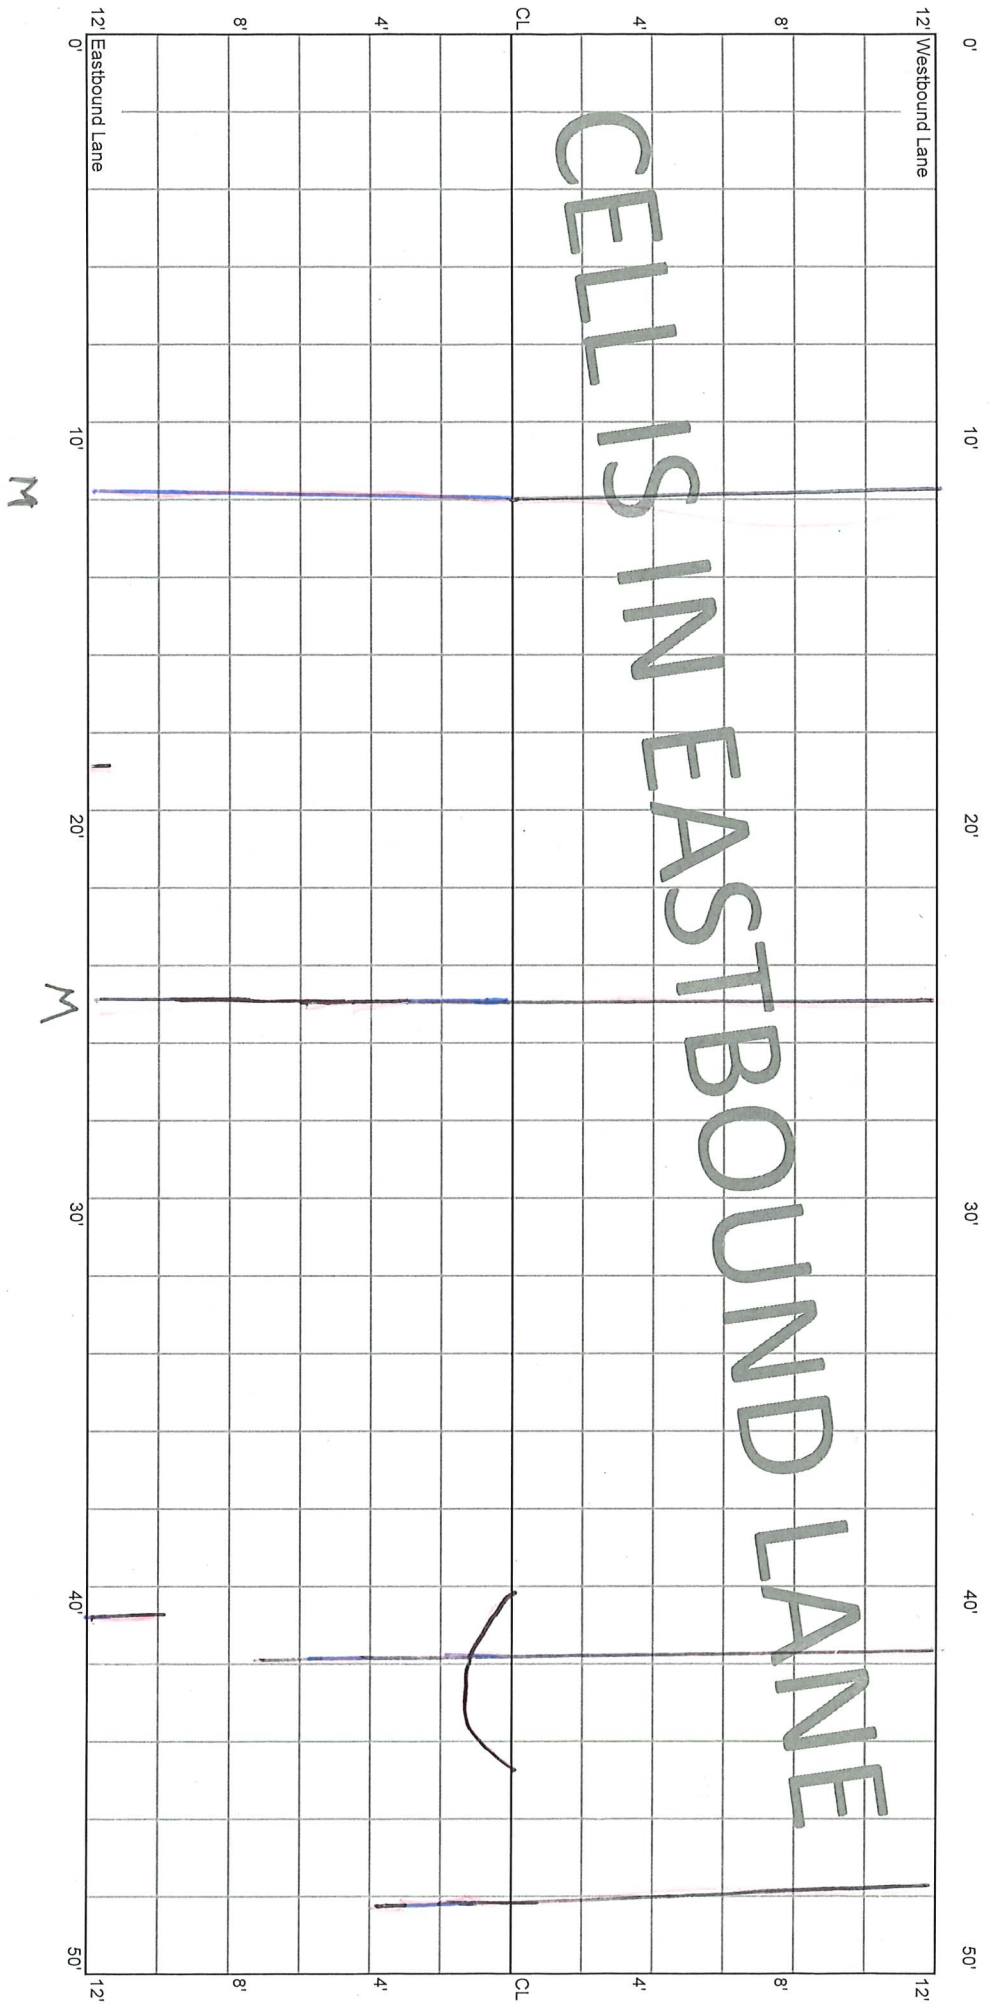

CELL IS IN EASTBOUND LANE

M


M

Cell 7005E

CELL 7005E
400 - 450 ft

26+00


26+50

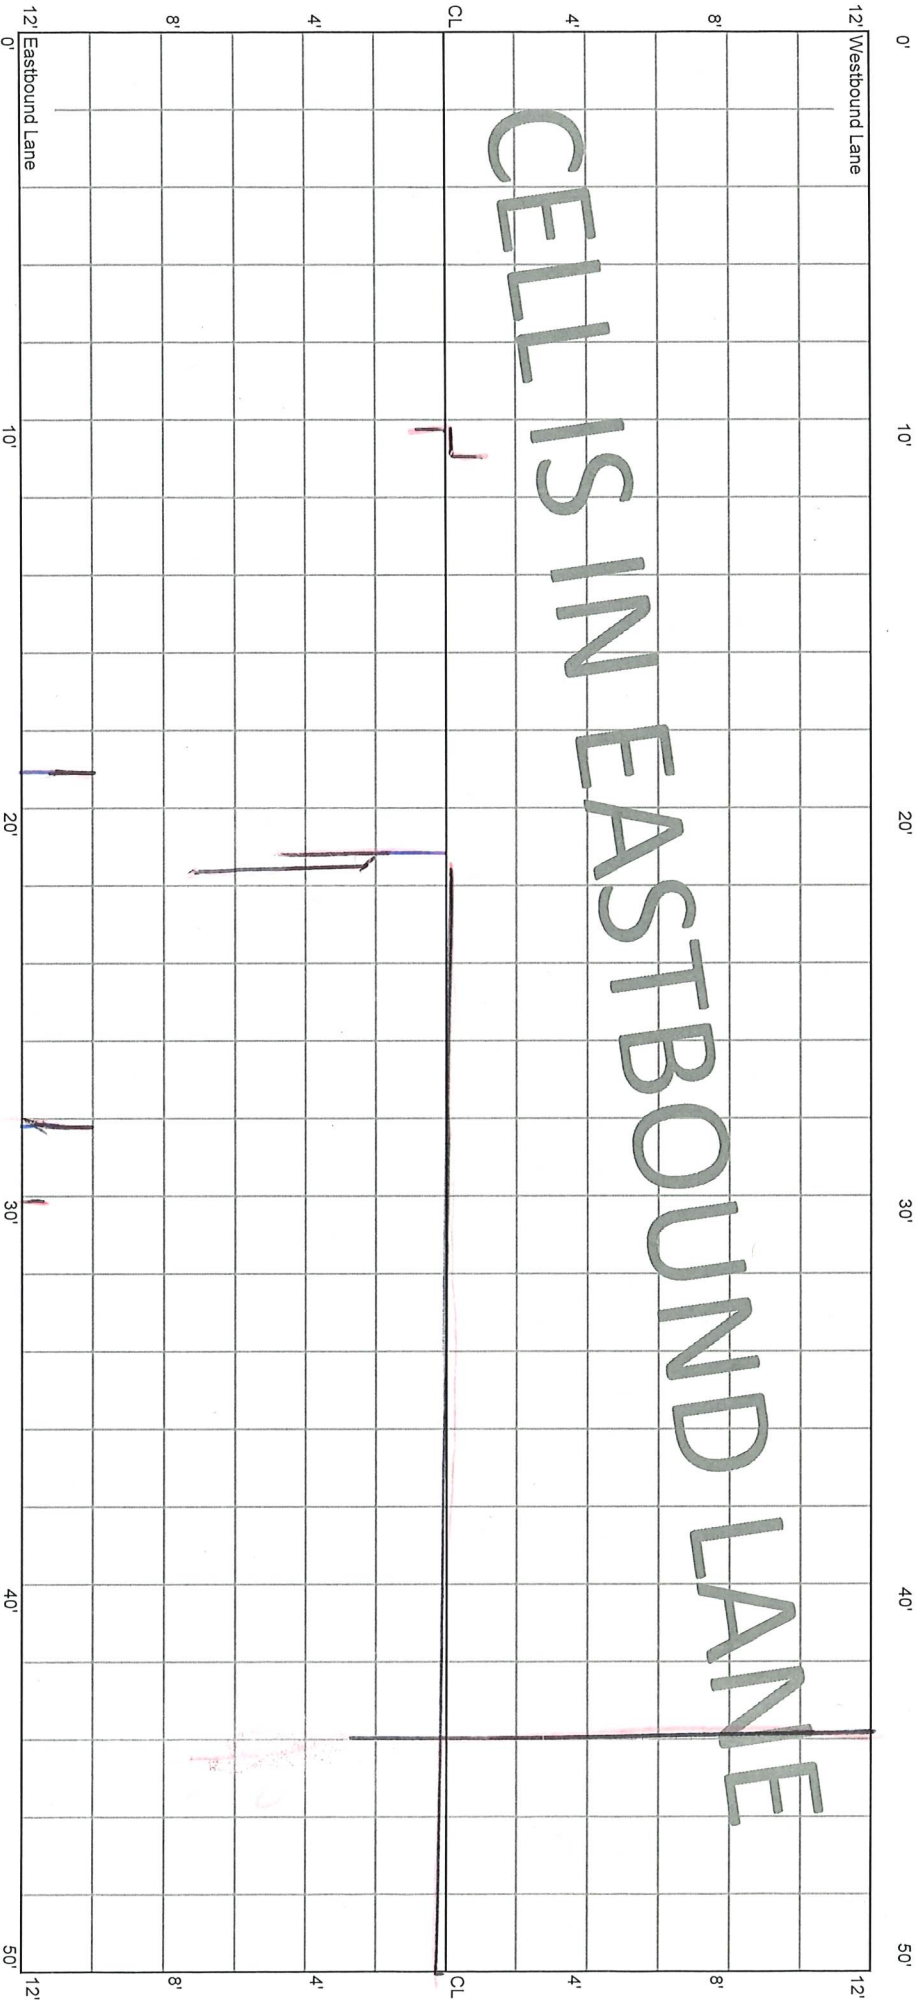

CELL 7005E
450 - 500 ft

26+50
26+58
CL KITTRIDGE

27+00

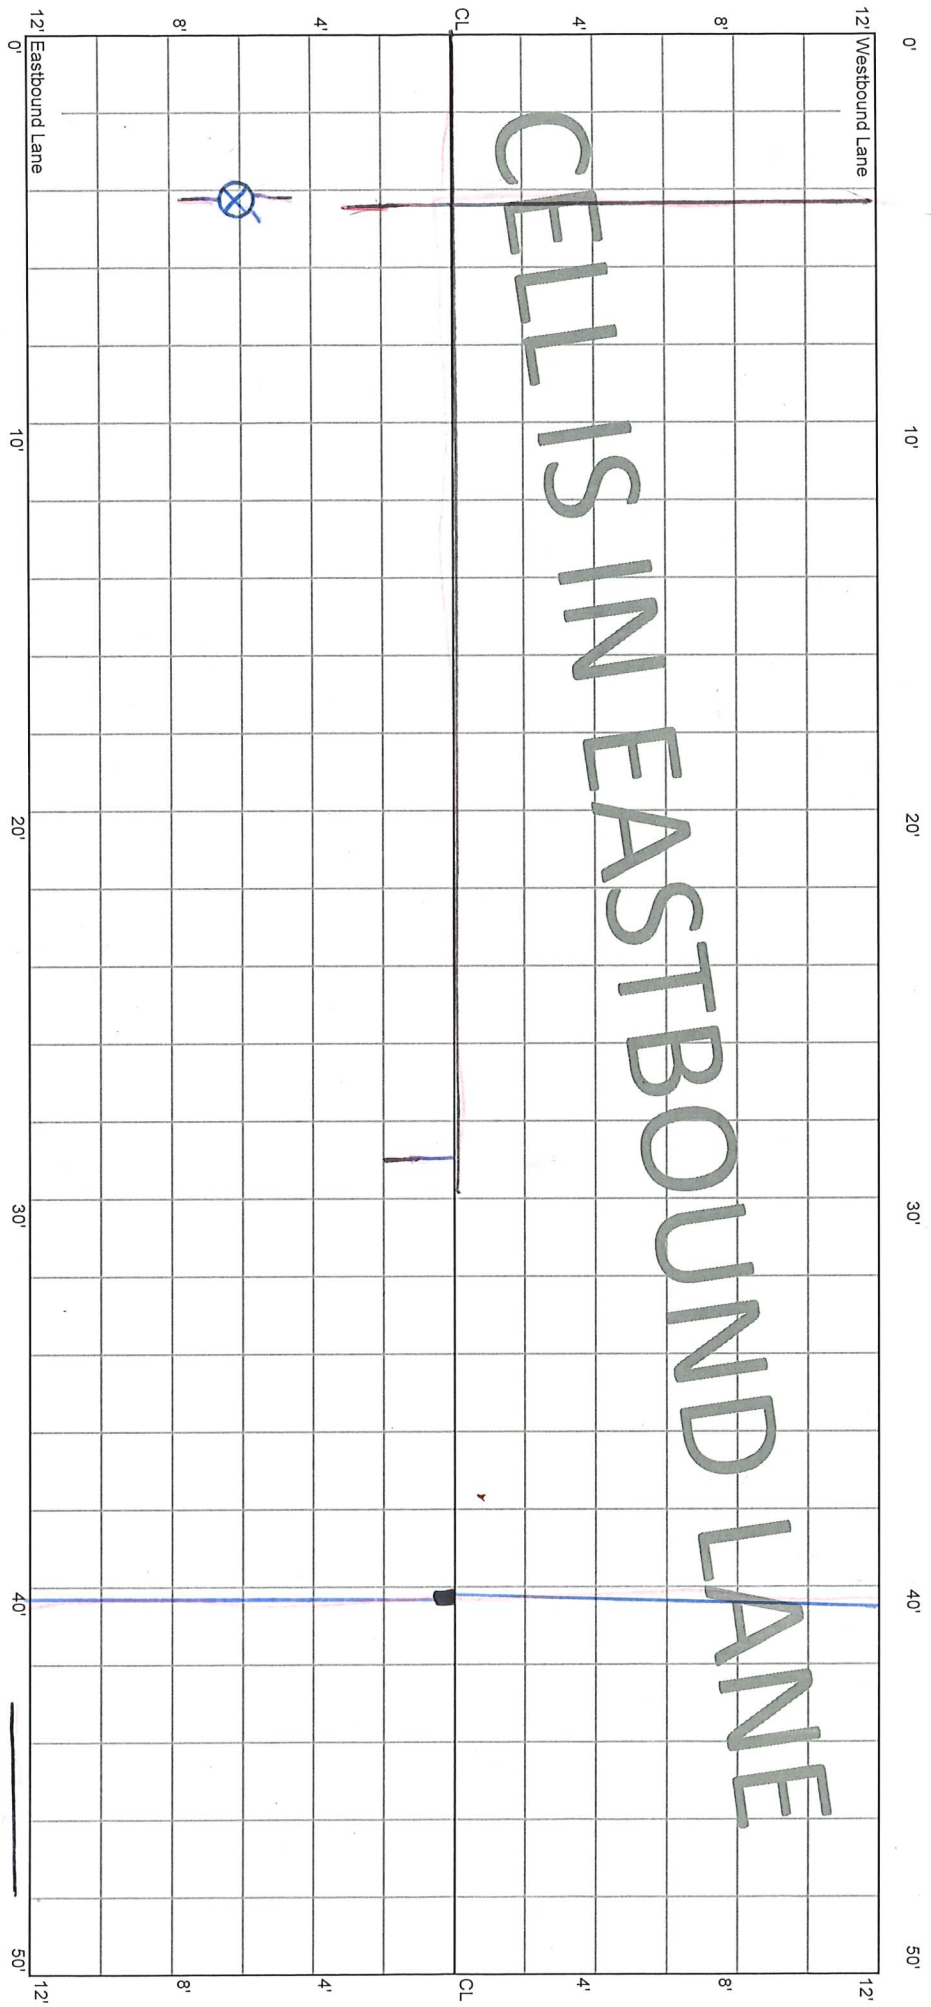

CELLS IN EASTBOUND LANE

Wright Co
Survey Marker


M

CELL 7005E
500 - 550 ft

27+00

16+25

27+50

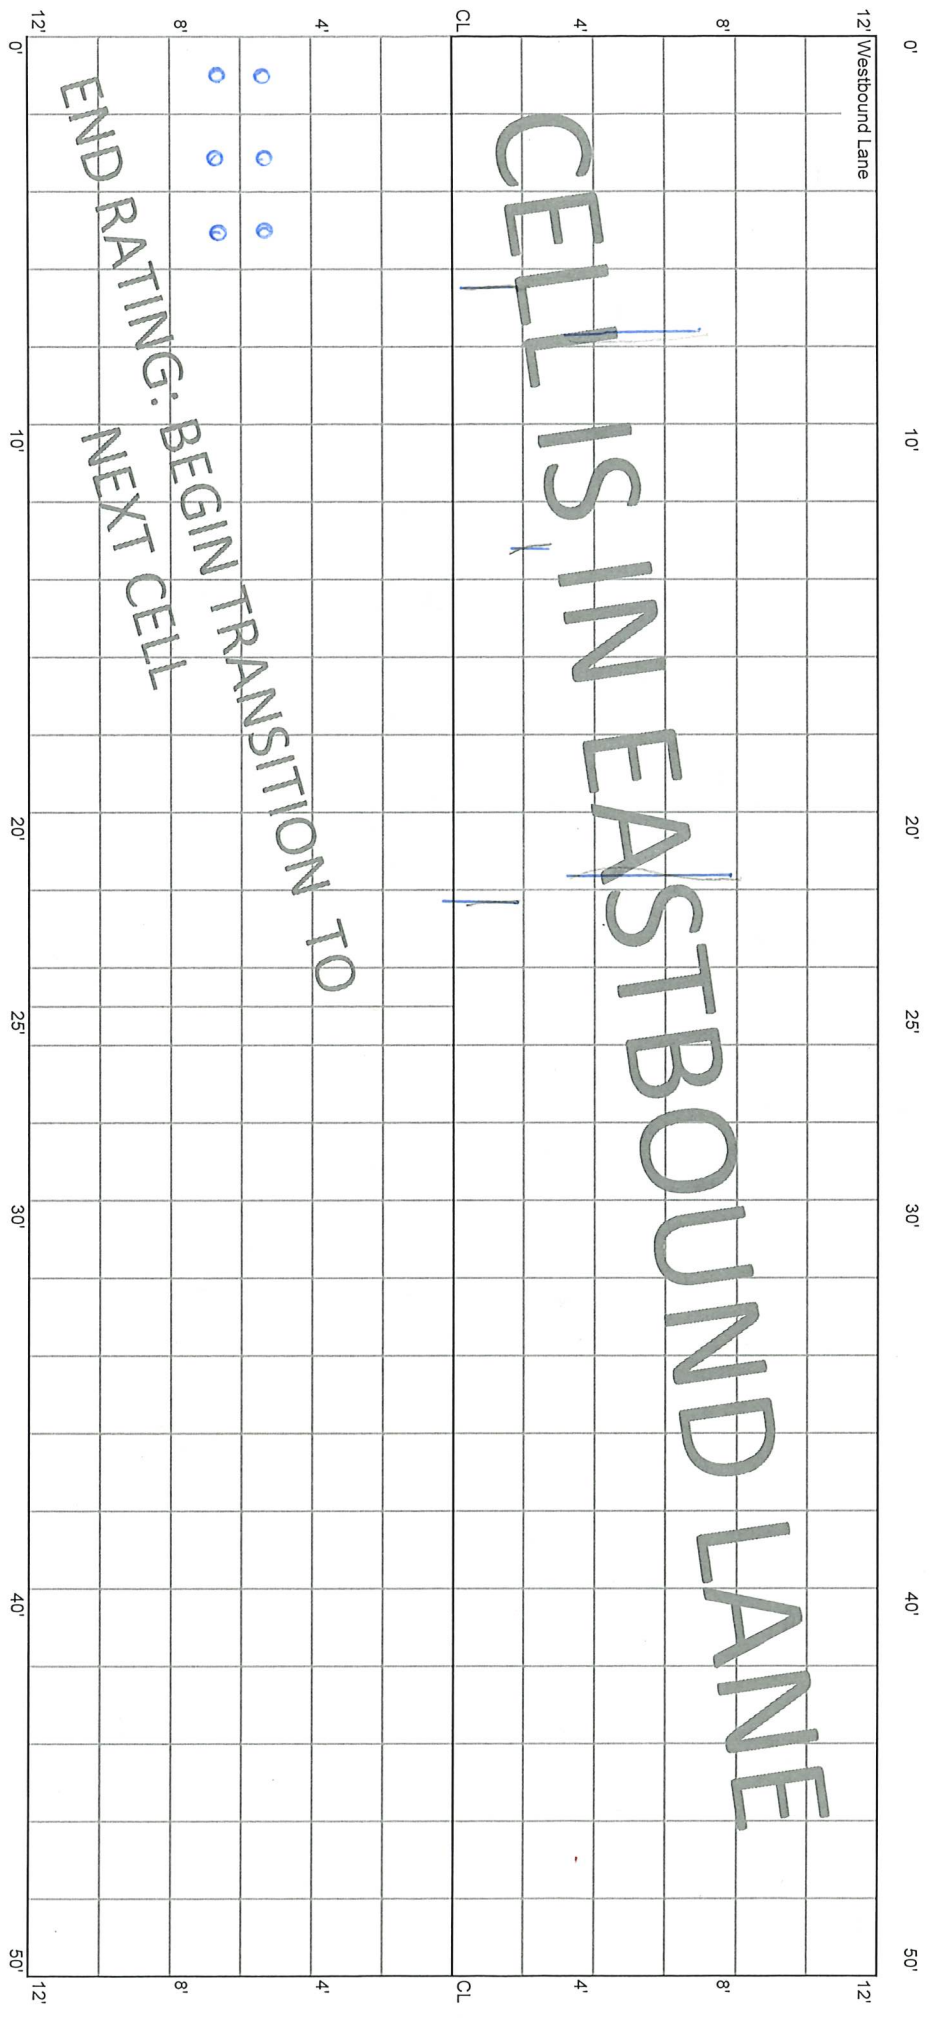

(0.001 to 10)
cores