


5.28.20 - E.J.  
 10.14.20 1.11.22  
 1.4.21 8.31.22  
 2.2.23  
 File 70TH ST  
 8.25.21 8.11.23

CELL 7008E  
 0 - 50 ft

38+50

39+00

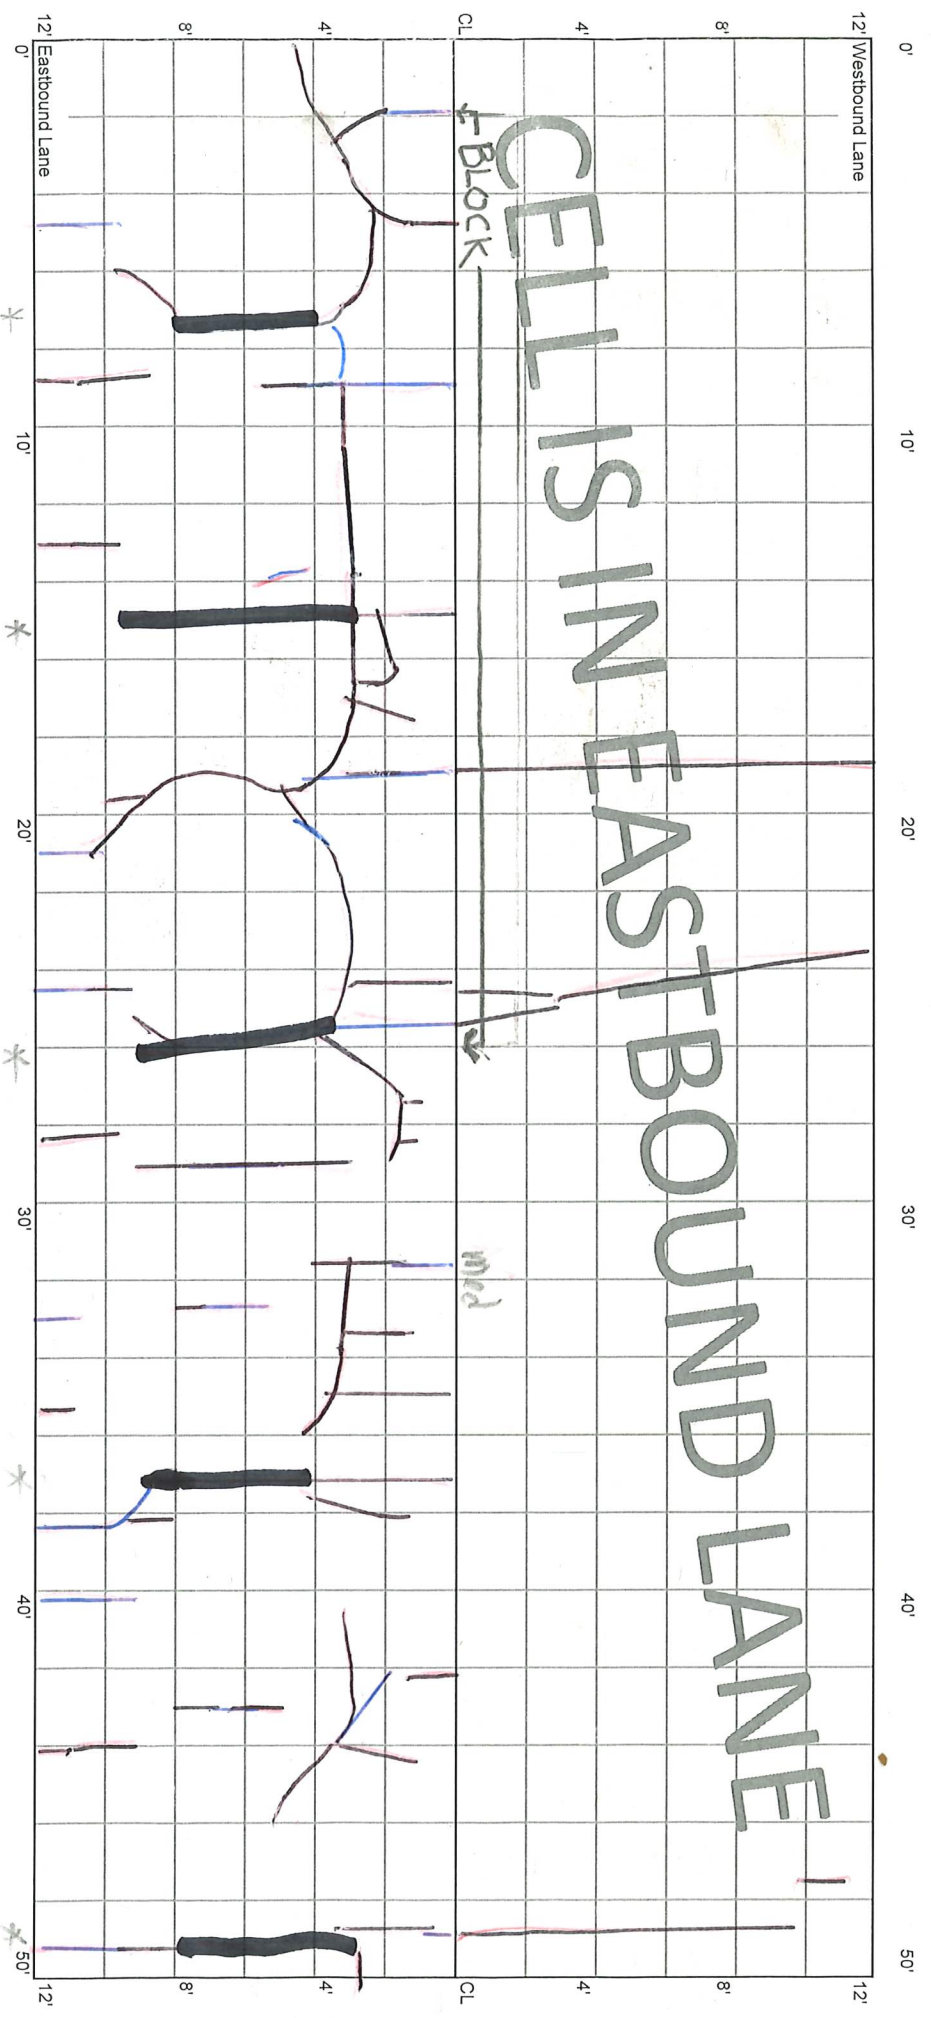

\* Rout & Seal

SP

AF  
 SP

SP

SP


SP

med

CELL 7008E  
50 - 100 ft

39+00

39+50

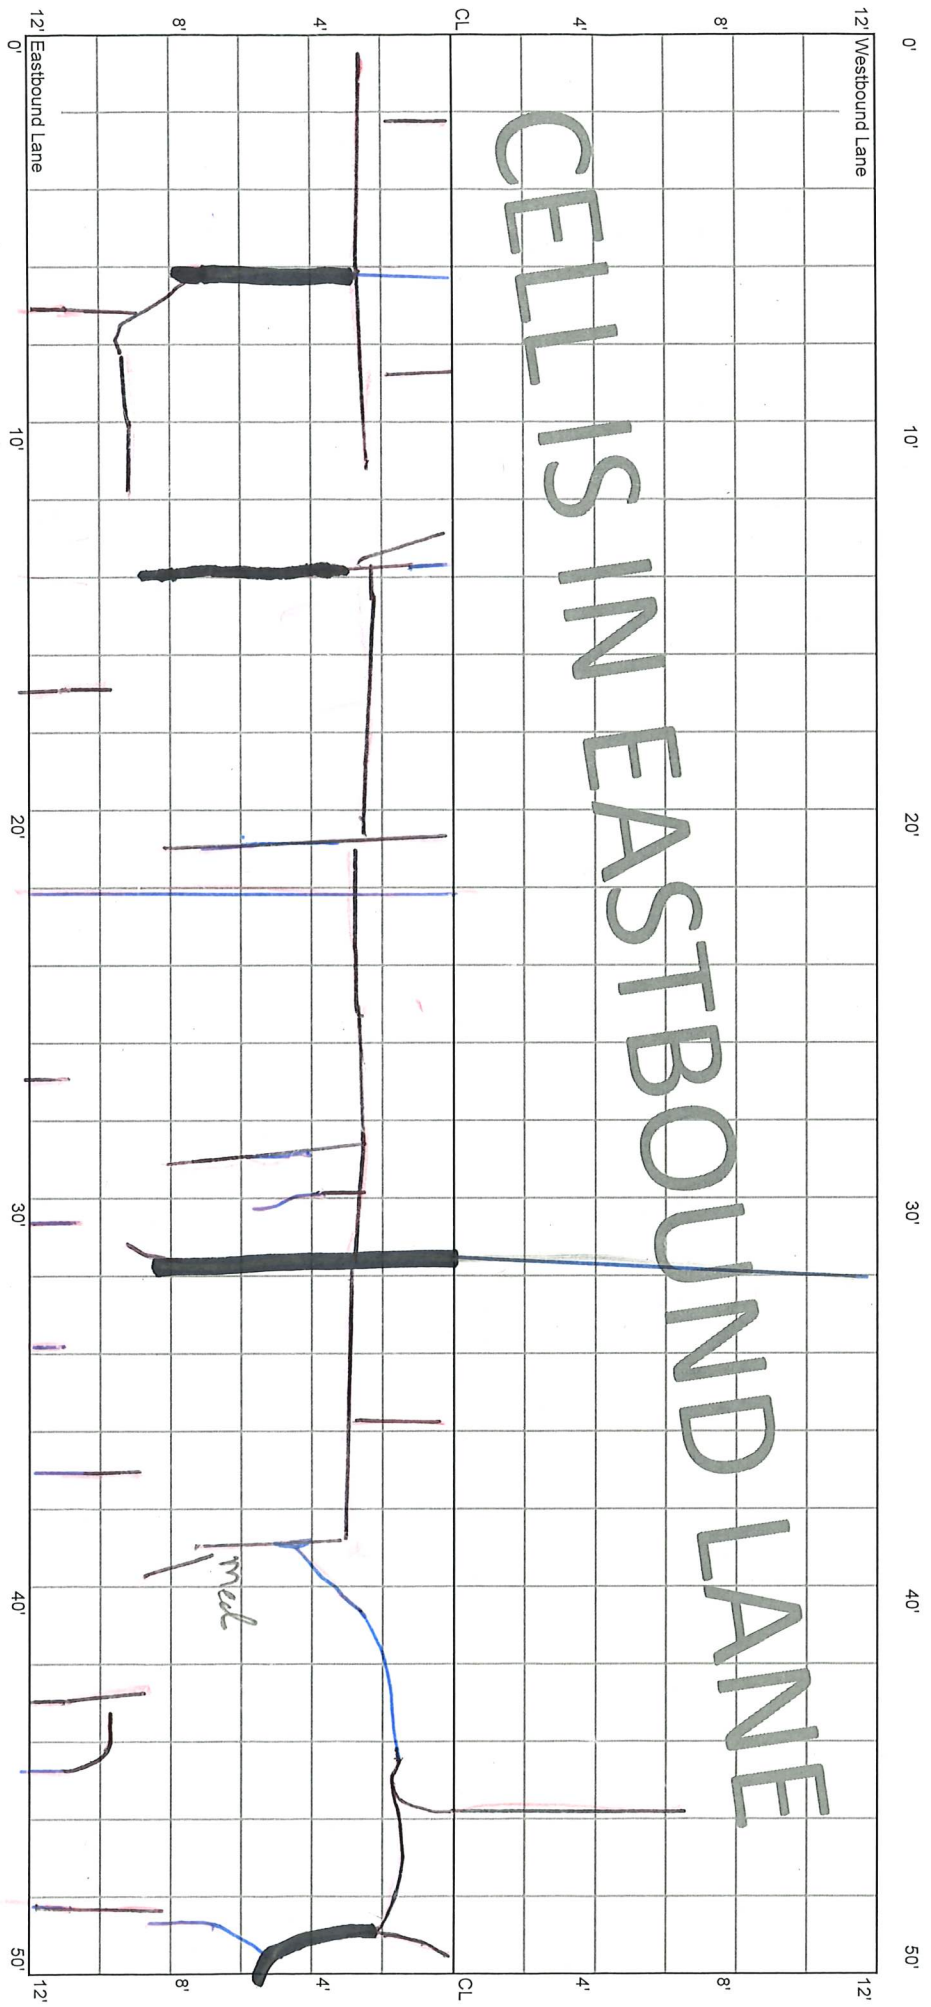

M  
SP

SP

SP


med

CELL 7008E  
100 - 150 ft

39+50

40+00

# CELLS IN EASTBOUND LANE

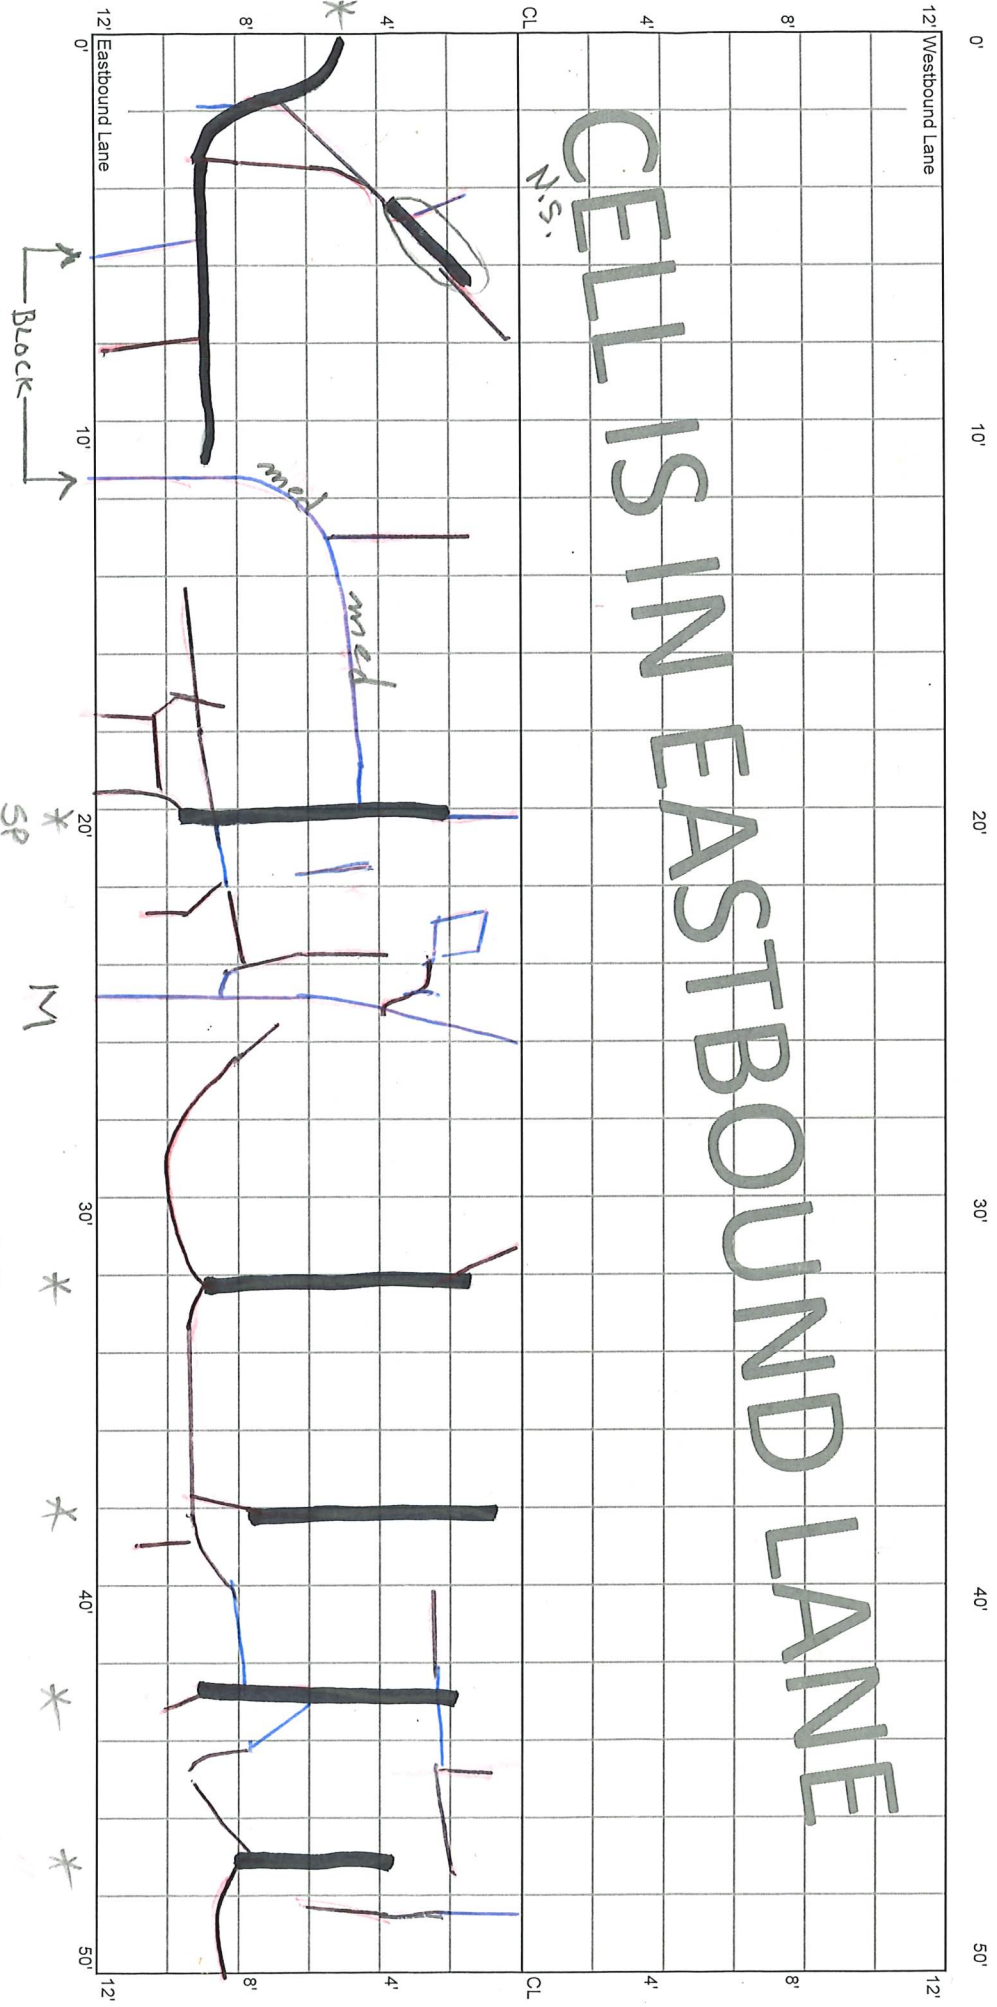


CELL 7008E  
150 - 200 ft

40+00

40+50

CELLS IN EASTBOUND LANE

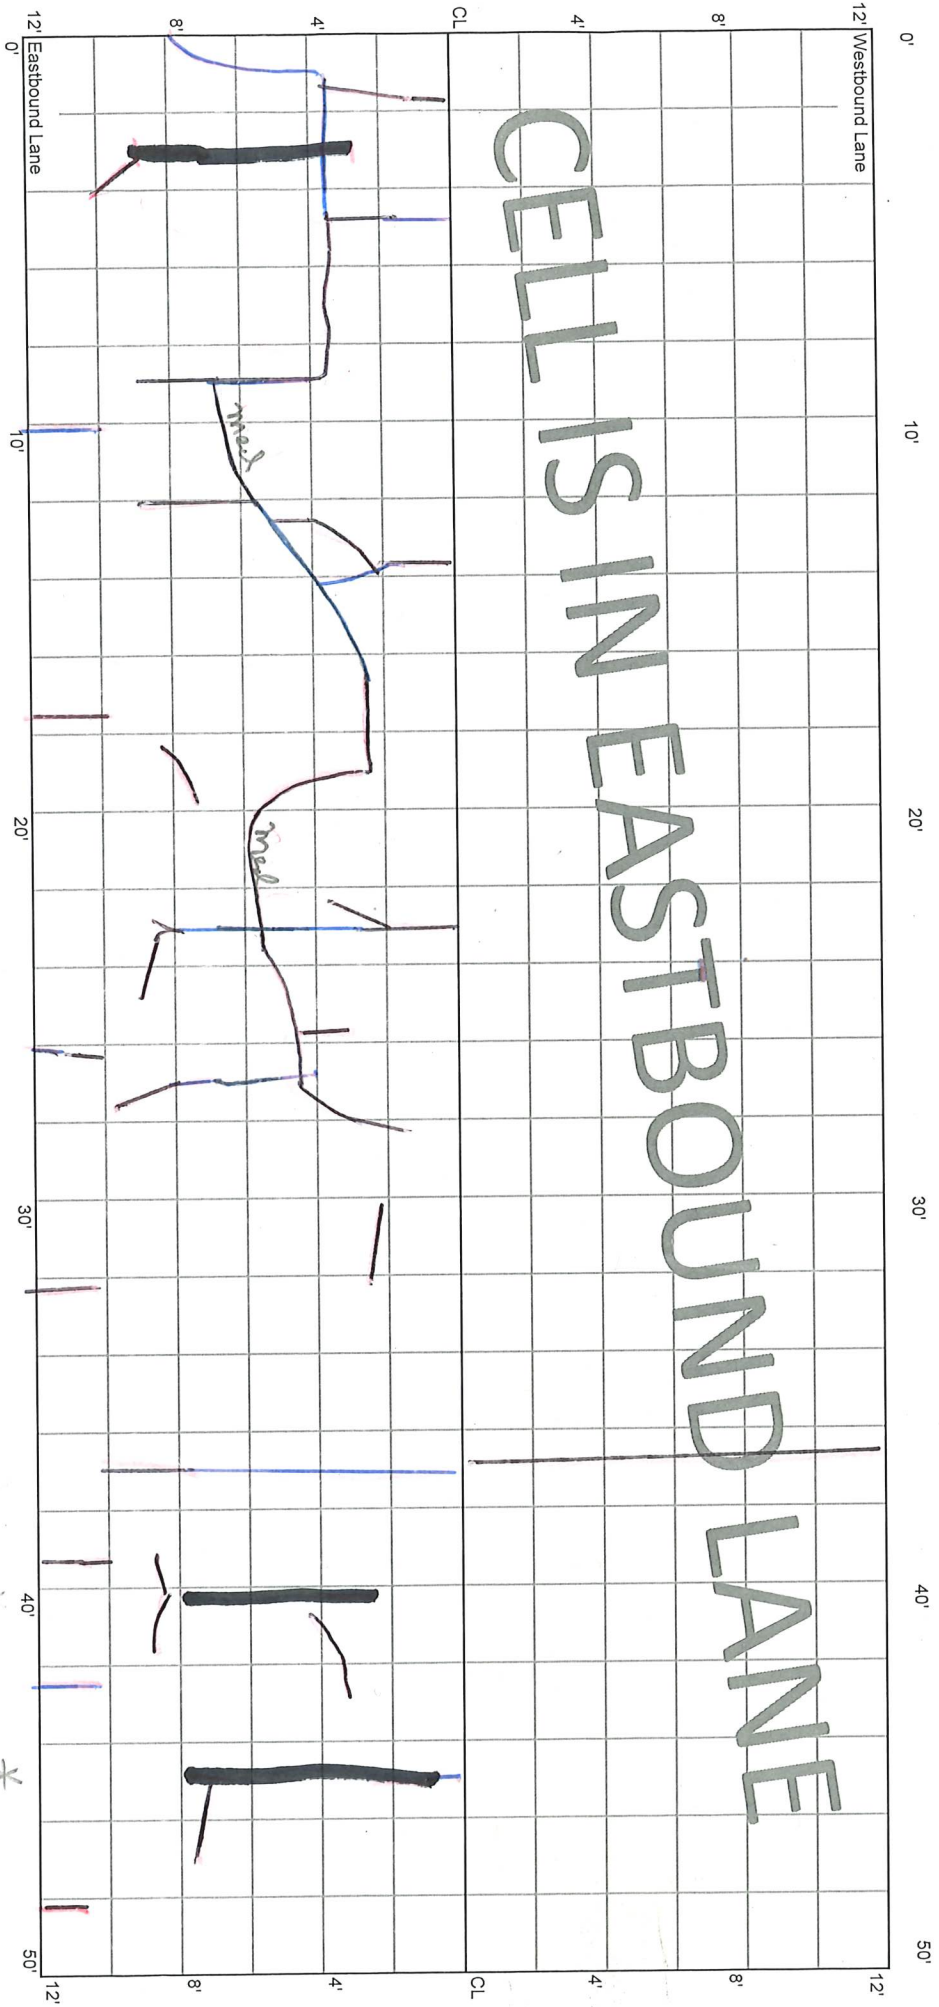

\*  
6' Sec 1

M


182

CELL 7008E  
200 - 250 ft

40+50

41+00

CELLS IN EASTBOUND LANE

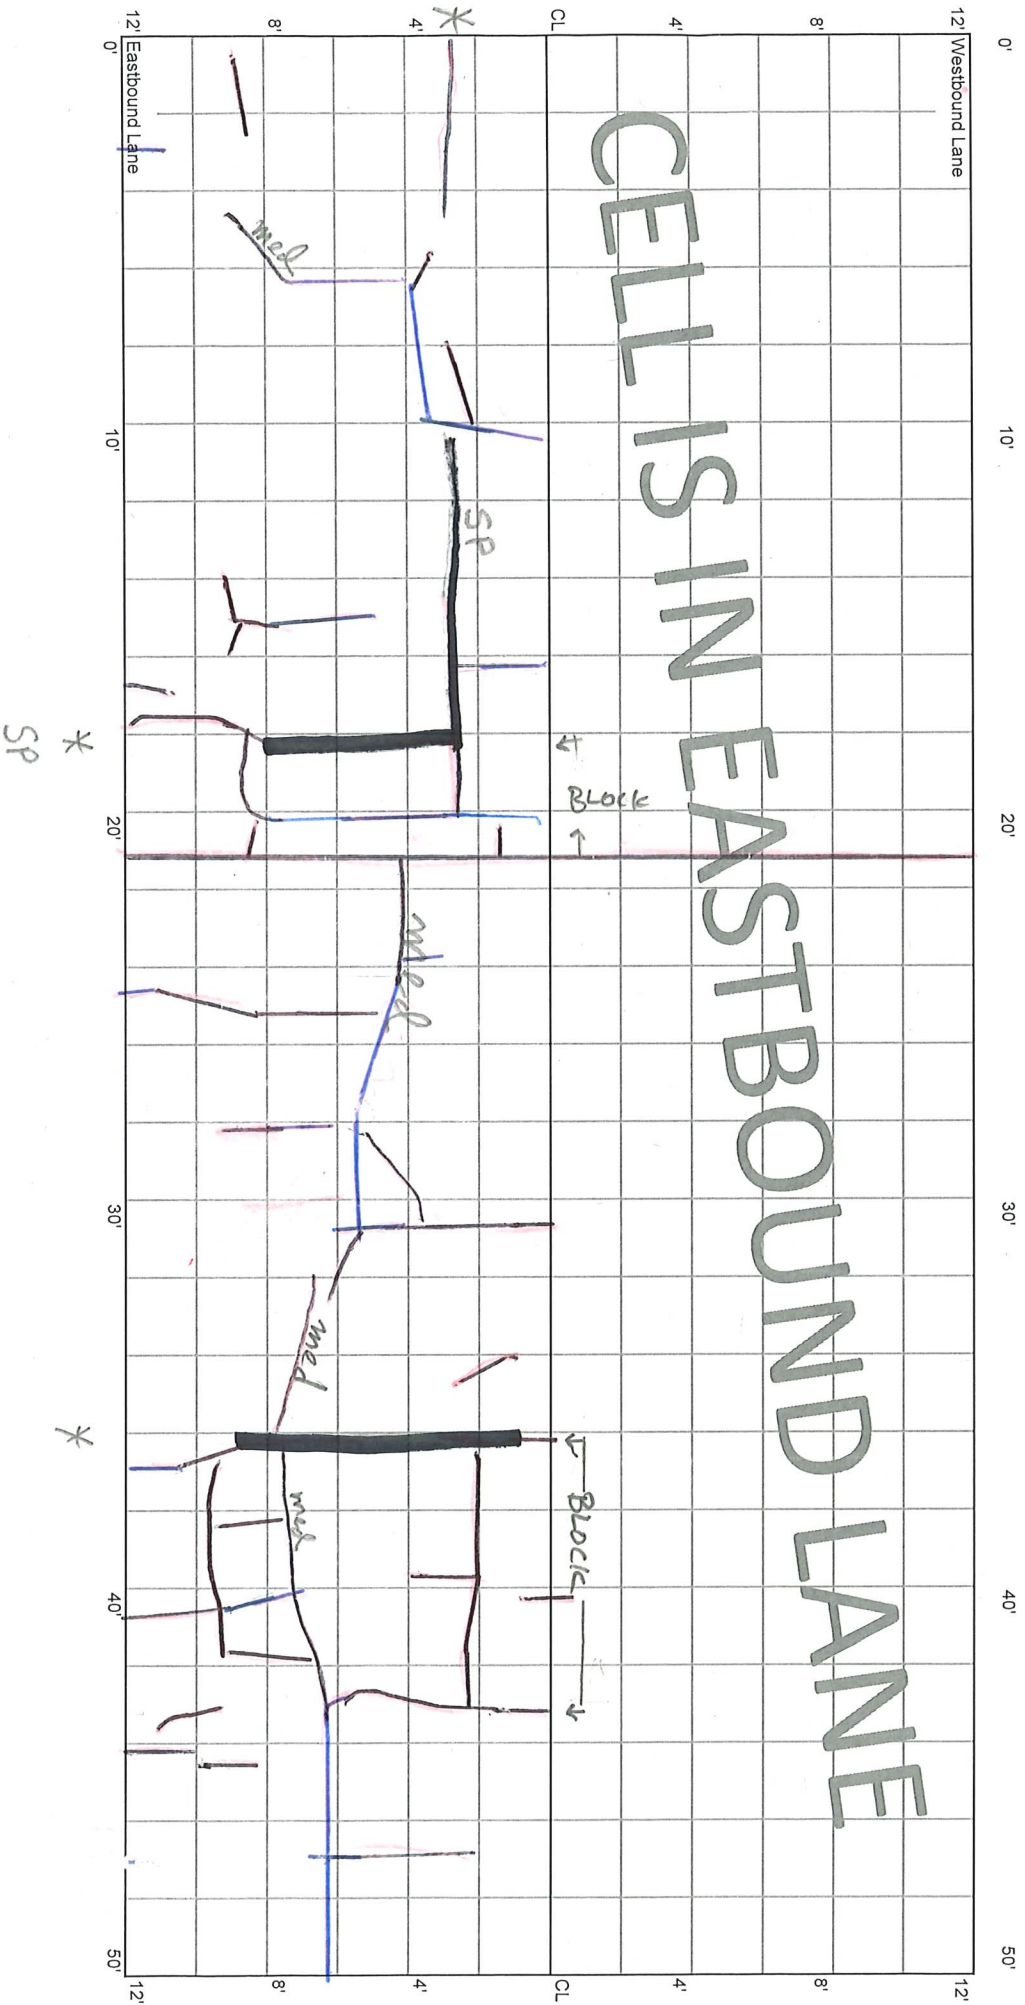

41+00

Mailbox  
at  
264' EB lane  
\*


CELL 7008E  
250 - 300 ft

41+50

0' 10' 20' 30' 40' 50'

12' Westbound Lane

CELL IS IN EASTBOUND LANE

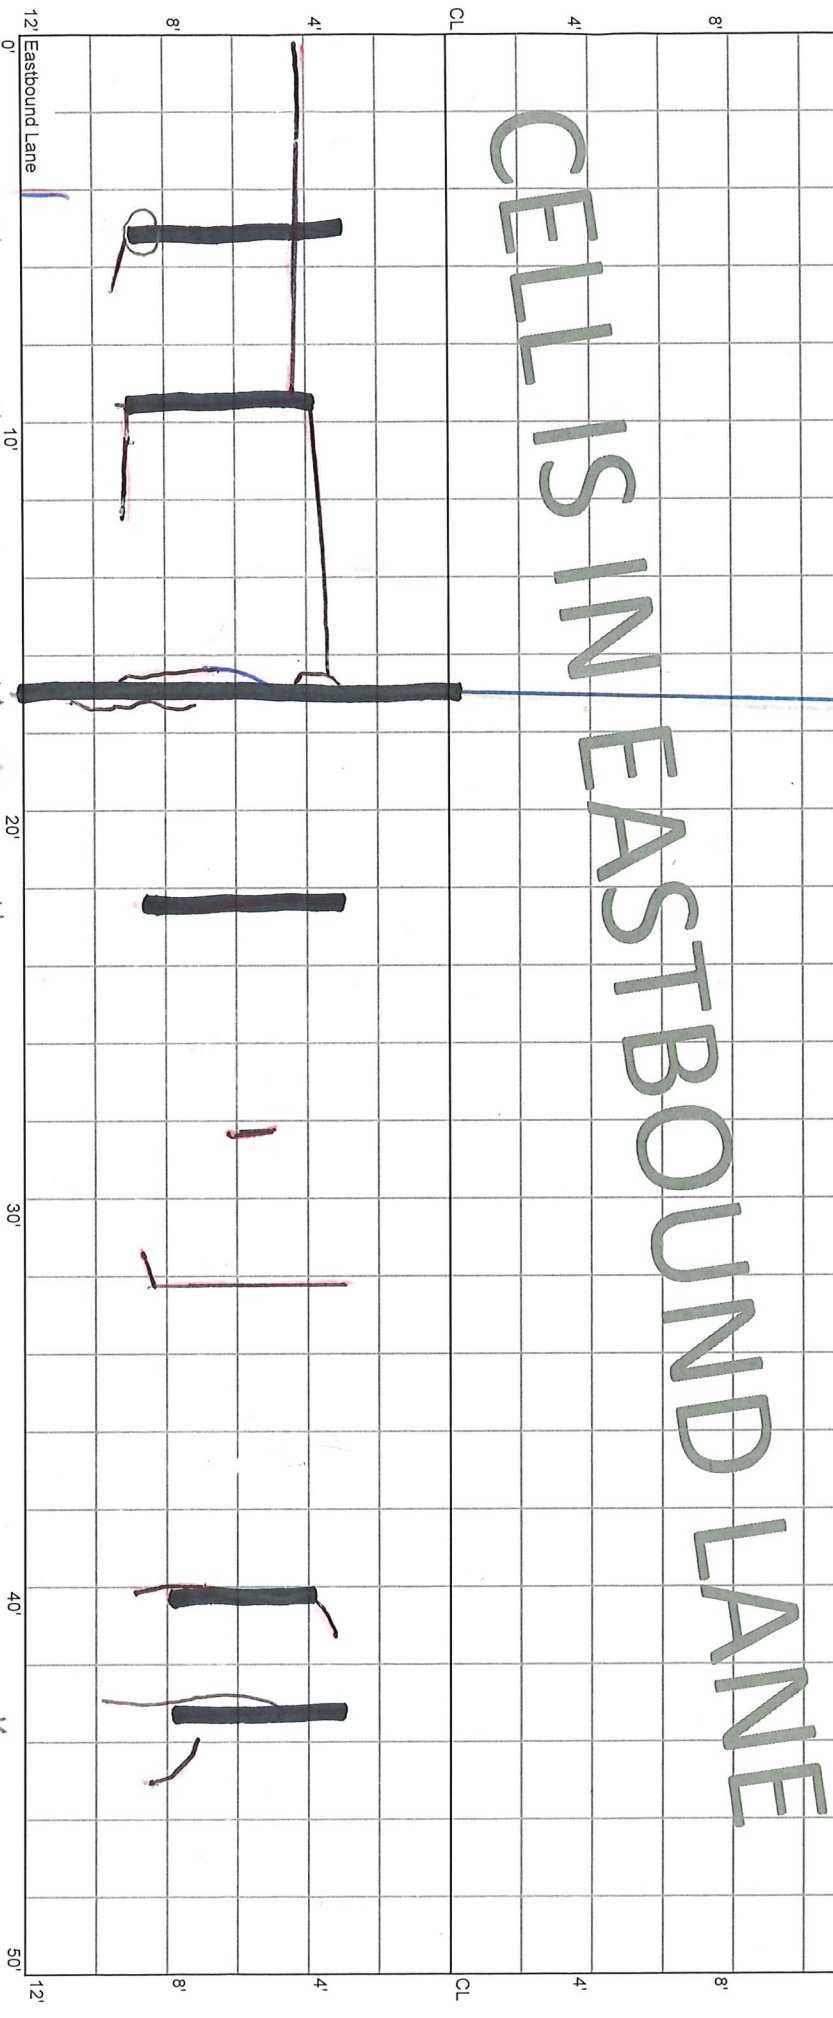

12' Eastbound Lane

\* SP AF 6"  
 \* \*  
 \* M 264'  
 \* AFSP  
 \* SP  
 \* \*  
 \* SP @ 264'  
 \* SP

CELL 7008E  
300 - 350 ft


41+50

42+00

12' Westbound Lane

12' Eastbound Lane

CELLS IN EASTBOUND LANE

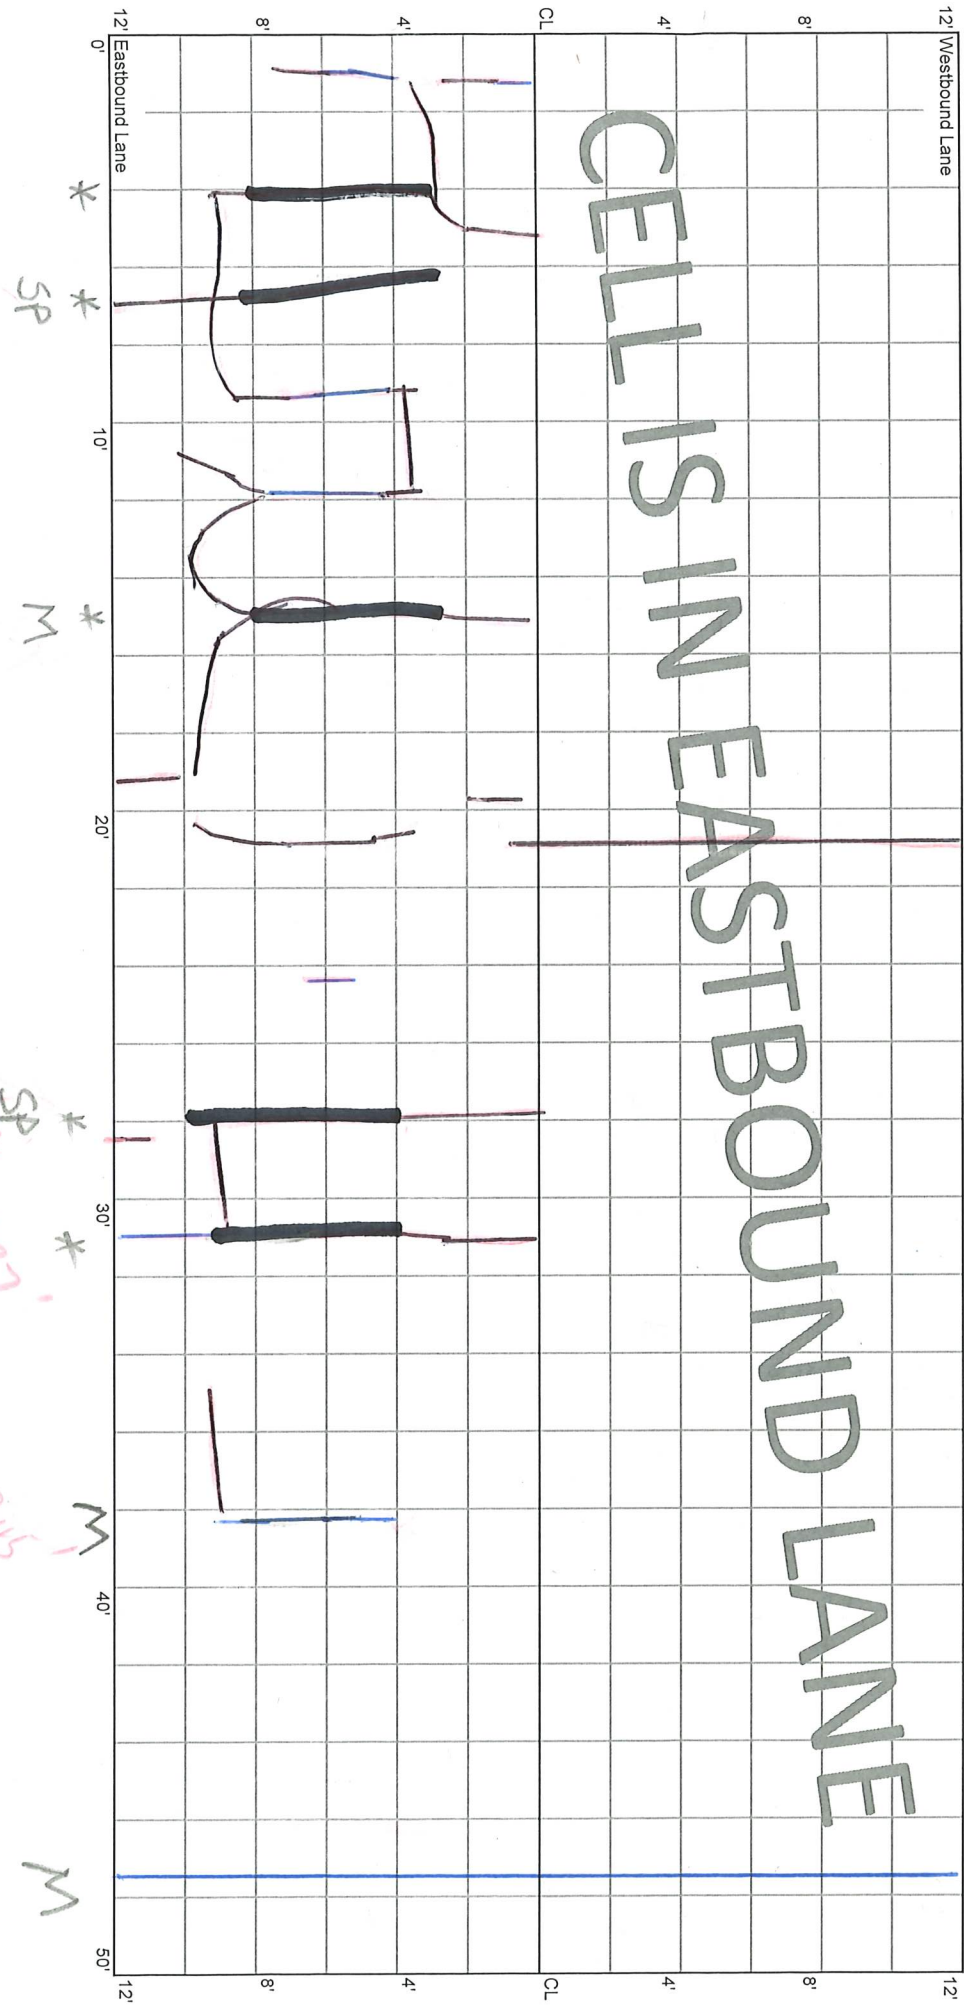


SP 327'  
M 327'  
M 335'  
M 345'

CELL 7008E  
350 - 400 ft

42+00

42+50

CELL IS IN EASTBOUND LANE

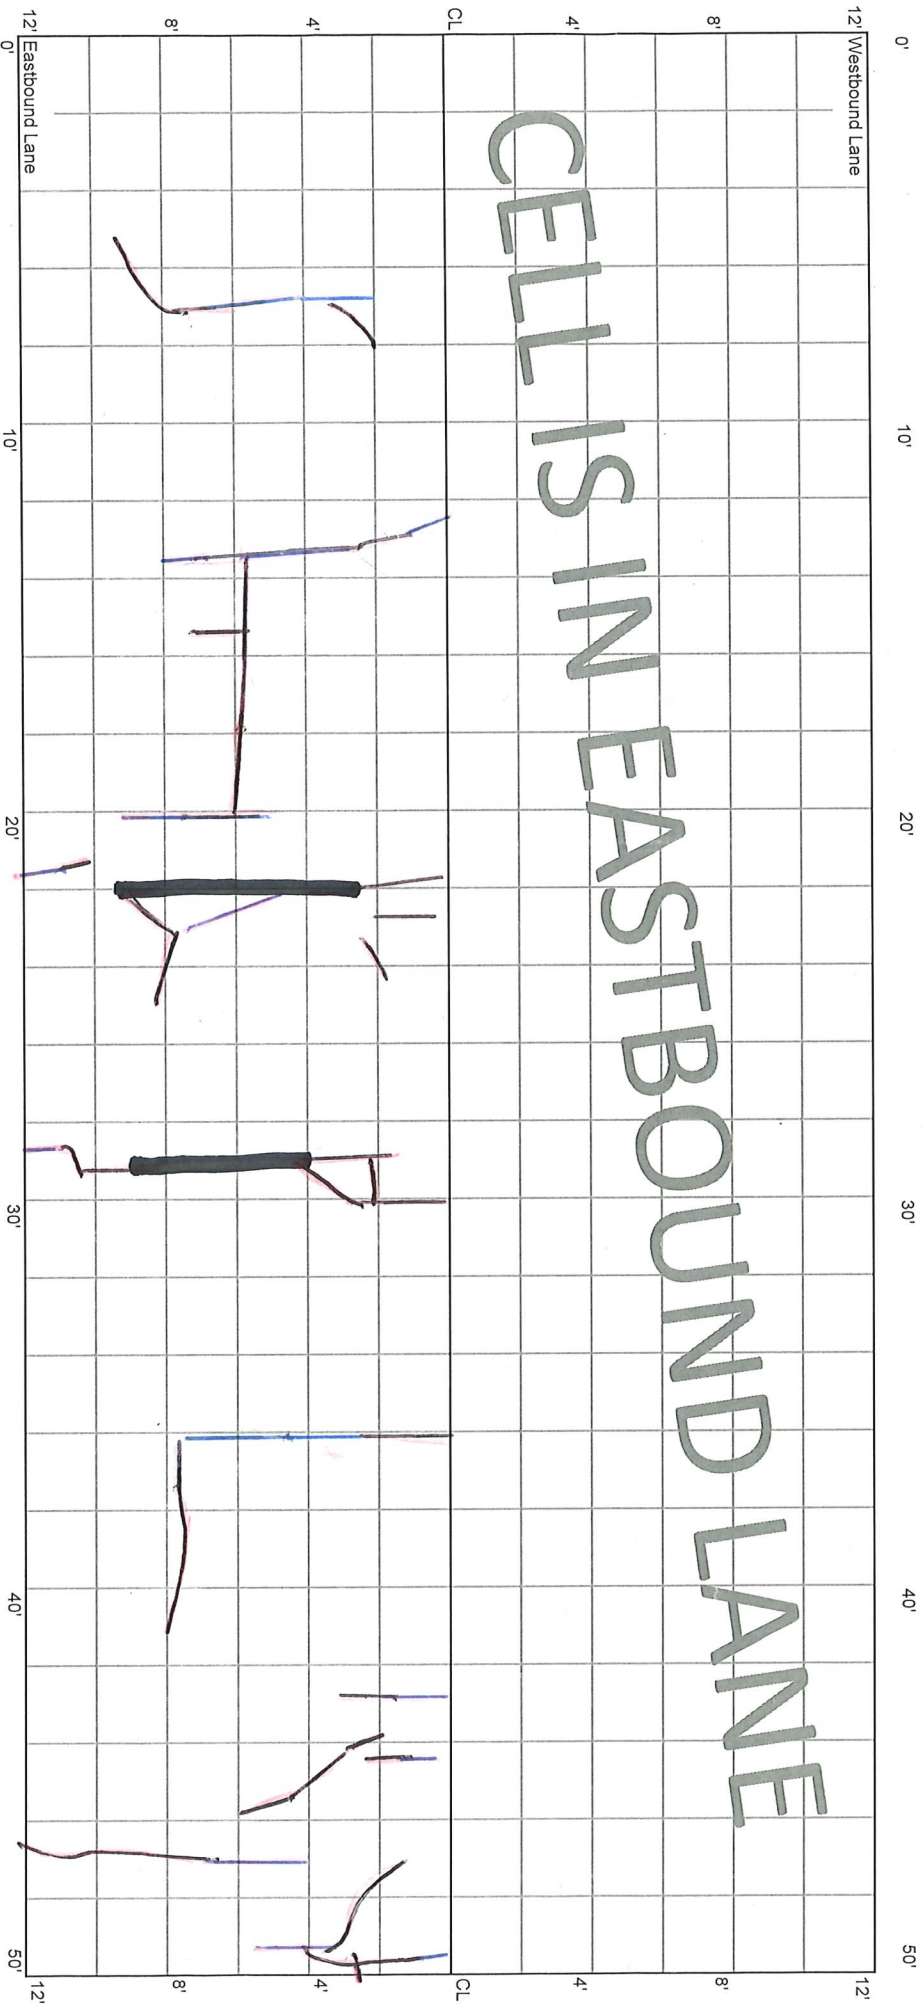

AF

\*


\*



CELL 7008E  
400 - 450 ft

42+50


43+00

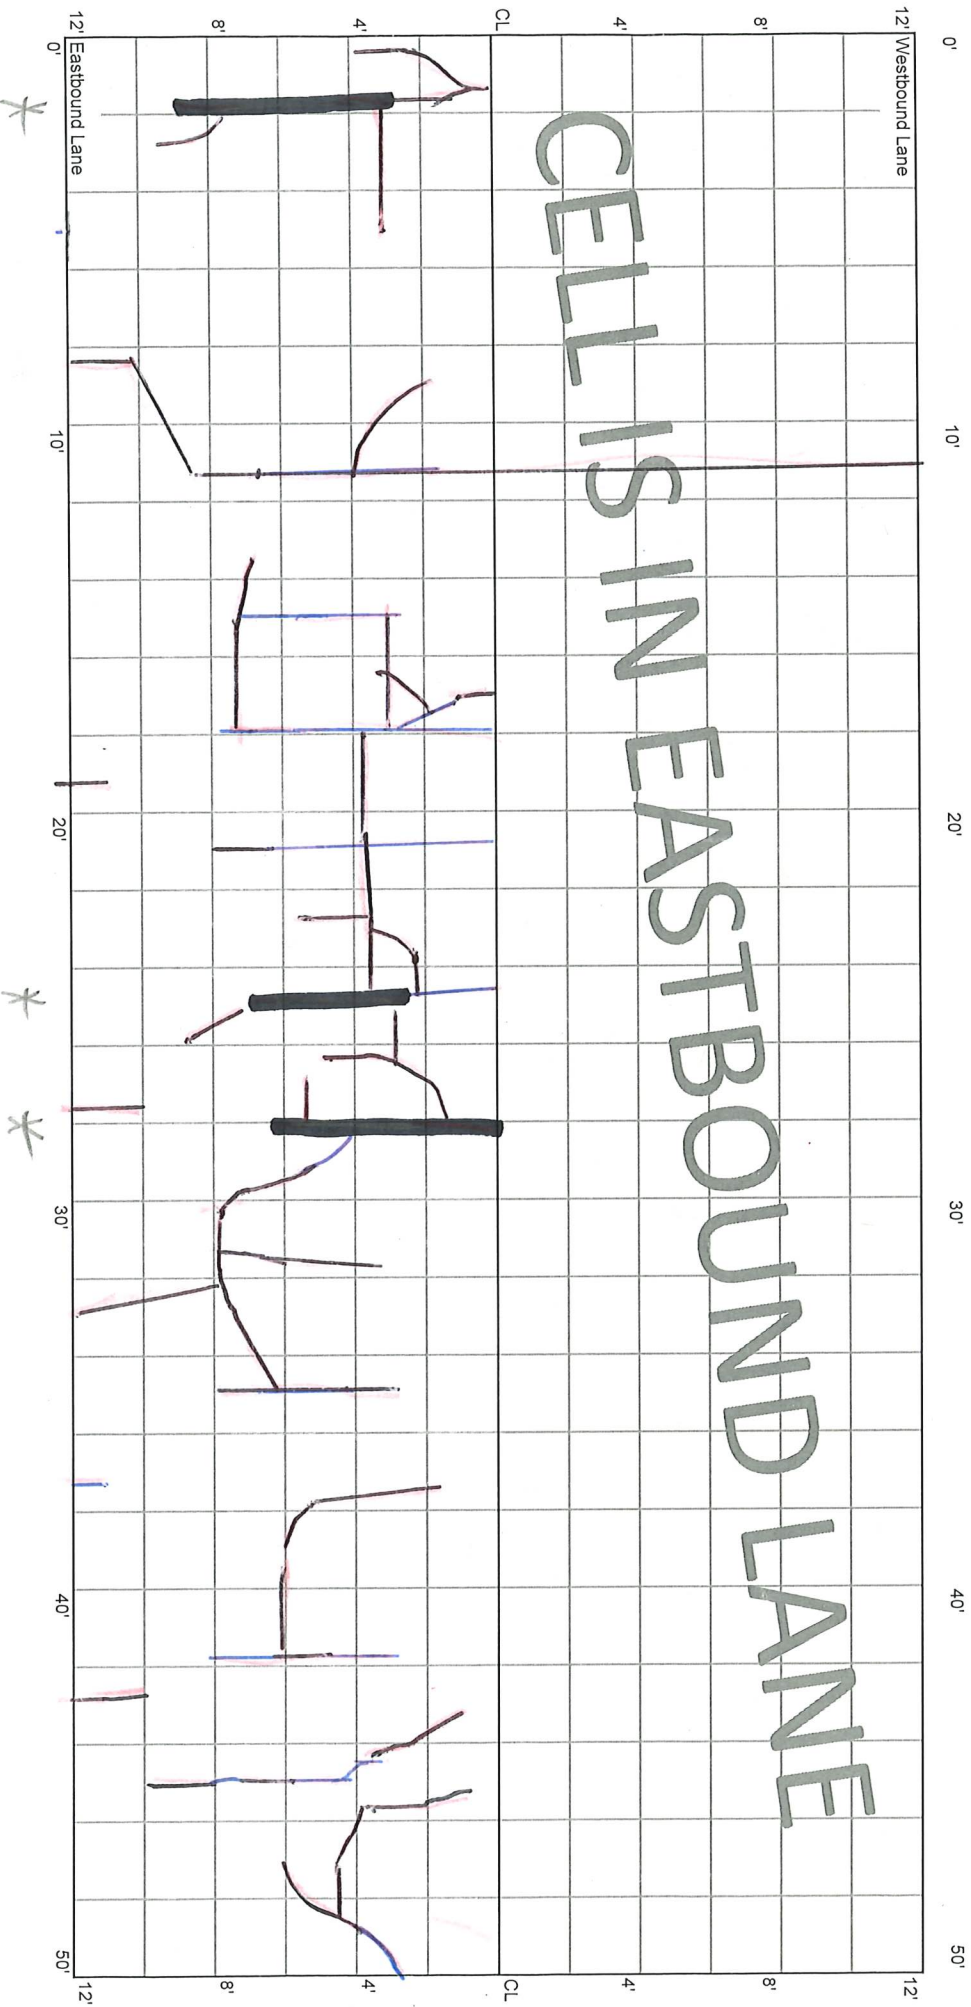

CELL 7008E  
450 - 500 ft

43+00

43+50

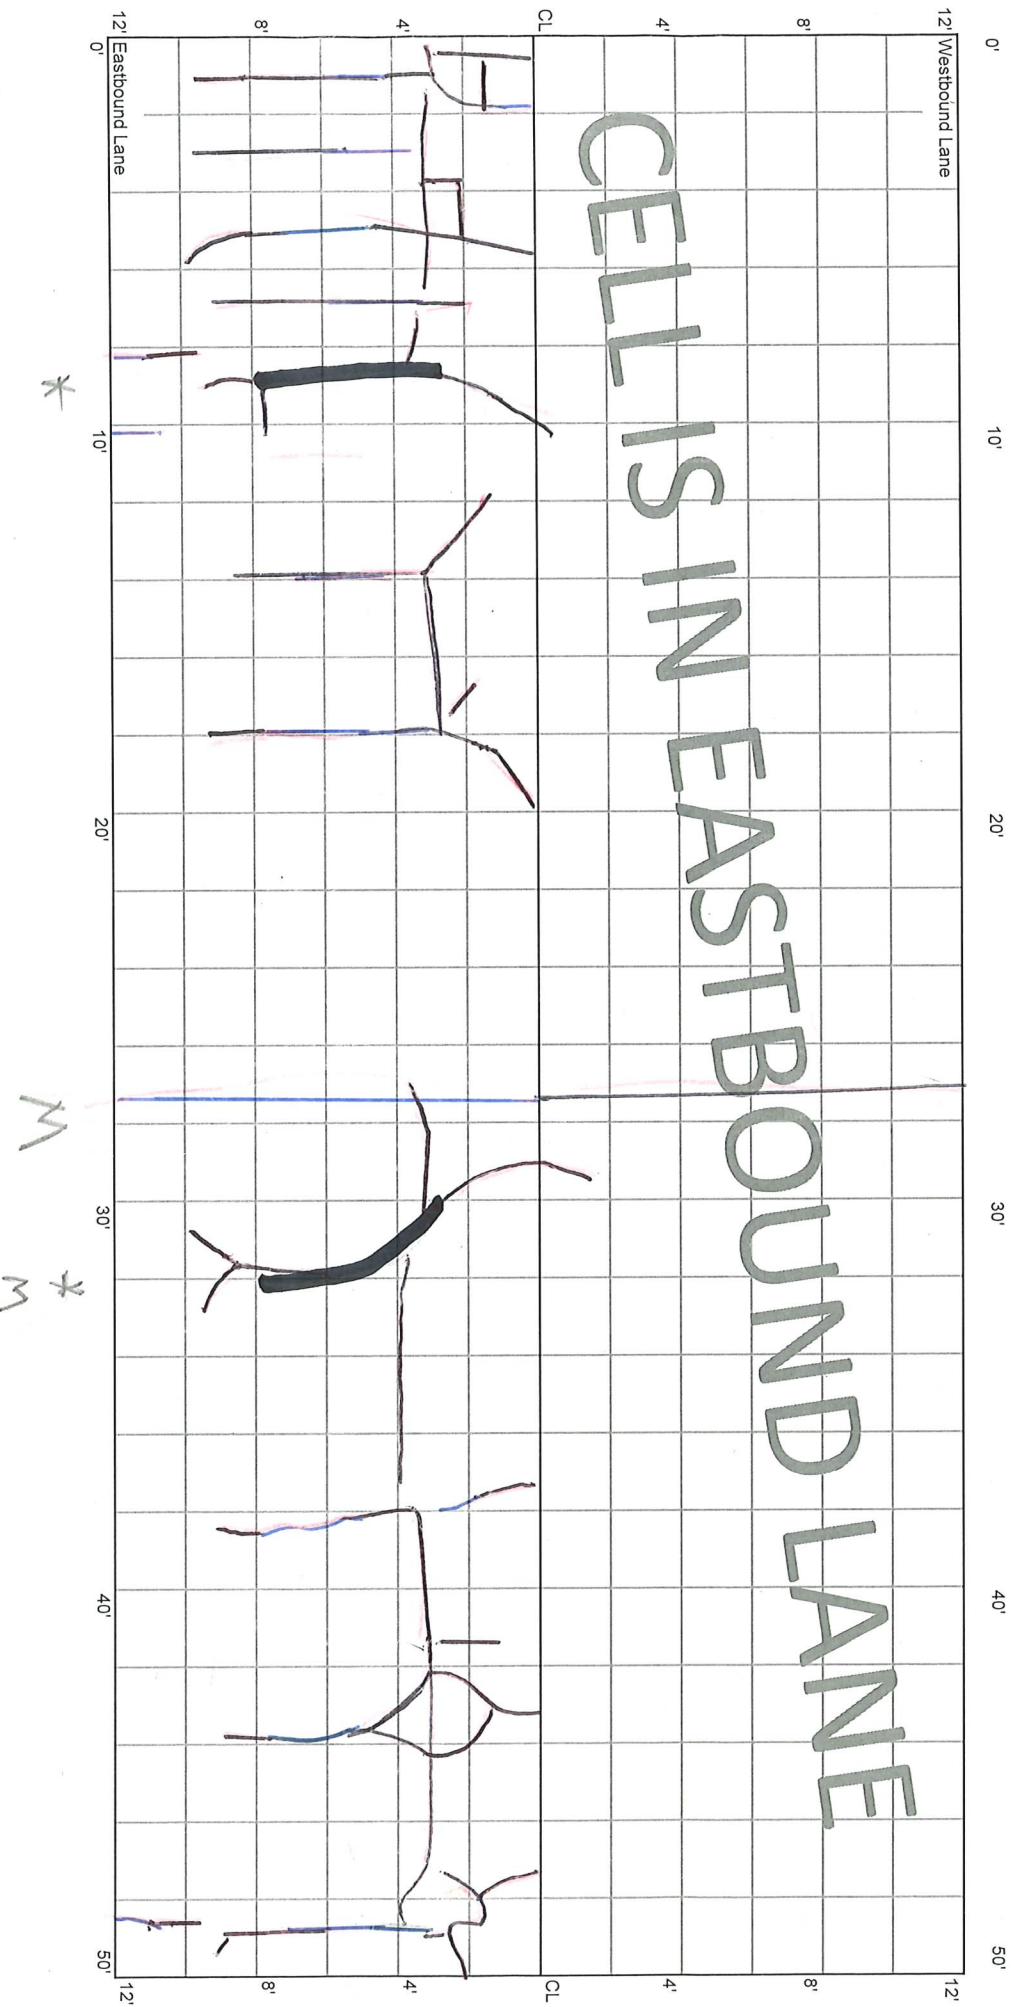

CELL 7008E  
500 - 842 ft

43+50

46+92

0'

342'

12' Westbound Lane

12'

8'

8'

4'

4'

CL

CL

12'

12'

10'

20'

36'

END RATING: TRANSITION TO COUNTY ROAD 19

CELL IS IN EASTBOUND LANE

END