

8.25.21 - 35 Trans. cracks outside  
Fog line.


5,28.20 E.J. - No Distress  
- 10.14.20 - No Distress  
1.4.21 - No Distress

Cell 7016 W  
CELL 7006W  
0 - 50 ft

File 70TH ST  
8.25.21 | 1.13.22  
          | 8.31.22  
          | 1.26.23  
          | 8.11.23

32+50


32+00

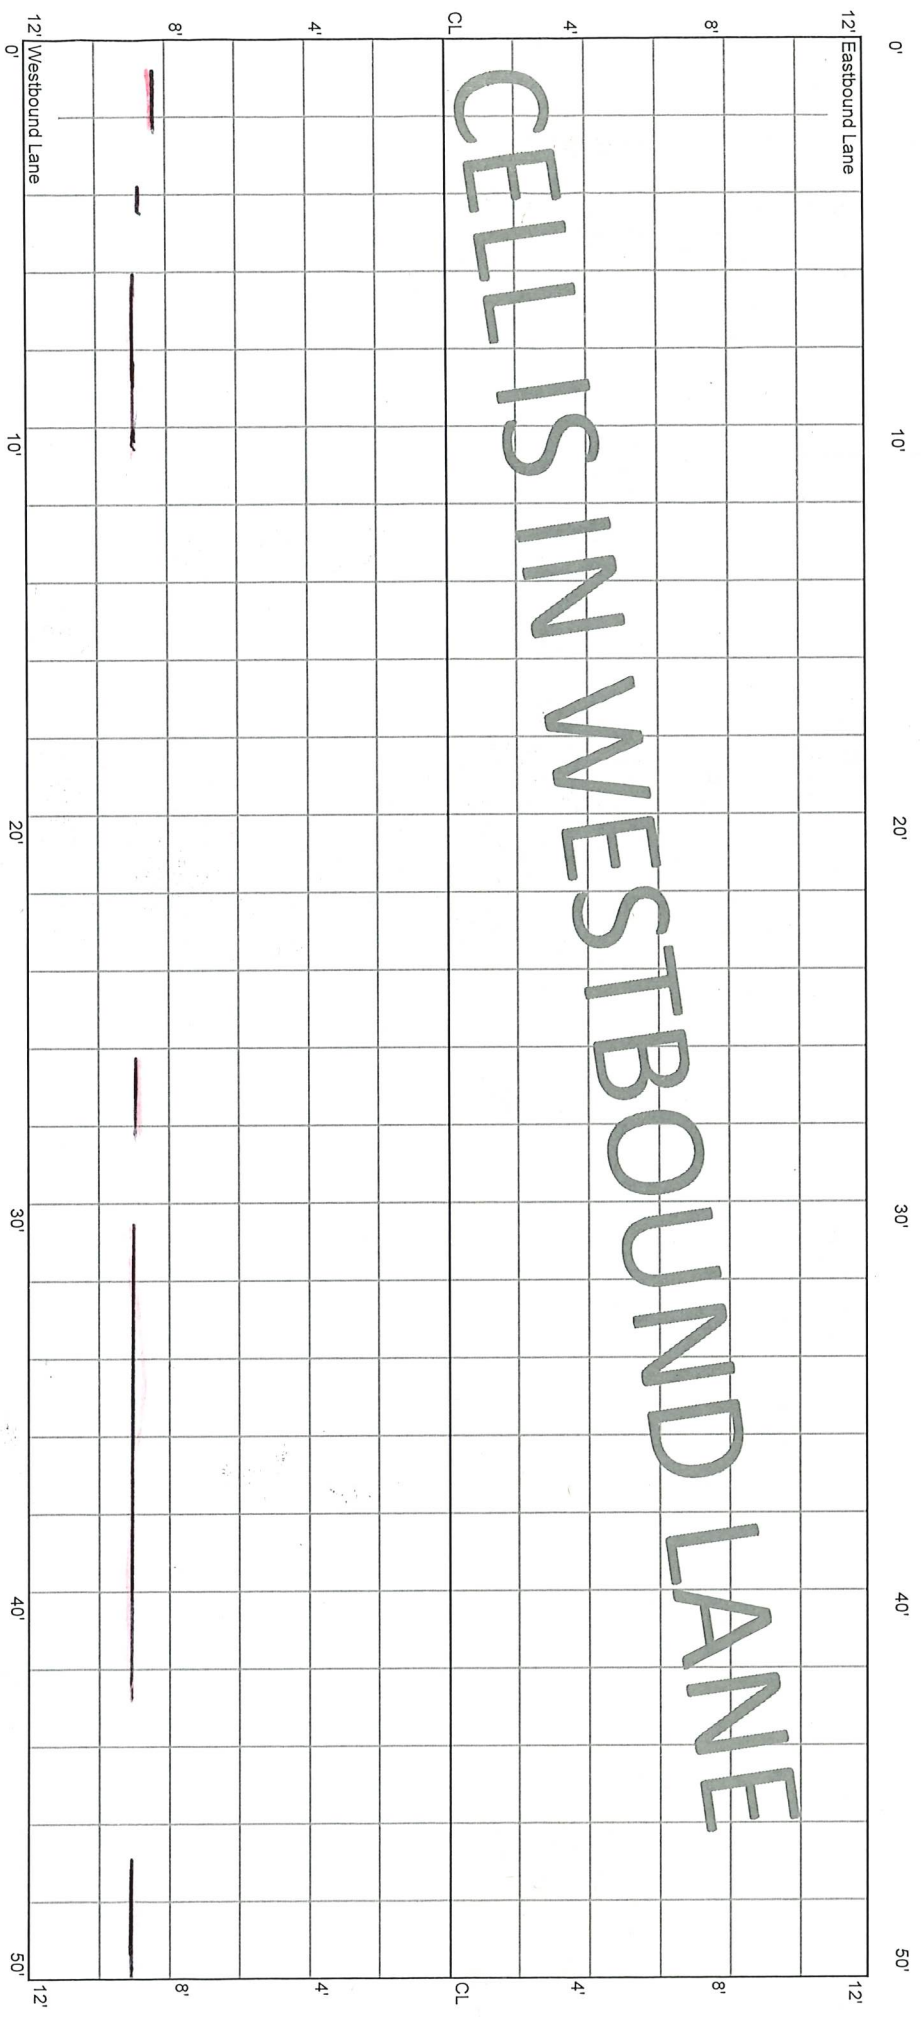

CELL 7006W  
50 - 100 ft

32+00

31+50

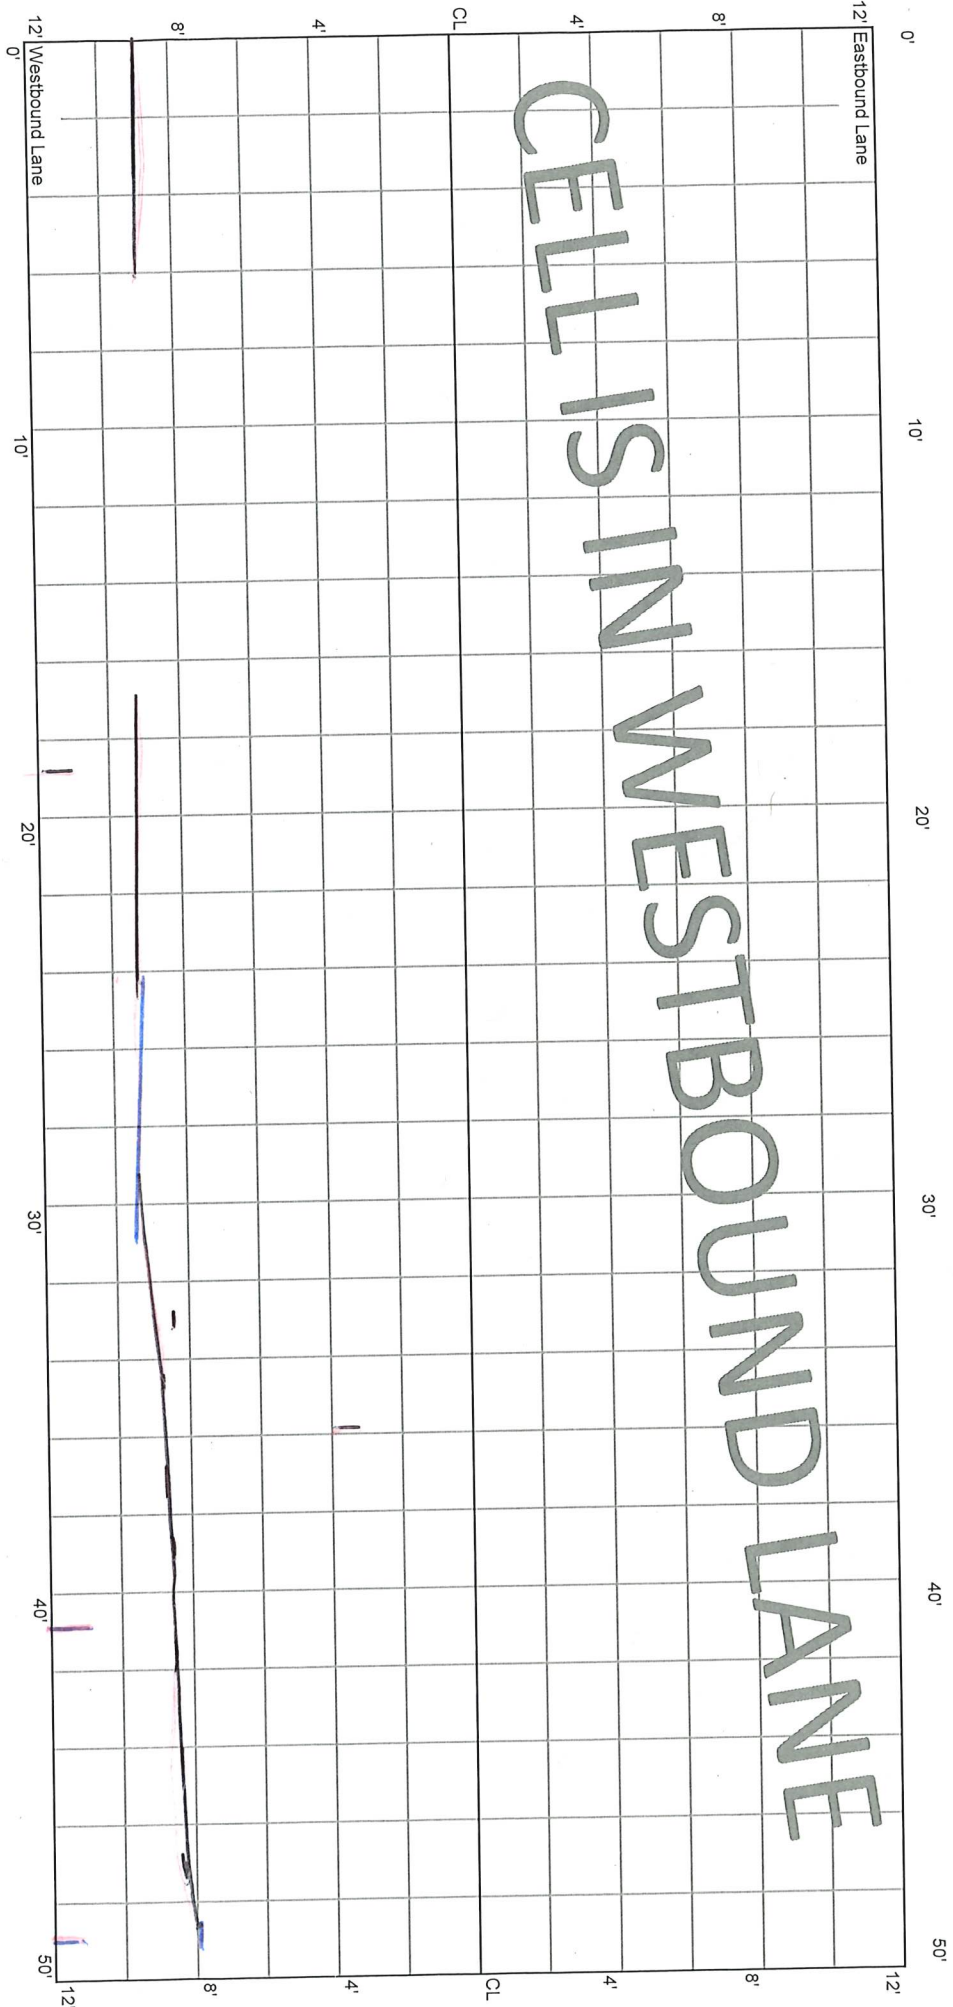


CELL IS IN WESTBOUND LANE

CELL 7006W  
100 - 150 ft

31+50


31+00

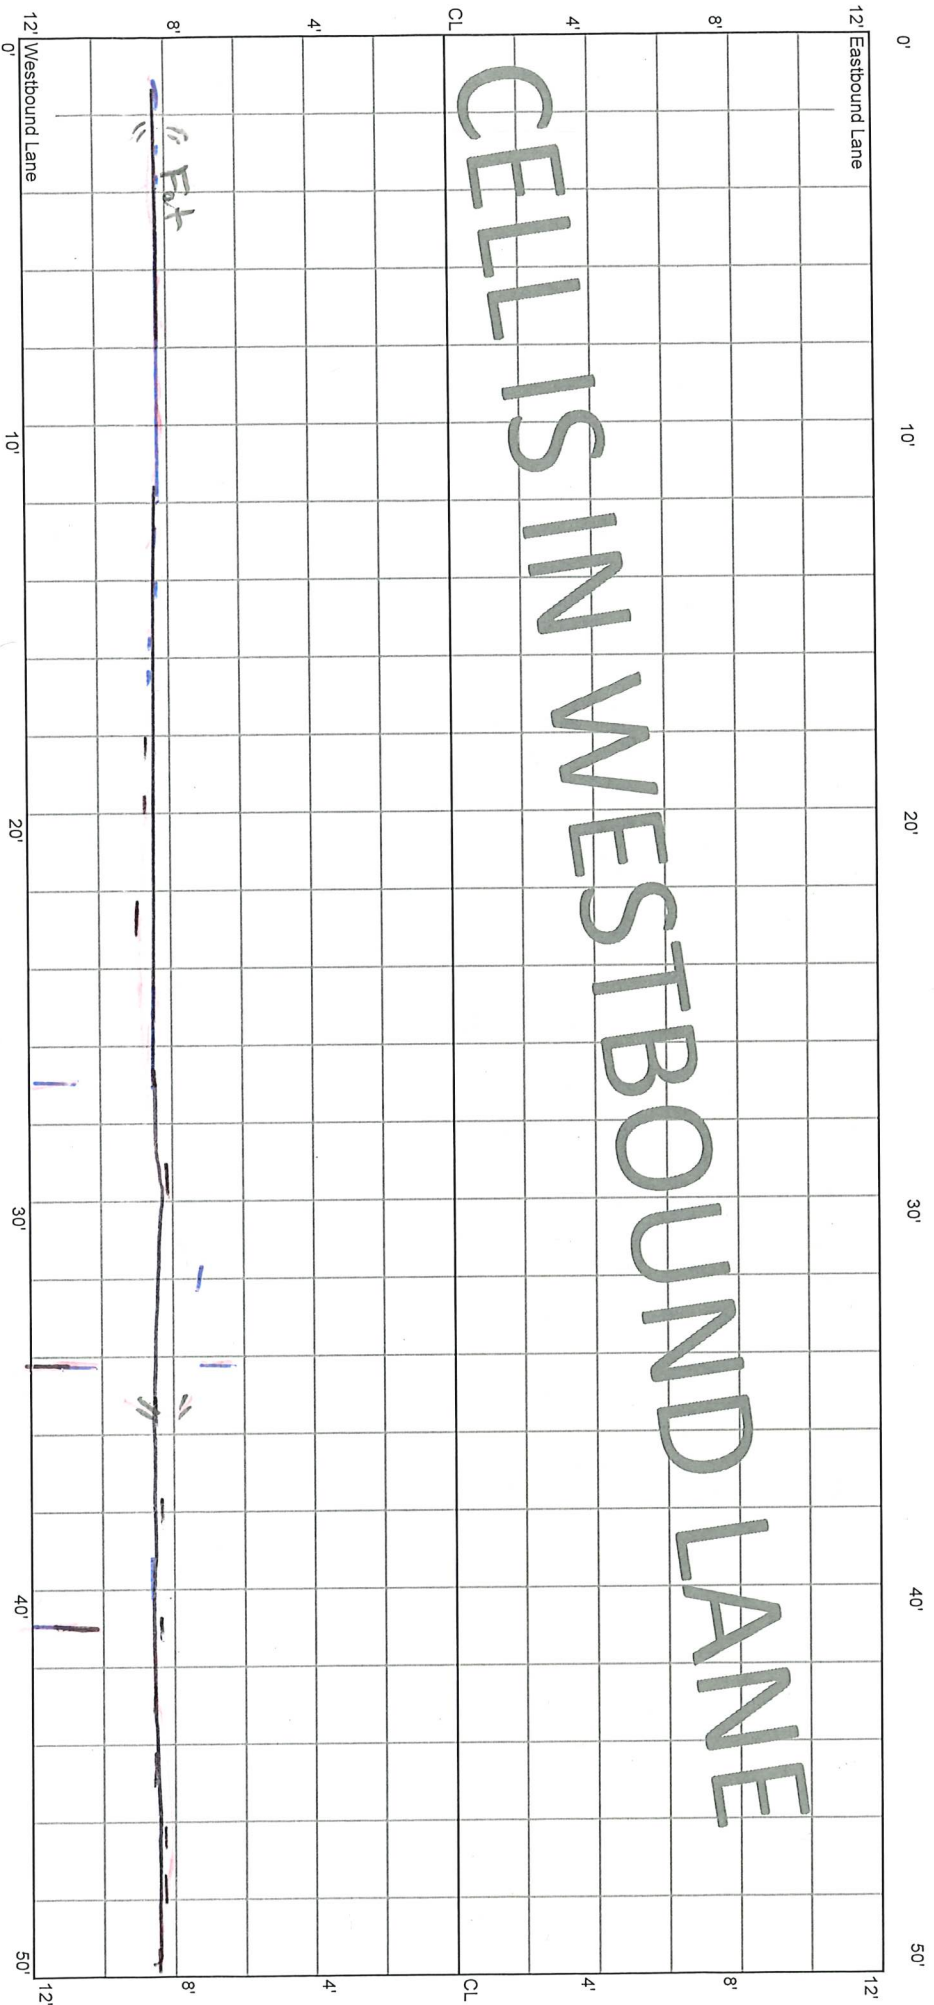

CELL 7006W  
150 - 200 ft

31+00


30+50

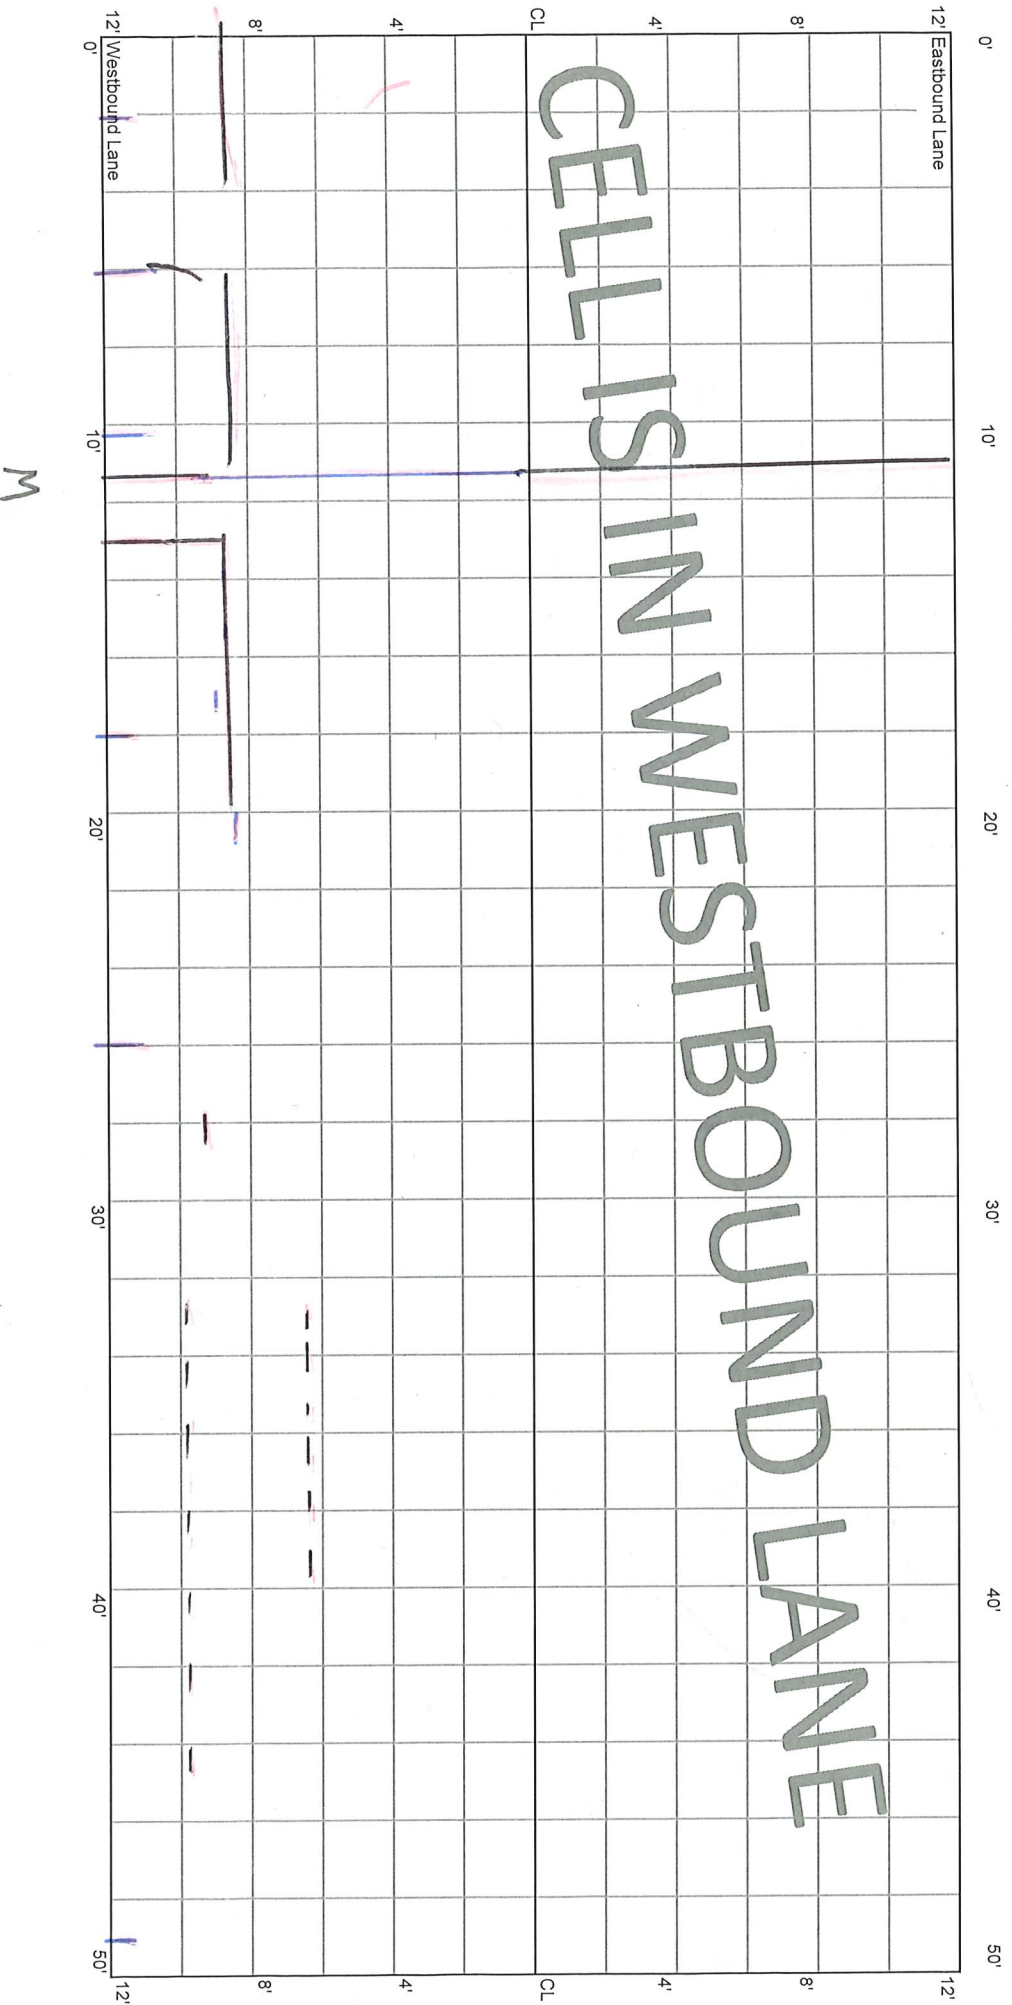

CELL 7006W  
200 - 250 ft

30+50

30+00

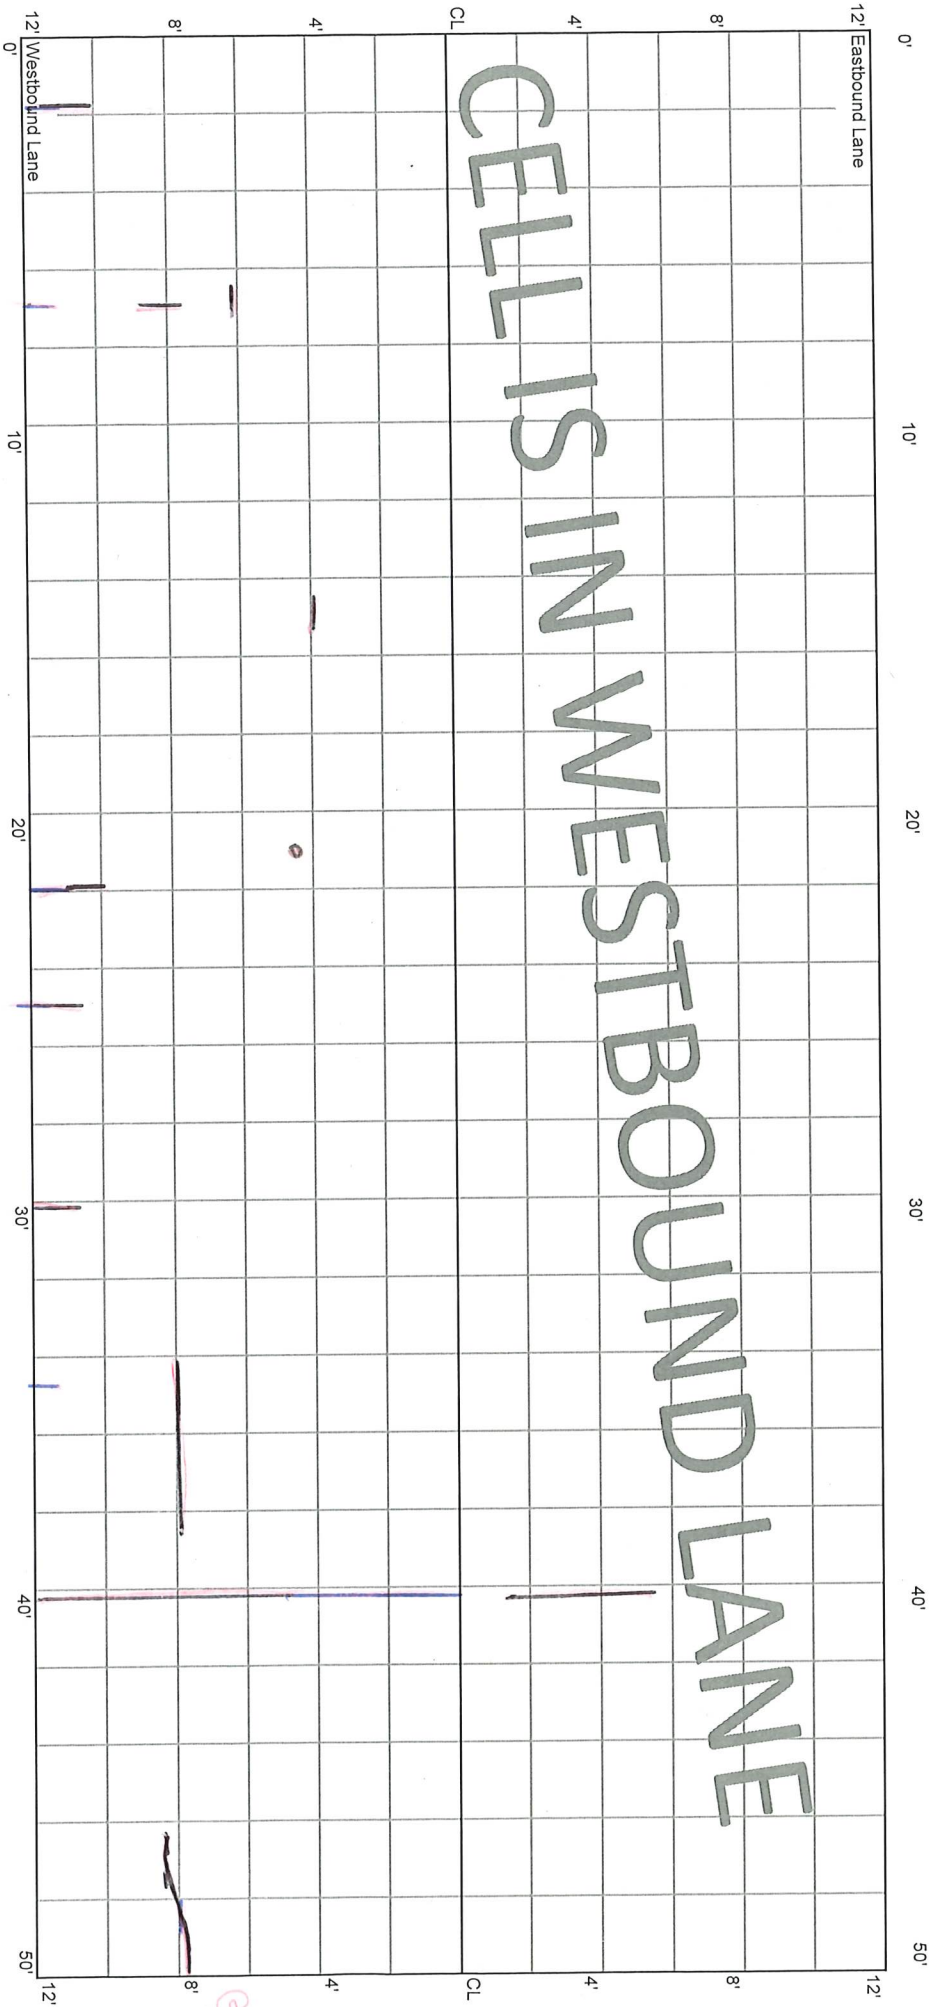


M

8'  
@5'

CELL 7006W  
250 - 300 ft

30+00

29+50

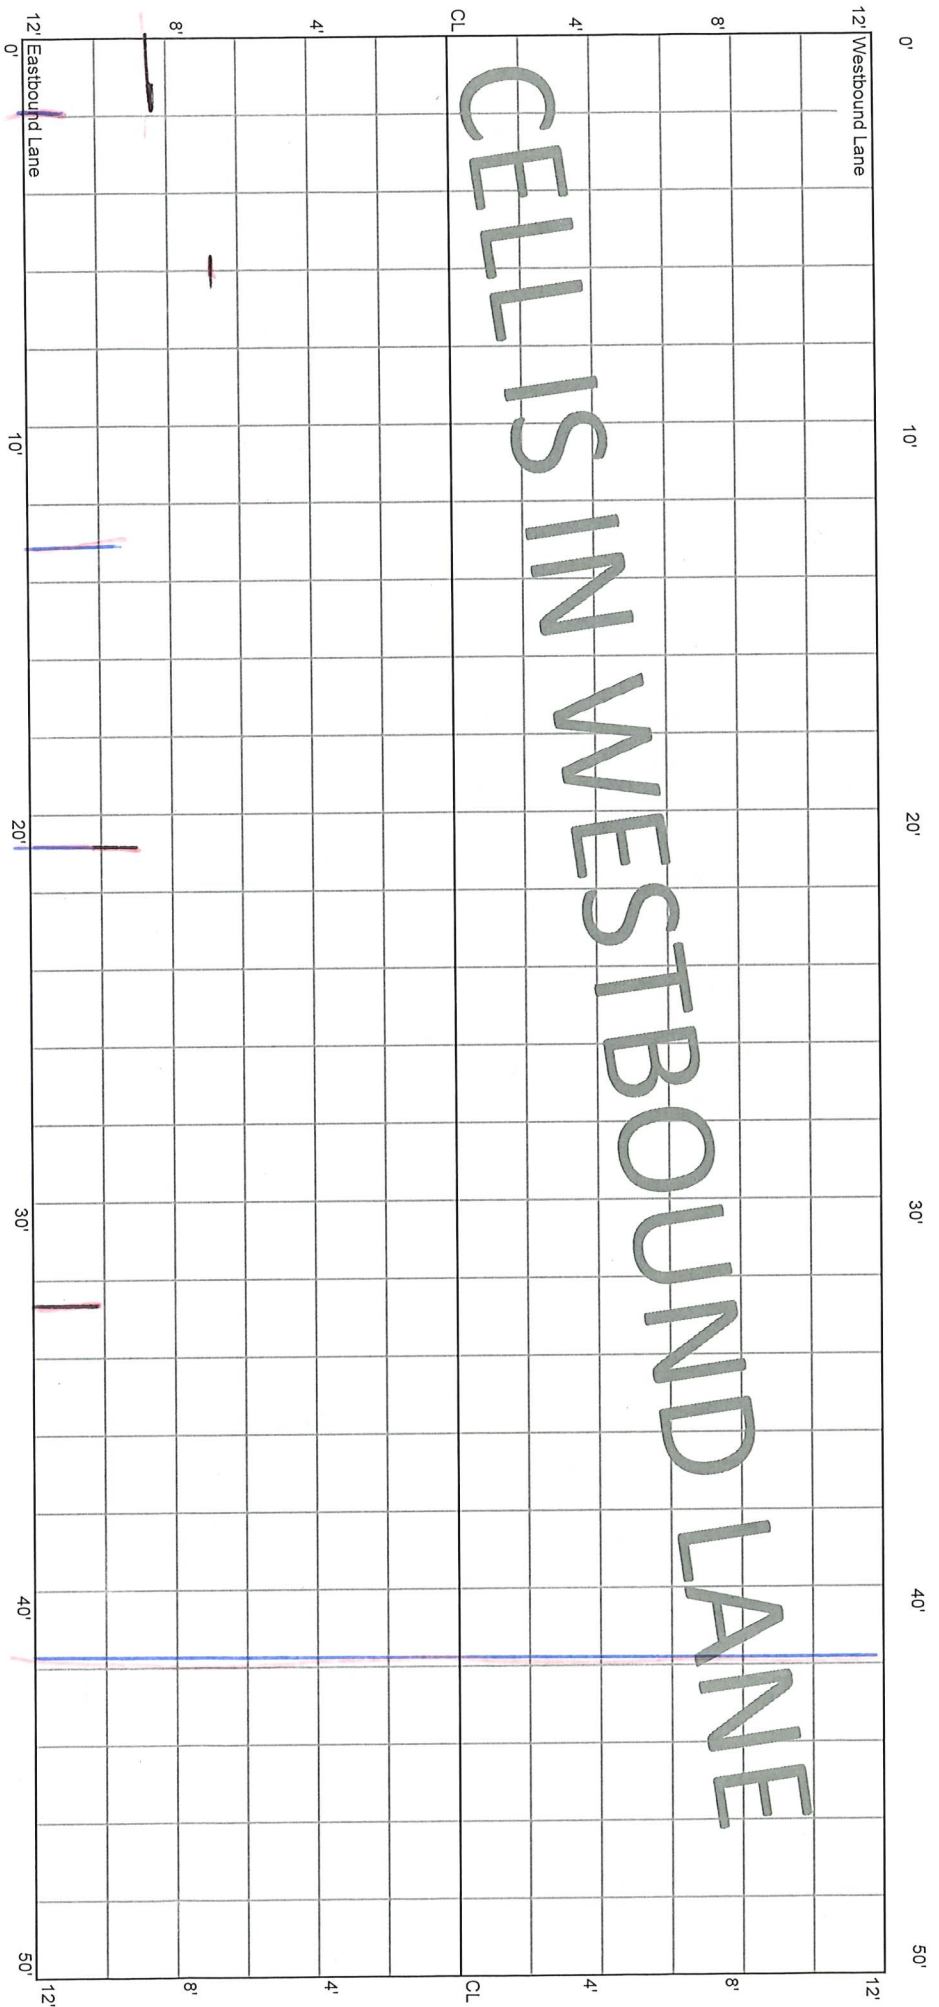


M

CELL 7006W  
300 - 350 ft

29+50


29+00

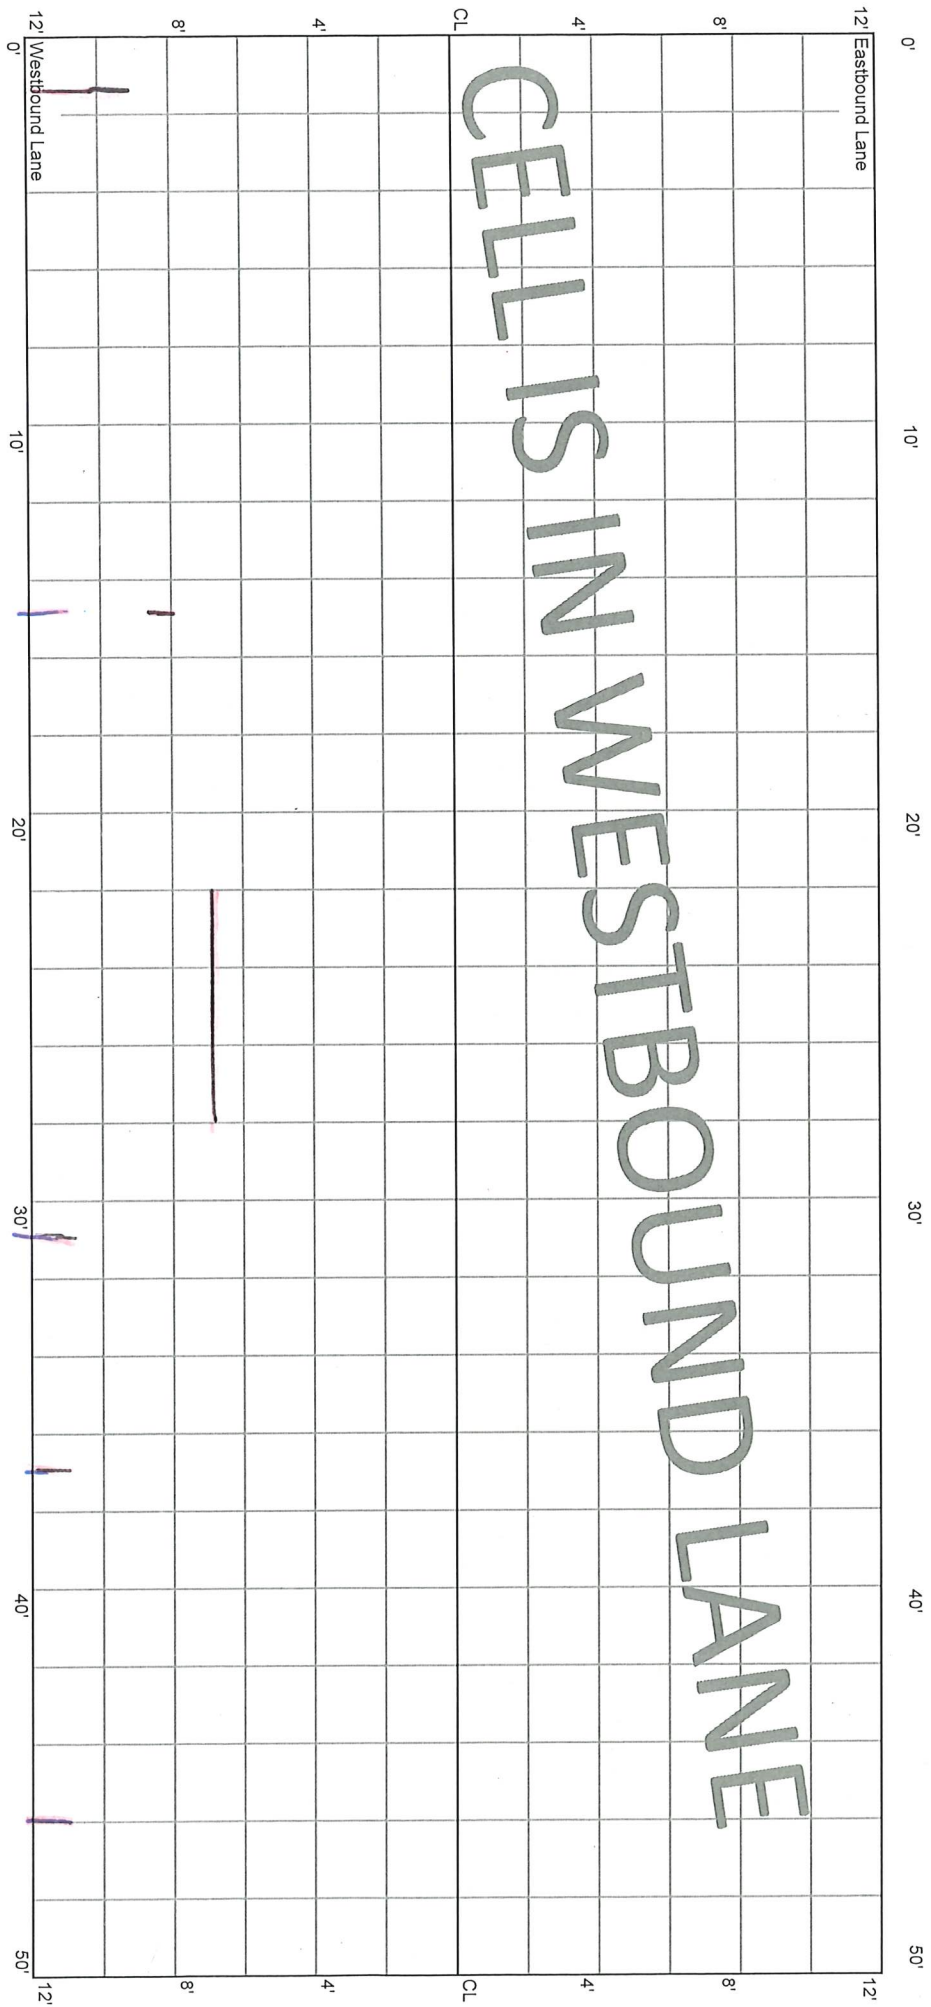

CELL 7006W  
350 - 400 ft

29+00

28+50

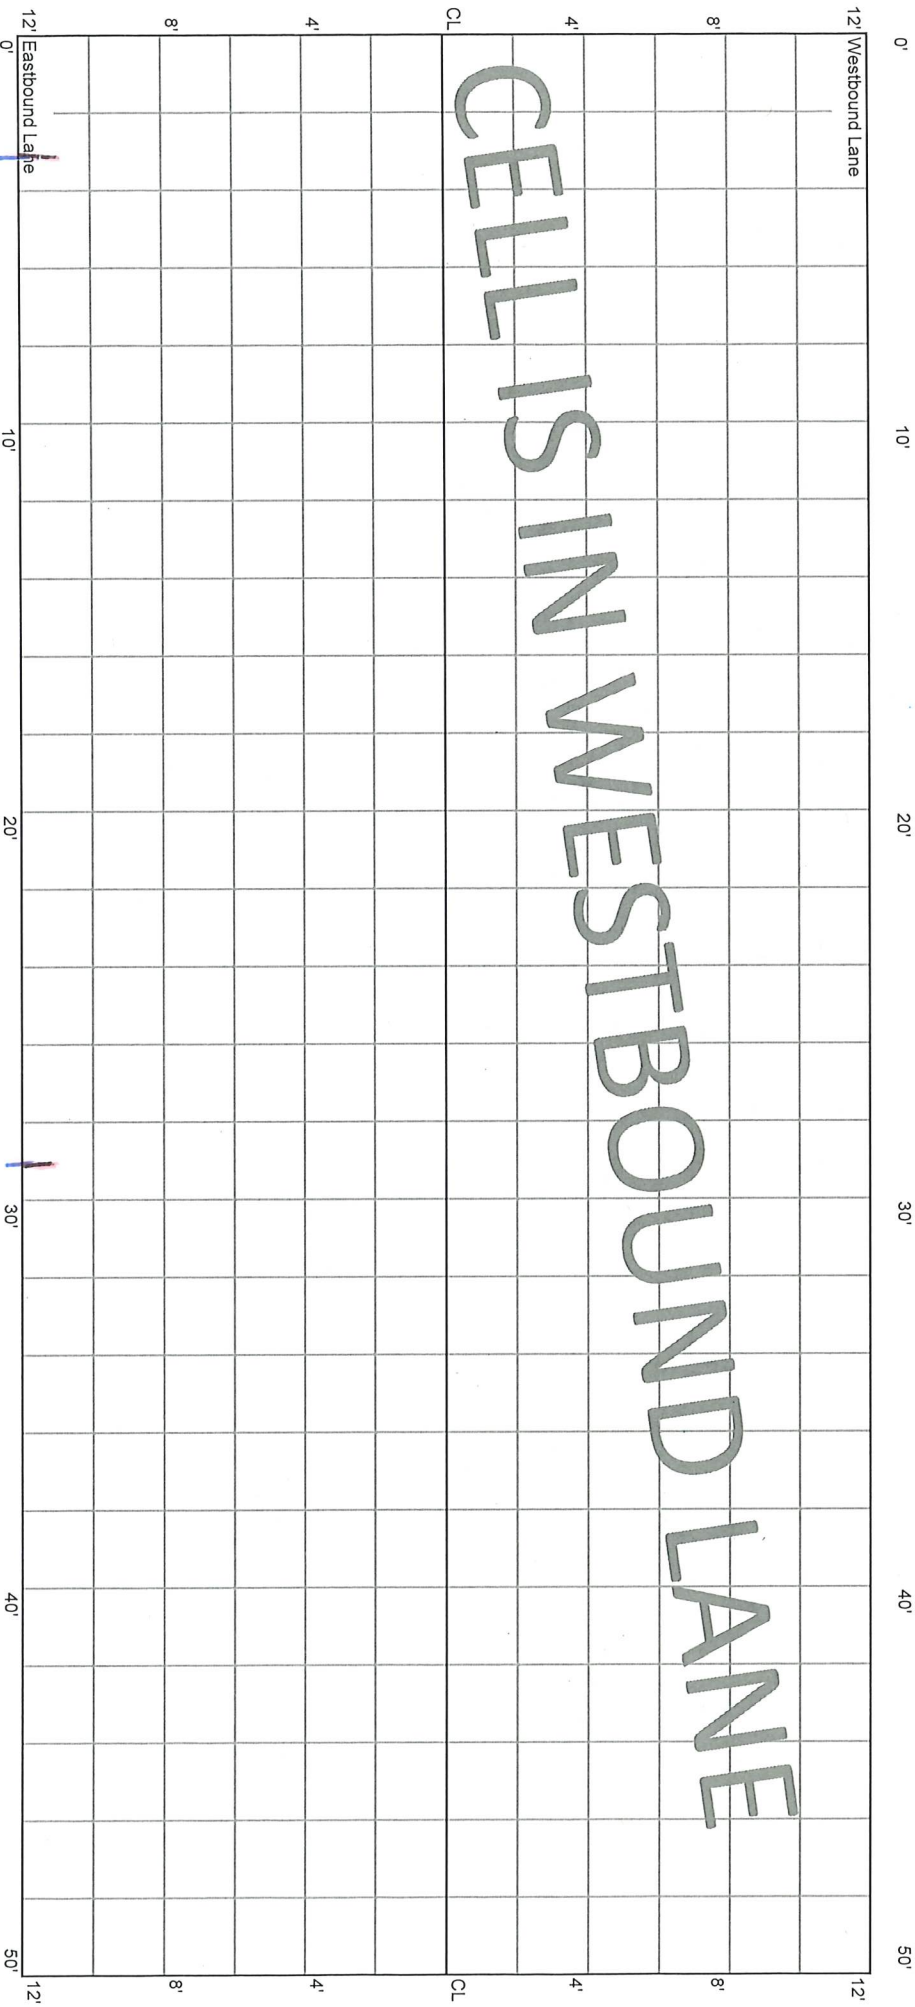




CELL 7006W  
400 - 450 ft

28+50


28+00

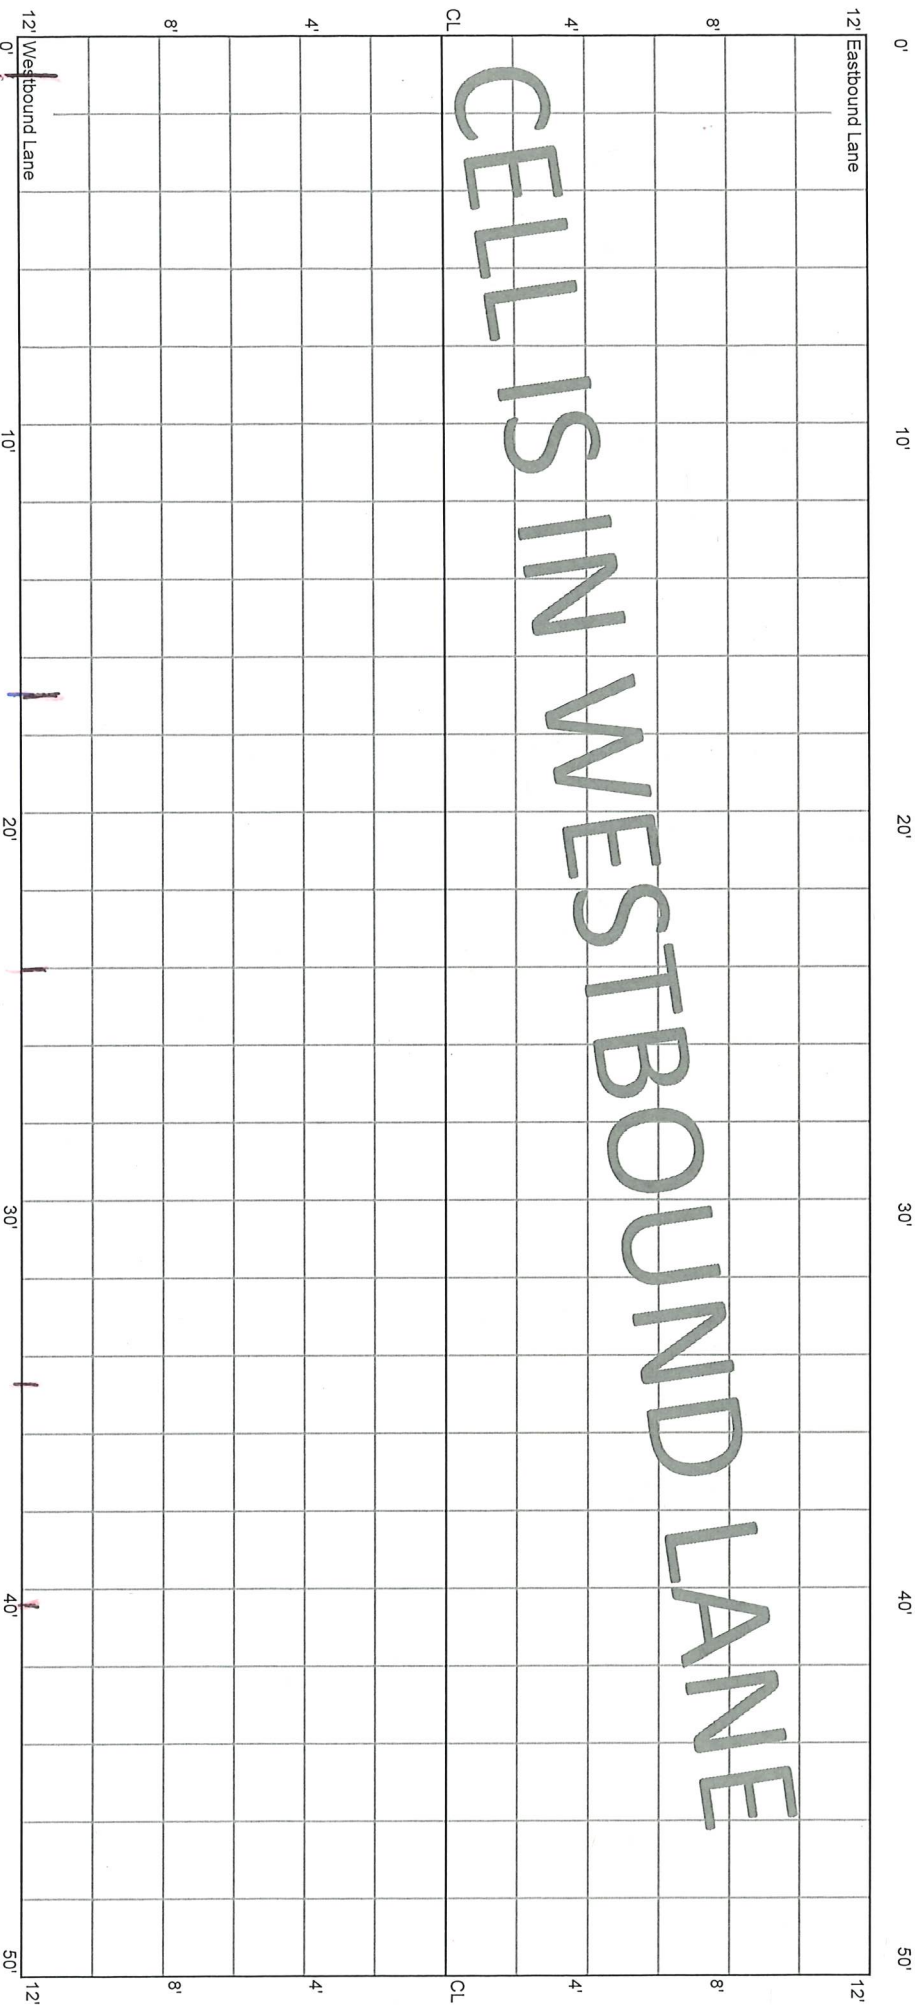

CELL 7006W  
450 - 500 ft

28+00

27+50

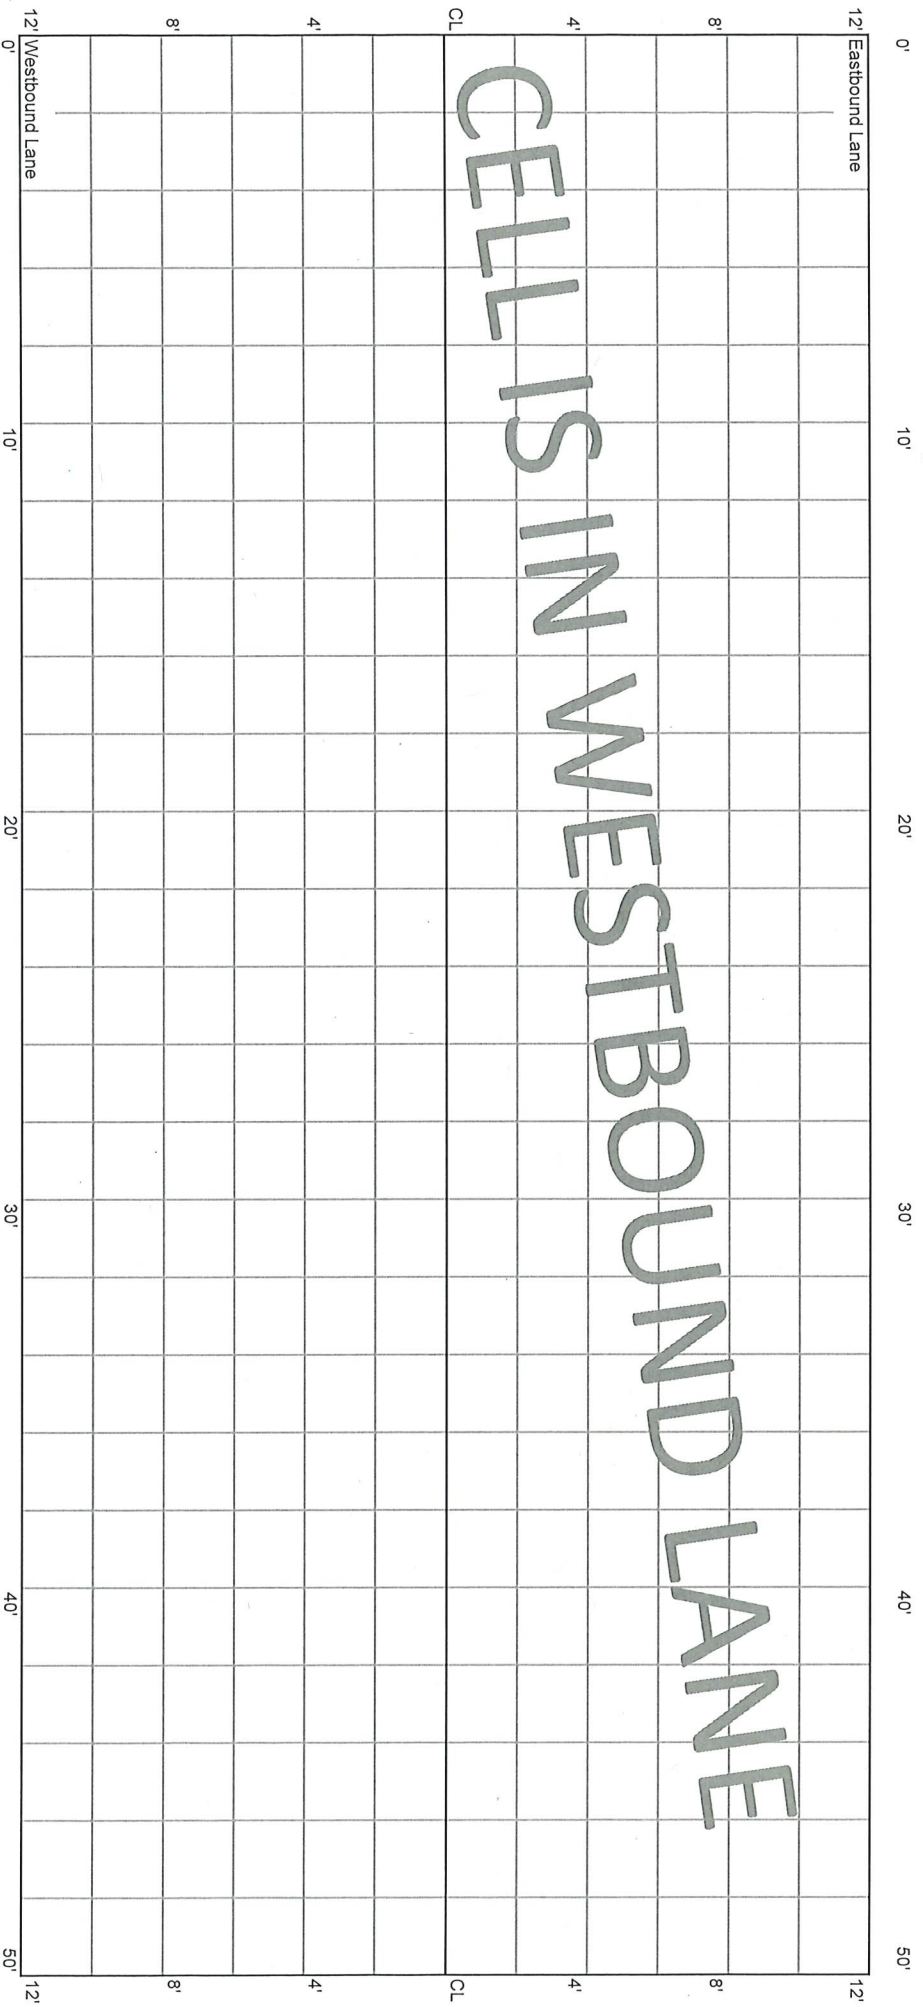

CELL 7006W  
500 - 550 ft

27+50

27+25

27+00

