


5.28.20 E.J.

File 70TH ST

CELL 7002W
0 - 50 ft

10+50


10+00

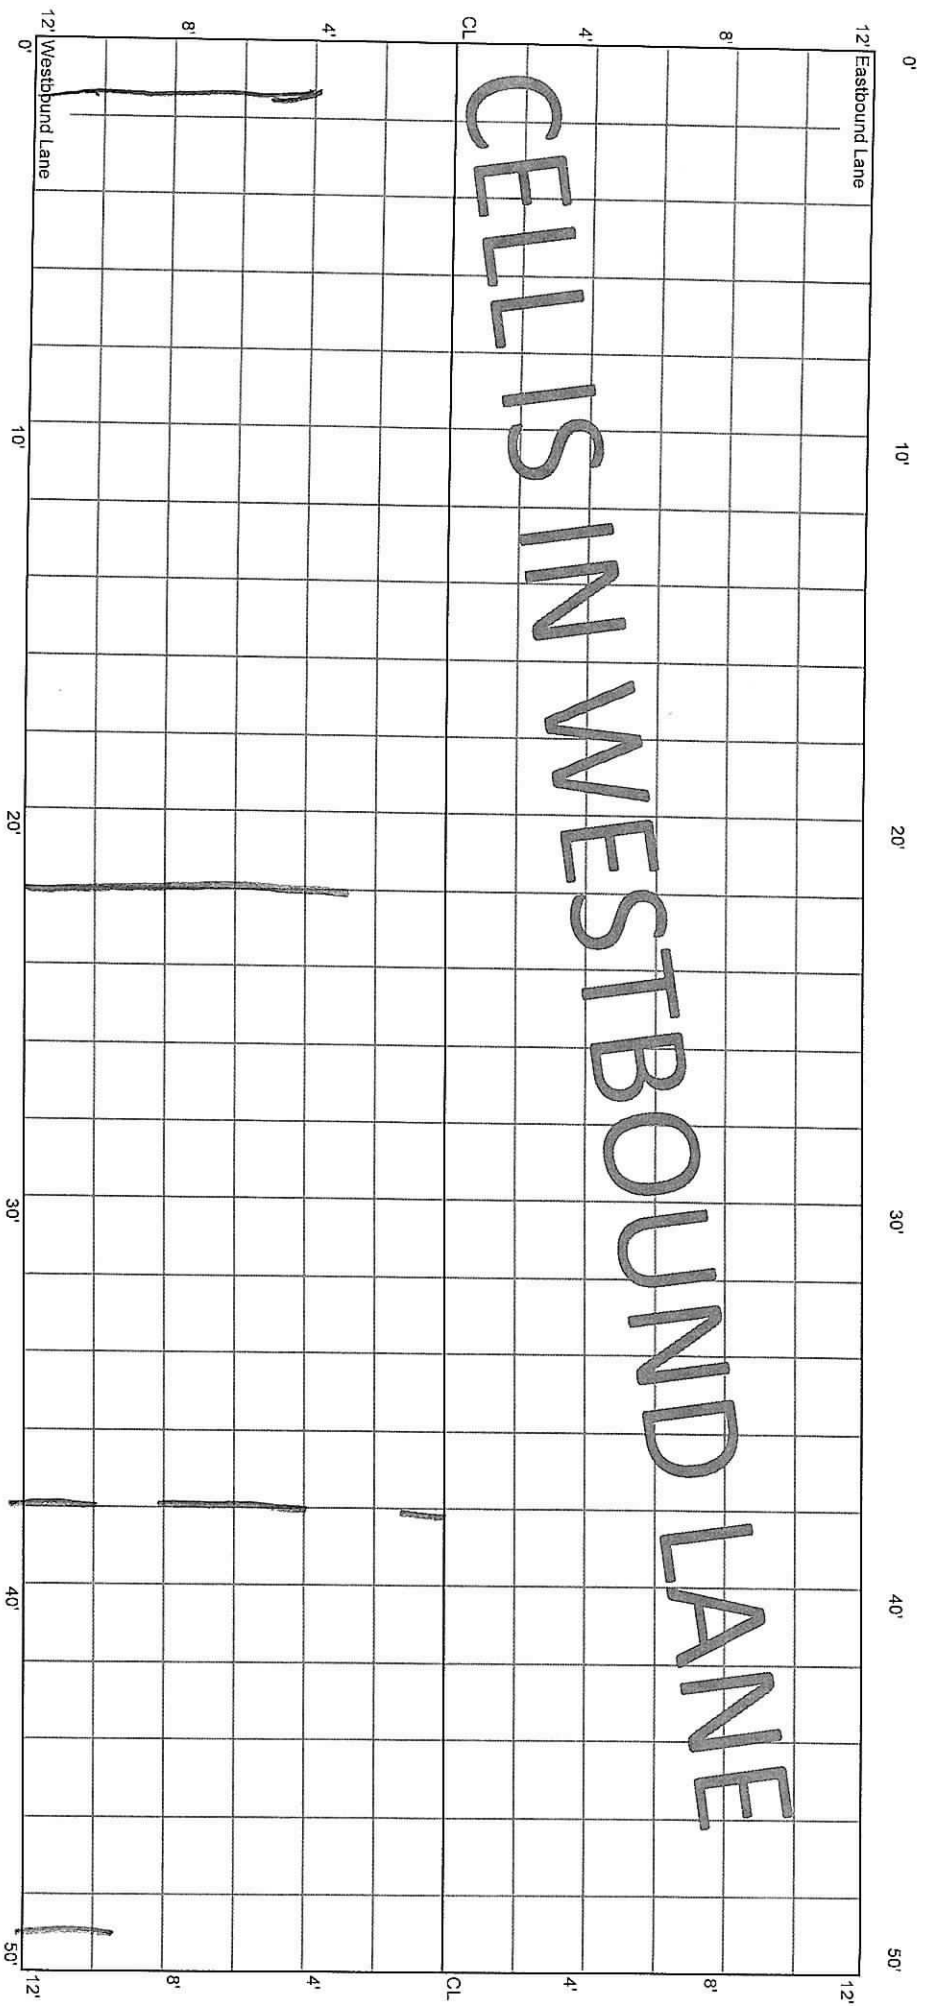

CELL 7002W
50 - 100 ft

10+00


9+50

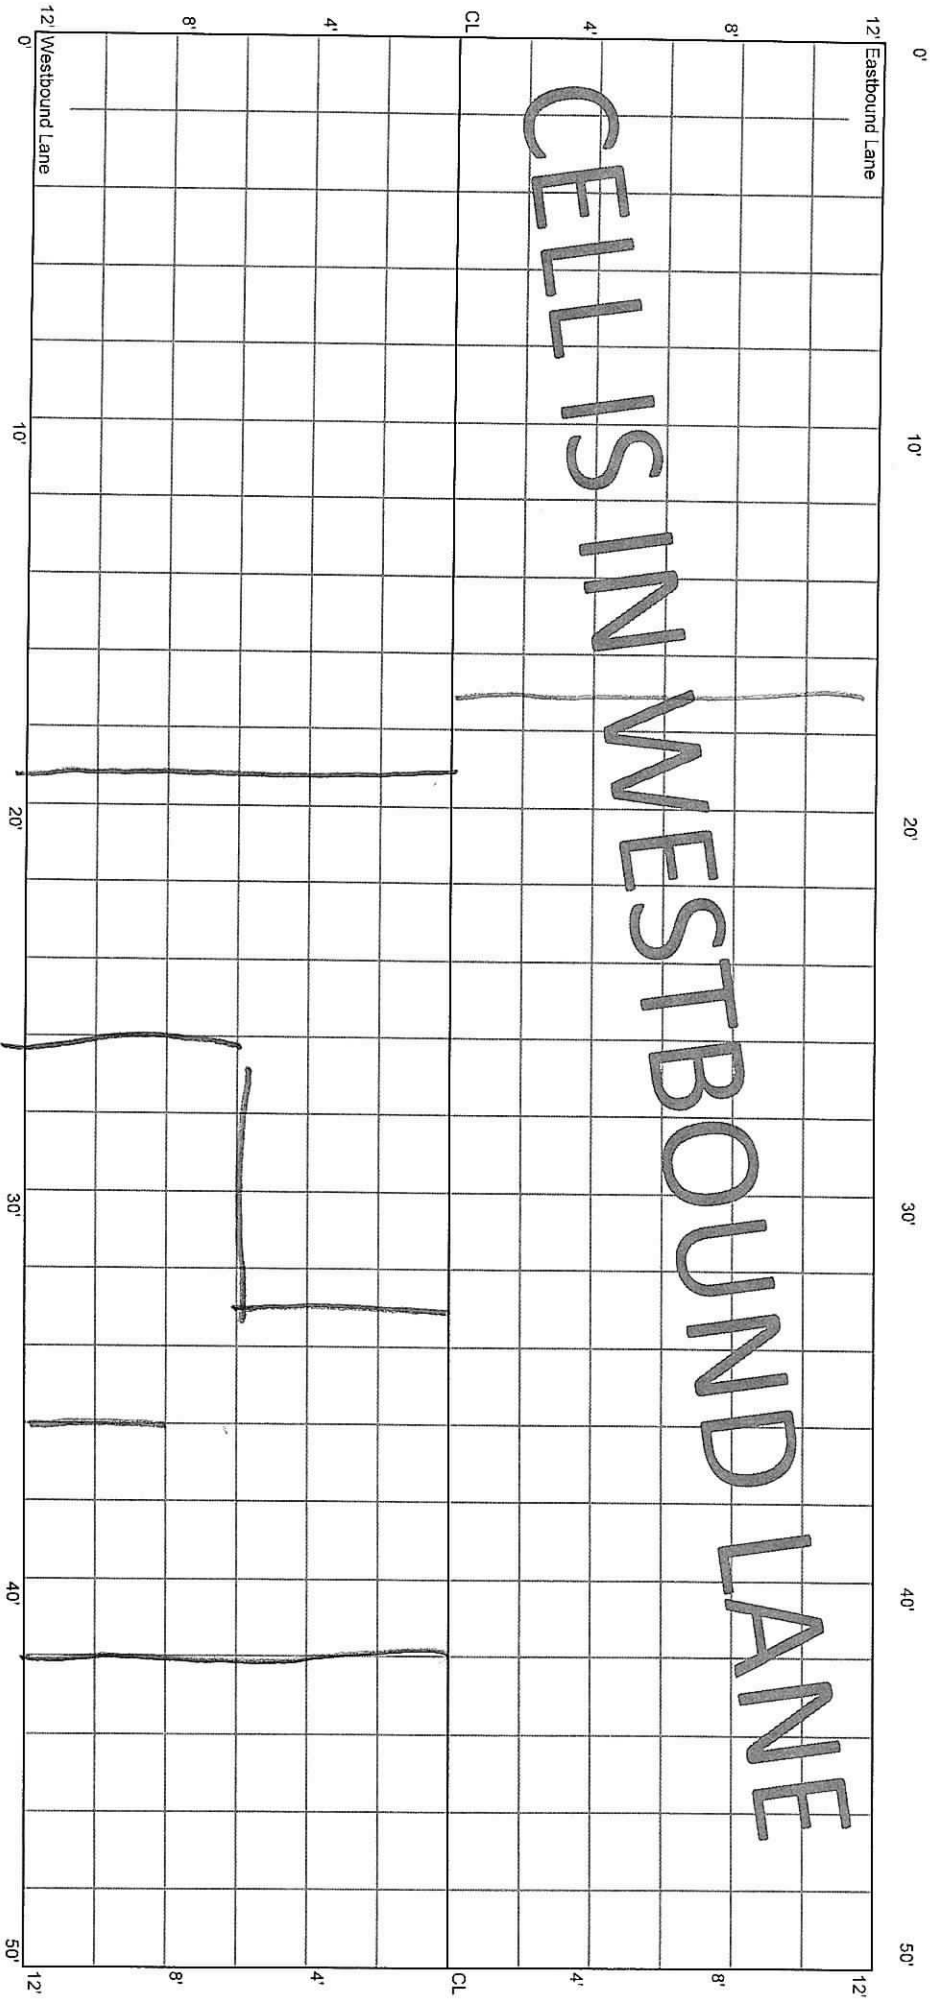

CELL 7002W
100 - 150 ft

9+50


9+00

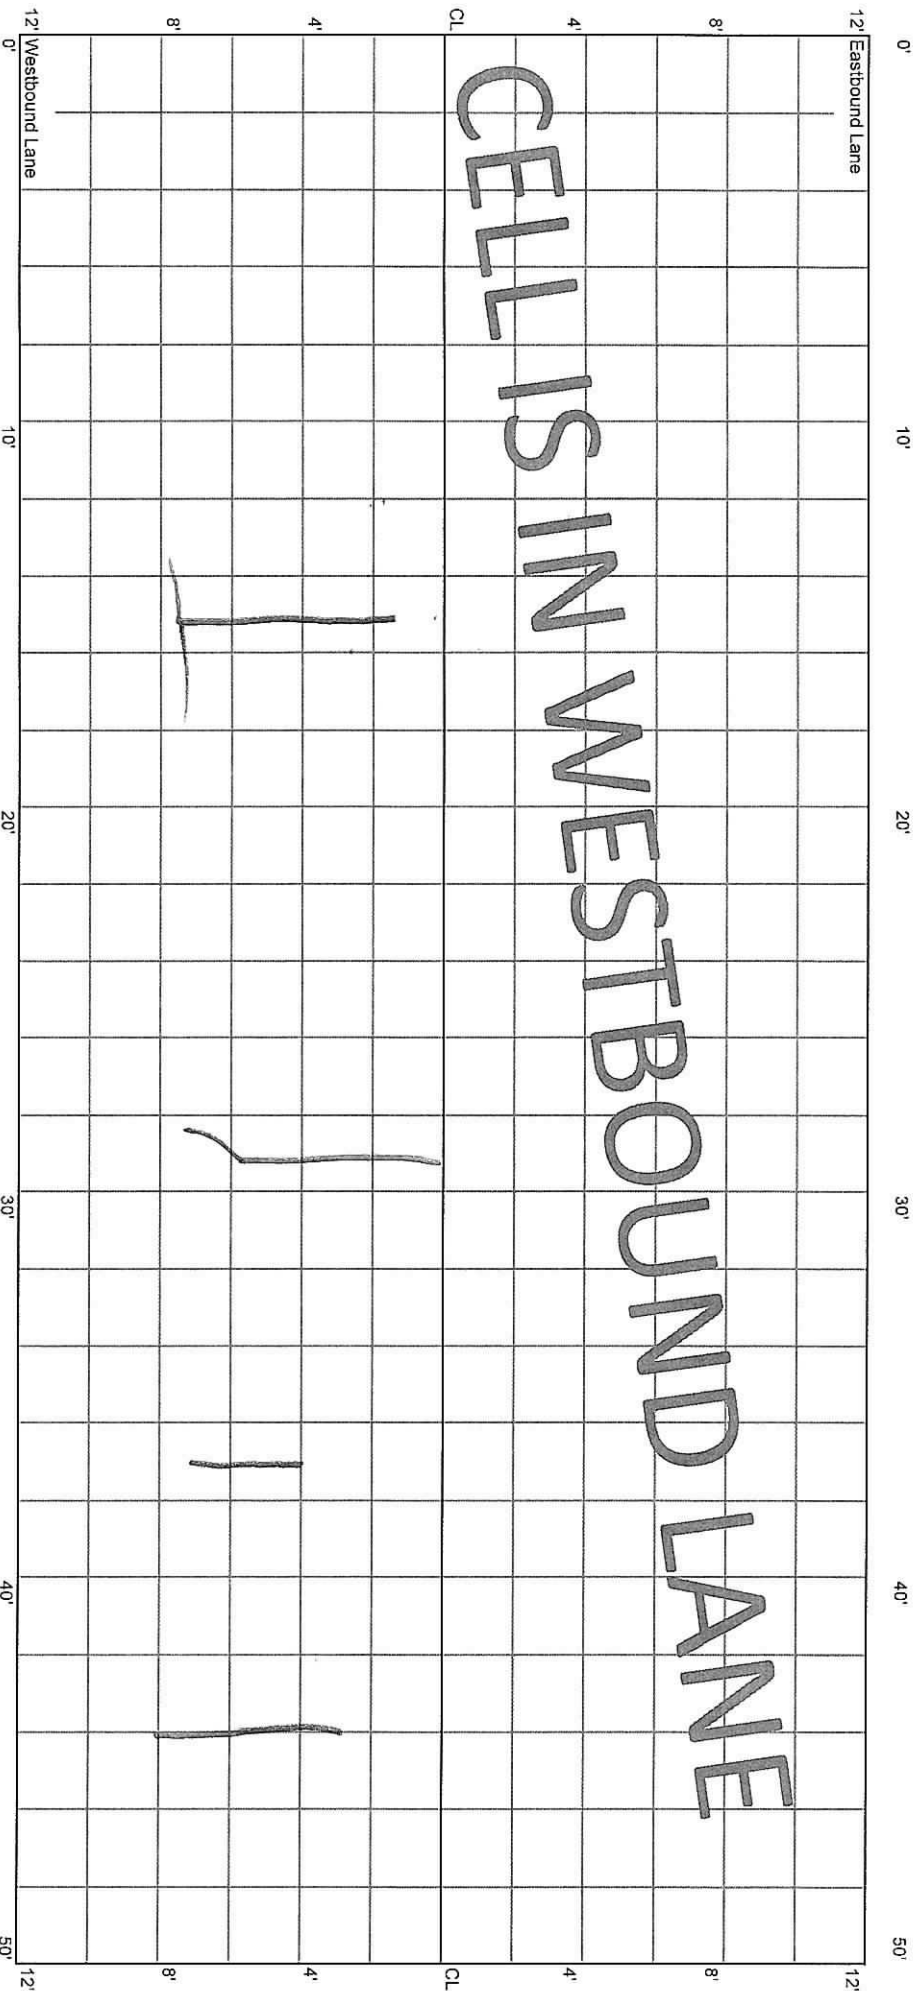

CELL 7002W
150 - 200 ft

9+00


8+50

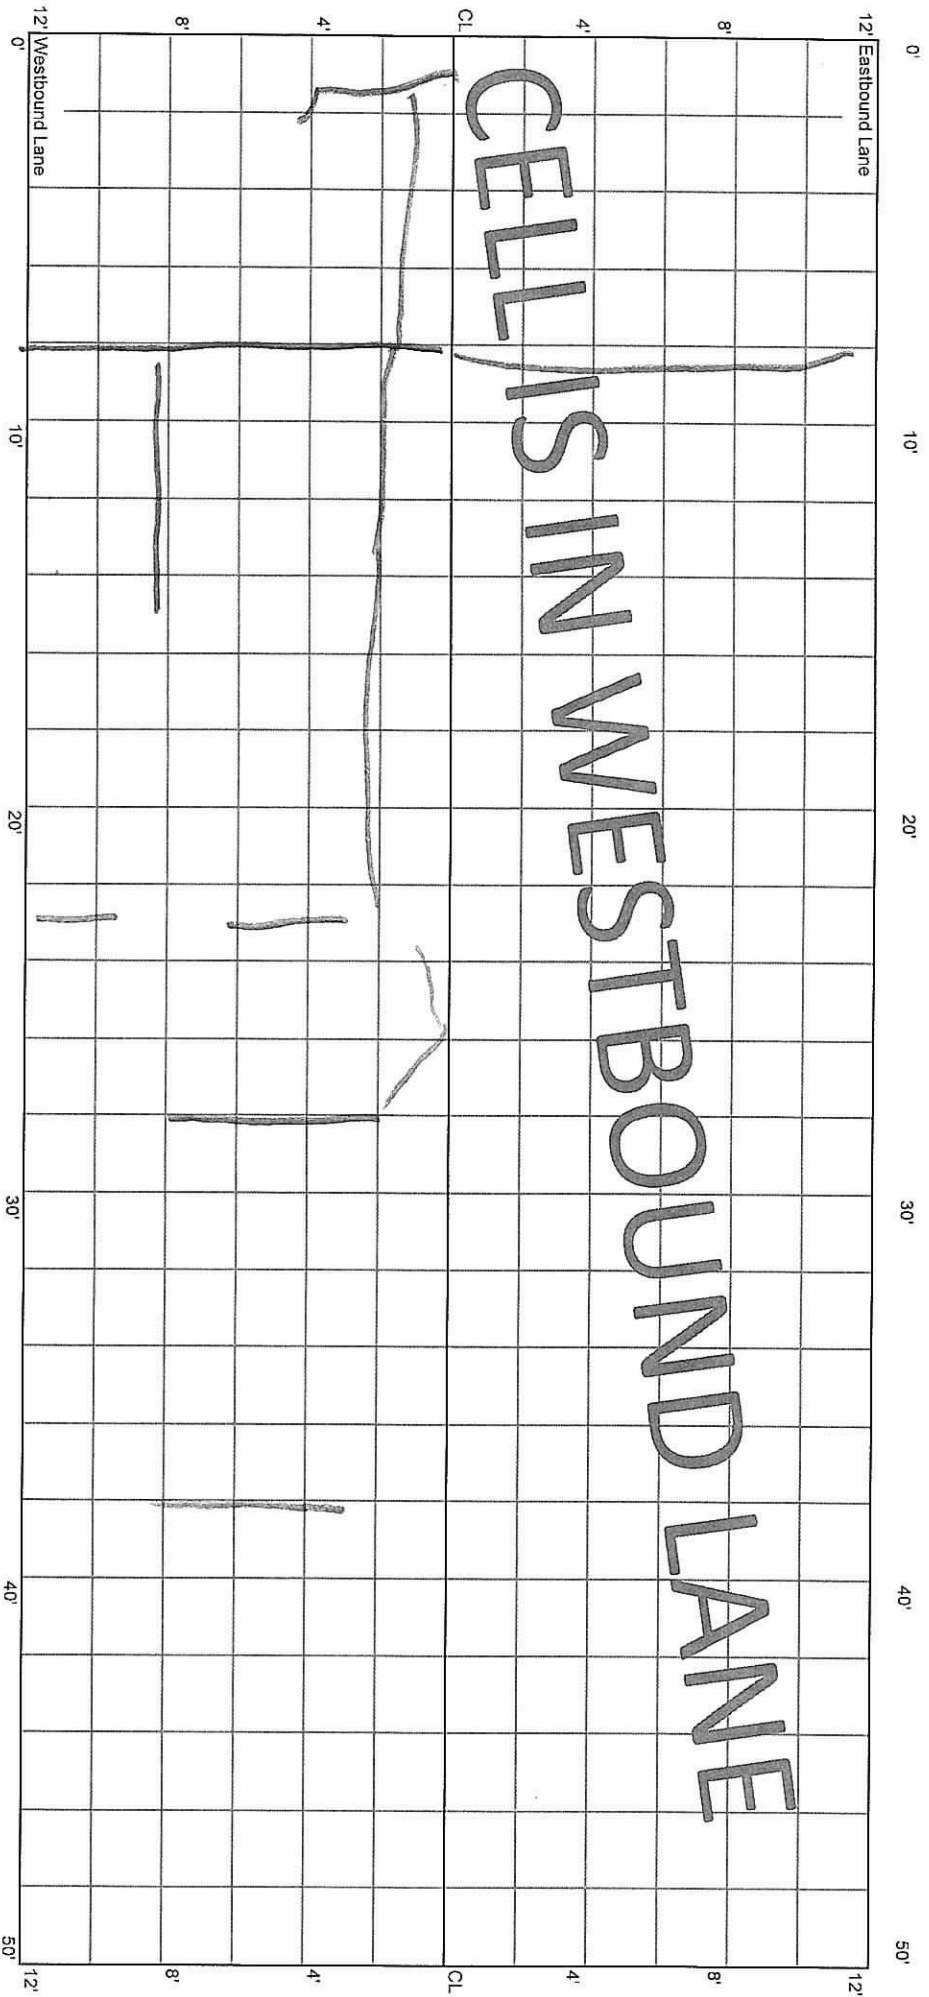

CELL 7002W
200 - 250 ft

8+50


8+00

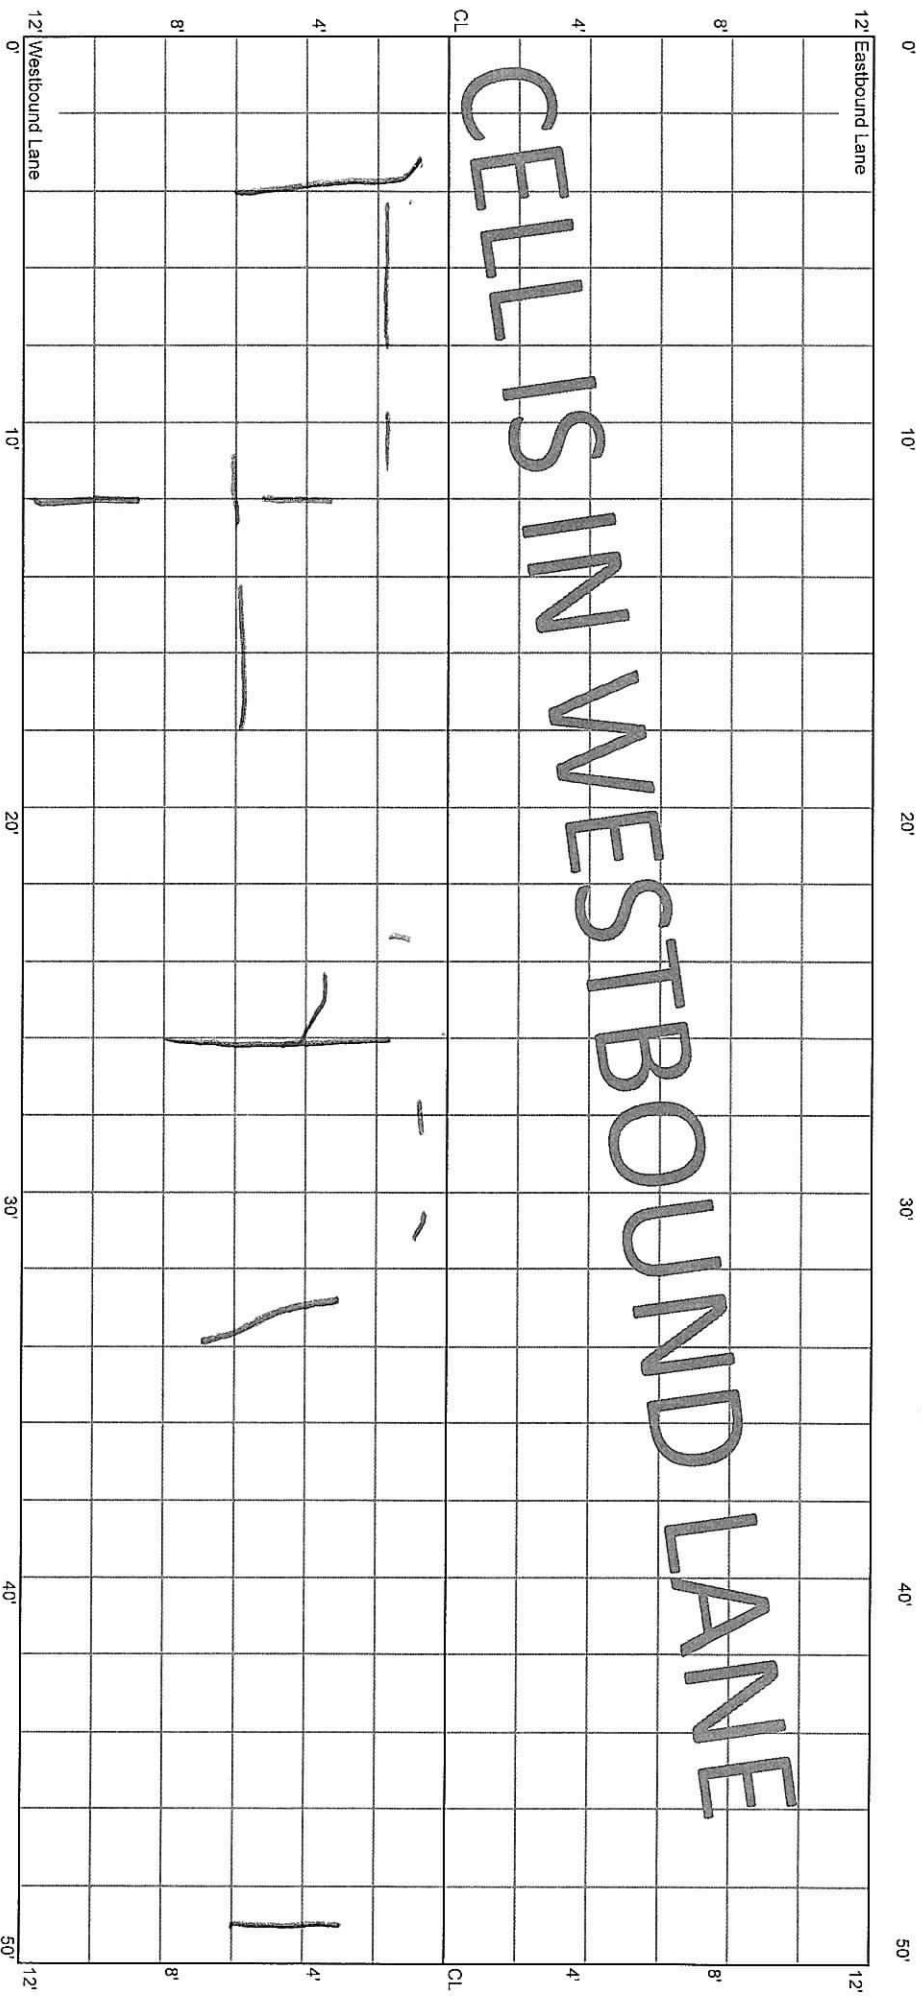

CELL 7002W
250 - 300 ft

8+00


7+50

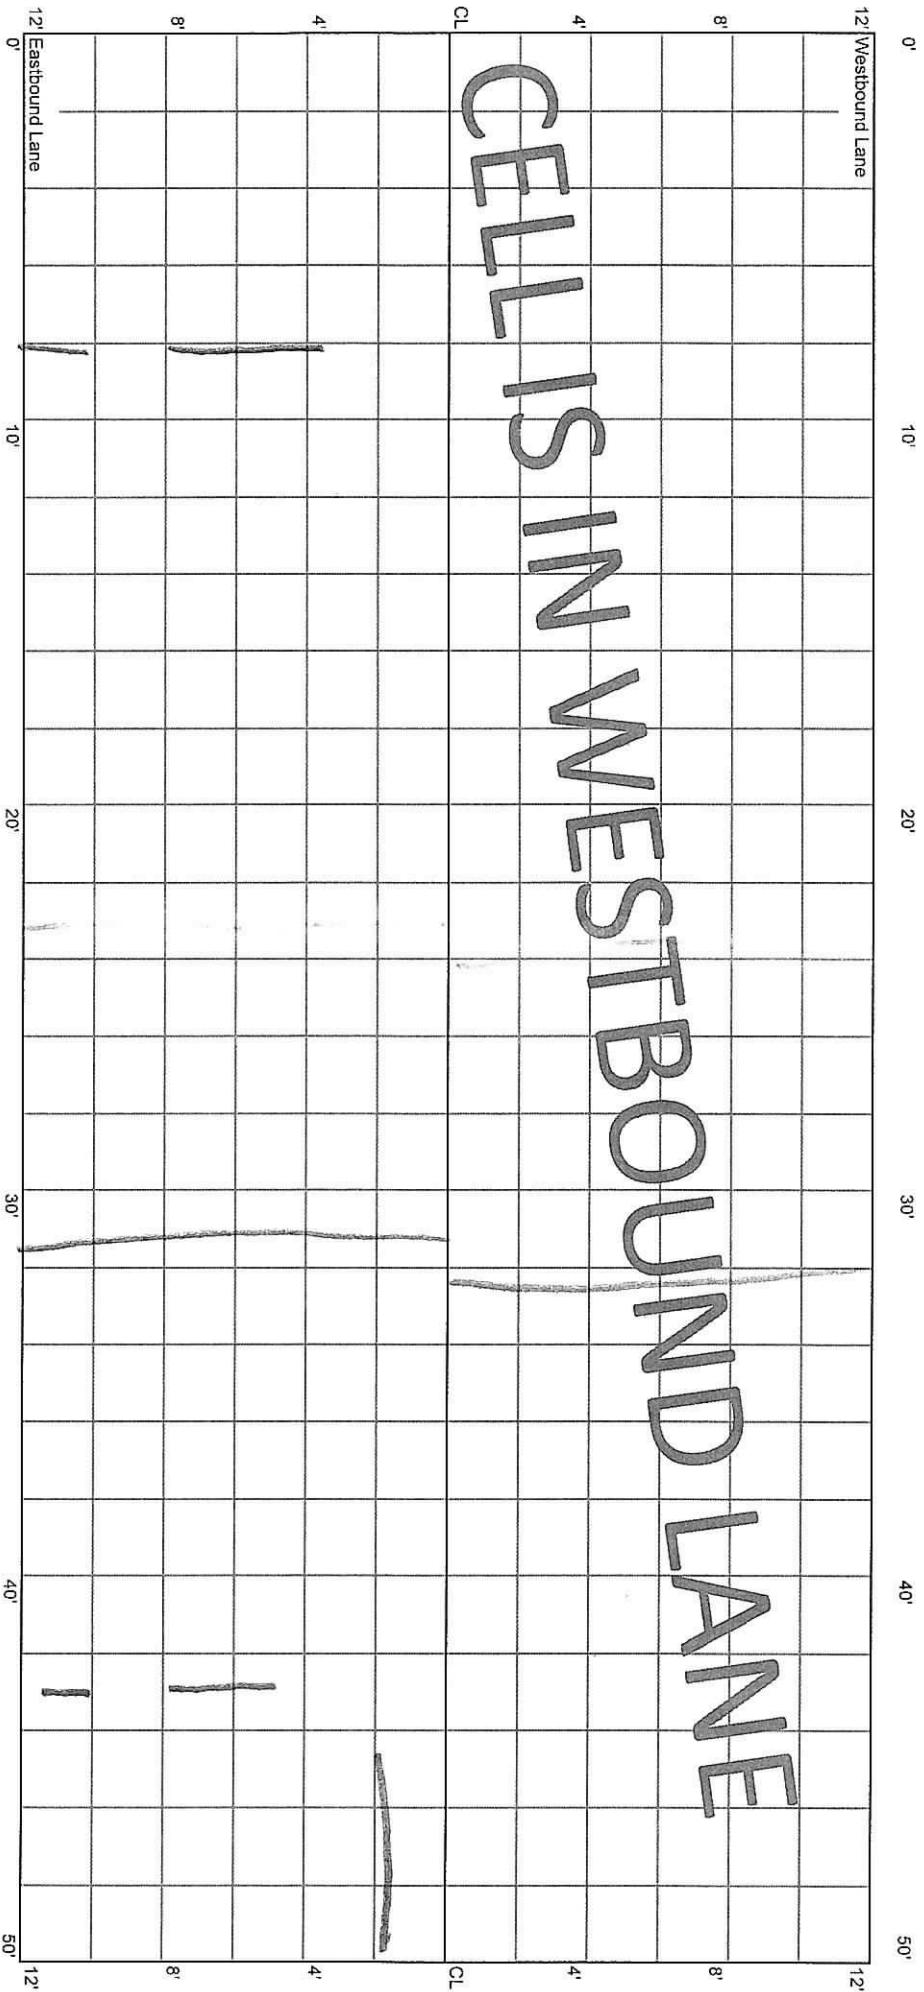

CELL 7002W
300 - 350 ft

7+50


7+00

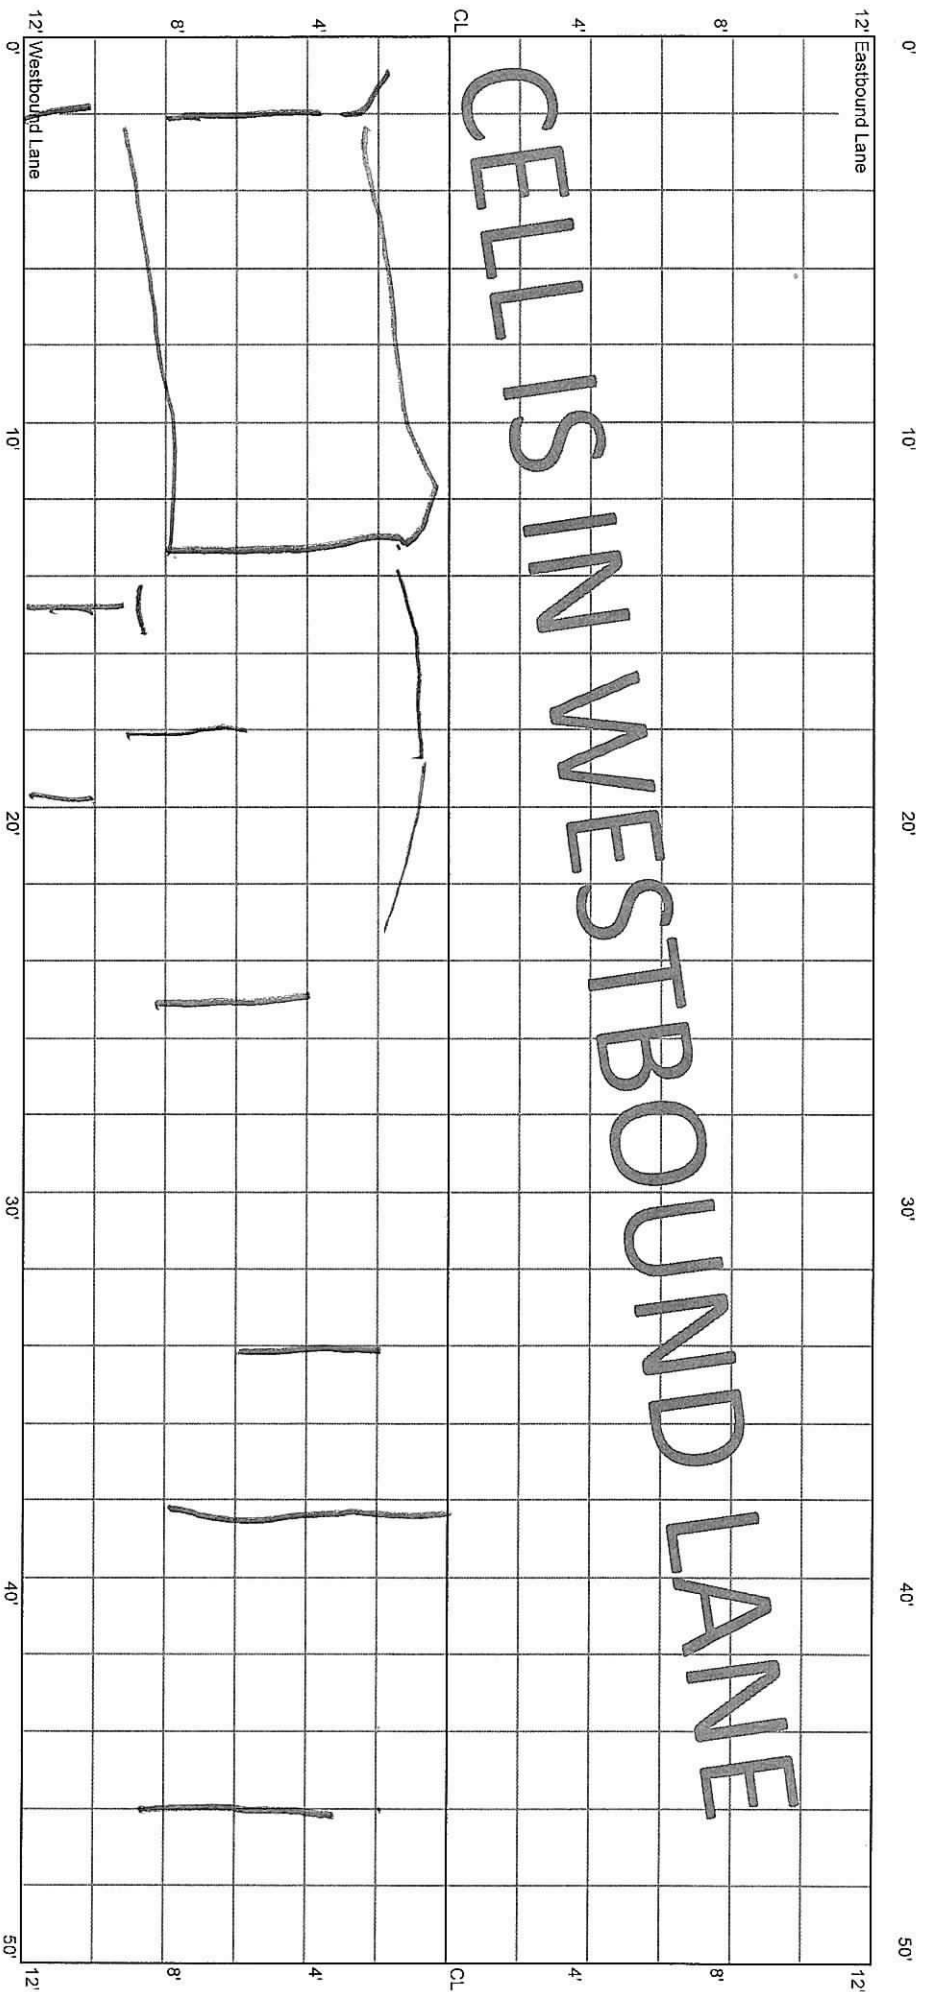

CELL 7002W
350 - 400 ft

7+00


6+50

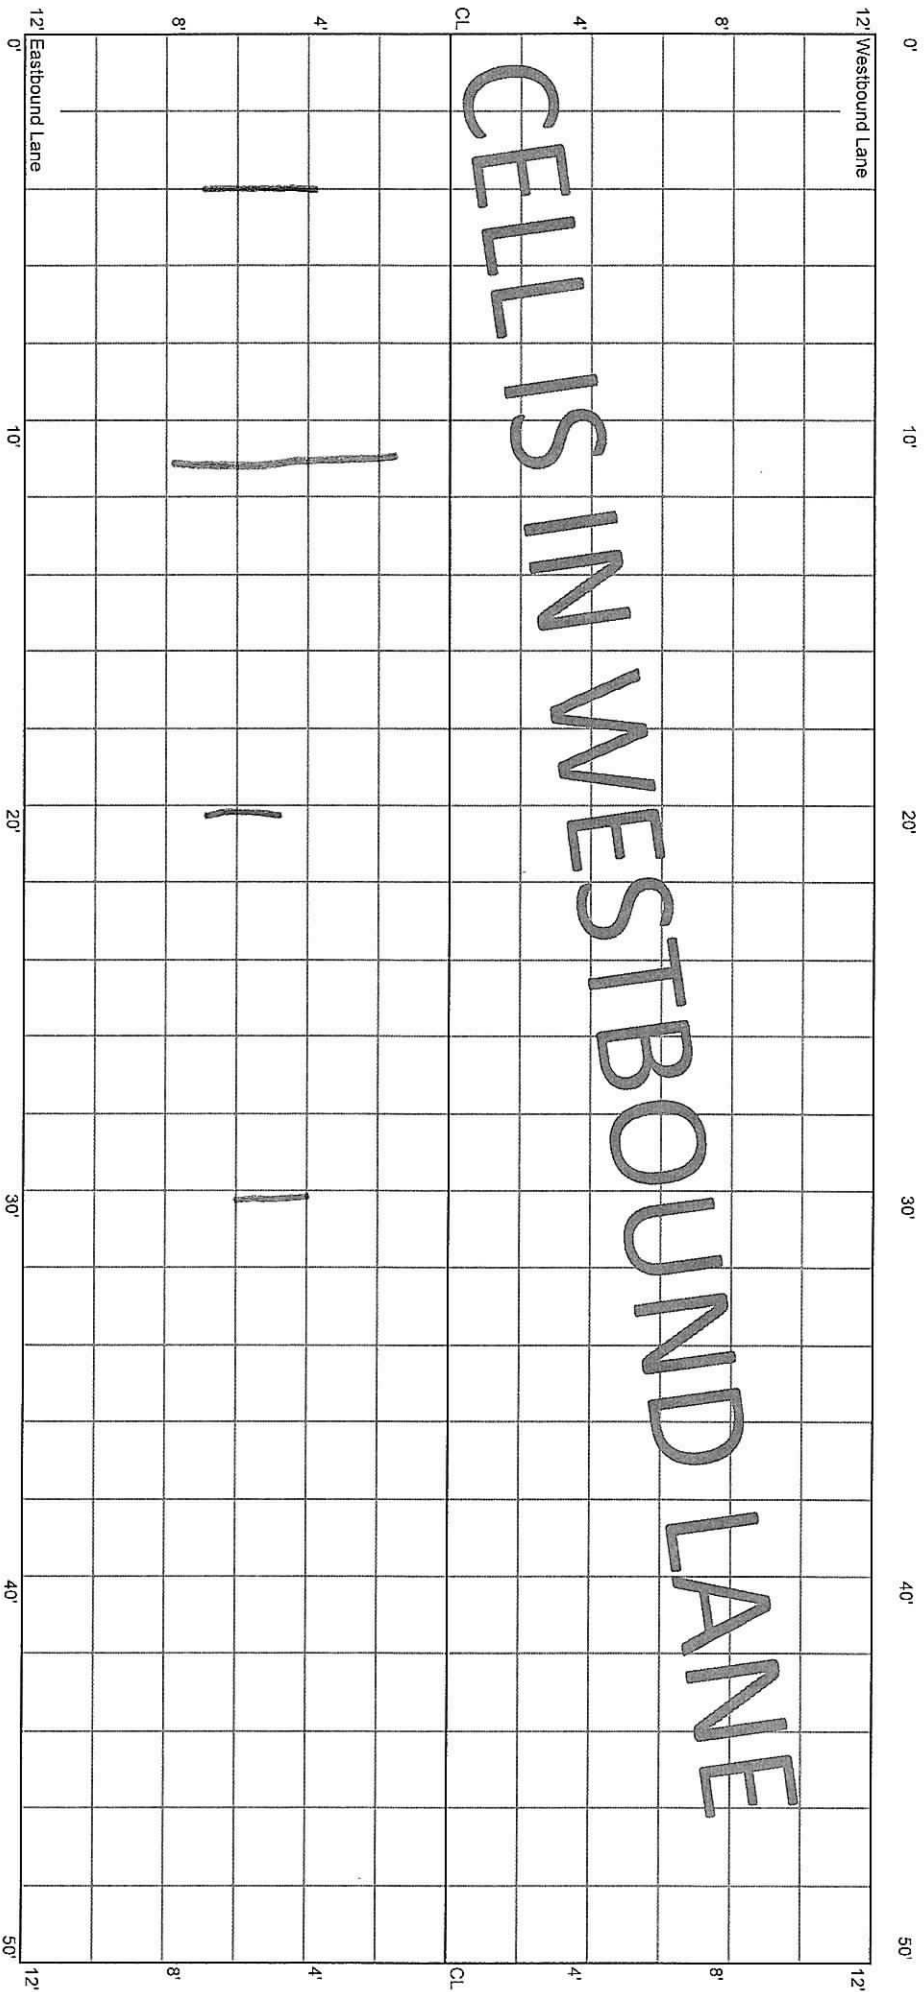

CELL 7002W
400 - 450 ft

6+50


6+00

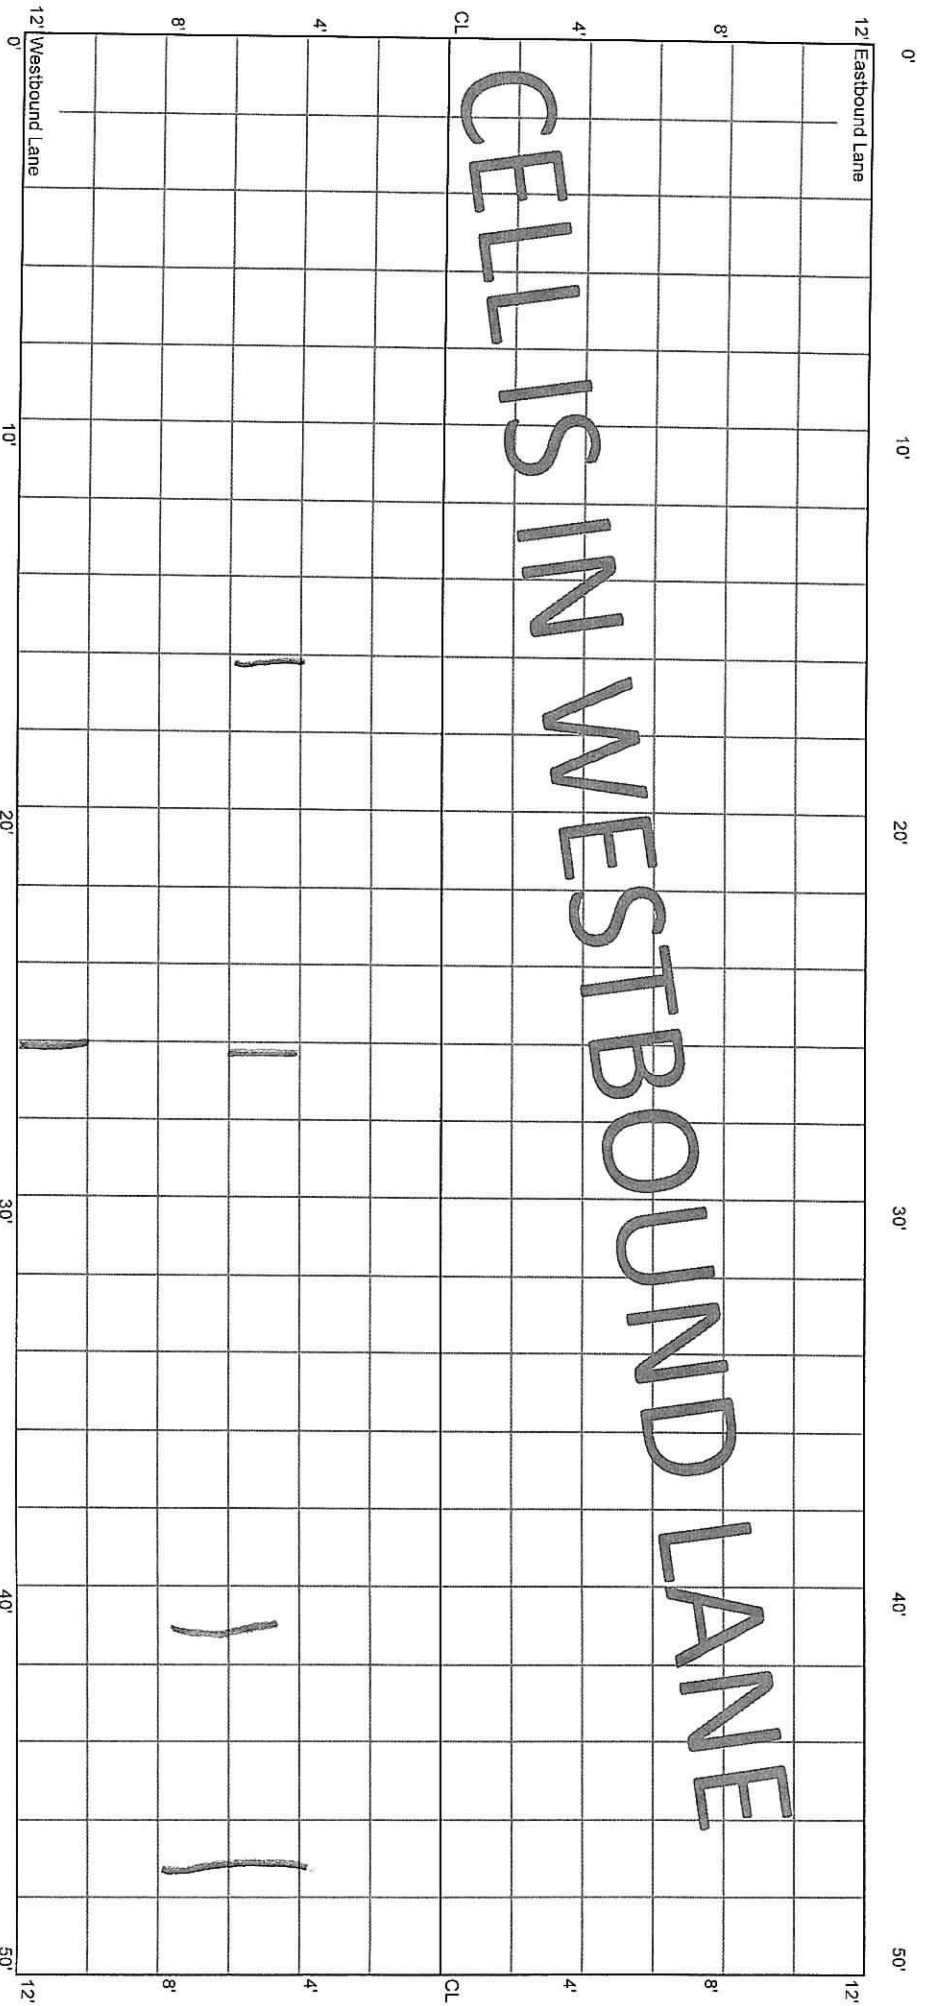

CELL 7002W
450 - 500 ft

6+00

5+50

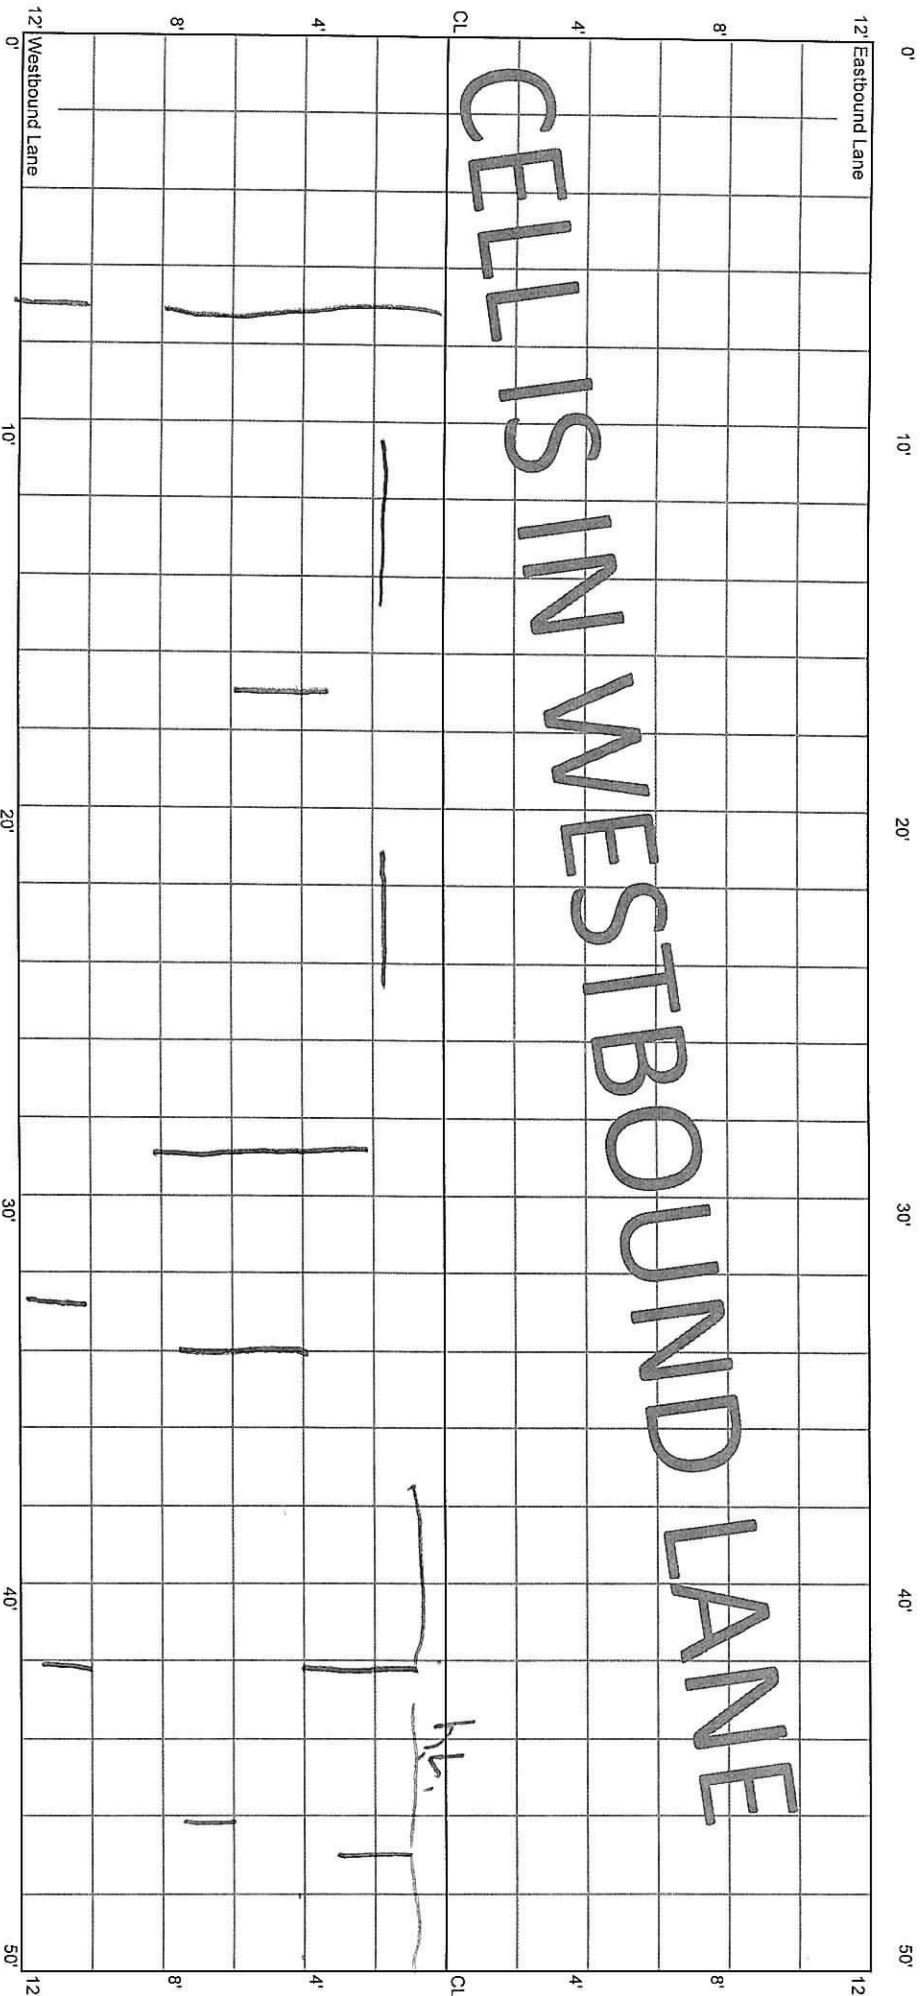

CELL 7002W
500 - 550 ft

5+50

5+25

5+00

