


5.28.20 E.J.

File 70TH ST

CELL 7004E
0 - 50 ft

16+50

17+00

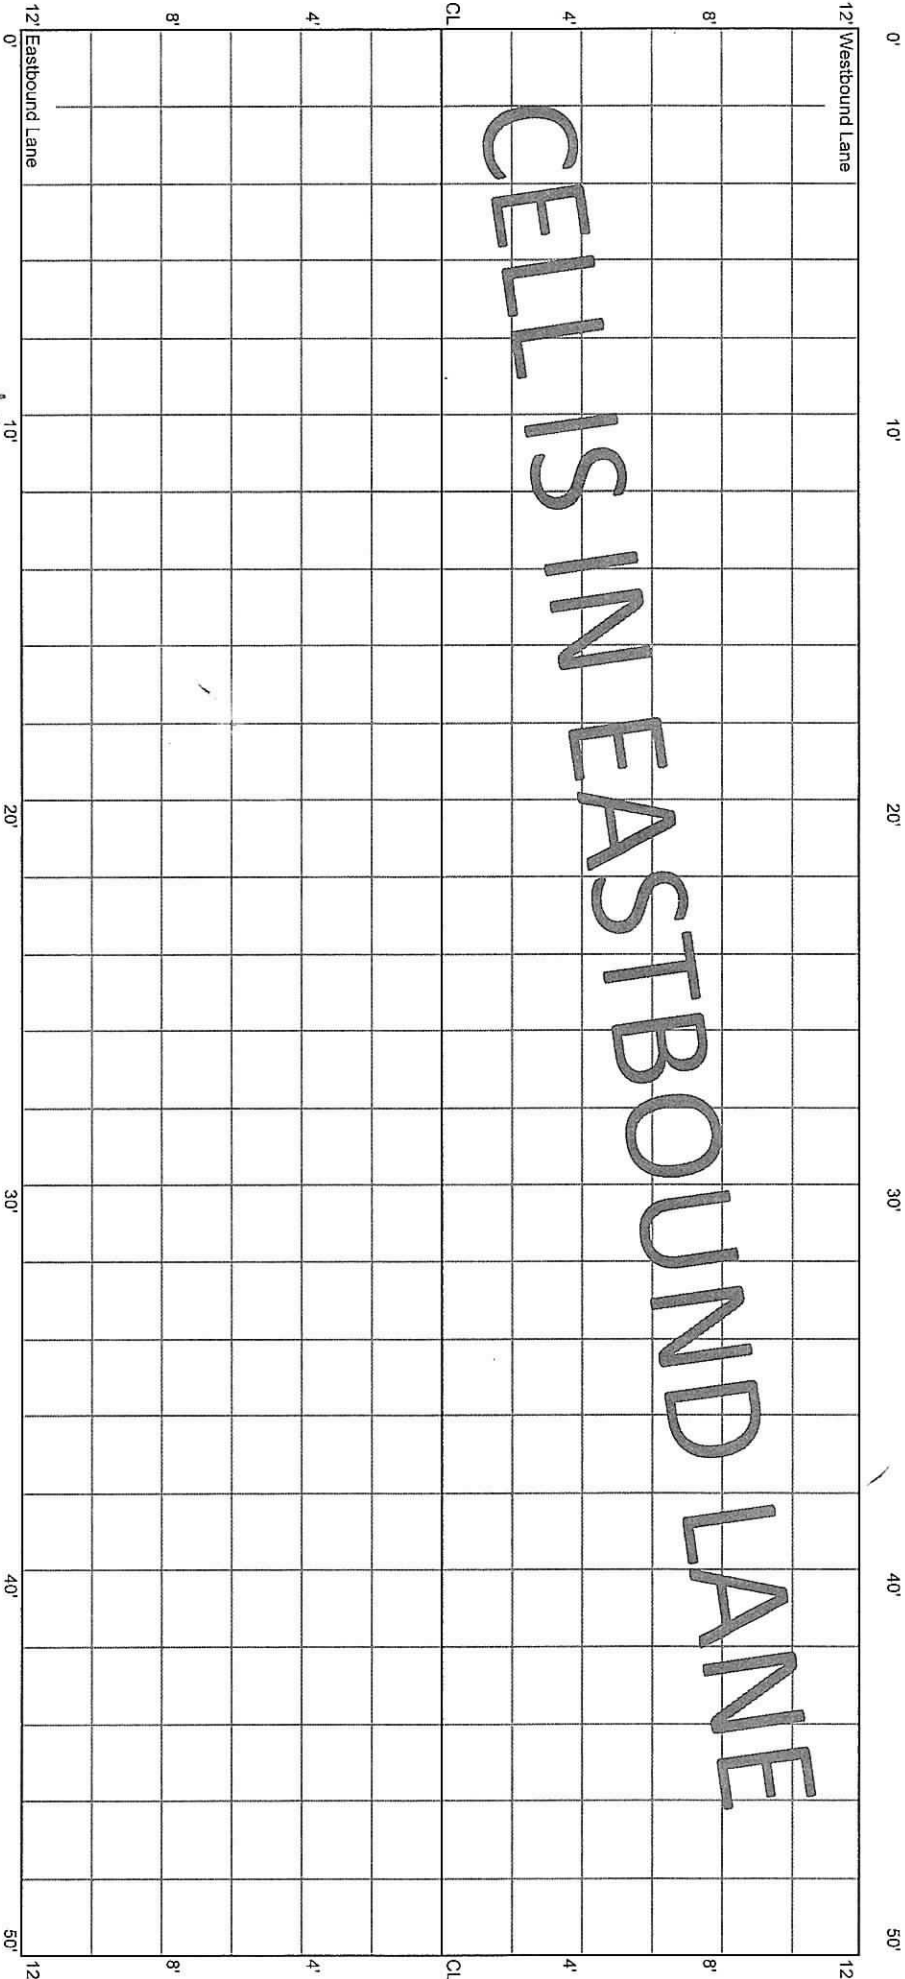


cut @ 150' on side of road

CELL 7004E
50 - 100 ft

17+00

17+50

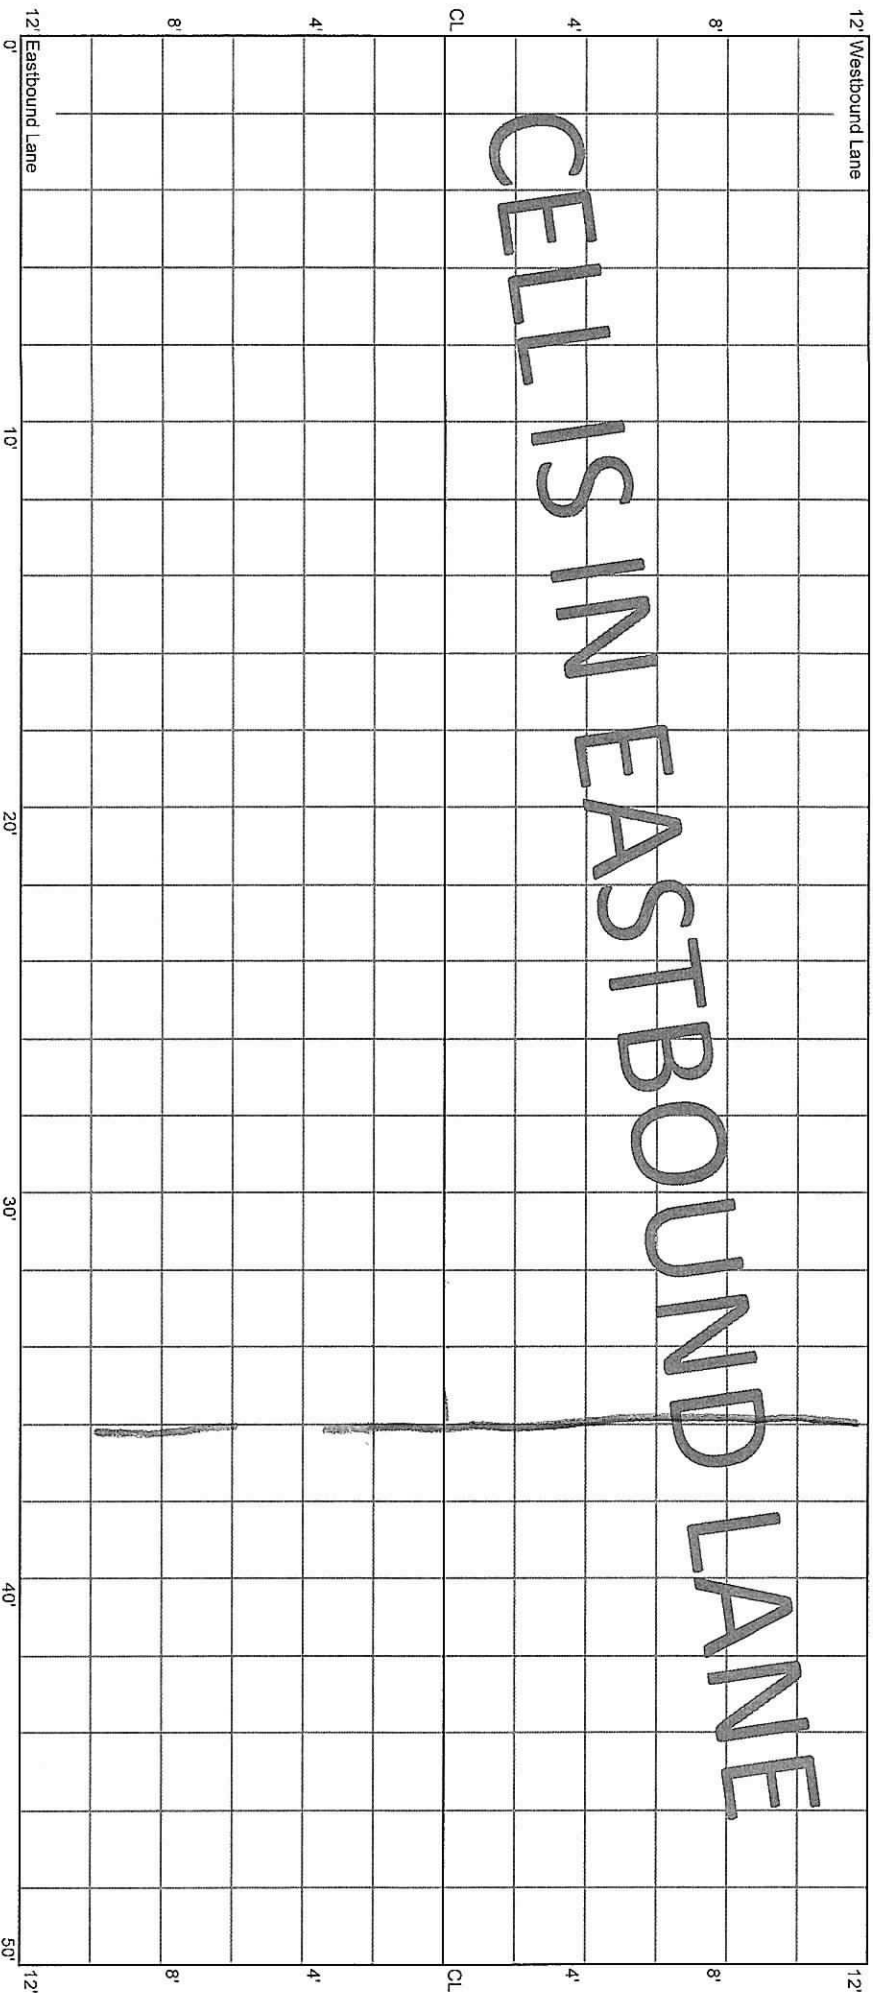

12' Westbound Lane

12' Eastbound Lane

0' 10' 20' 30' 40' 50'

0' 10' 20' 30' 40' 50'

12' 8' 4' CL 4' 8' 12'


12' 8' 4' CL 4' 8' 12'

CELLS IN EASTBOUND LANE

CELL 7004E
100 - 150 ft

17+50


18+00

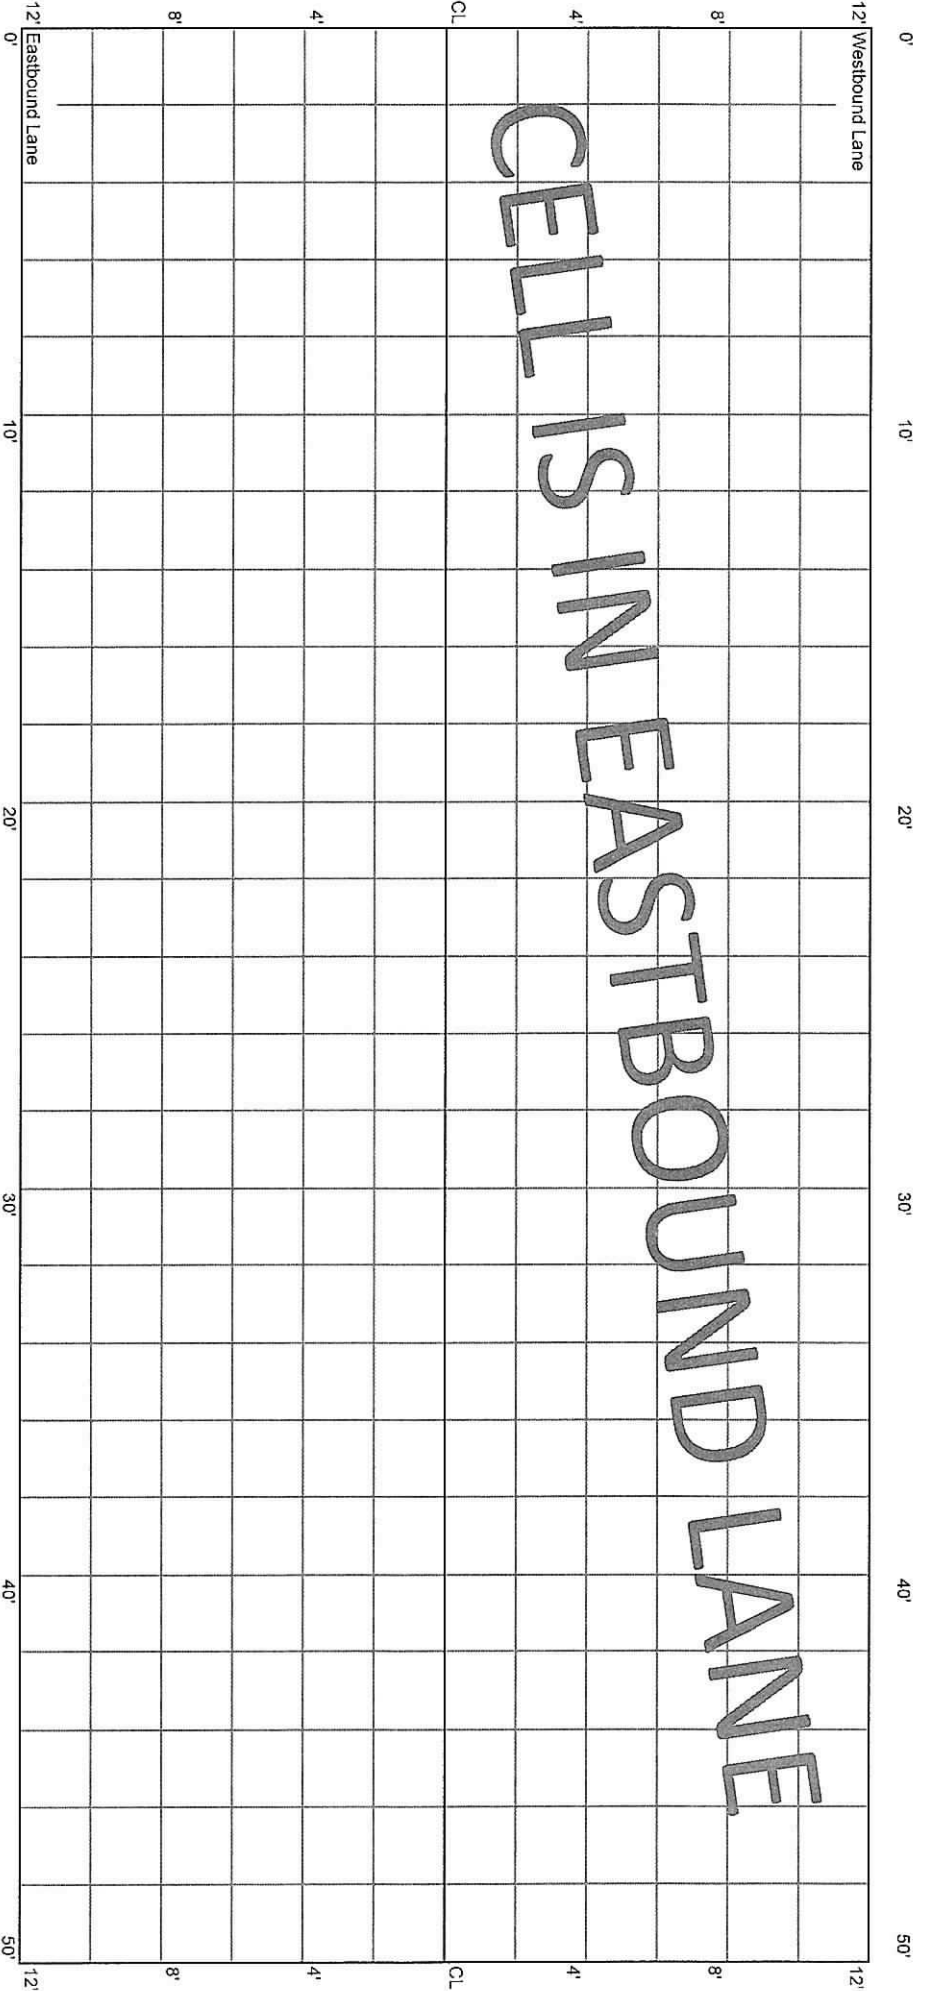

12' Westbound Lane

12' Eastbound Lane

CELL 7004E
150 - 200 ft

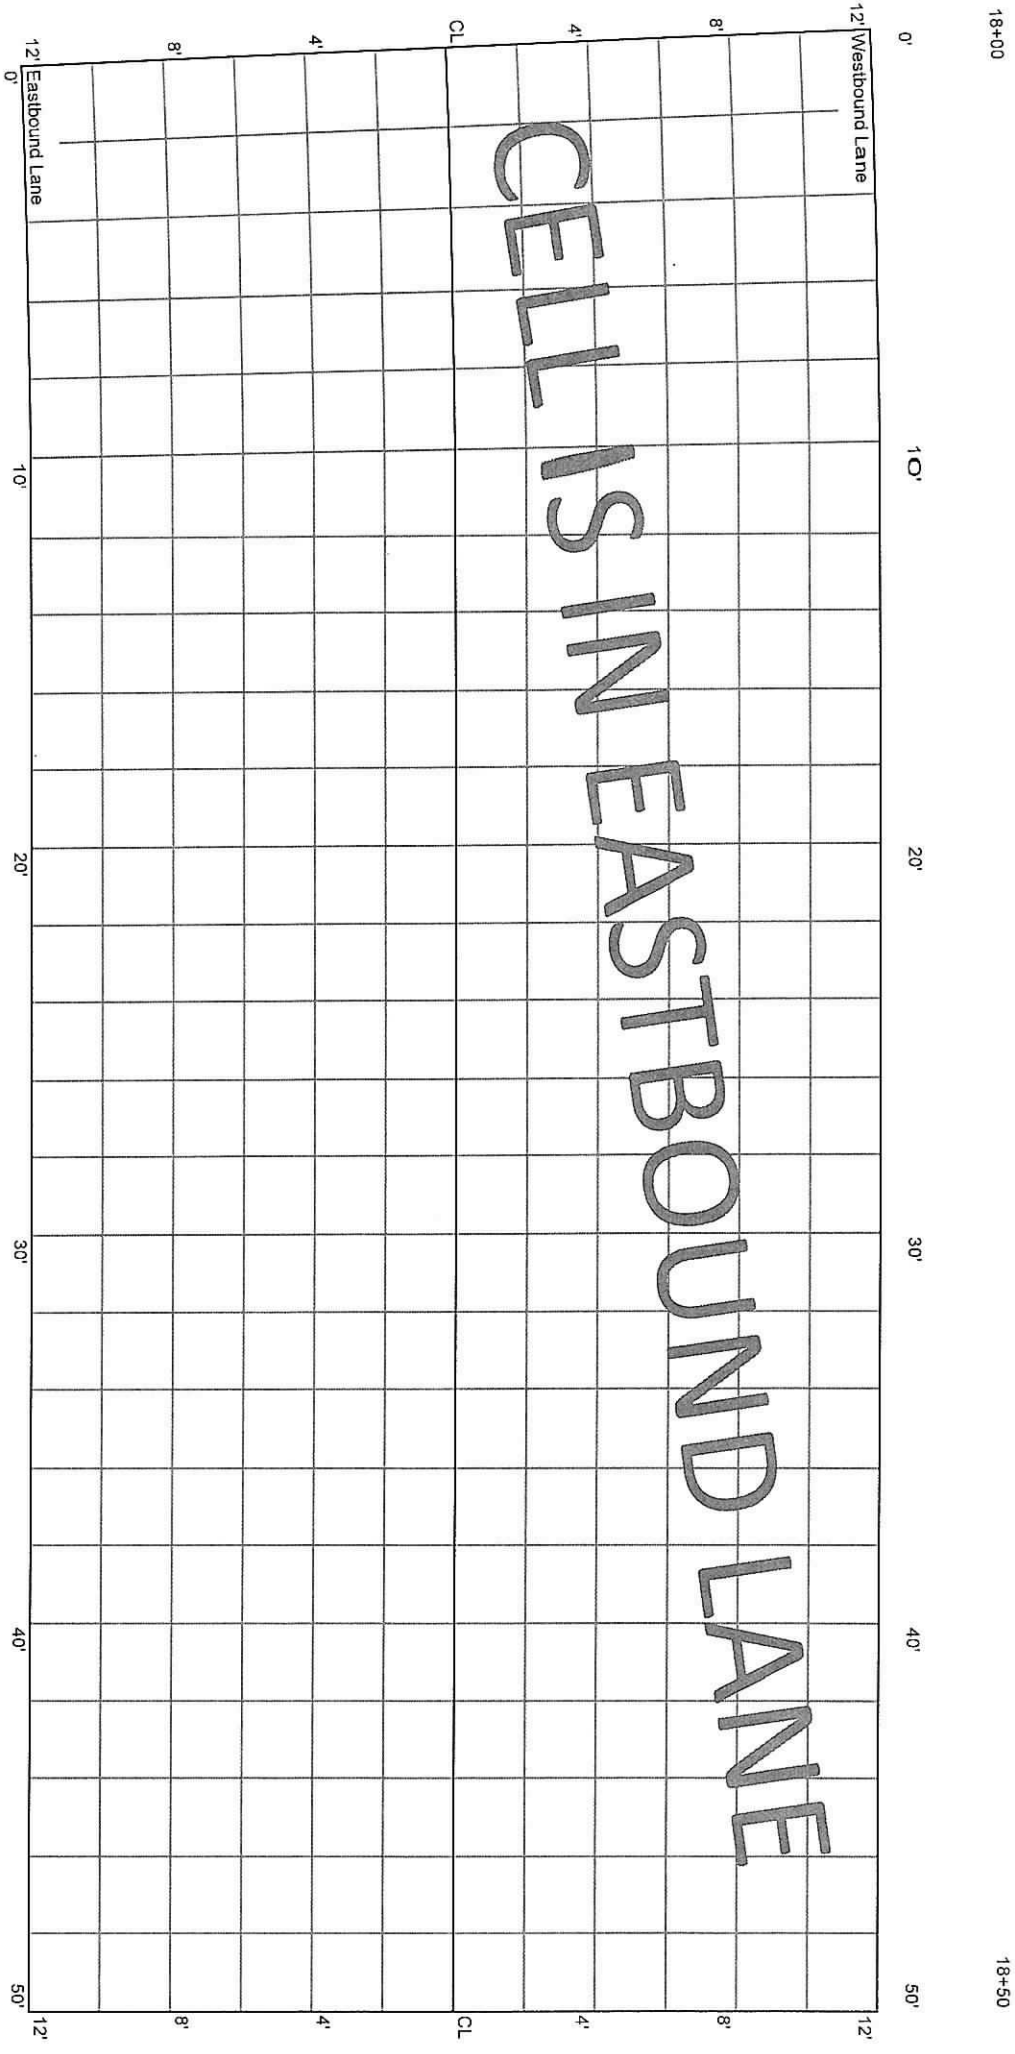


18+00

18+50

CELL 7004E
200 - 250 ft

18+50


19+00

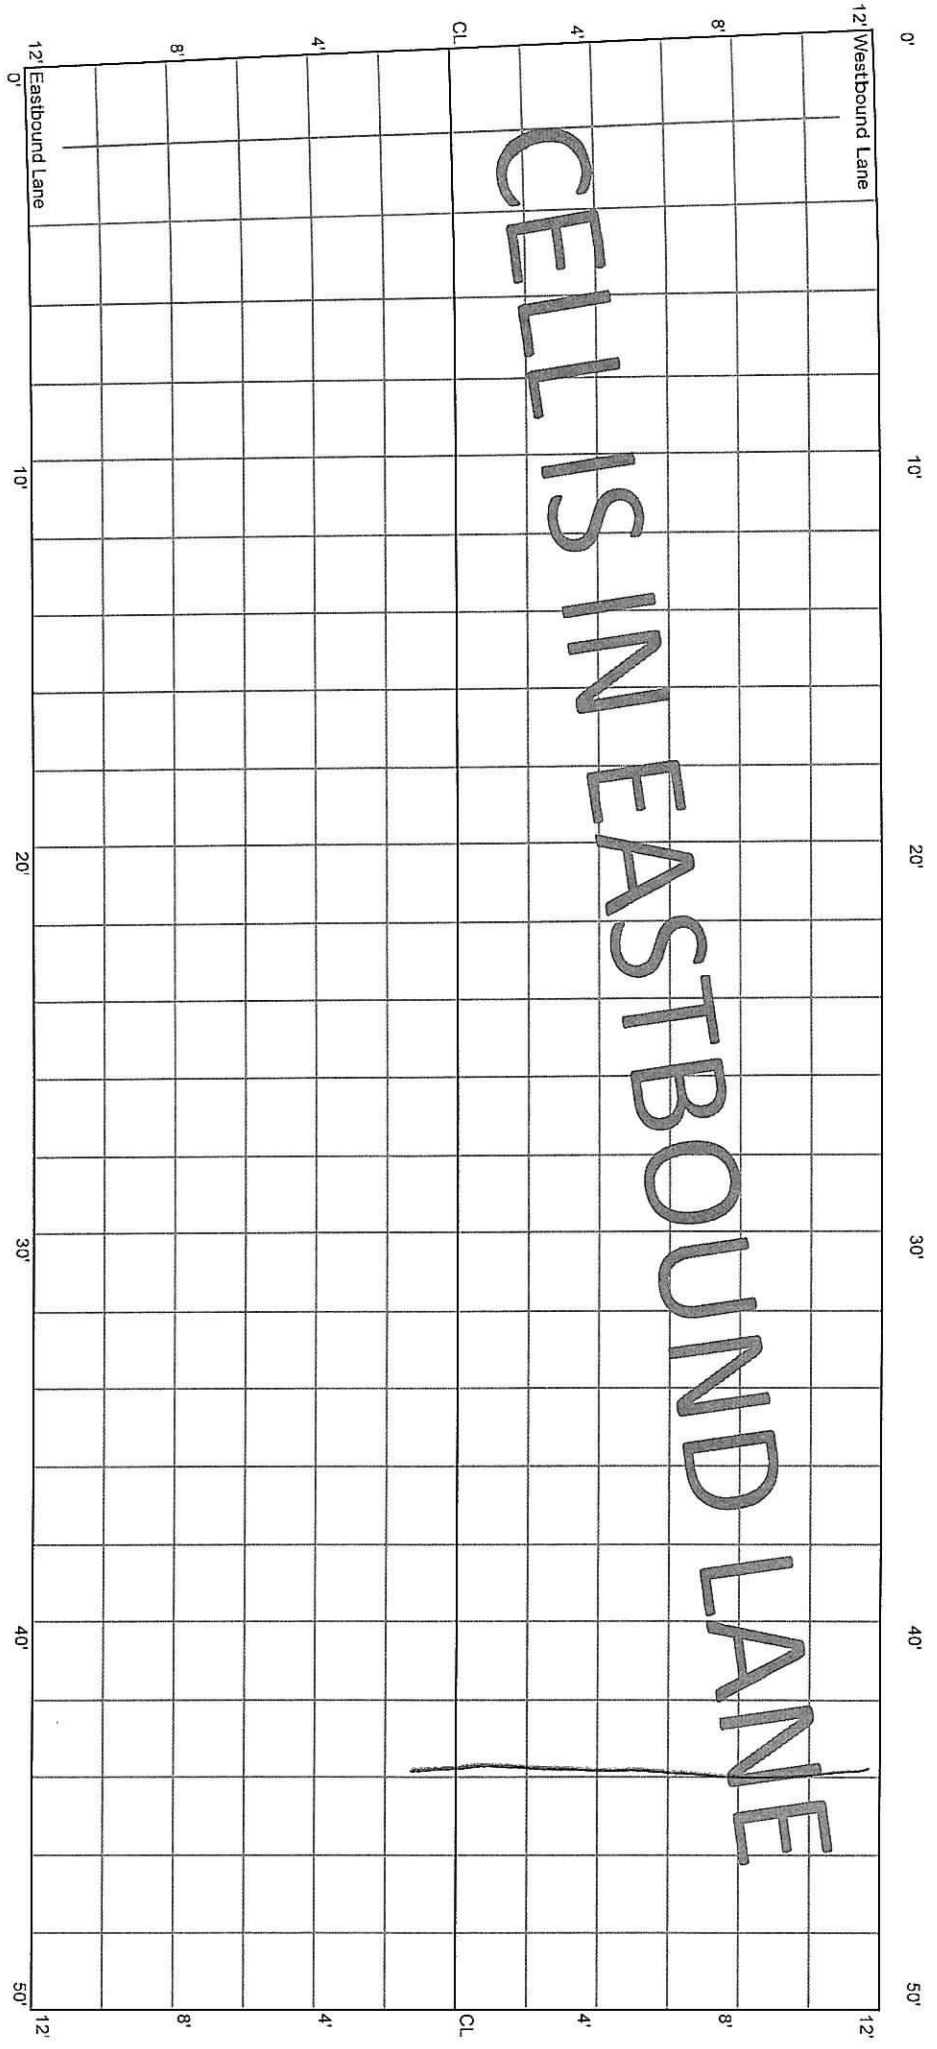

CELL 7004E
250 - 300 ft

19+00


19+50

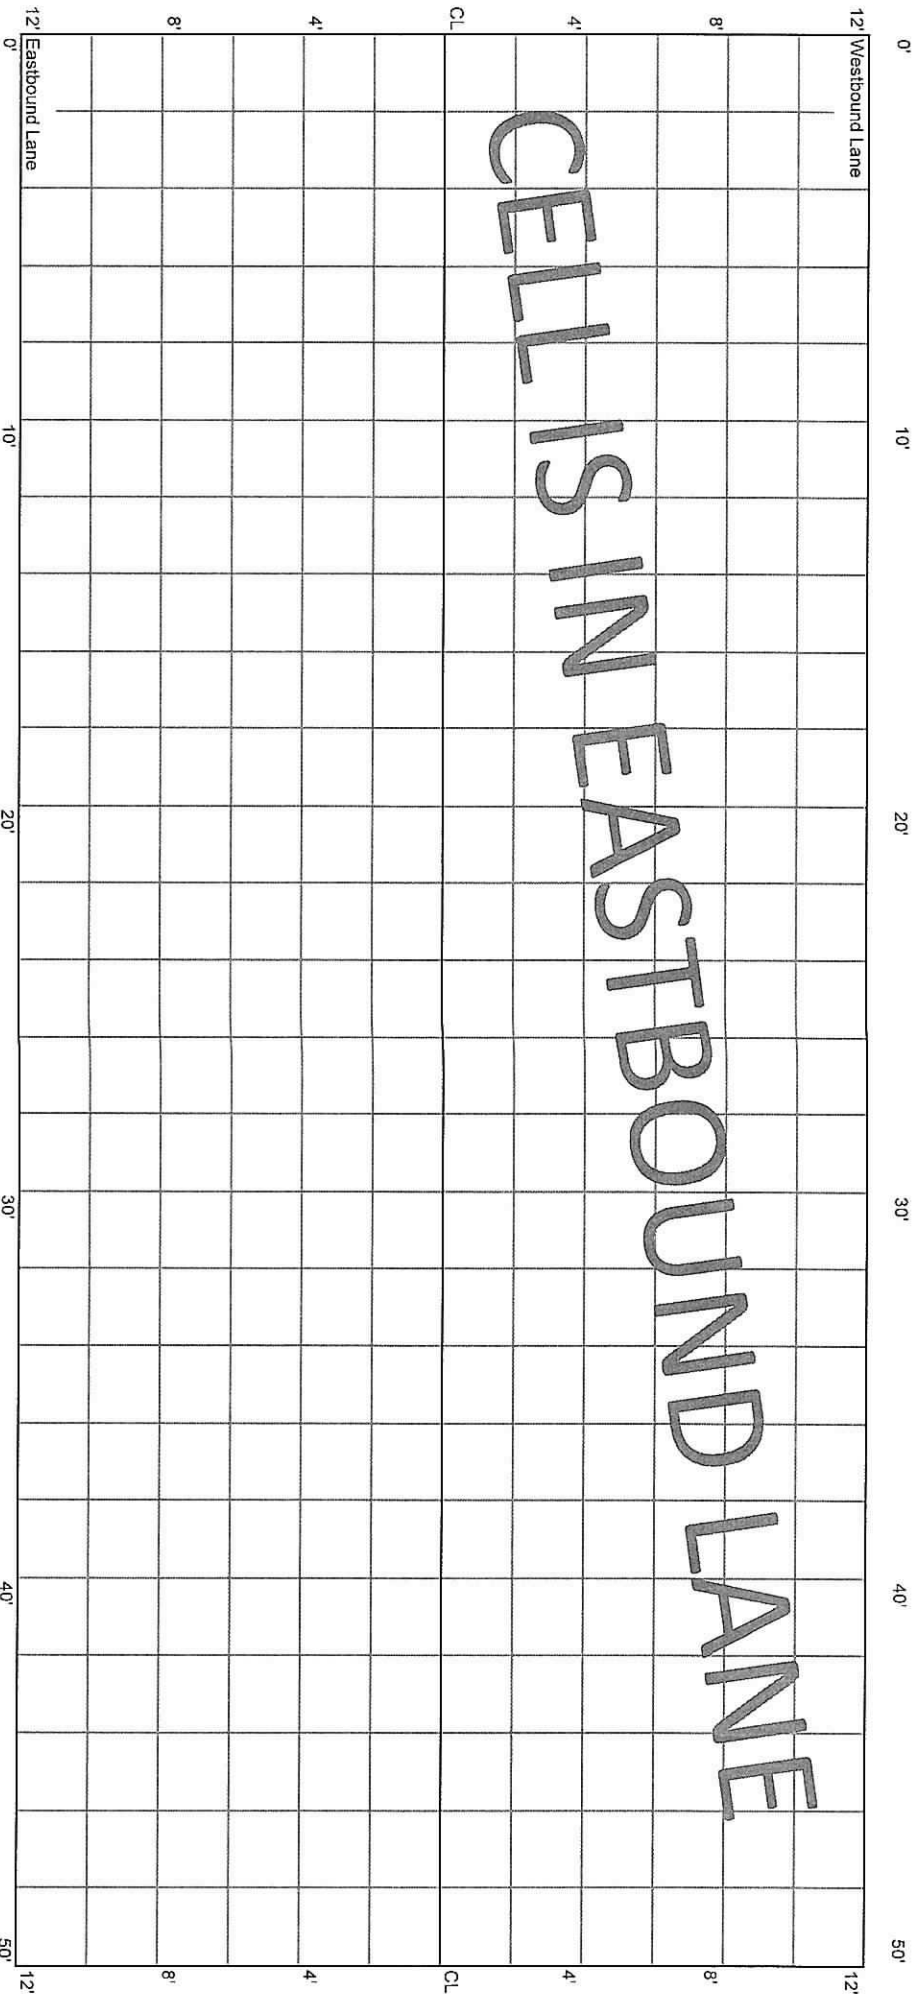

CELL 7004E
300 - 350 ft

19+50


20+00

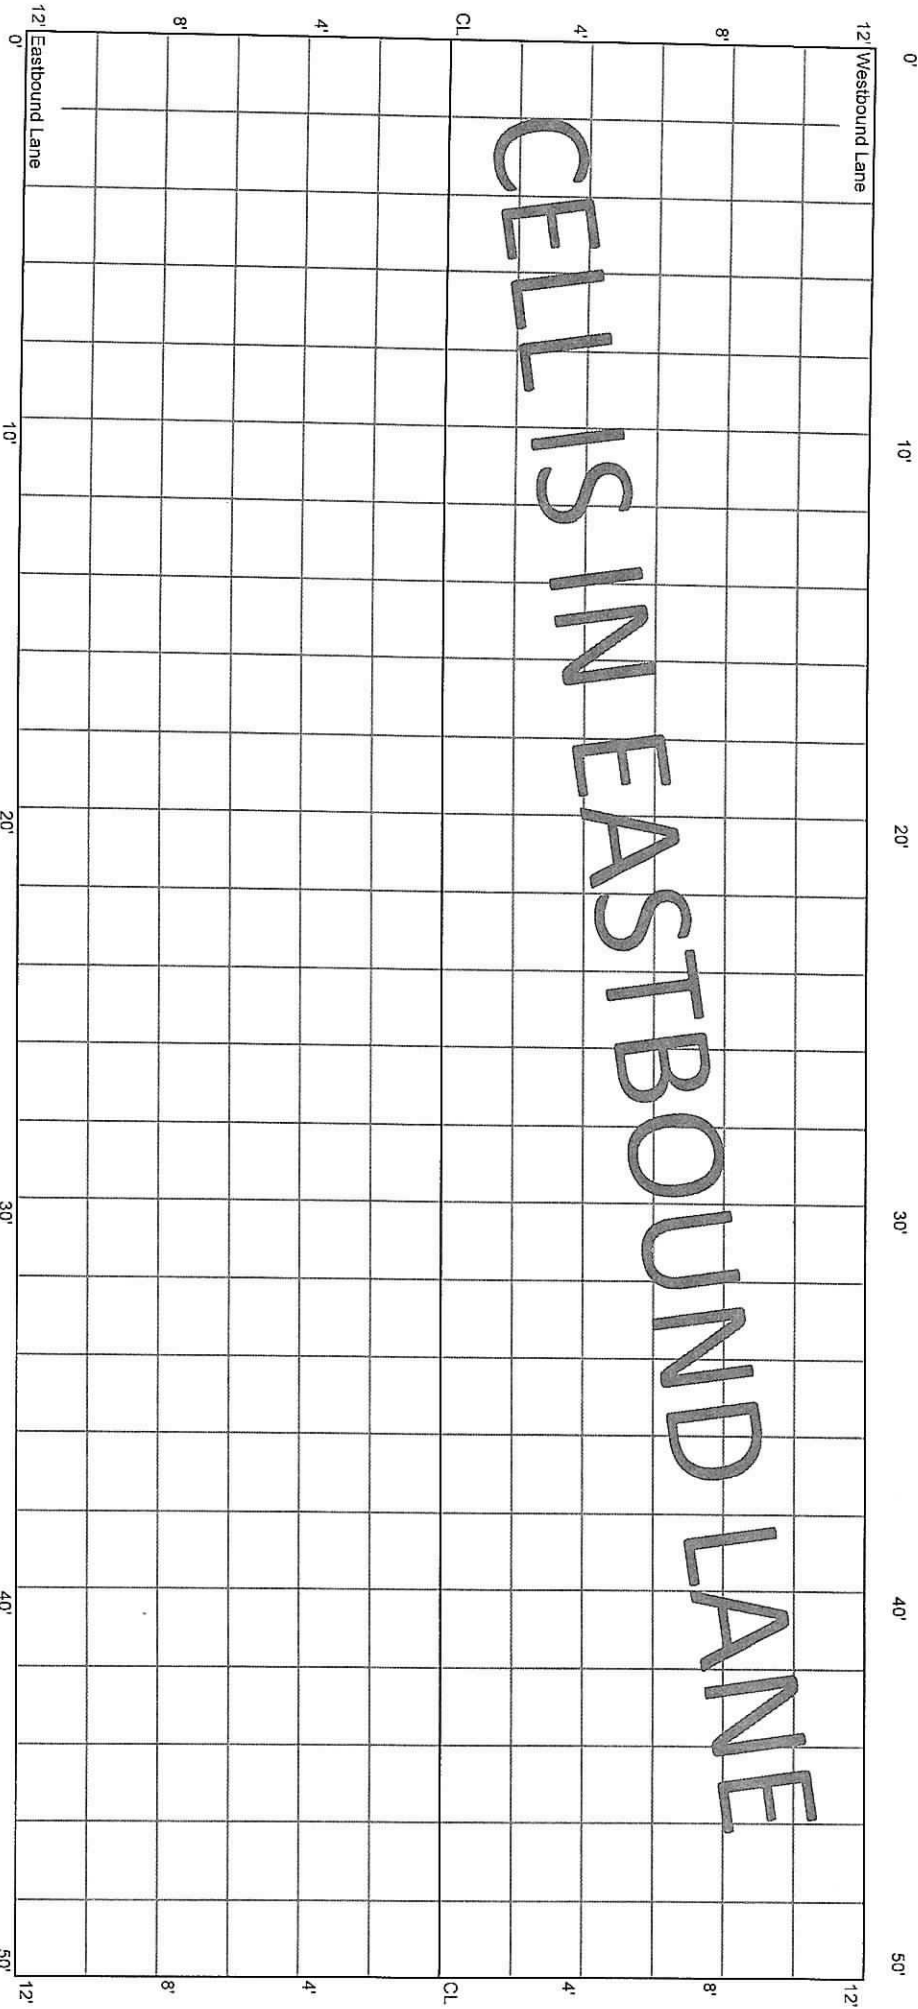

CELL 7004E
350 - 400 ft

20+00


20+50

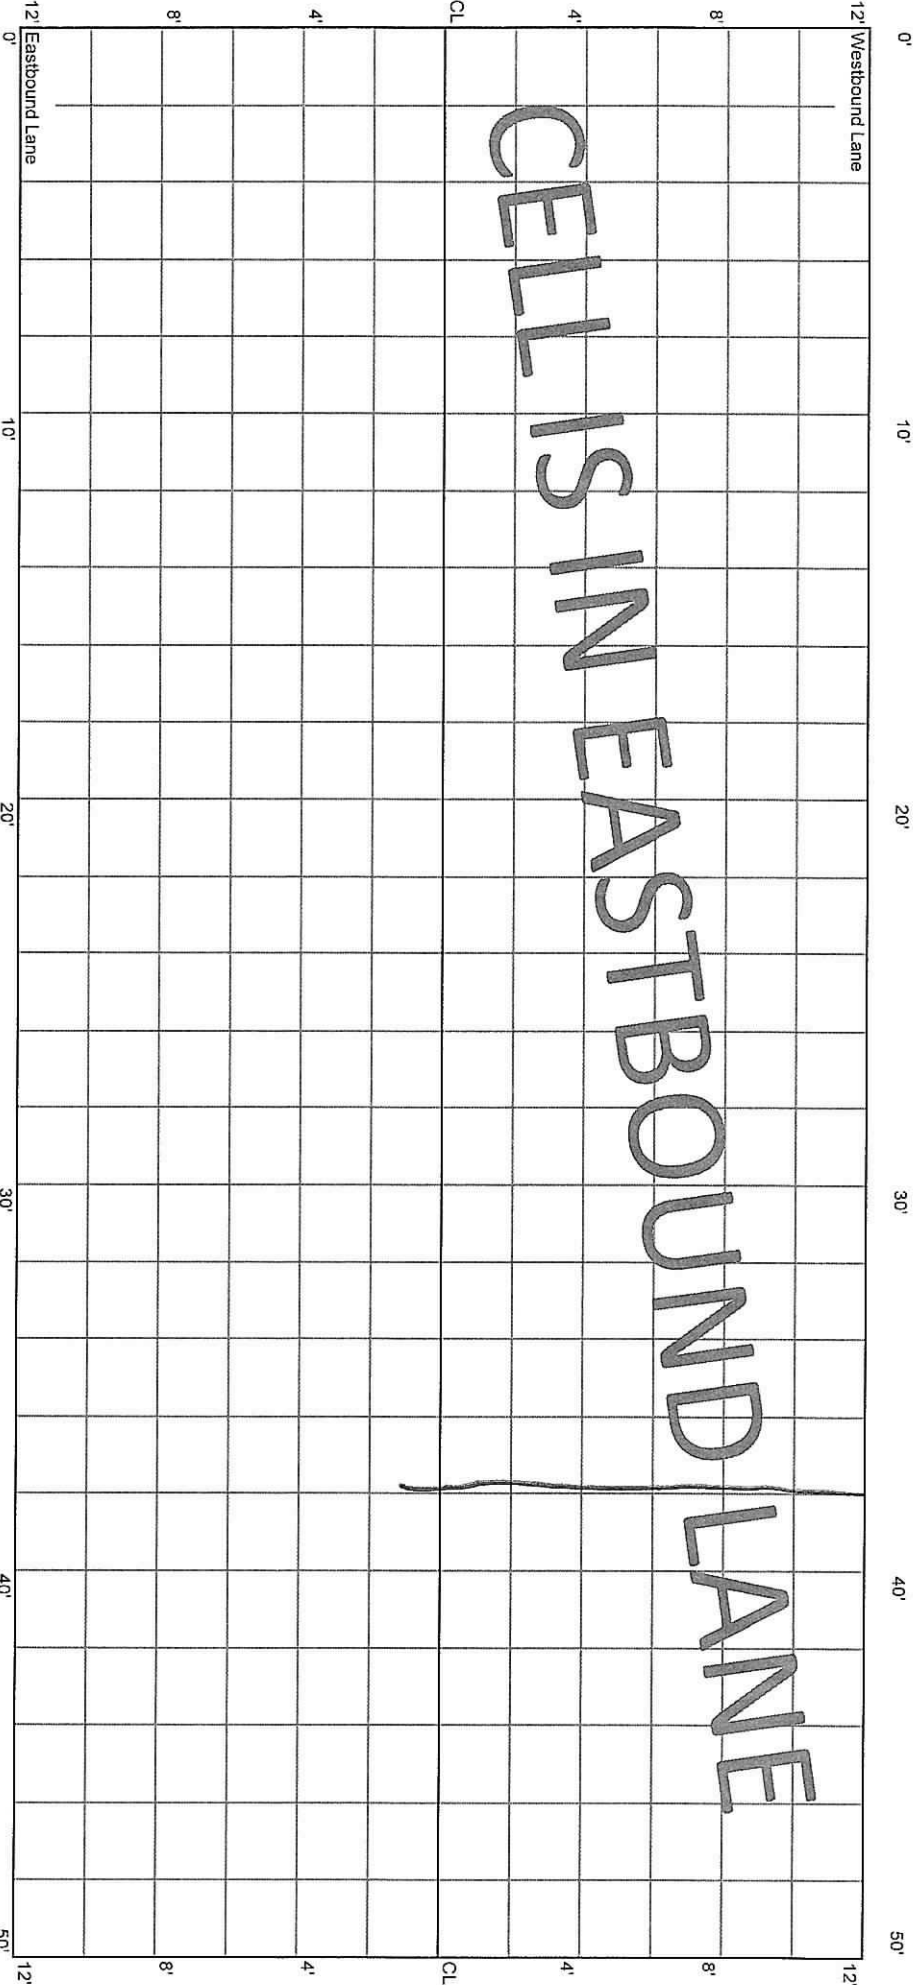


CELL 7004E
400 - 450 ft

20+50

21+00

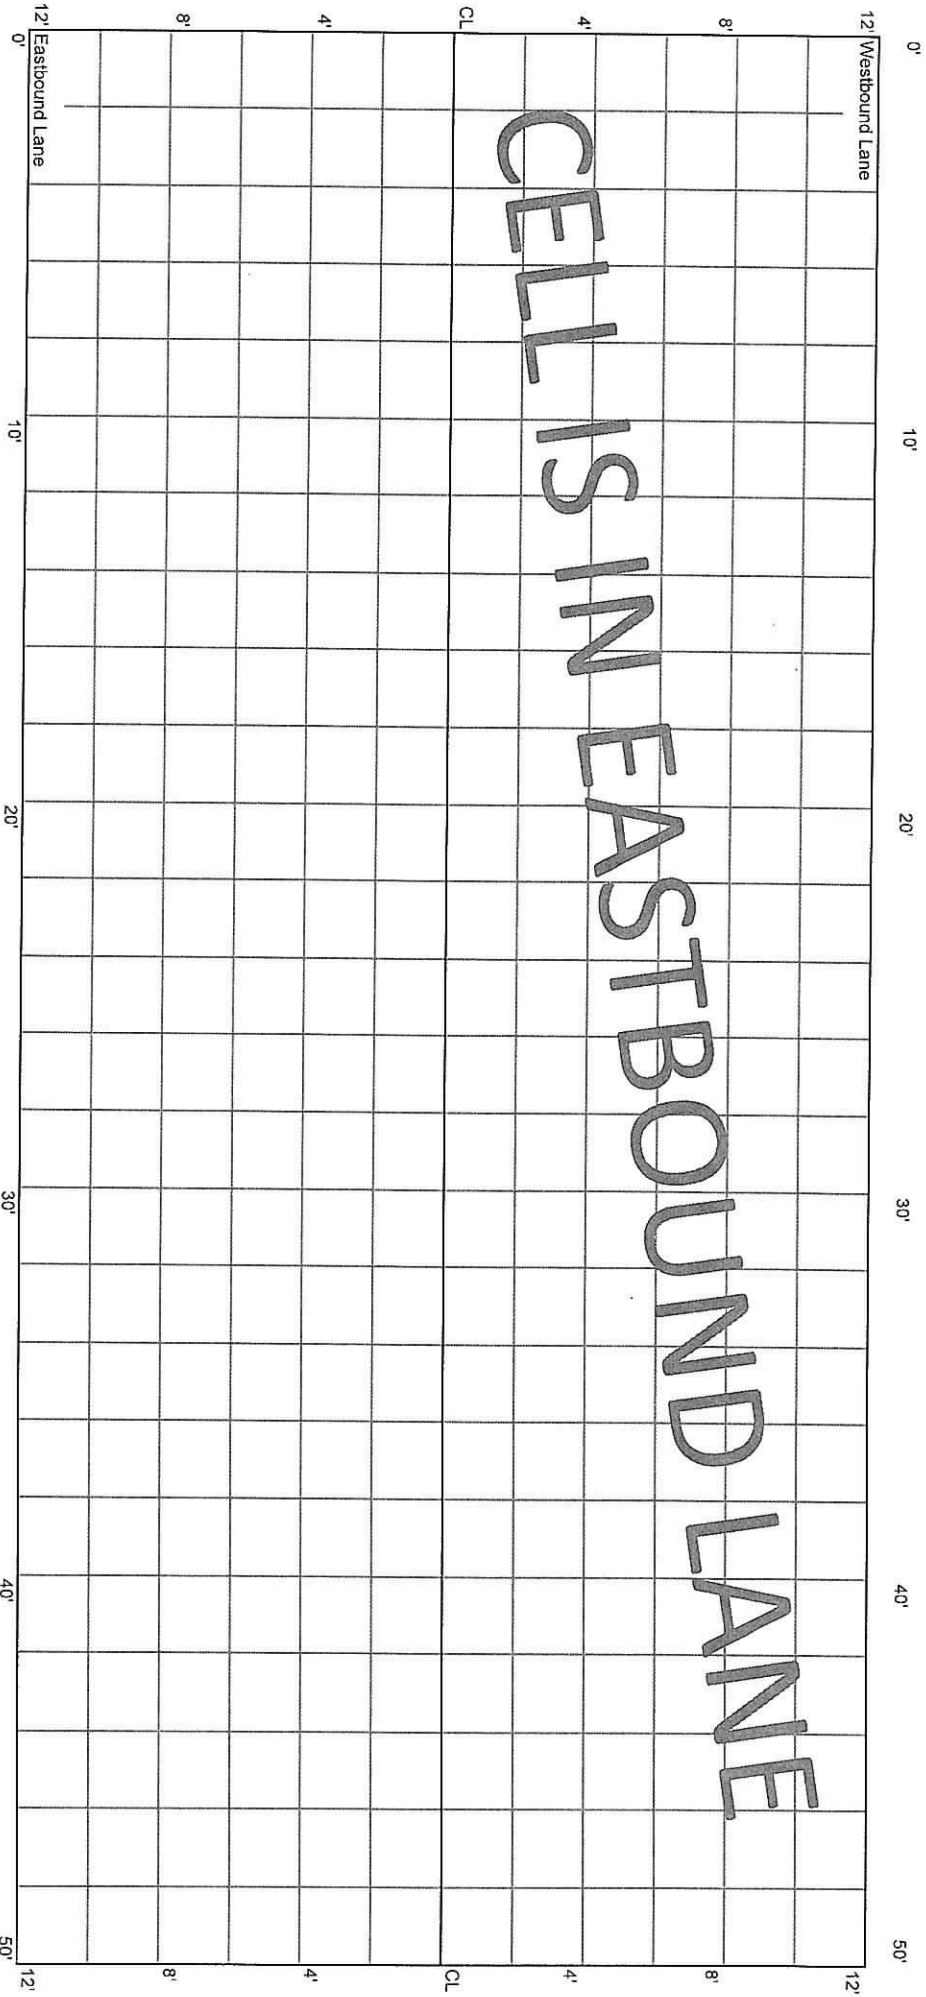

CELL 7004E
450 - 500 ft

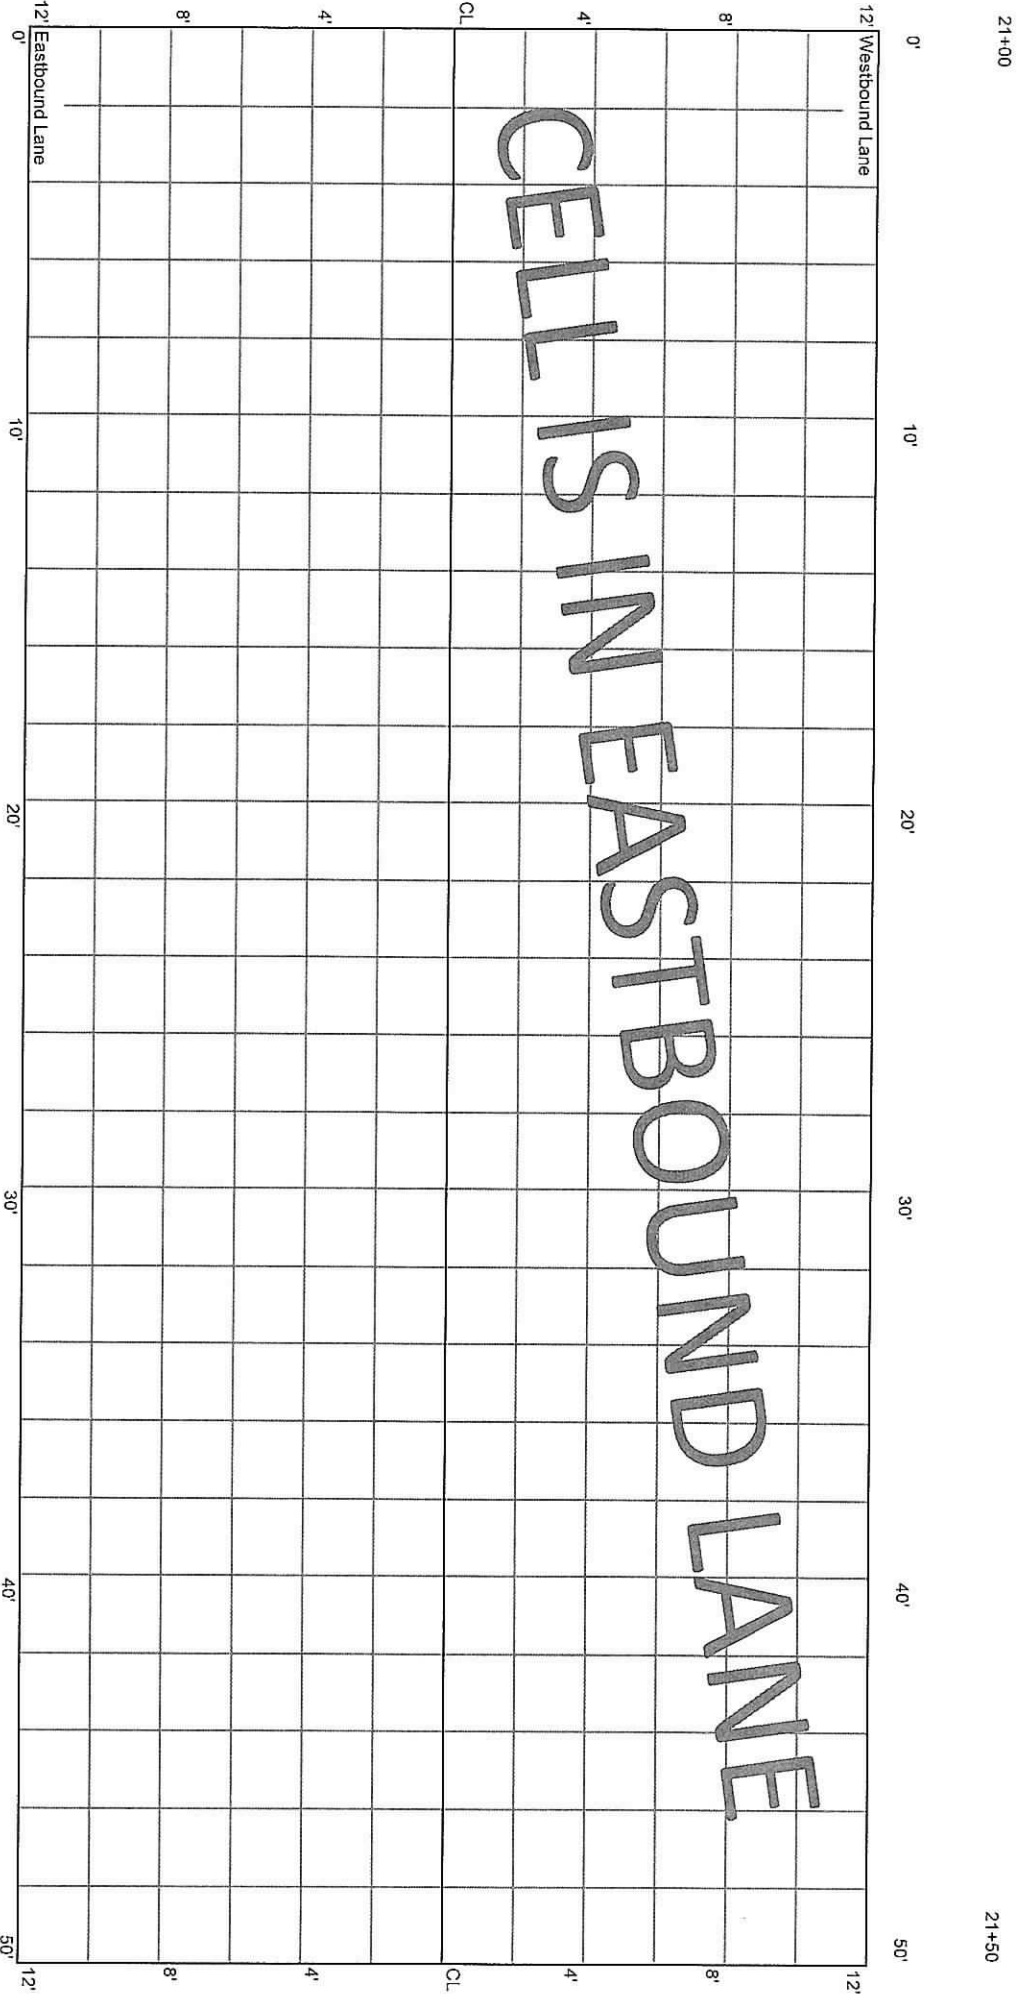

CELL 7004E
500 - 550 ft

21+50

16+25

22+00

