


5.28.20 E.S.

File 70TH ST

CELL 7005E
0 - 50 ft

22+00

22+50

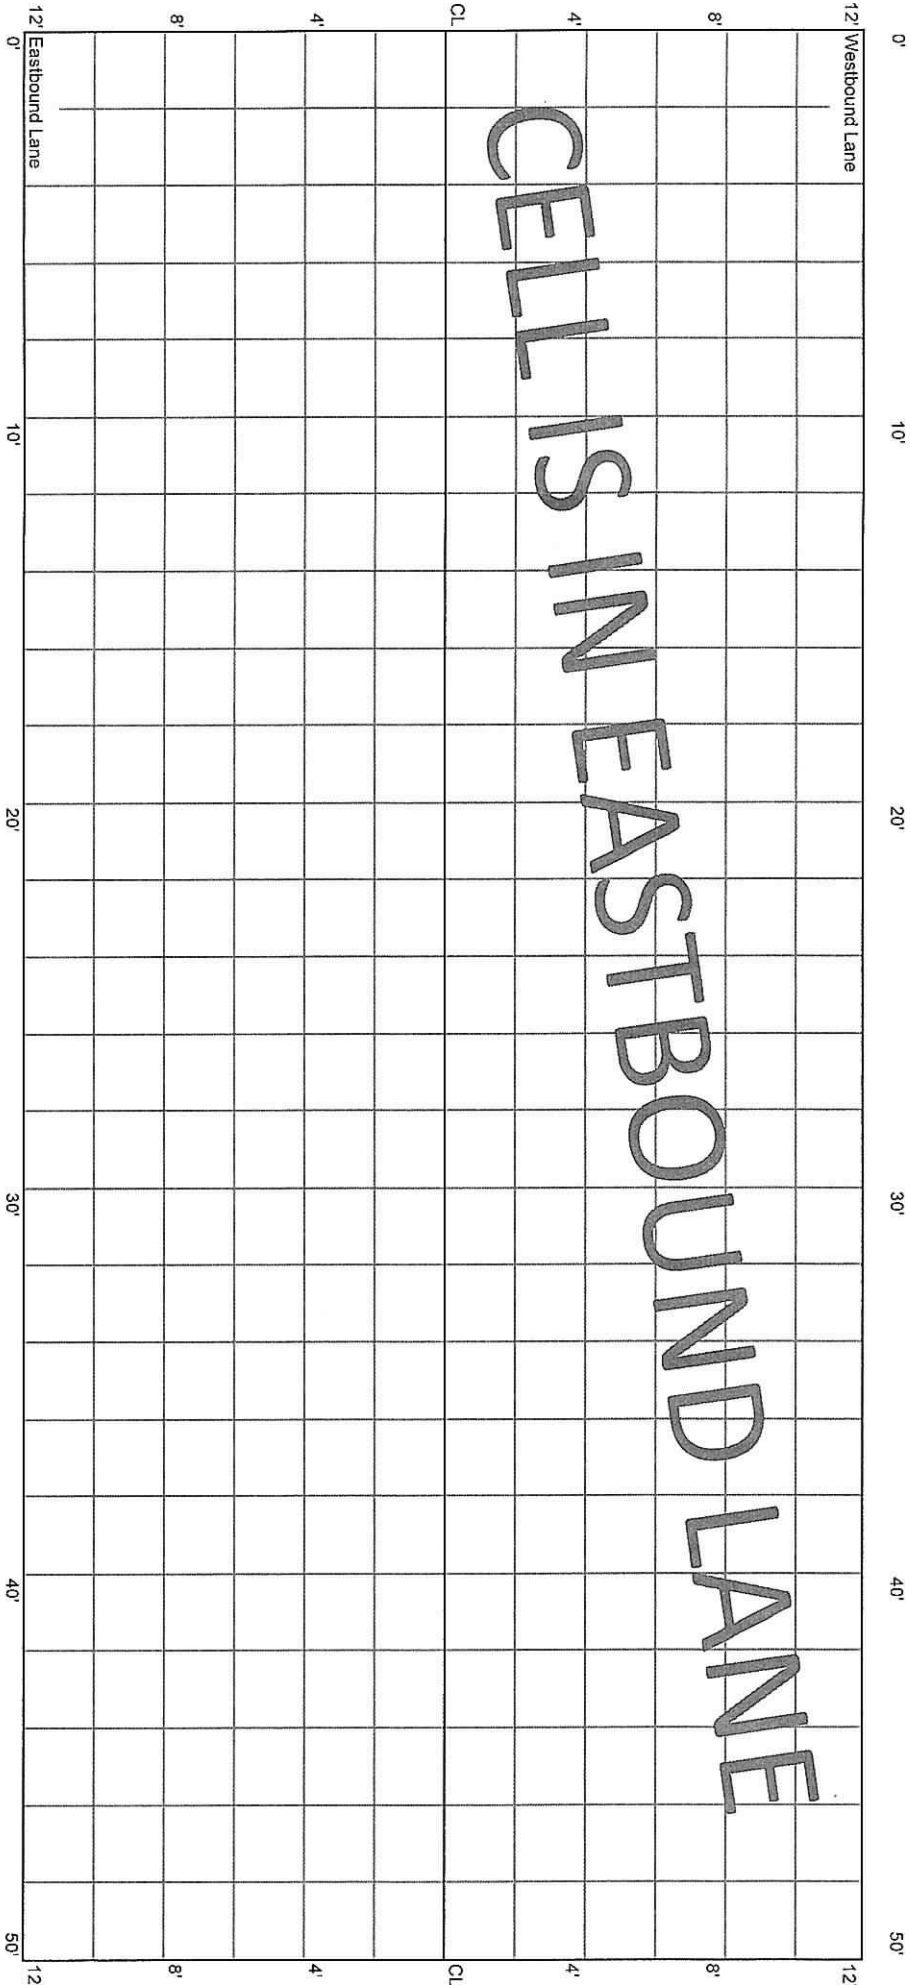


*Red on file
S.L.*

CELL 7005E
50 - 100 ft

22+50


23+00

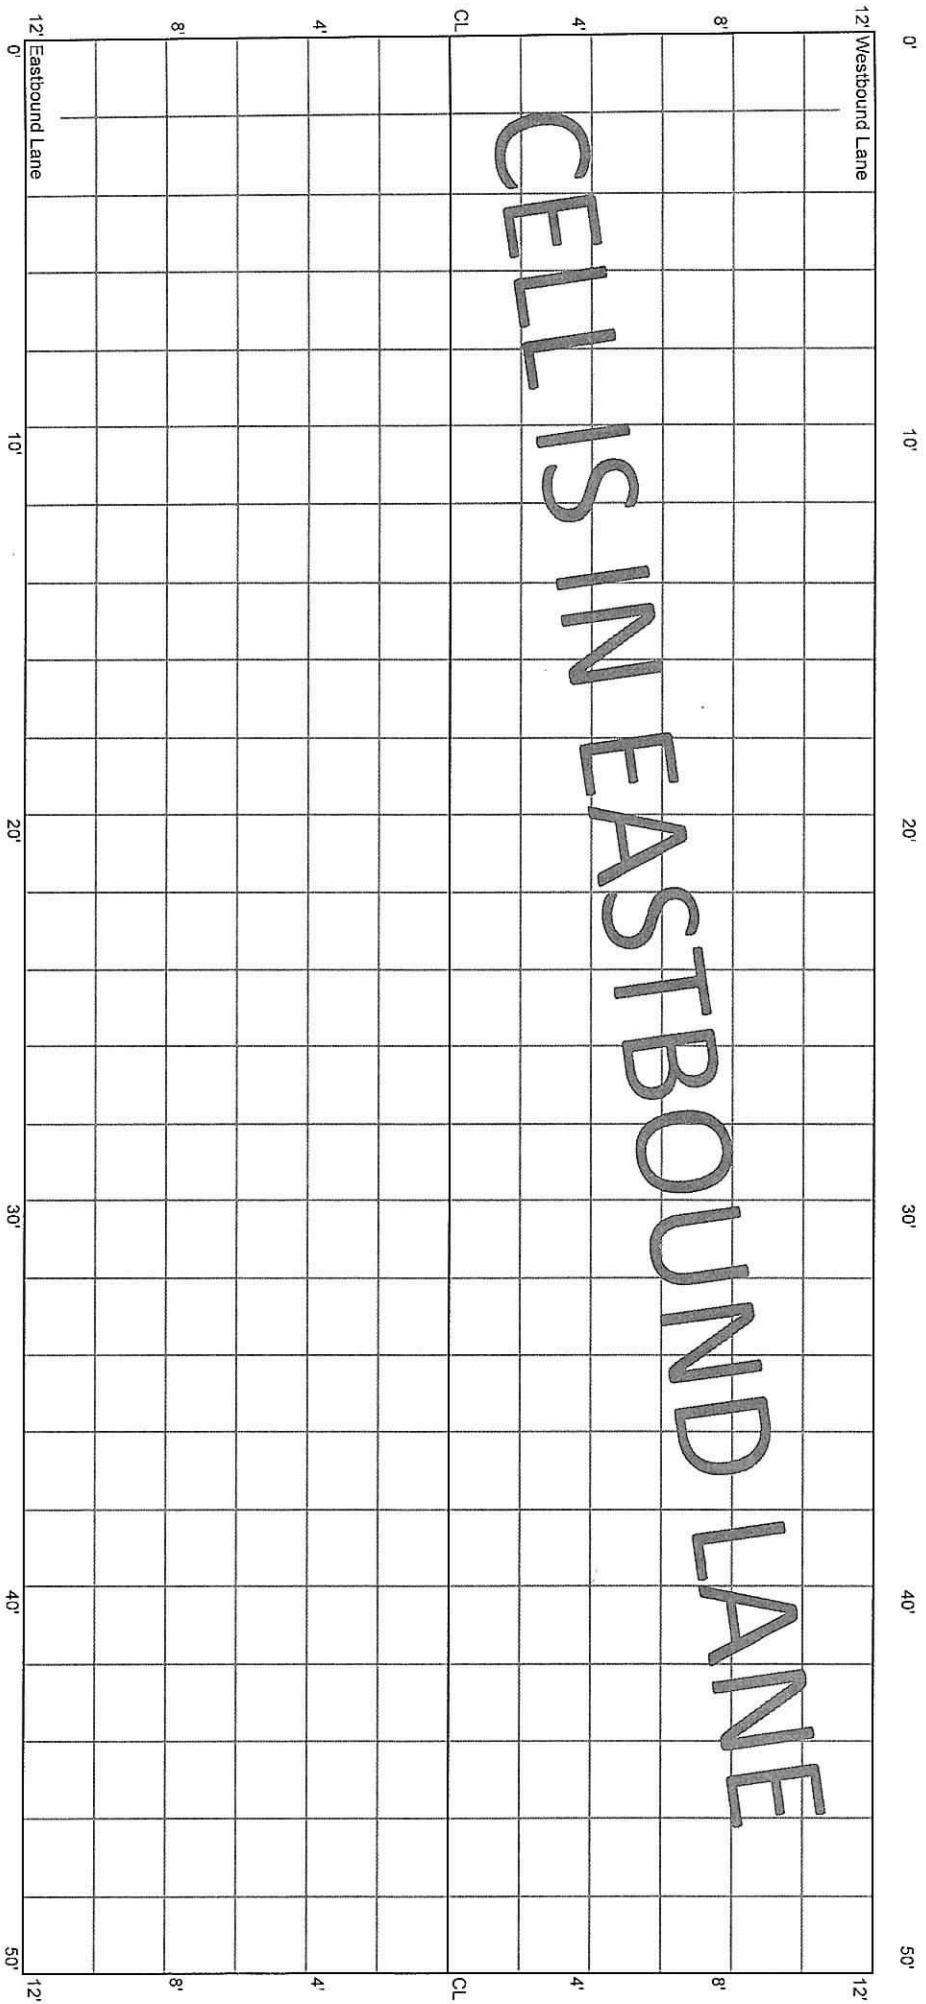

CELL 7005E
100 - 150 ft

23+00


23+50

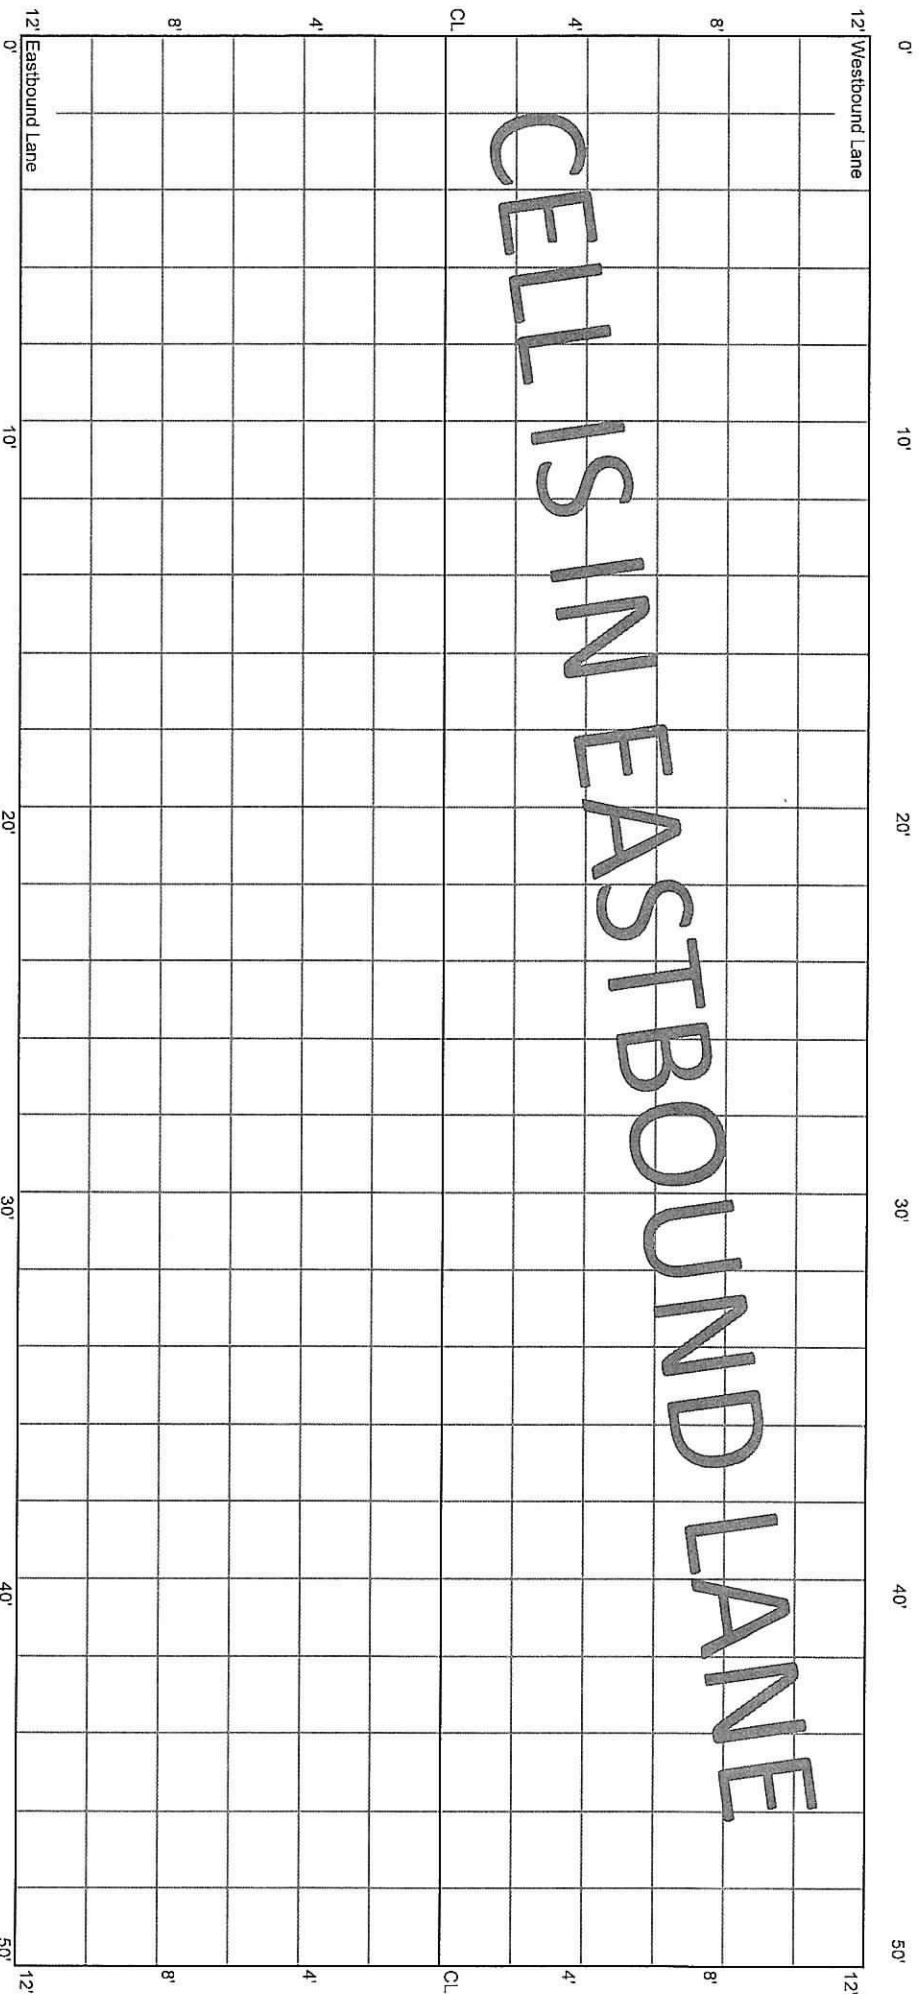

CELL 7005E
150 - 200 ft

23+50


24+00

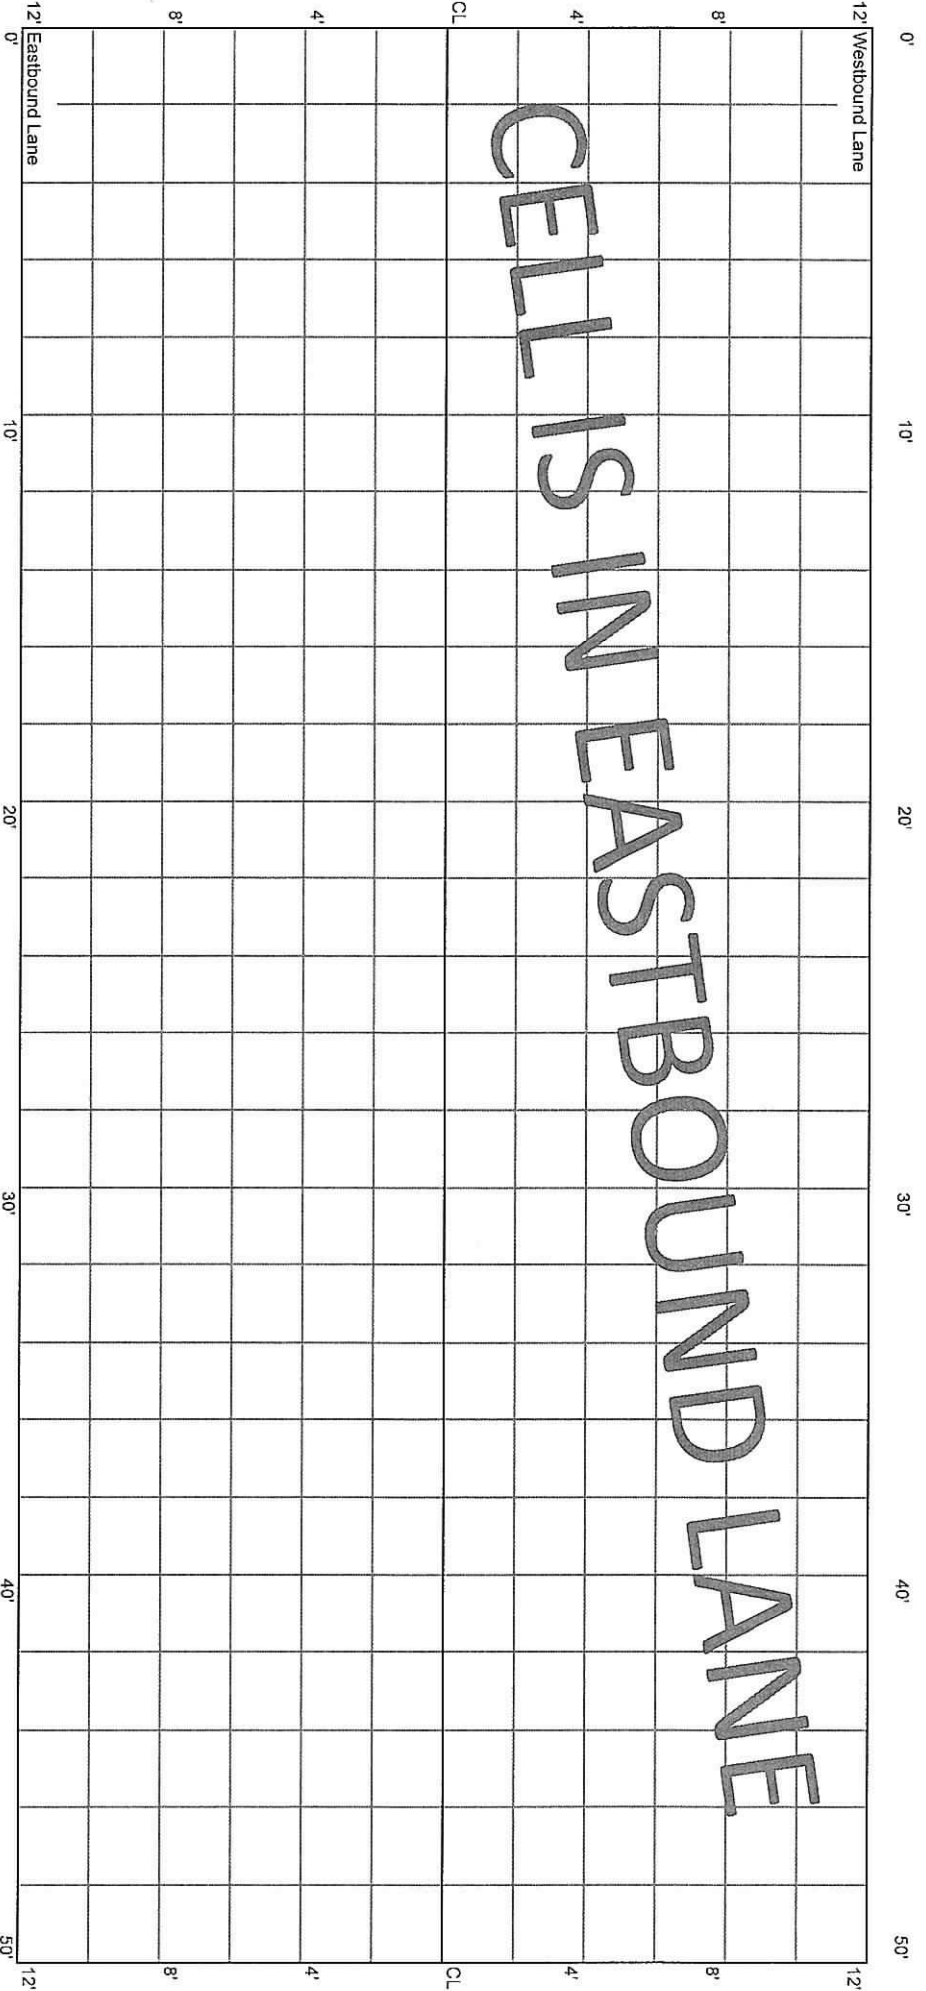

CELL 7005E
200 - 250 ft

24+00

24+50

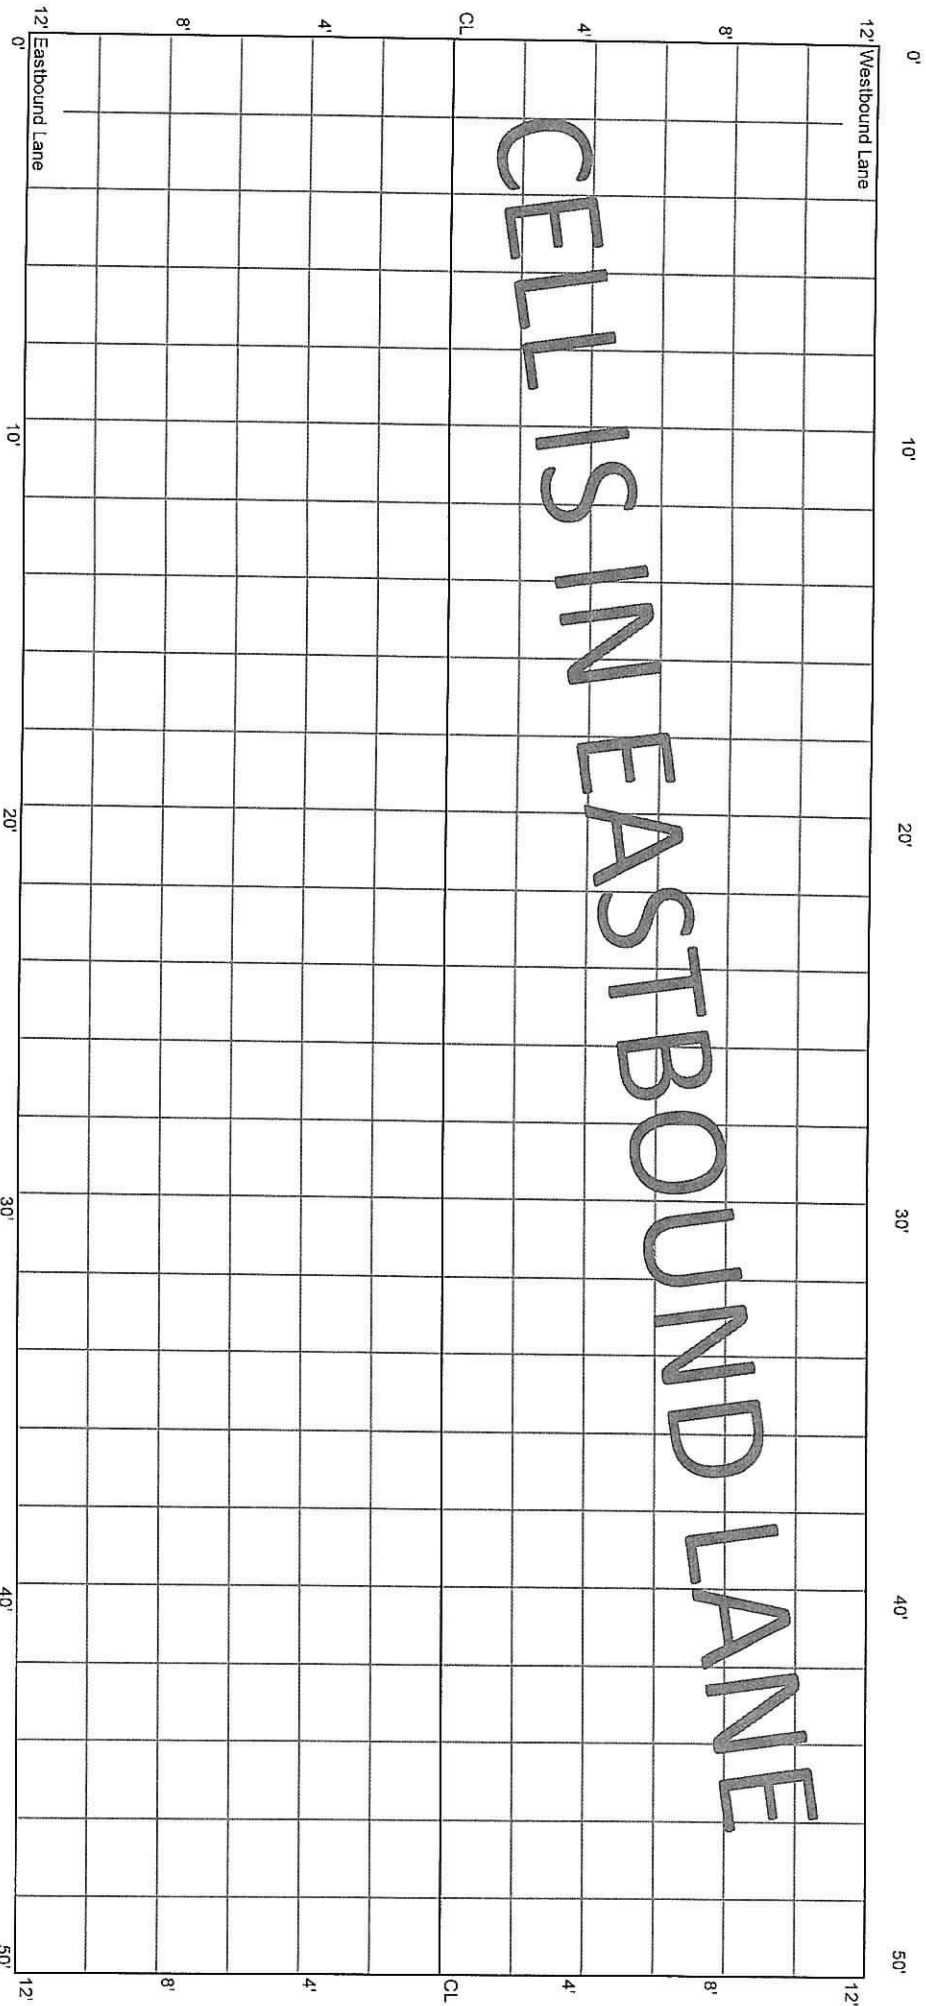


CELLS IN EASTBOUND LANE


CELL 7005E
250 - 300 ft

24+50


25+00

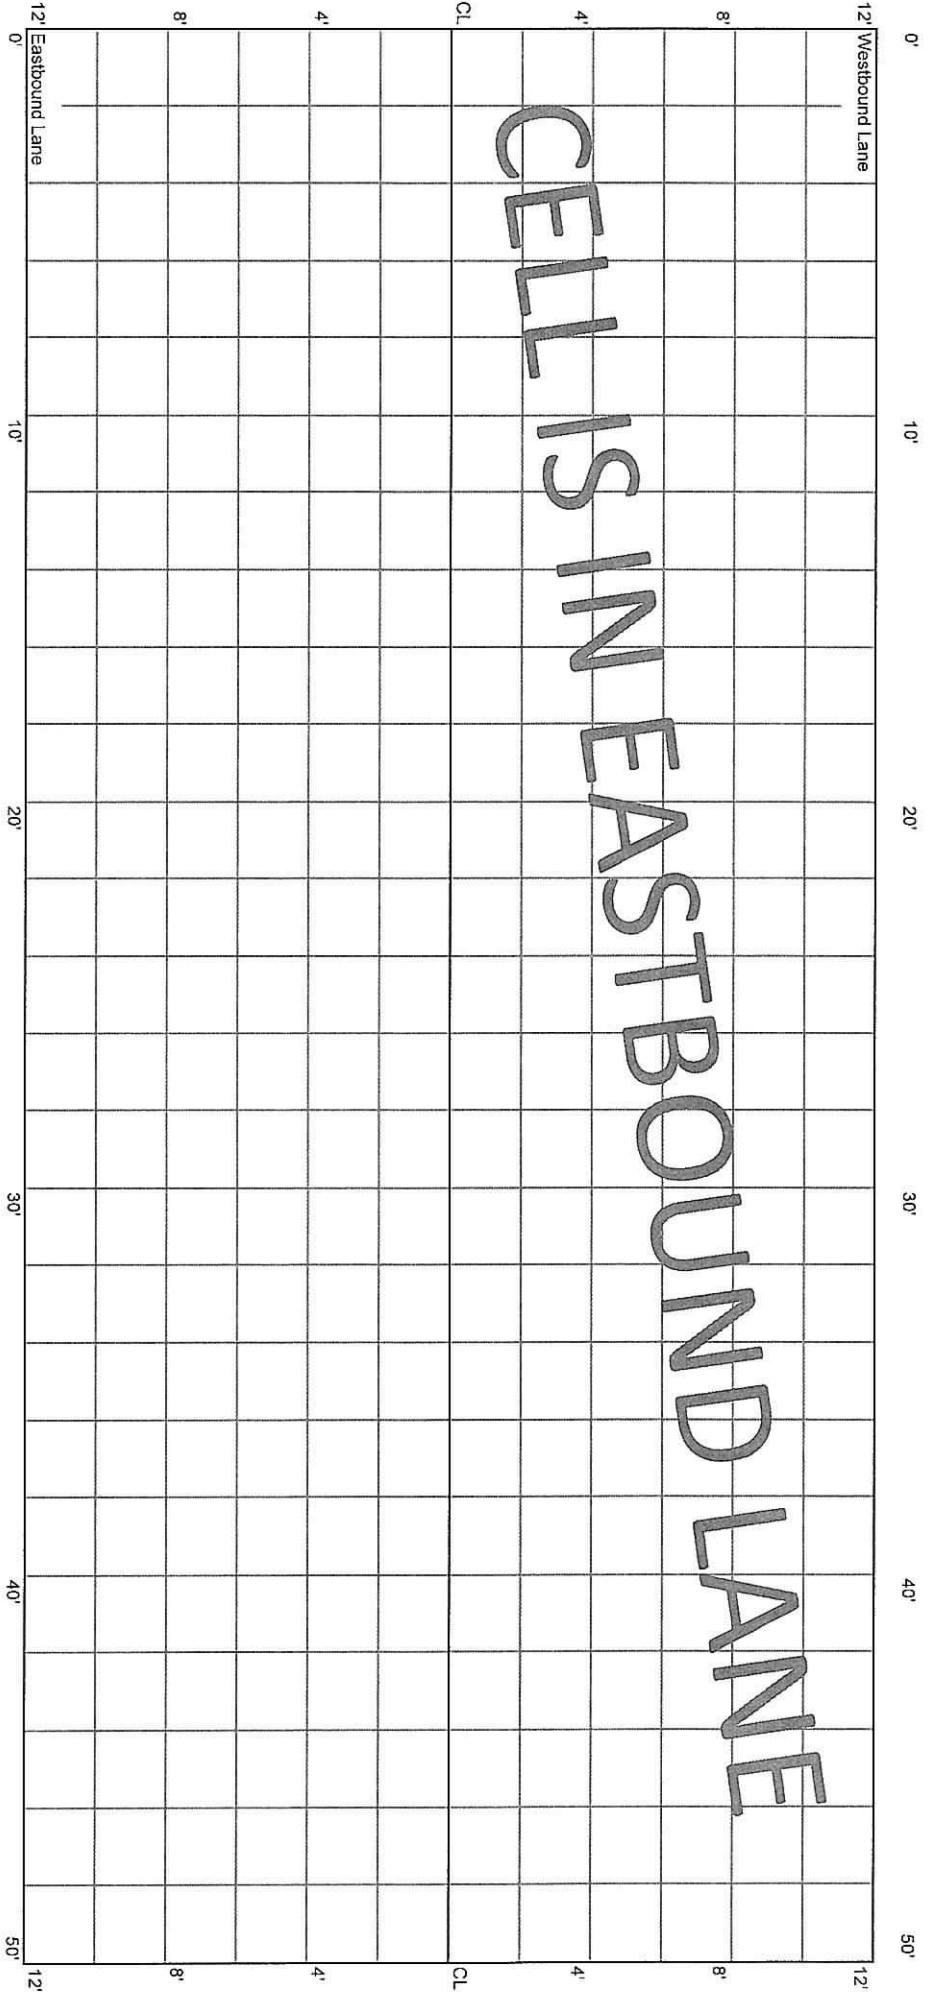

CELL 7005E
300 - 350 ft

25+00


25+50

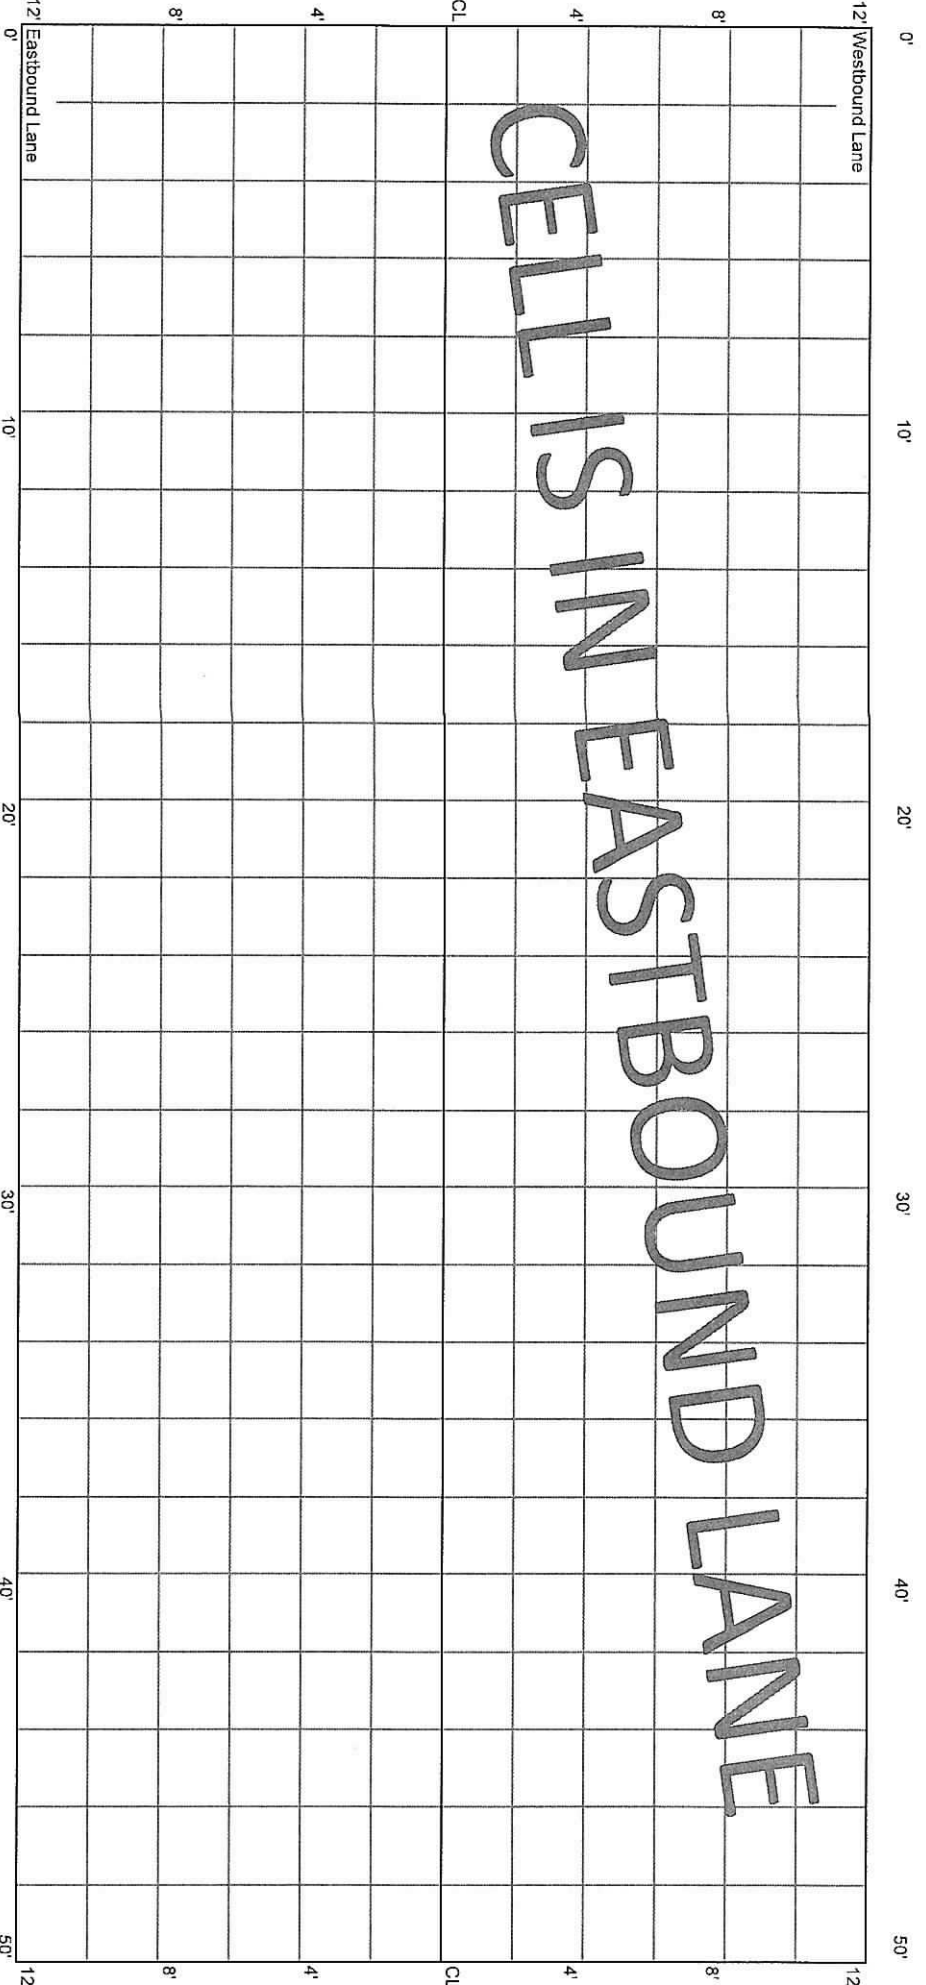

CELL 7005E
350 - 400 ft

25+50


26+00

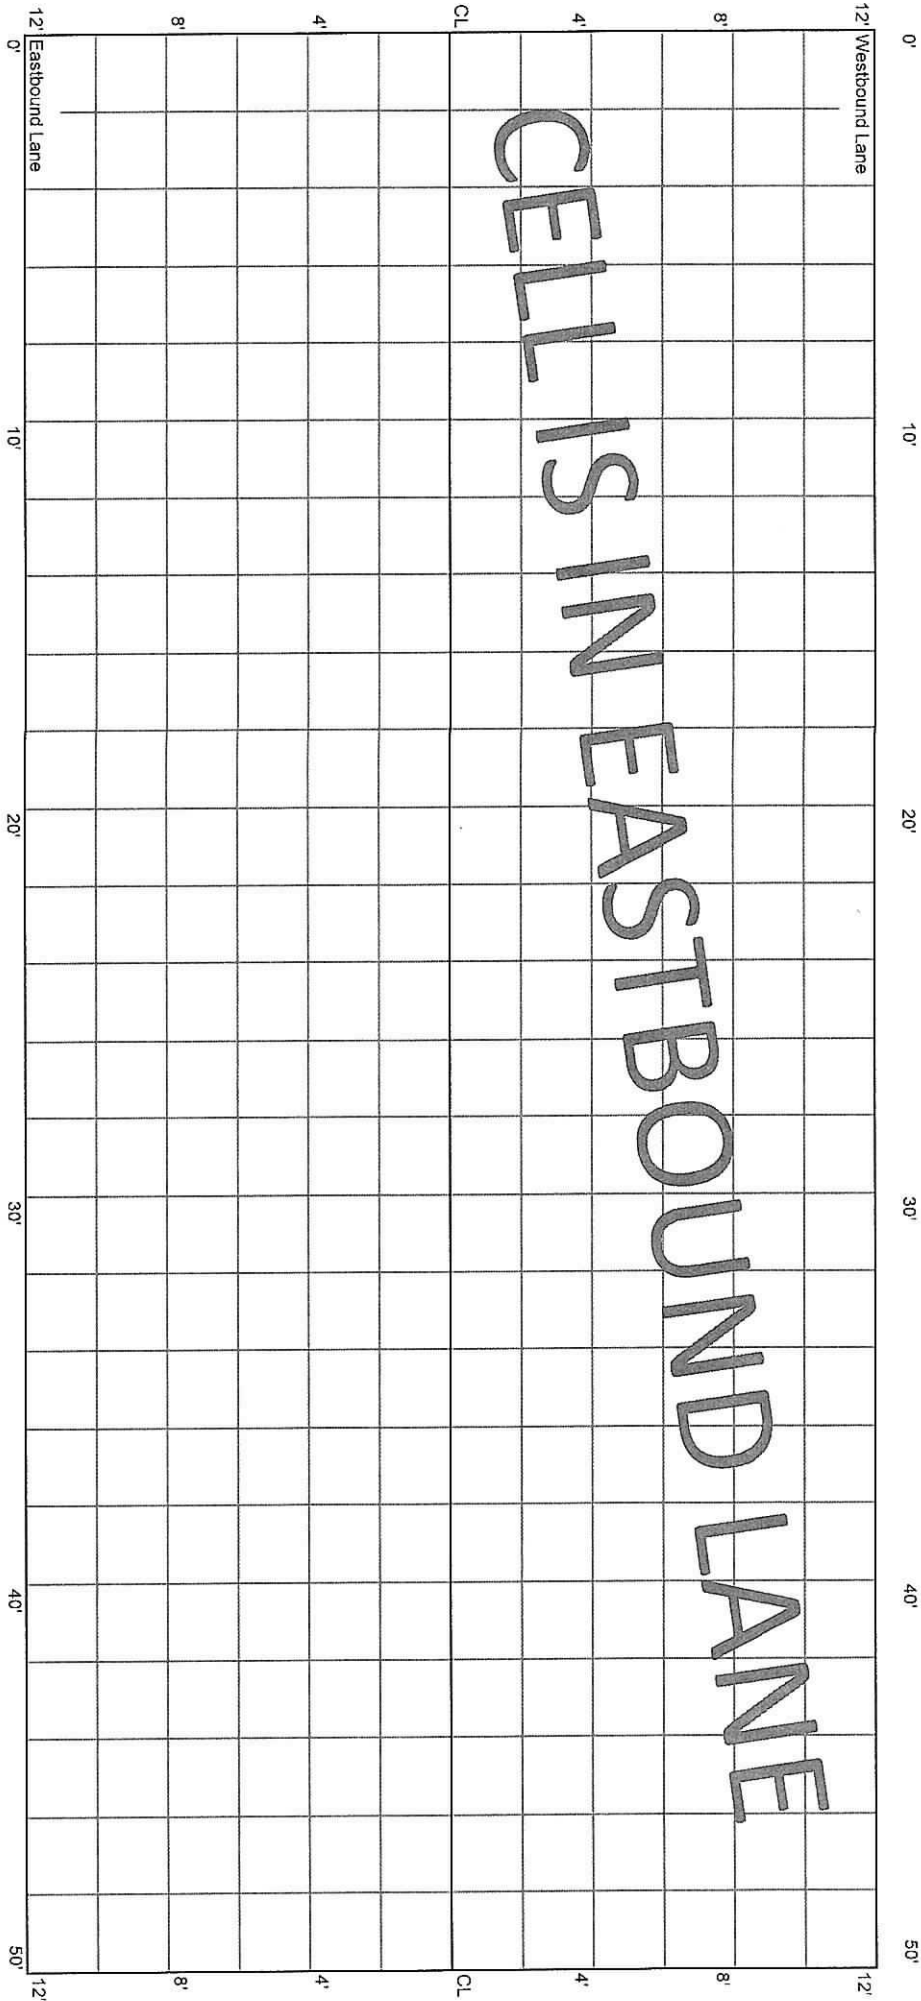

CELL 7005E
400 - 450 ft

26+00


28+50

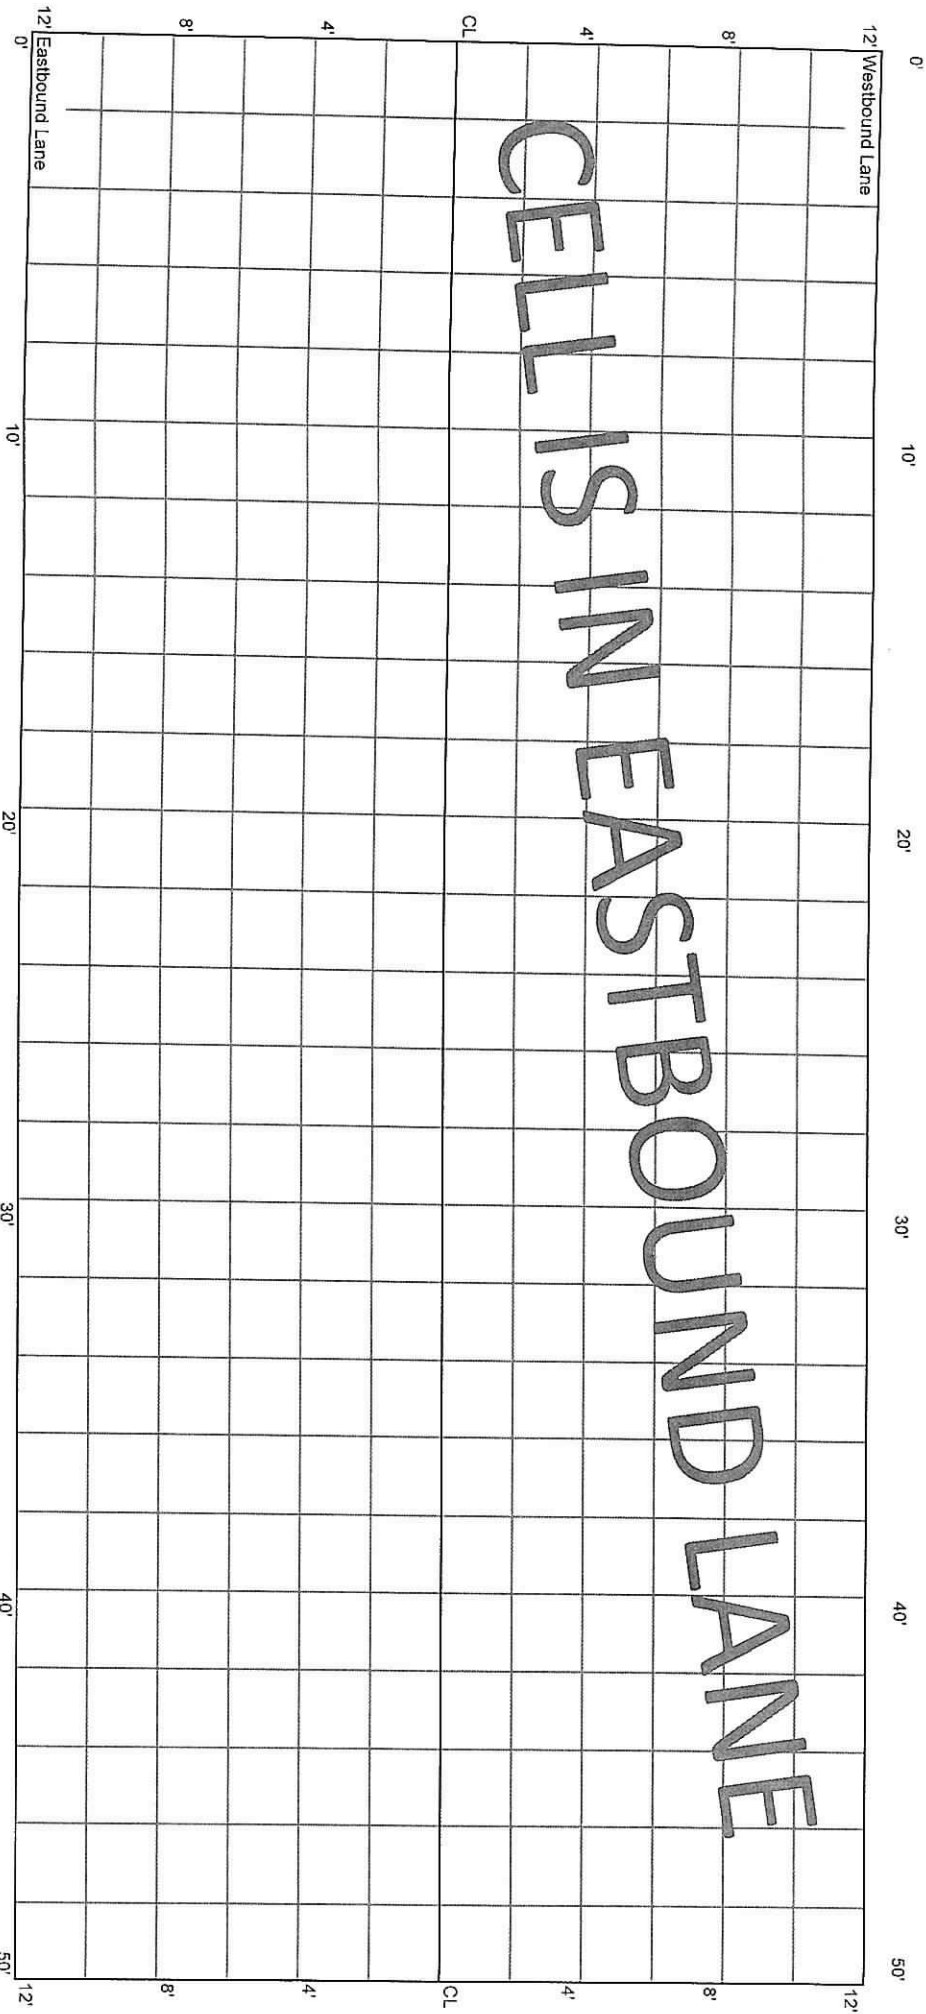

CELL 7005E
450 - 500 ft

26+50 26+58
CL KITTRIDGE

27+00

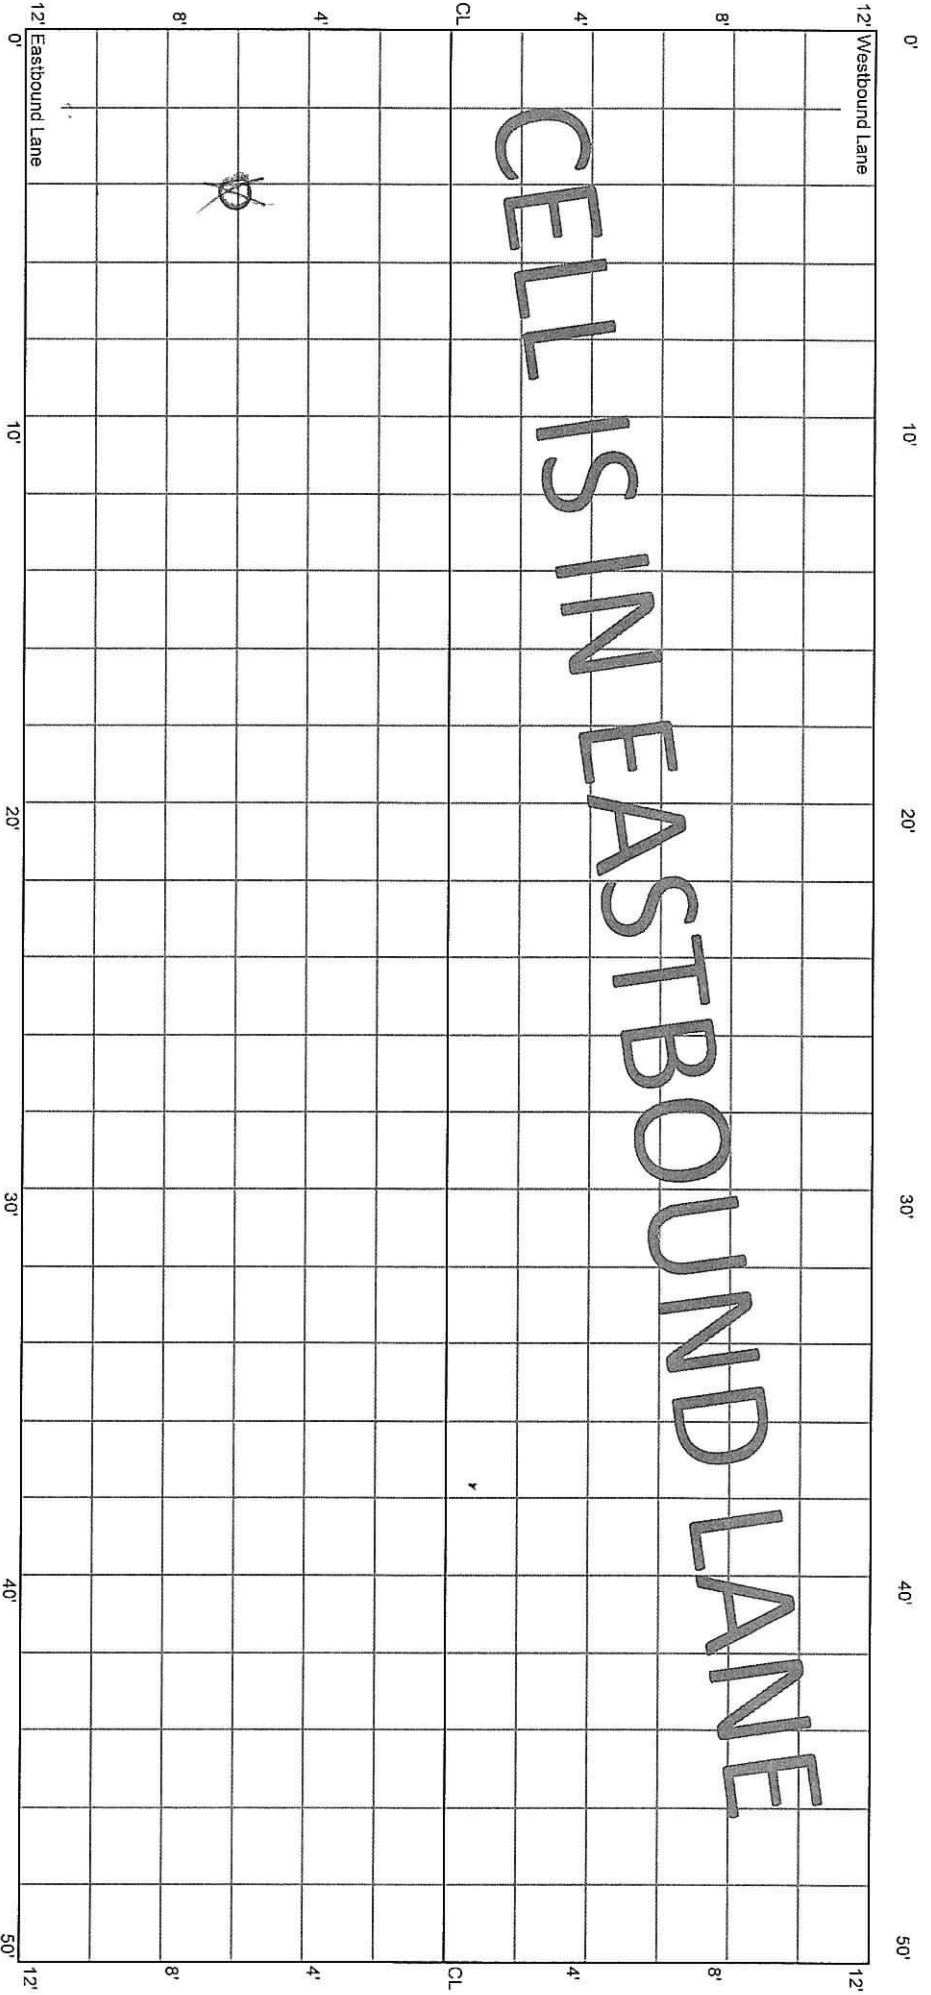

*X marked by
Surrey Corp.*

CELL 7005E
500 - 550 ft

27+00

16+25

27+50

