

5.28.20 E.S.


File 70TH ST

CELL 7005W
0 - 50 ft

27+00

26+58
CL KITTRIDGE


26+50

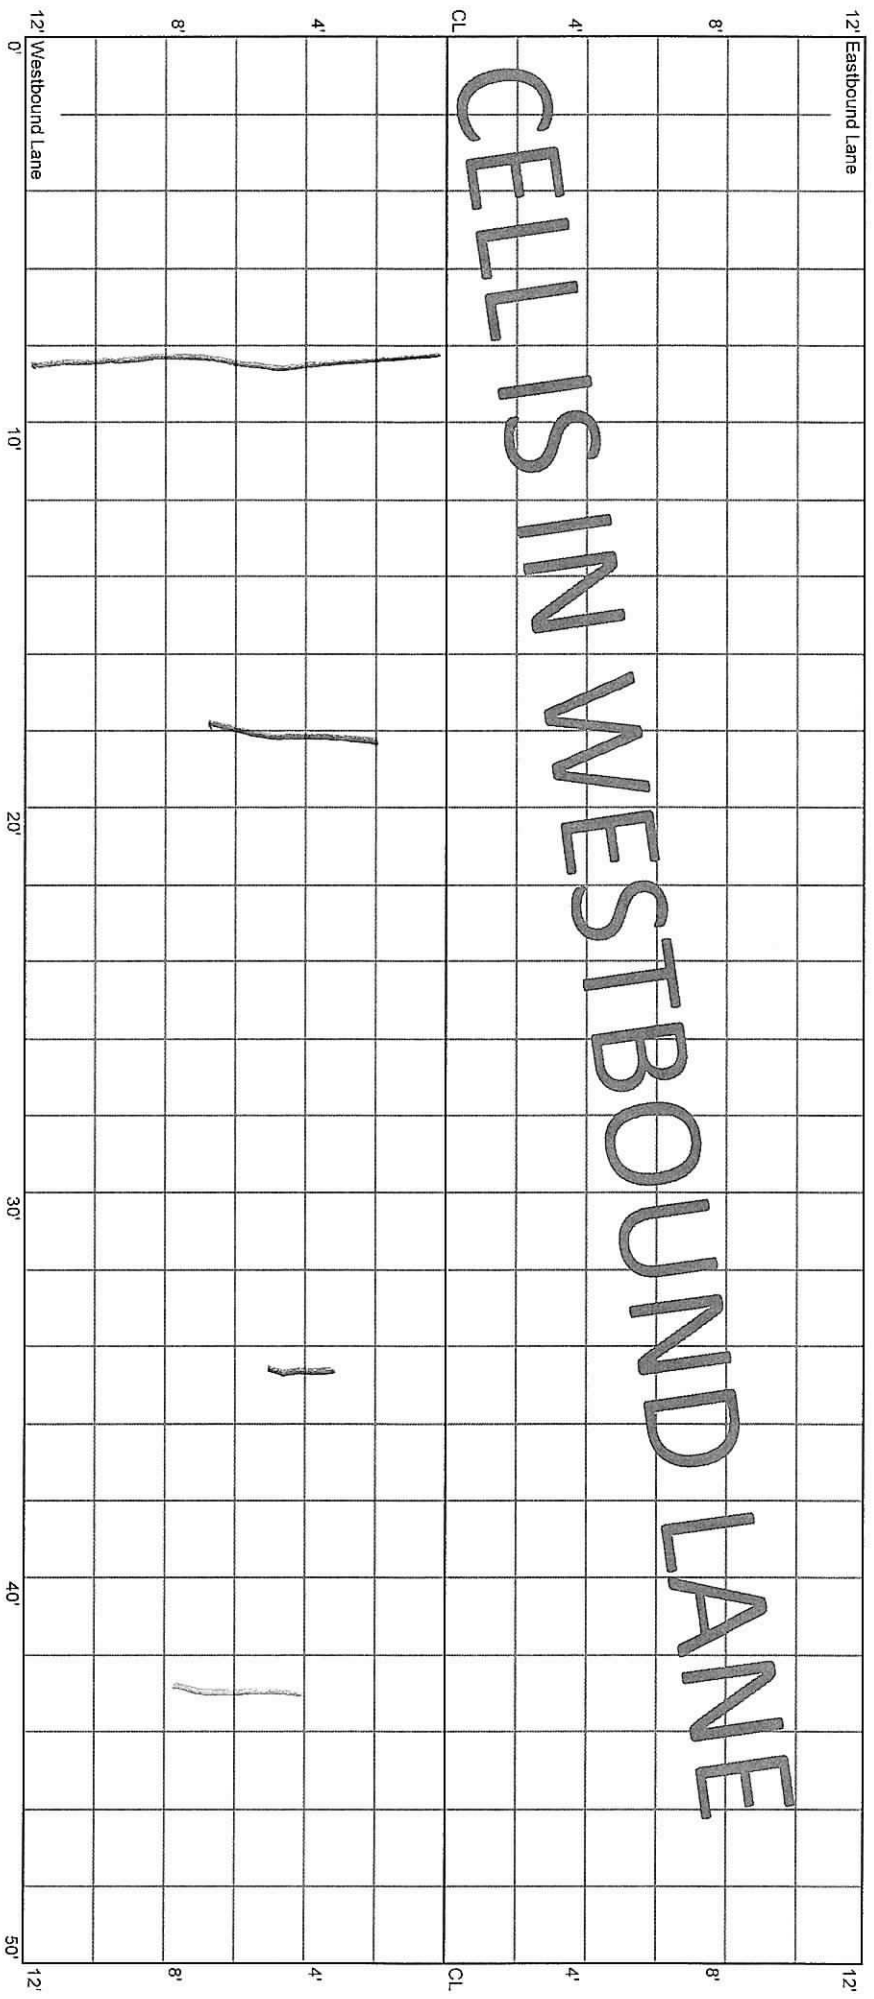

CELL 7005W
50 - 100 ft

28+50


26+00

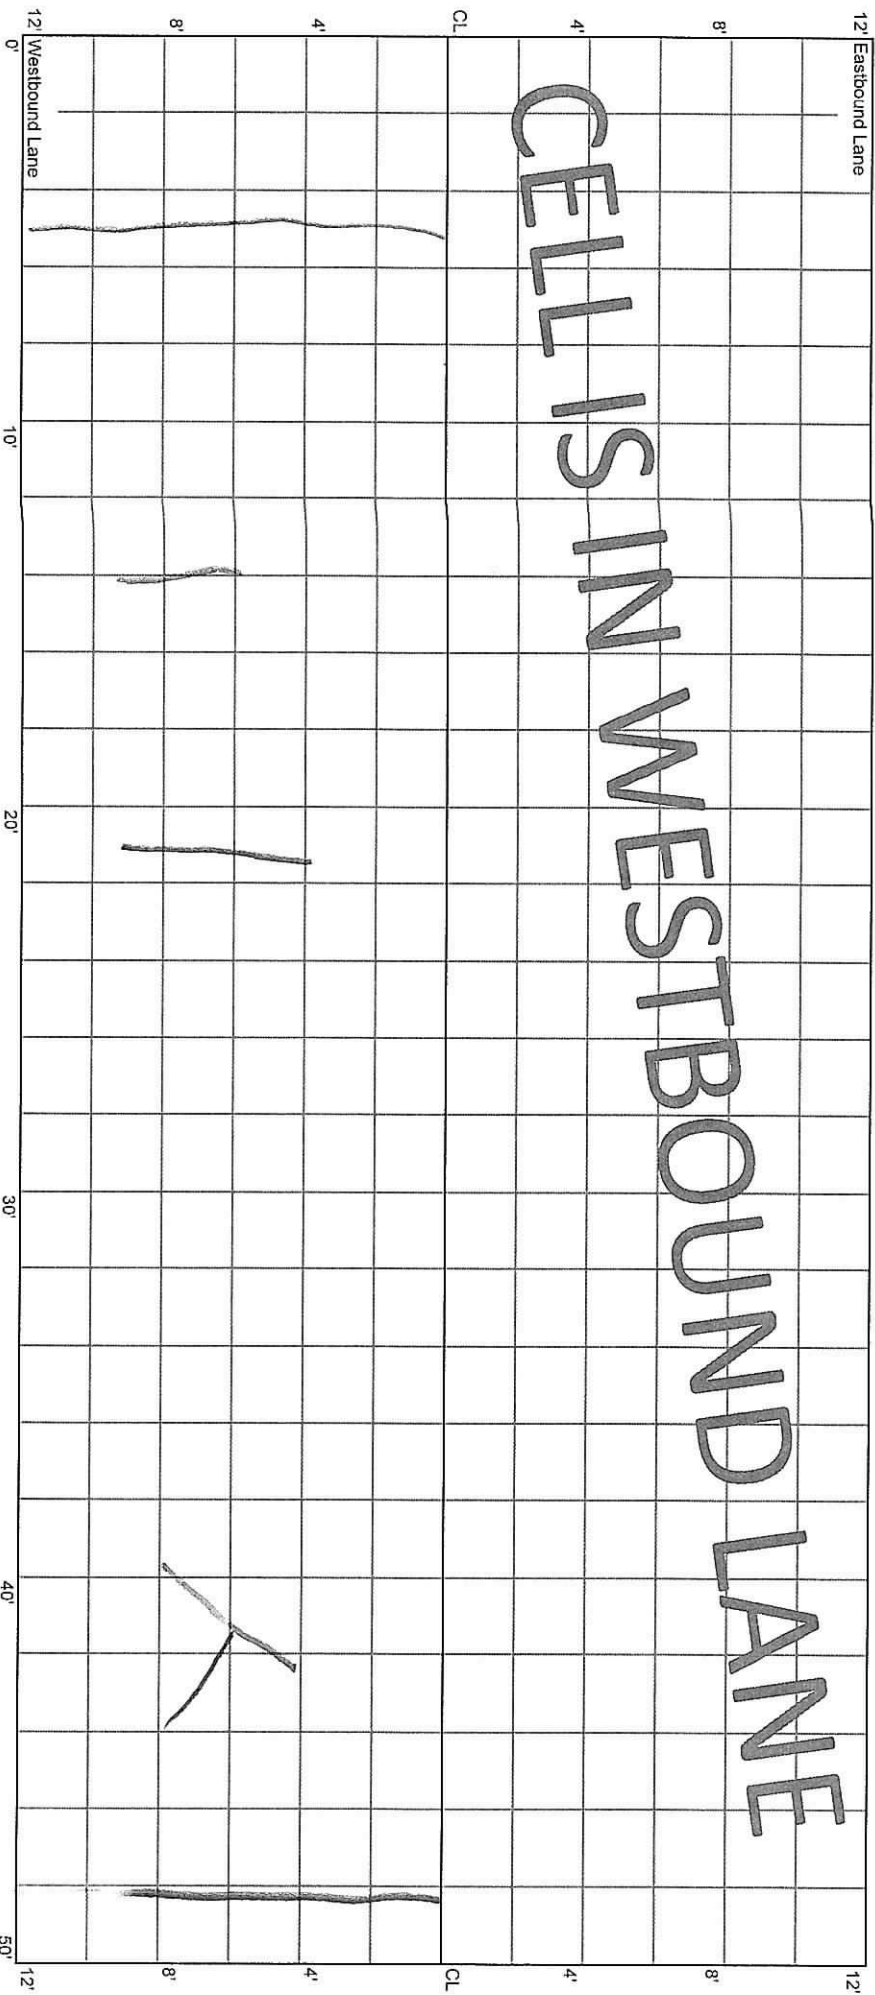

CELL 7005W
100 - 150 ft

26+00


25+50

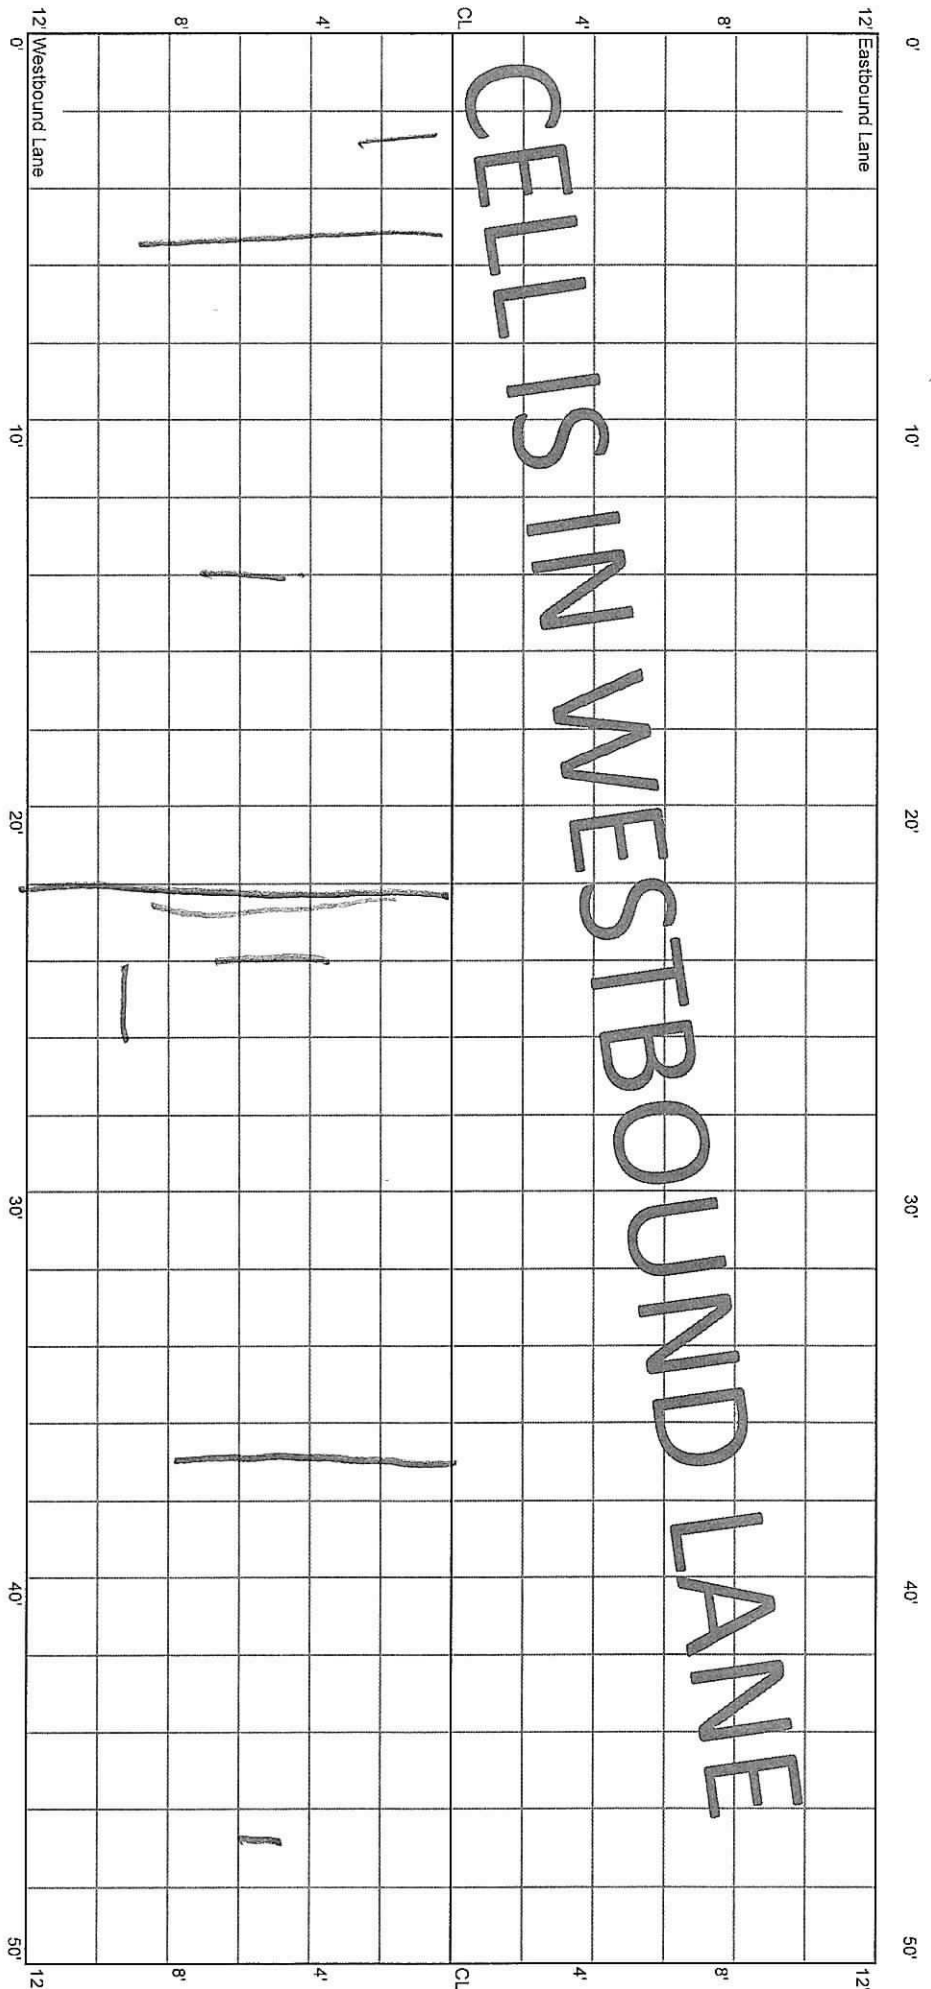

CELL 7005W
150 - 200 ft

25+50


25+00

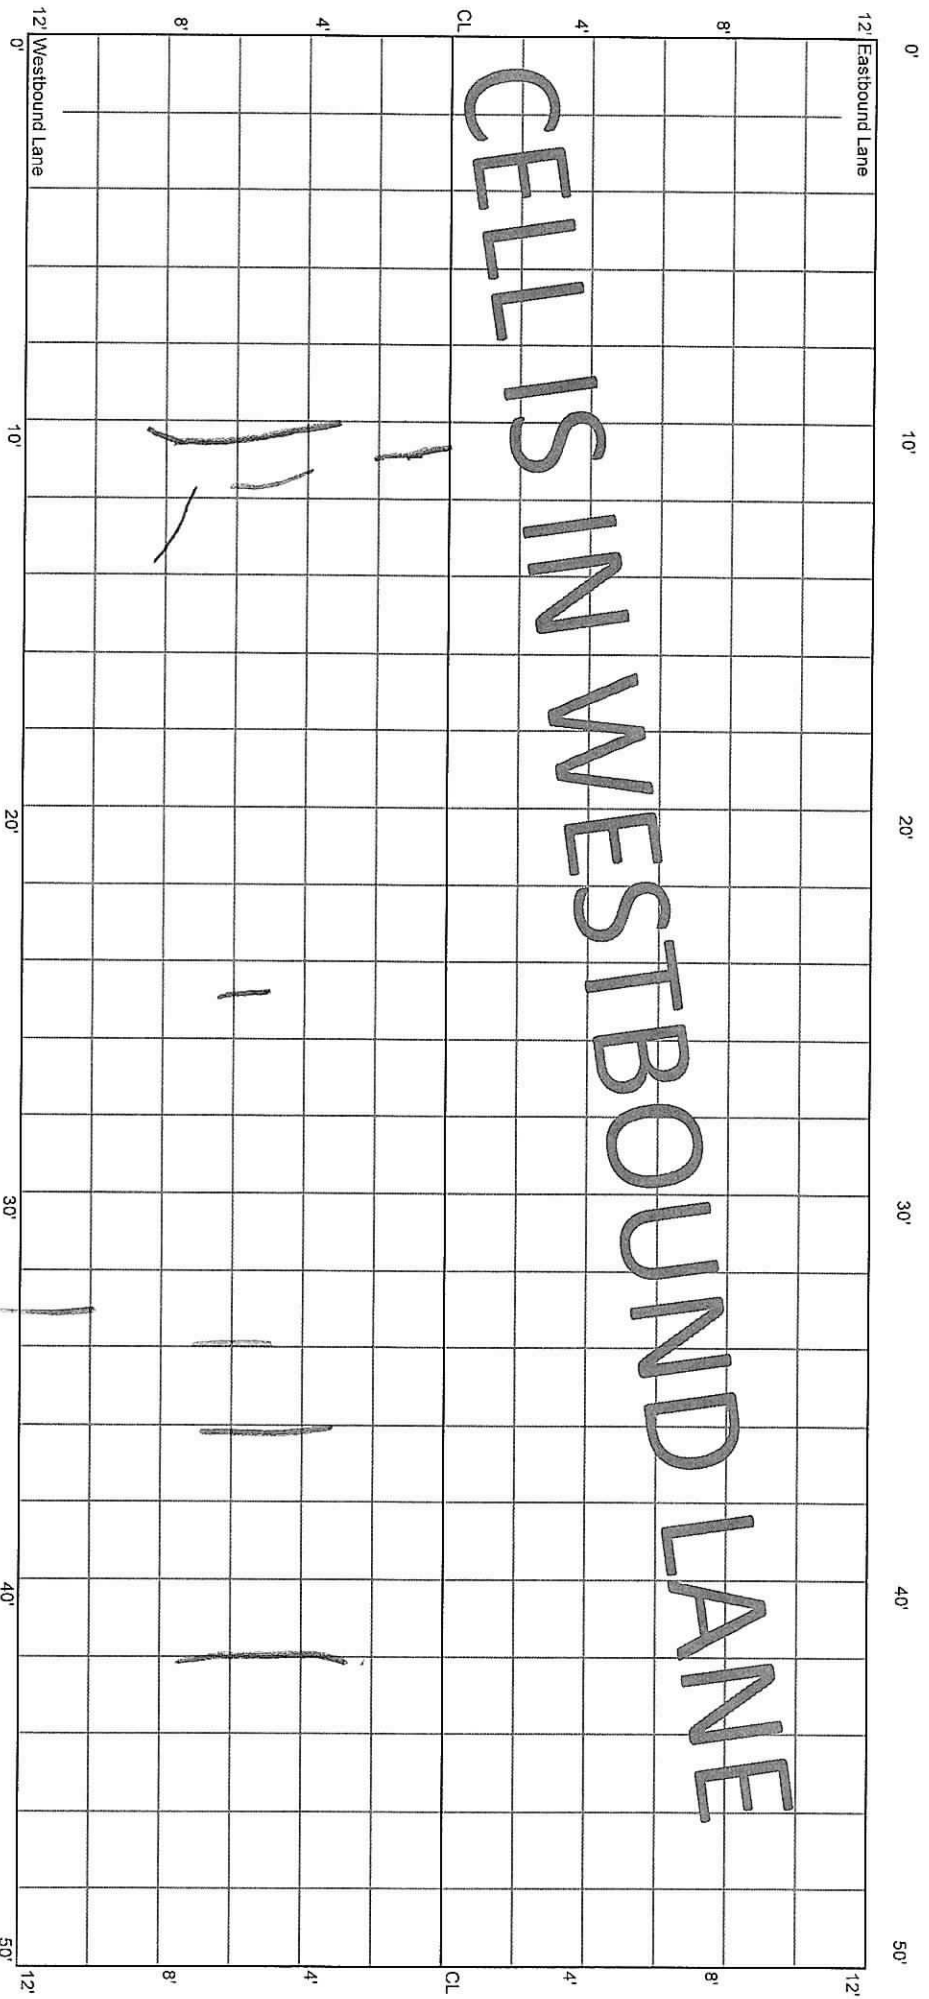

CELL 7005W
200 - 250 ft

25+00


24+50

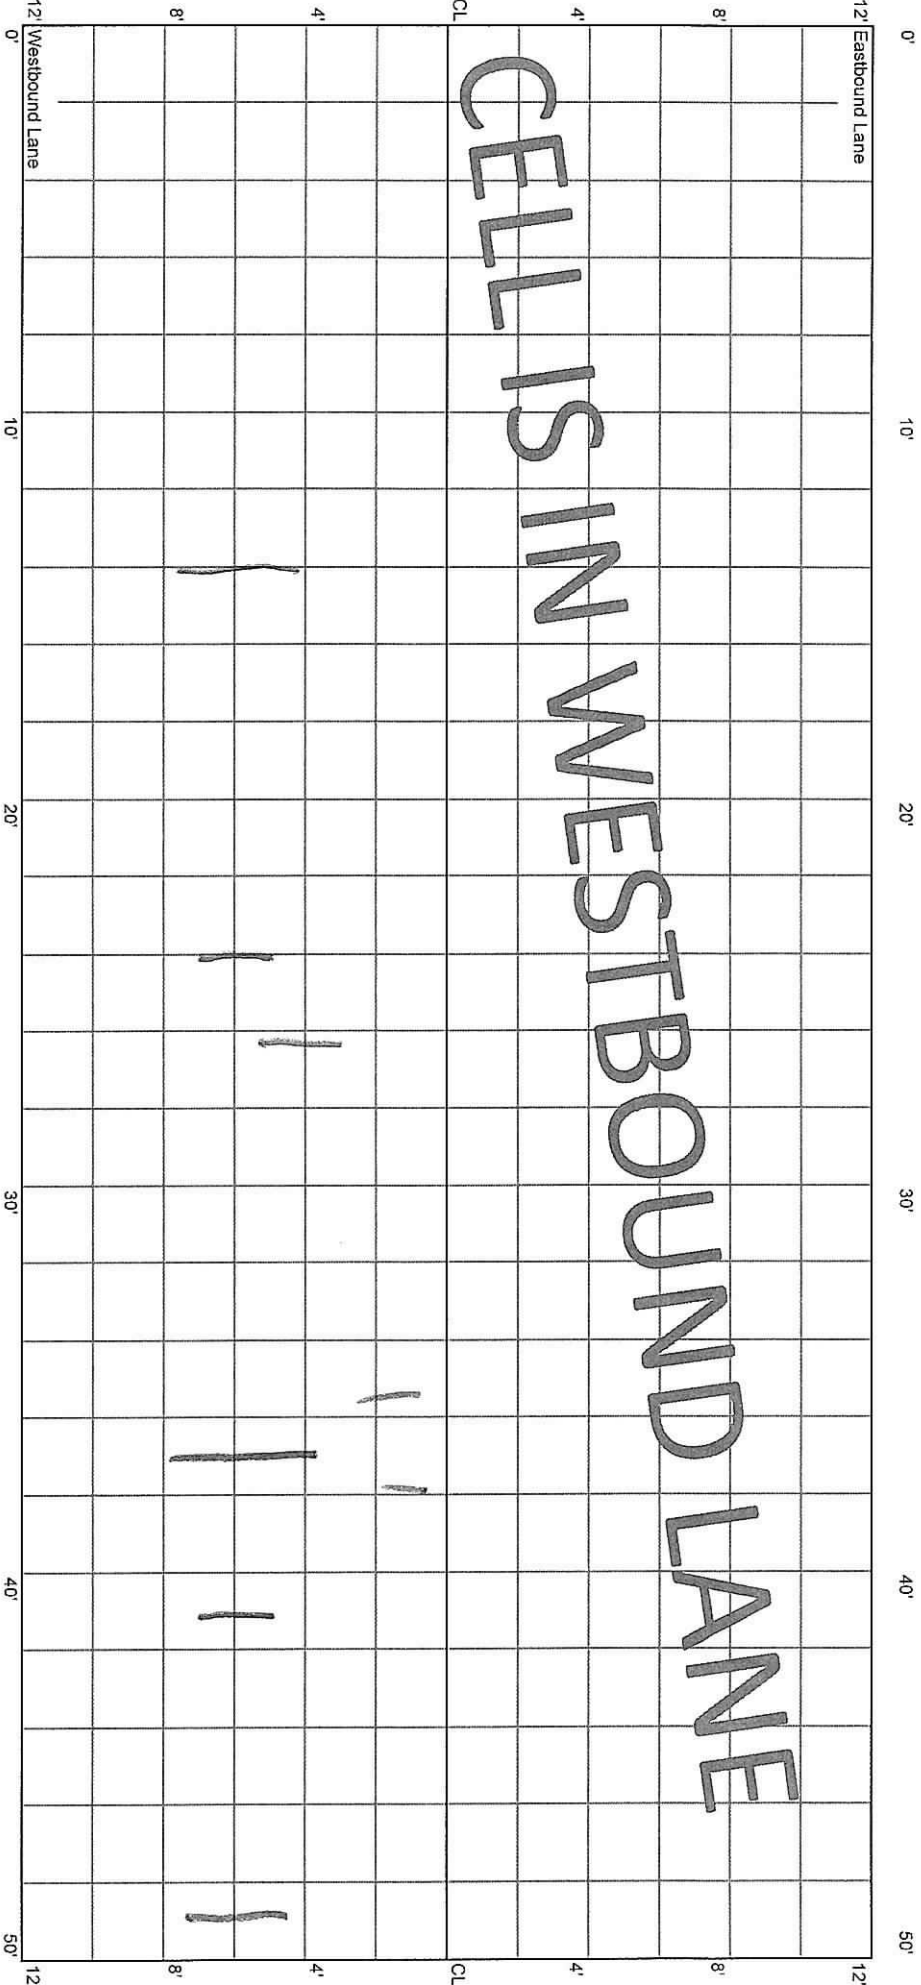

CELL 7005W
250 - 300 ft

24+50


24+00

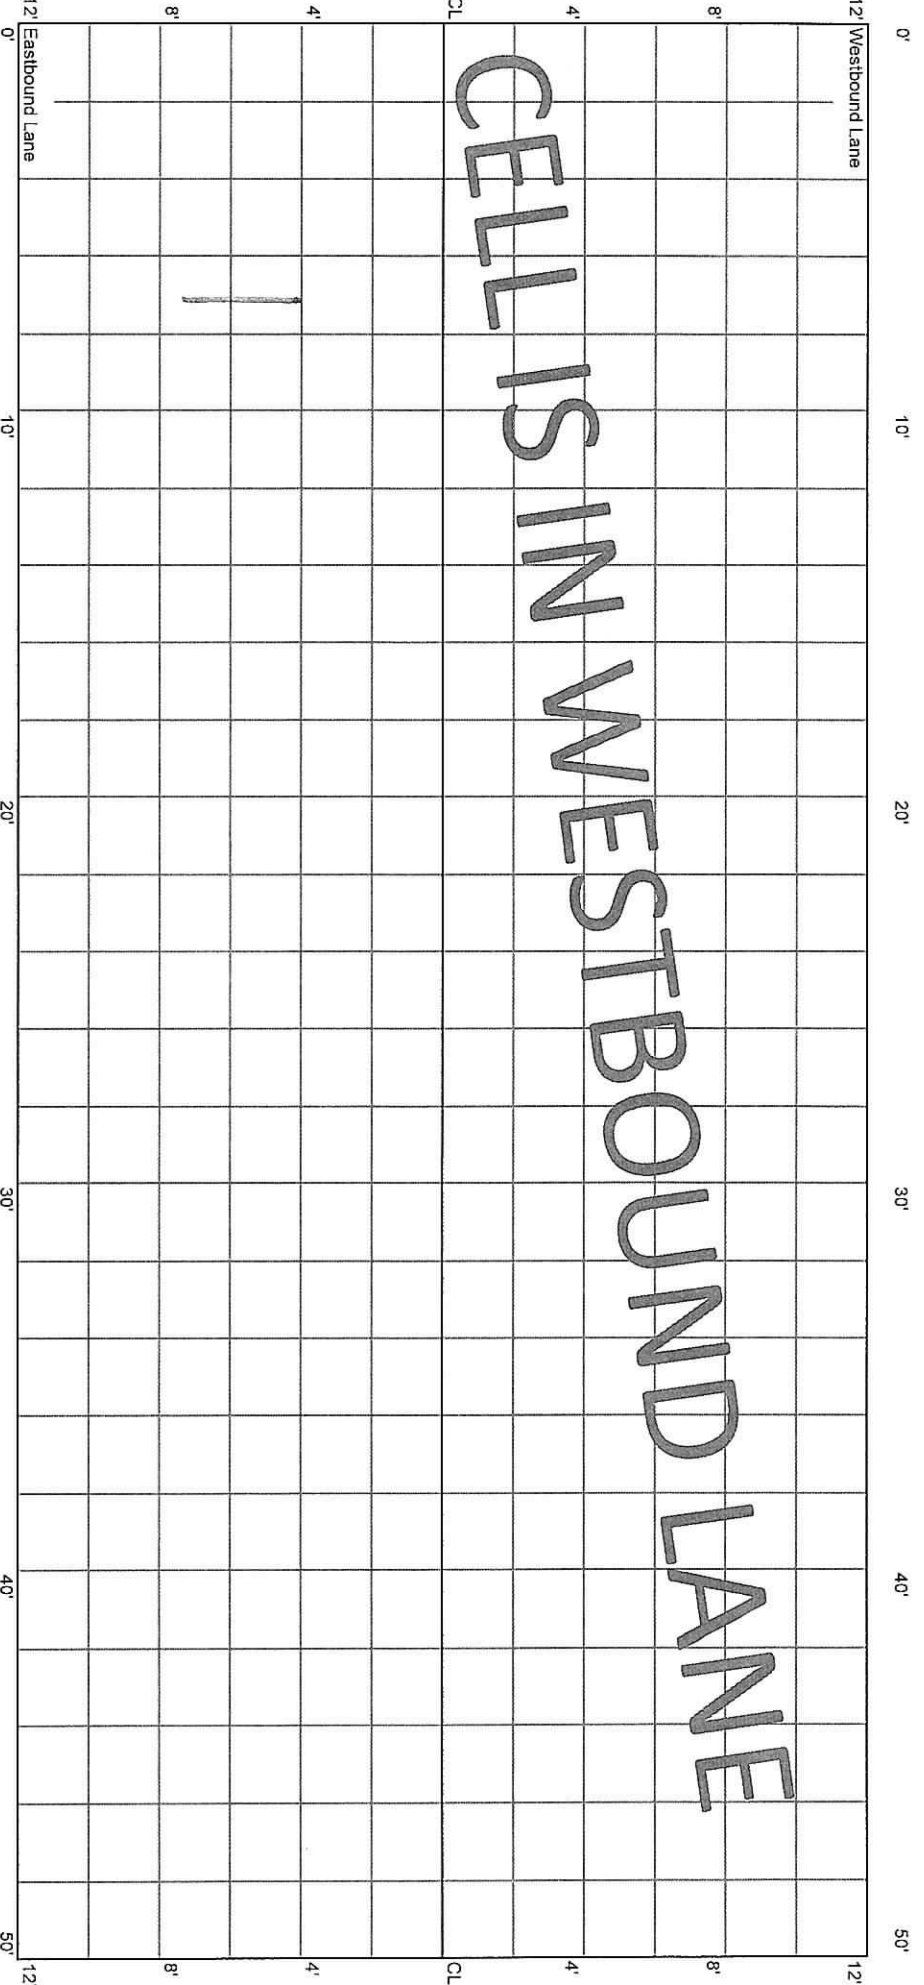

CELL 7005W
350 - 400 ft

23+50


23+00

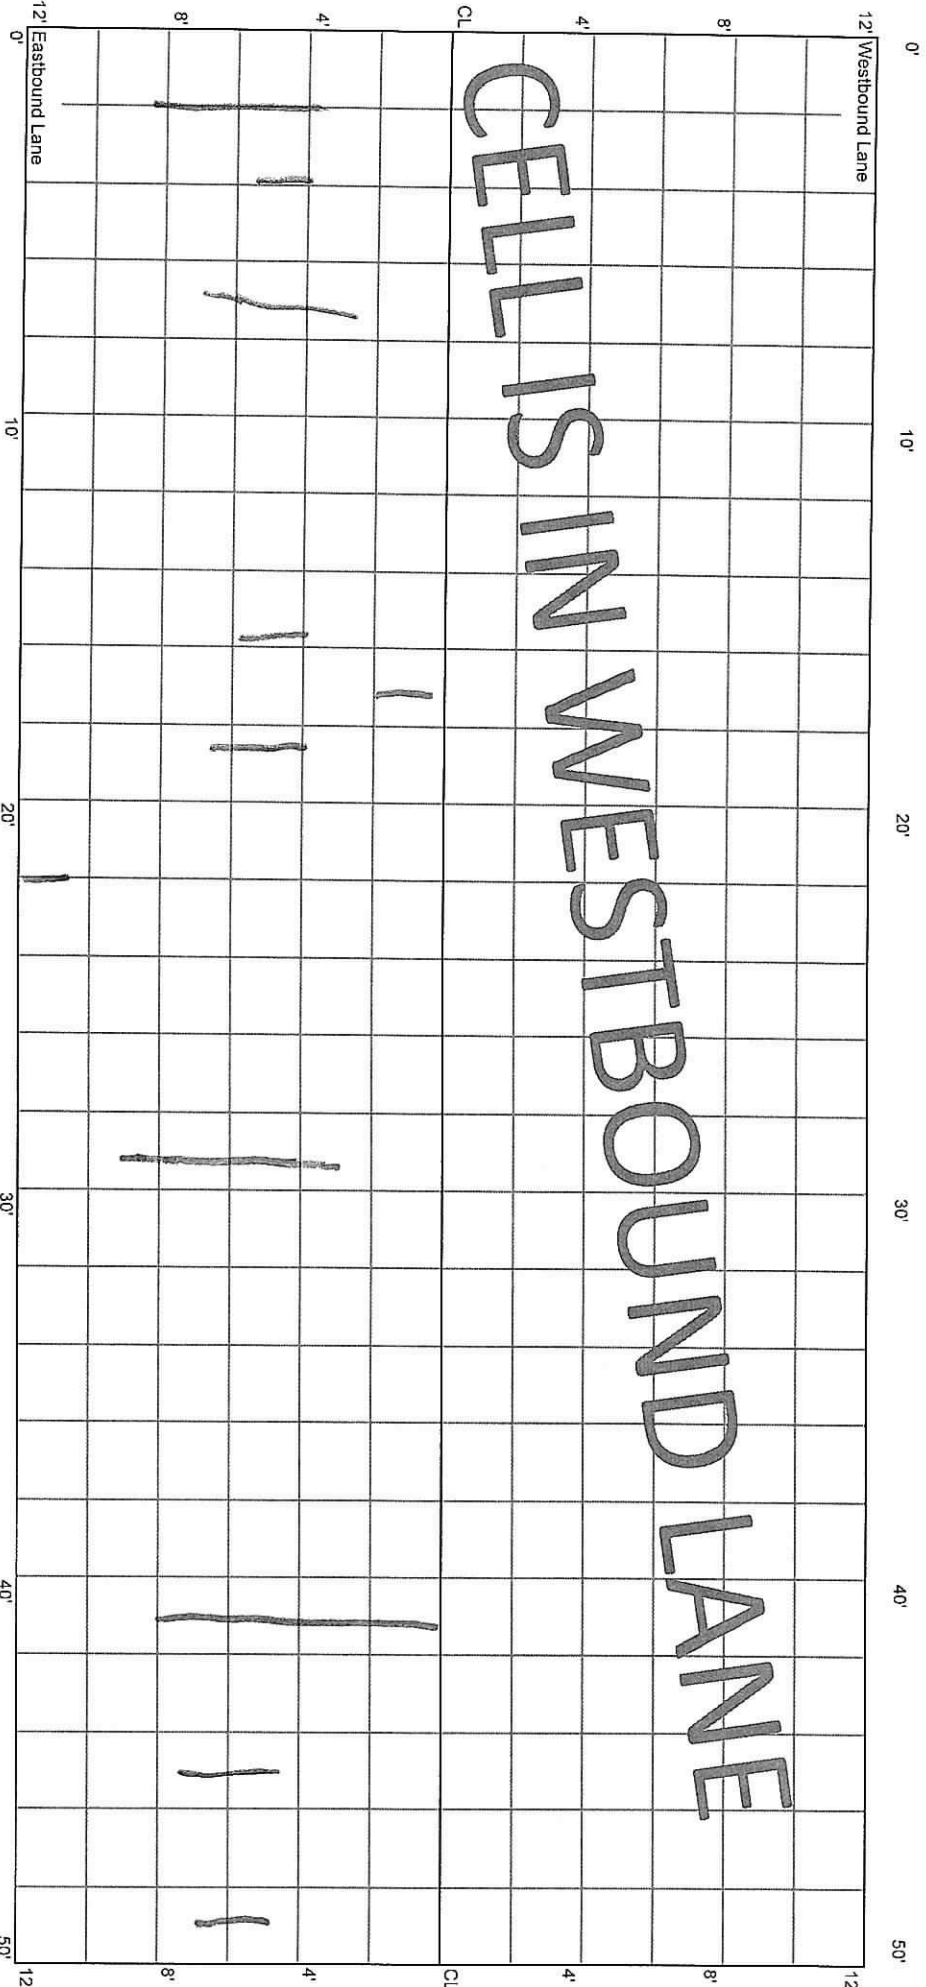

CELL 700SW
400 - 450 ft

23+00

22+50

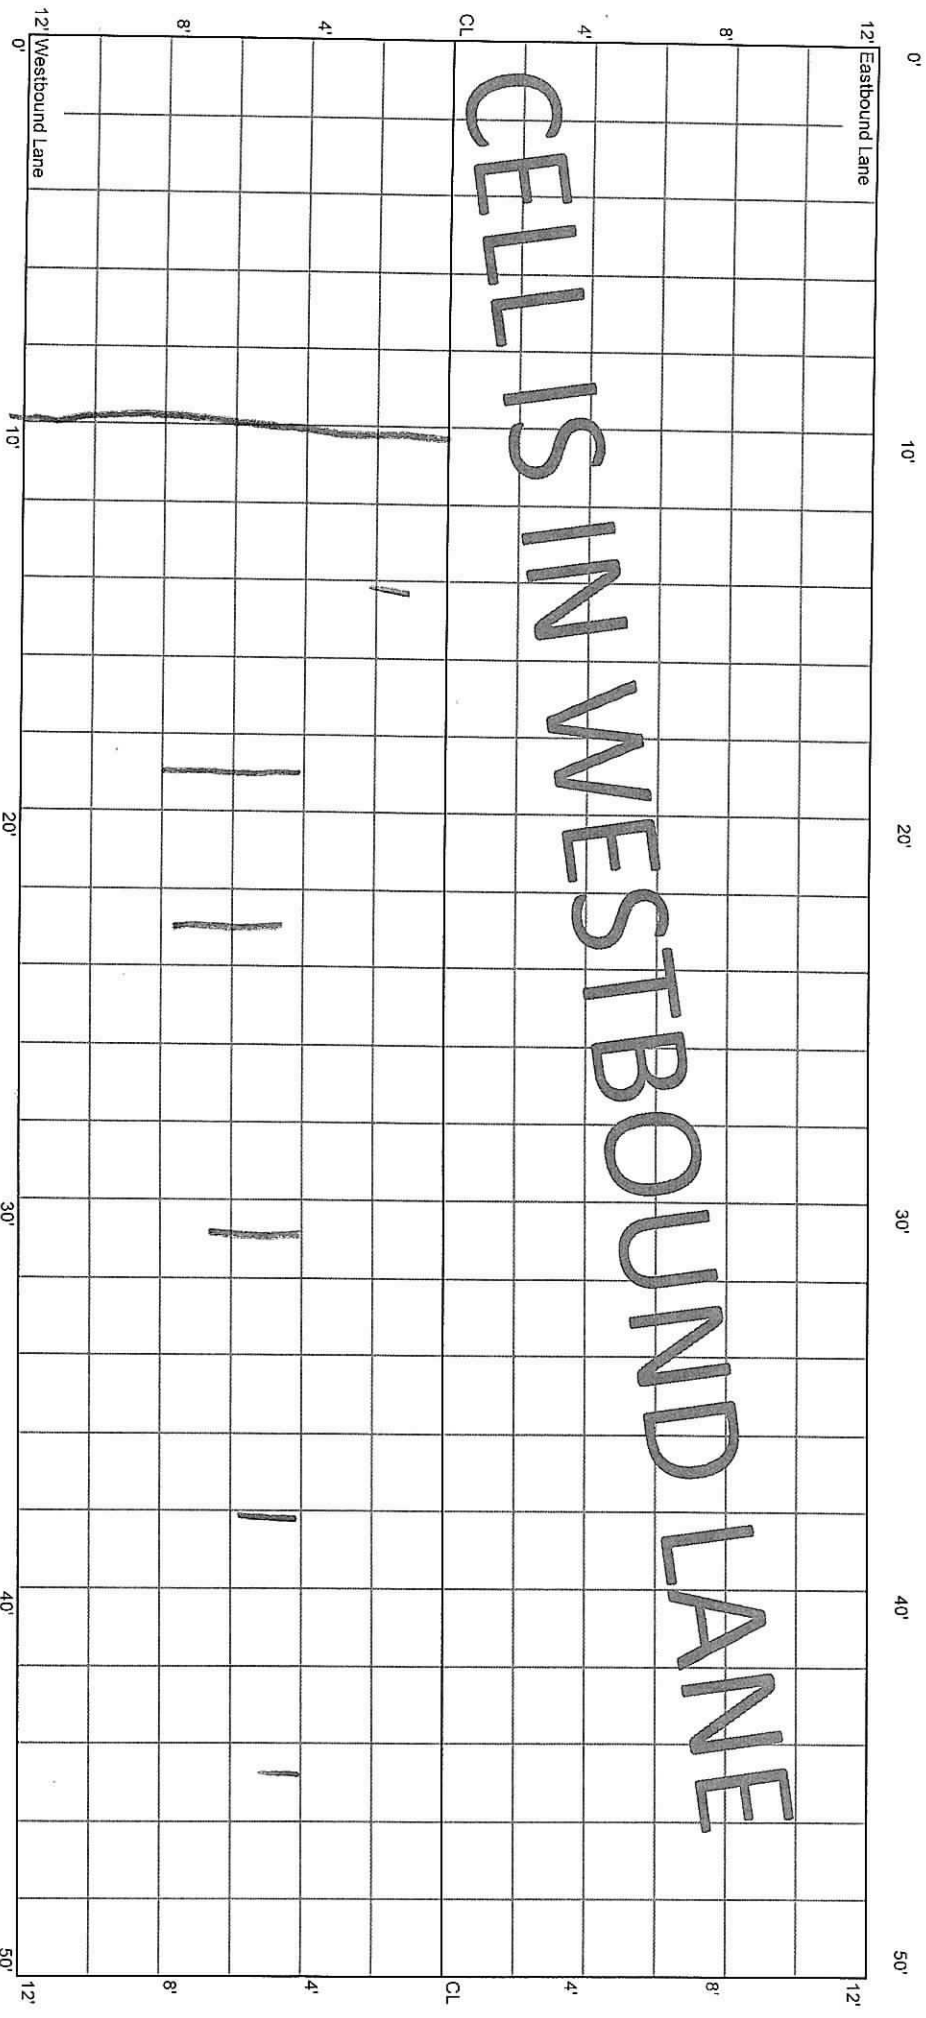


CELLS IN WESTBOUND LANE

CELL 7005W
450 - 500 ft

22+50

22+00

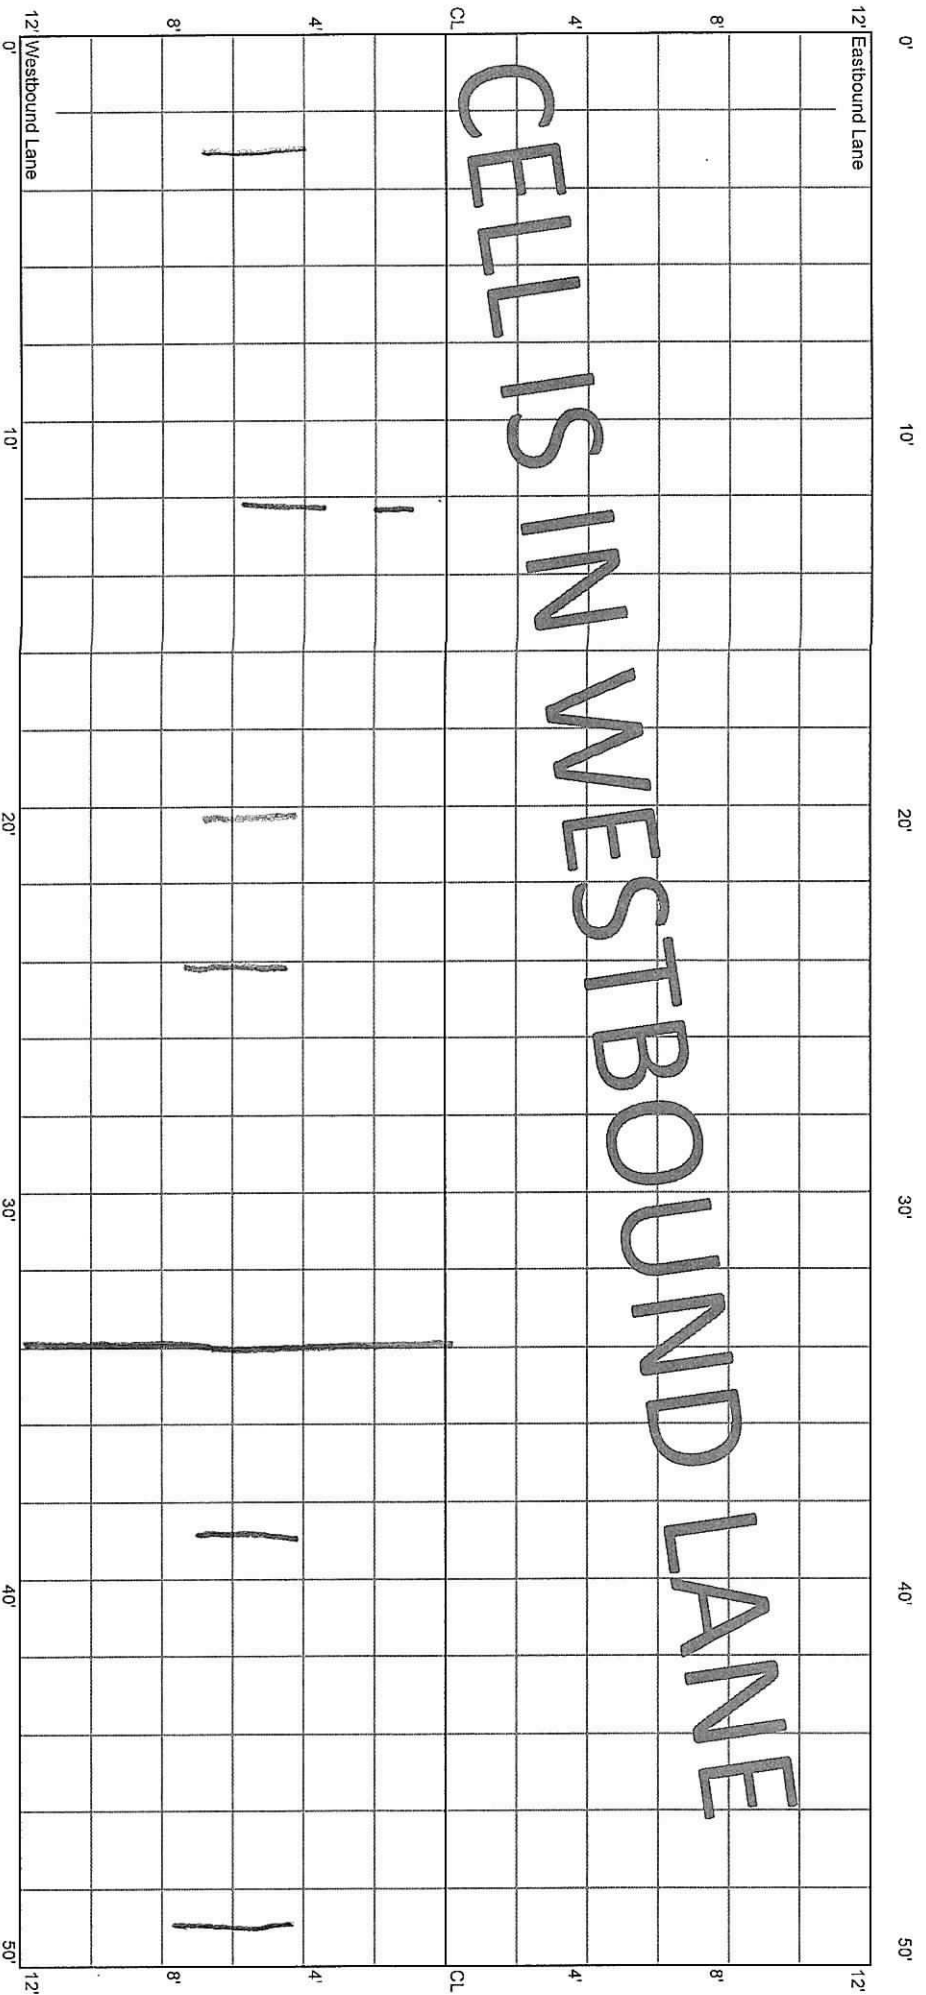

CELL 7005W
500 - 550 ft

22+00

21+75

21+50

