


5.28.20 E.T. - No Disturb

File 70TH ST

CELL 7006W  
0 - 50 ft

32+50


32+00

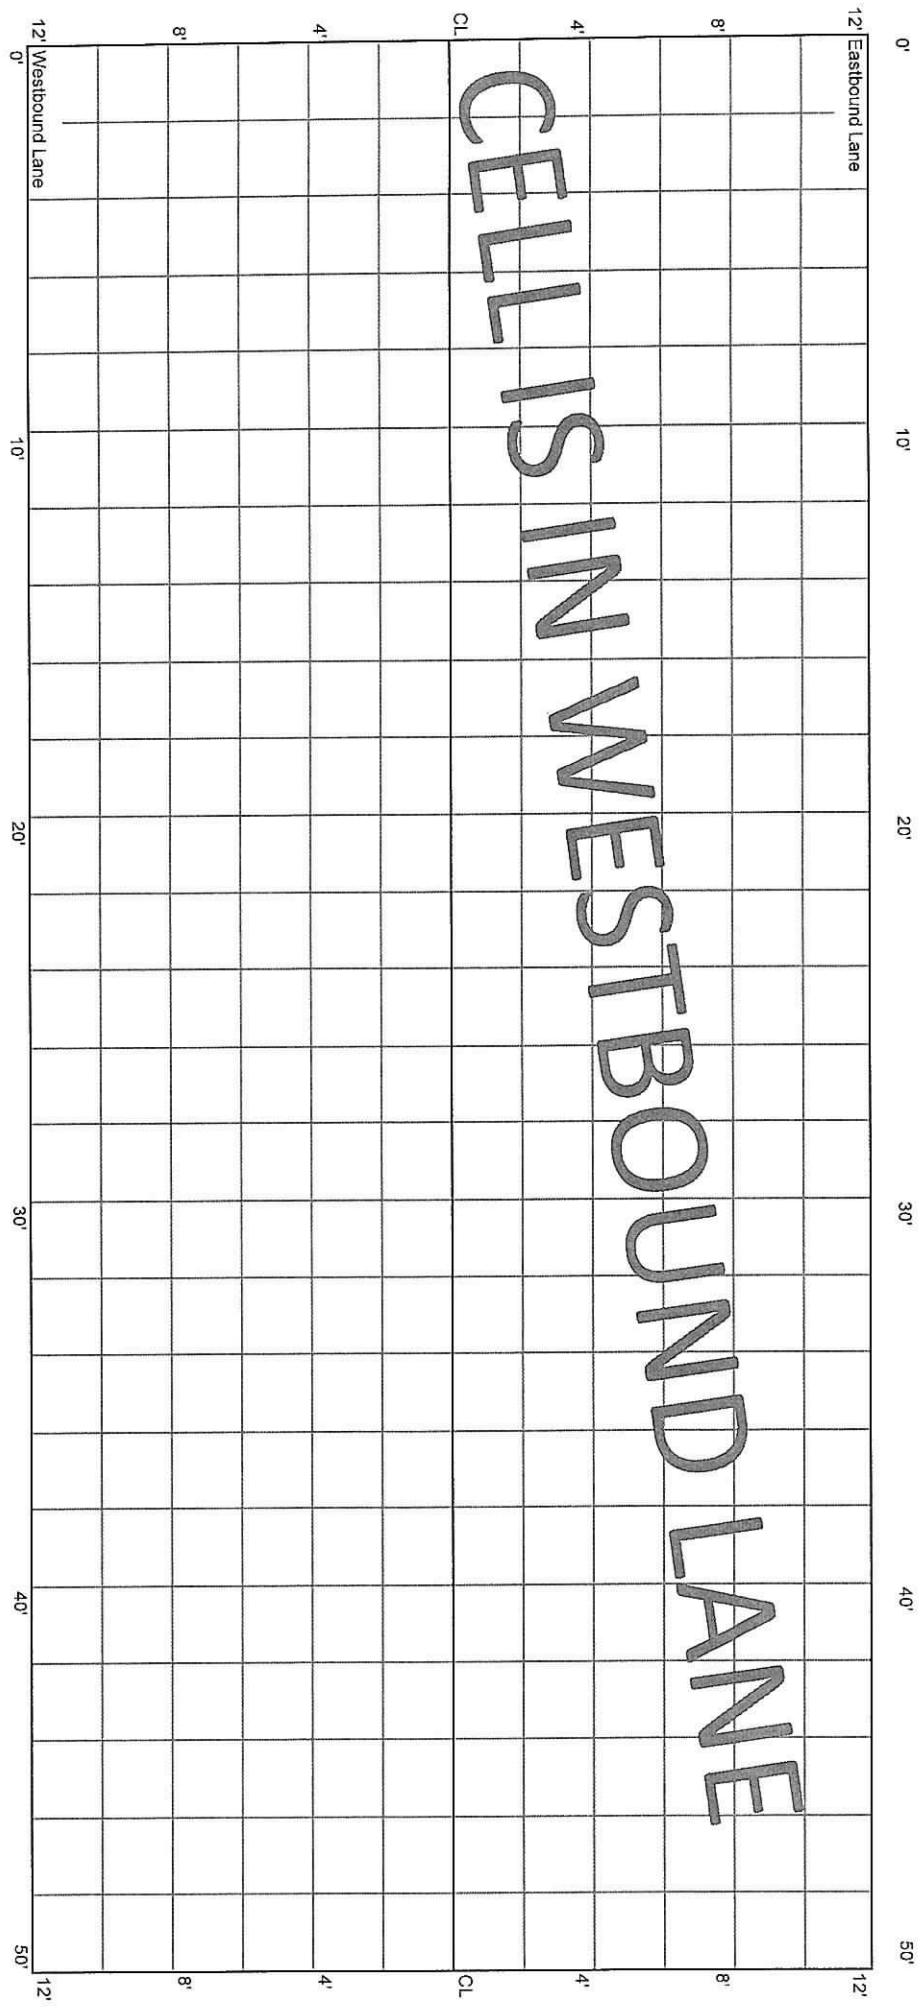

CELL 7006W  
50 - 100 ft

32+00


31+50

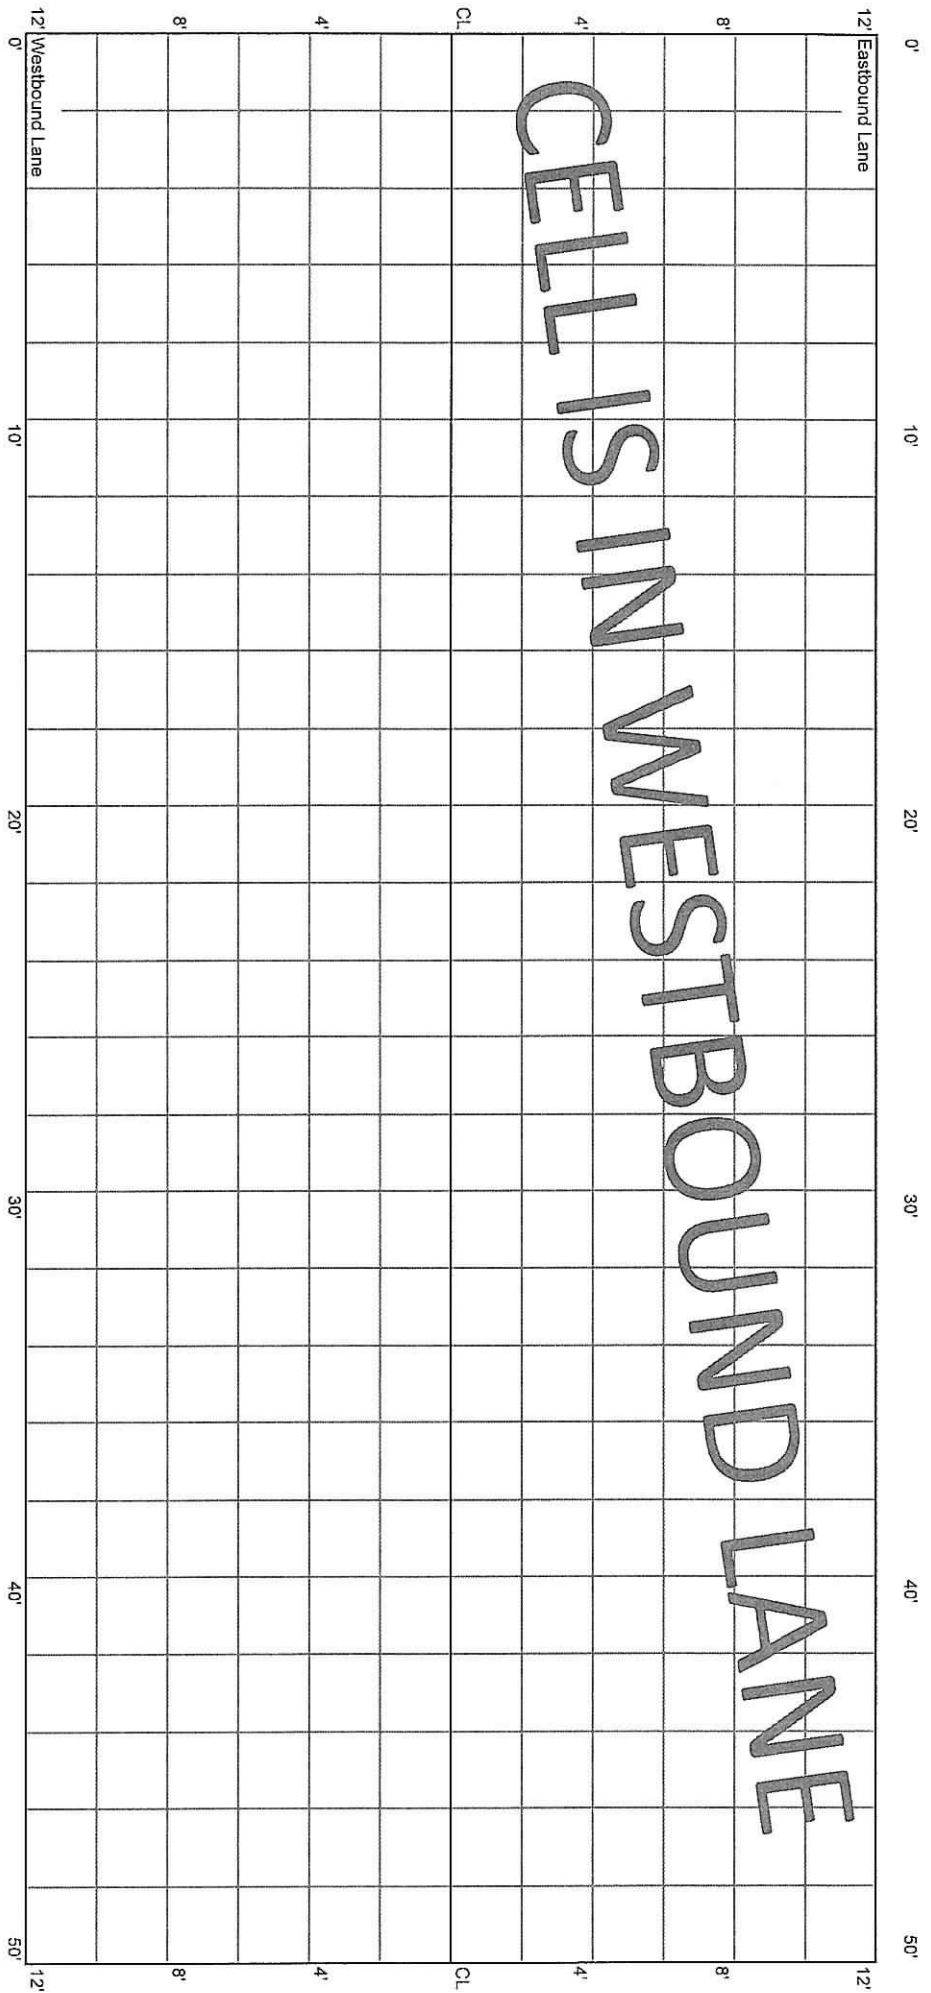

CELL 7006W  
100 - 150 ft

31+50


31+00

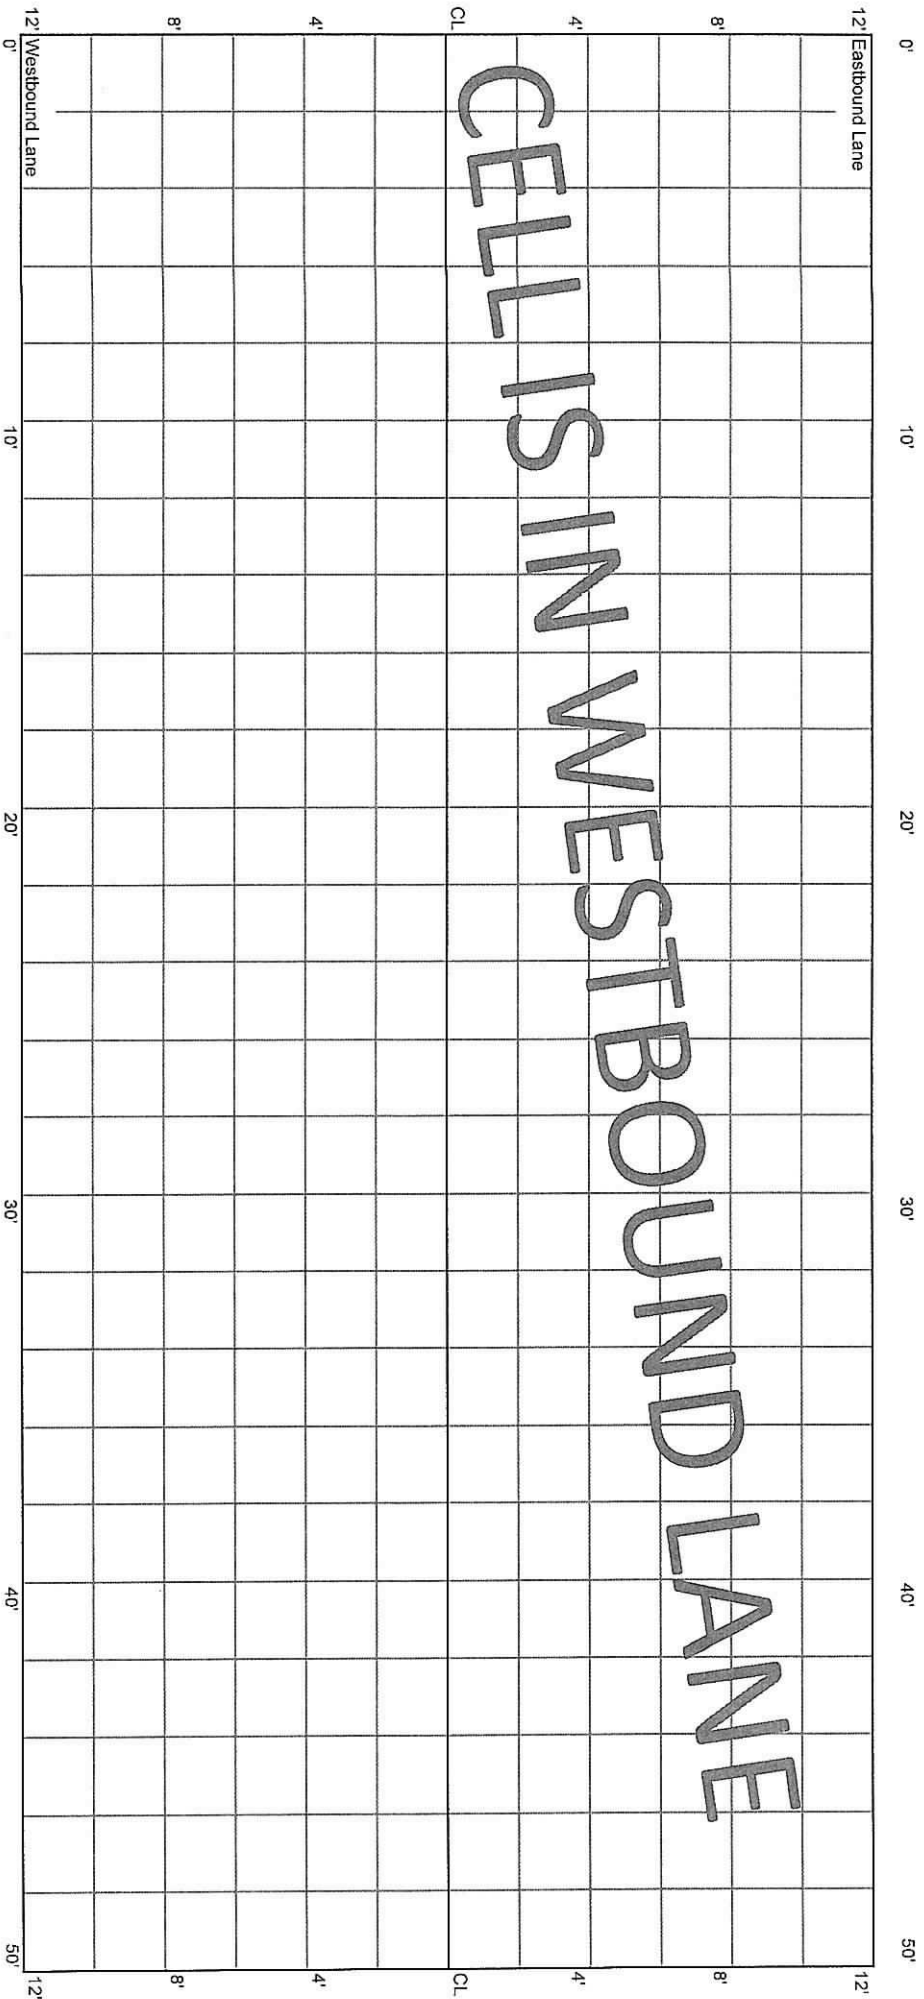

**CELL 7006W**  
150 - 200 ft

31+00


30+50

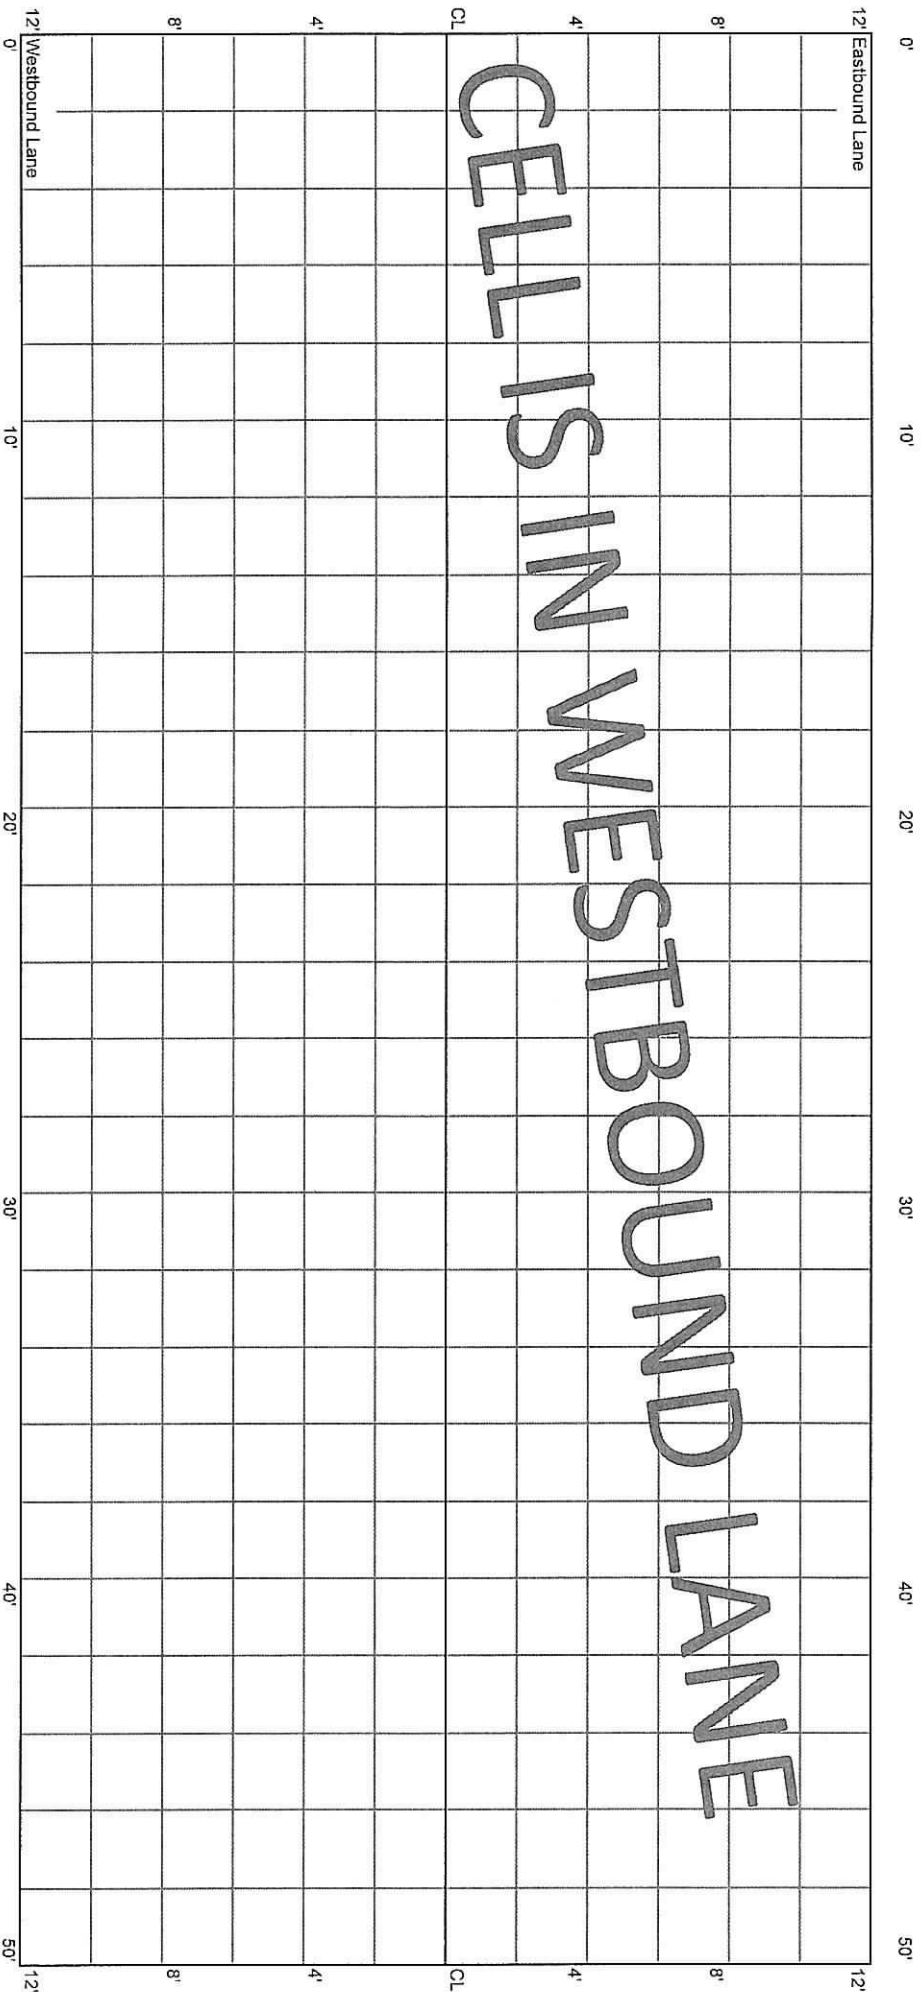

CELL 7006W  
200 - 250 ft

30+50


30+00

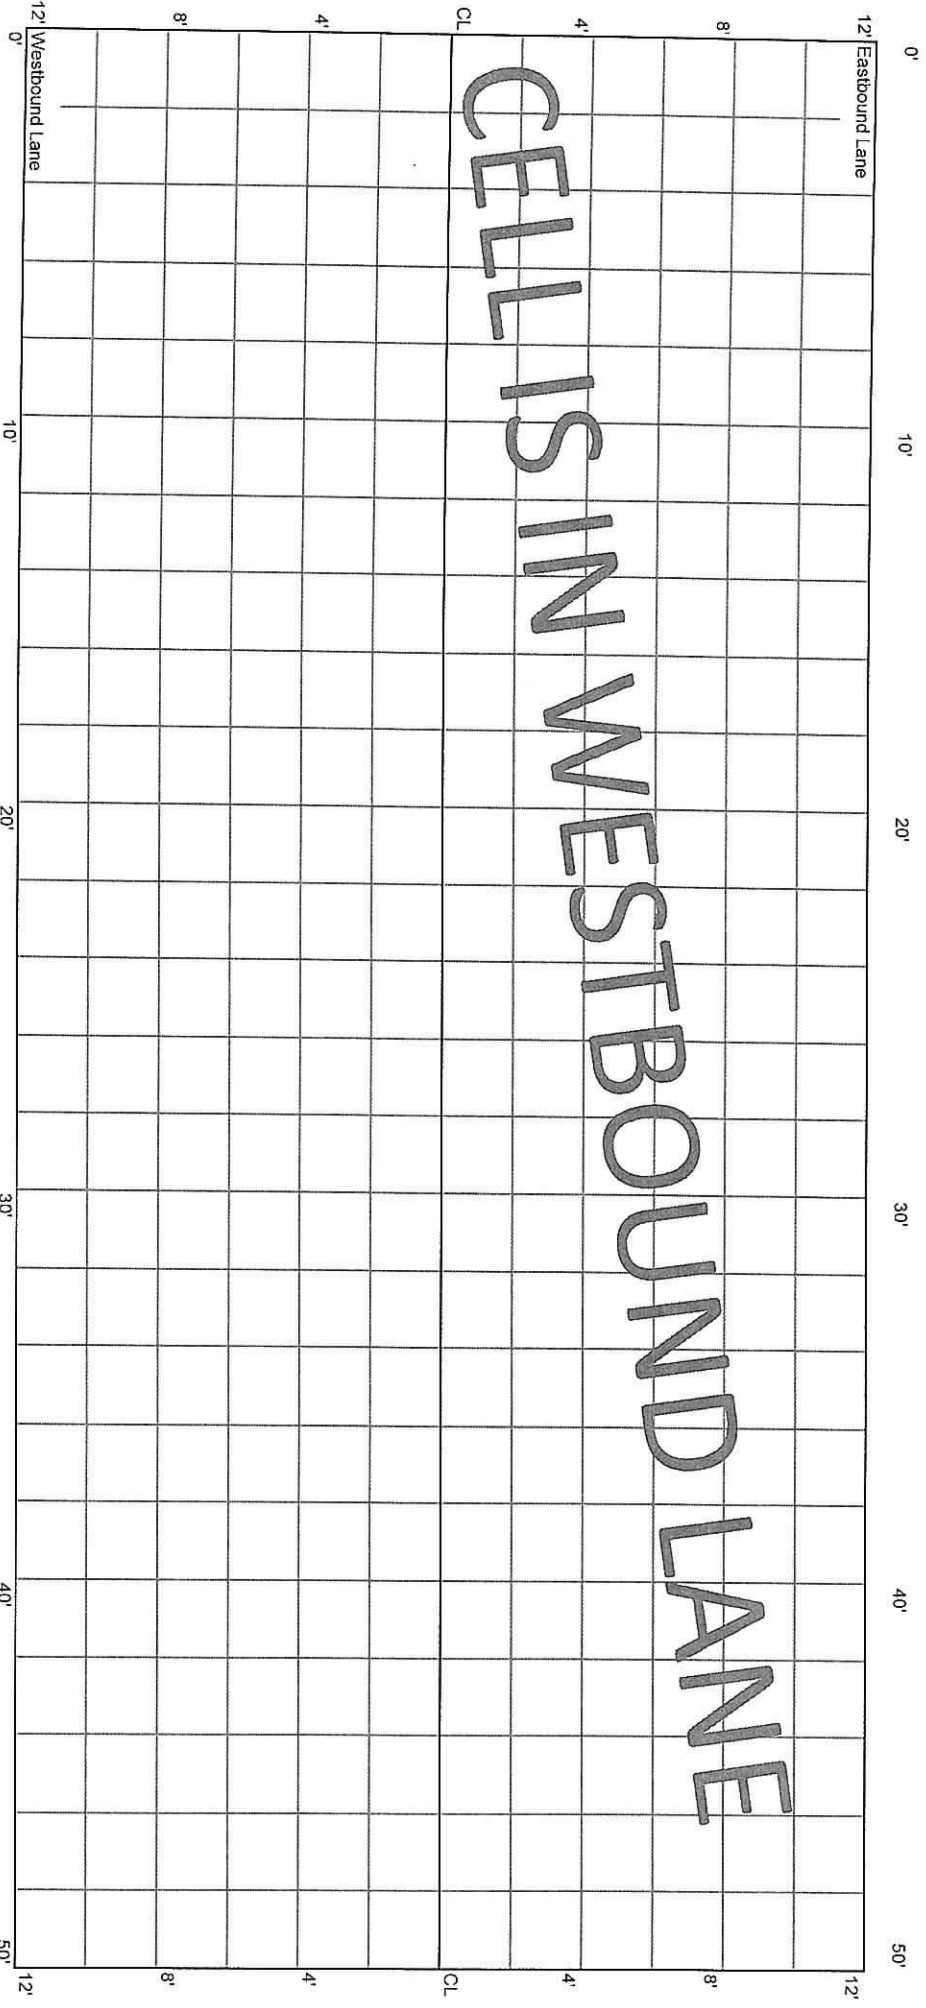

CELL 7006W  
250 - 300 ft

30+00


29+50

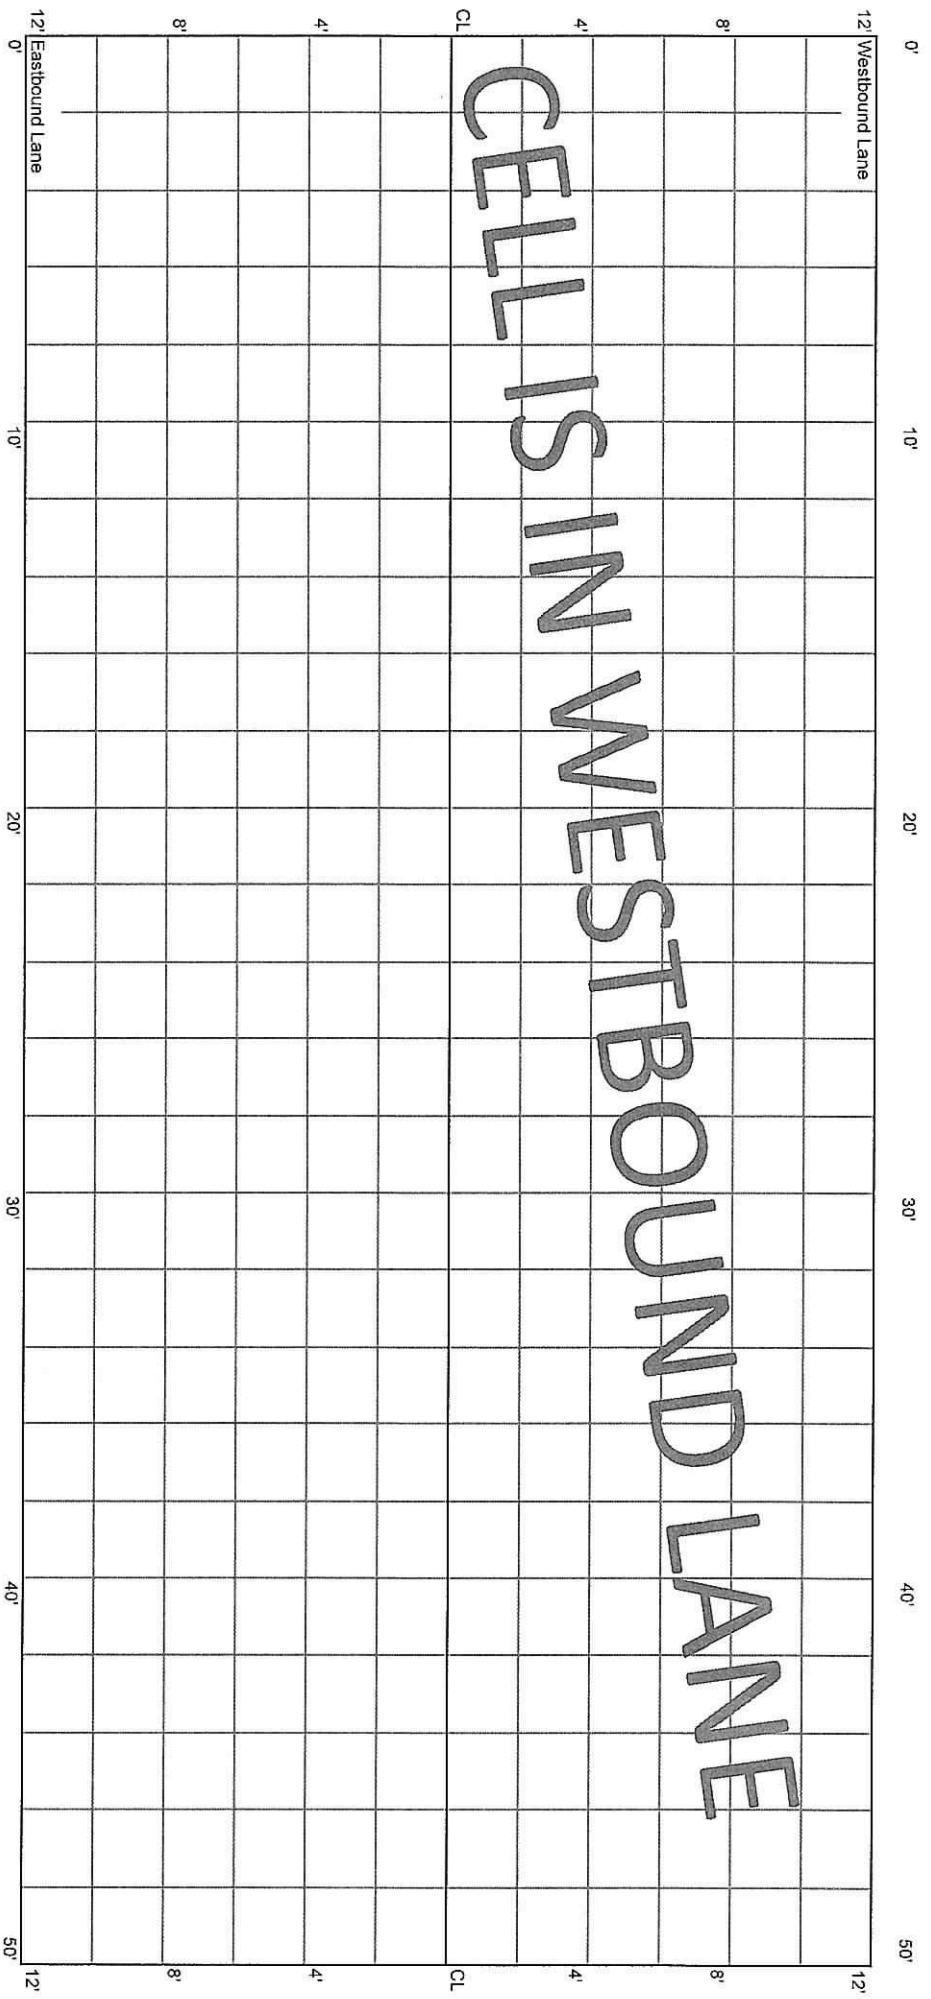

CELL 7006W  
300 - 350 ft

29+50


29+00

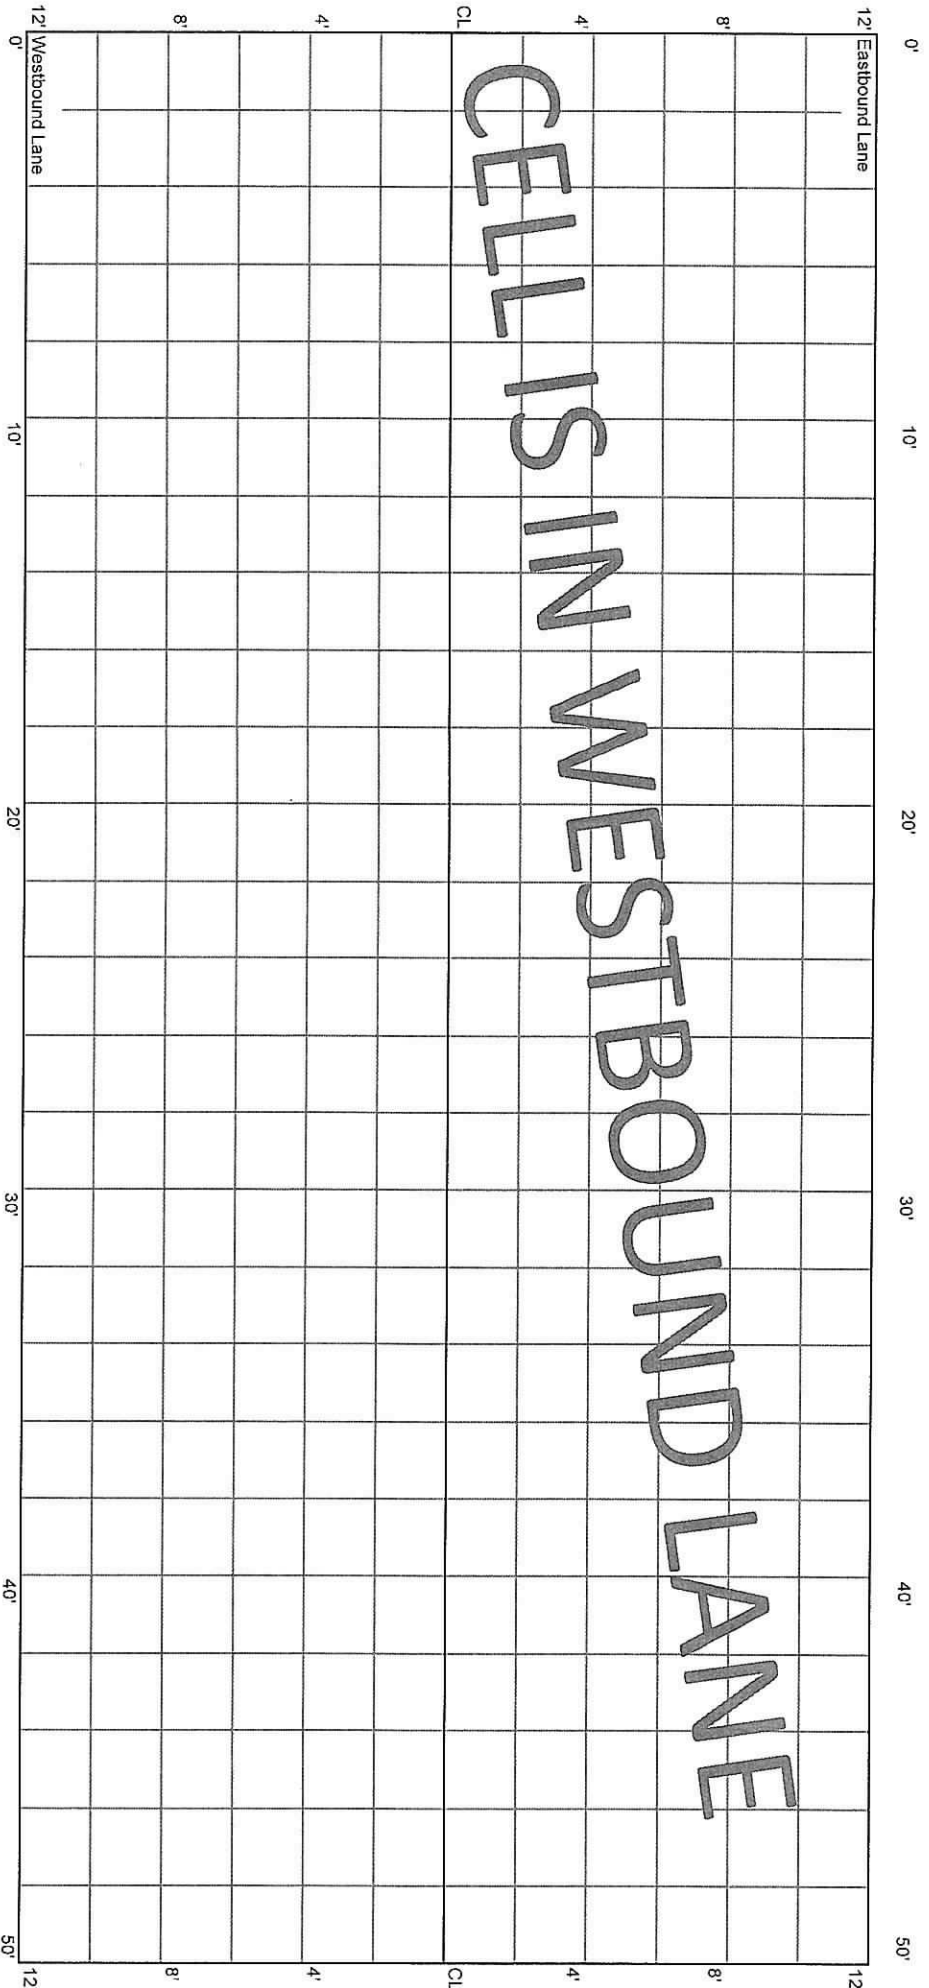

CELL 7006W  
350 - 400 ft

29+00

28+50

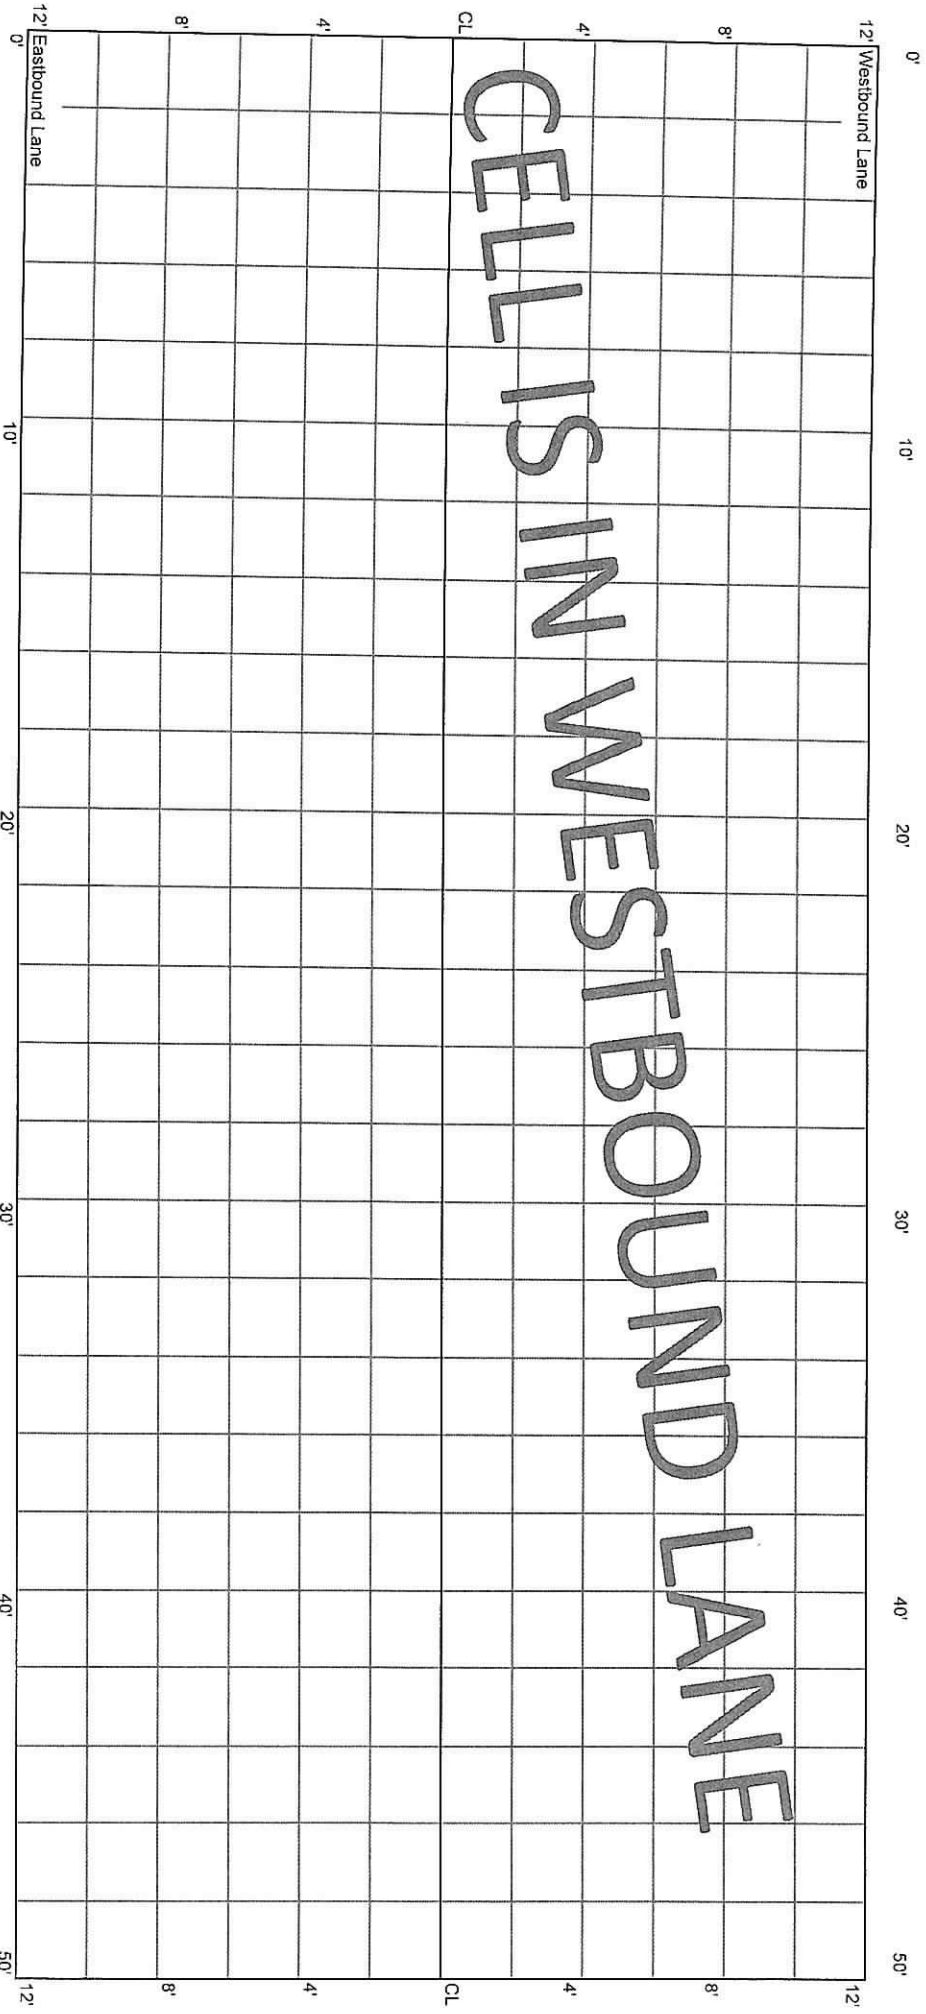




CELL 7006W  
400 - 450 ft

28+50


28+00

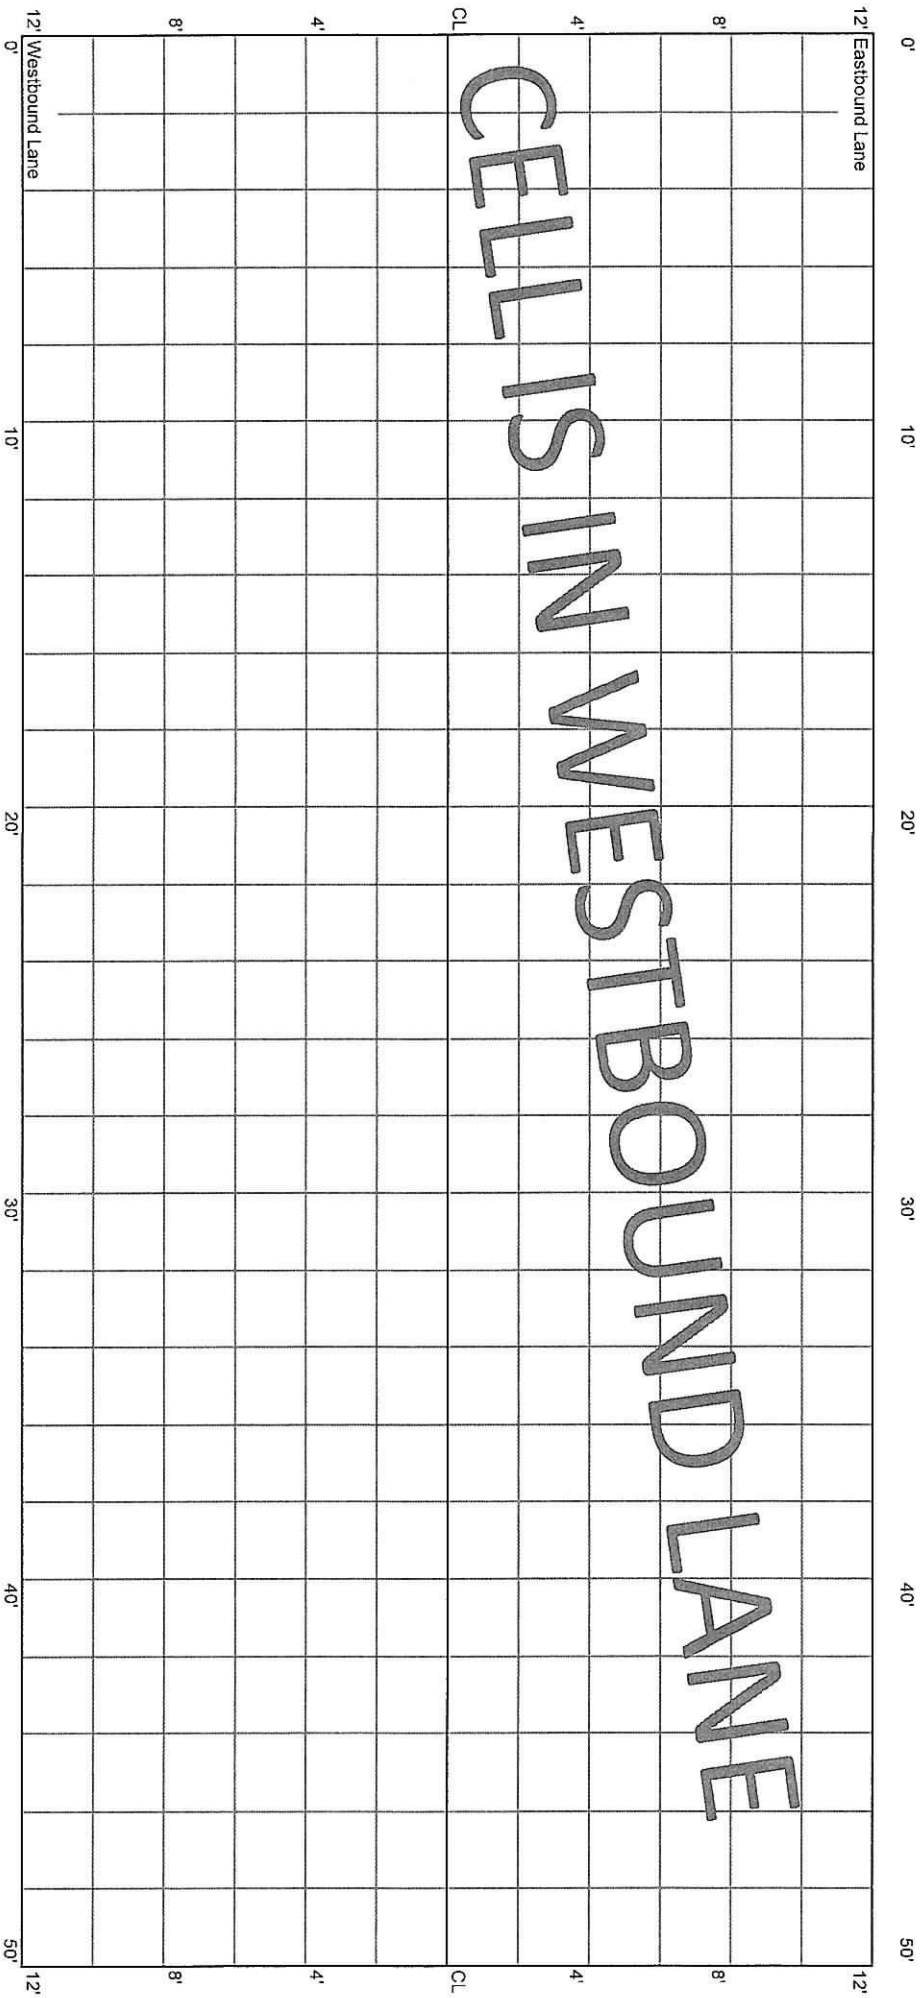

CELL 7006W  
450 - 500 ft

28+00

27+50

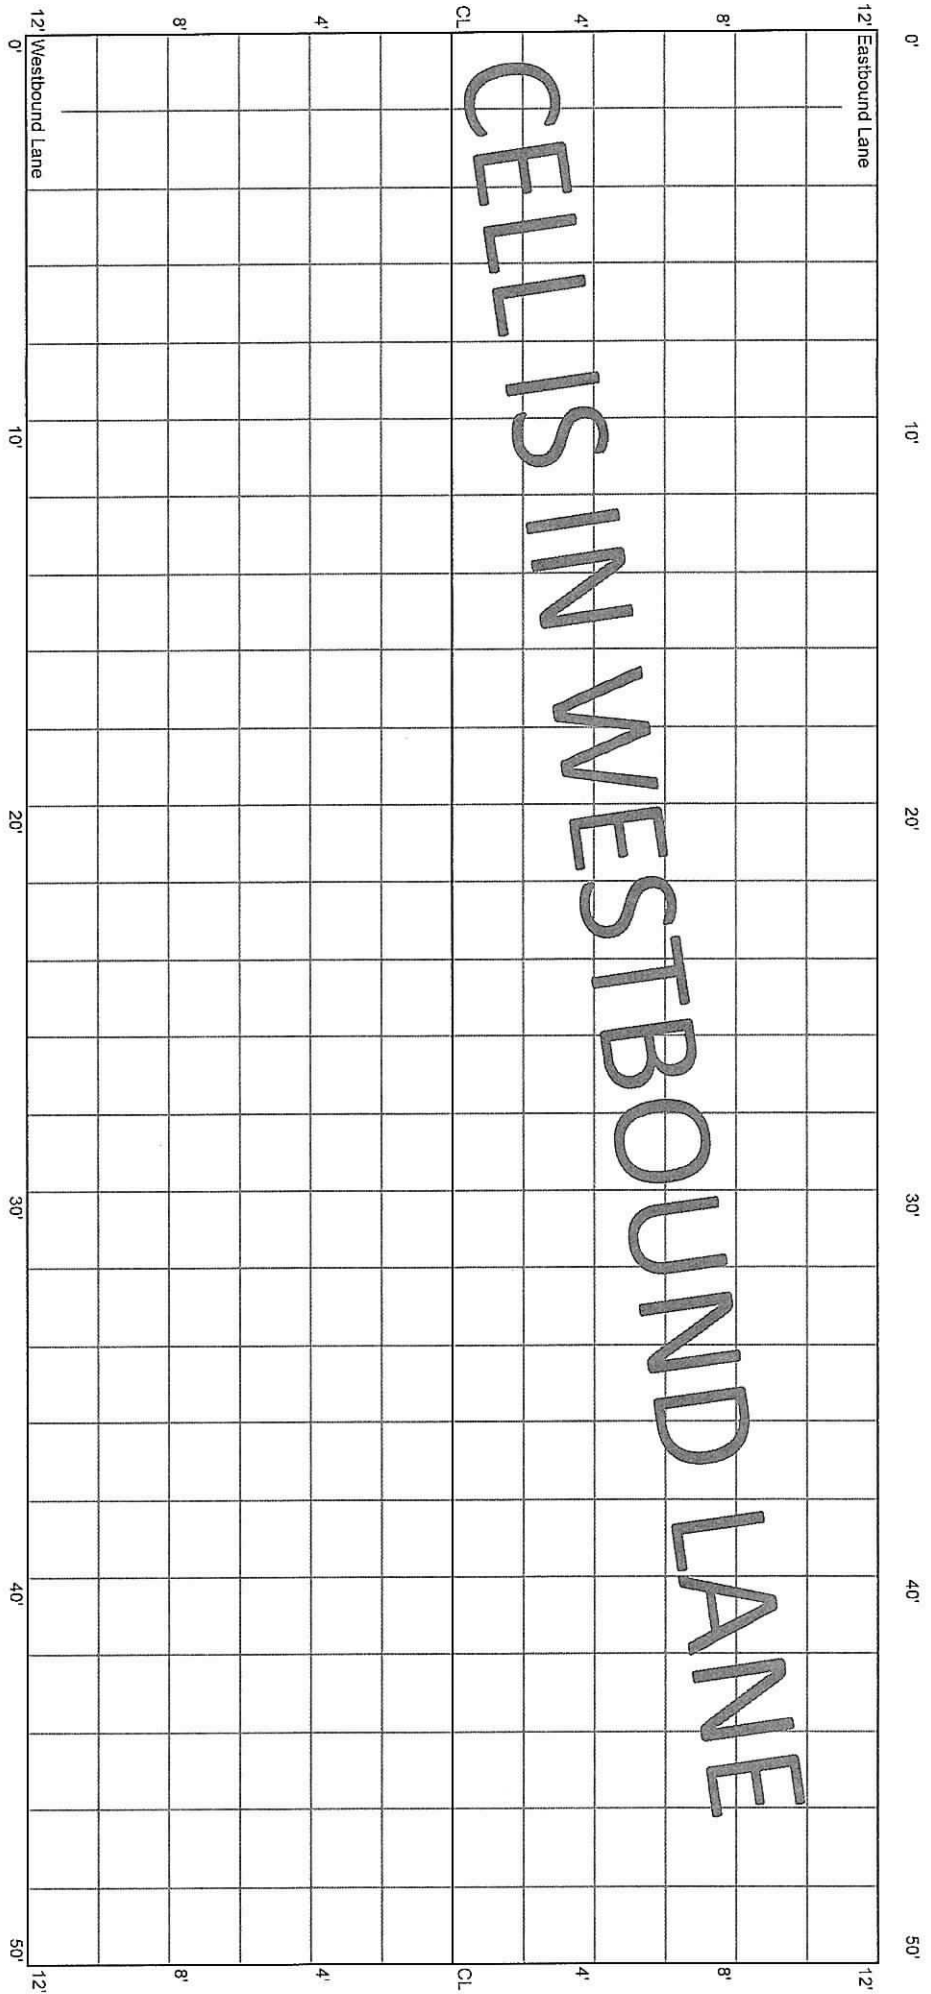

CELL 7006W  
500 - 550 ft

27+50

27+25

27+00

