

5:28, 20 E.J.  
10.14.25


CELL 7001E  
0 - 50 ft

File 70TH ST

Begin CL Kadler

0+00

0+50

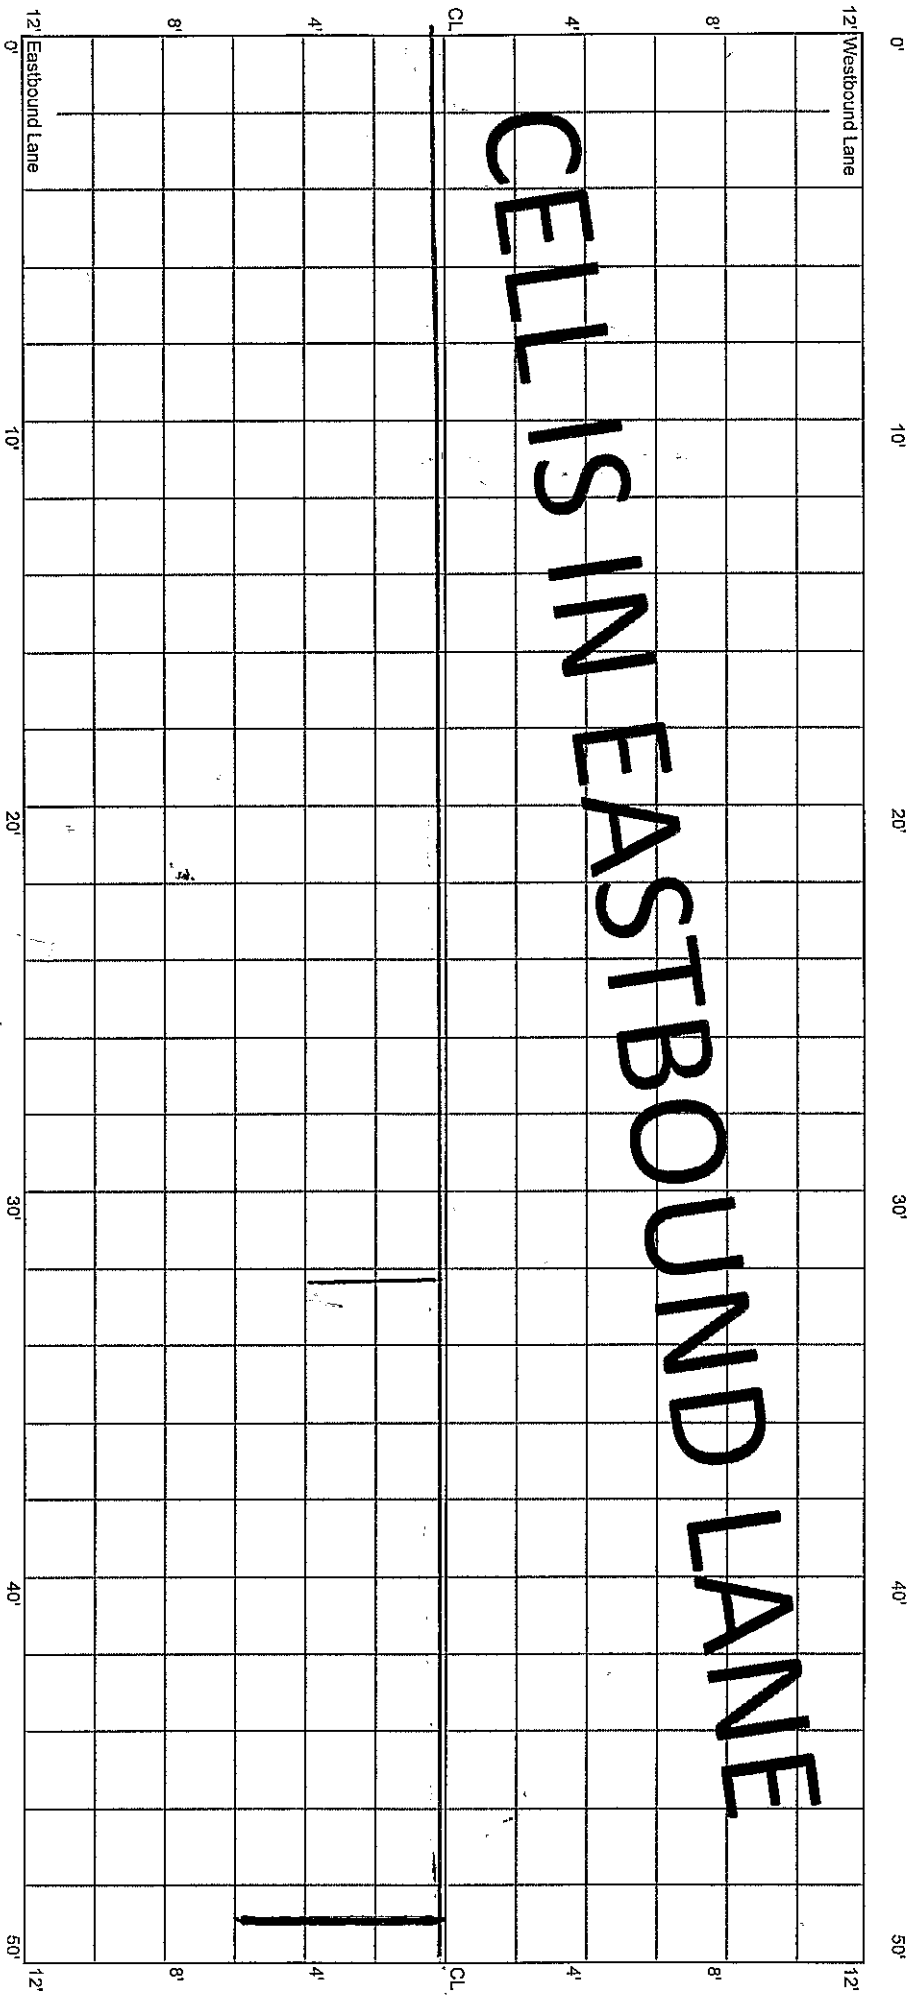


\* Pout Seal

\*

CELL 7001E  
50 - 100 ft

0+50

1+00

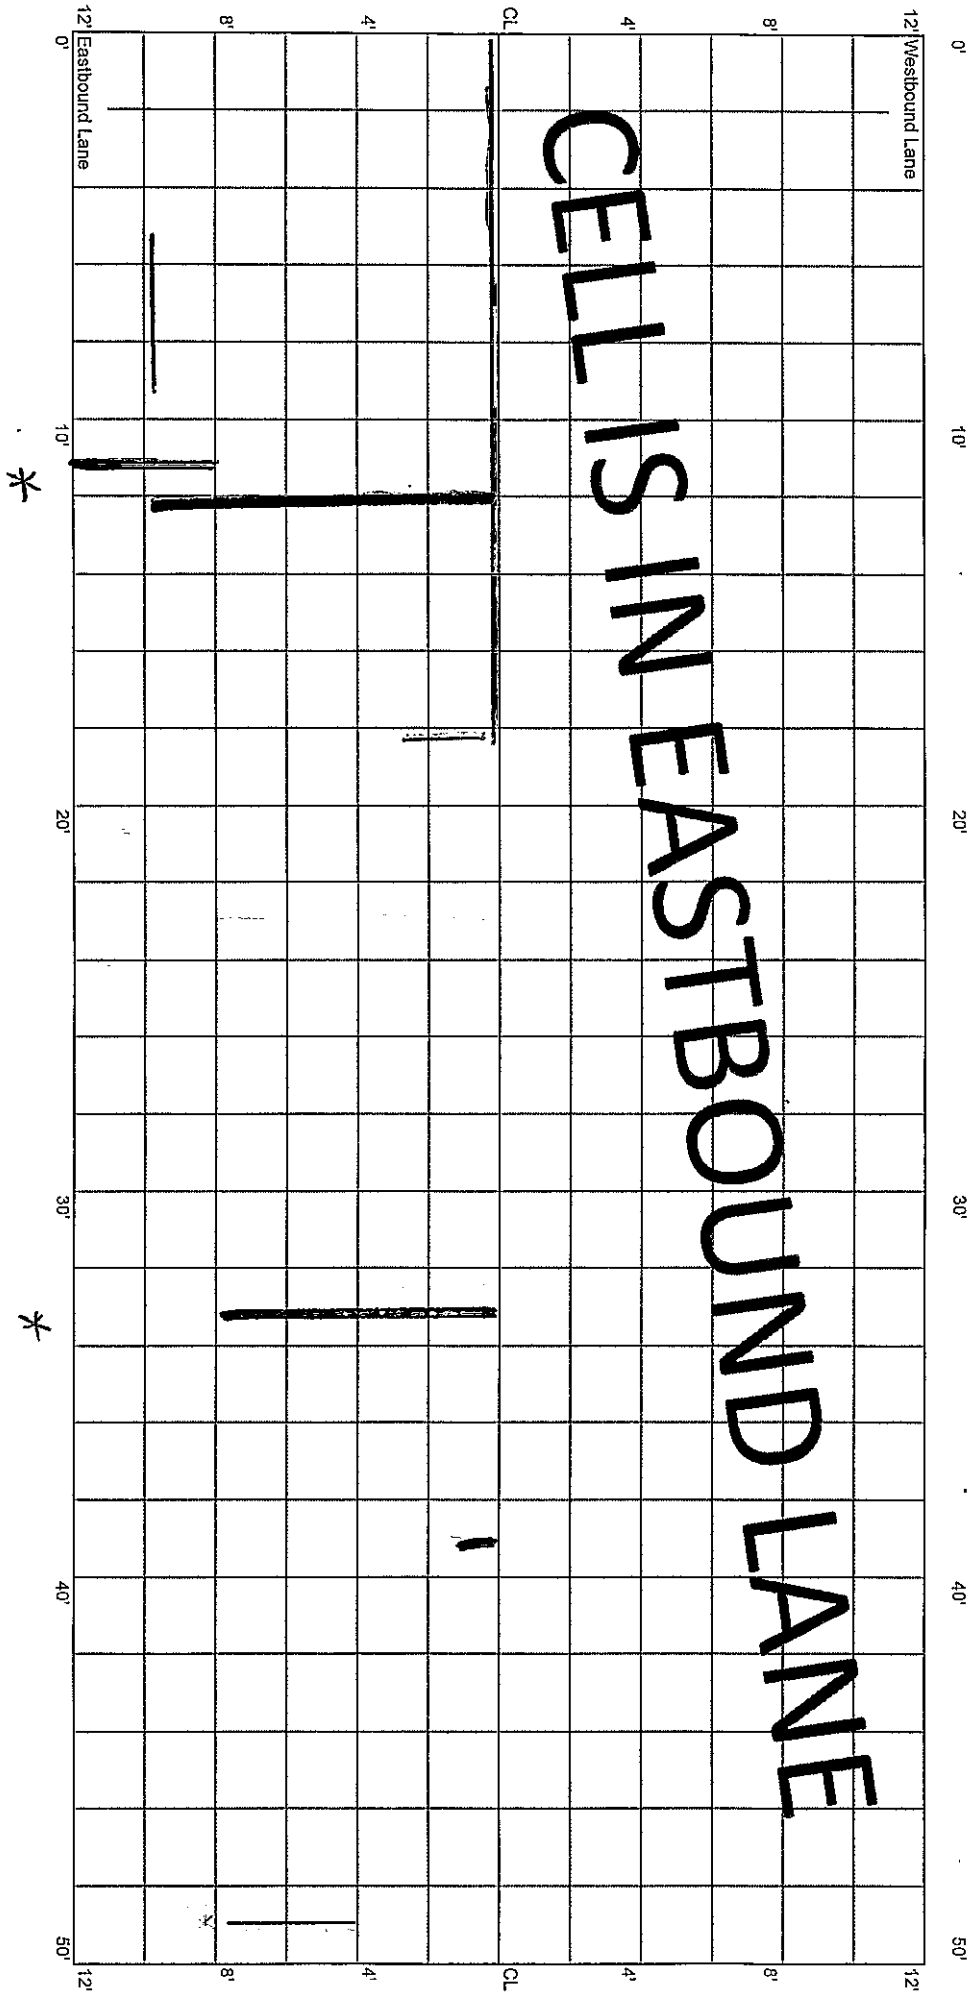


CELL IS IN EASTBOUND LANE

CELL 7001E  
100 - 150 ft

1+00


1+50

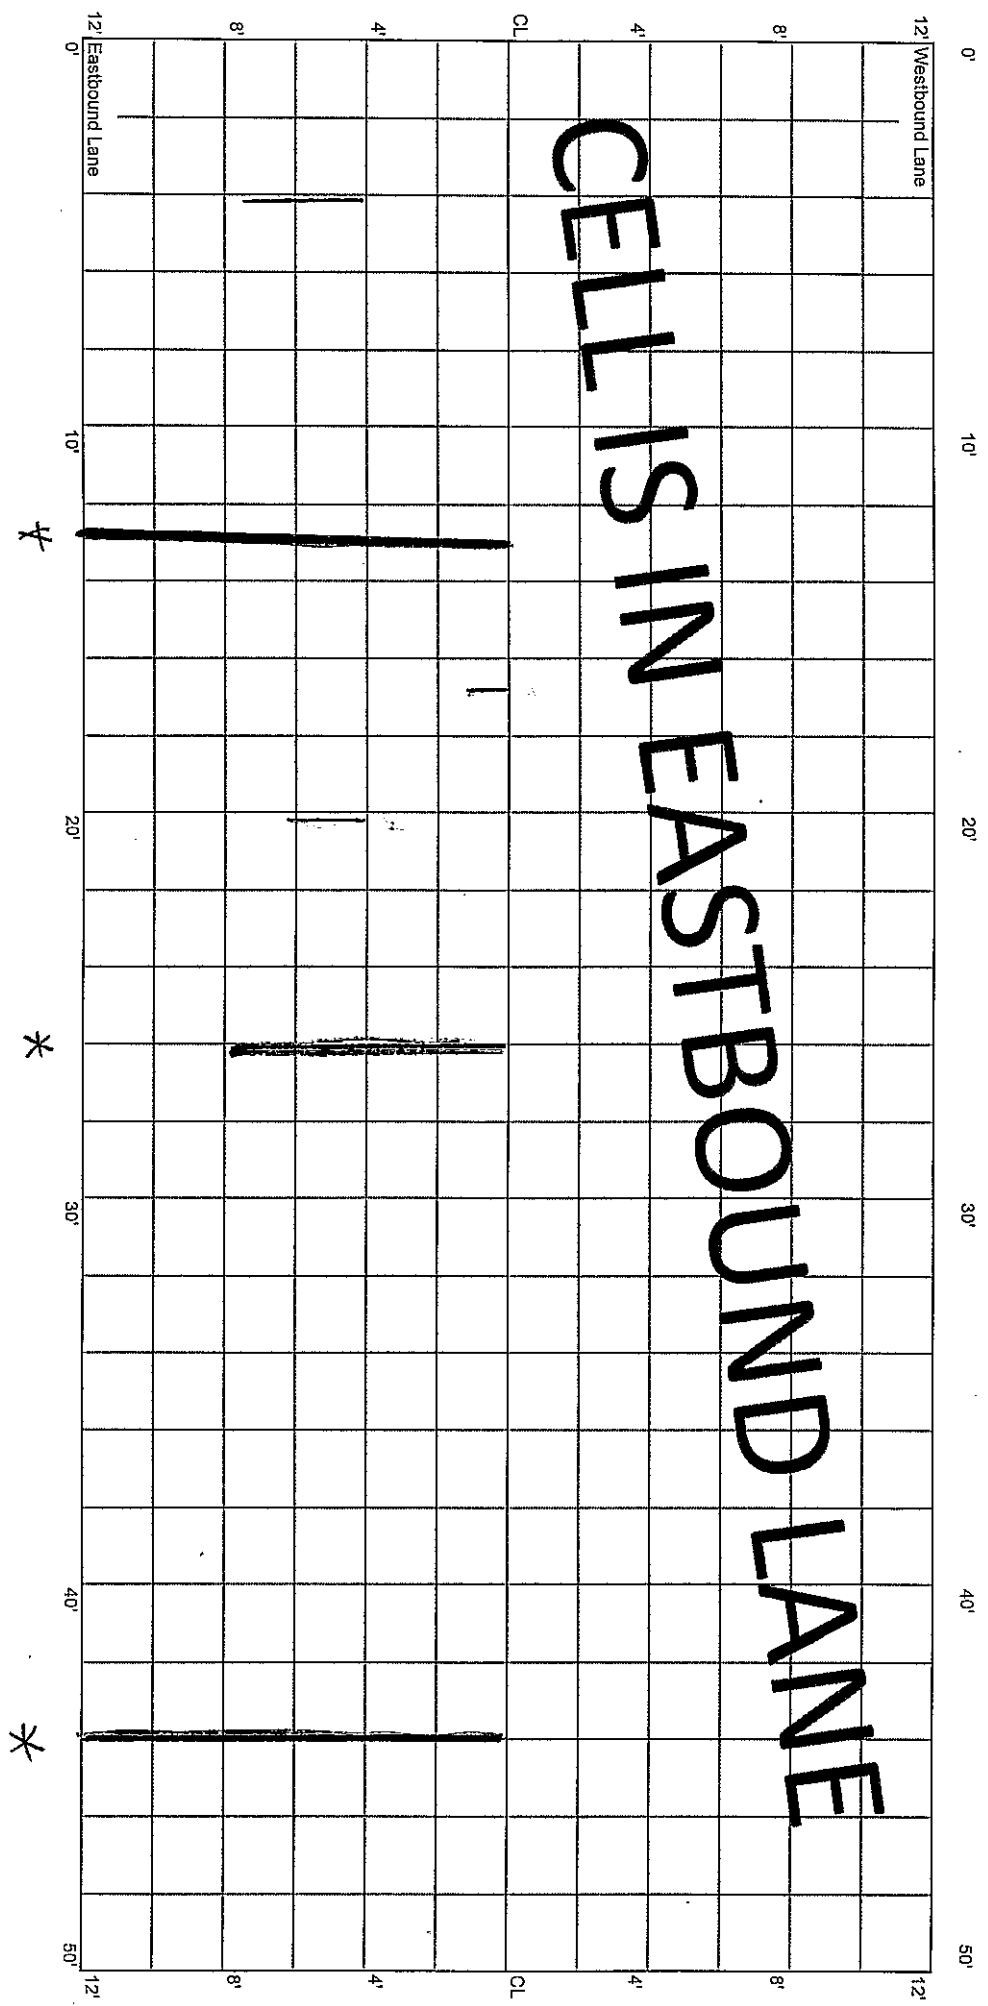

CELL 7001E  
150 - 200 ft

1+50


2+00

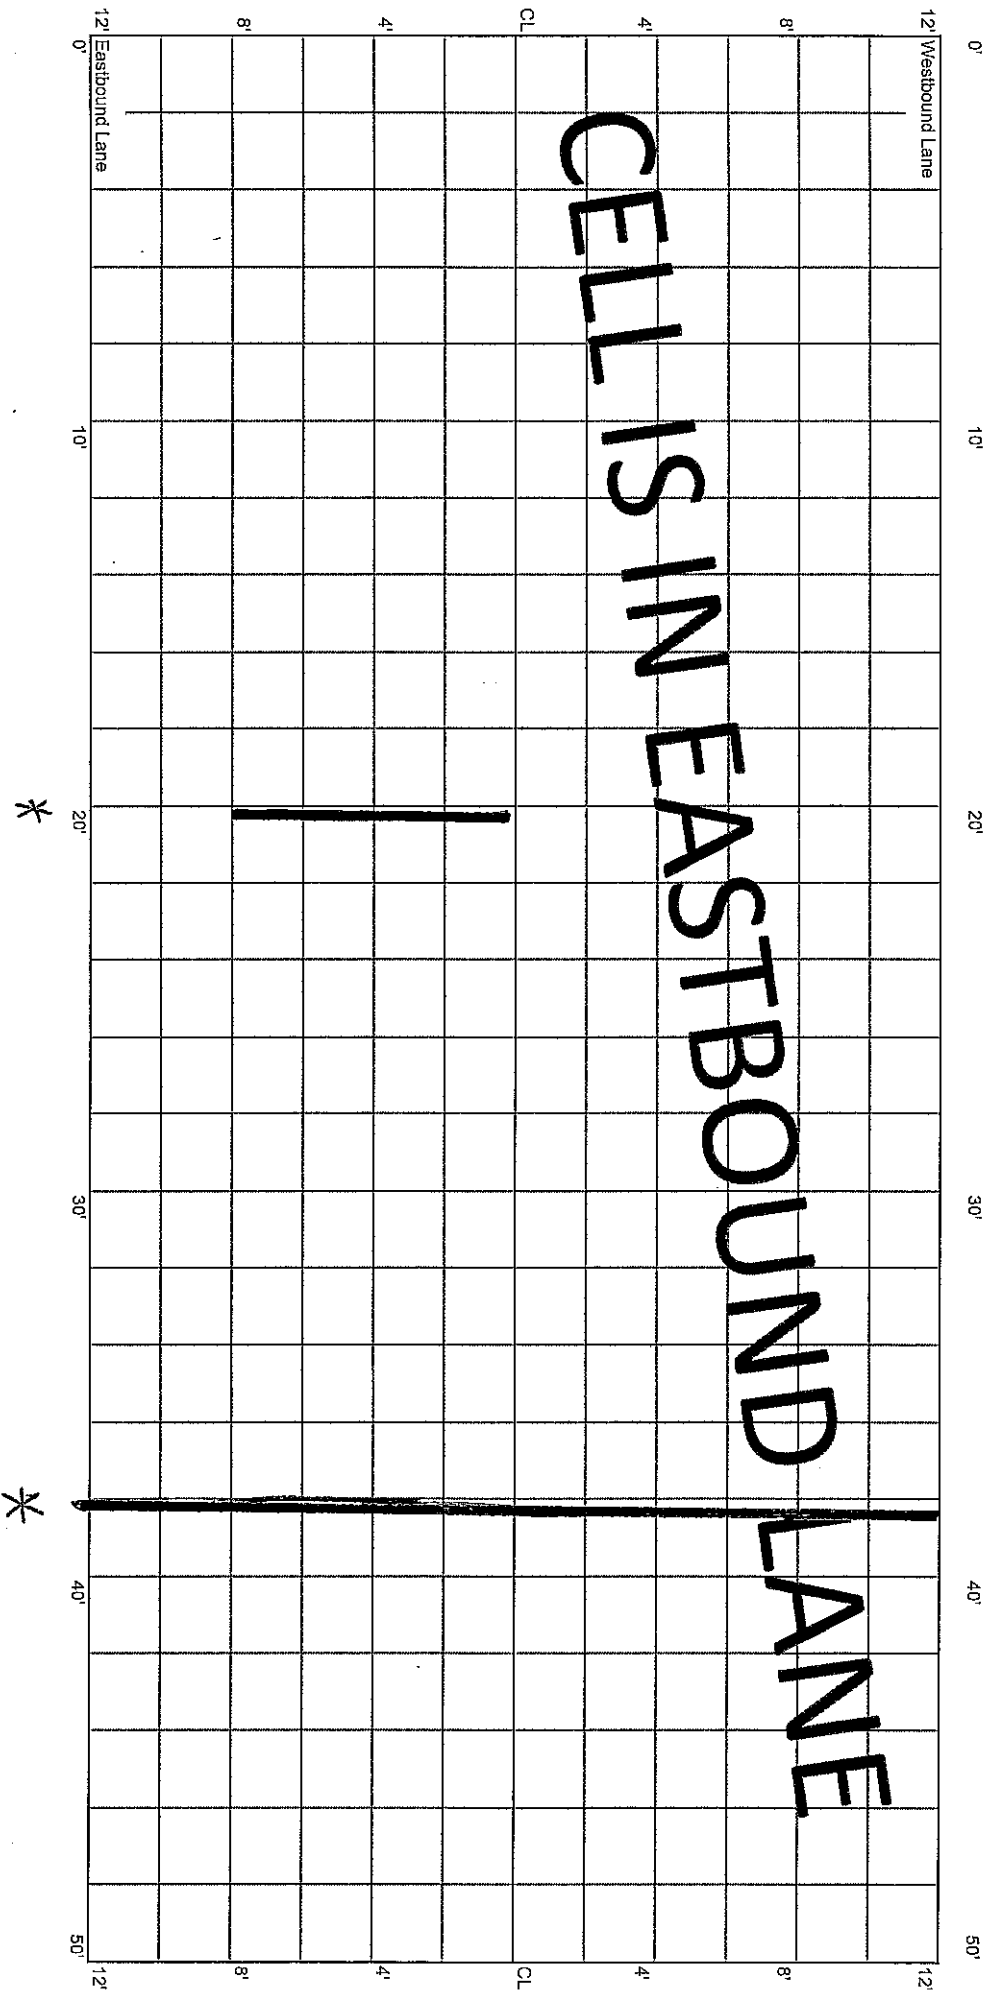

CELL 7001E  
200 - 250 ft

2+00


2+50

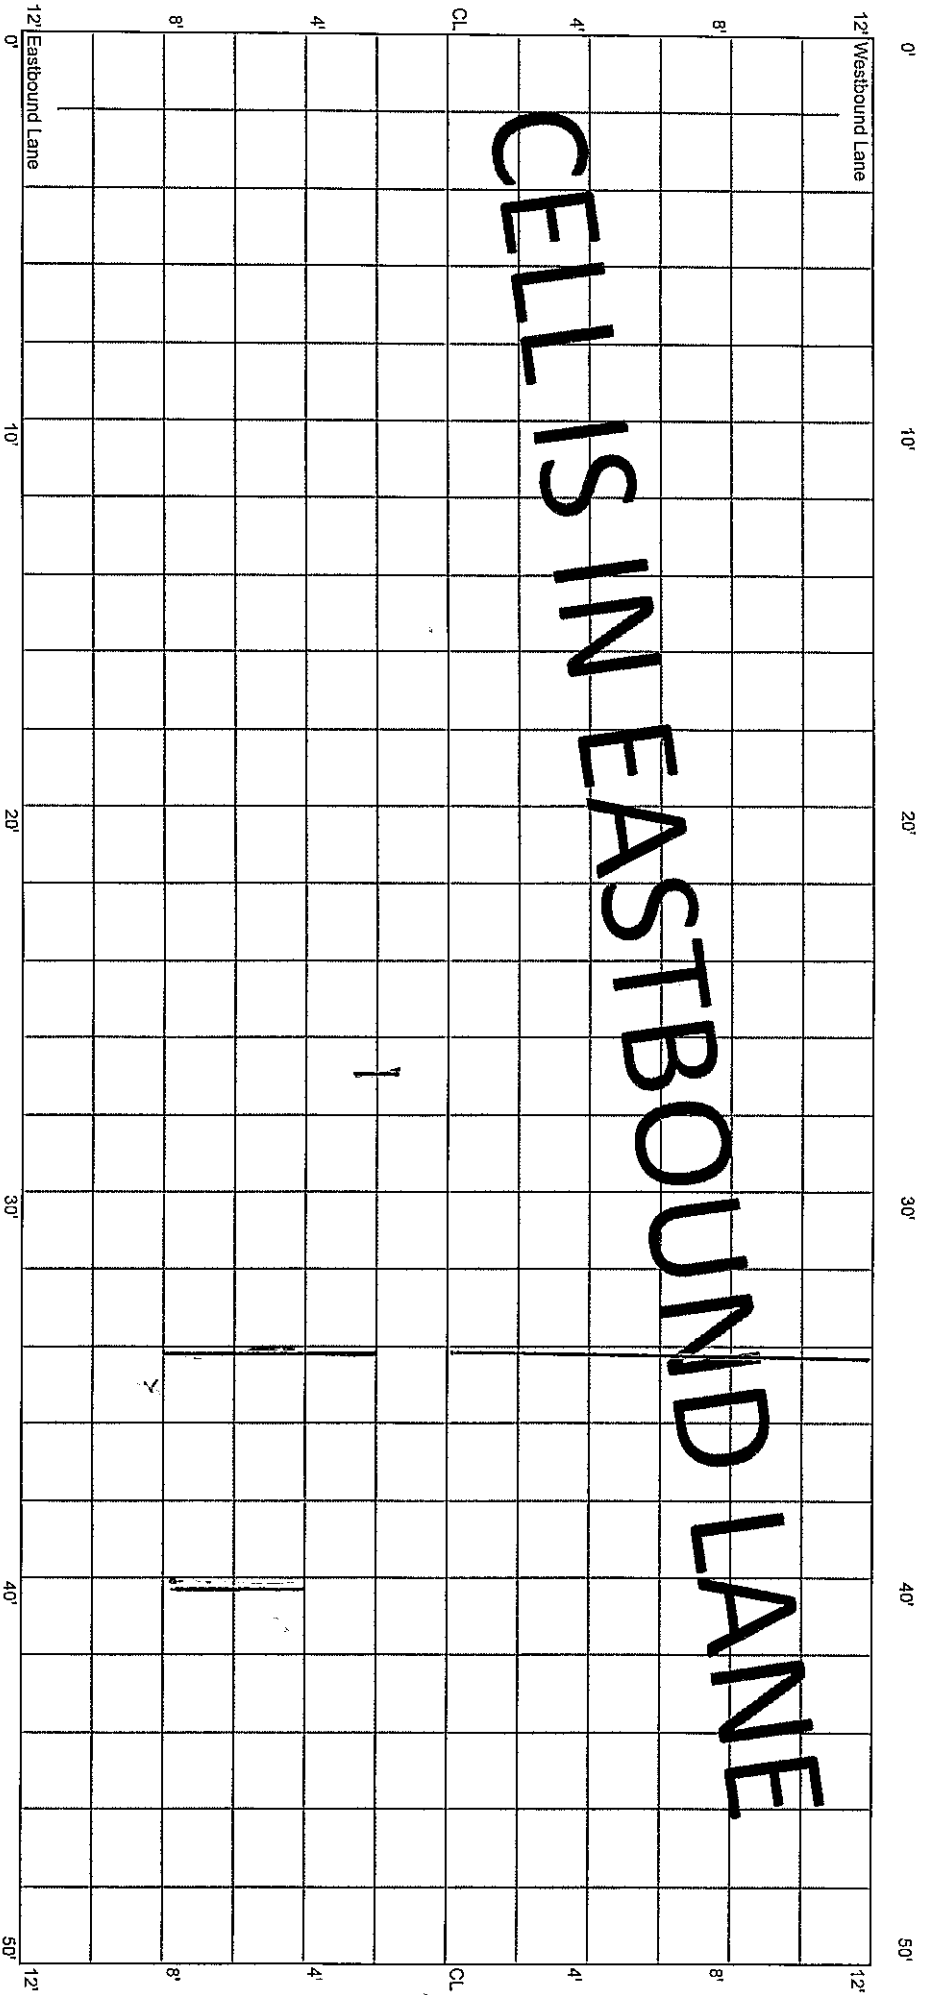

CELL 7001E  
250 - 300 ft


2+50

3+00

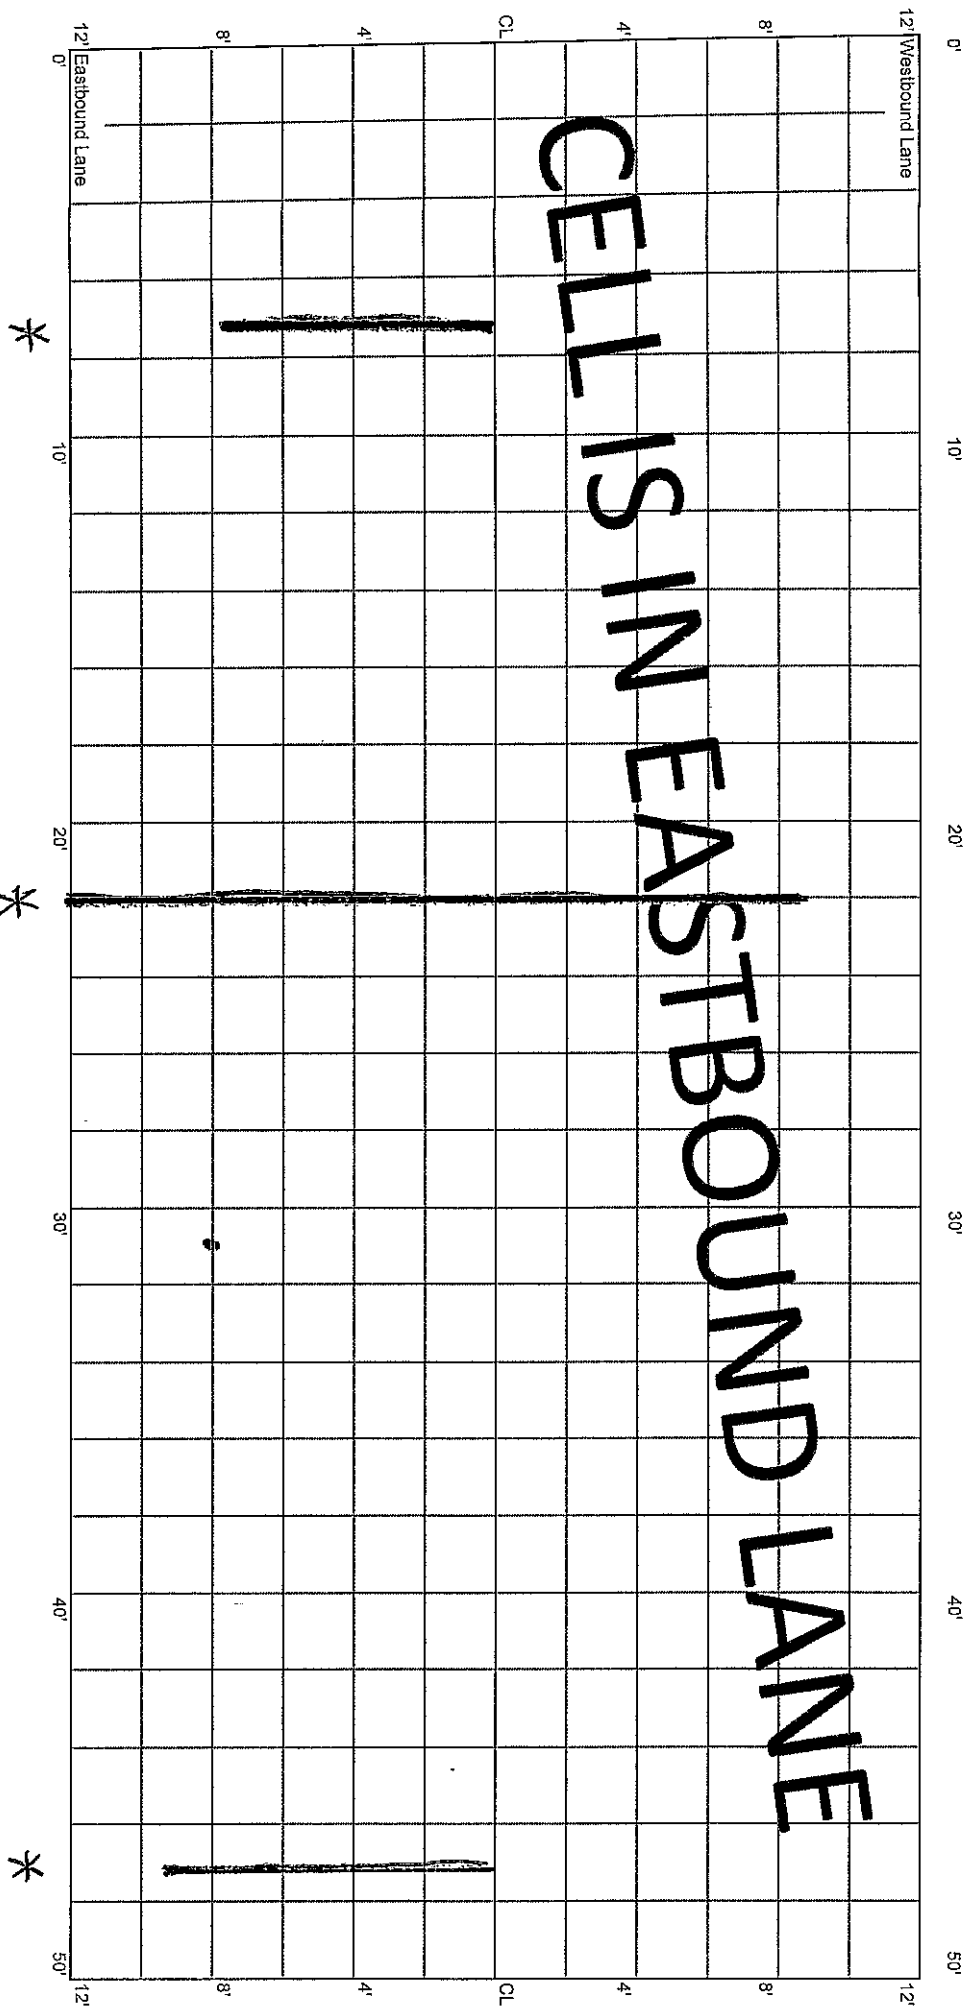

pop


CELL 7001E  
300 - 350 ft

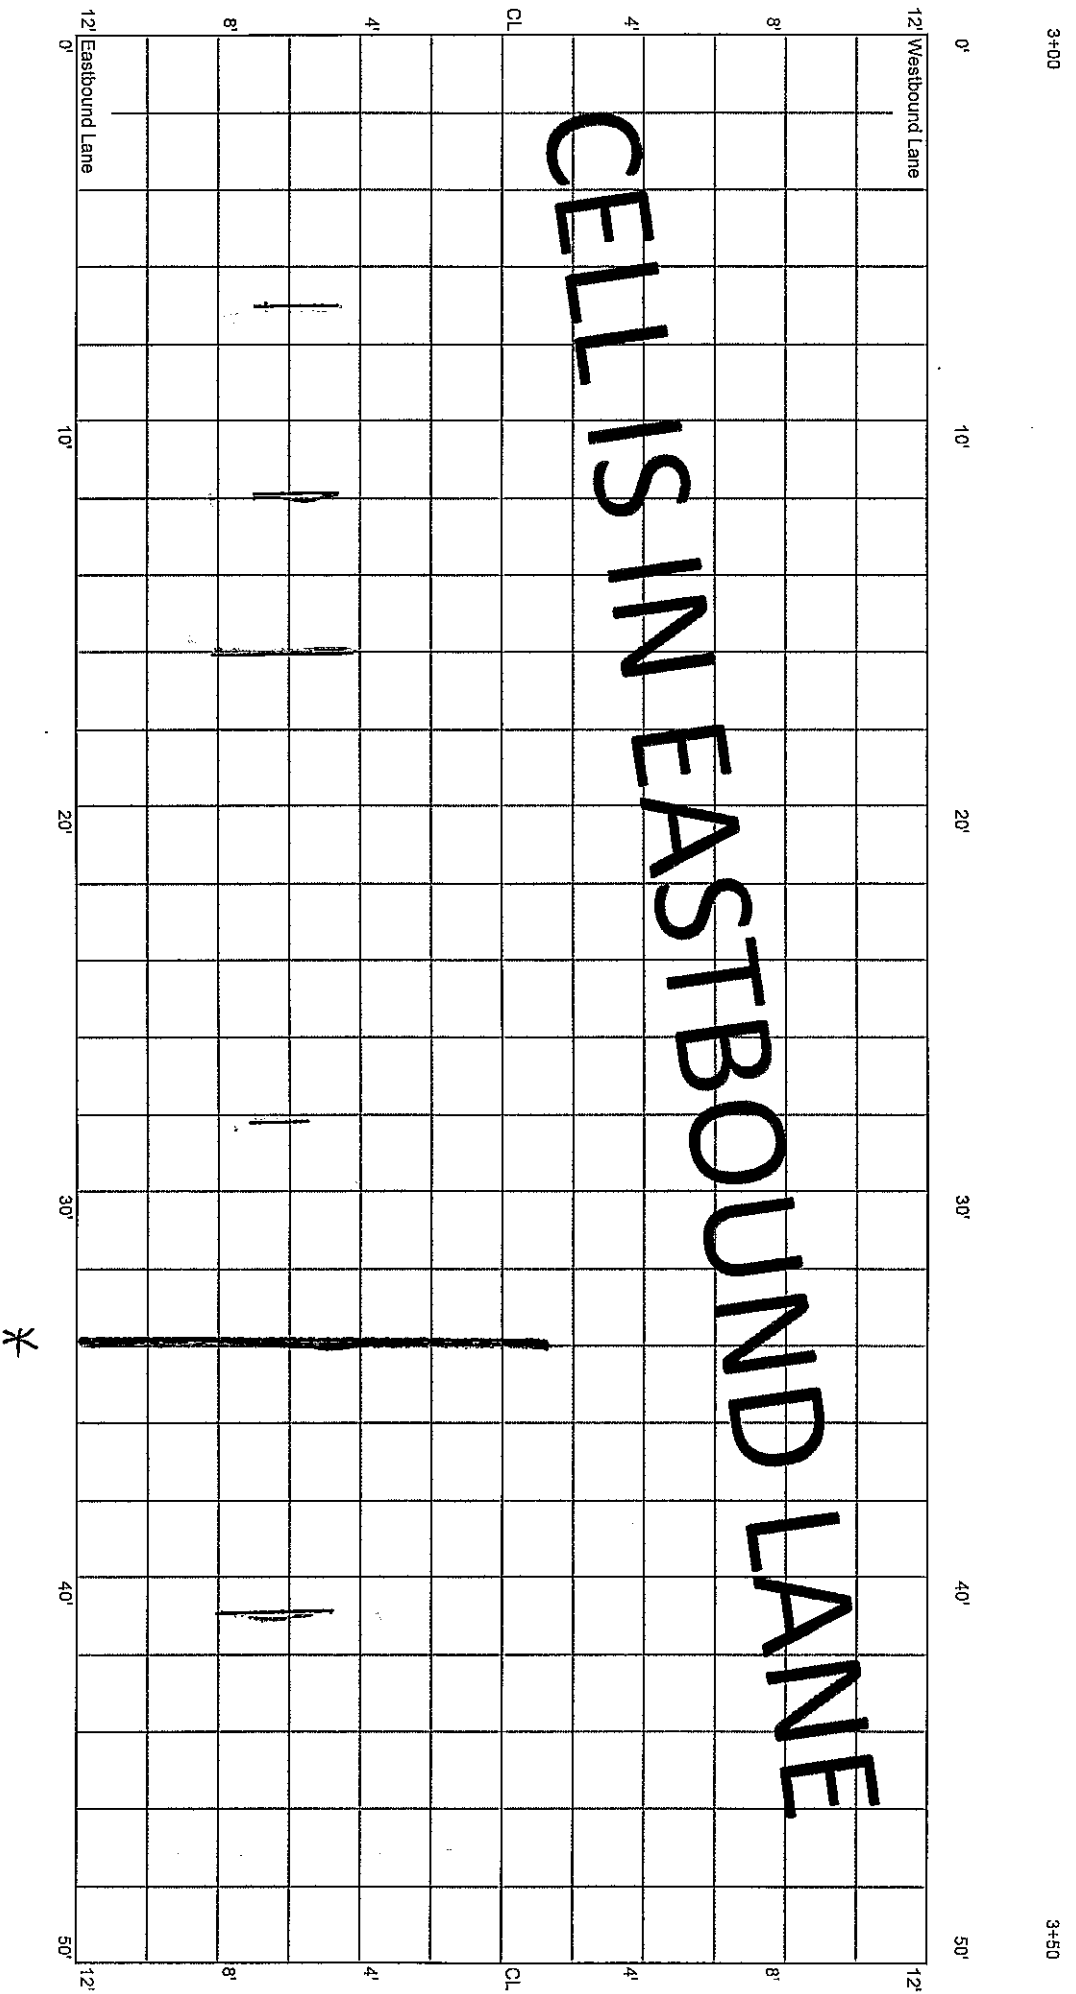

CELL 7001E  
350 - 400 ft

3+50

4+00

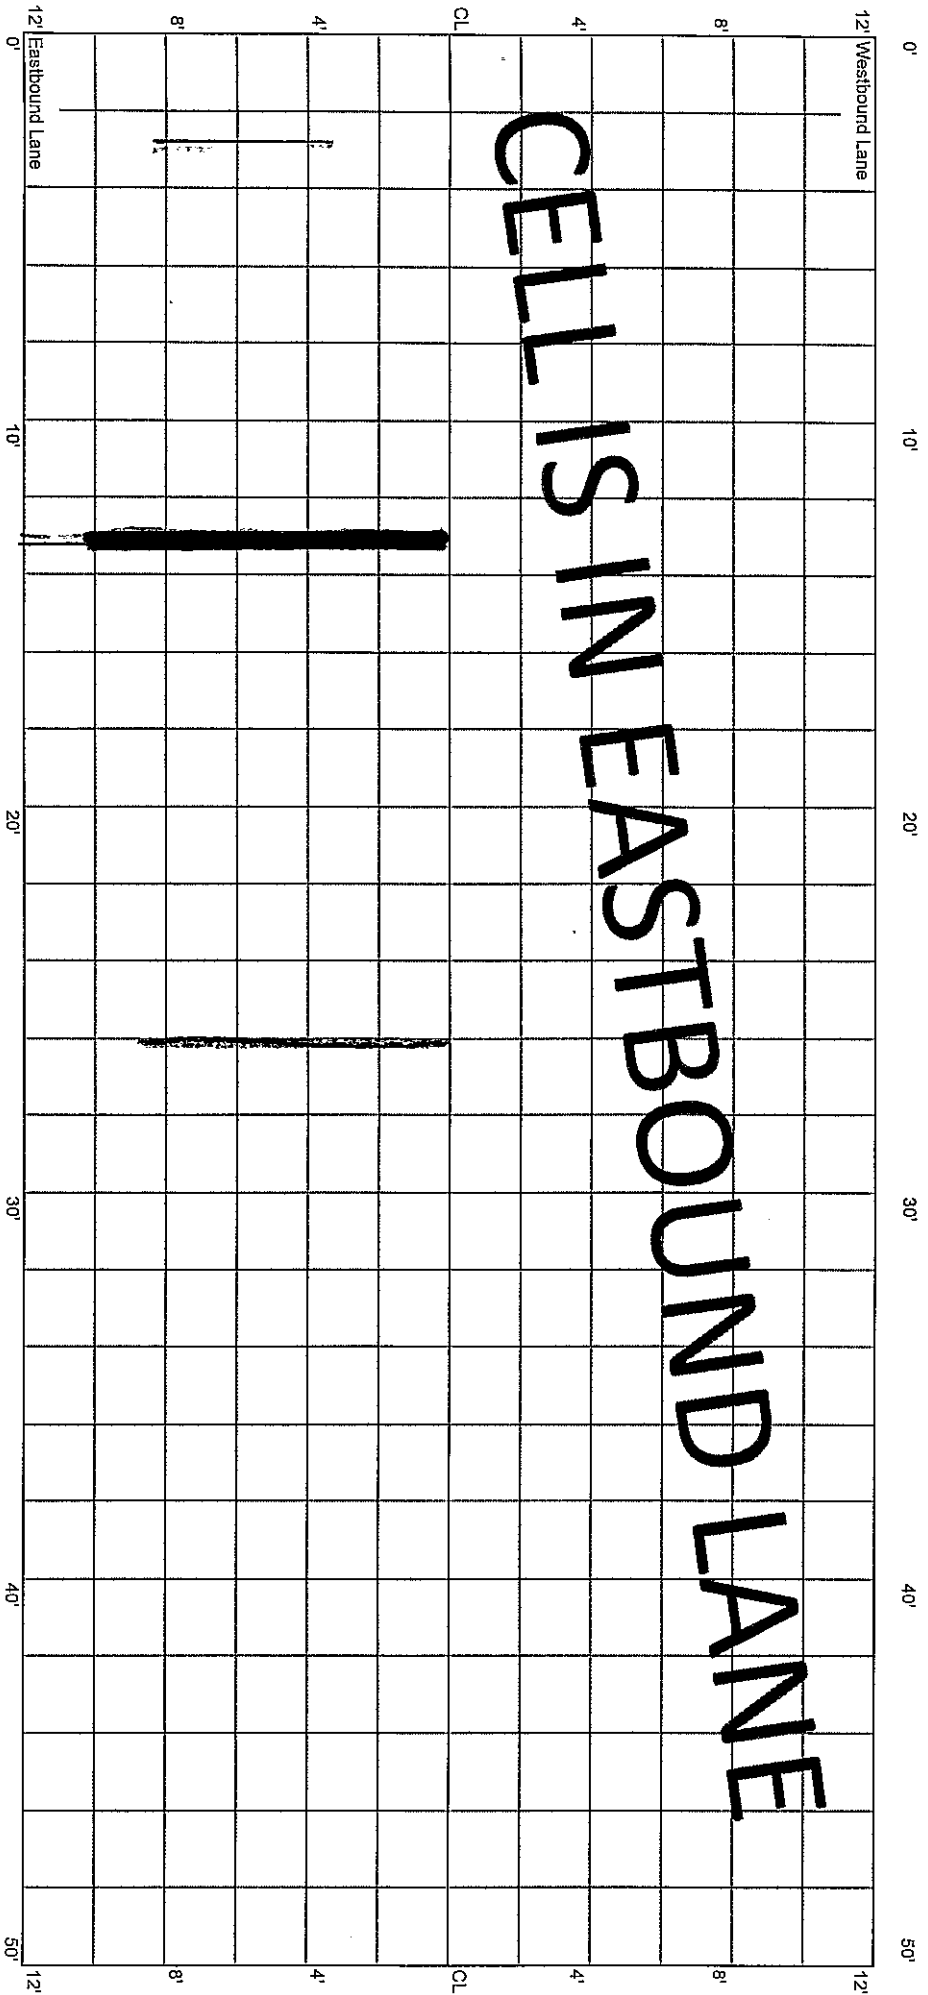

CELL IS IN EASTBOUND LANE

\* 10-ft


\*




CELL 7001E  
400 - 450 ft

4+00

4+50

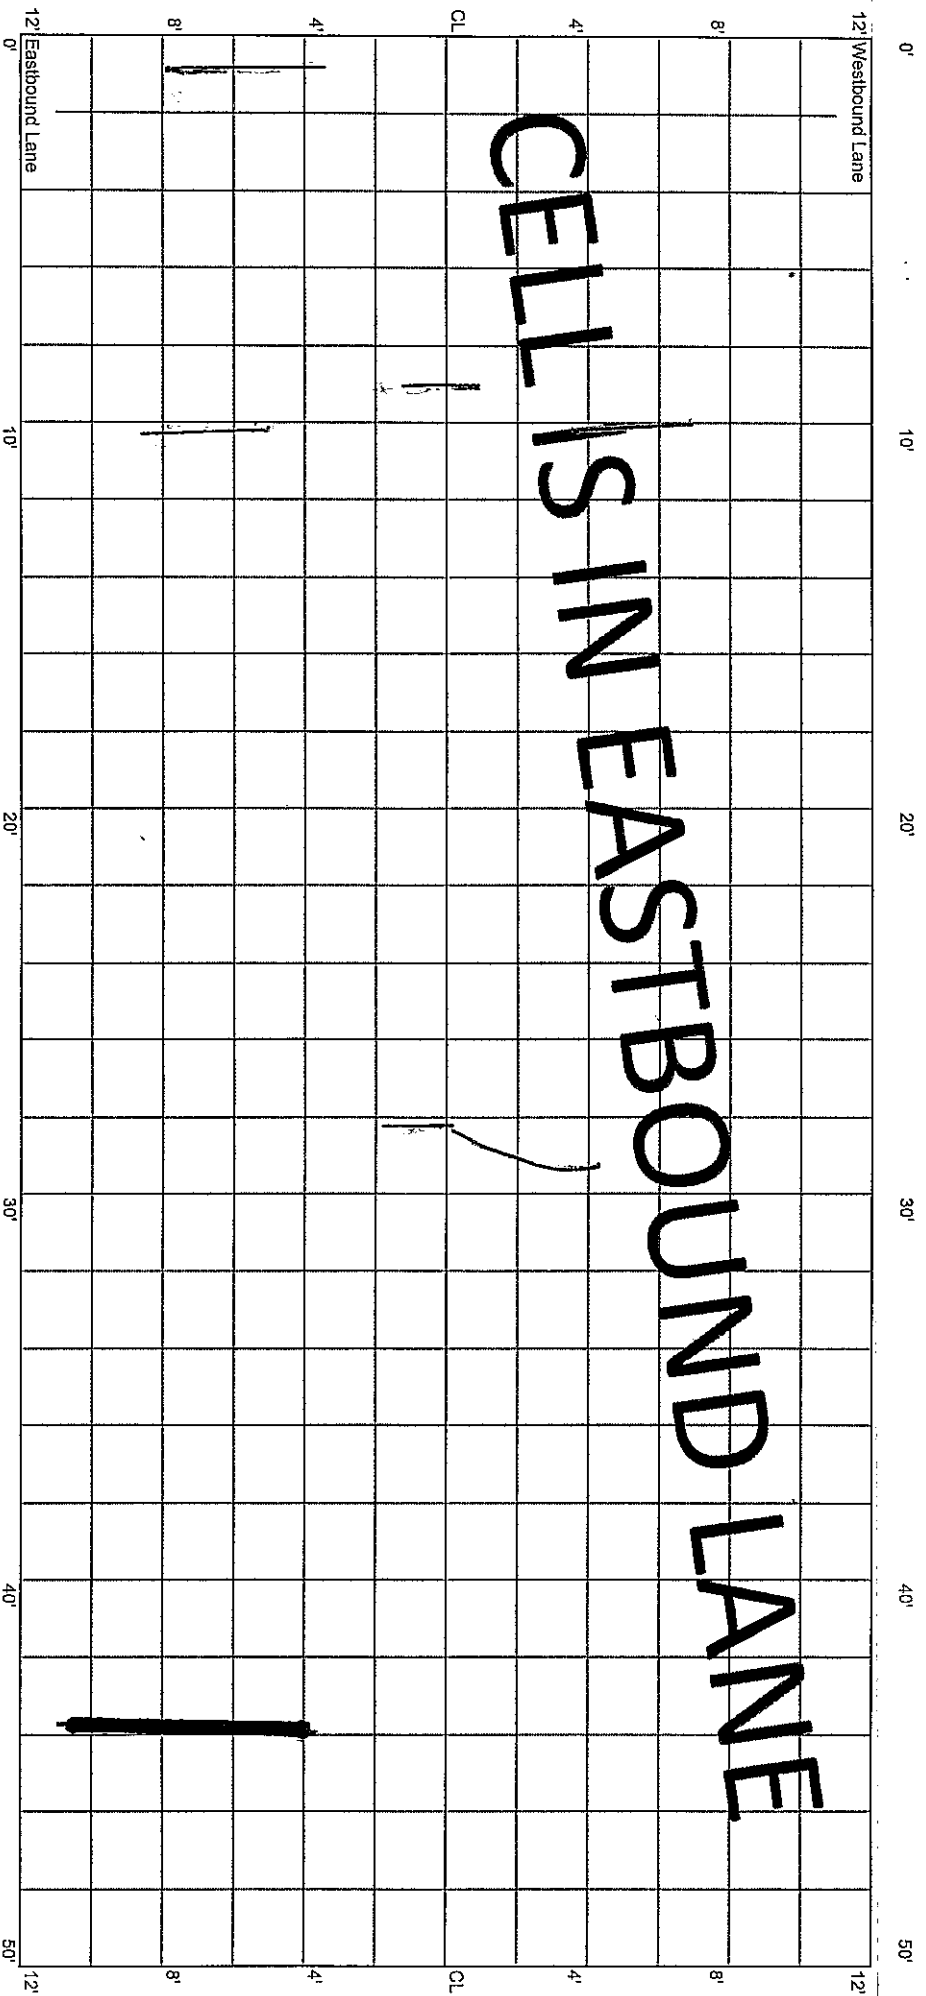

CELL 7001E  
450 - 500 ft

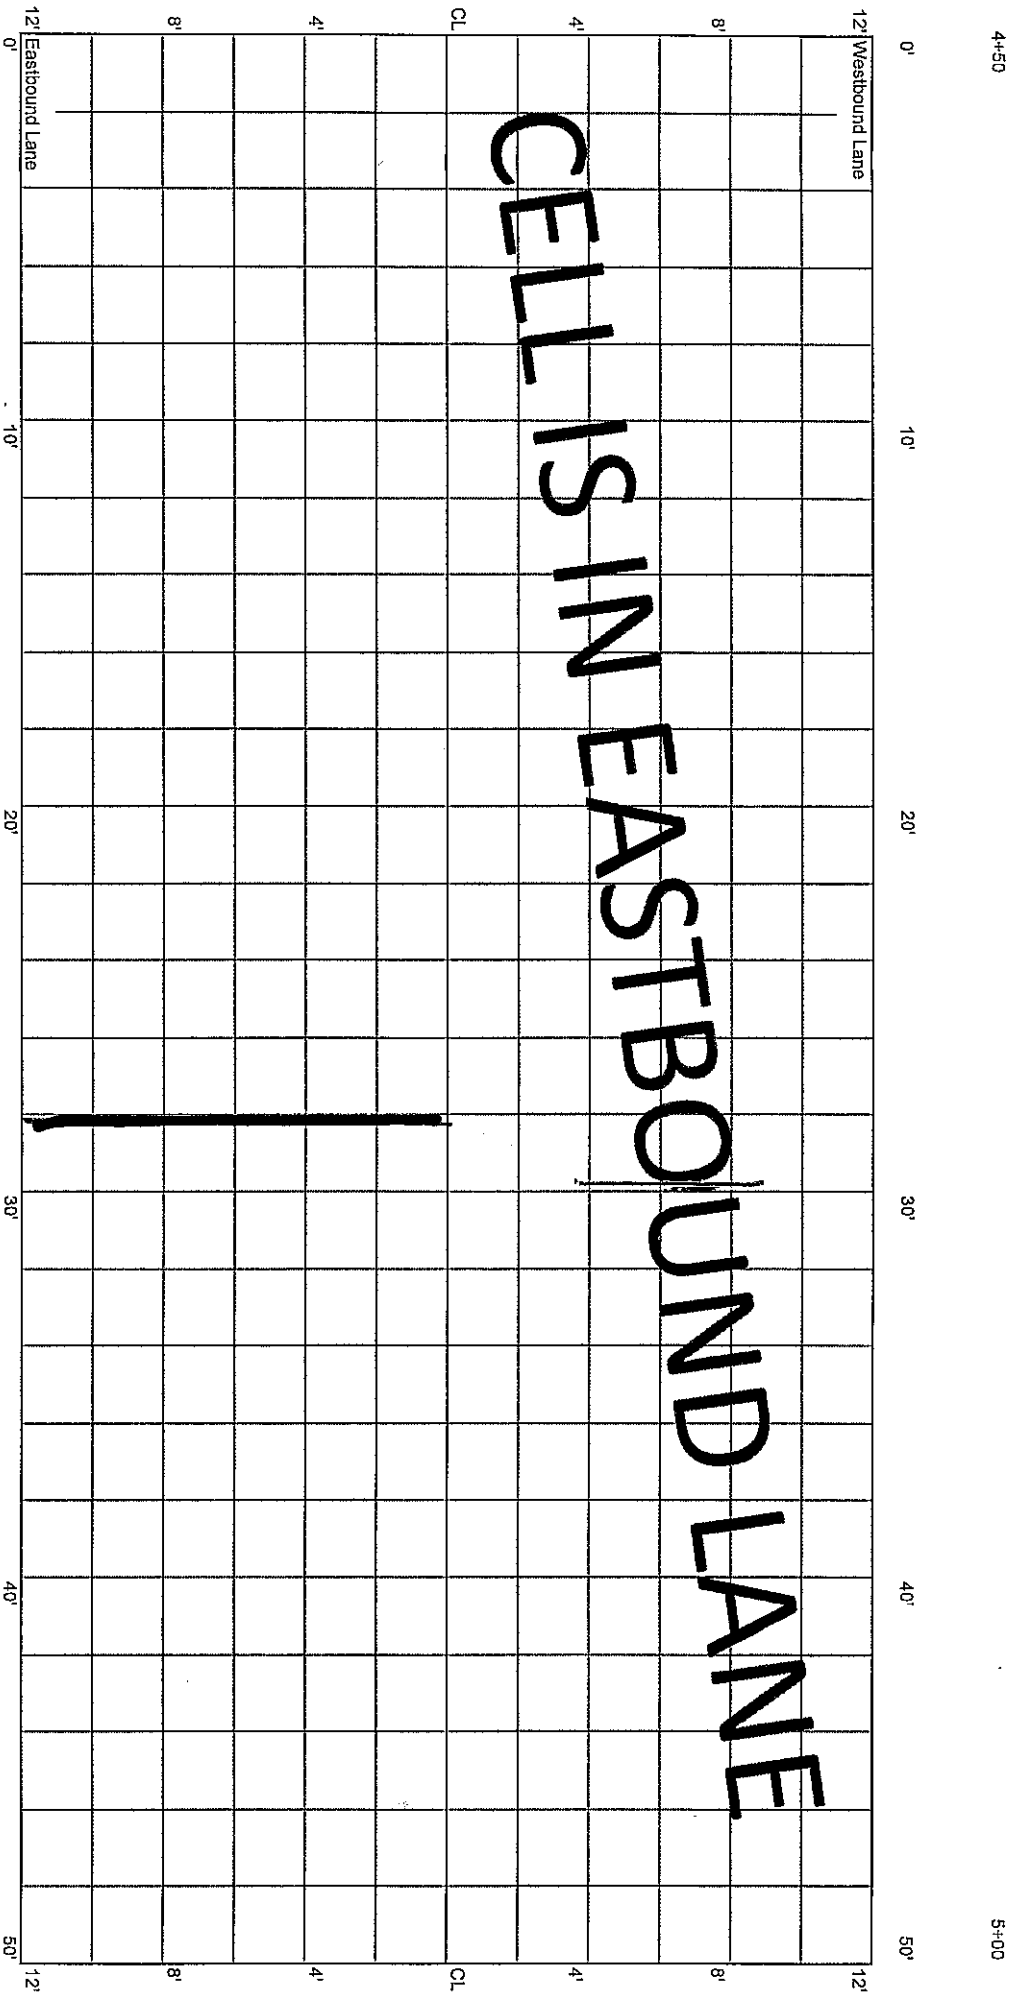


CELL 7001E  
500 - 550 ft

5+00

5+25

5+50

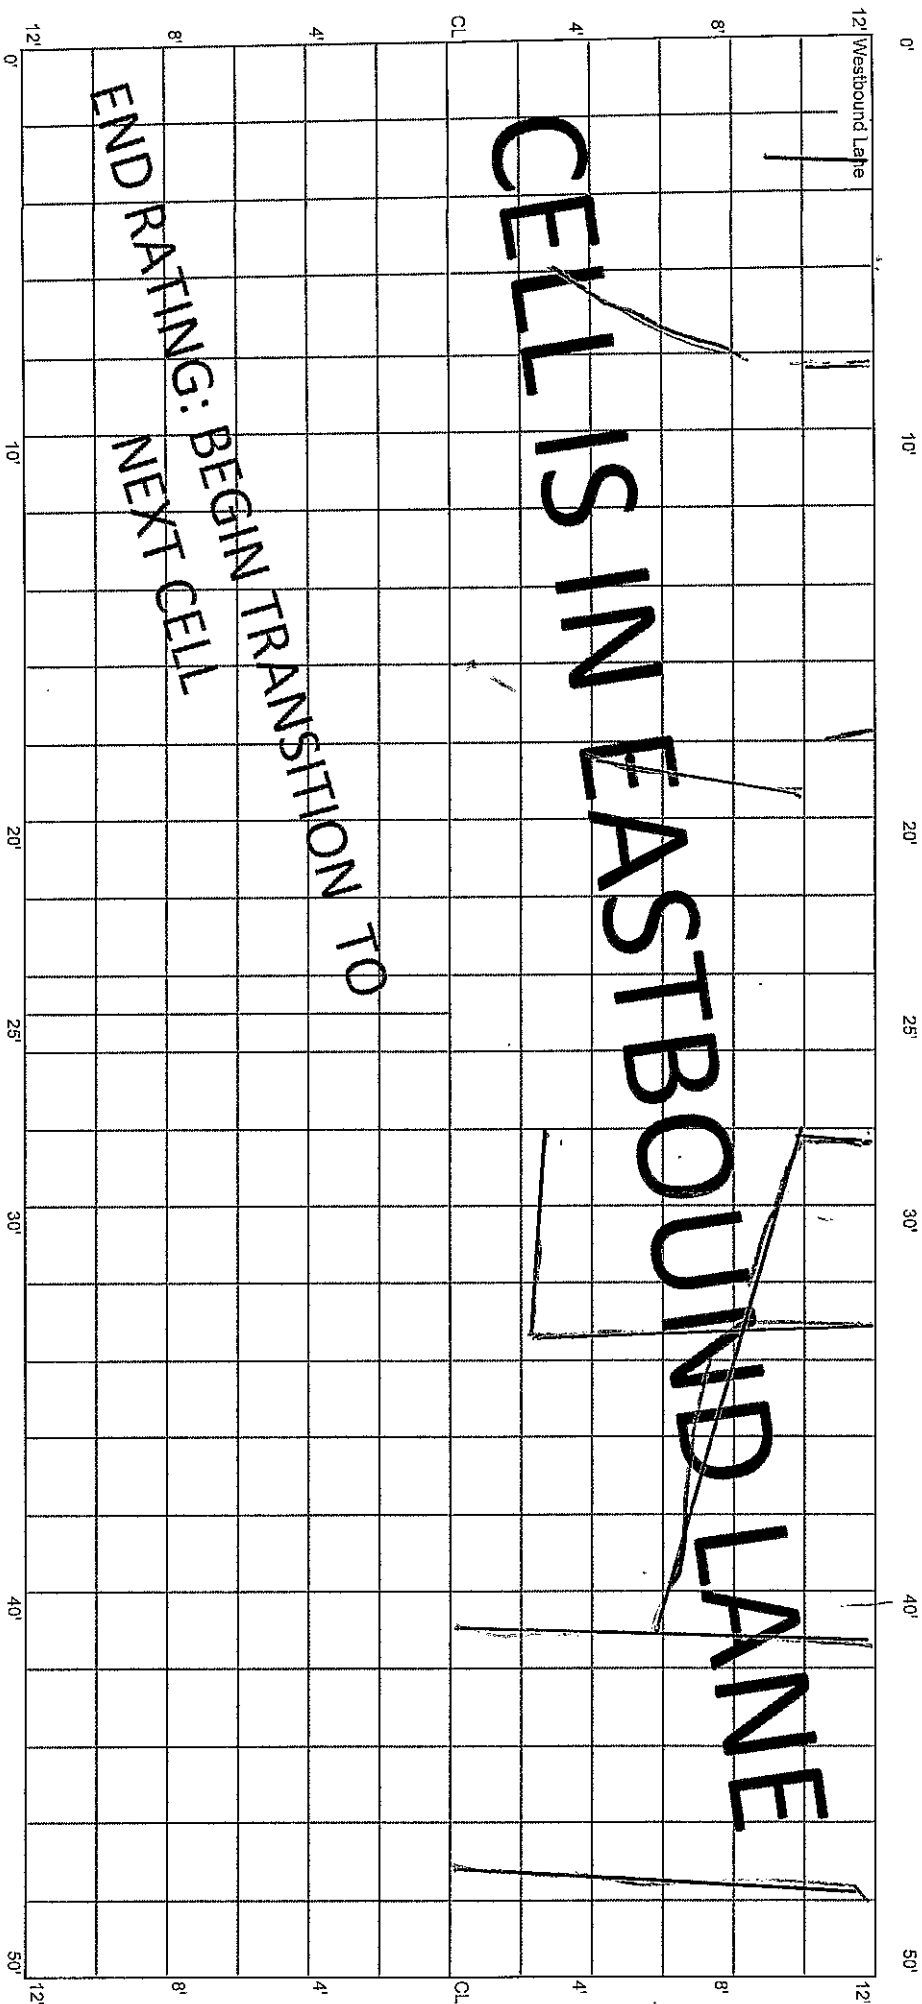

CELL IS IN EASTBOUND LANE

END RATING: BEGIN TRANSITION TO  
NEXT CELL

