

5.28.20 E.I.

10.14.20


File 70TH ST

CELL 7004E
0 - 50 ft

16+50

17+00

Put outside of Fog line for 150'

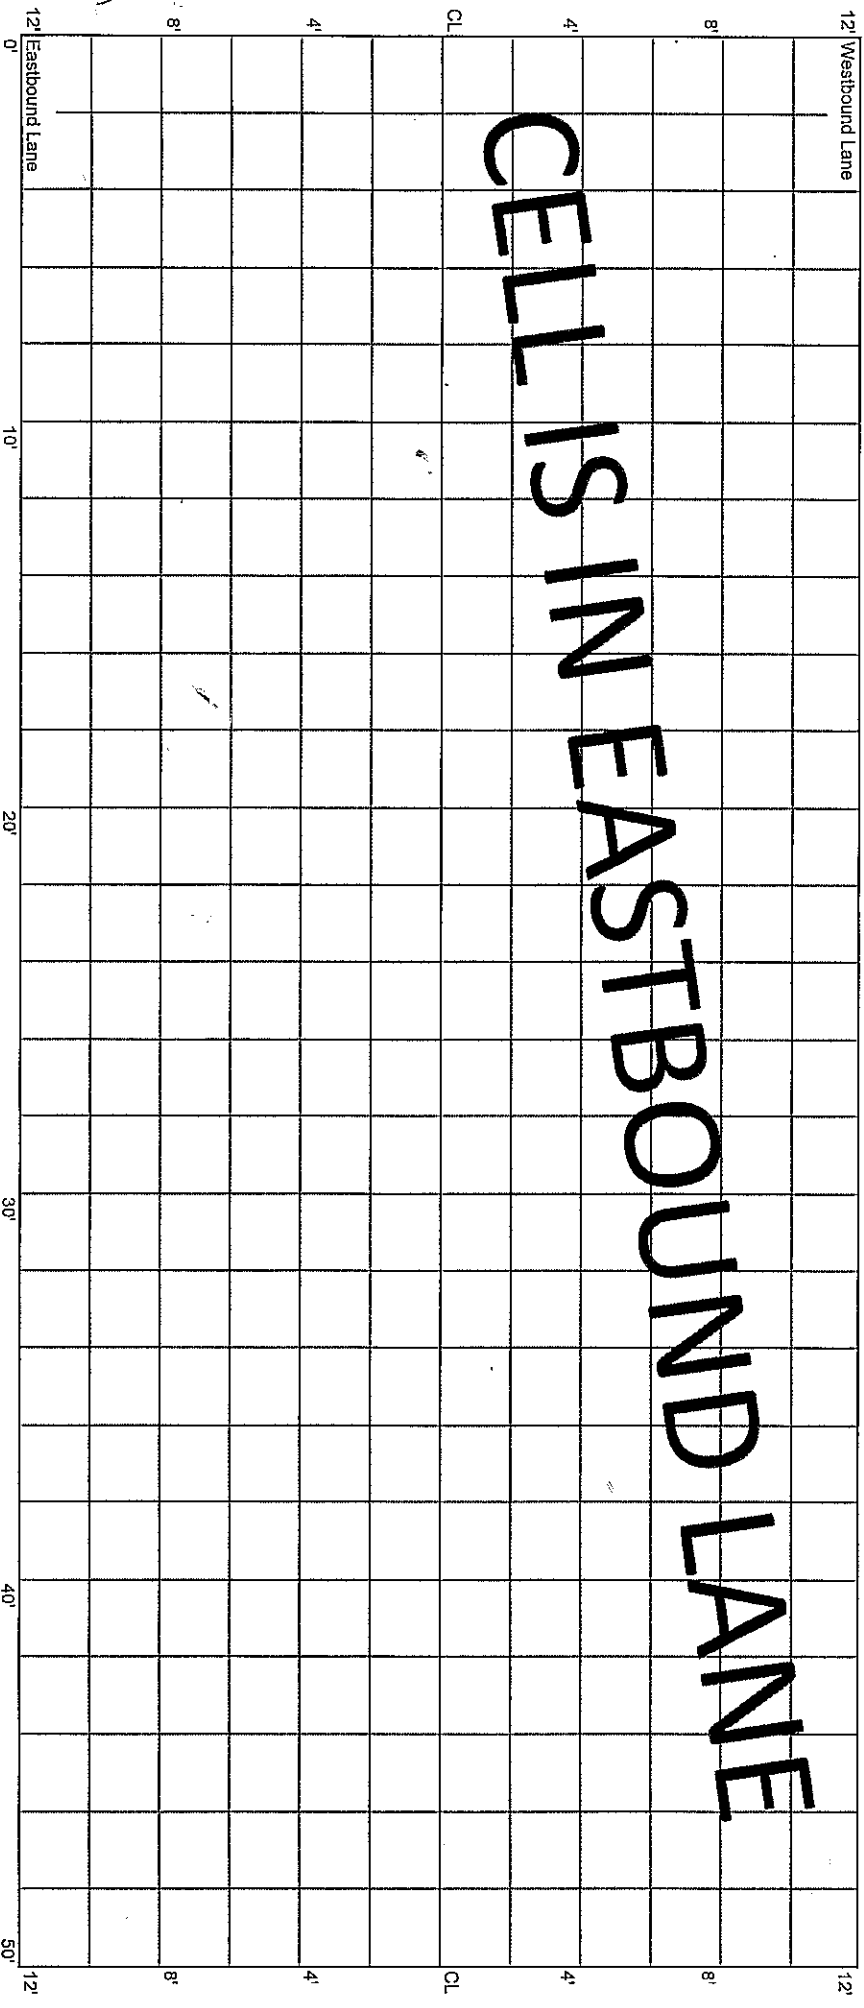


* Route & Seal

CELL 7004E
50 - 100 ft

17+00


17+50

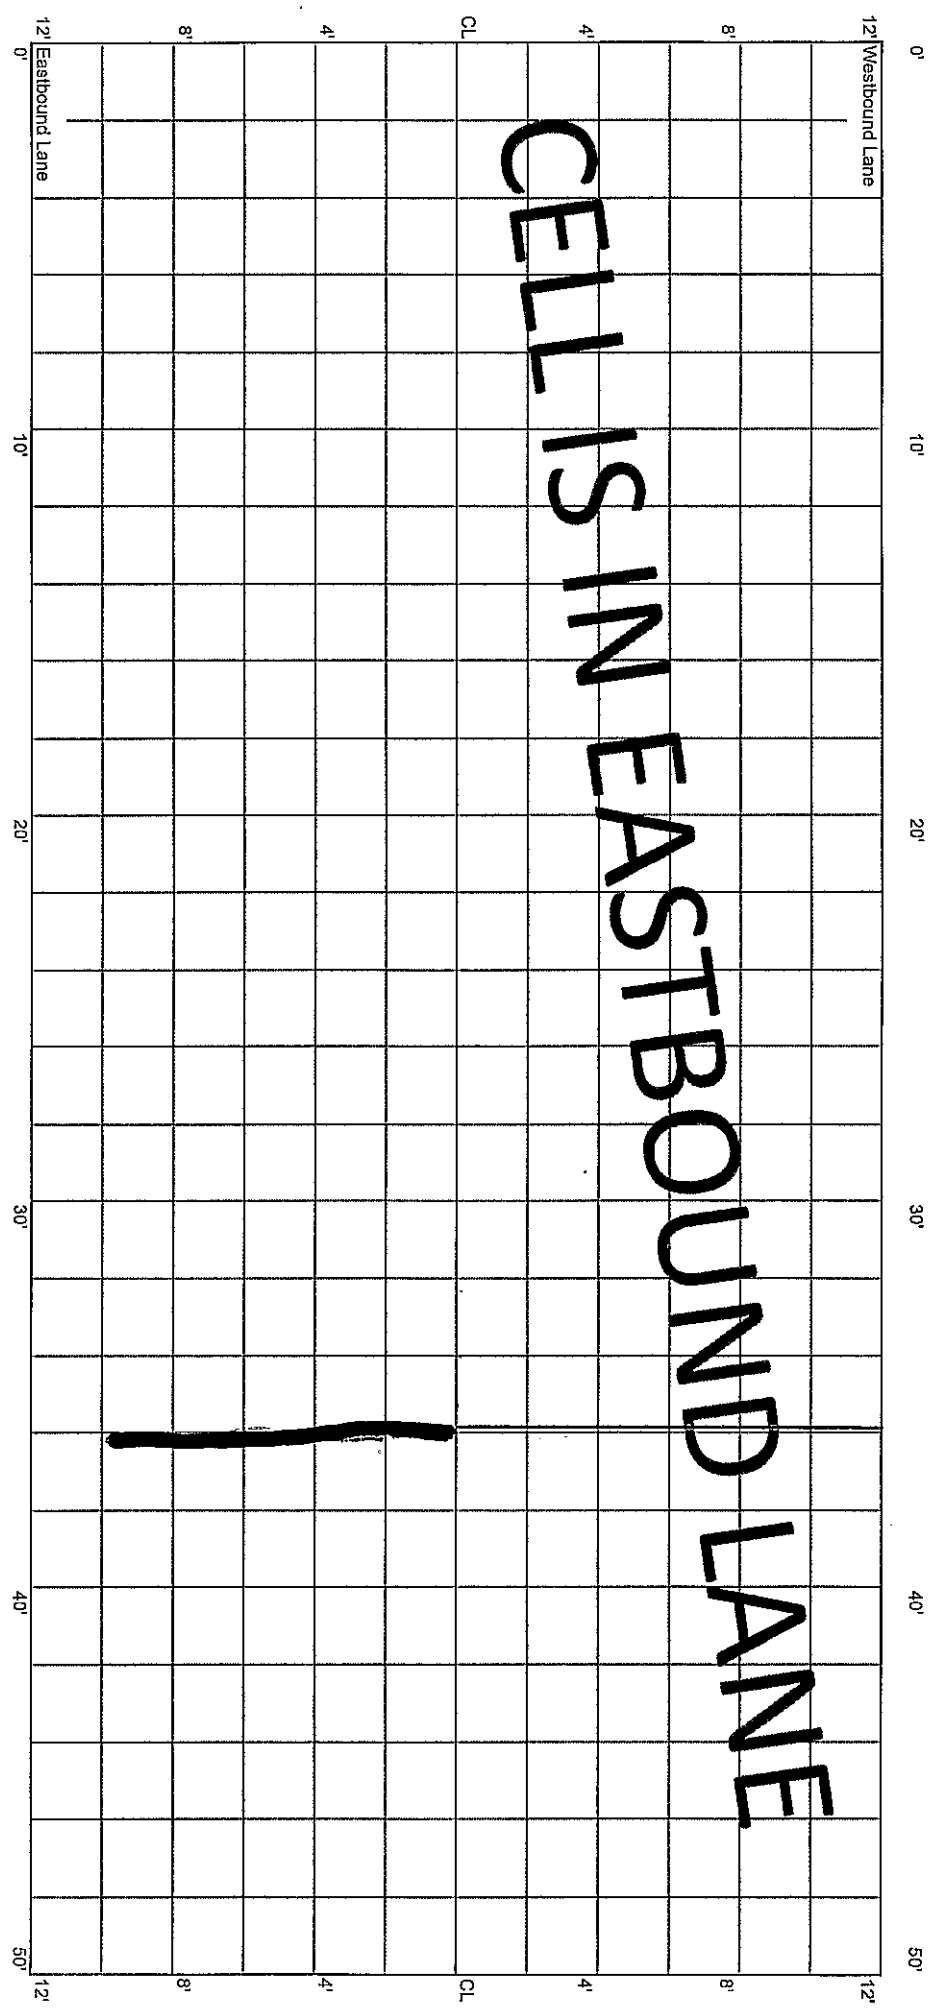

CELL IS IN EASTBOUND LANE

*

CELL 7004E
100 - 150 ft

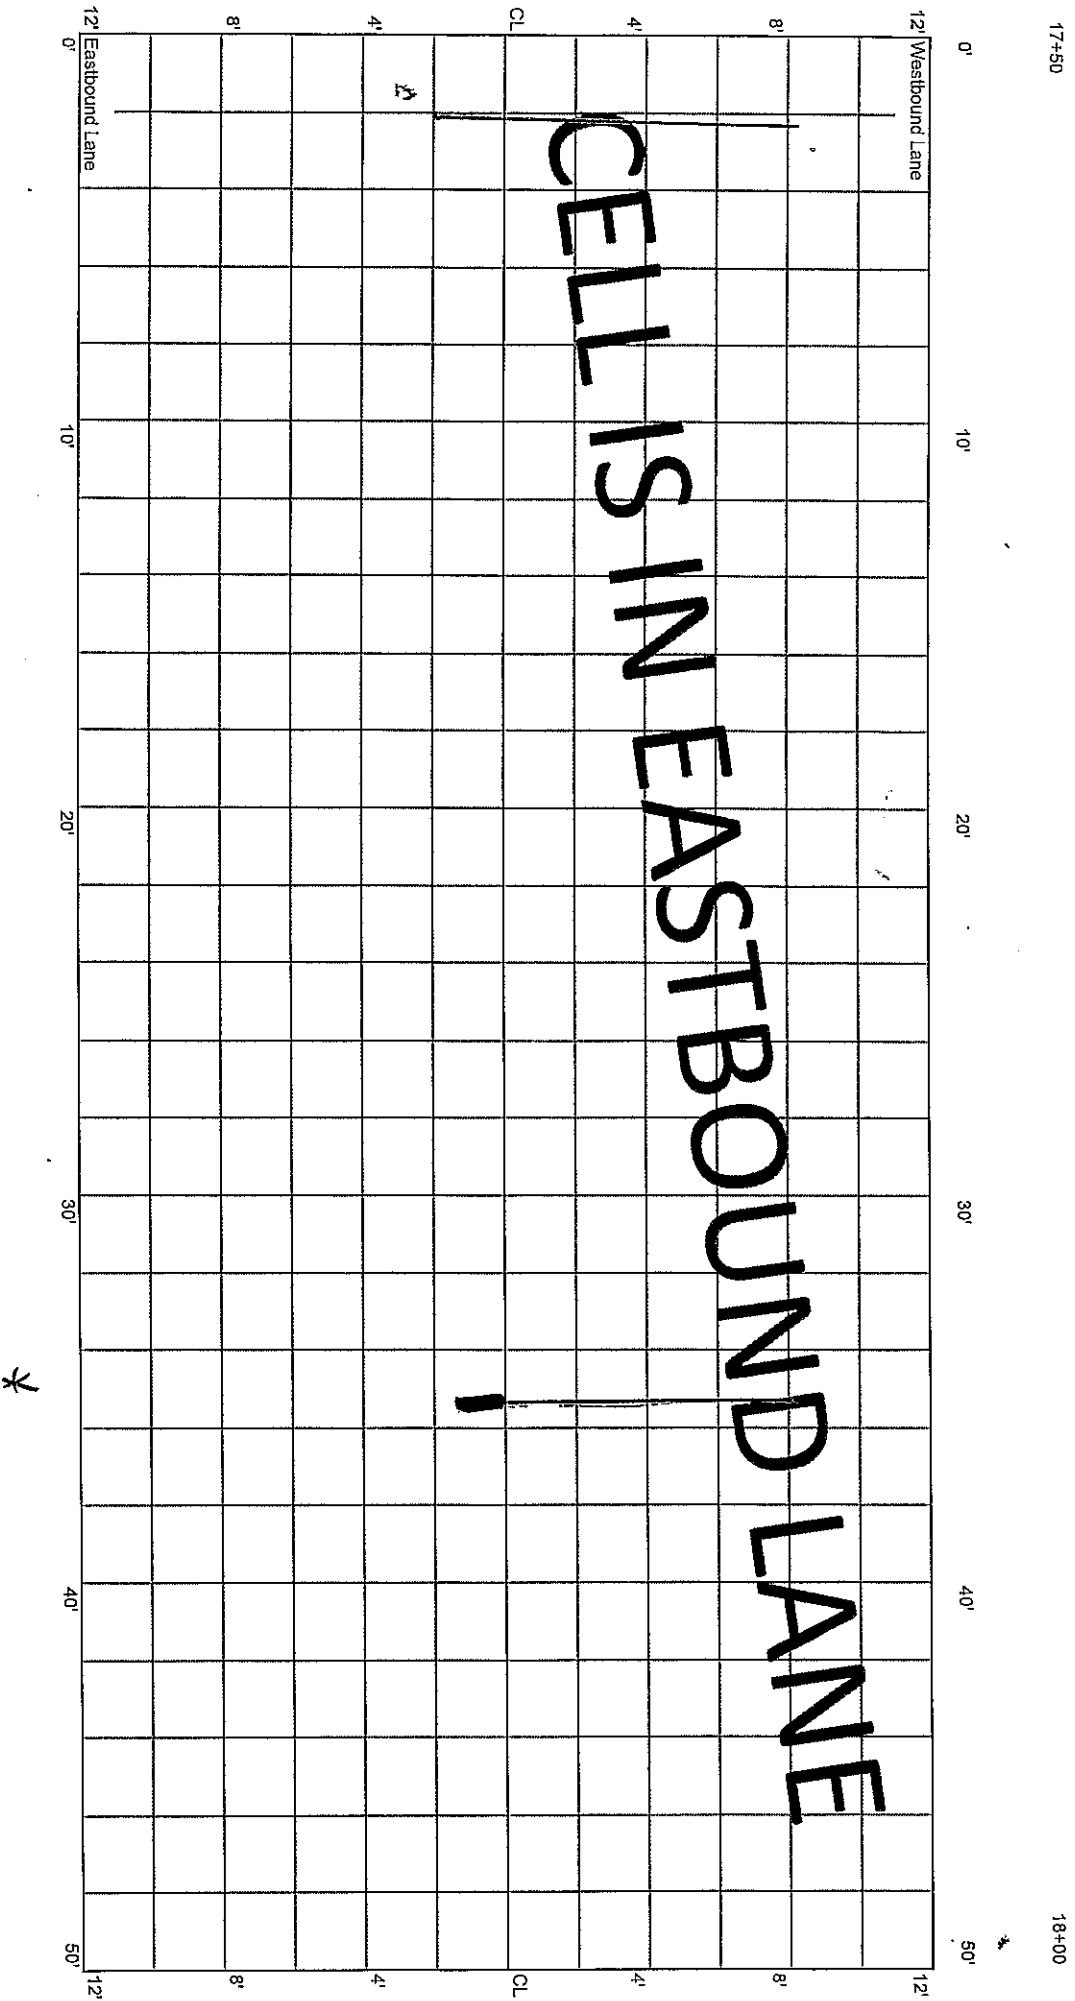

17+50

18+00

0'

10'

20'

30'

40'

50'

12' Westbound Lane

10'

20'

30'

40'


12' Eastbound Lane

*

CELL 7004E
150 - 200 ft

18+00


18+50

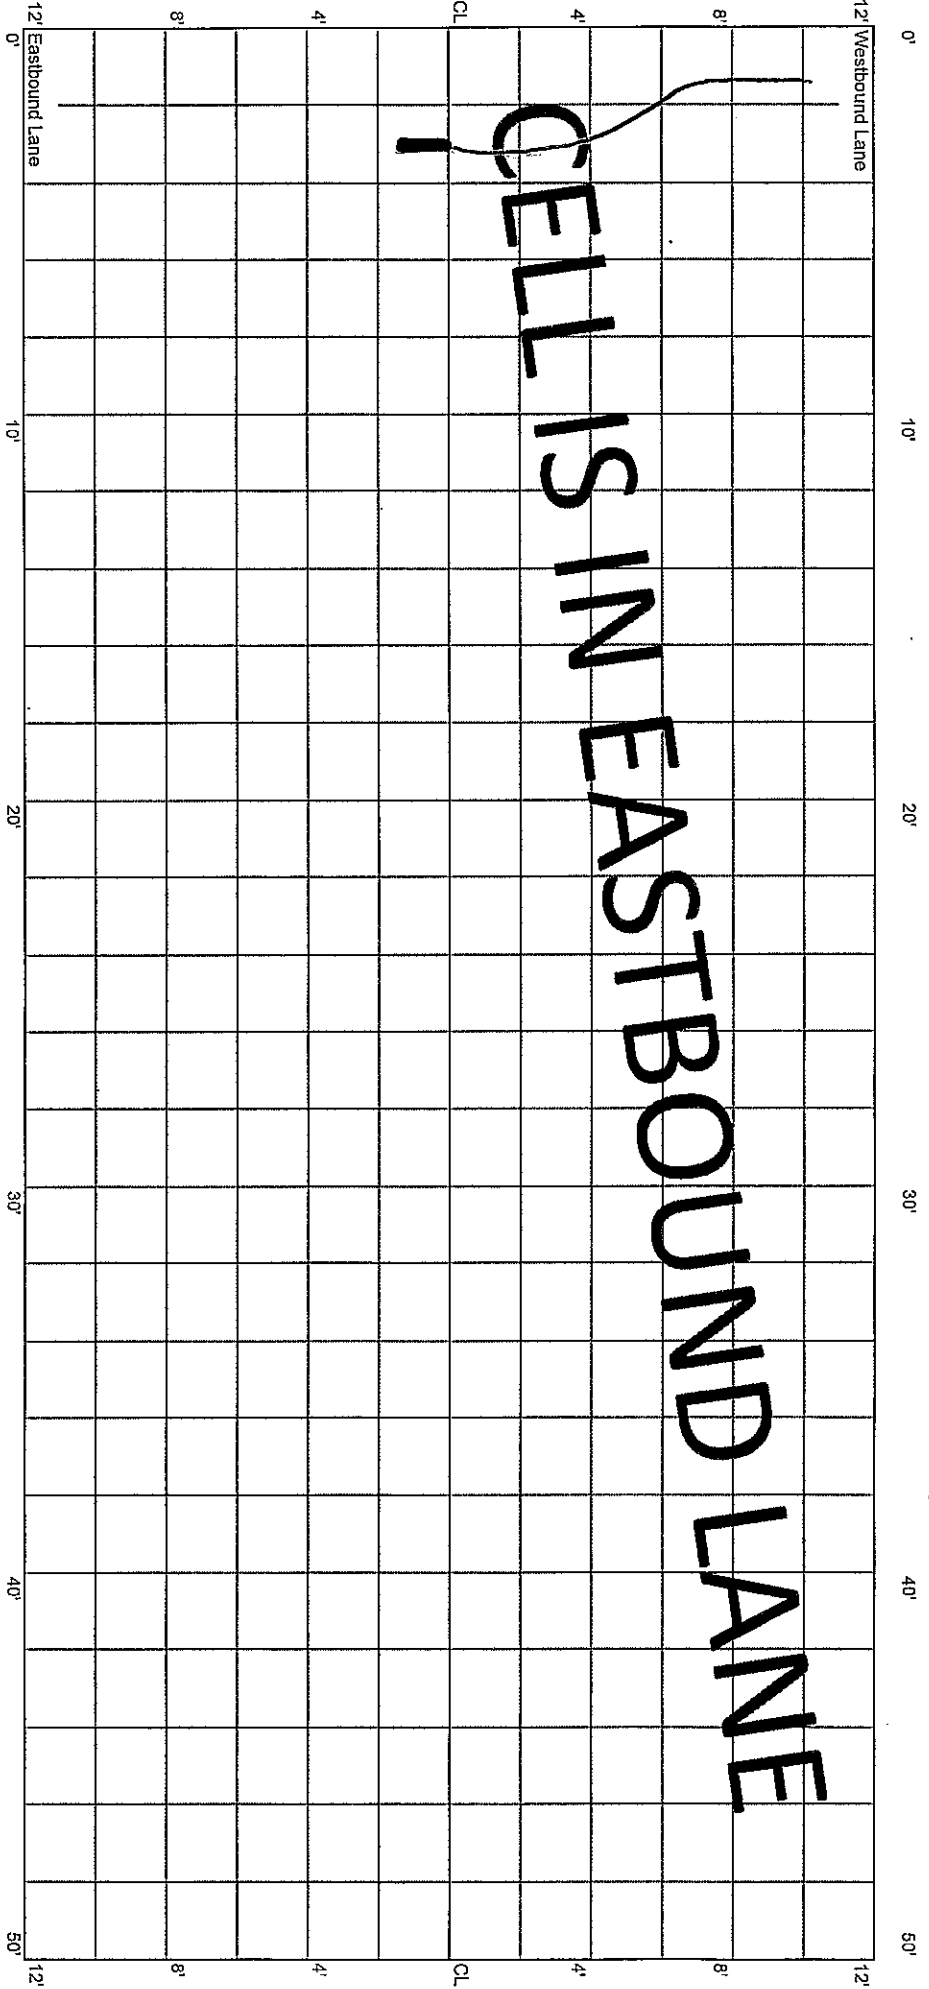

CELL 7004E
200 - 250 ft

18+50

19+00

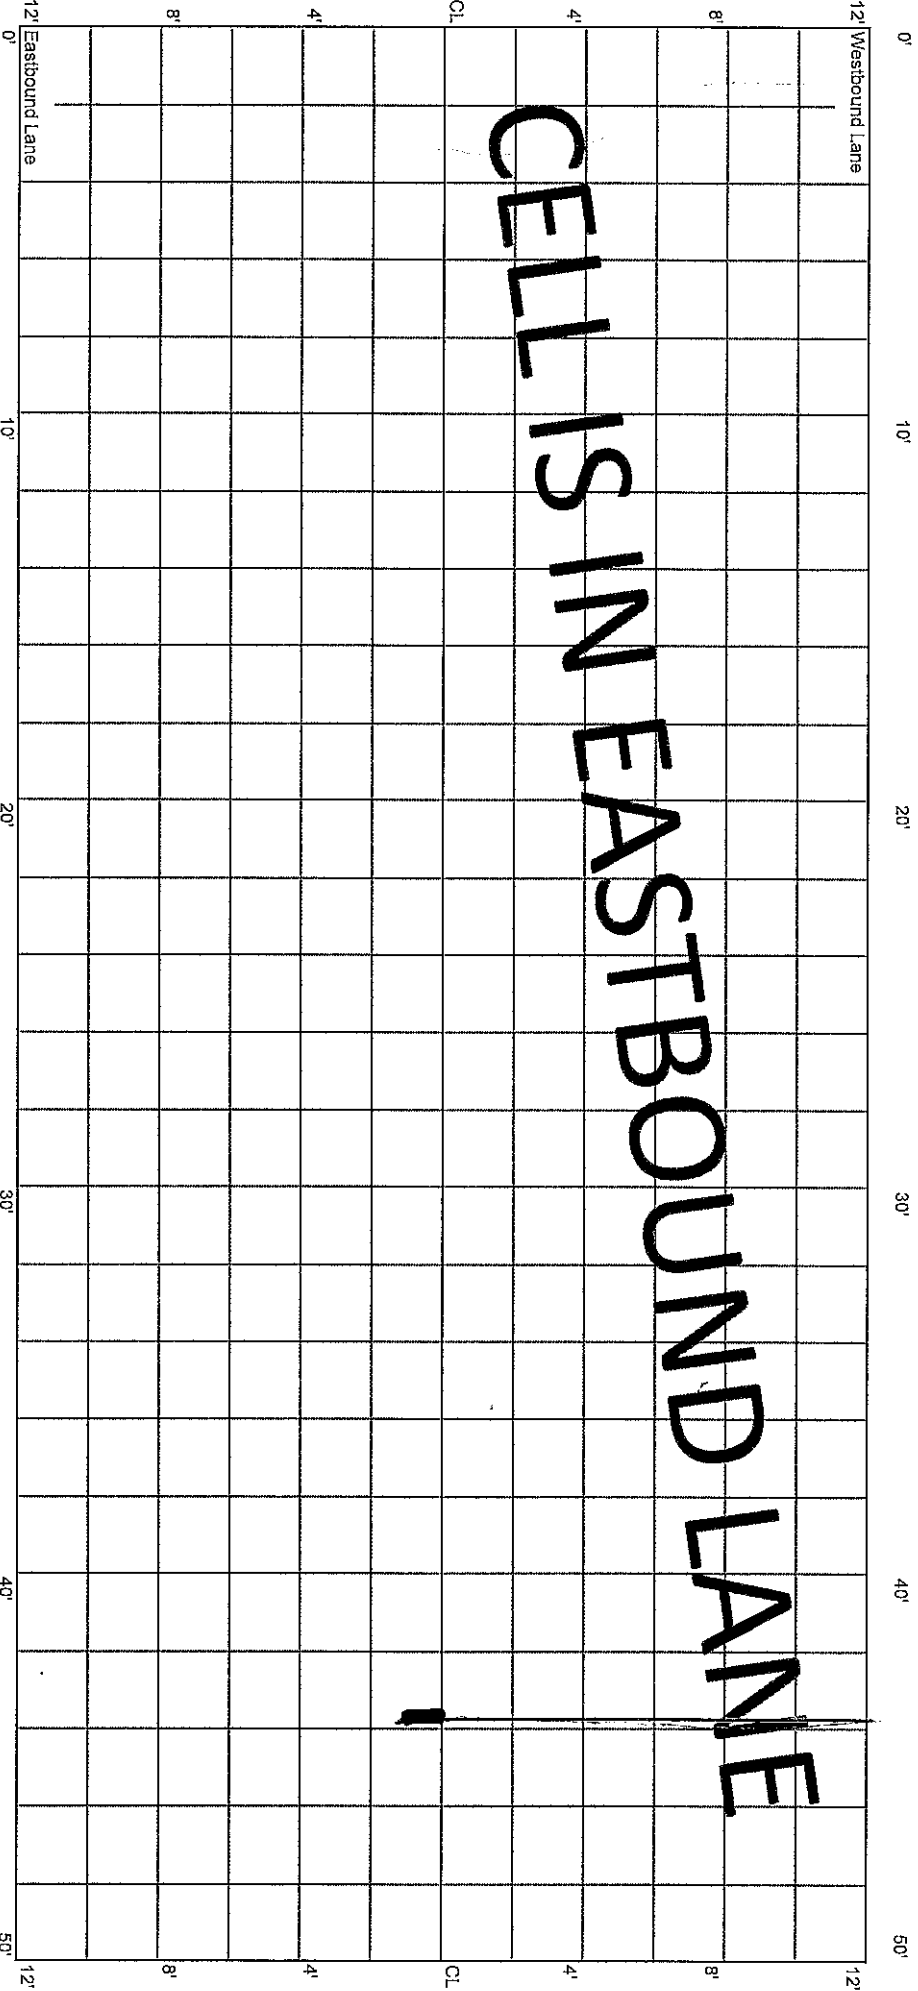


*

CELL 7004E
250 - 300 ft

19+00


19+50

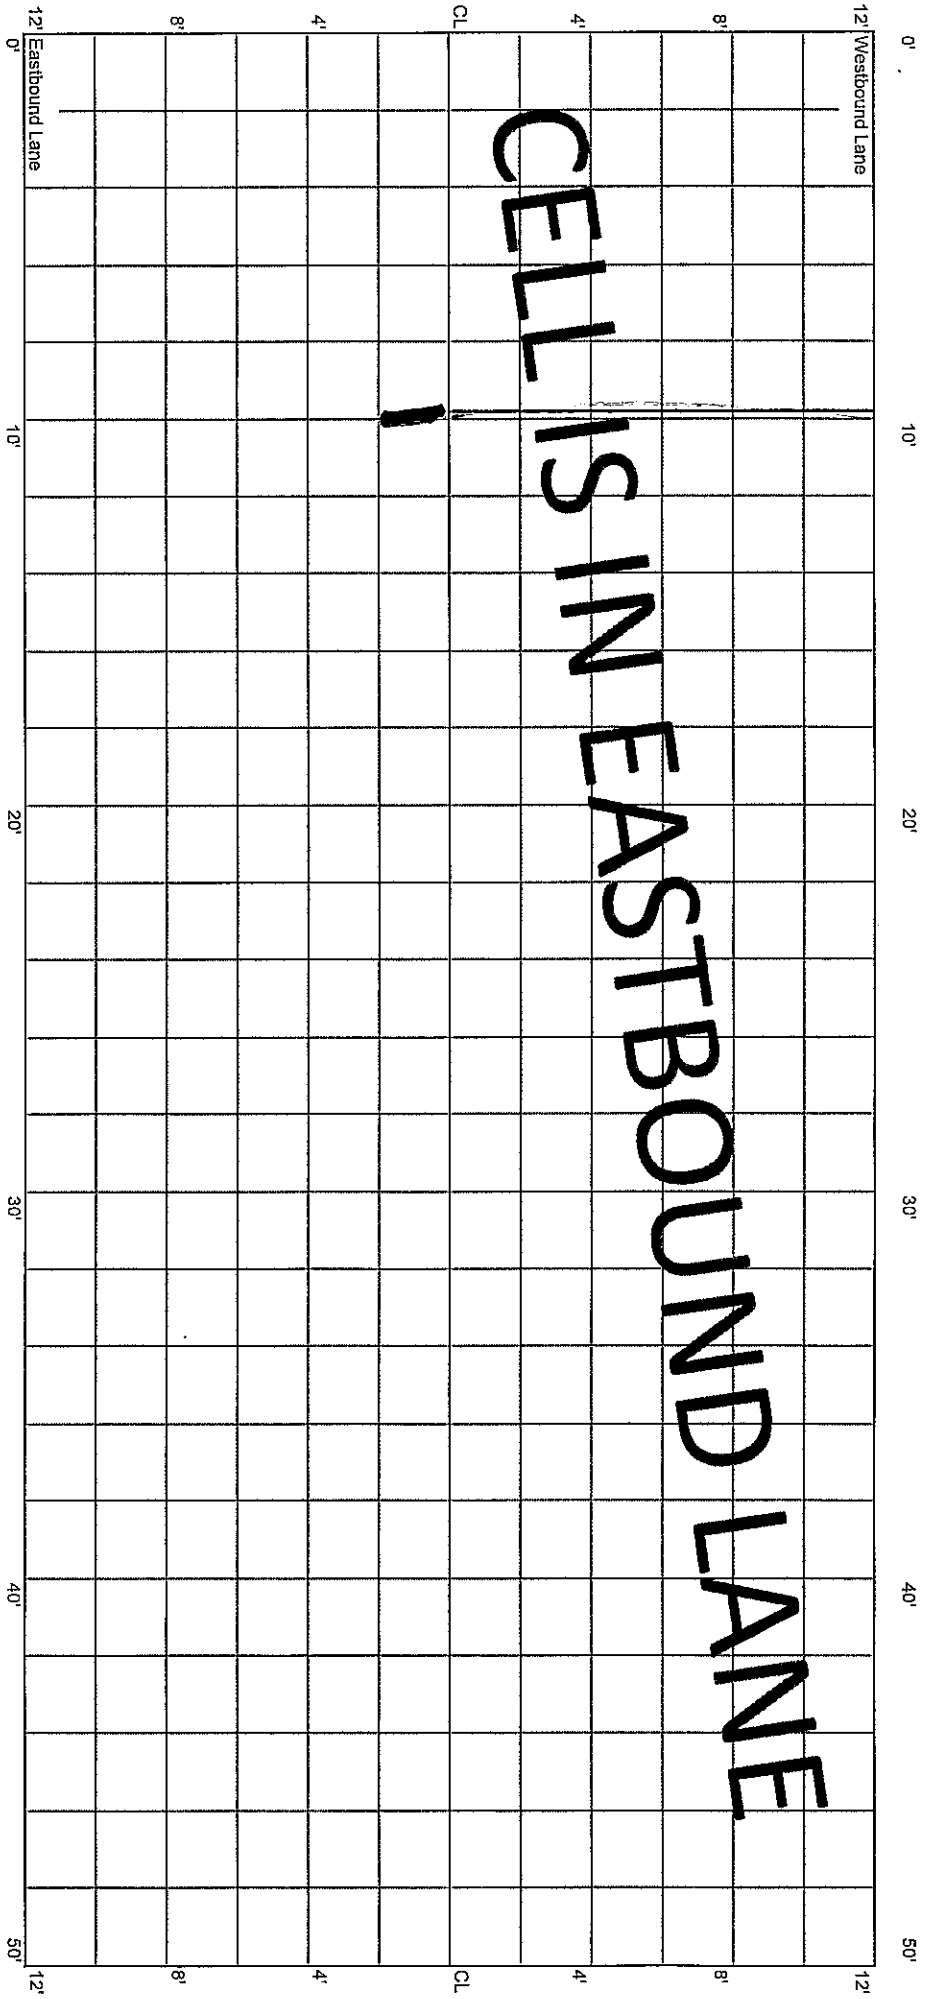

*


CELL 7004E
300 - 350 ft

Put outside Fogline 300 to end

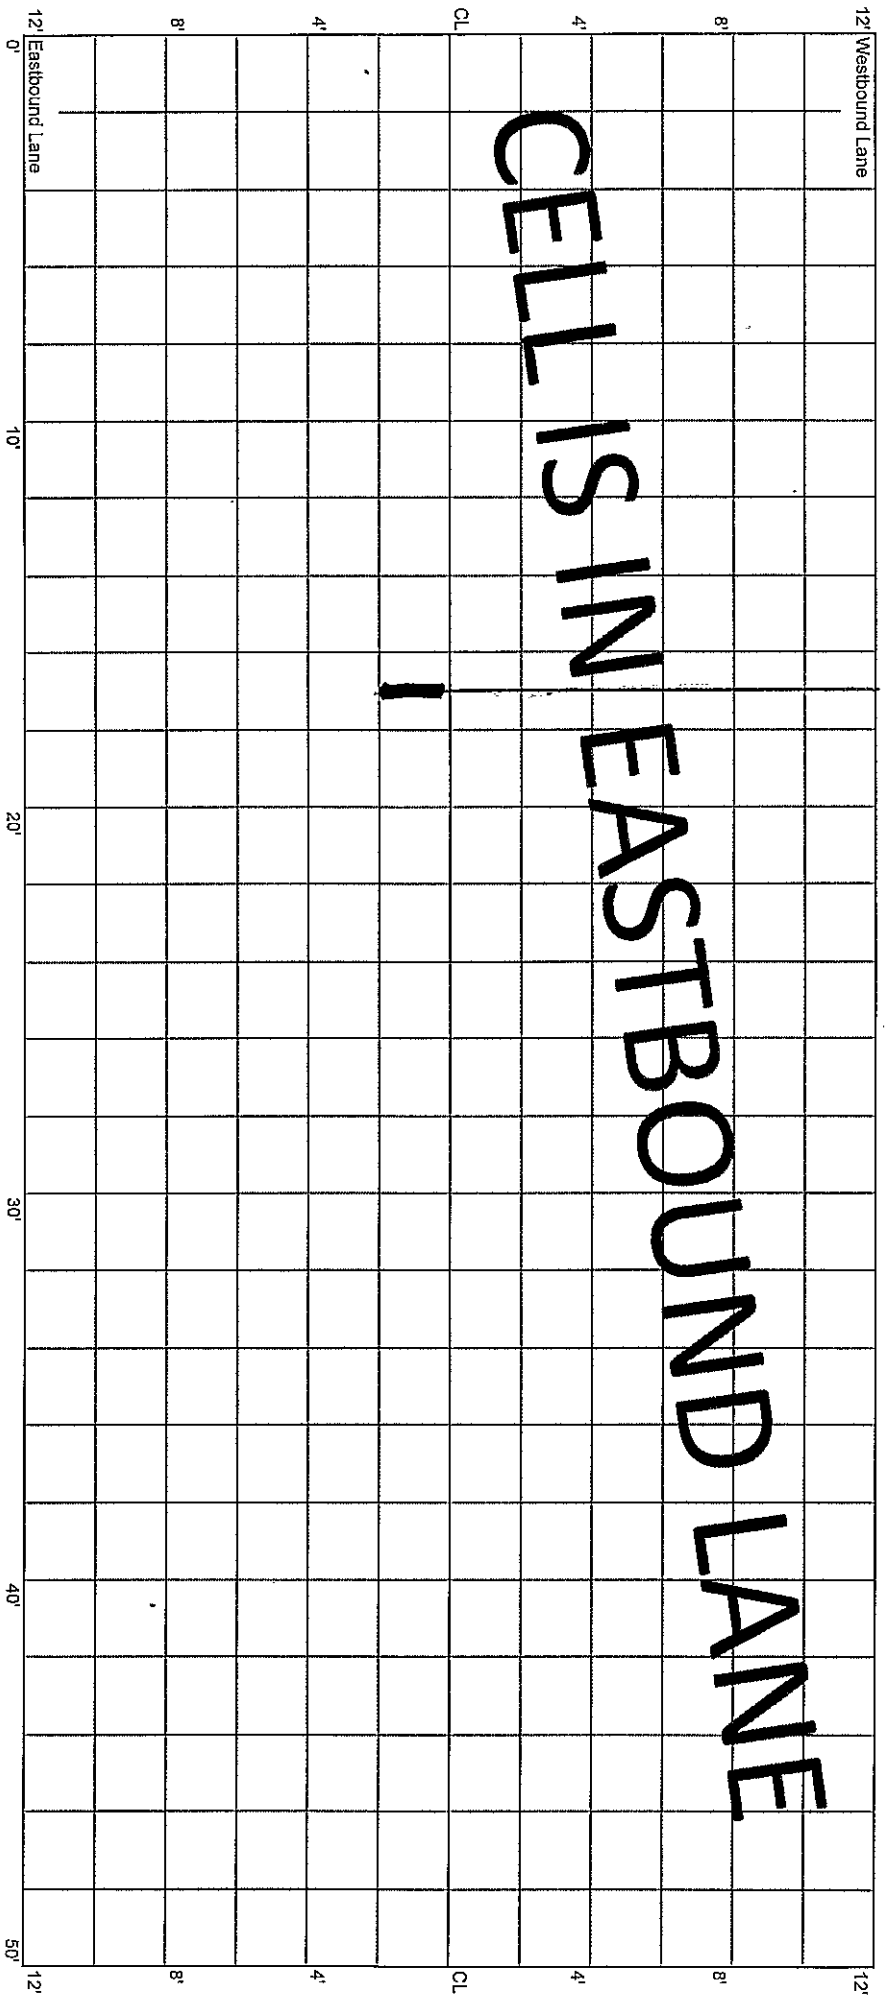

CELL 7004E
350 - 400 ft

CELLS IN EASTBOUND LANE

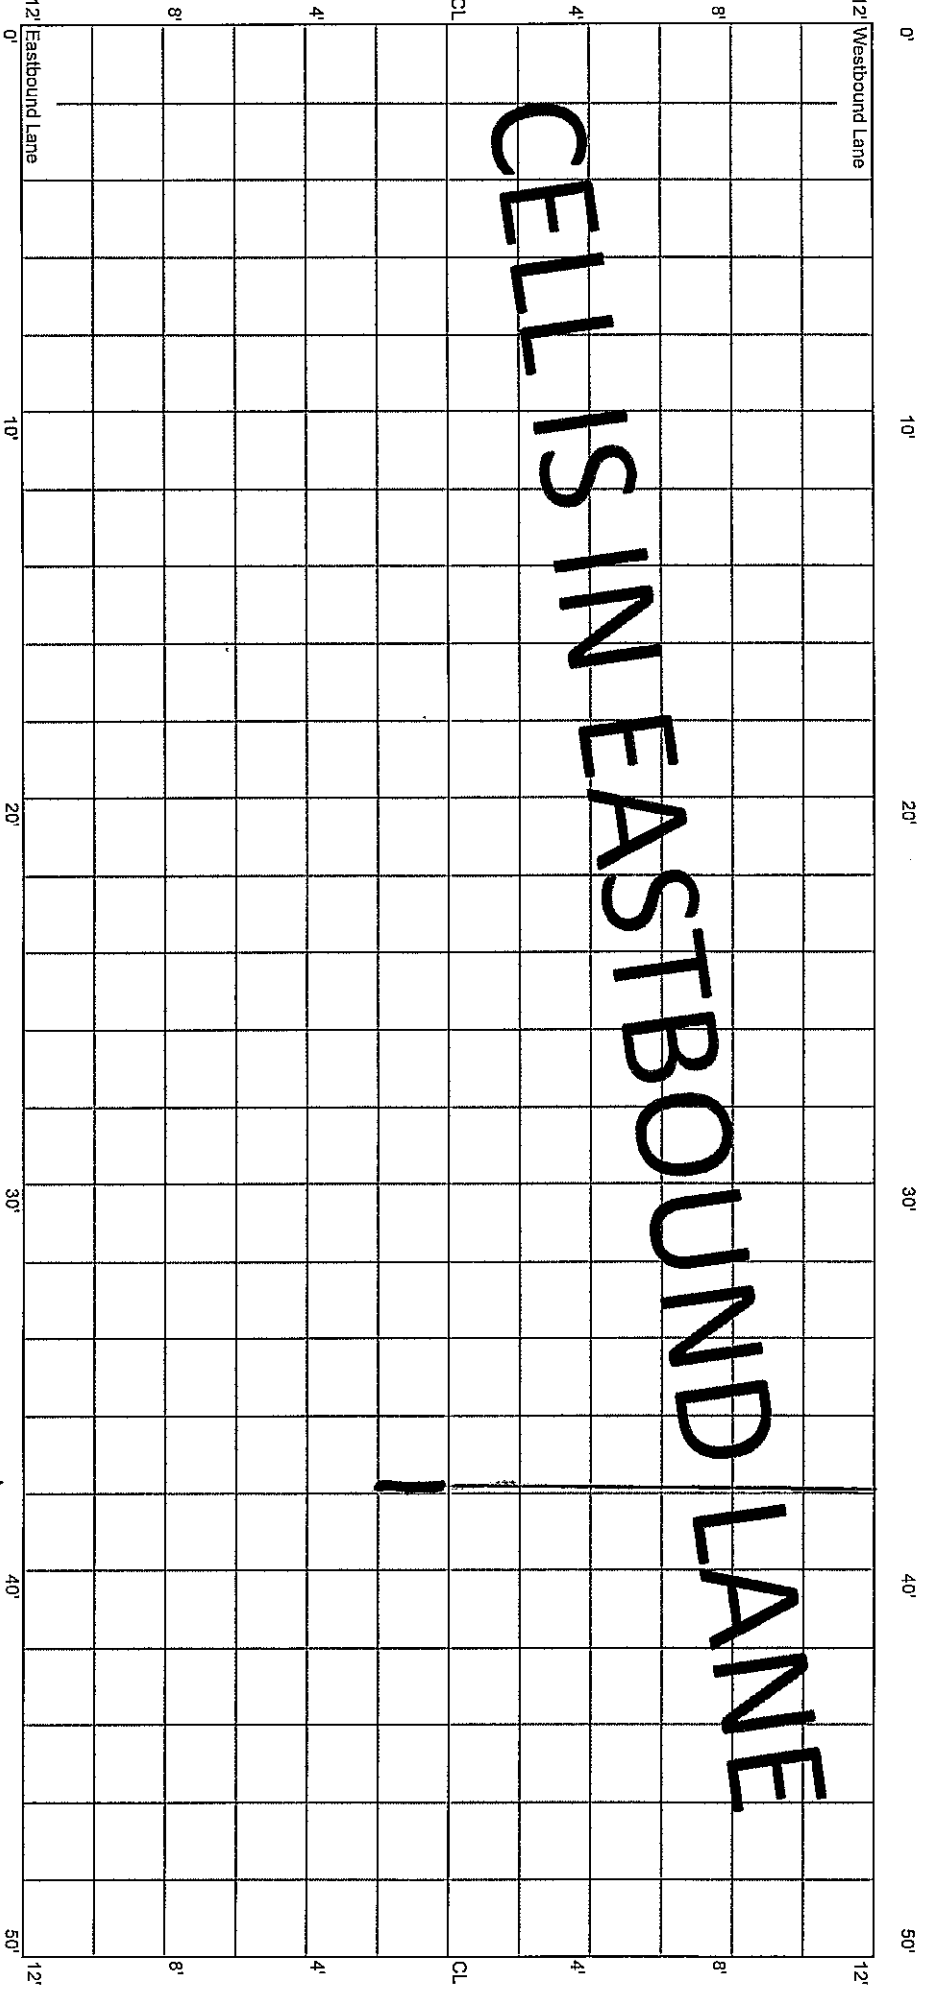


20+00

20+50


CELL 7004E
400 - 450 ft

CELL IS IN EASTBOUND LANE

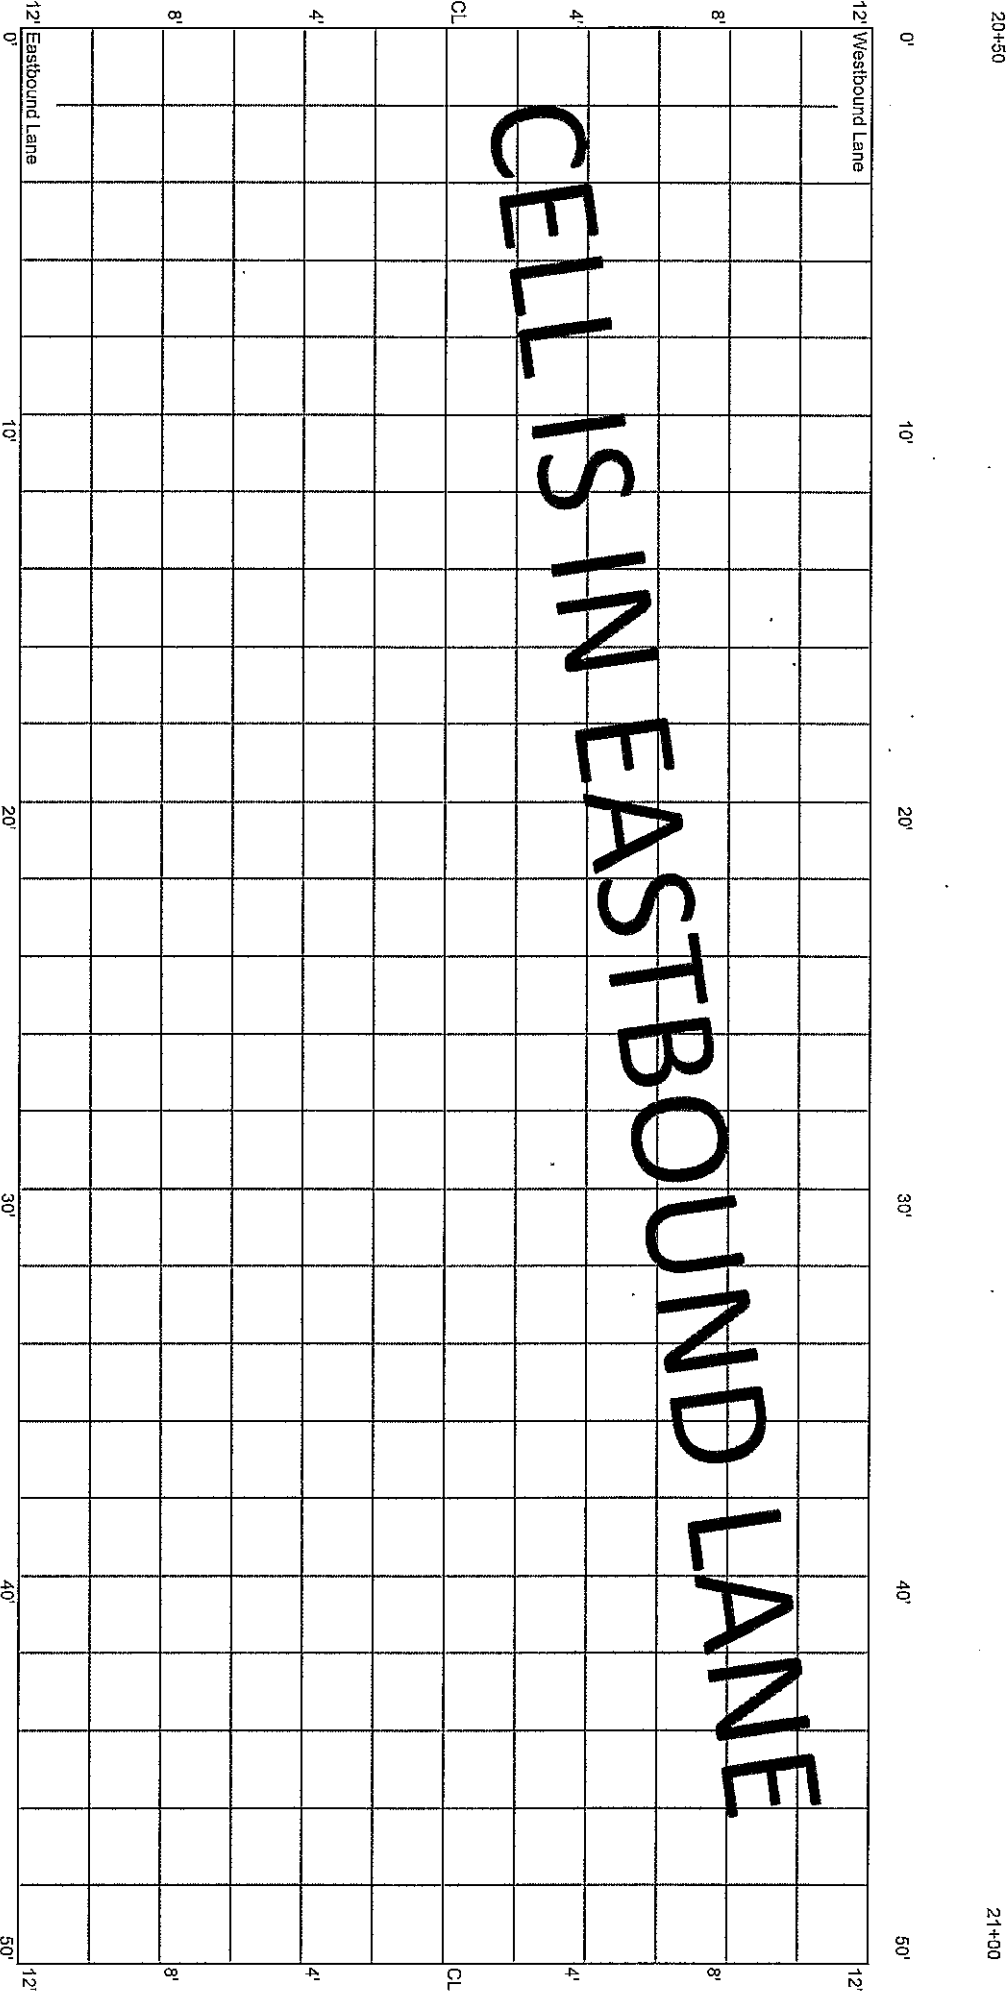

CELL 7004E
450 - 500 ft

CELLS IN EASTBOUND LANE

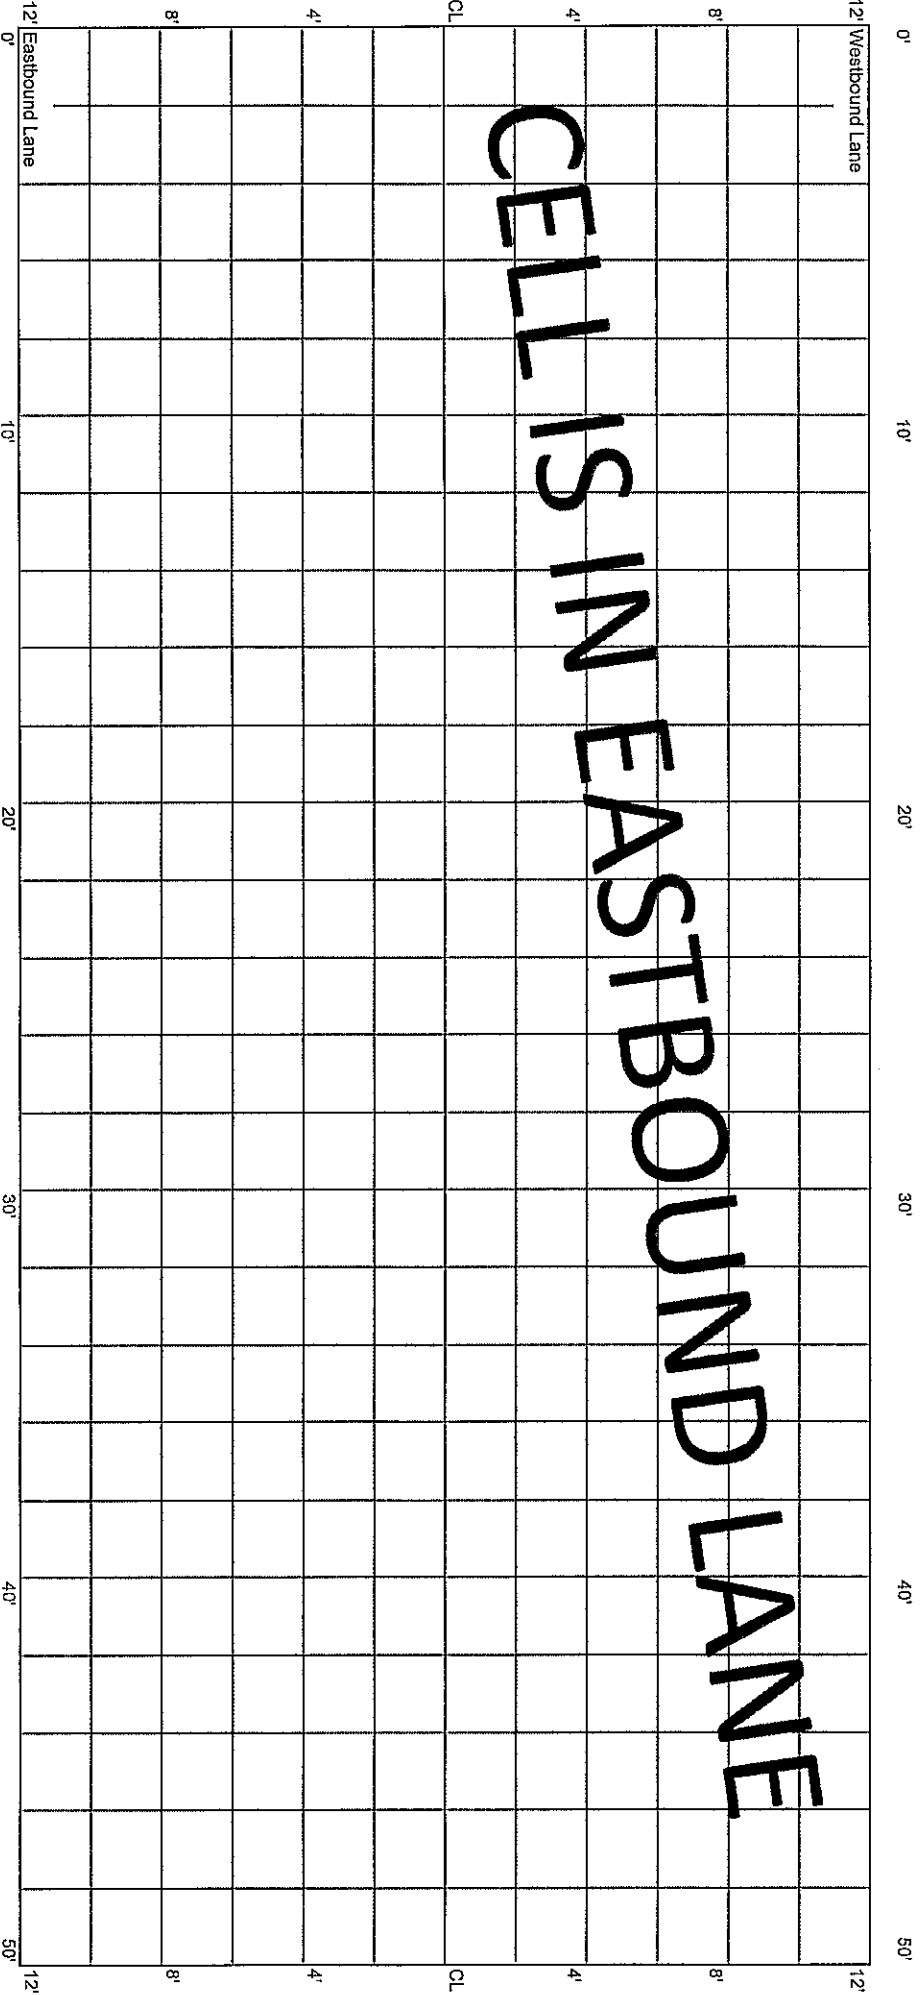

21+00

21+50

CELL 7004E
500 - 550 ft

21+50

16+25

22+00

