


5.28.20 E.J. - No Distress  
10.14.20 - No Distress

File 70TH ST

CELL 7007W  
0 - 50 ft

38+00


37+50

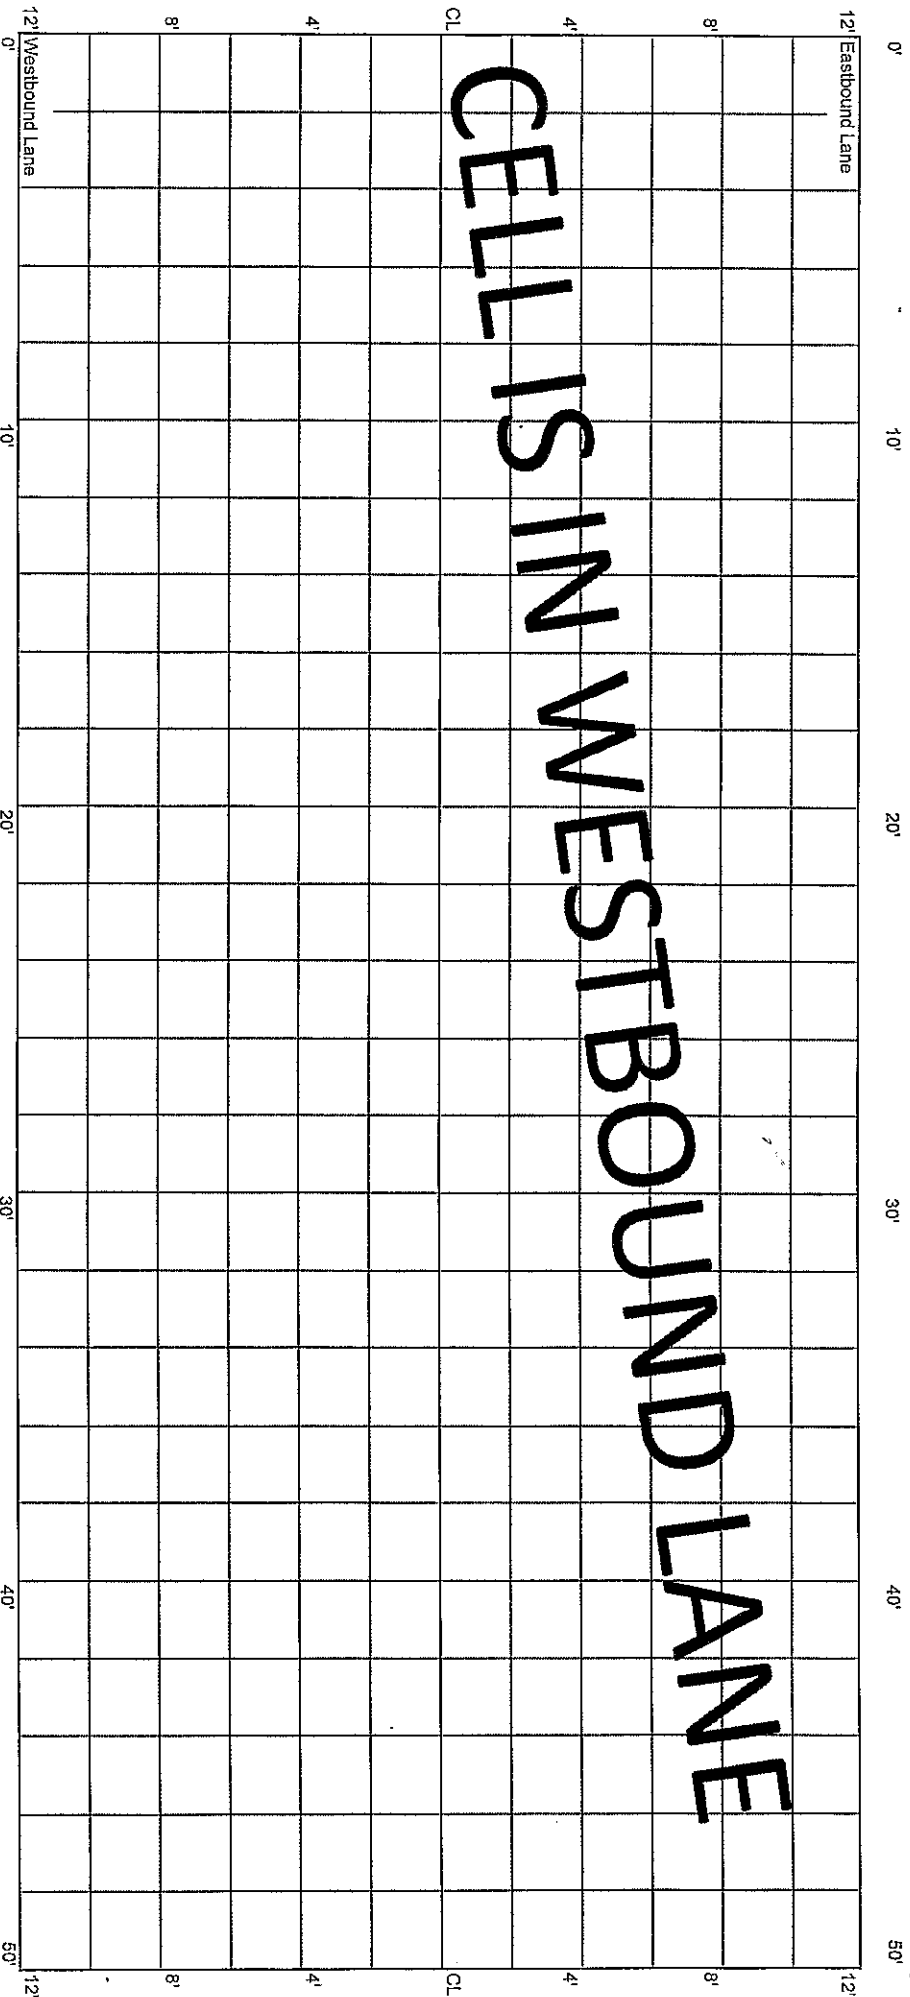

CELL 7007W  
50 - 100 ft

37+50


37+00

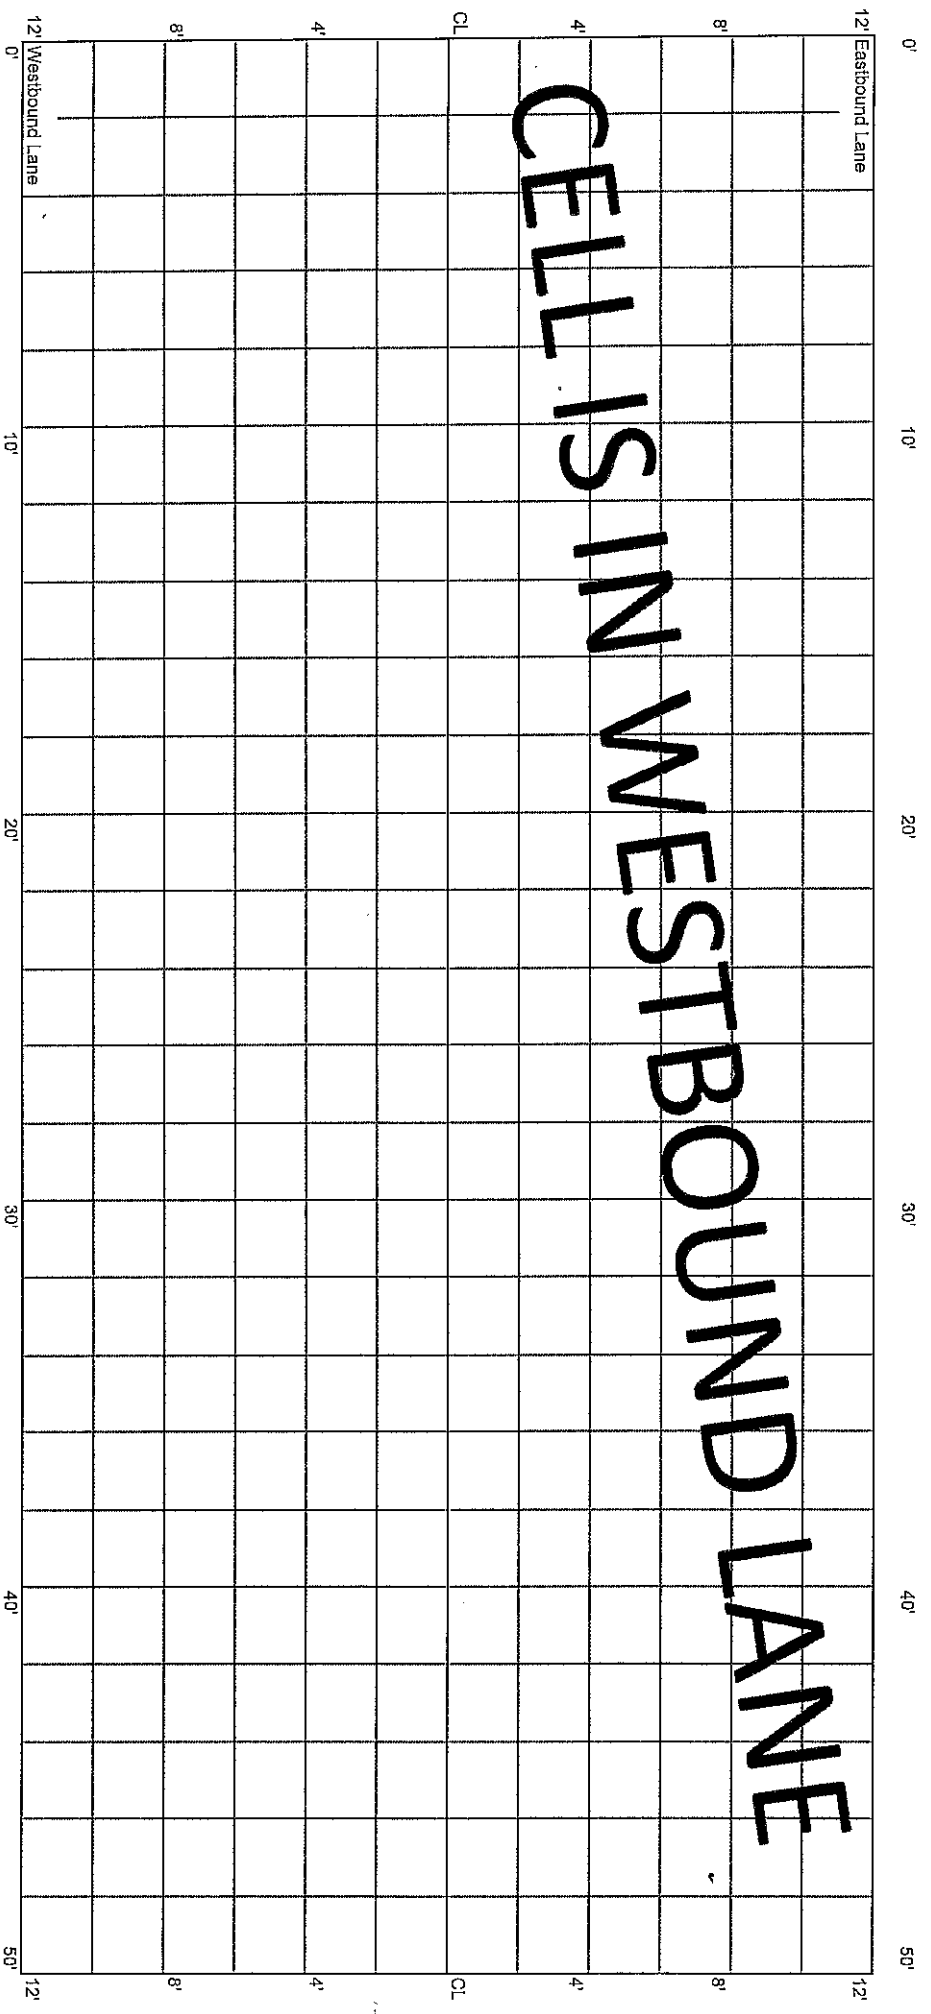

CELL 7007W  
100 - 150 ft

37+00


38+50

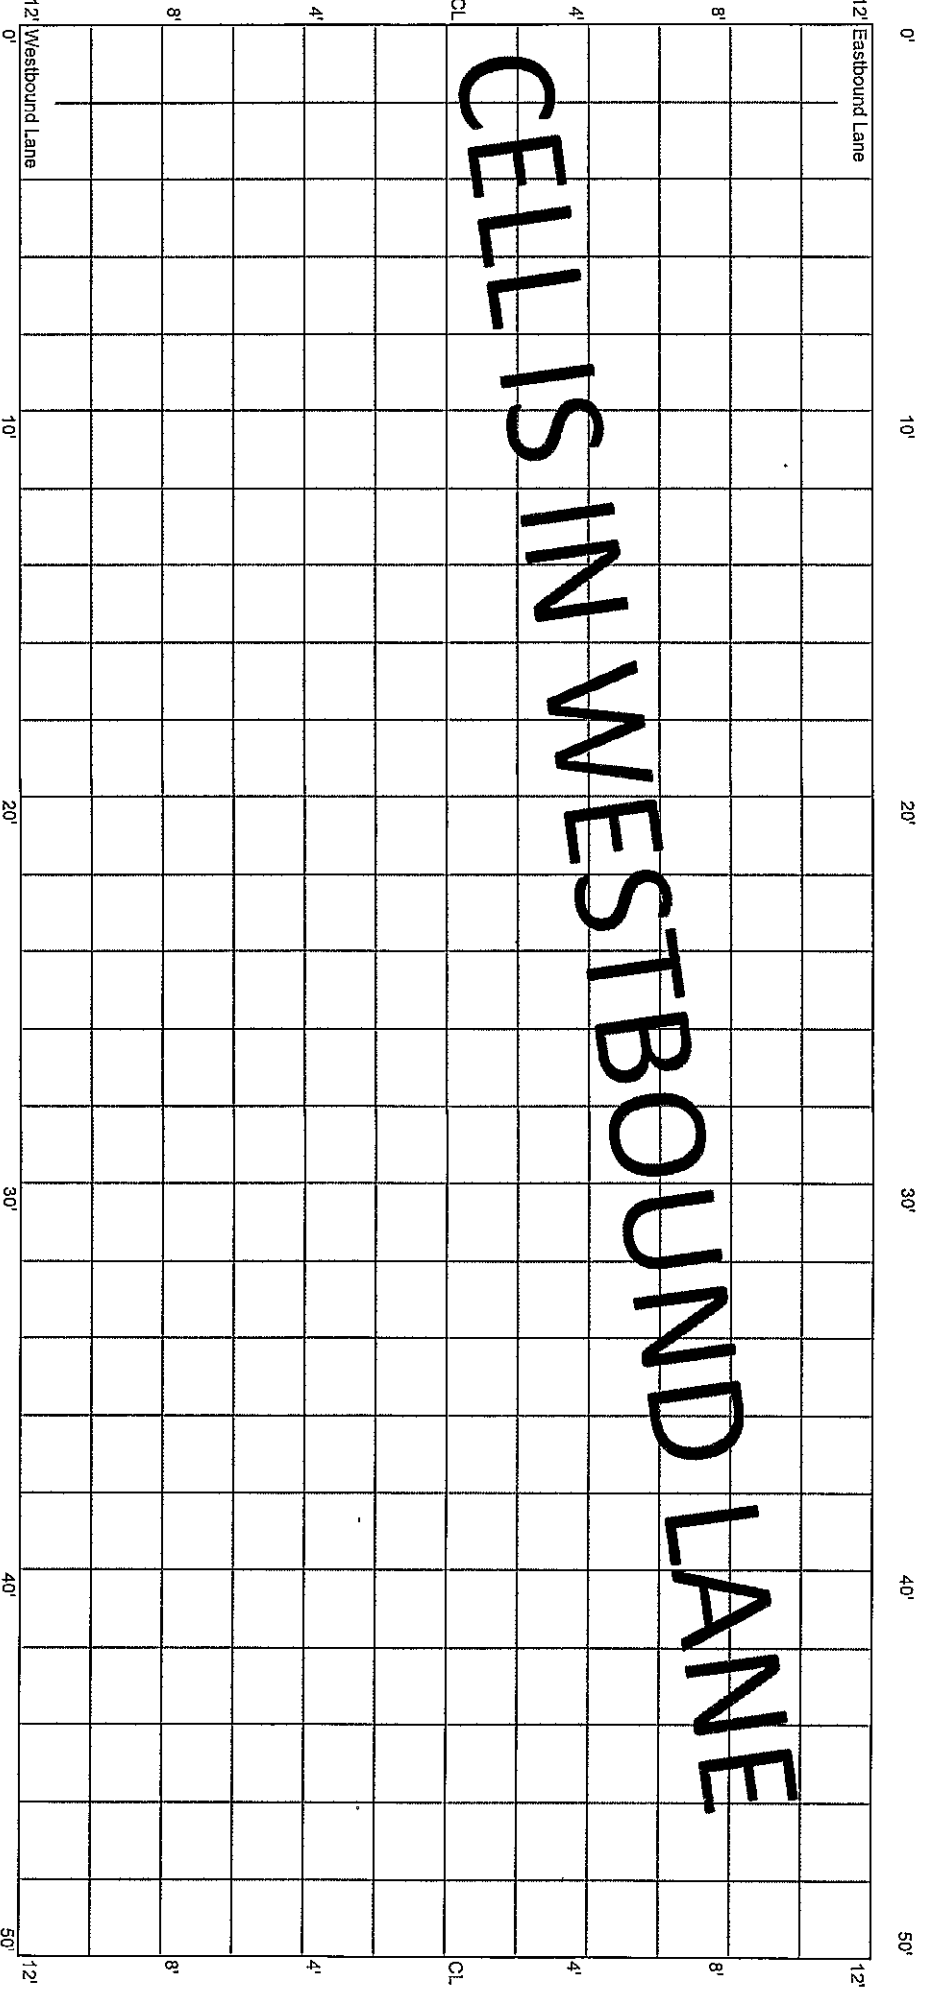

CELL 7007W  
150 - 200 ft

36+50


36+00

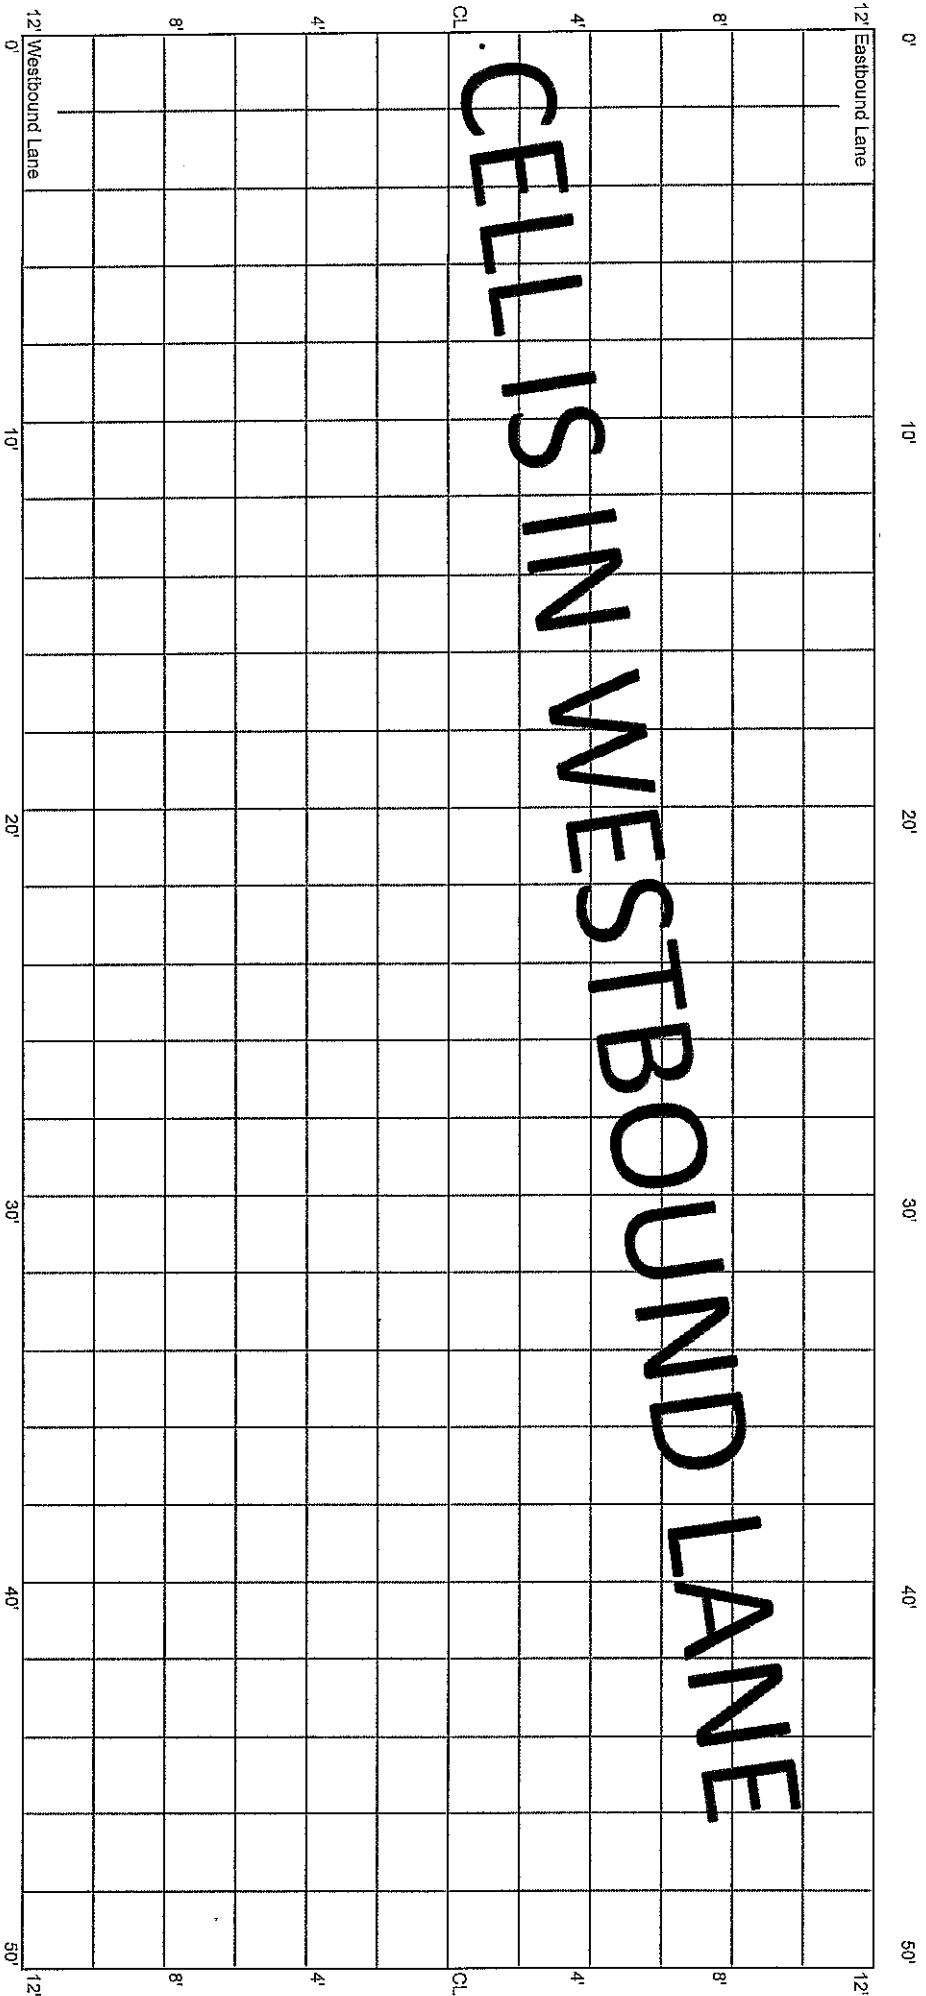

CELL 7007W  
200 - 250 ft

36+00


35+50

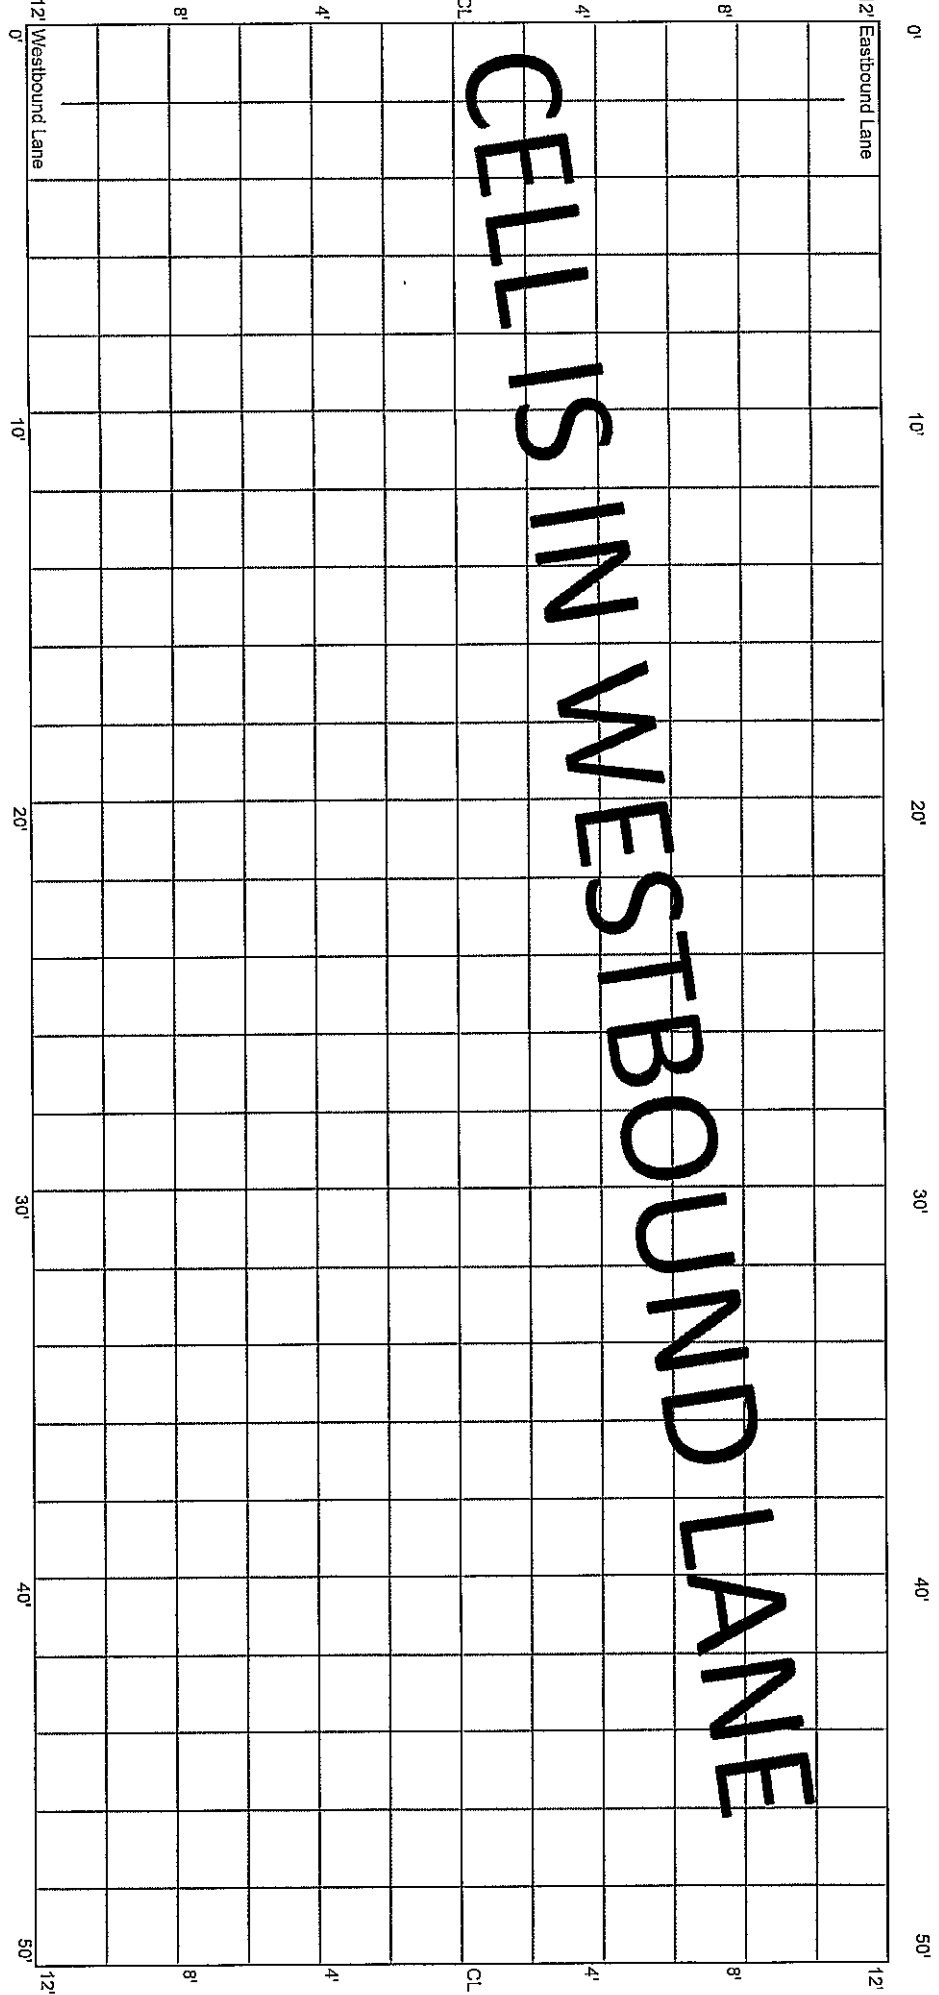

CELL 7007W  
250 - 300 ft

35+50  
35+30  
CL KALLAND


36+00

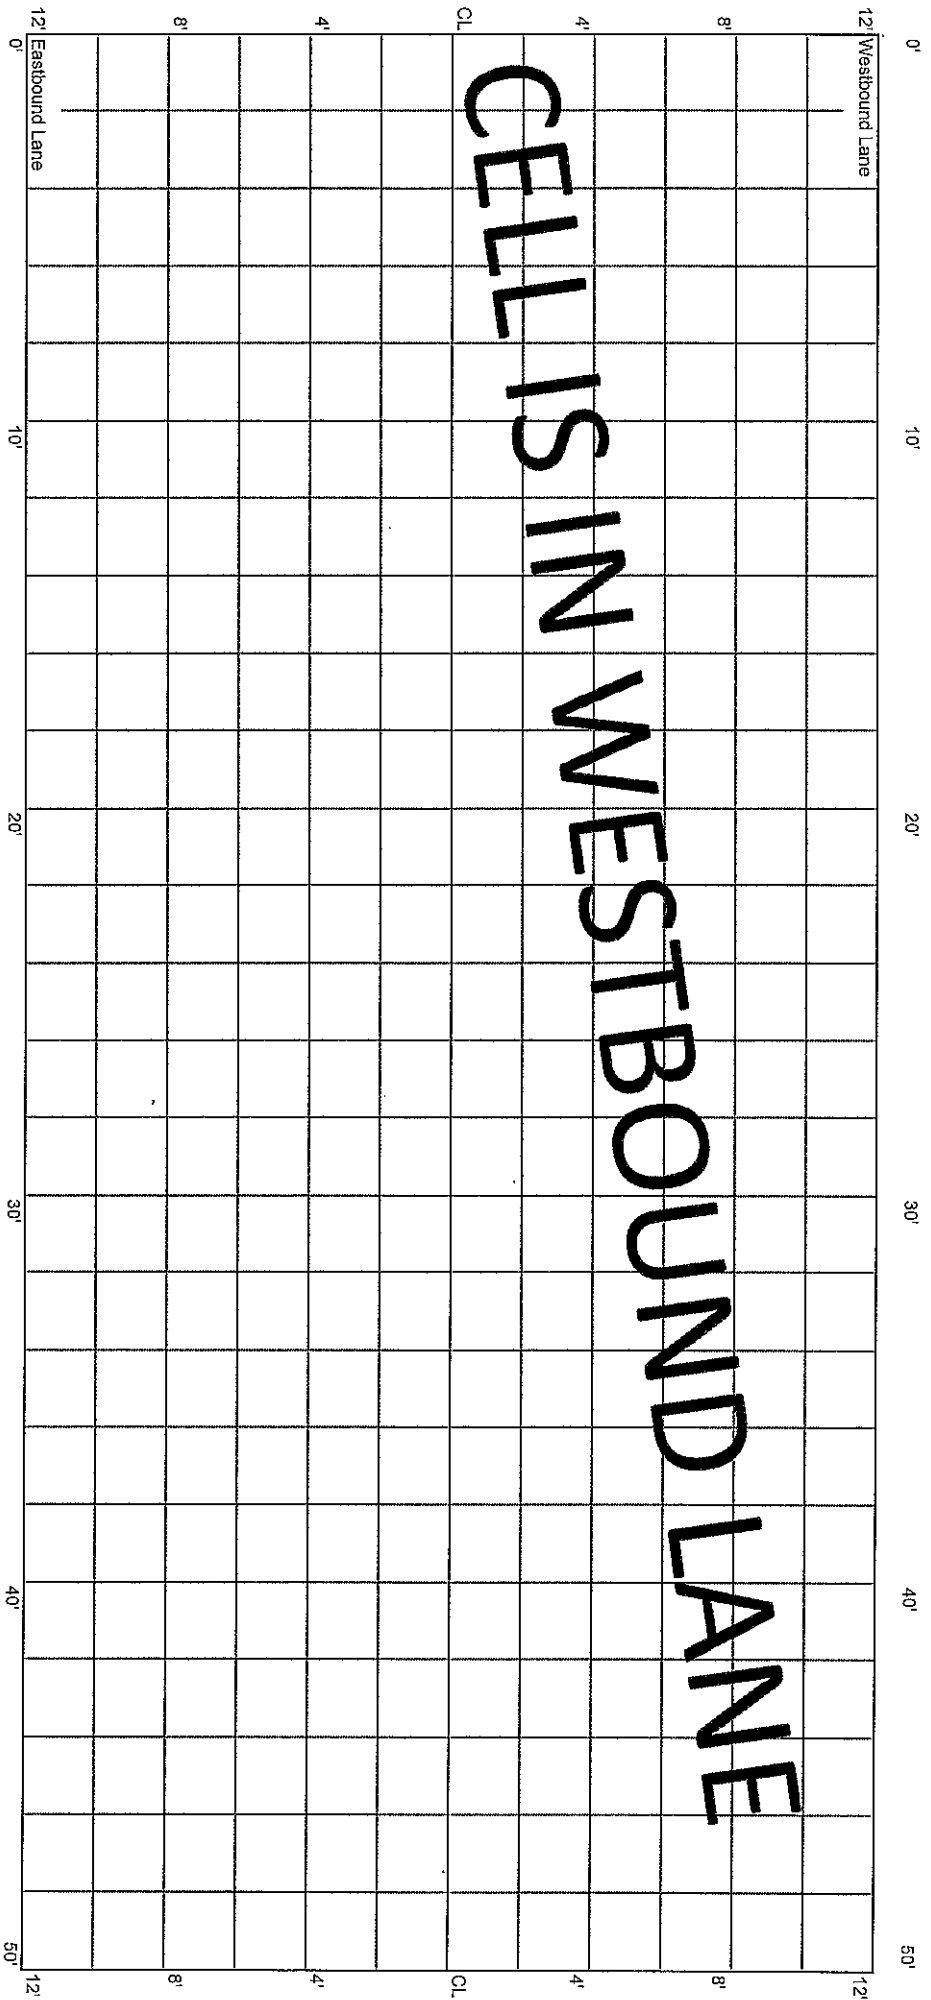

CELL 7007W  
300 - 350 ft

35+00


34+50

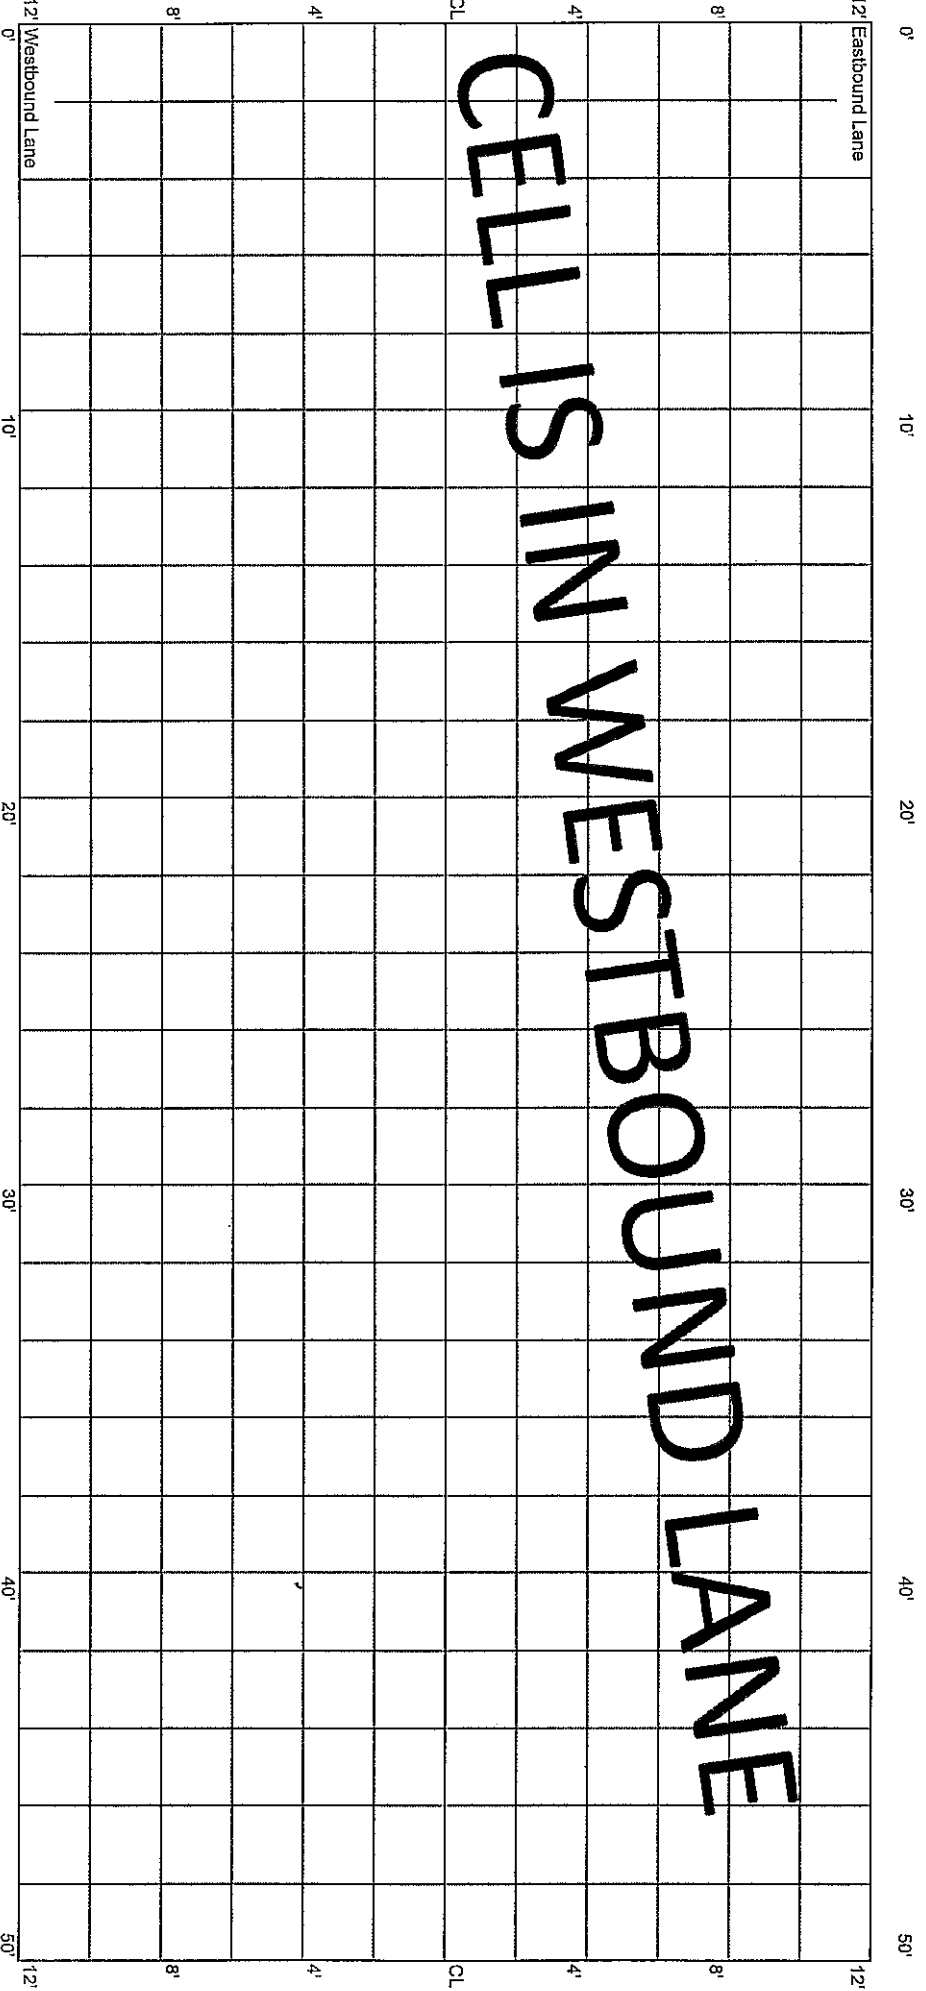

CELL 7007W  
350 - 400 ft

34+50

34+00

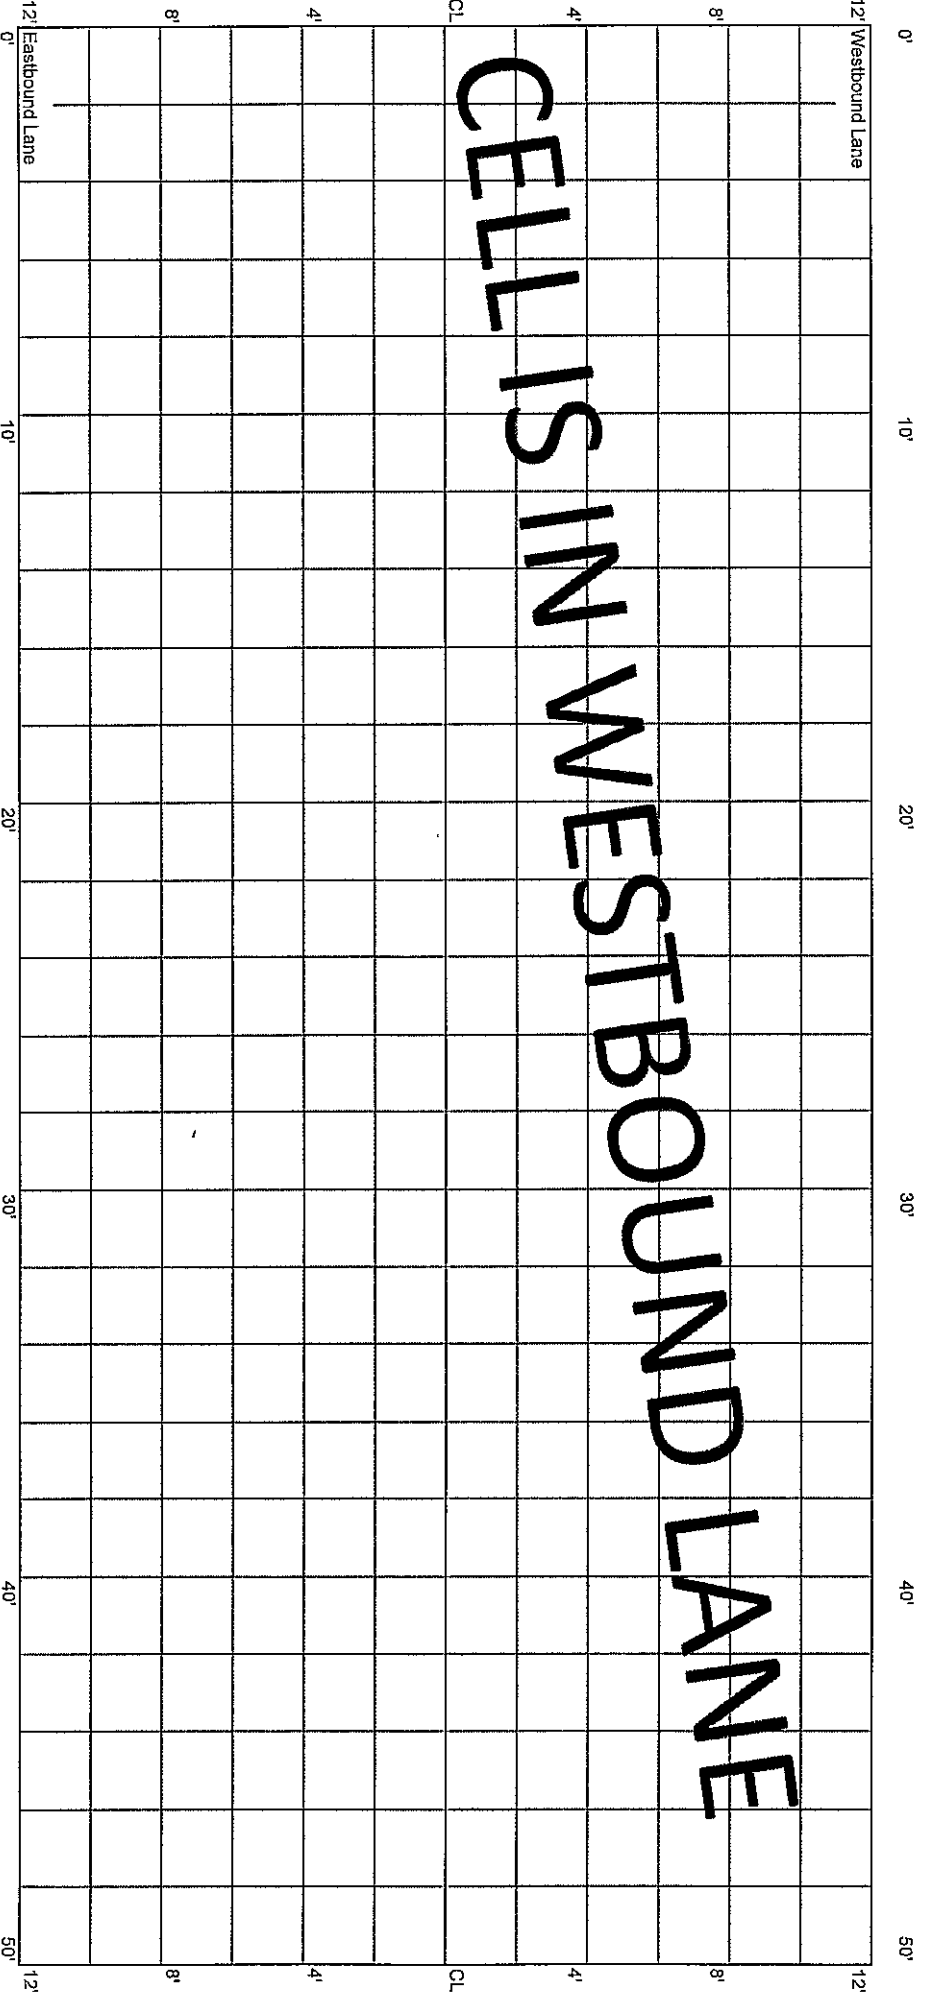




CELL 7007W  
400 - 450 ft

34+00


33+50

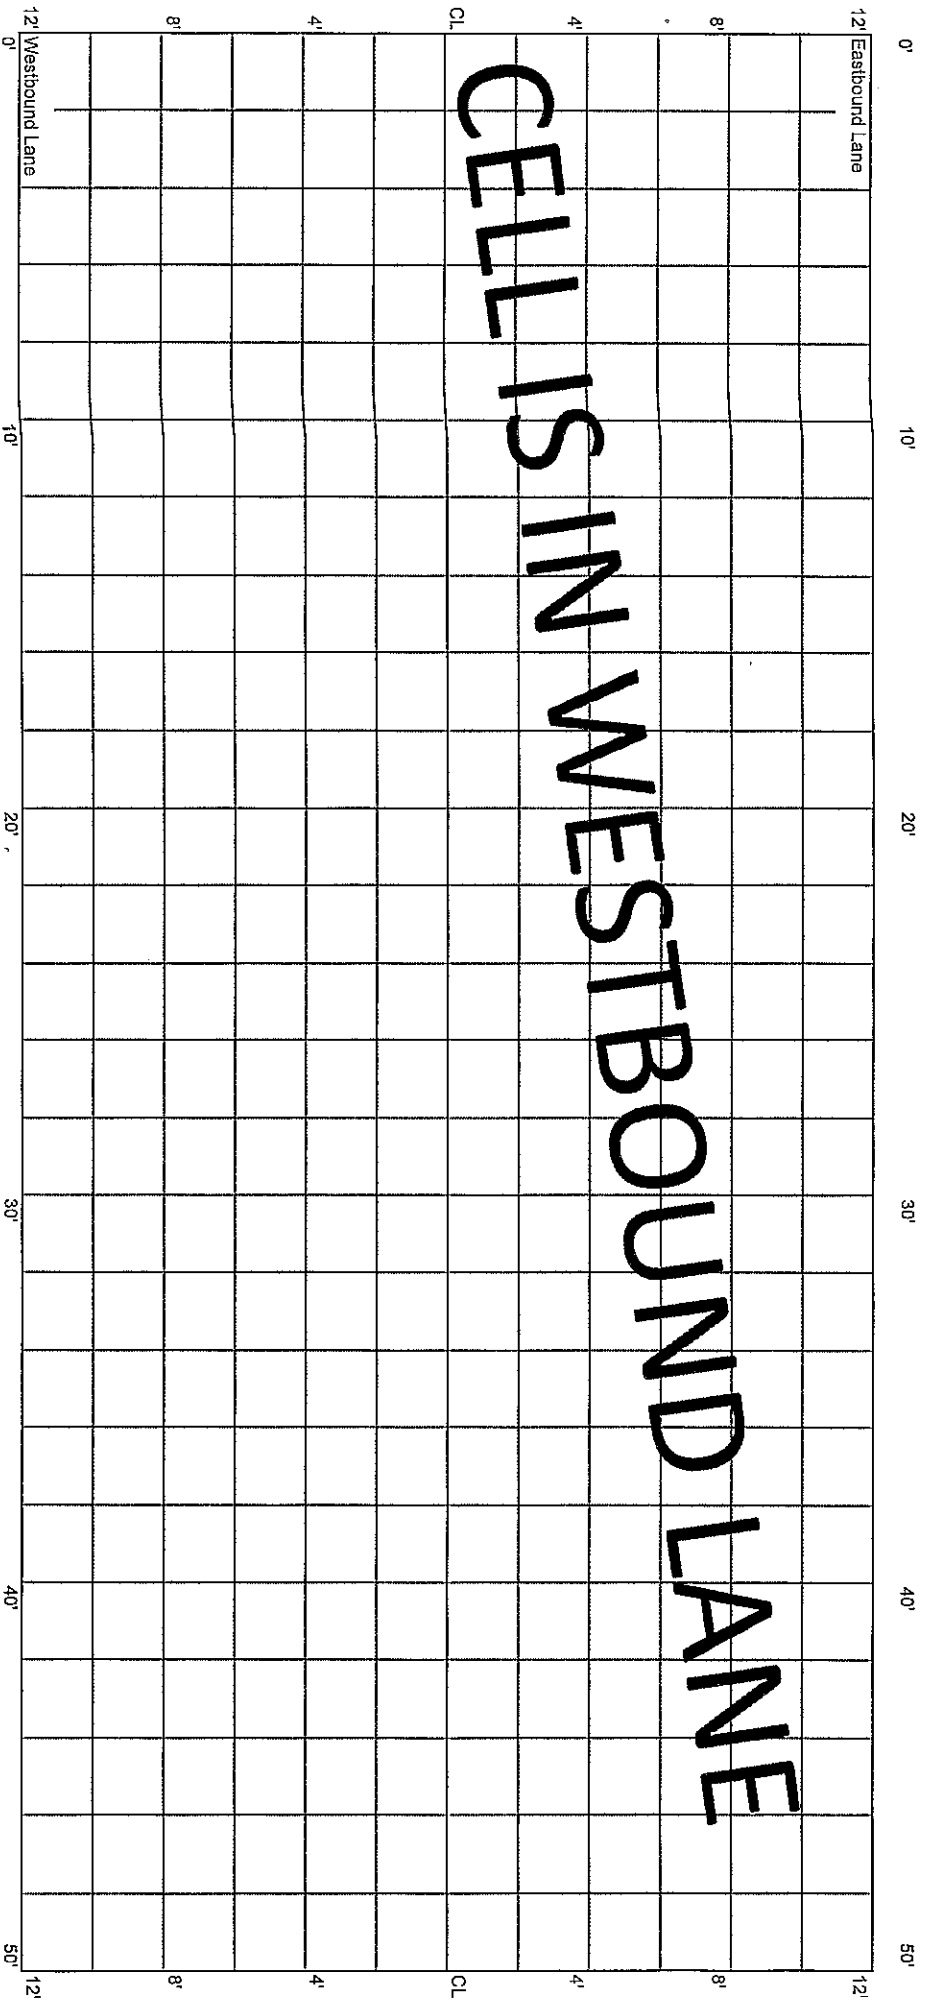

CELL 7007W  
450 - 500 ft

33+50

33+00

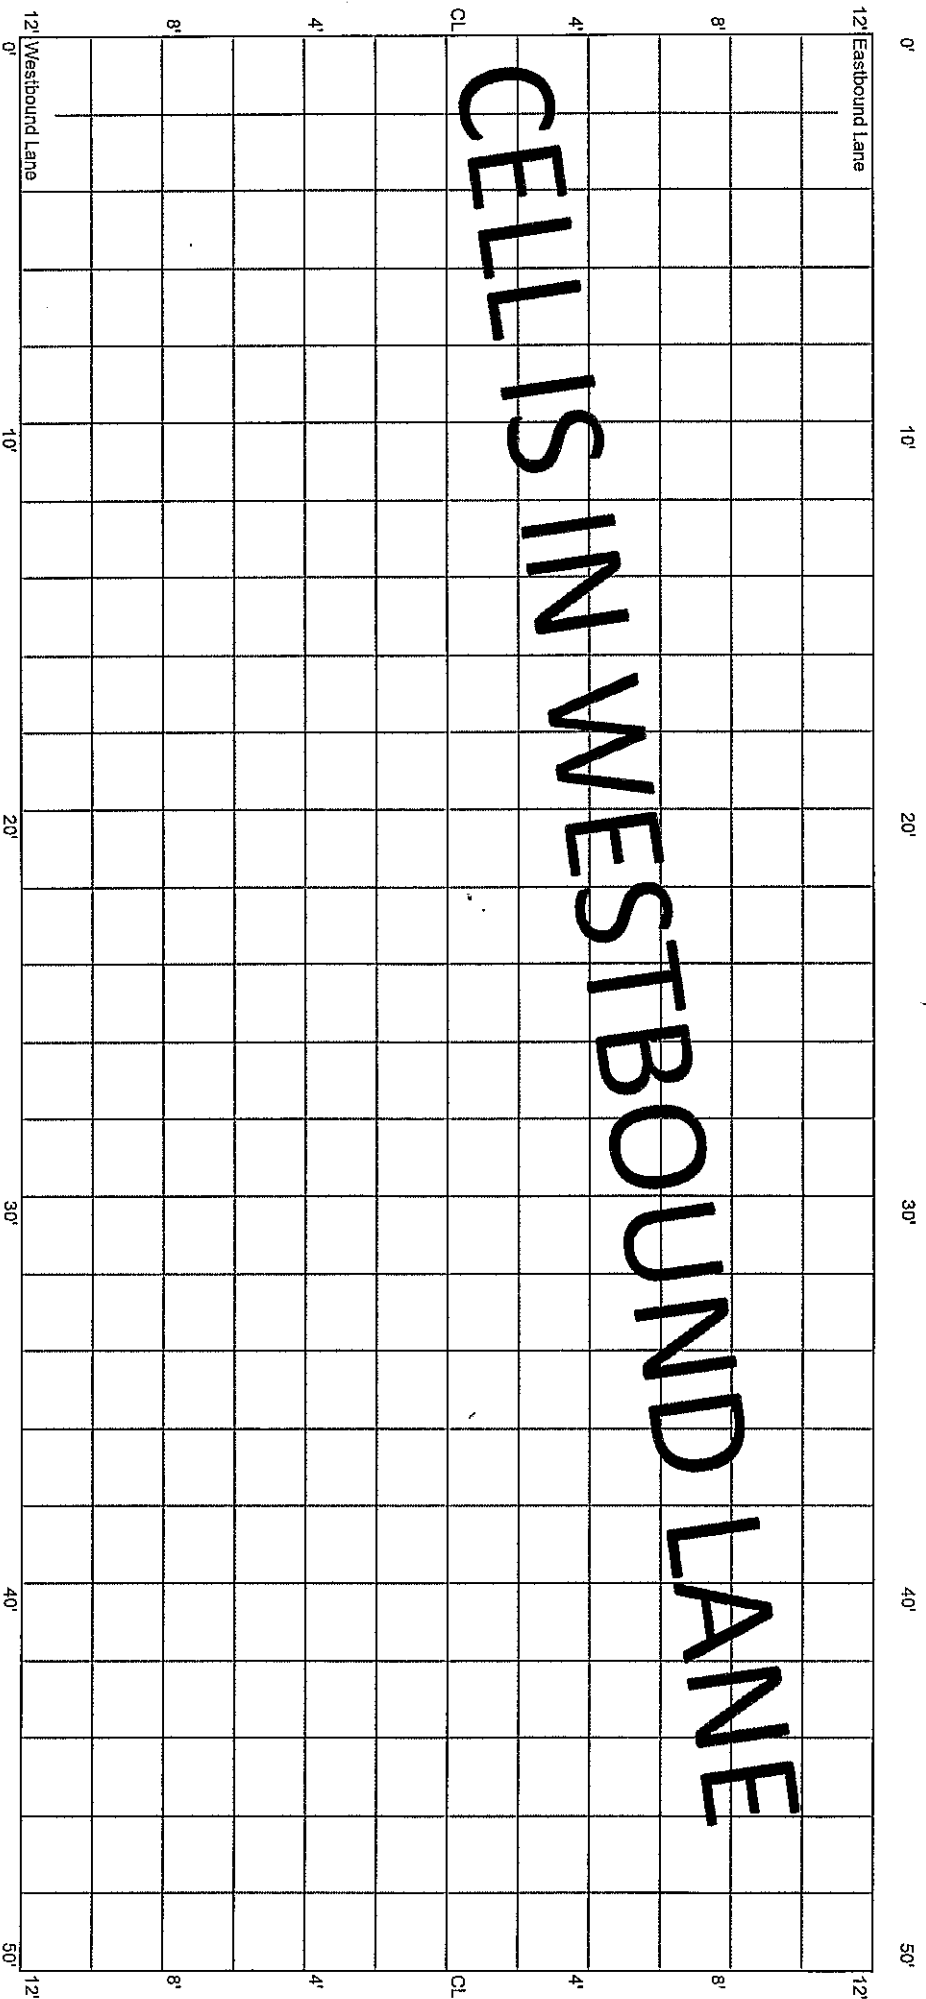

CELL 7007W  
500 - 550 ft

33+00

32+75

32+50

