


5,28,20, E.S.
10.14.20

File 70TH ST

CELL 7008W
0 - 50 ft

43+50

43+00

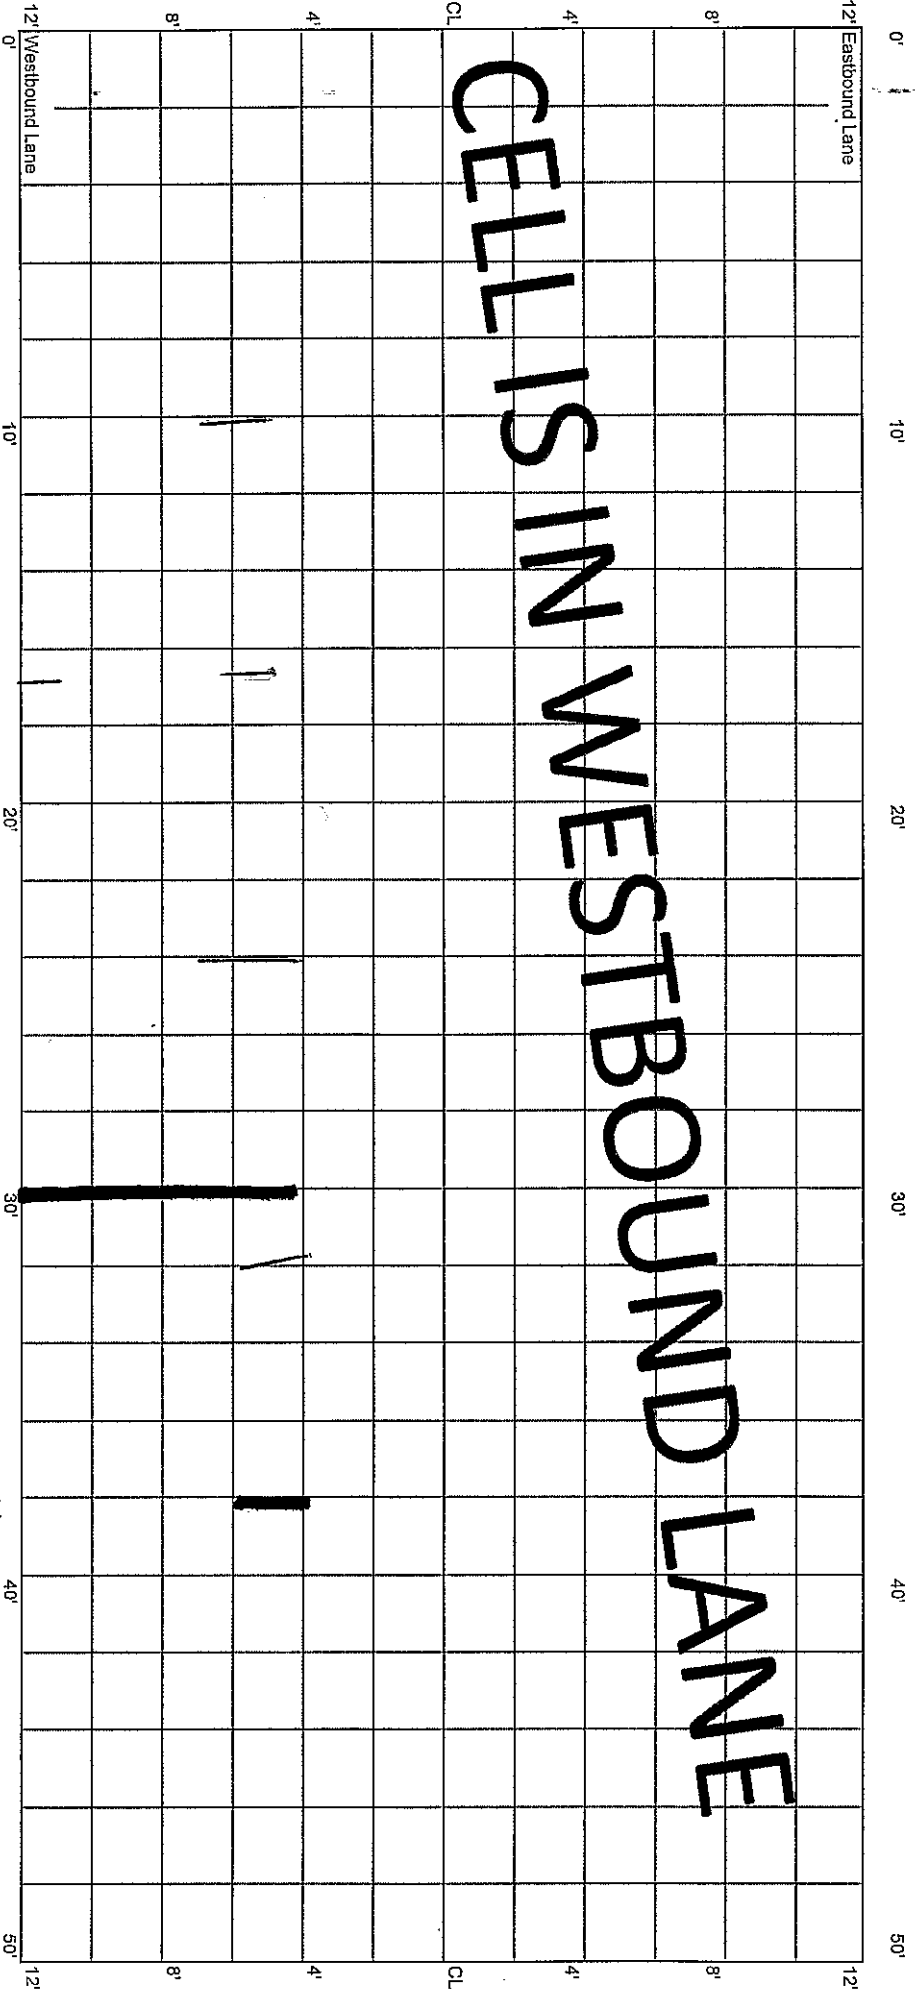

* ROUT & SEAL

CELL 7008W
50 - 100 ft


43+00

42+50

0' 10' 20' 30' 40' 50'

12' Eastbound Lane
0' 10' 20' 30' 40' 50'
12' Westbound Lane


CELLS IN WESTBOUND LANE

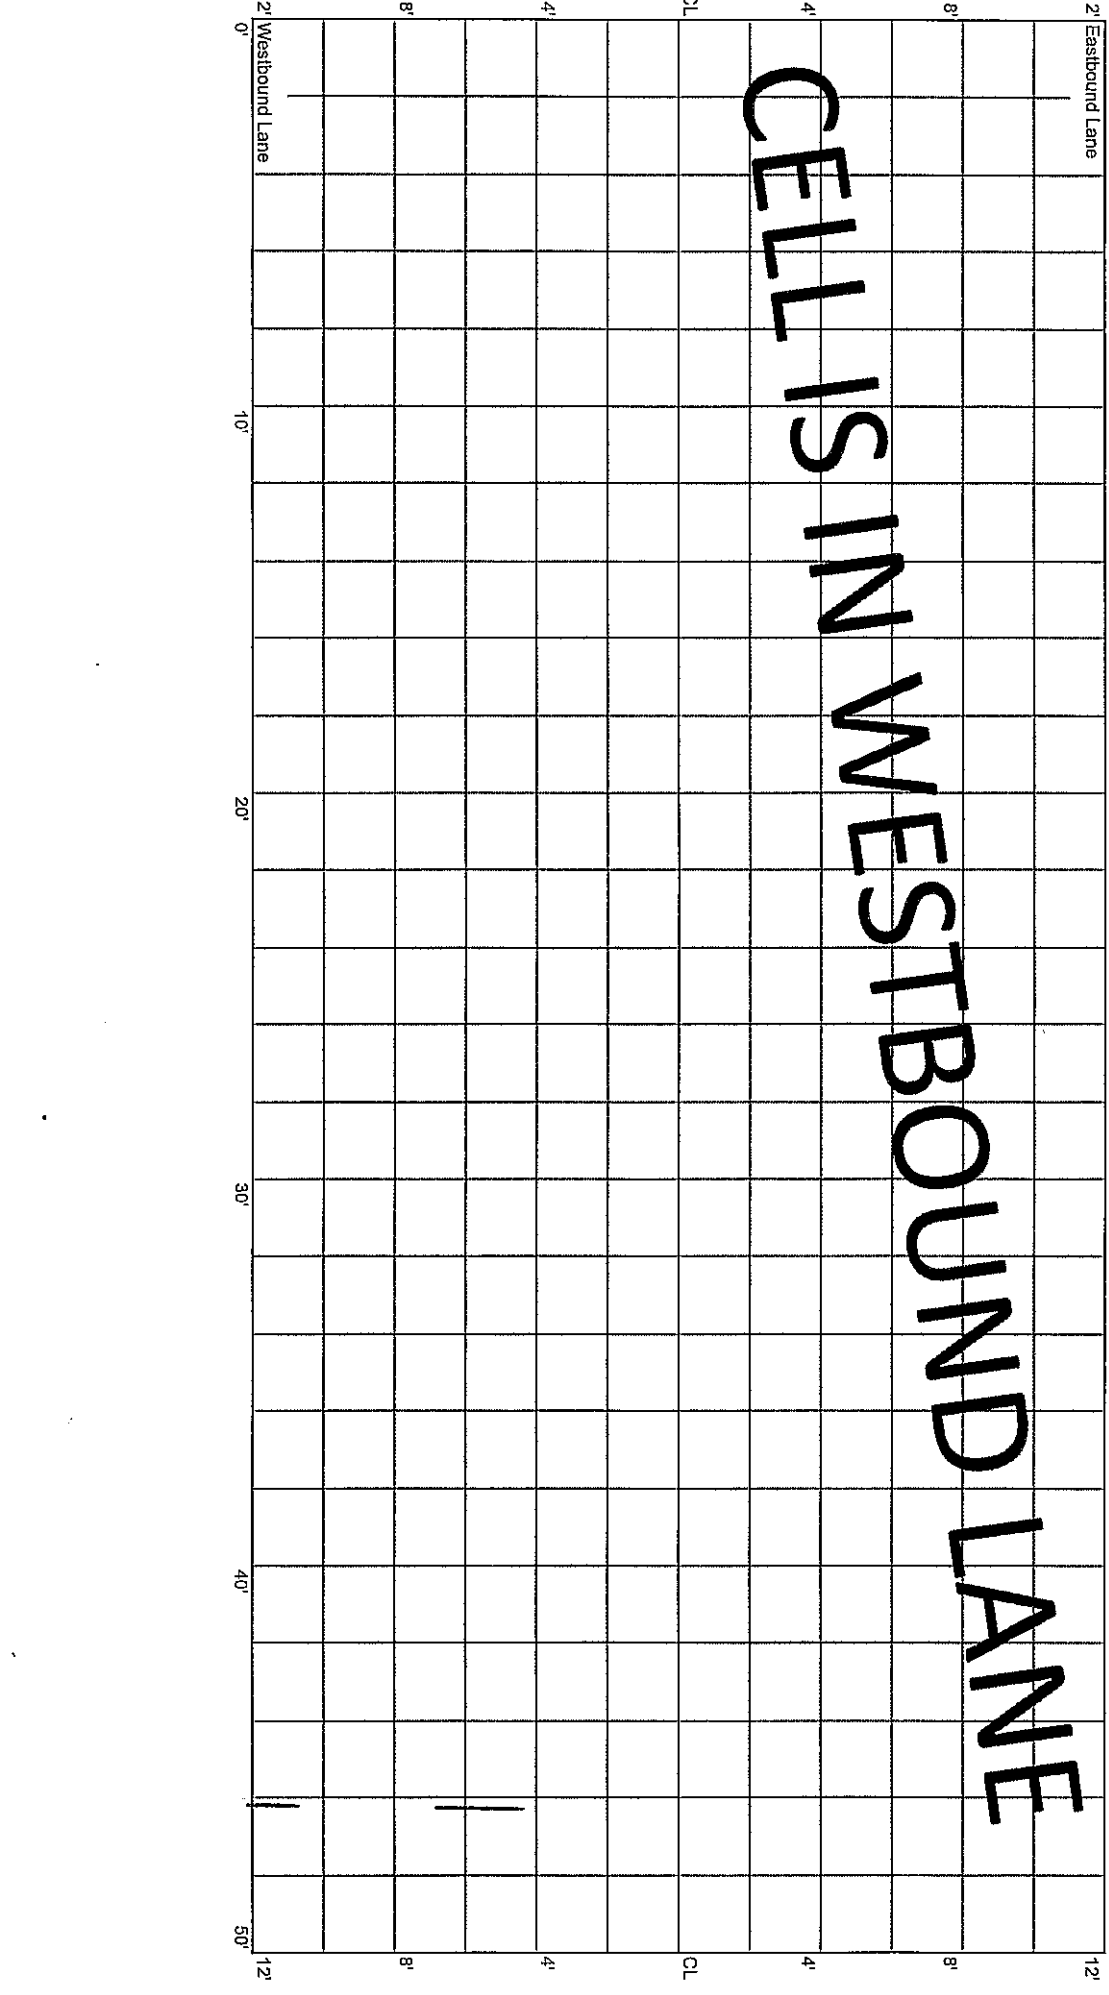

CELL 7008W
100 - 150 ft

42+50

42+00

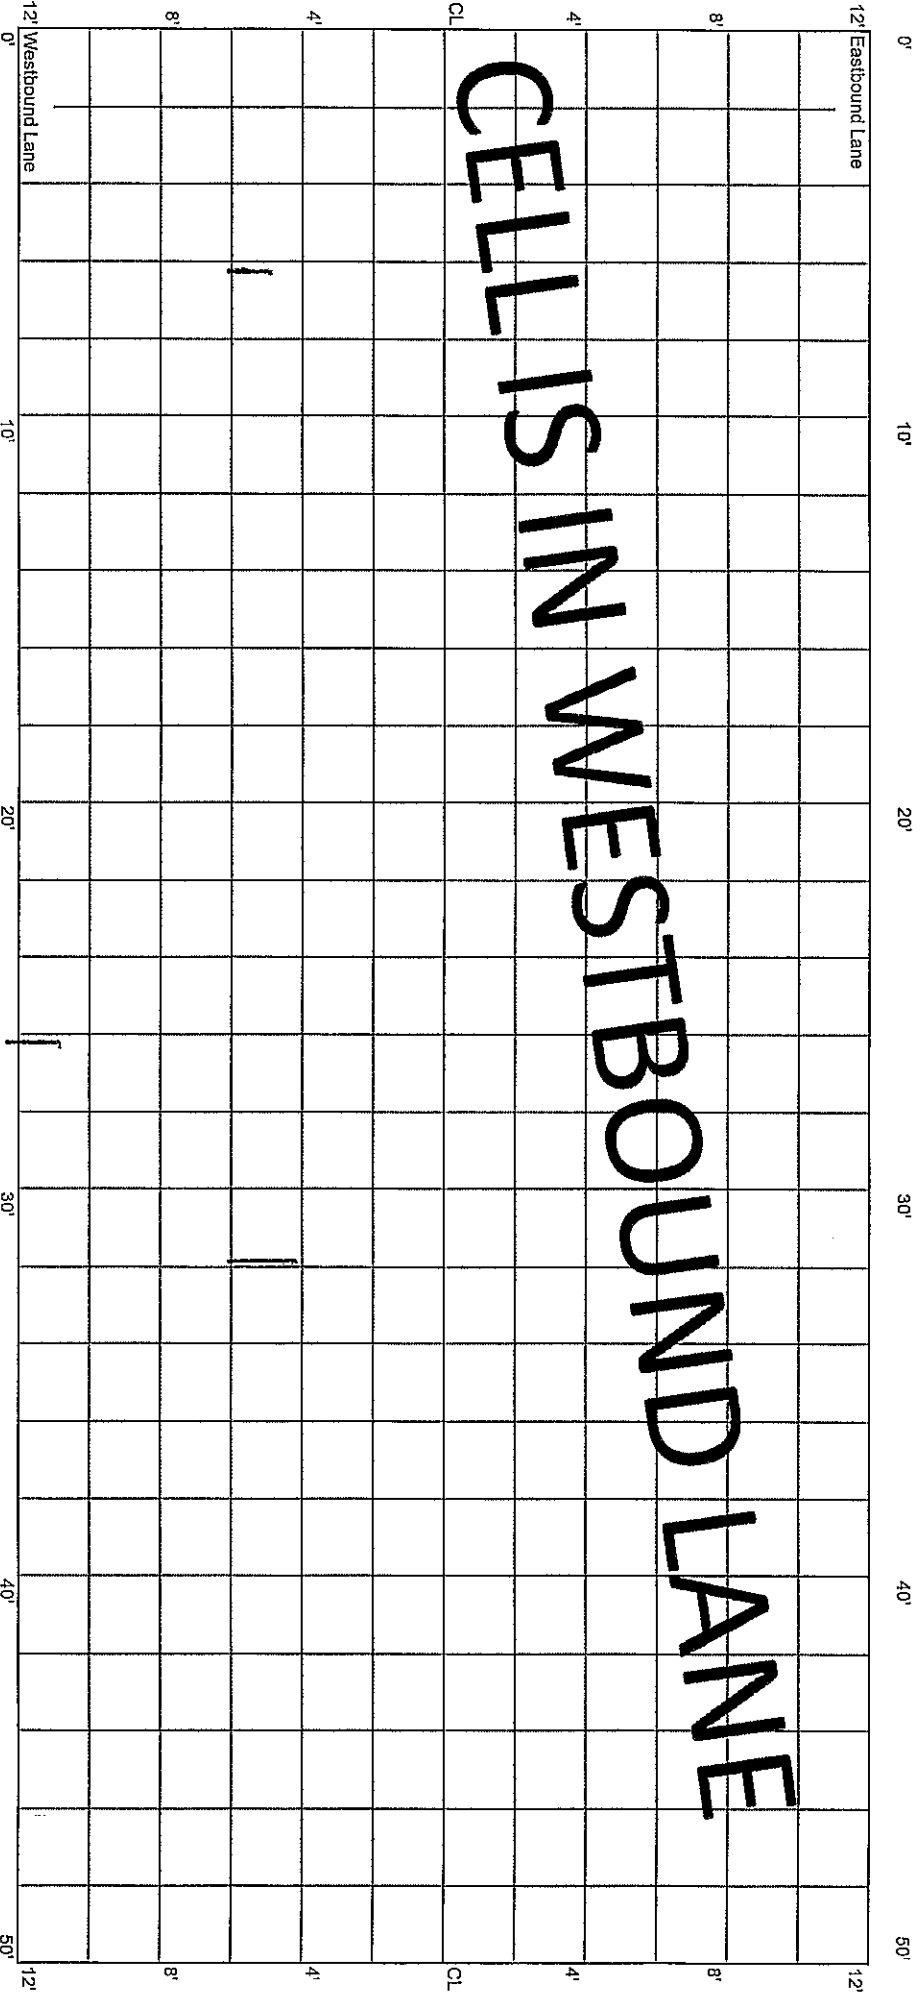


1
2
3
4

CELL 7008W
150 - 200 ft

42+00


41+50

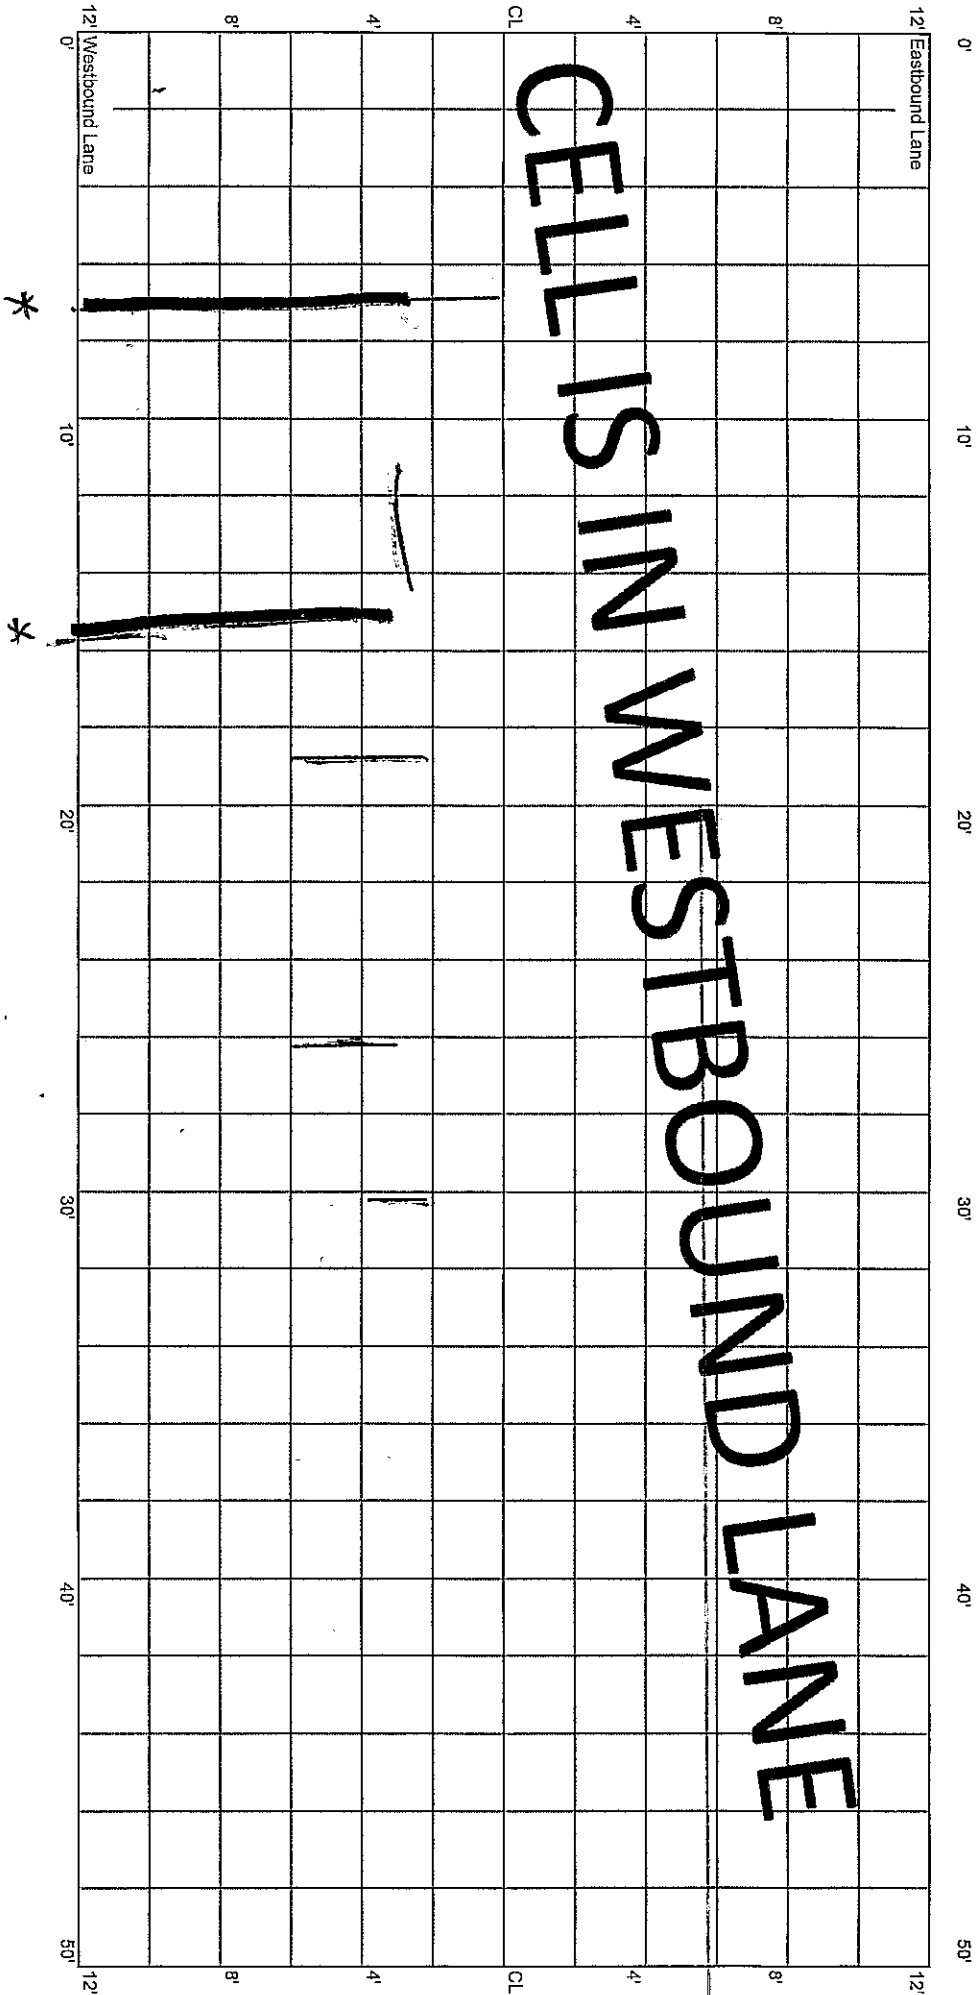

CELL 7008W
200 - 250 ft

41+50

41+00

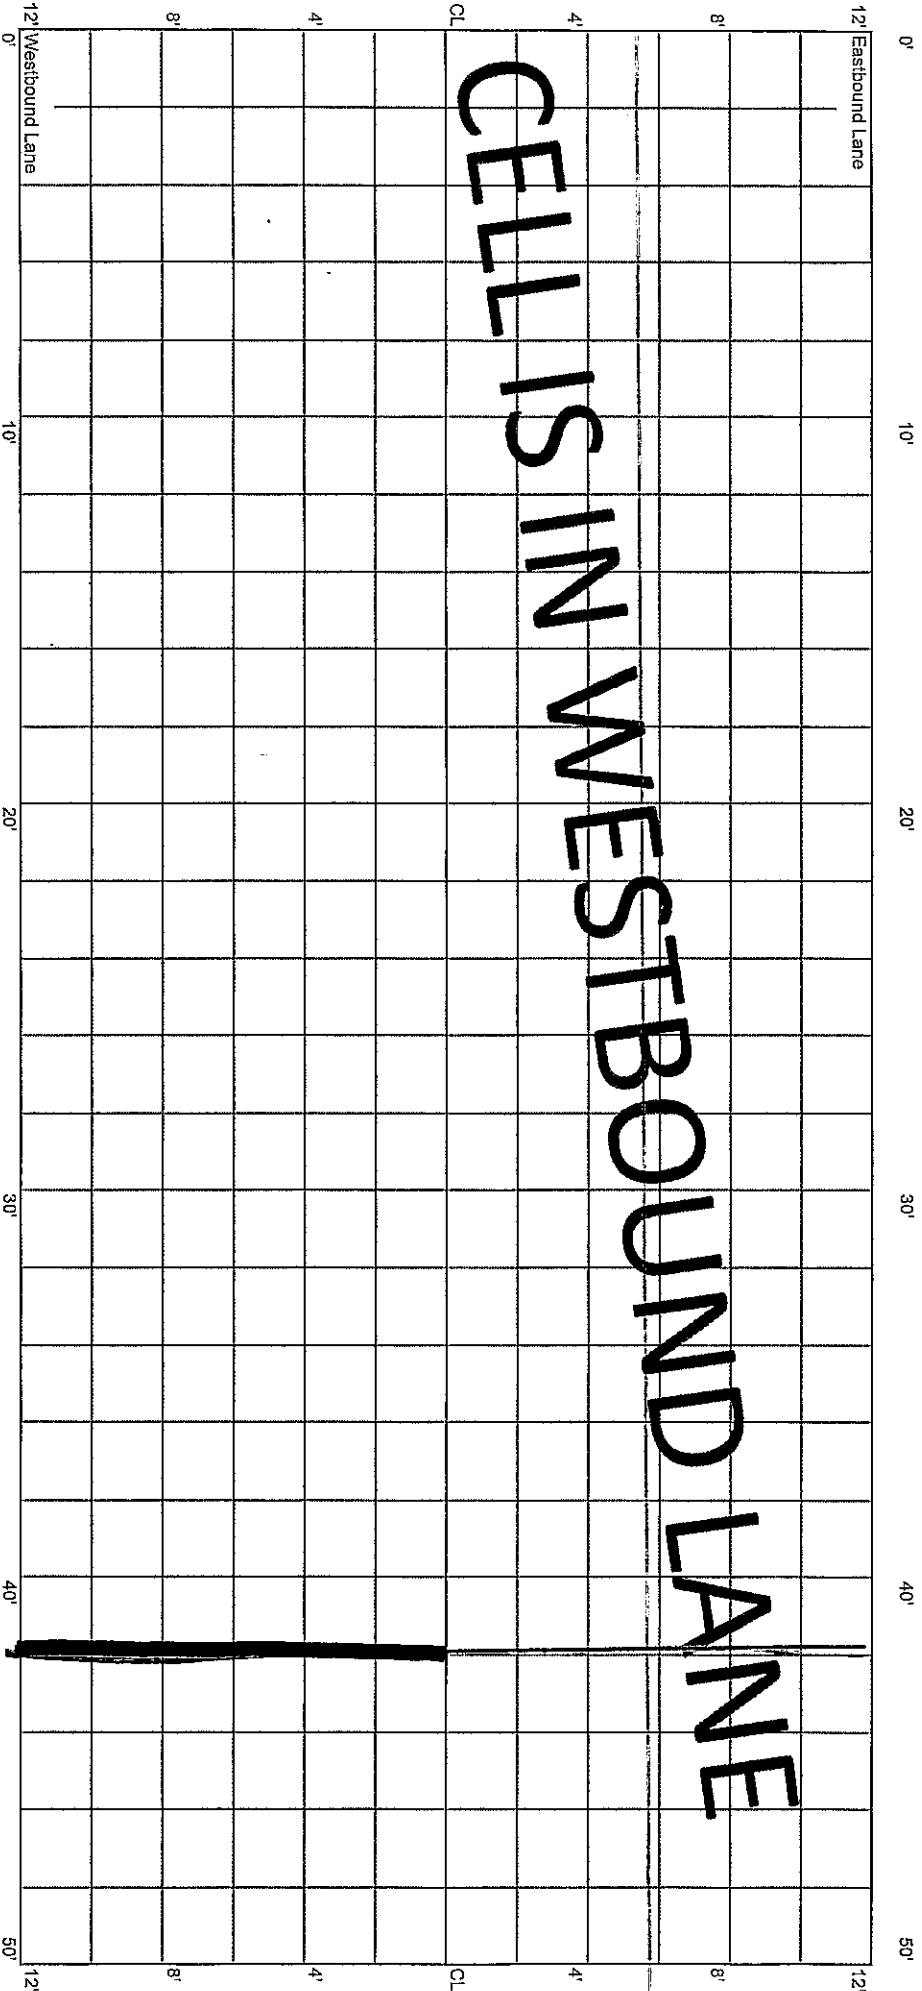


*

CELL 7008W
250 - 300 ft

41+00

40+50

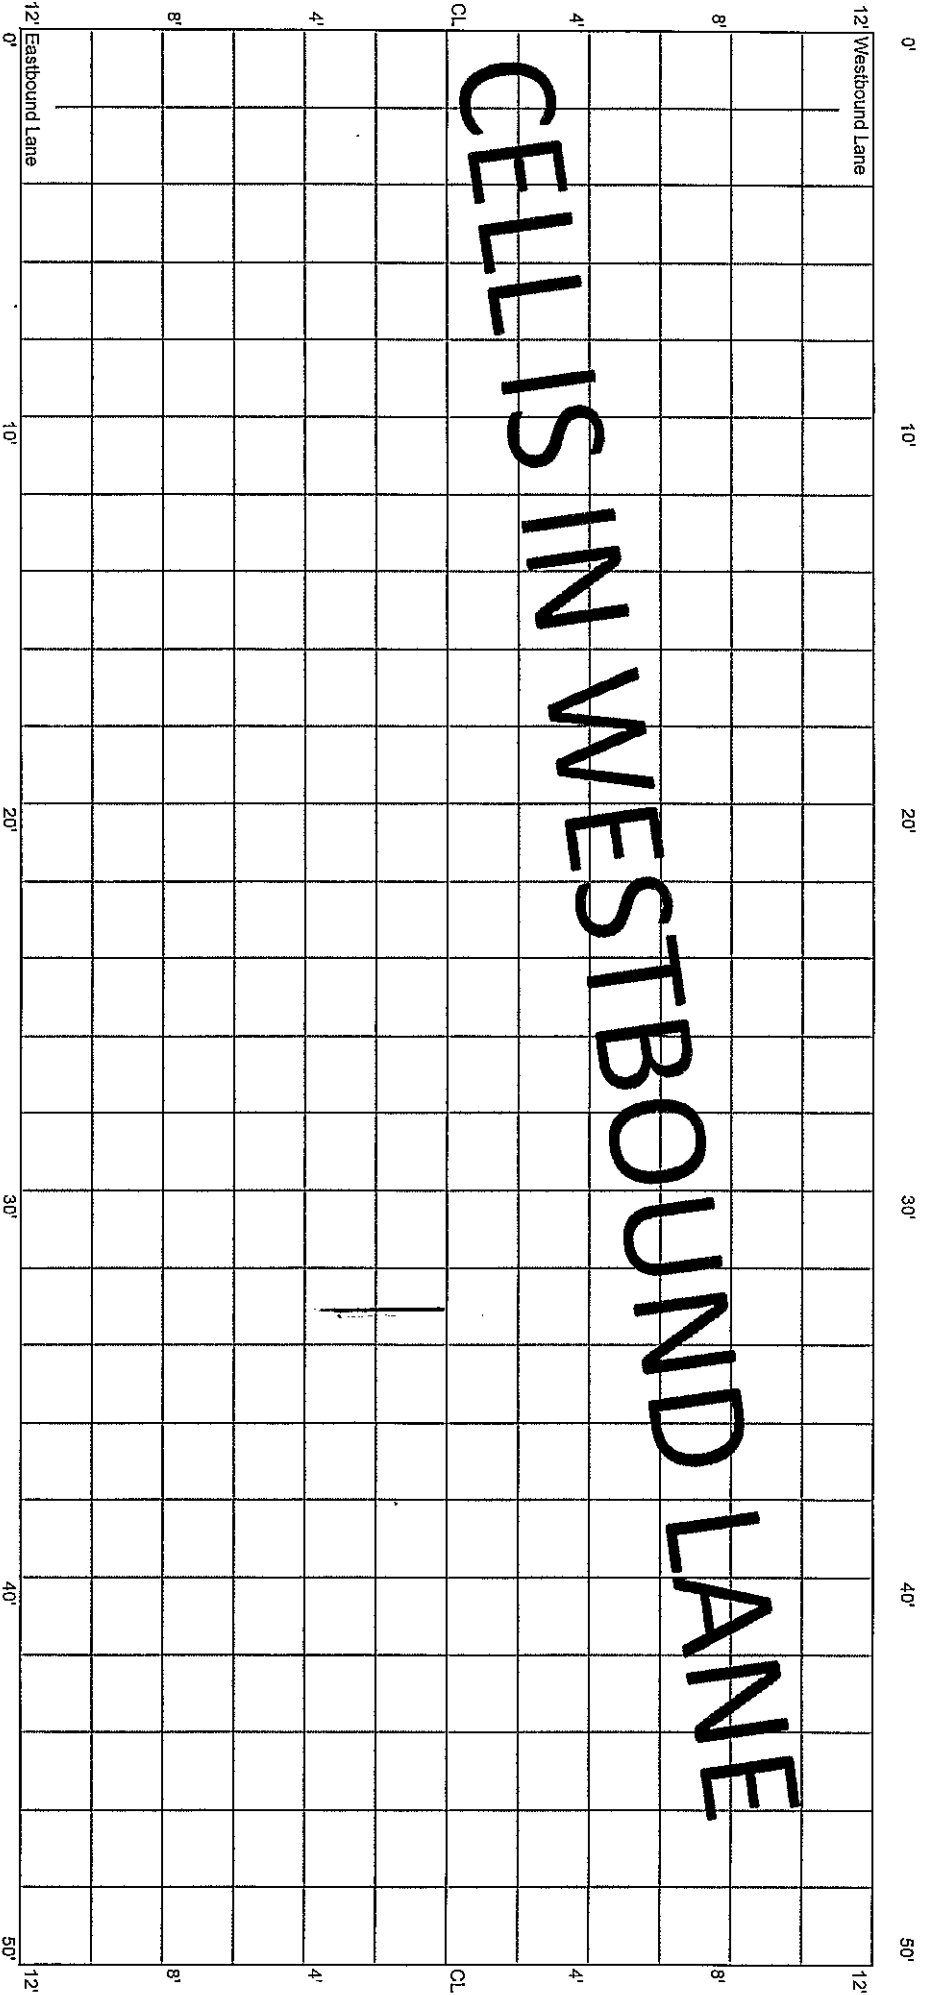

0' 10' 20' 30' 40' 50'

12 Westbound Lane 12 Eastbound Lane

CELLS IN WESTBOUND LANE


8' 4' CL 8' 4' CL

0' 10' 20' 30' 40' 50'

CELL 7008W
300 - 350 ft

40+50


40+00

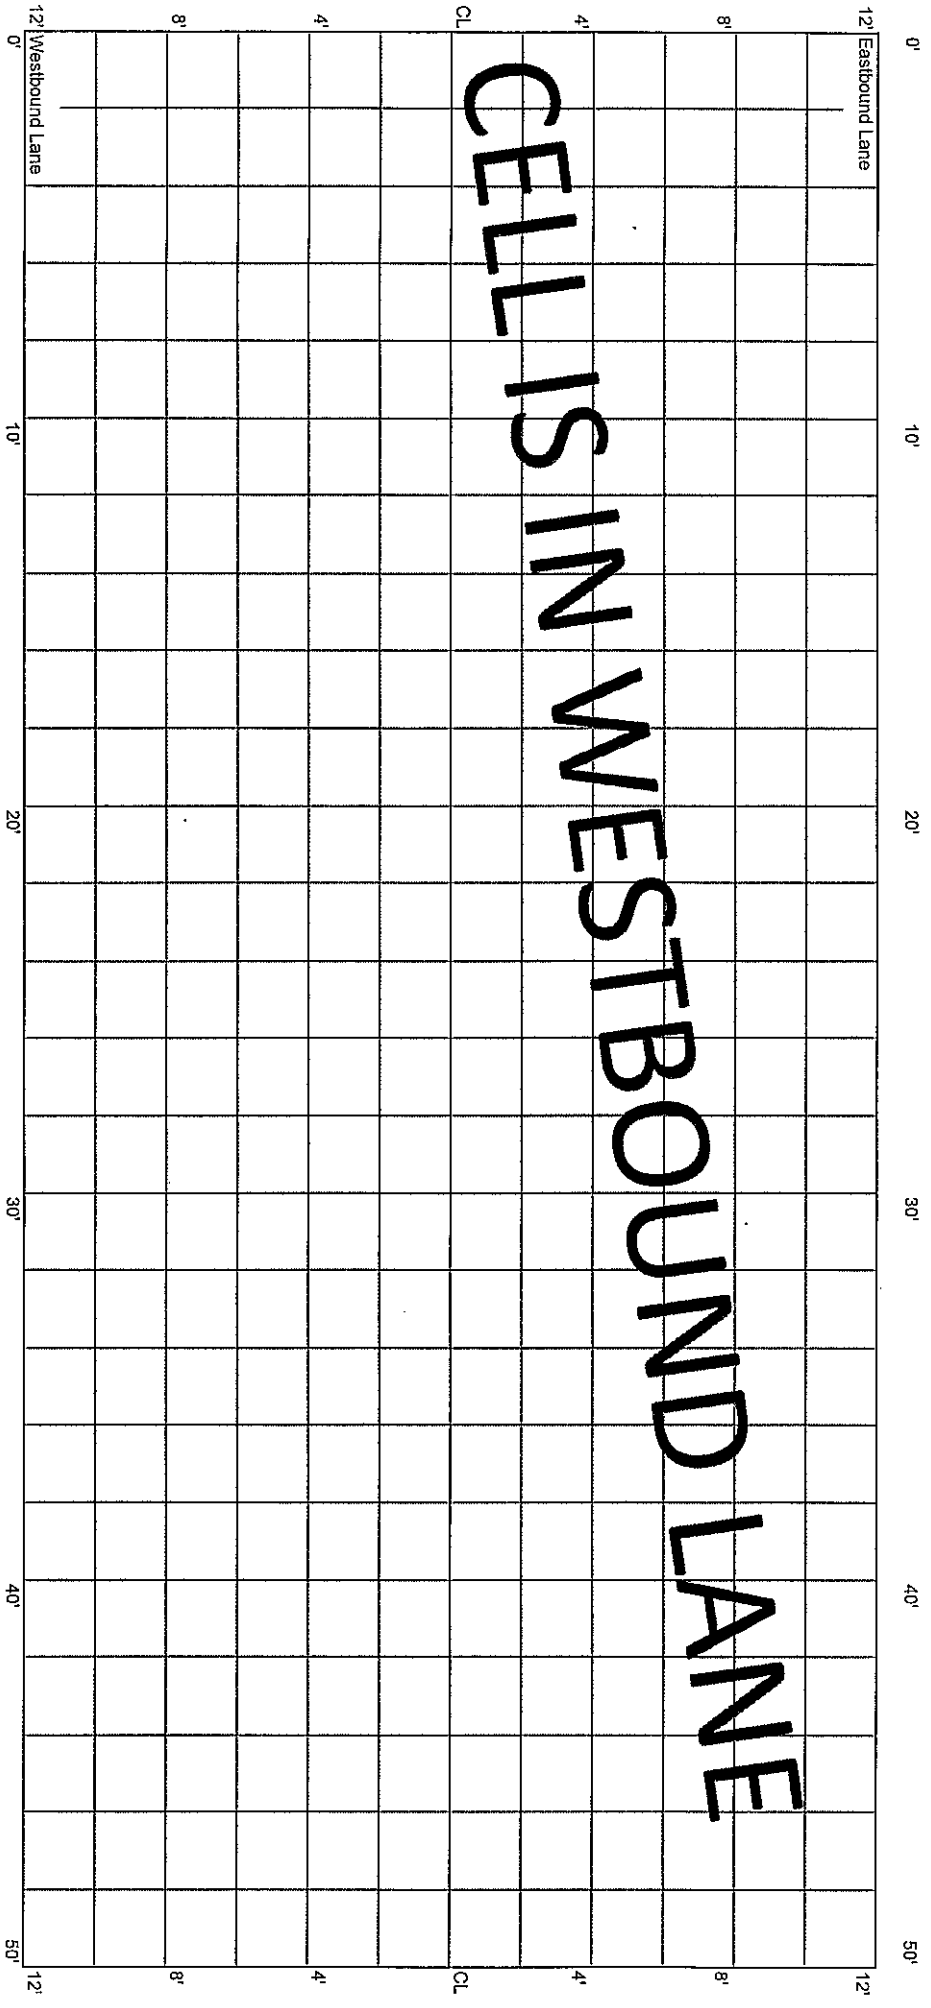

CELL 7008W
350 - 400 ft

40+00


39+50

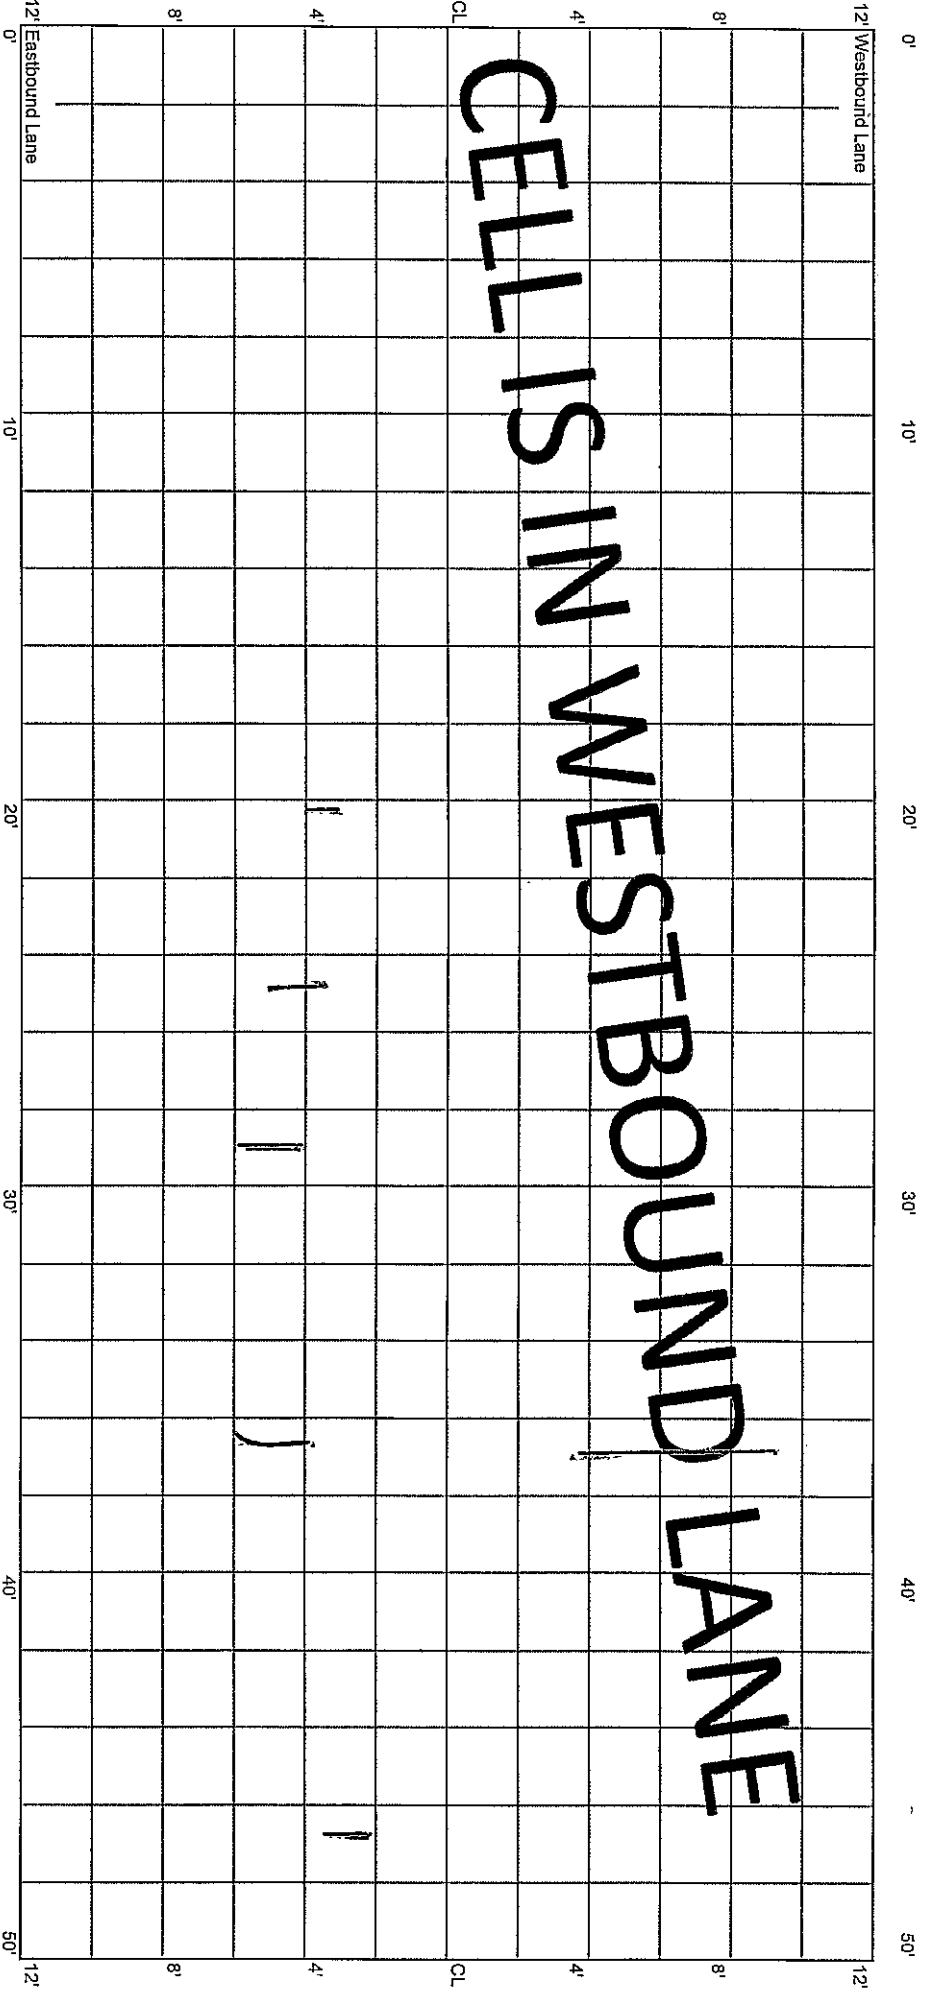

CELL 7008W
400 - 450 ft

39+60


39+00

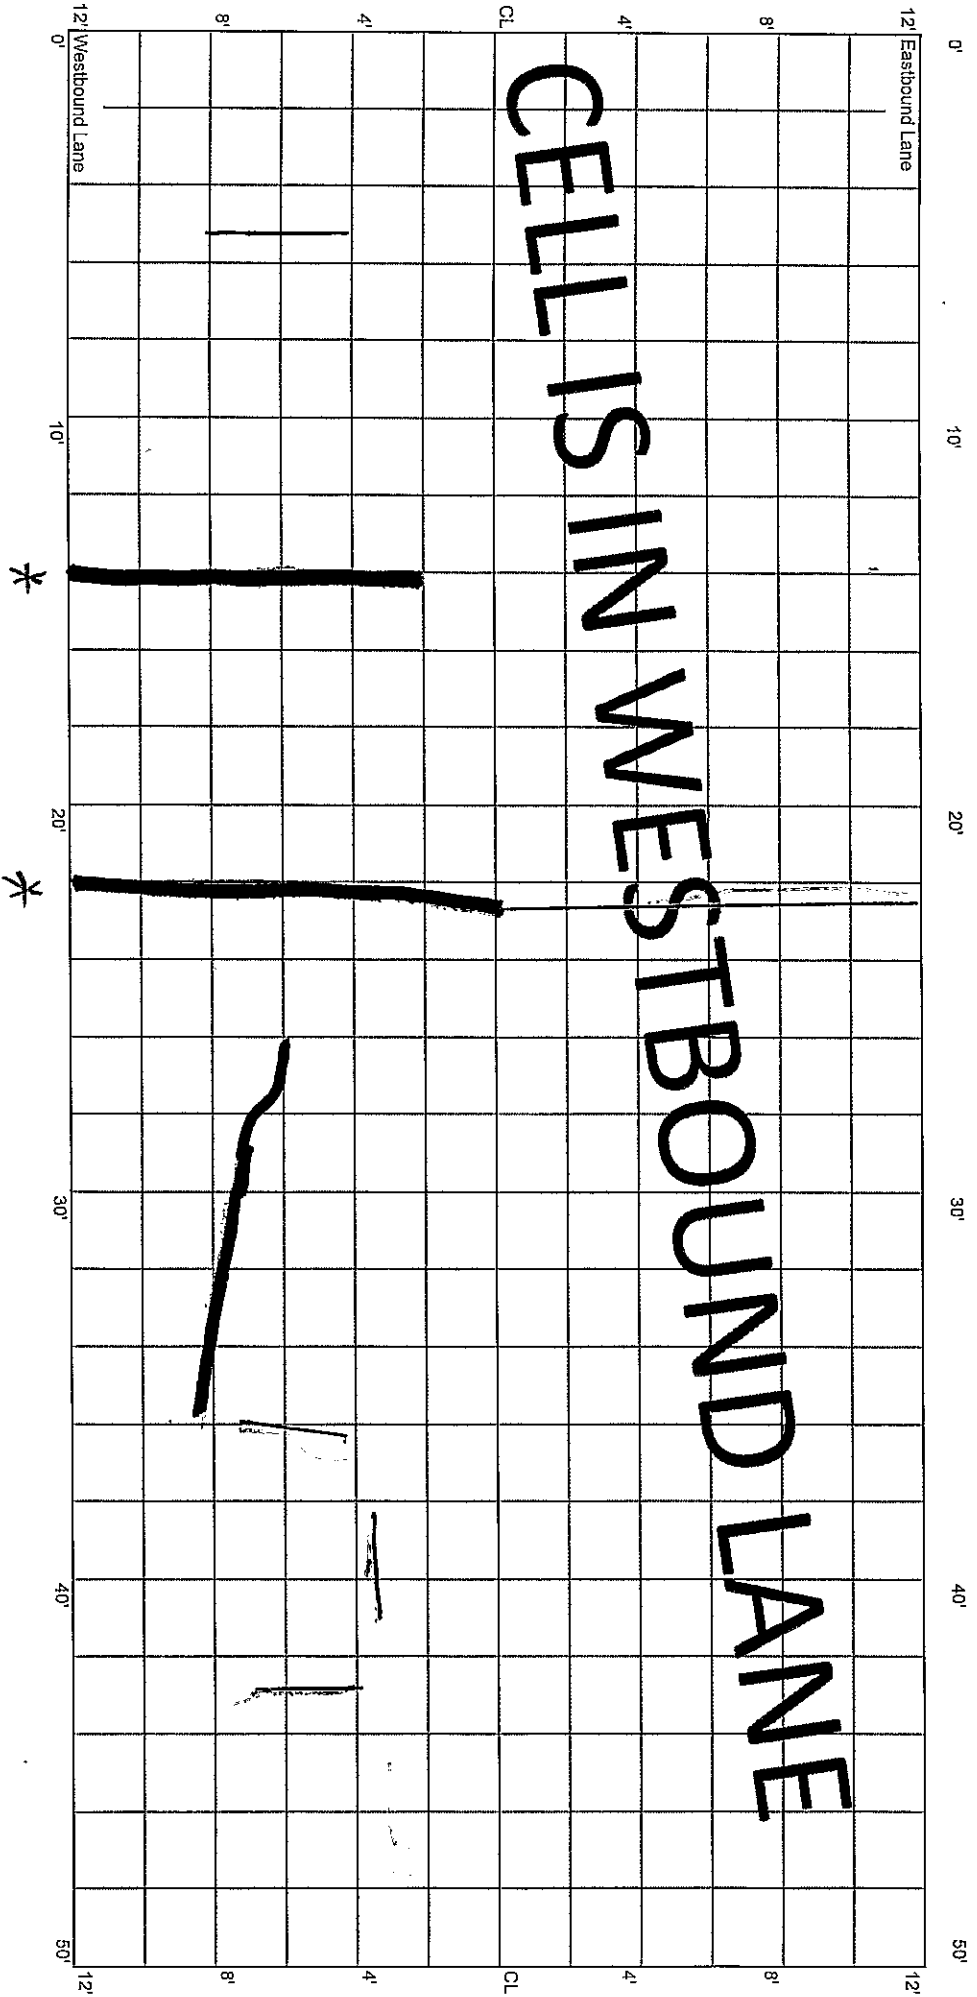

CELL 7008W
450 - 500 ft

39+00

38+50

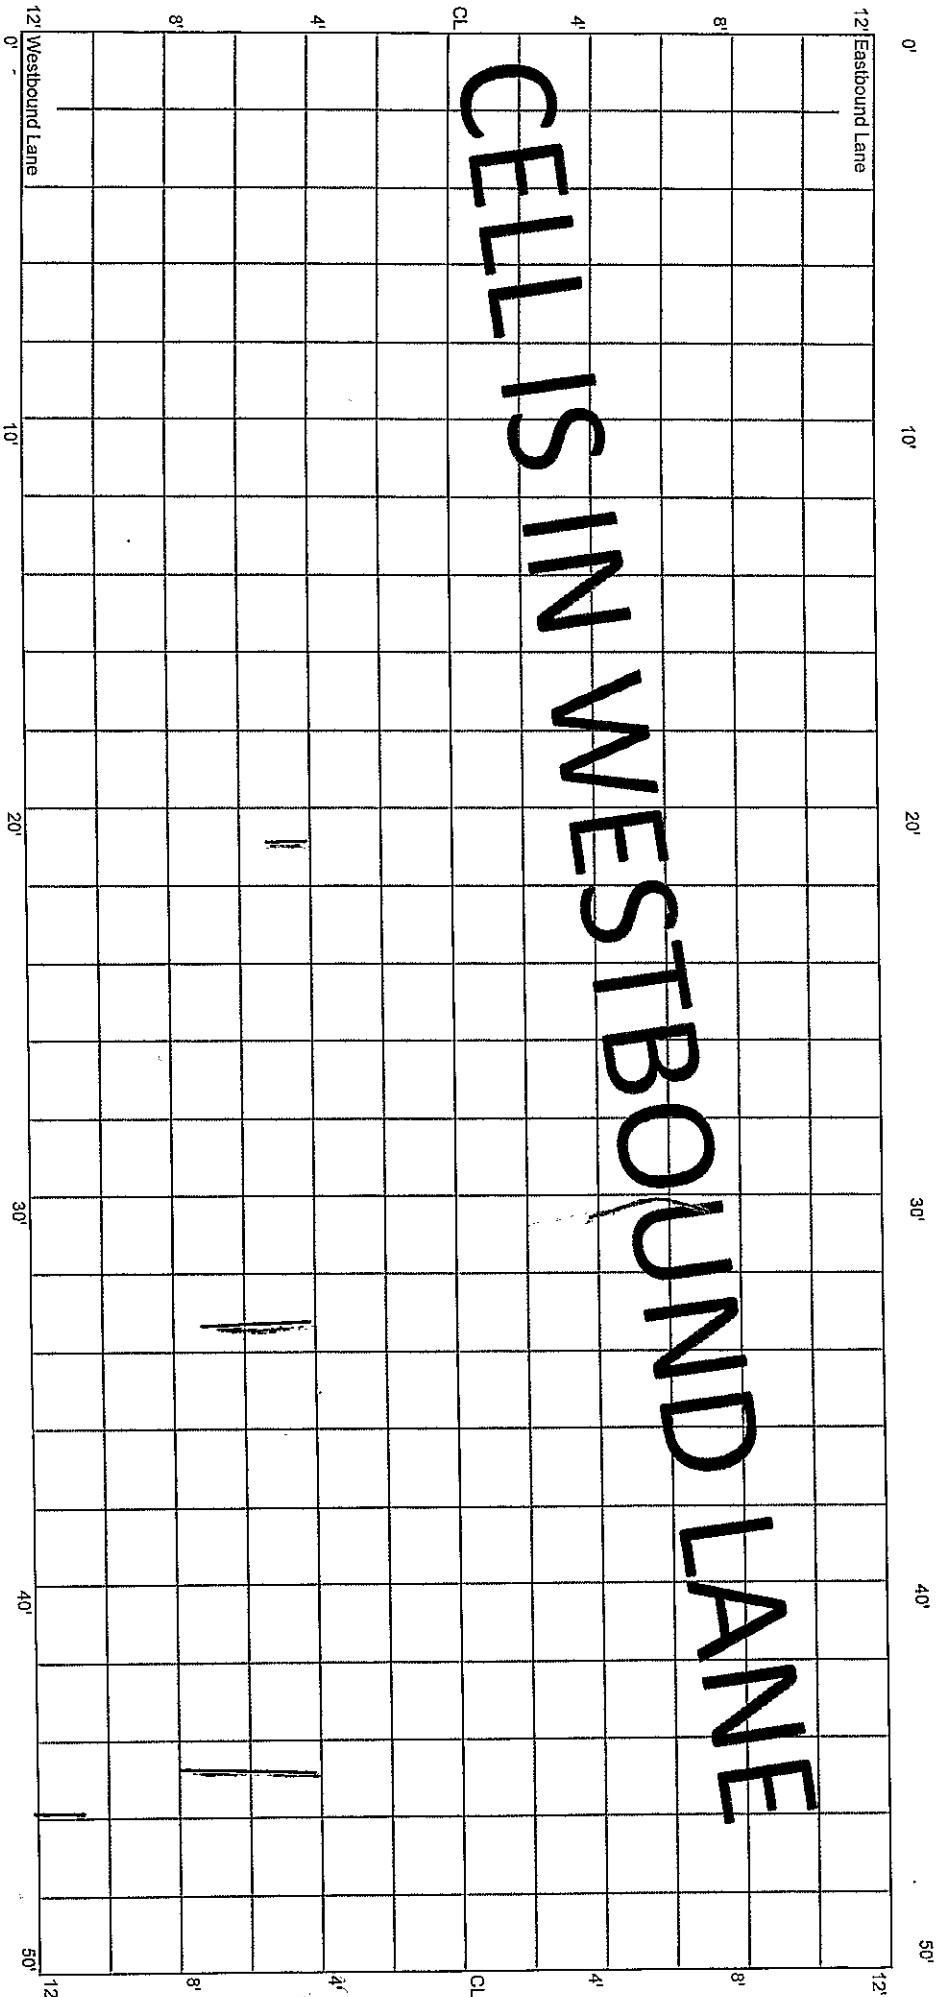

CELL 7008W
500 - 550 ft

38+50

38+25

38+00

