

5.28.20 E.I.T.
10.14.20


File 70TH ST

CELL 7001W
0 - 50 ft

5+00

4+50

0' 10' 20' 30' 40' 50'

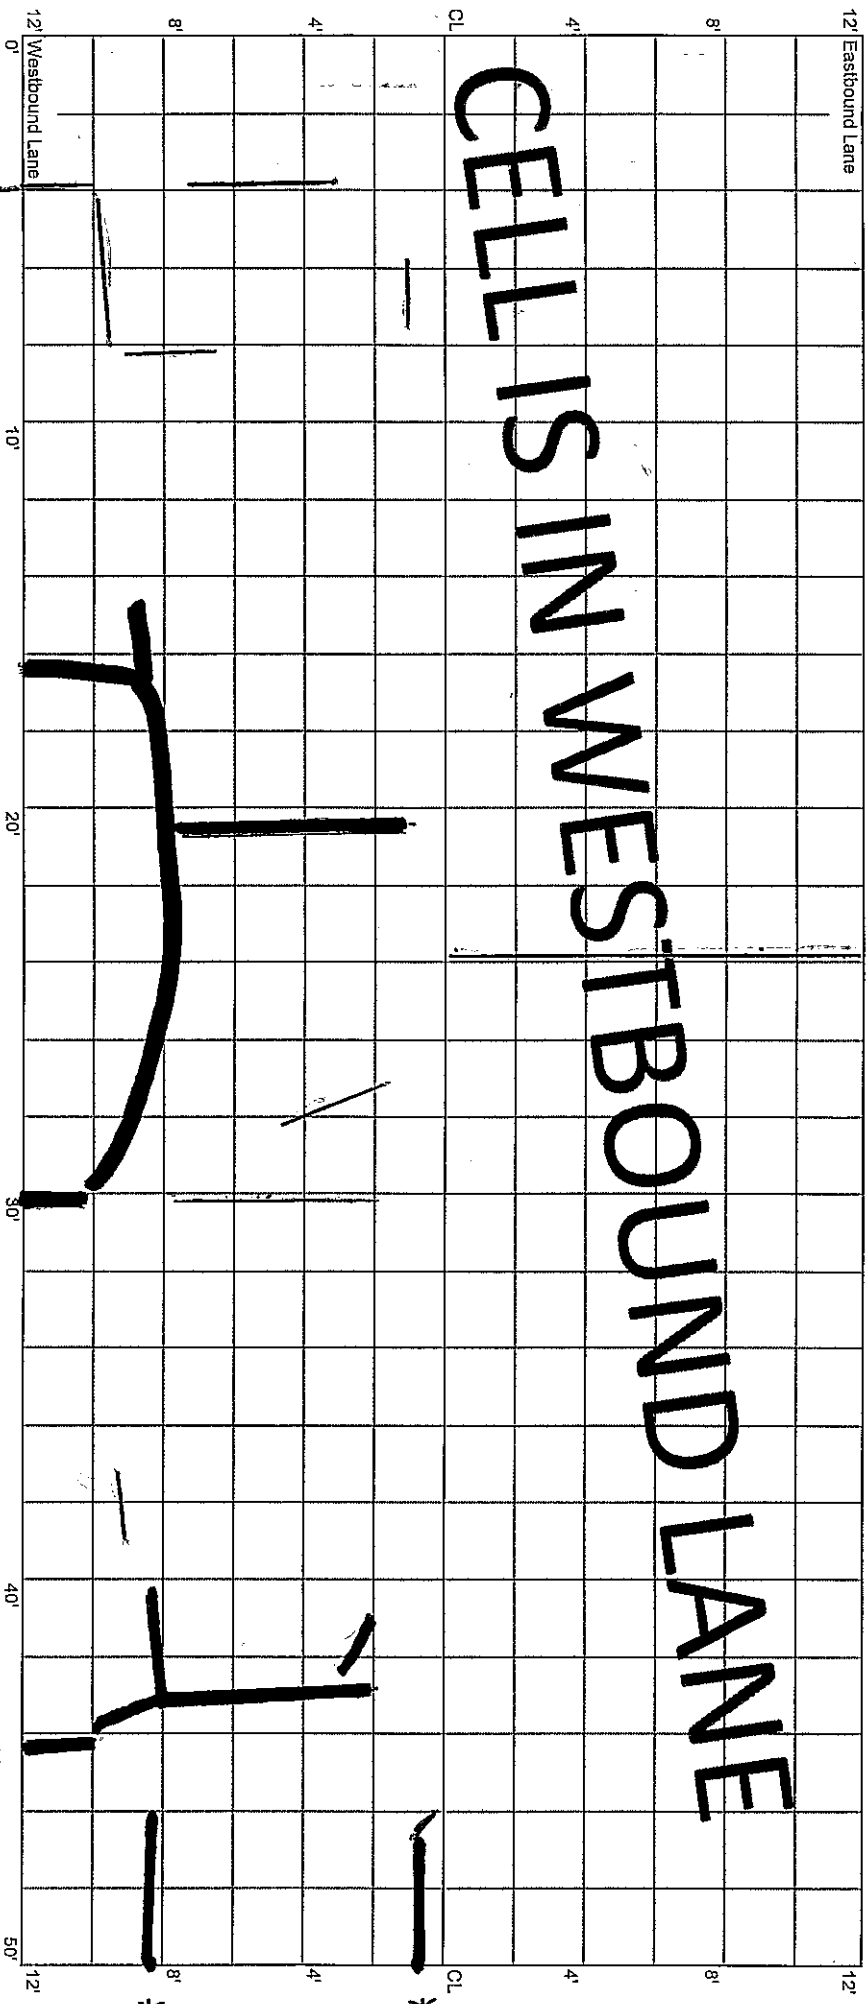

*Port & Seal

F-114 R1
R2

CELL 7001W
50 - 100 ft

4+50


4+00

0' 10' 20' 30' 40' 50'

12' Eastbound Lane

12'

CELLS IN WESTBOUND LANE

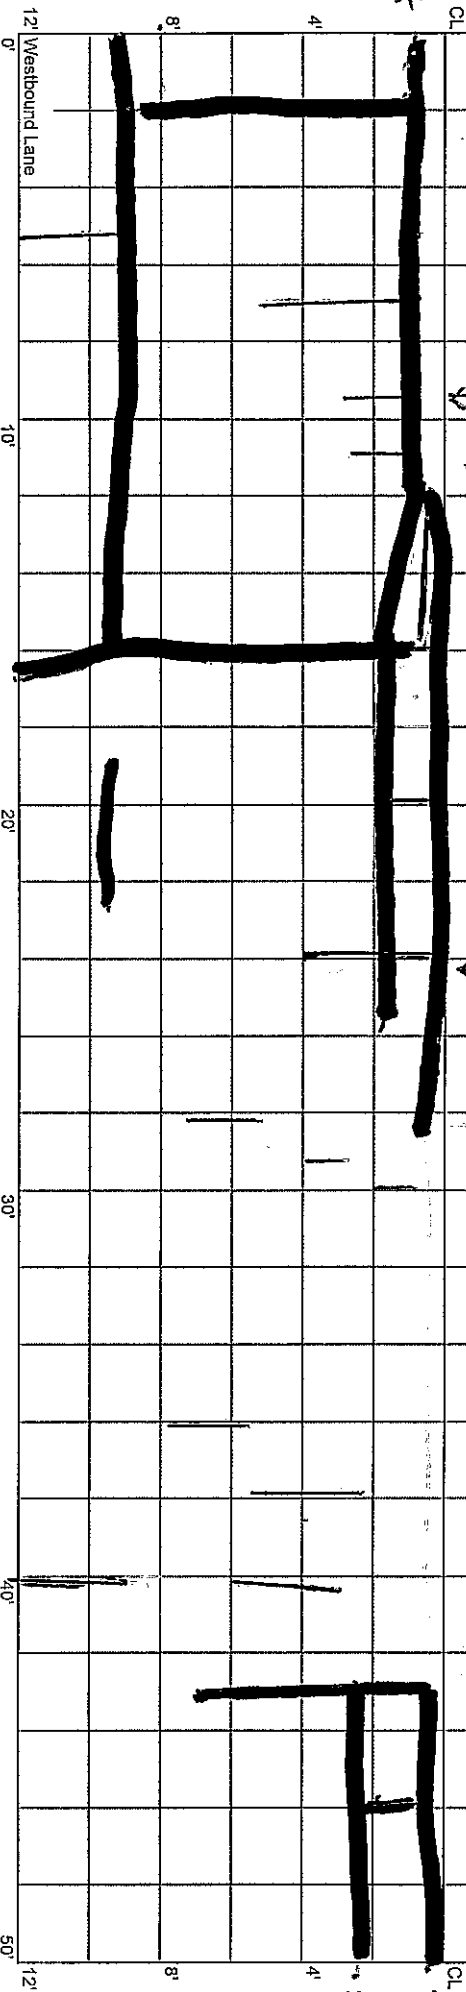

M *

M *


*

* * CL

CELL 7001W
100 - 150 ft

4+00

3+50

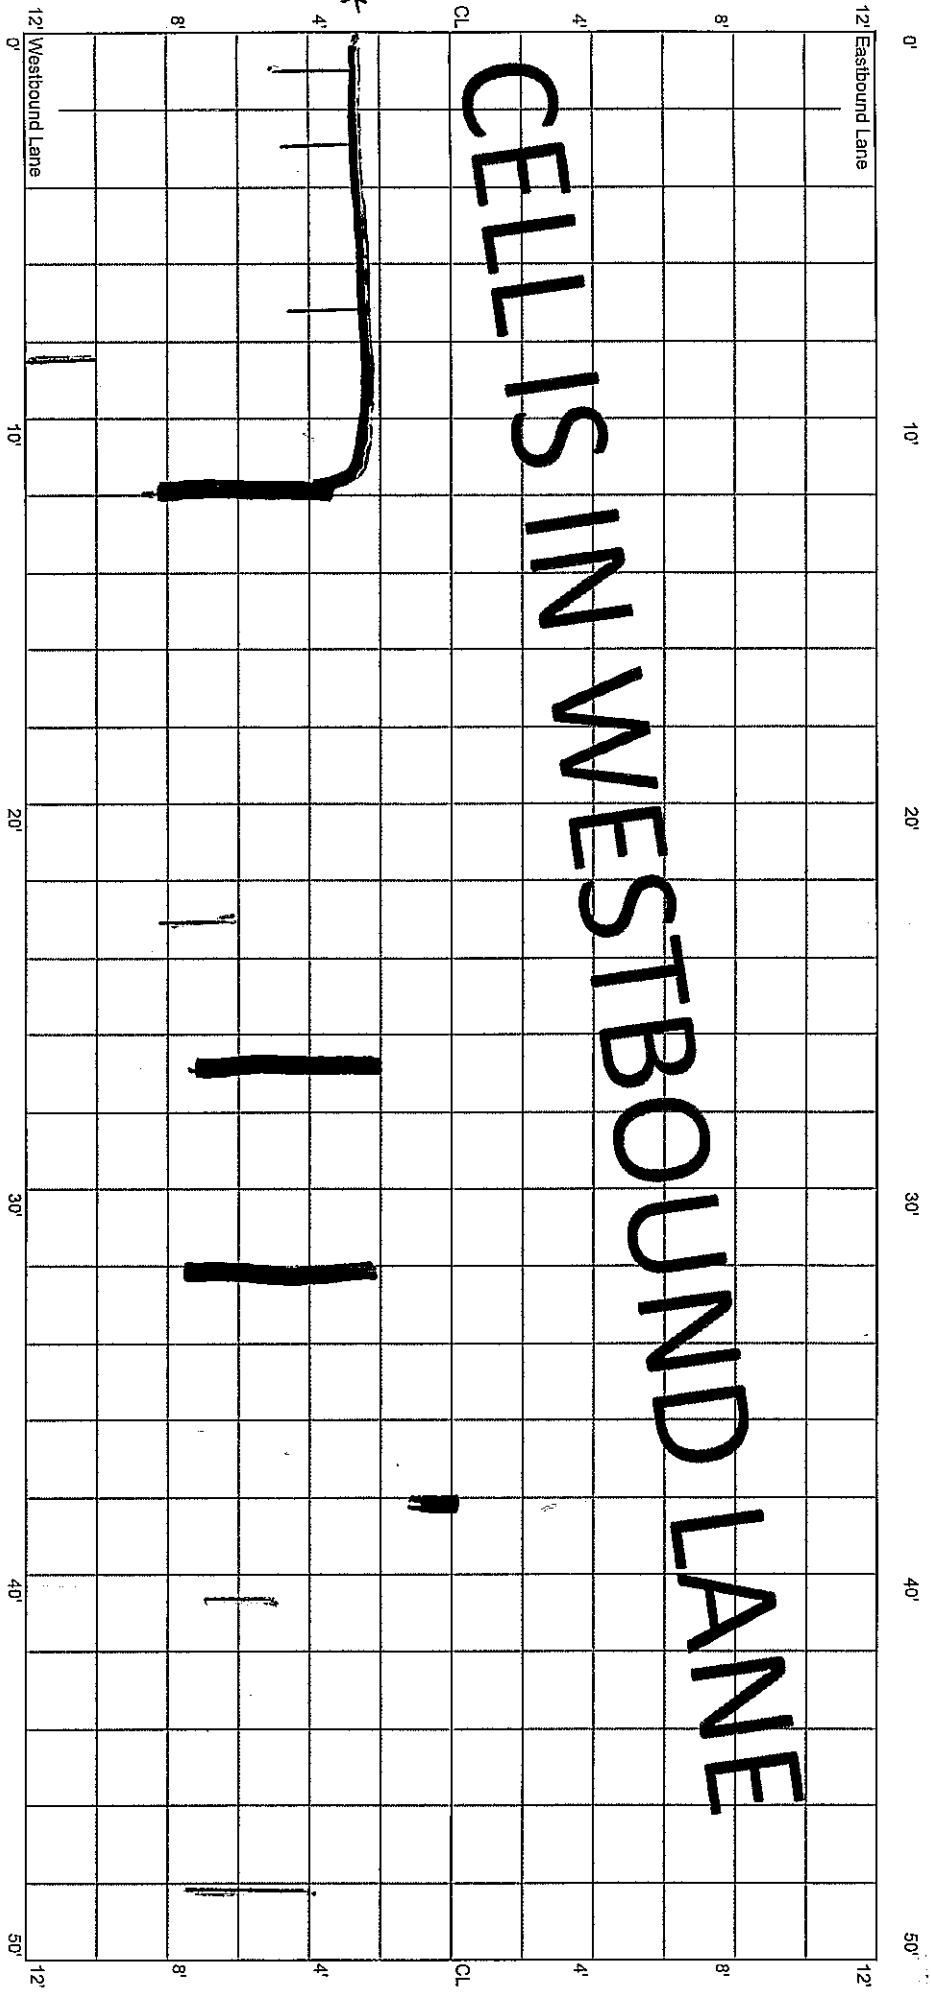


*

*

*

*


CELL 7001W
150 - 200 ft

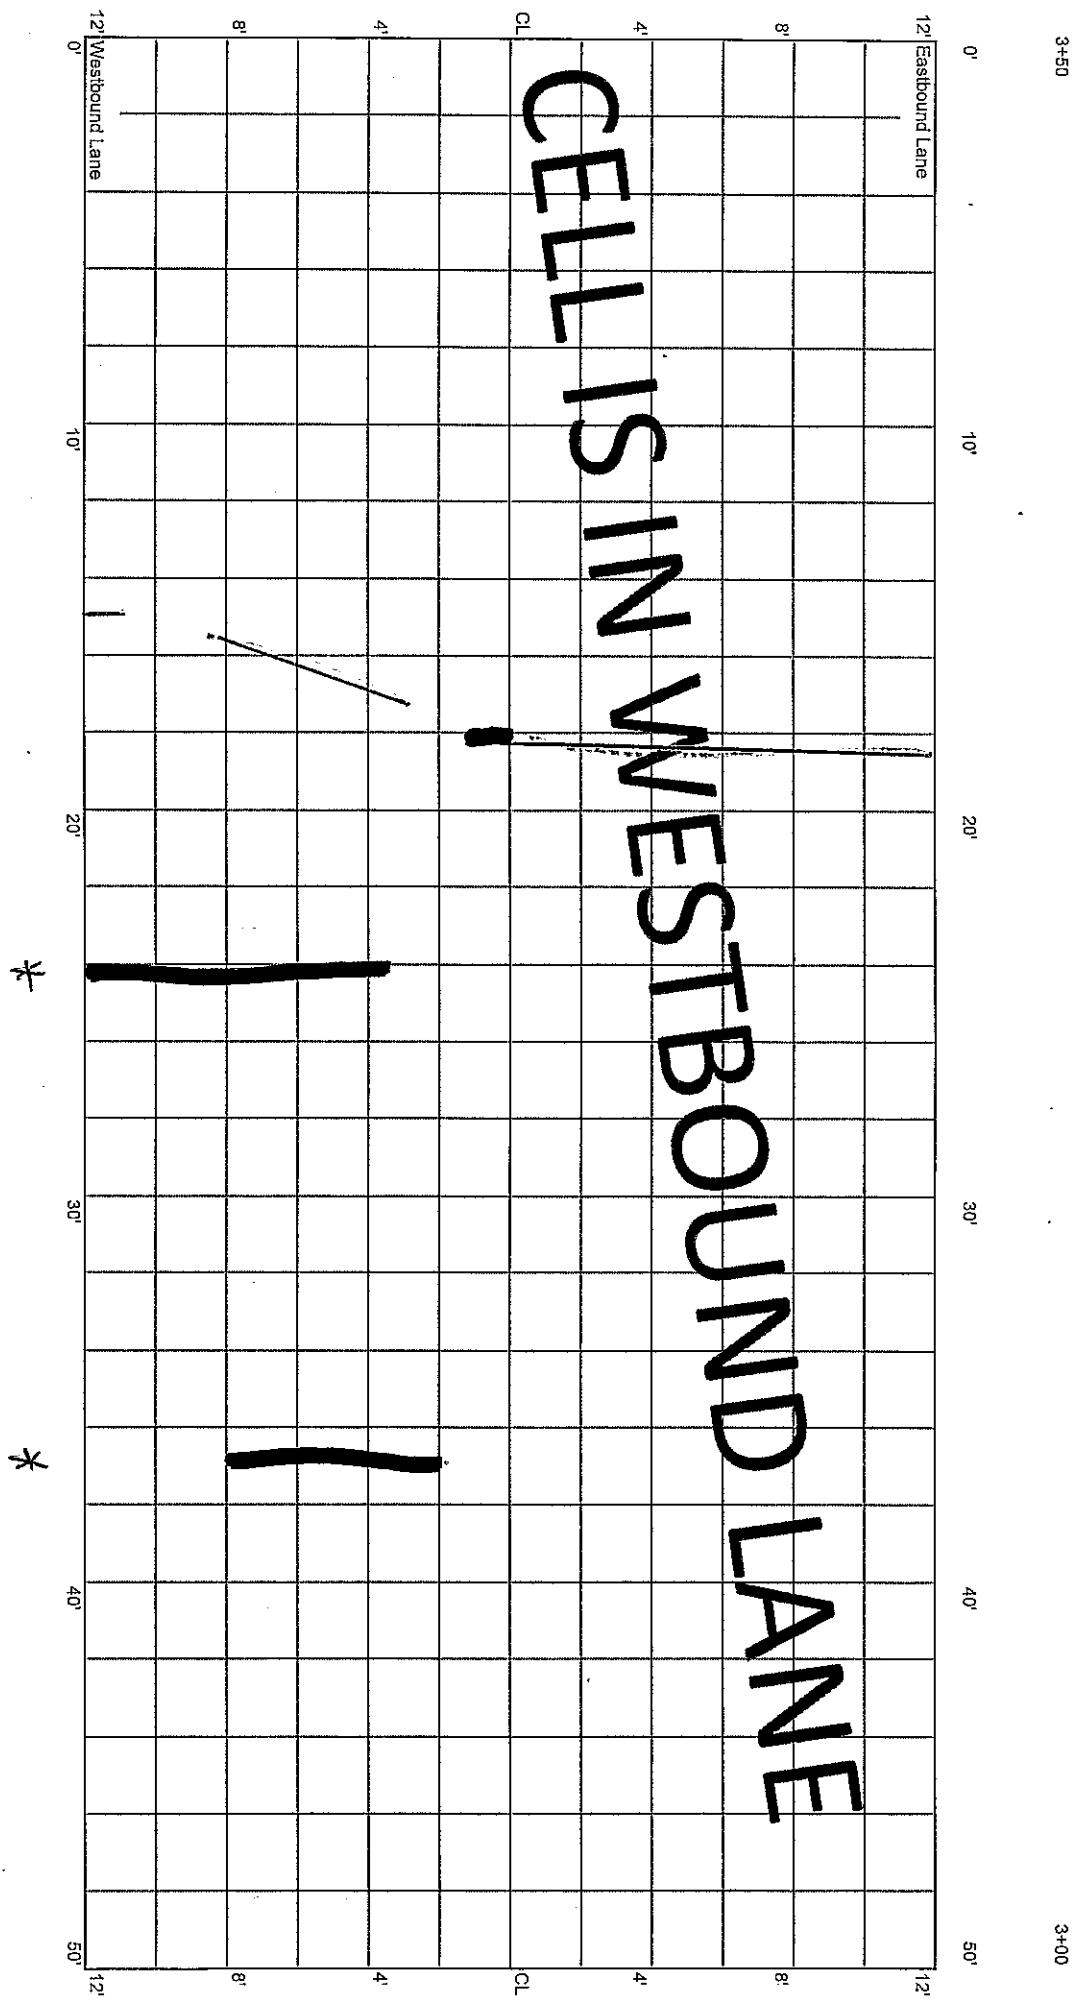

CELL 7001W
200 - 250 ft

3+00

2+50

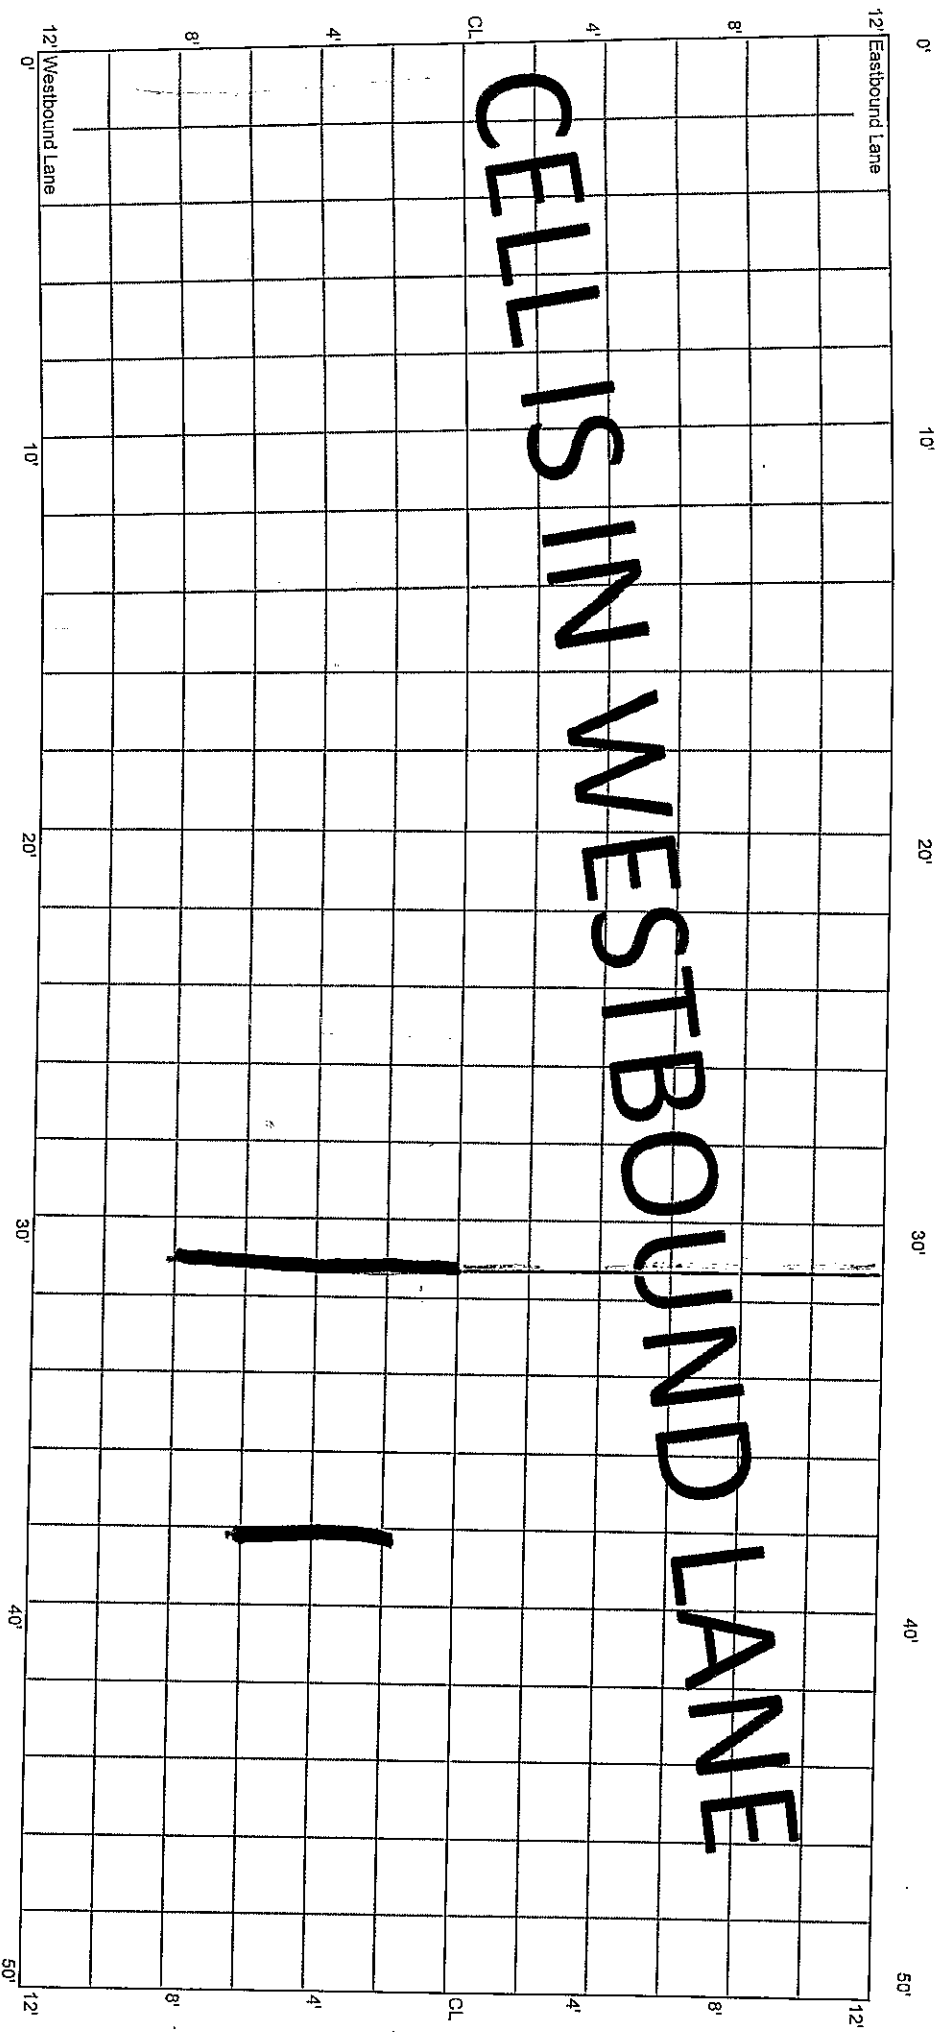


* * *

CELL 7001W
250 - 300 ft

2+50


2+00

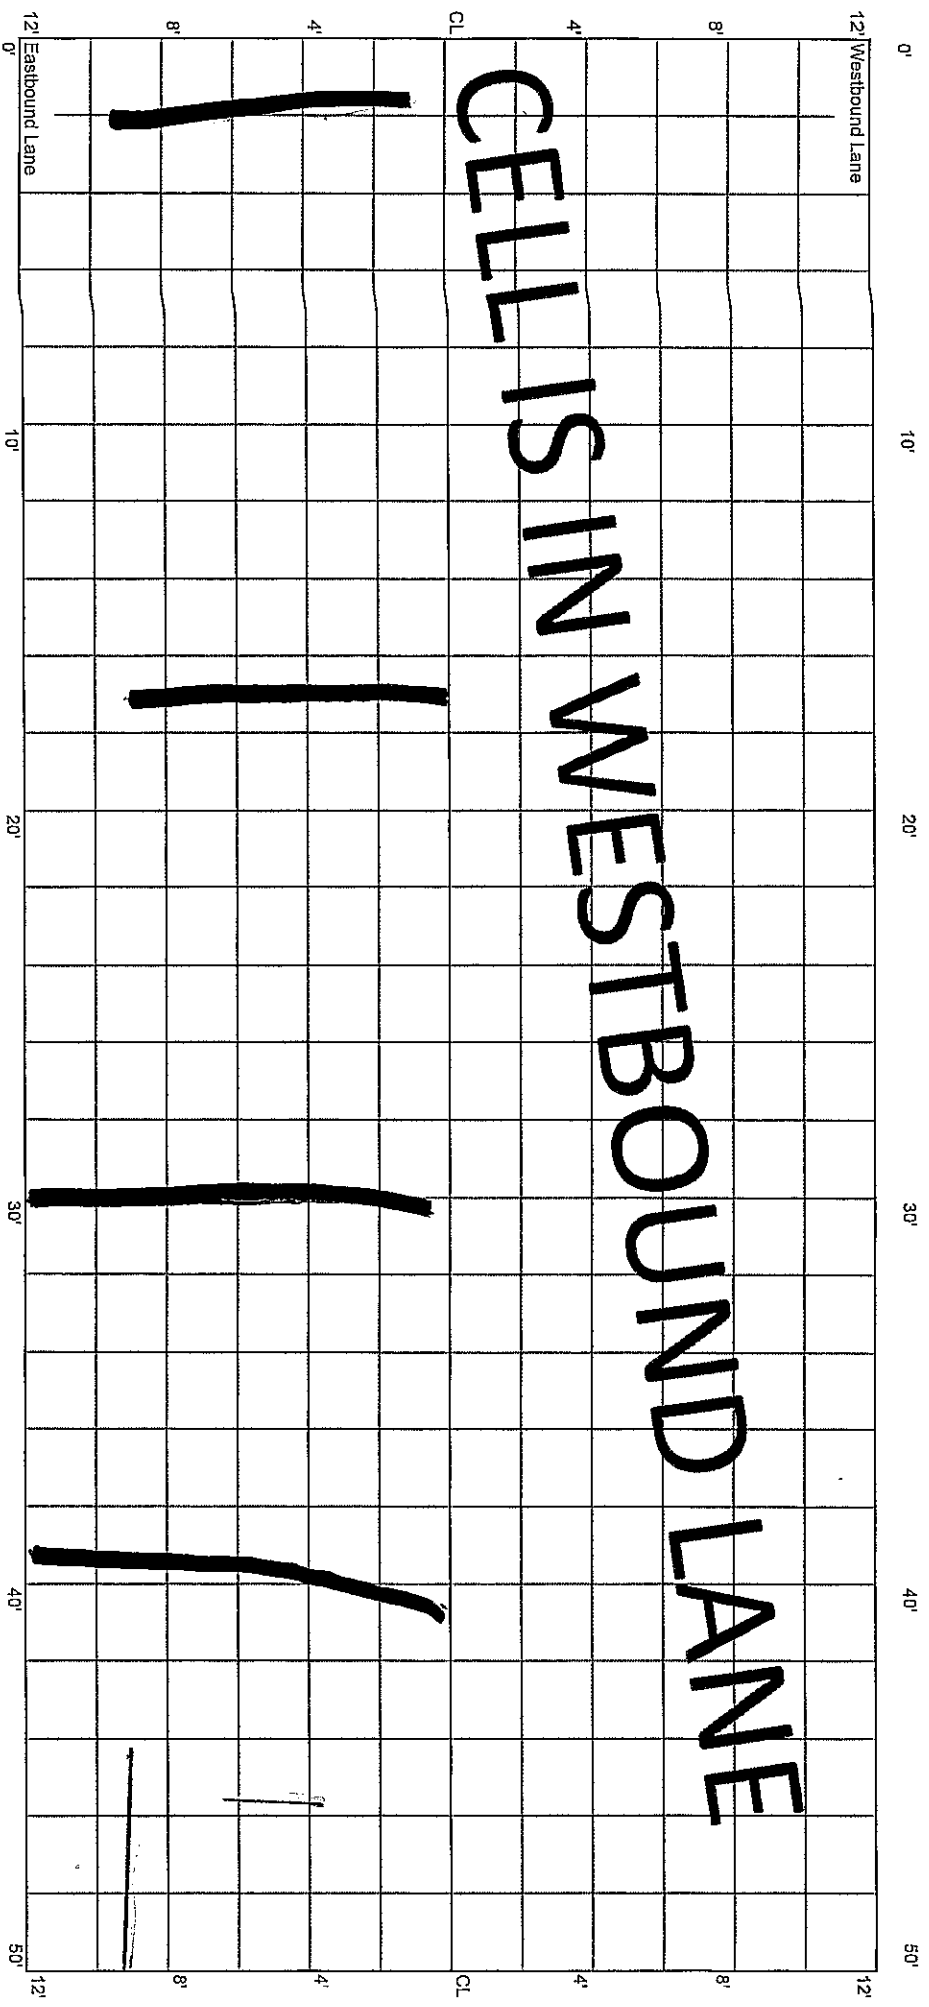


CELL 7001W
300 - 350 ft

2+00

1+50

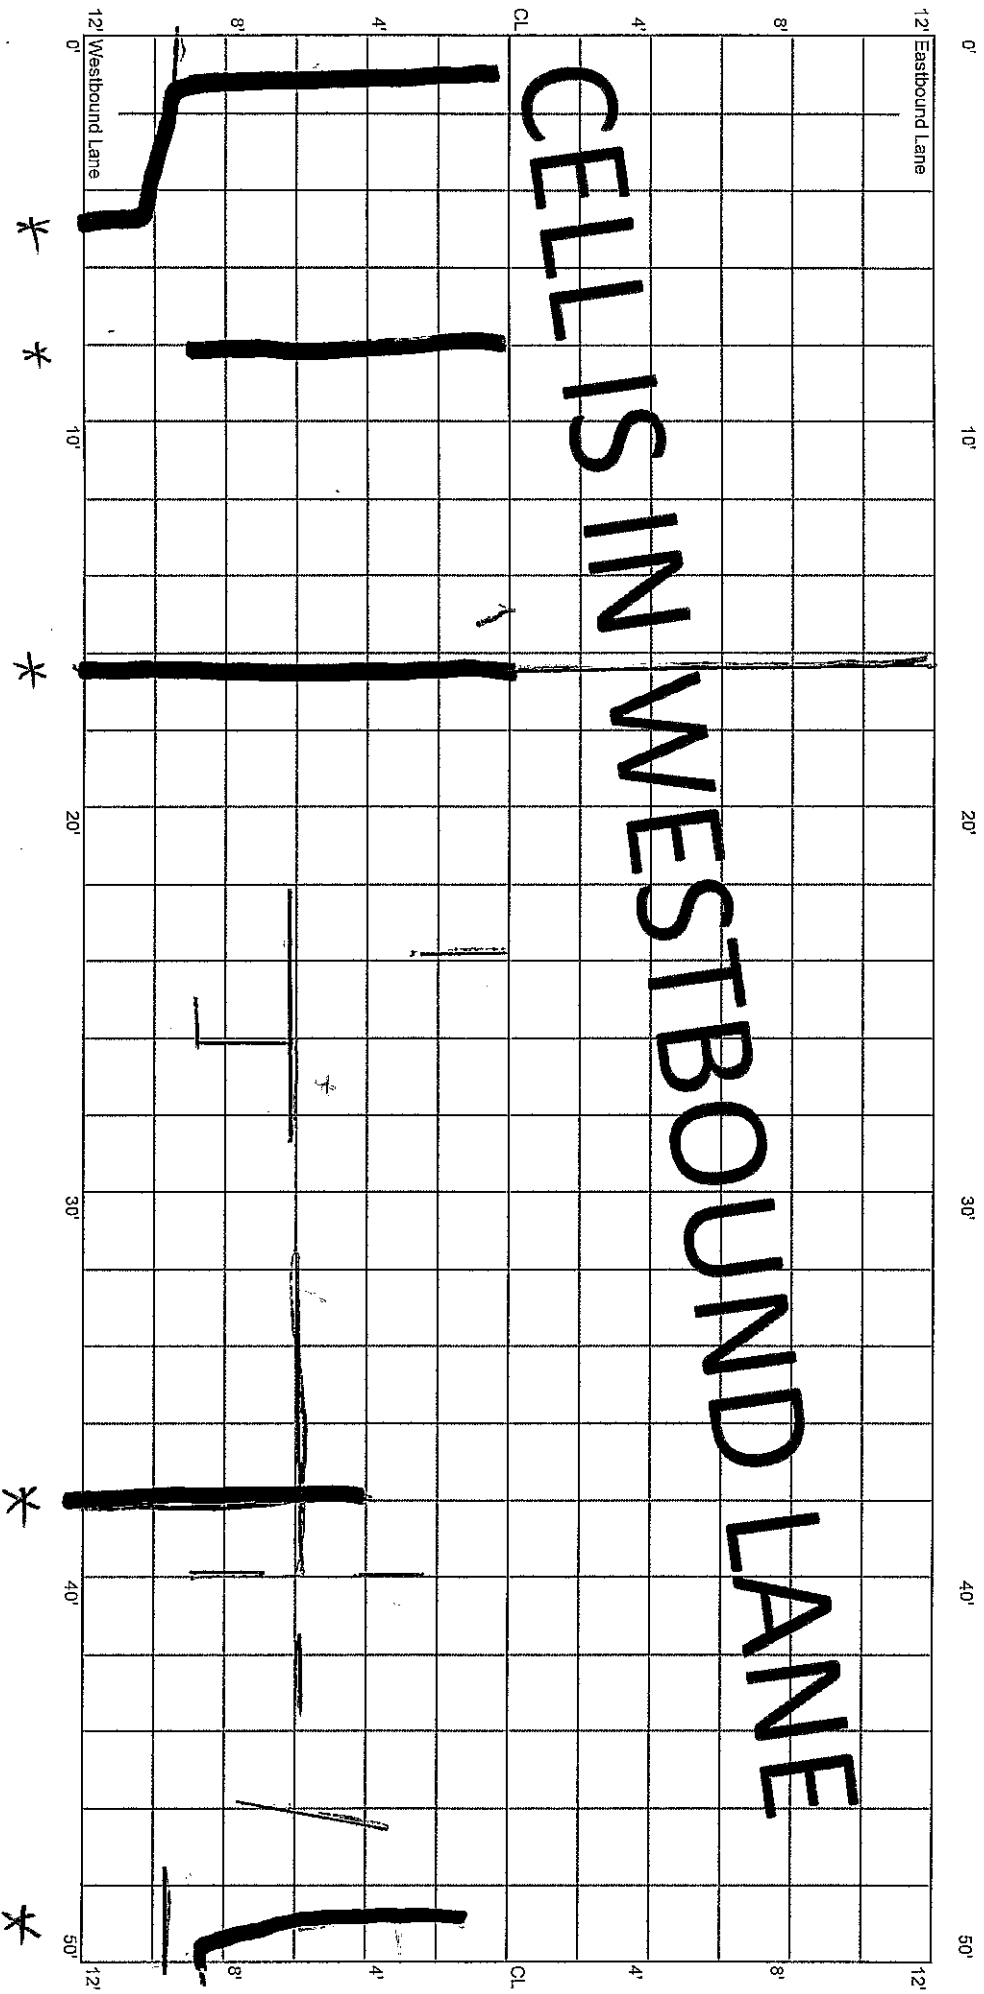


CELL 7001W
350 - 400 ft

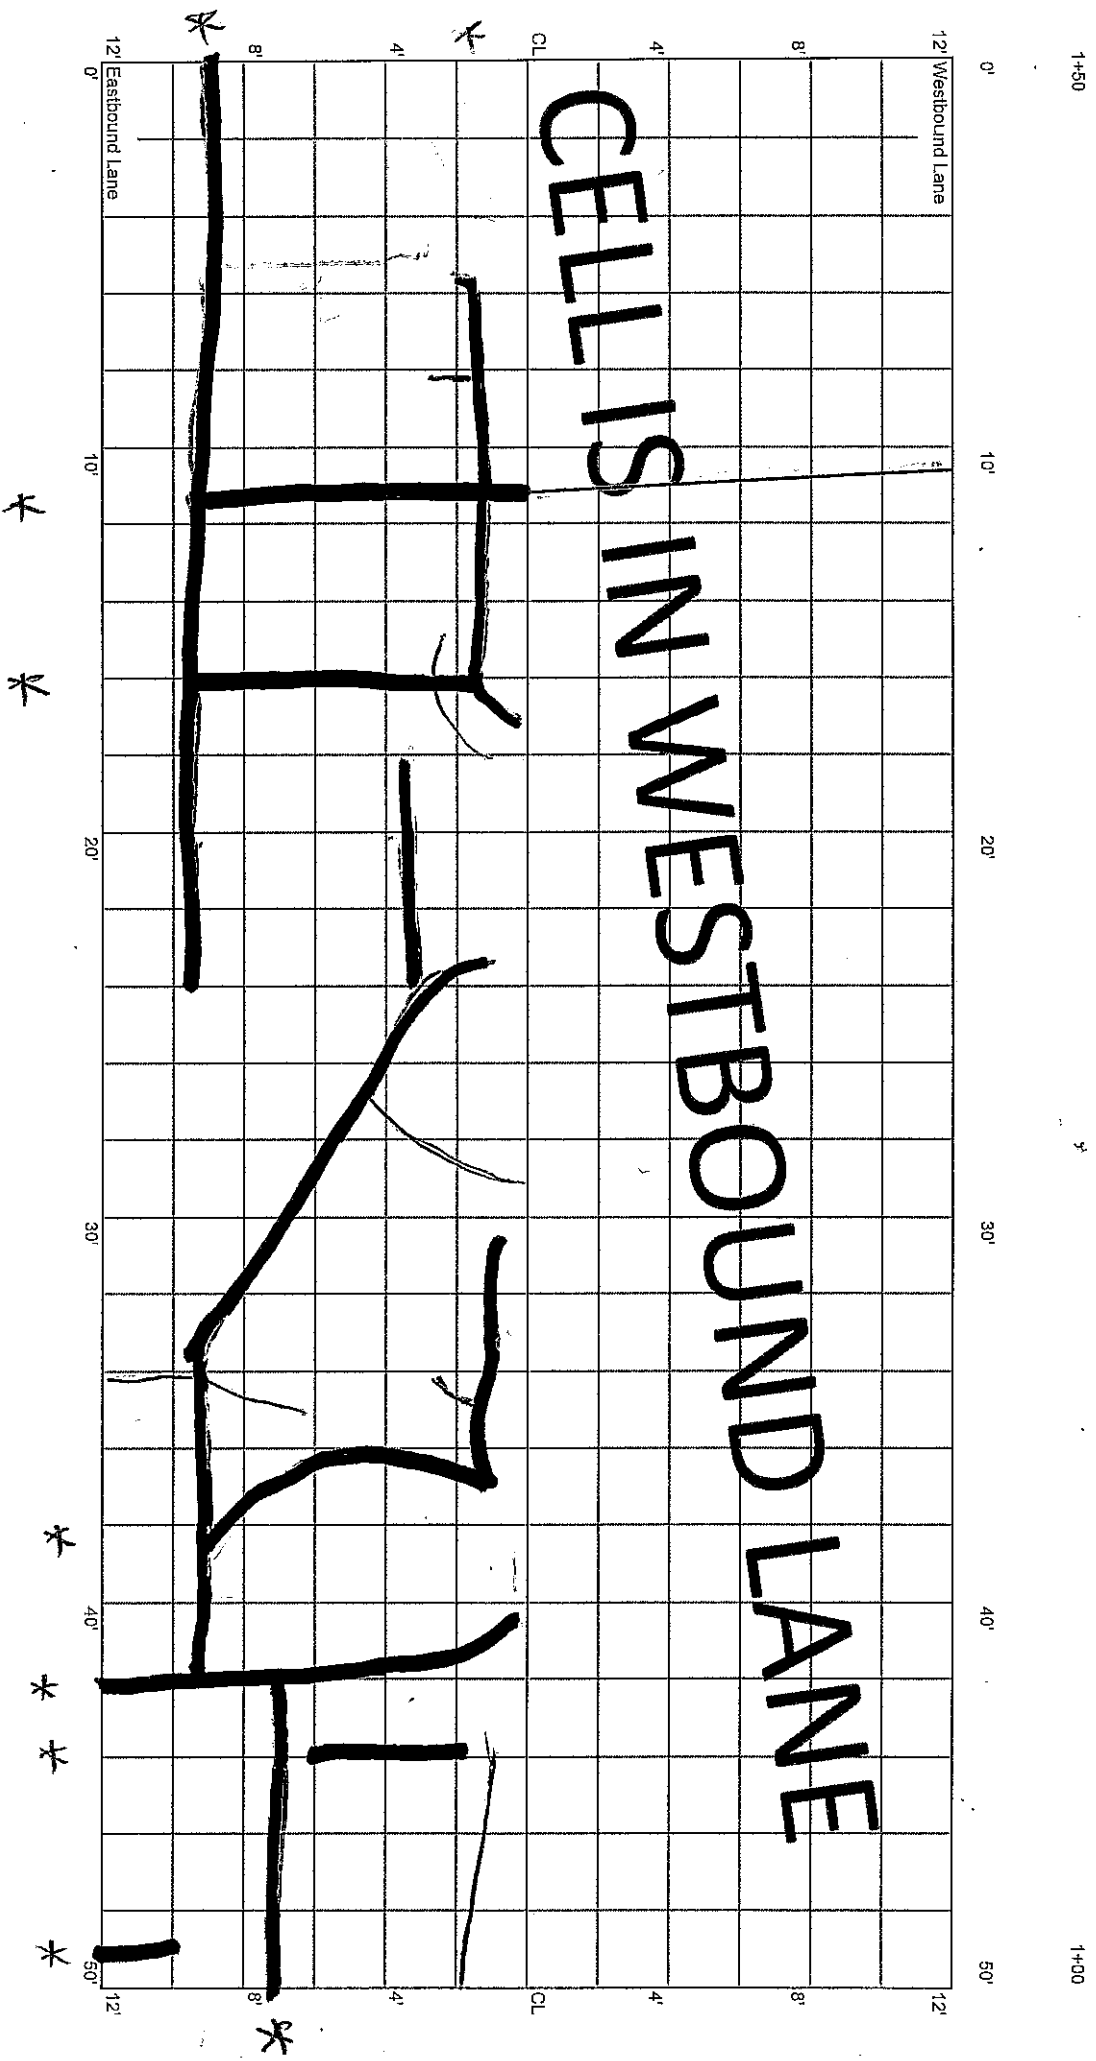

CELL 7001W
400 - 450 ft

1+00

0+50

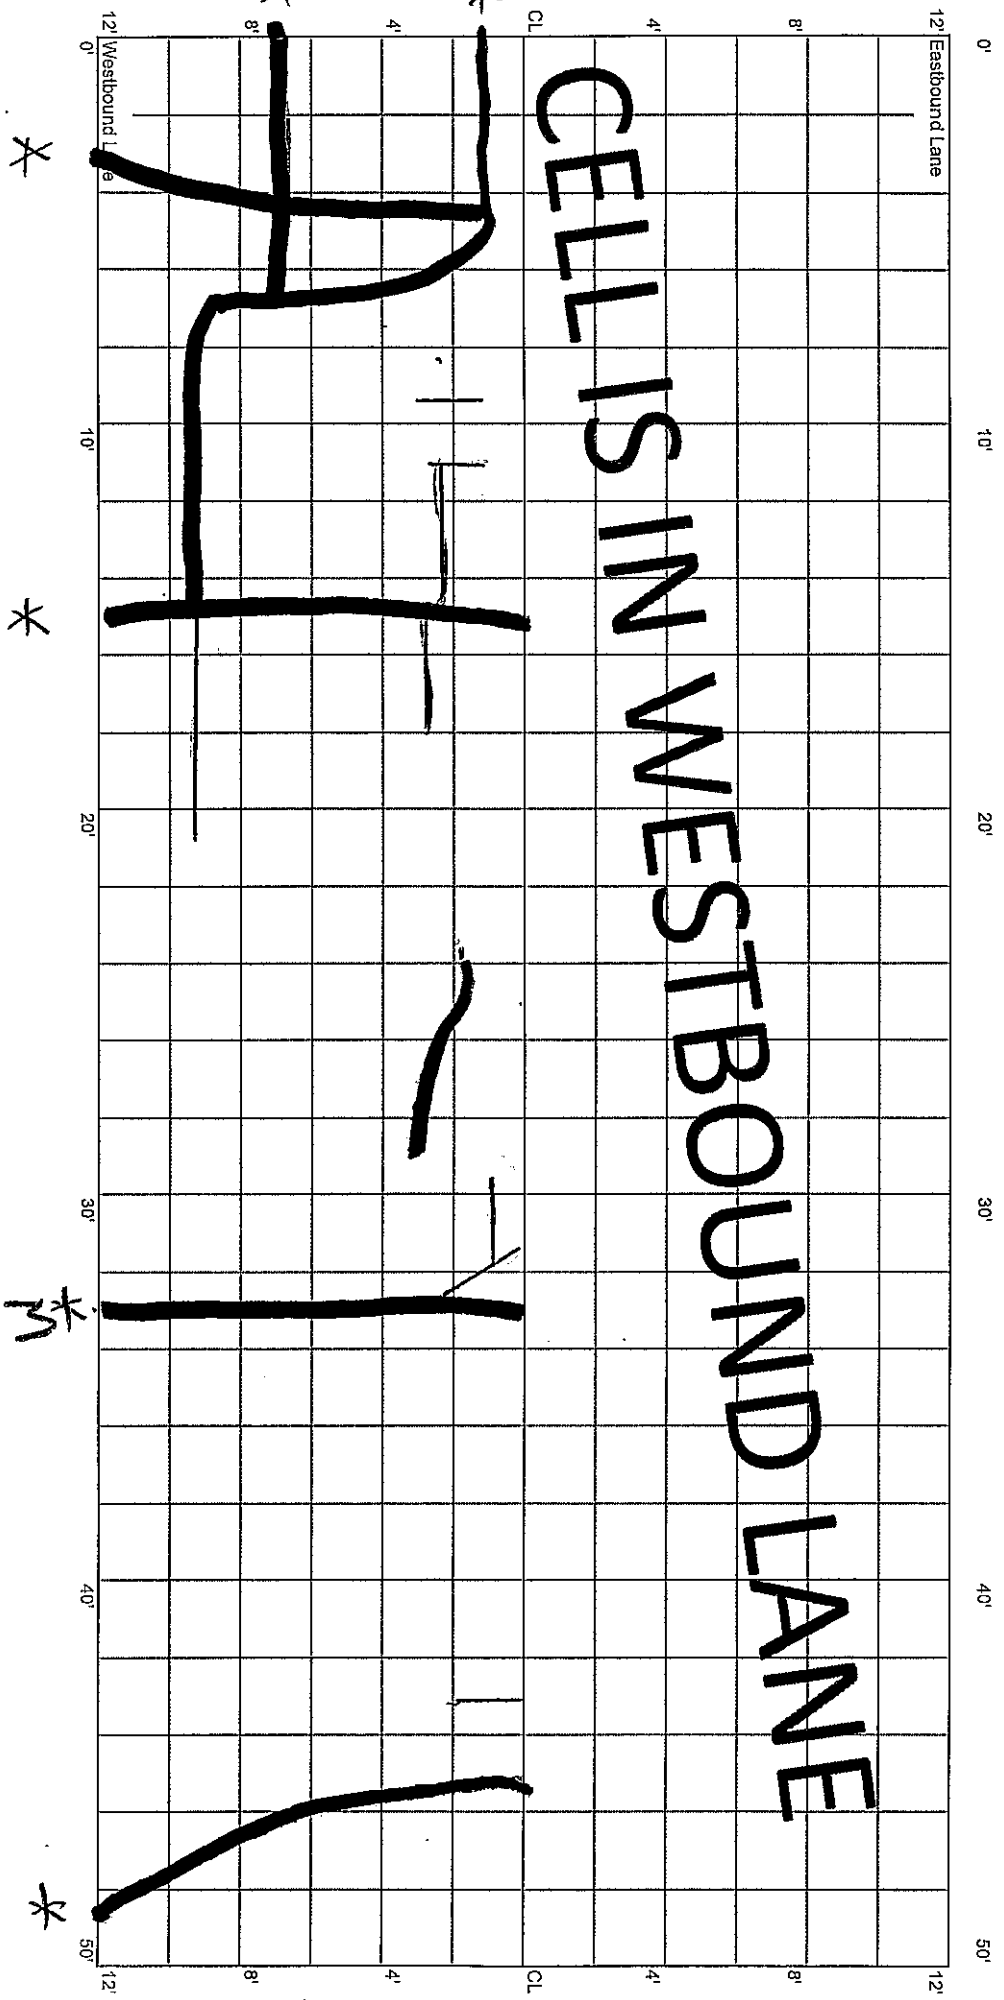

0'

10'

20'

30'

40'

50'

0'

10'

20'

30'

40'

50'

12' Eastbound Lane

12' Westbound Lane

CELLS IN WESTBOUND LANE

CL

CL

*

*

*


*

CELL 7001W
450 - 500 ft

End CL Kadler

0+50

0+00

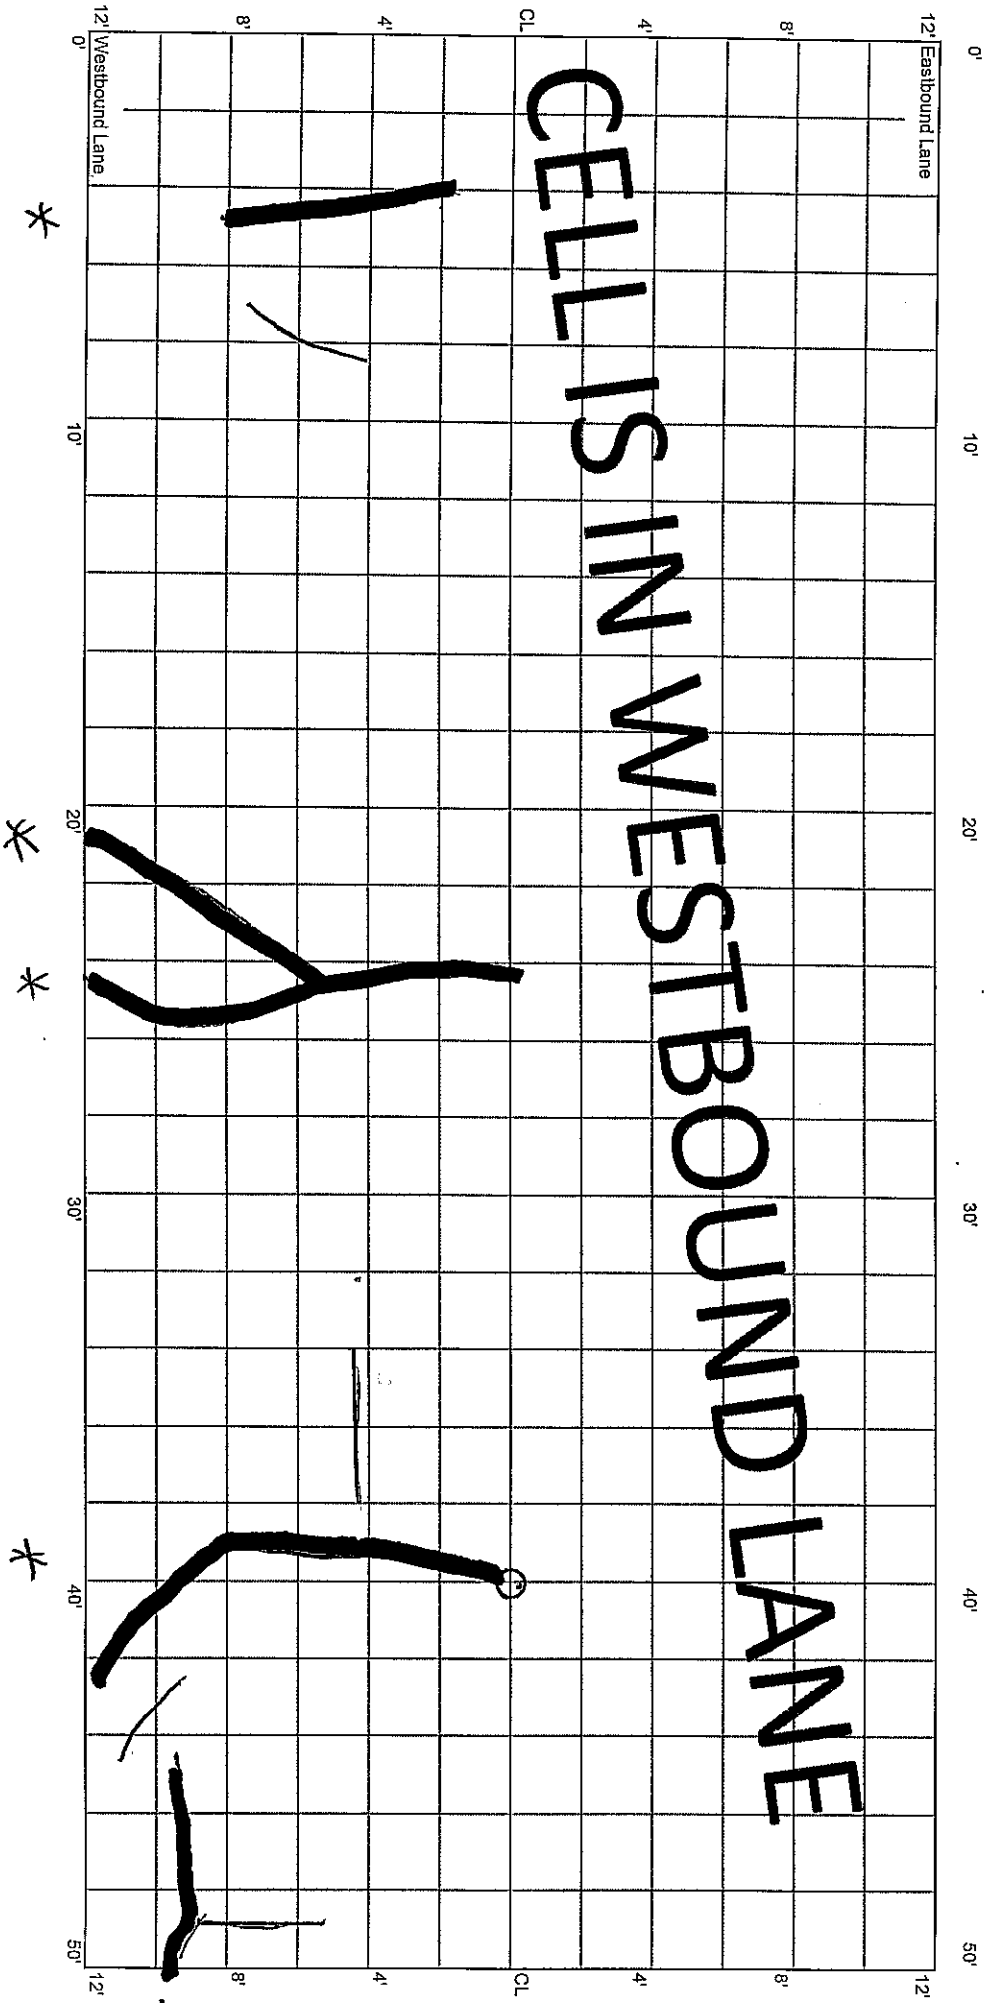

End CL Kadler

CELL 7001W
500 - 550 ft

0+00

-0+23

0'

-10'

-20'

-23'

12' Eastbound Lane

12'

8'

8'

4'

4'

CL

CL

CELL IS IN WESTBOUND LANE

4'

4'

8'

8'

END RATING: CL KADLER

12' Westbound Lane

12'

0'

-10'

-20'

-23'