

5:28:20 E.T.
10.14.25
1.4.21


FILE 70TH ST

Begin CL Kadler

0+00

CELL 7001E
0 - 50 ft


0+50

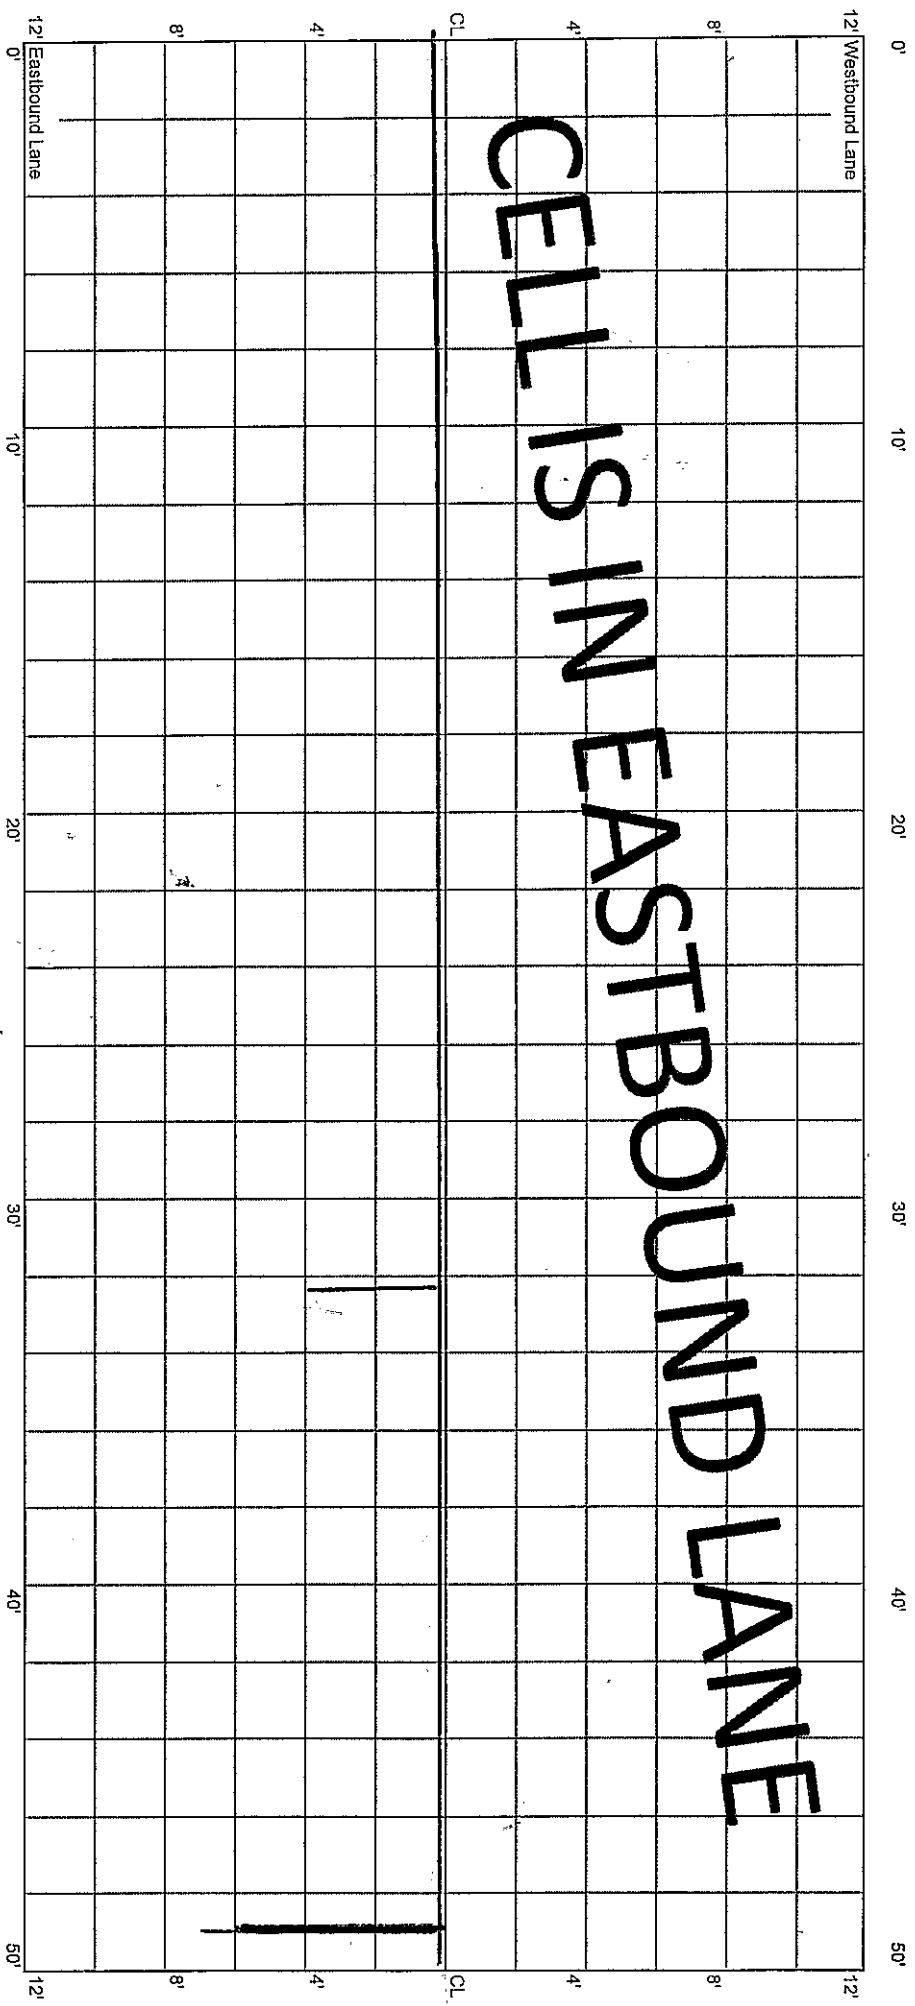

CELLS IN EASTBOUND LANE

* Route 1 Seal


CELL 7001E
50 - 100 ft

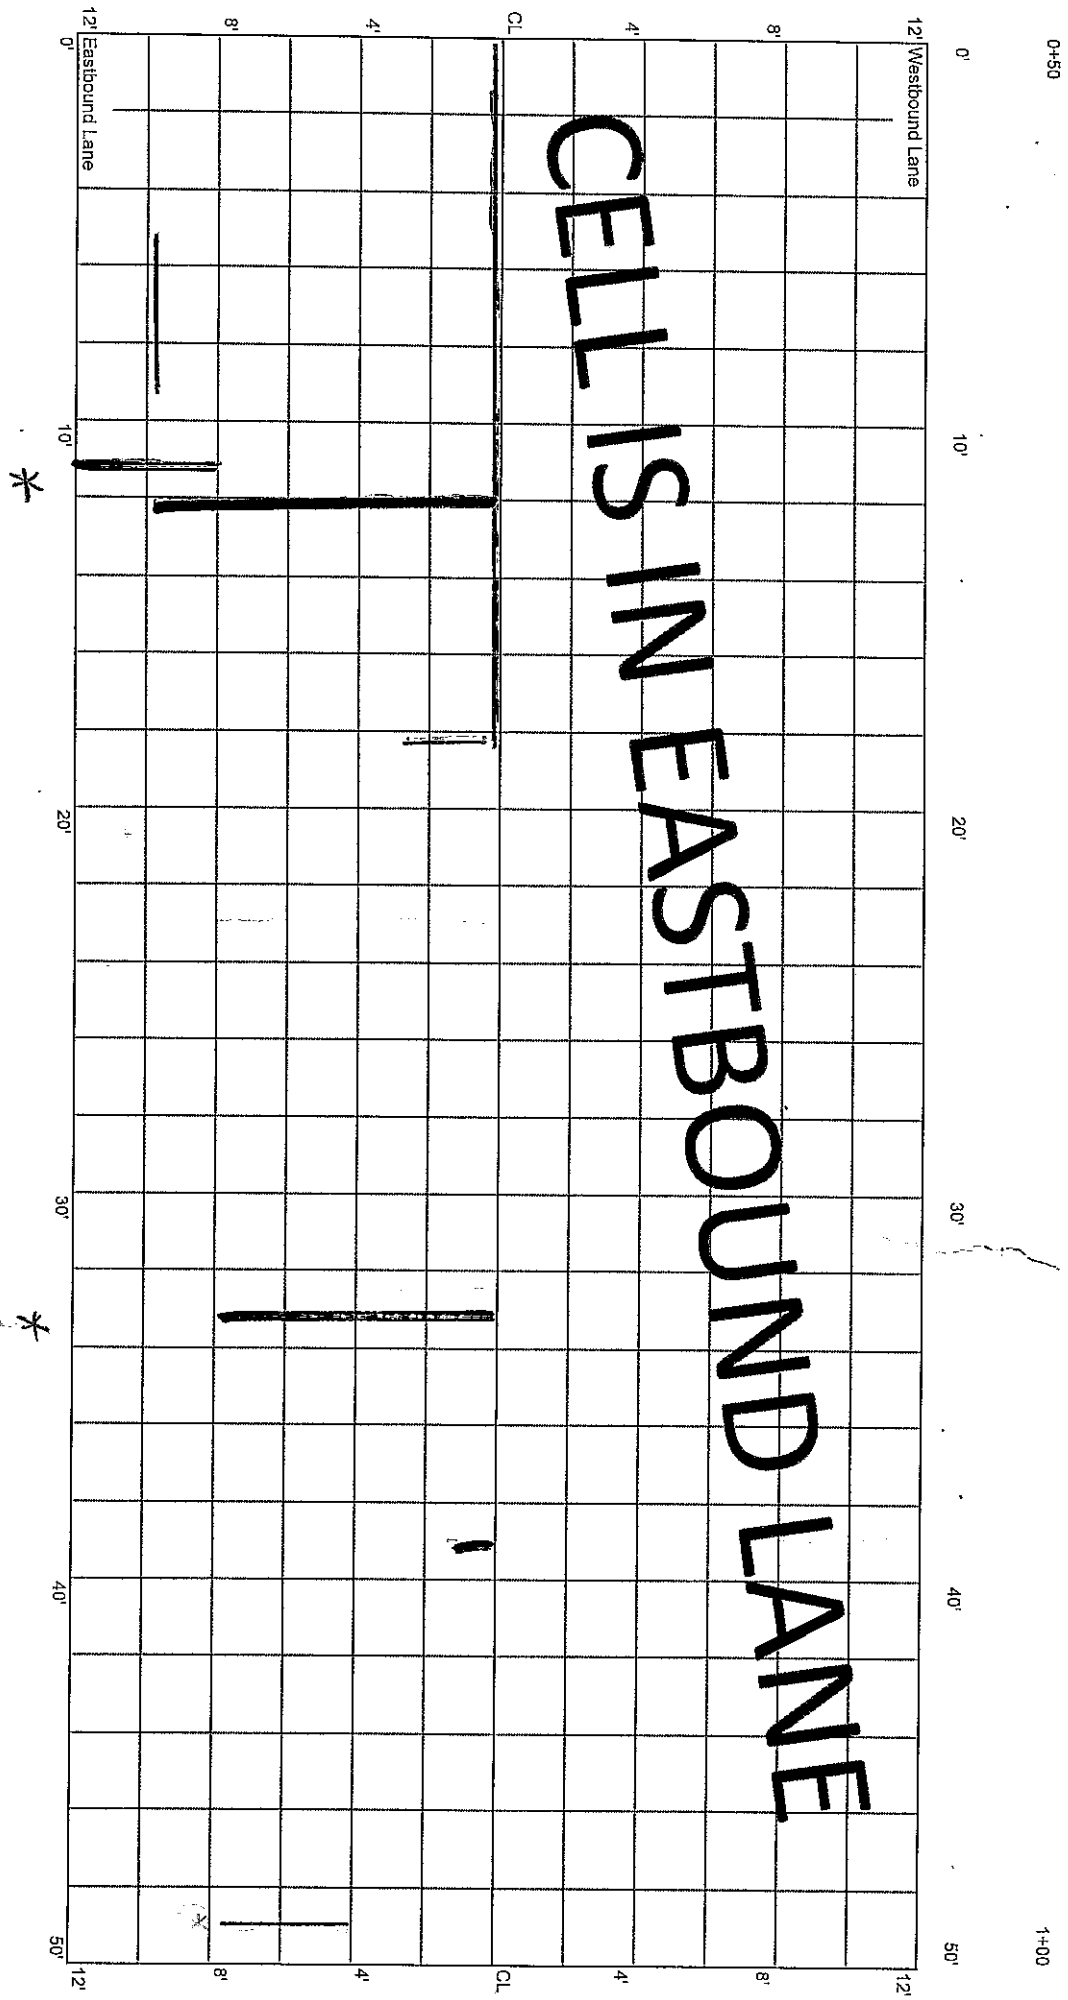

CELL 7001E
100 - 150 ft

1+00


1+50

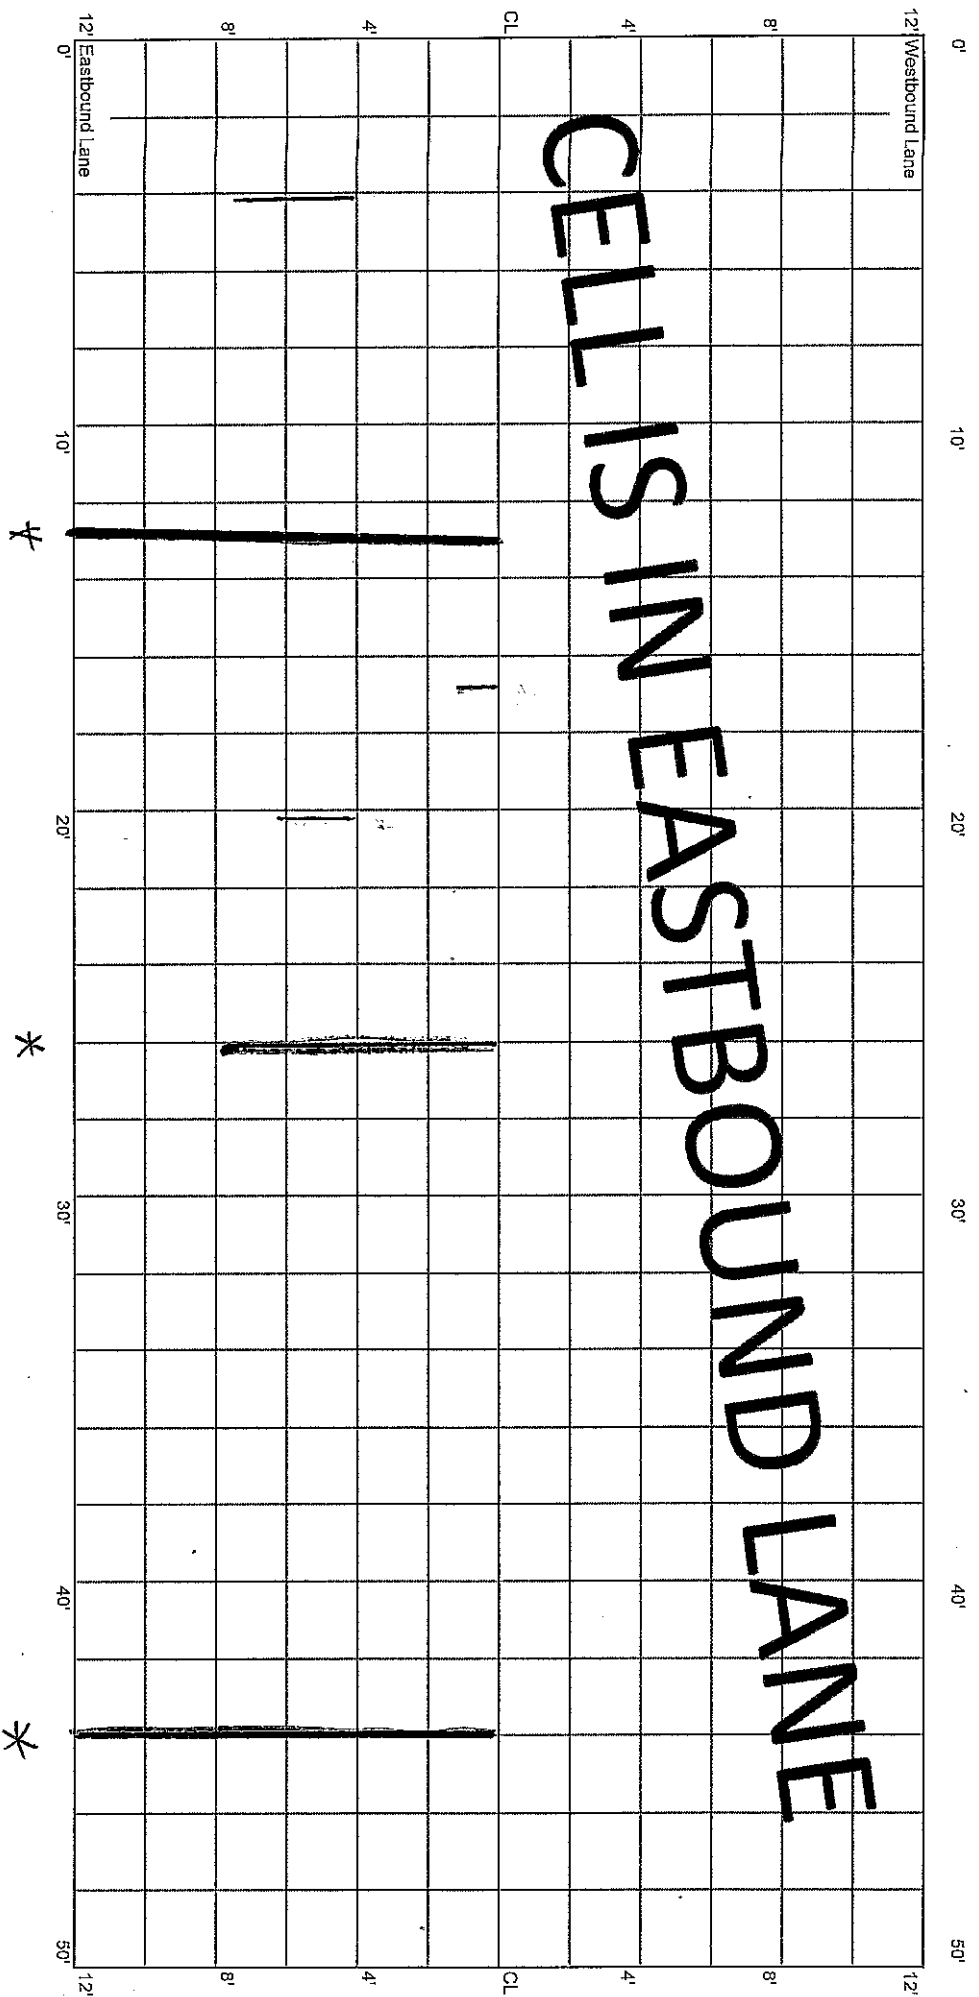

CELL 7001E
150 - 200 ft

1+50

2+00

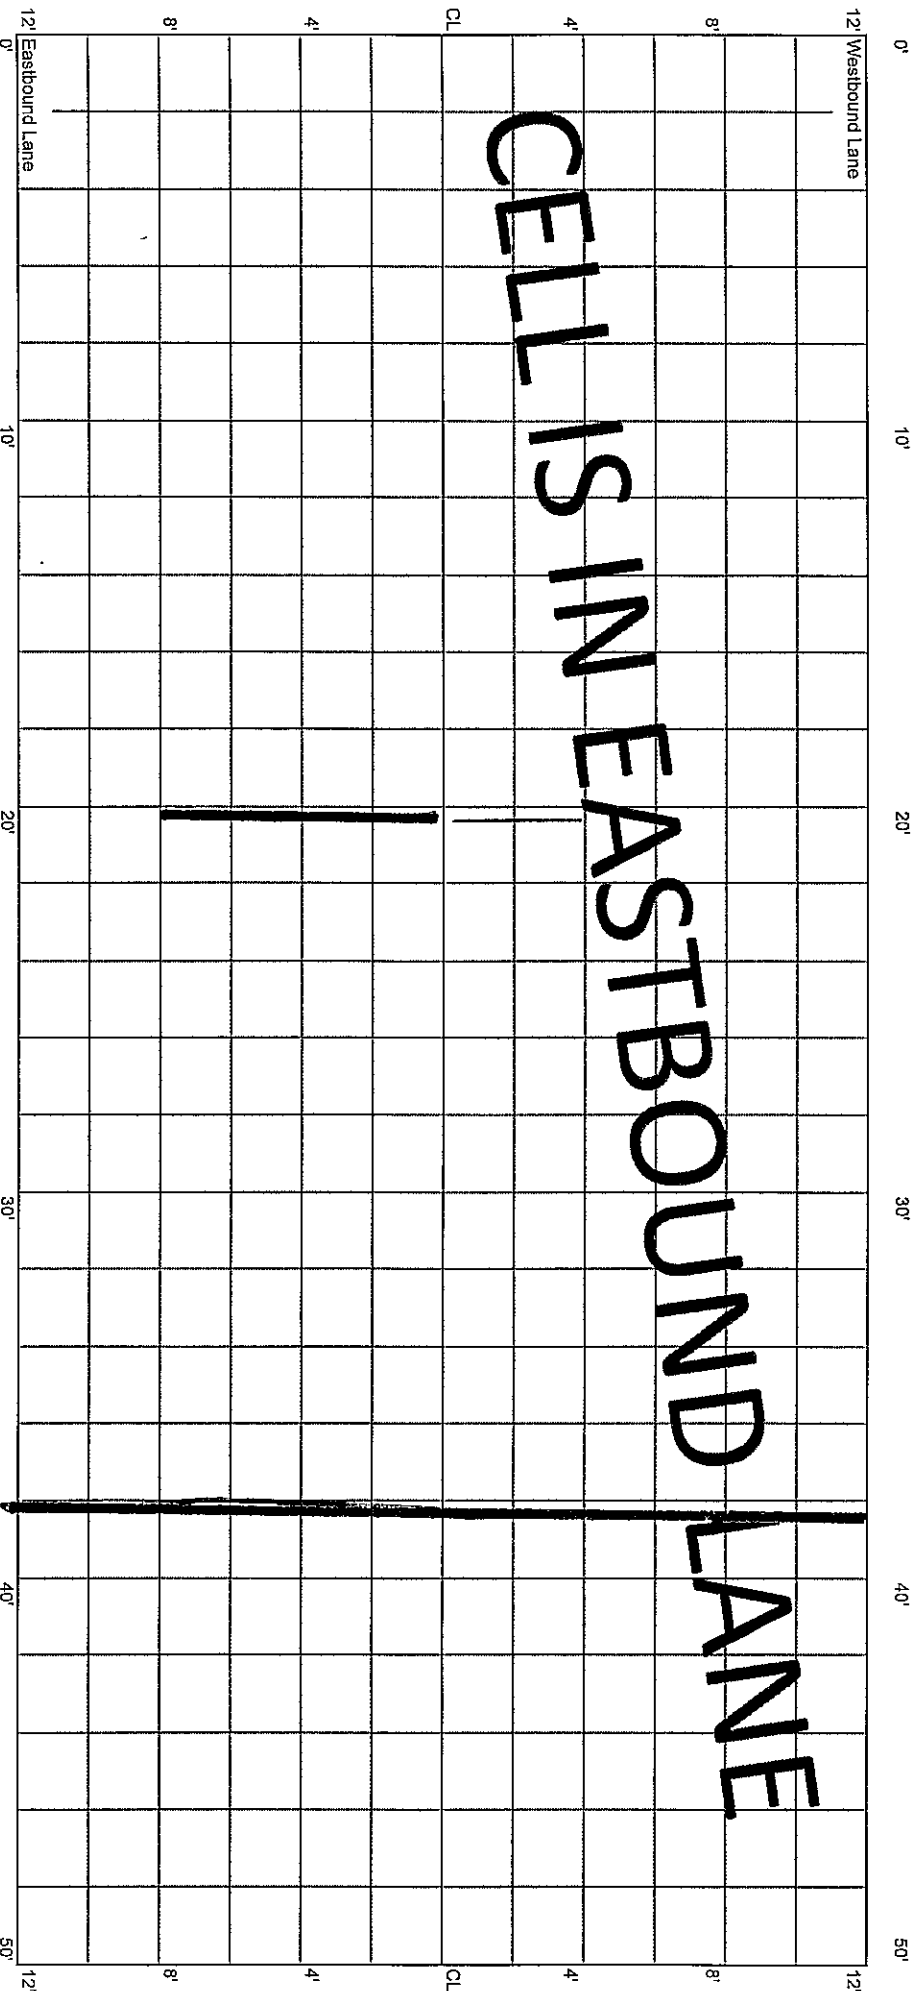

CELL IS IN EASTBOUND LANE

*


8' Seal

*

CELL 7001E
200 - 250 ft

2+00

2+50

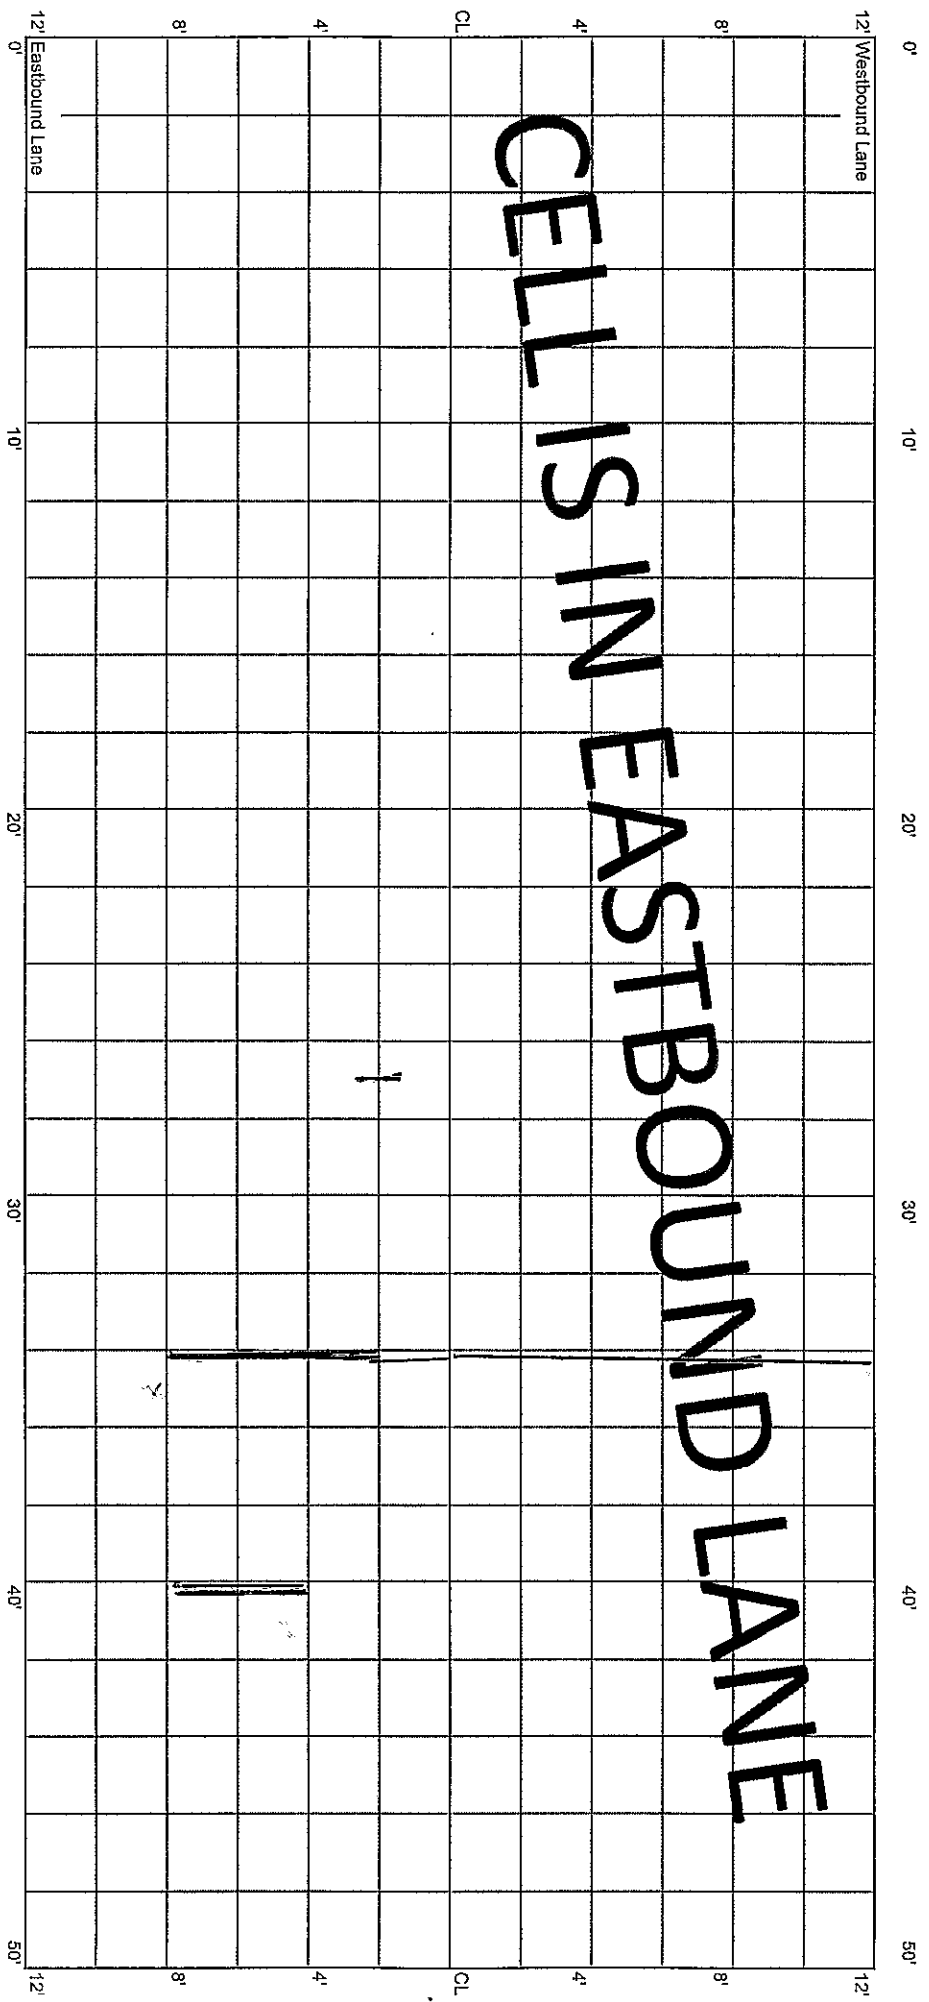


8' Seal

4' Seal

CELL 7001E
250 - 300 ft

2+50

3+00

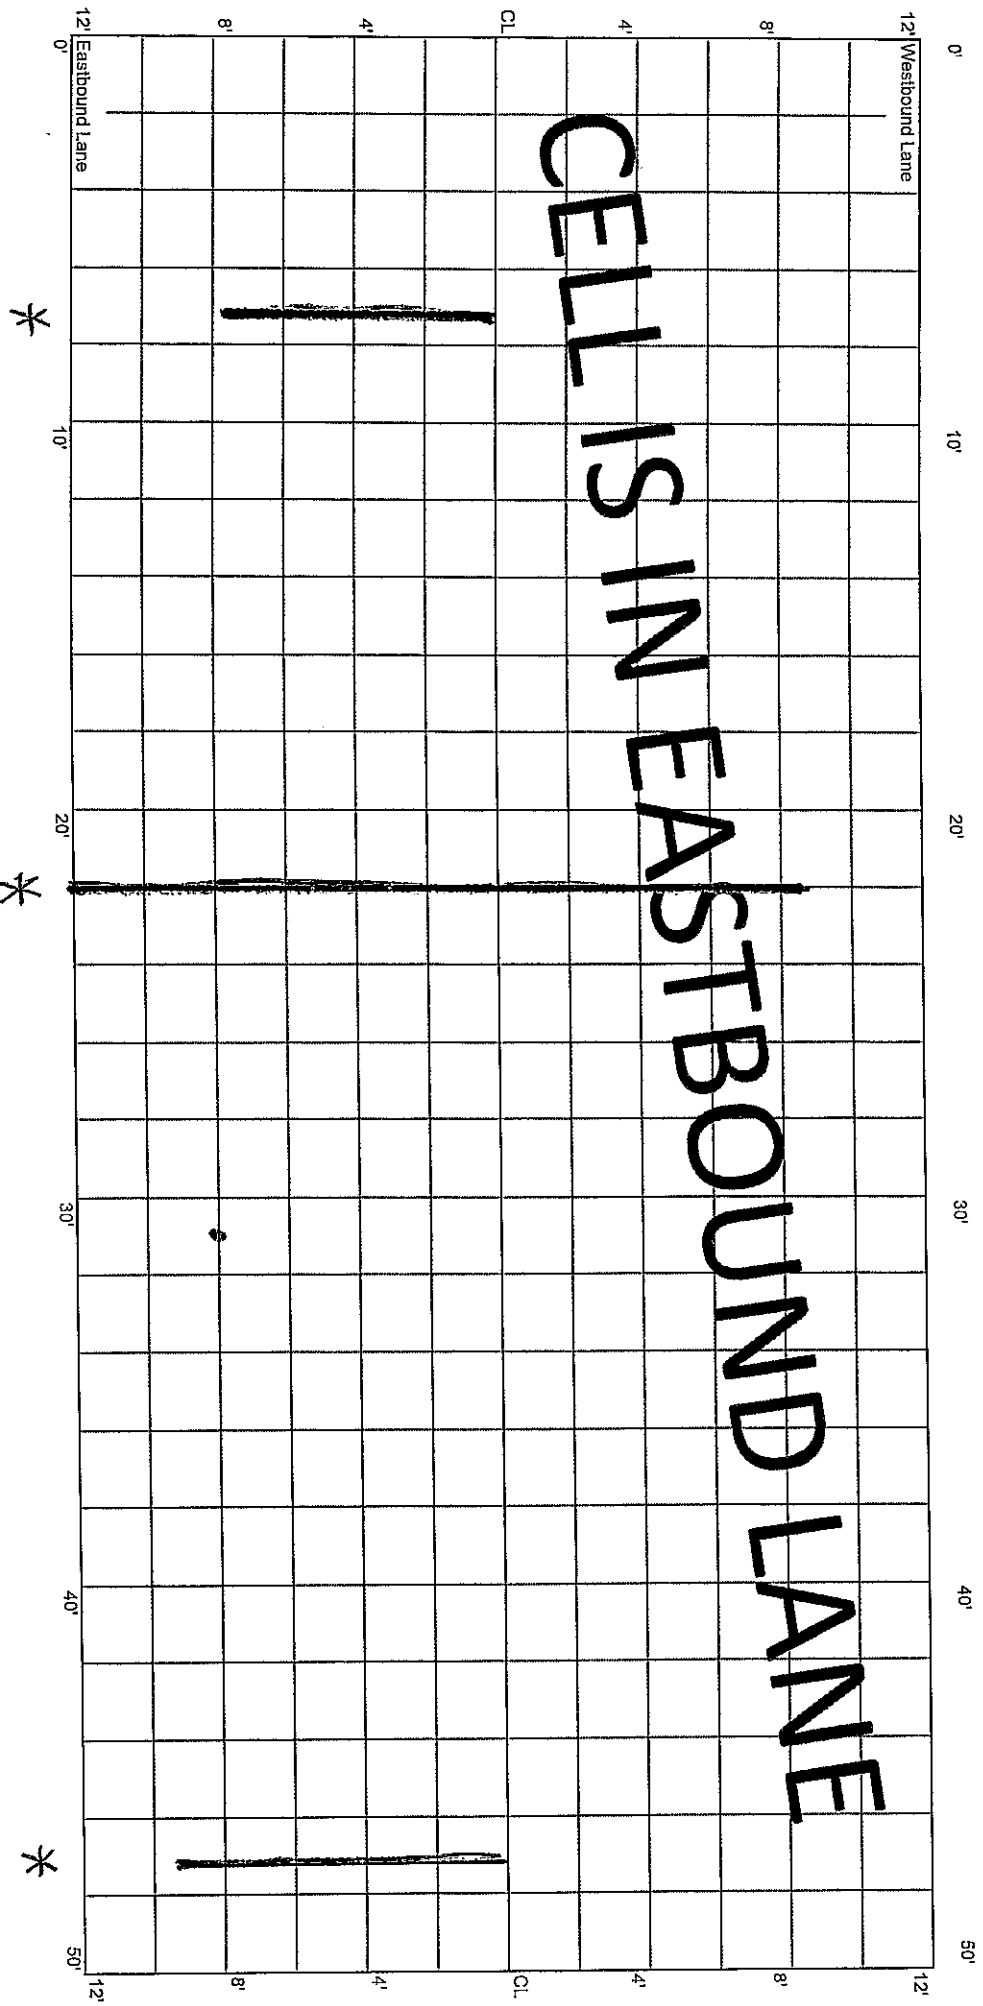

CELLS IN EASTBOUND LANE

*

*


*

pop

CELL 7001E
300 - 350 ft

3+00

3+50

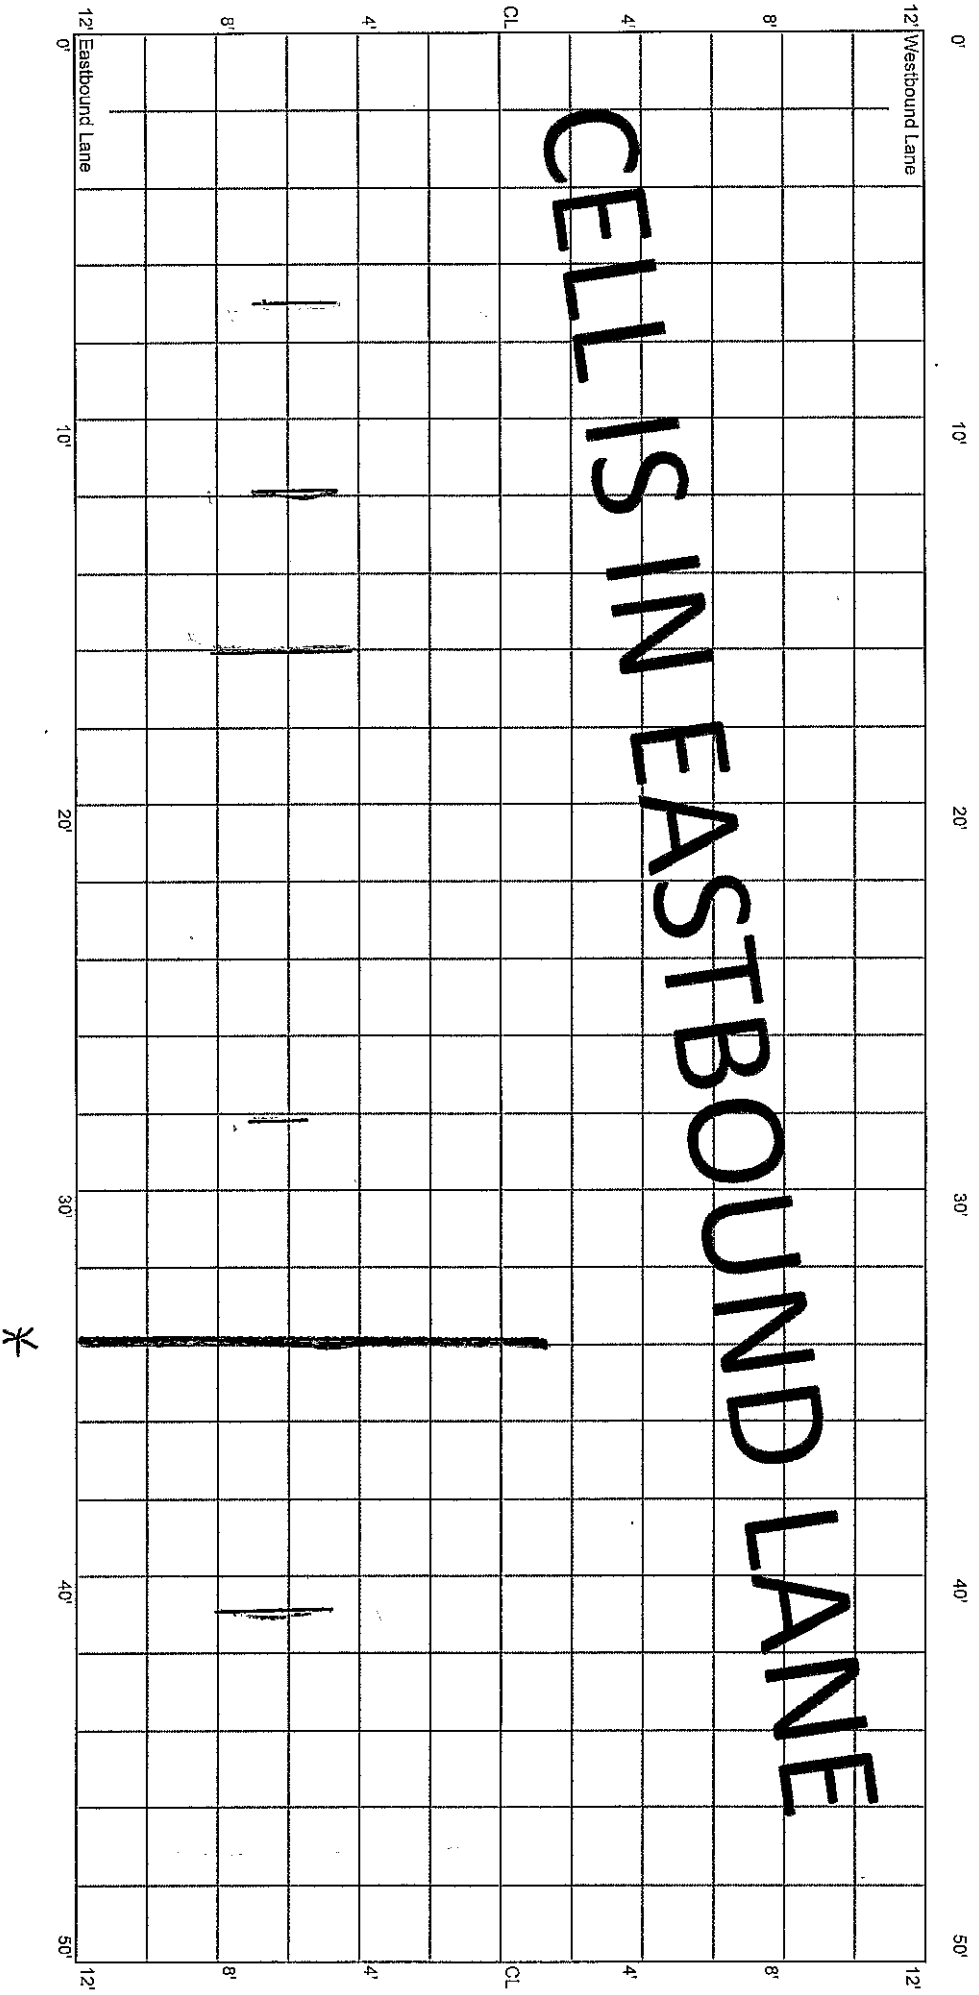


CELL 7001E
350 - 400 ft

3+50

4+00

CELLS IN EASTBOUND LANE

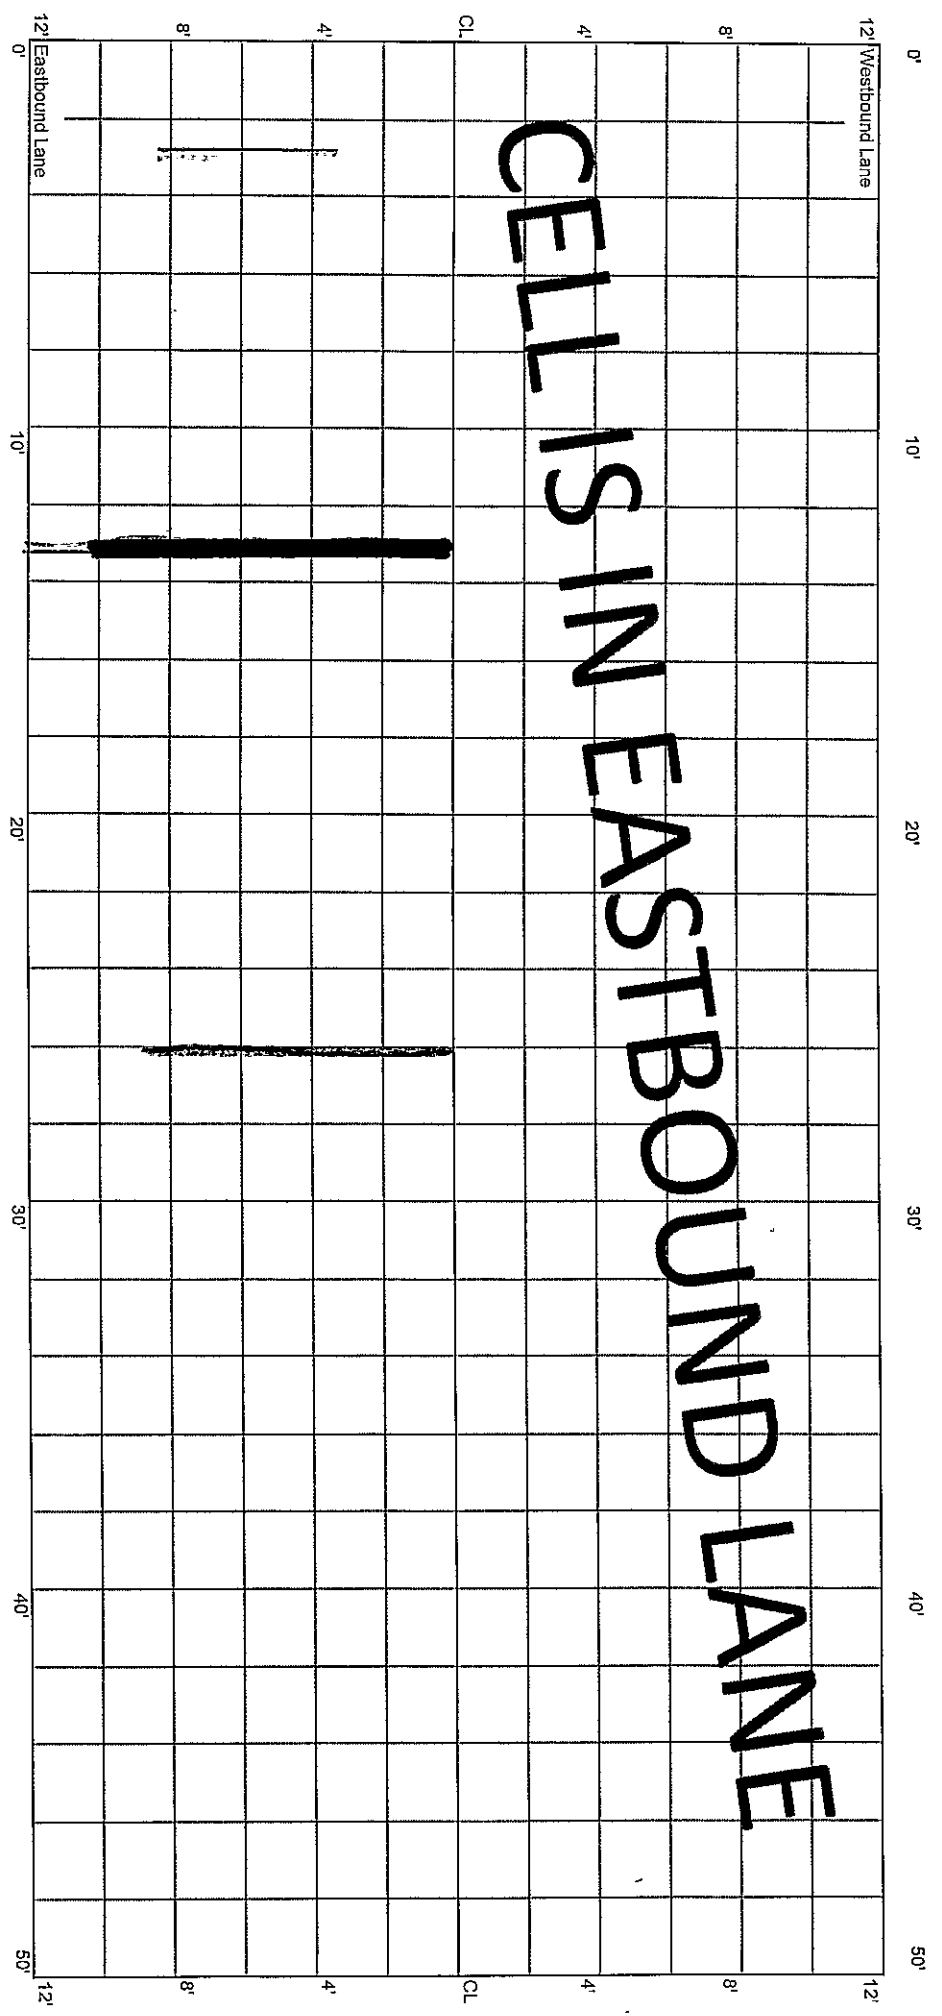


* 10-ft

*

CELL 7001E
400 - 450 ft

4+00

4+50

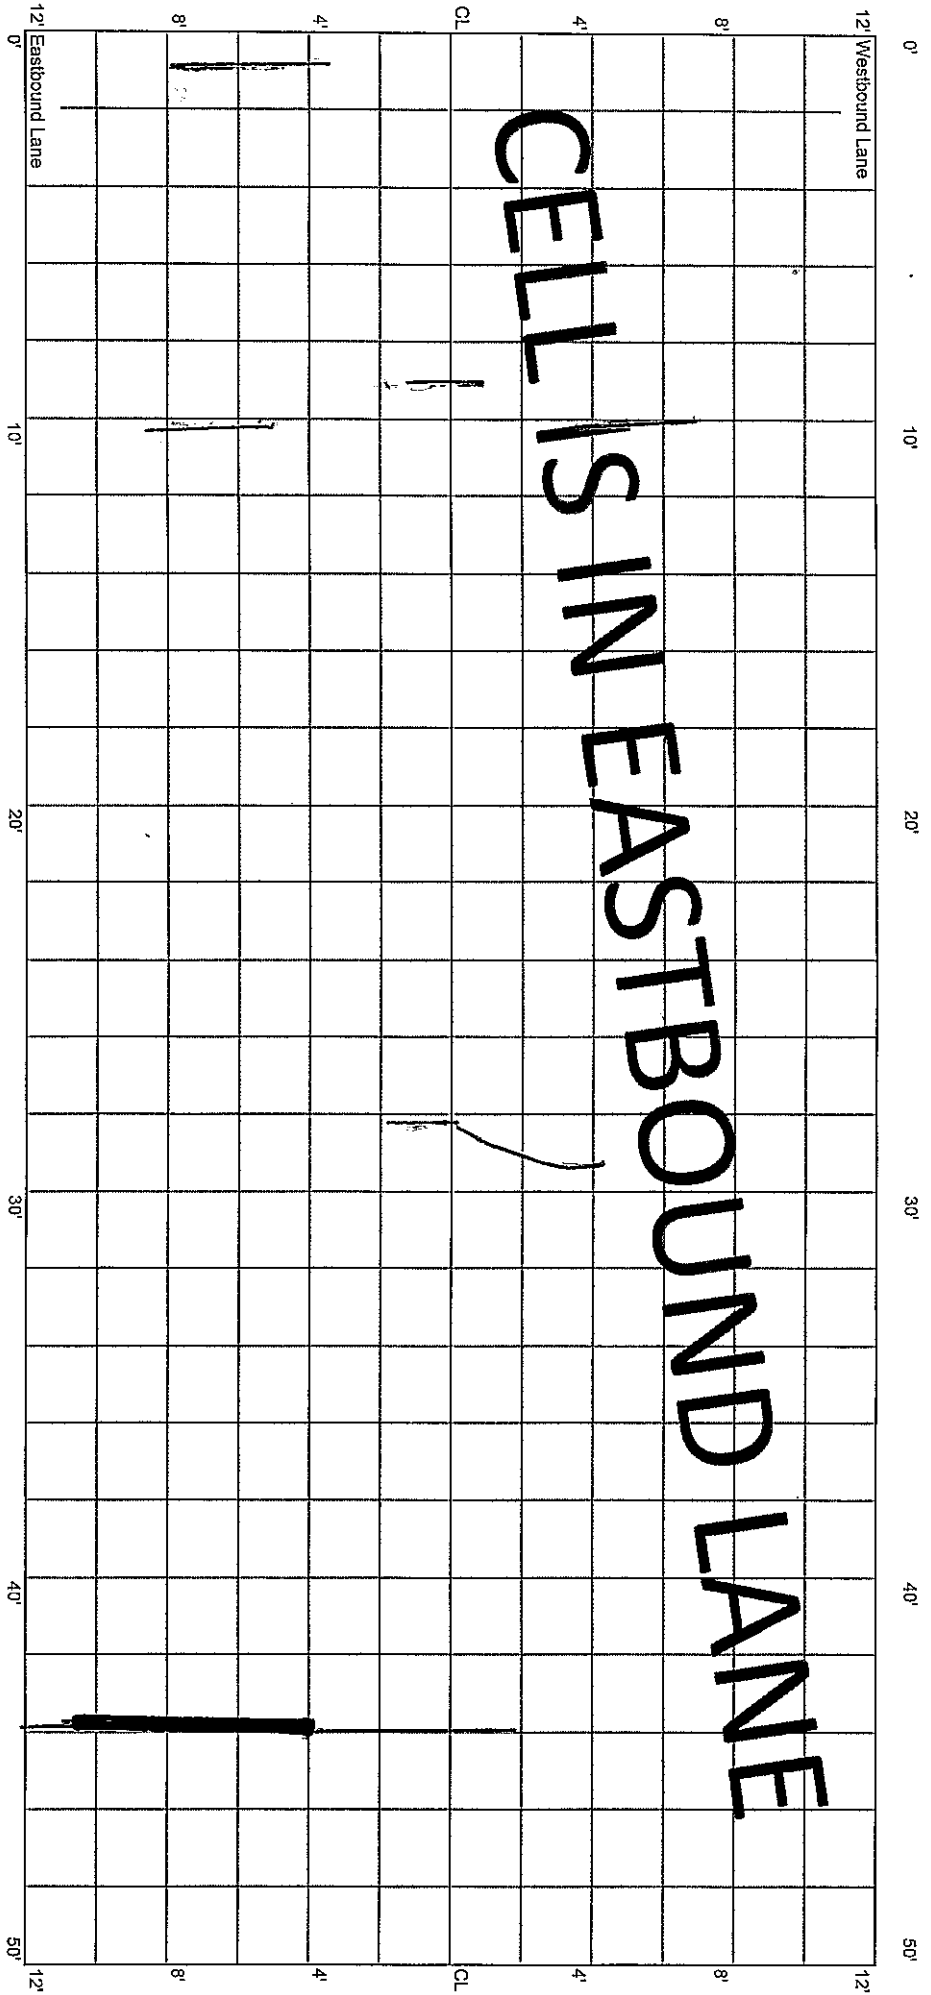


154
1/9/21

CELL 7001E
450 - 500 ft

4+50

5+00

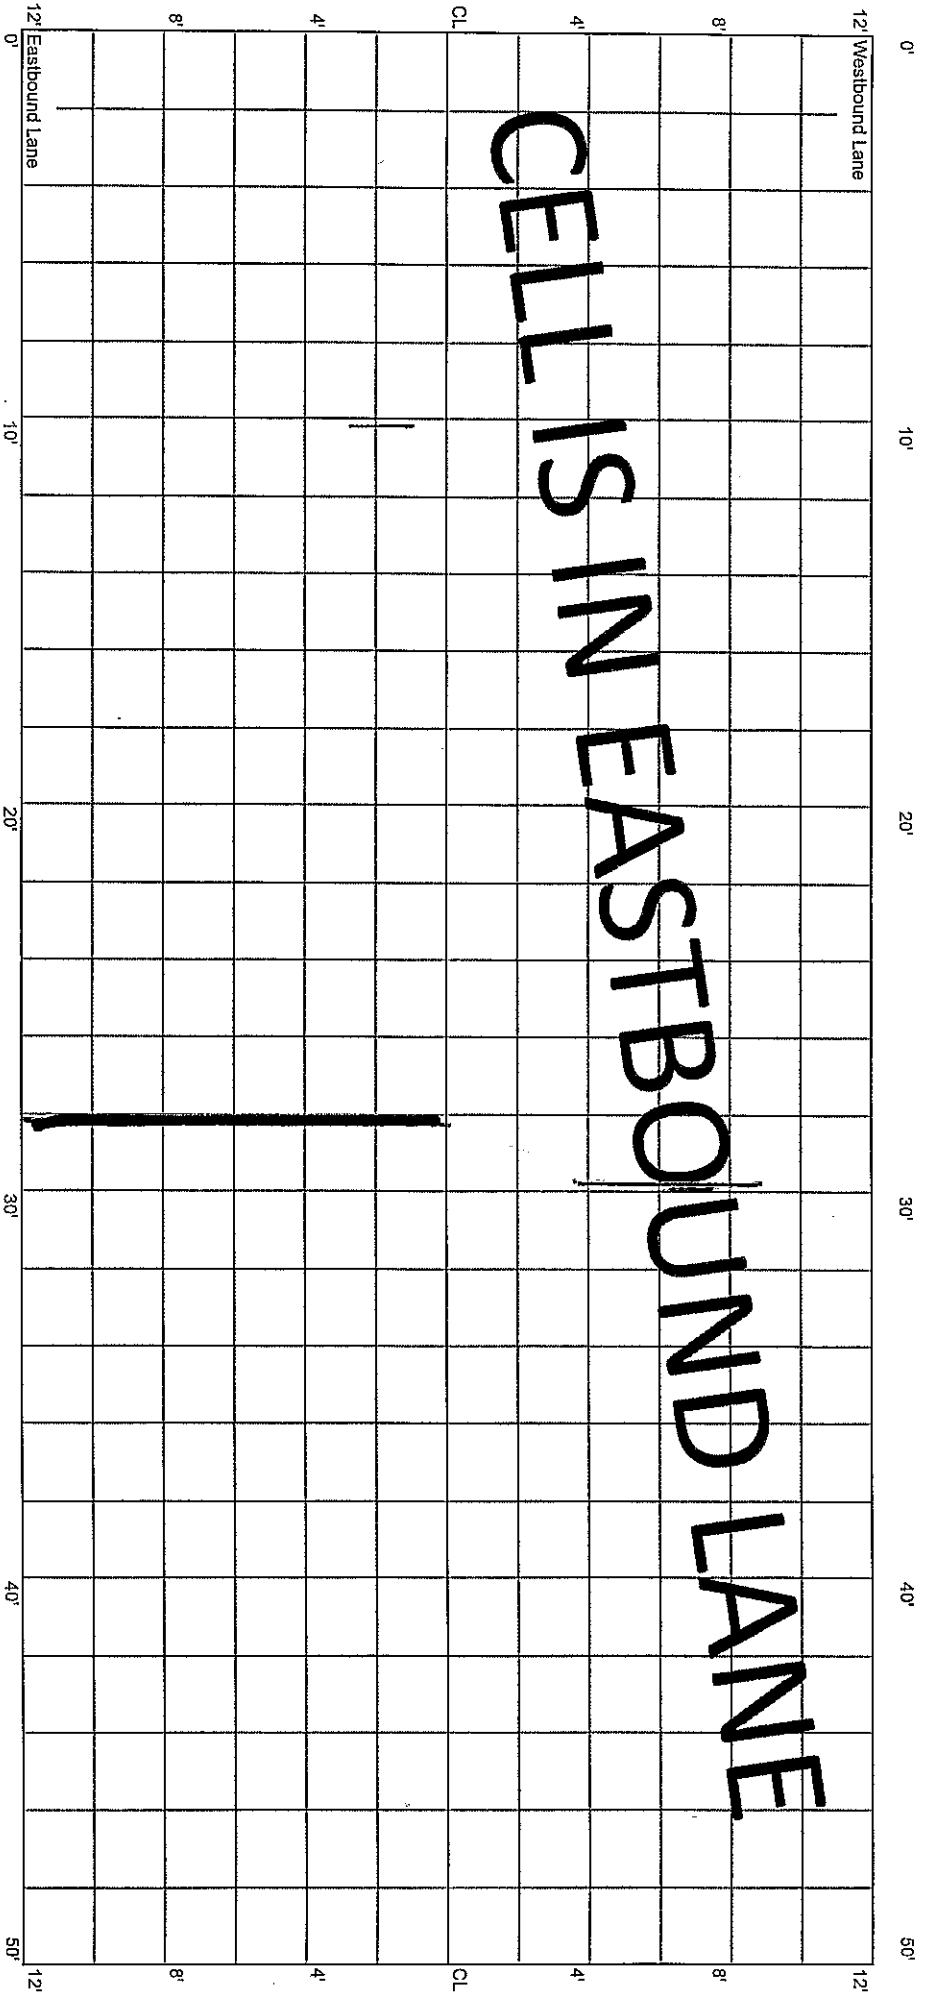

0'

10'

20'

30'

40'

50'

12' Westbound Lane

12'

8'

8'

4'

4'

CL

CL

4'

4'

8'

8'

12' Eastbound Lane

12'

0'

10'

20'

30'

40'


50'

CELL 7001E
500 - 550 ft

5+00

5+25


5+50

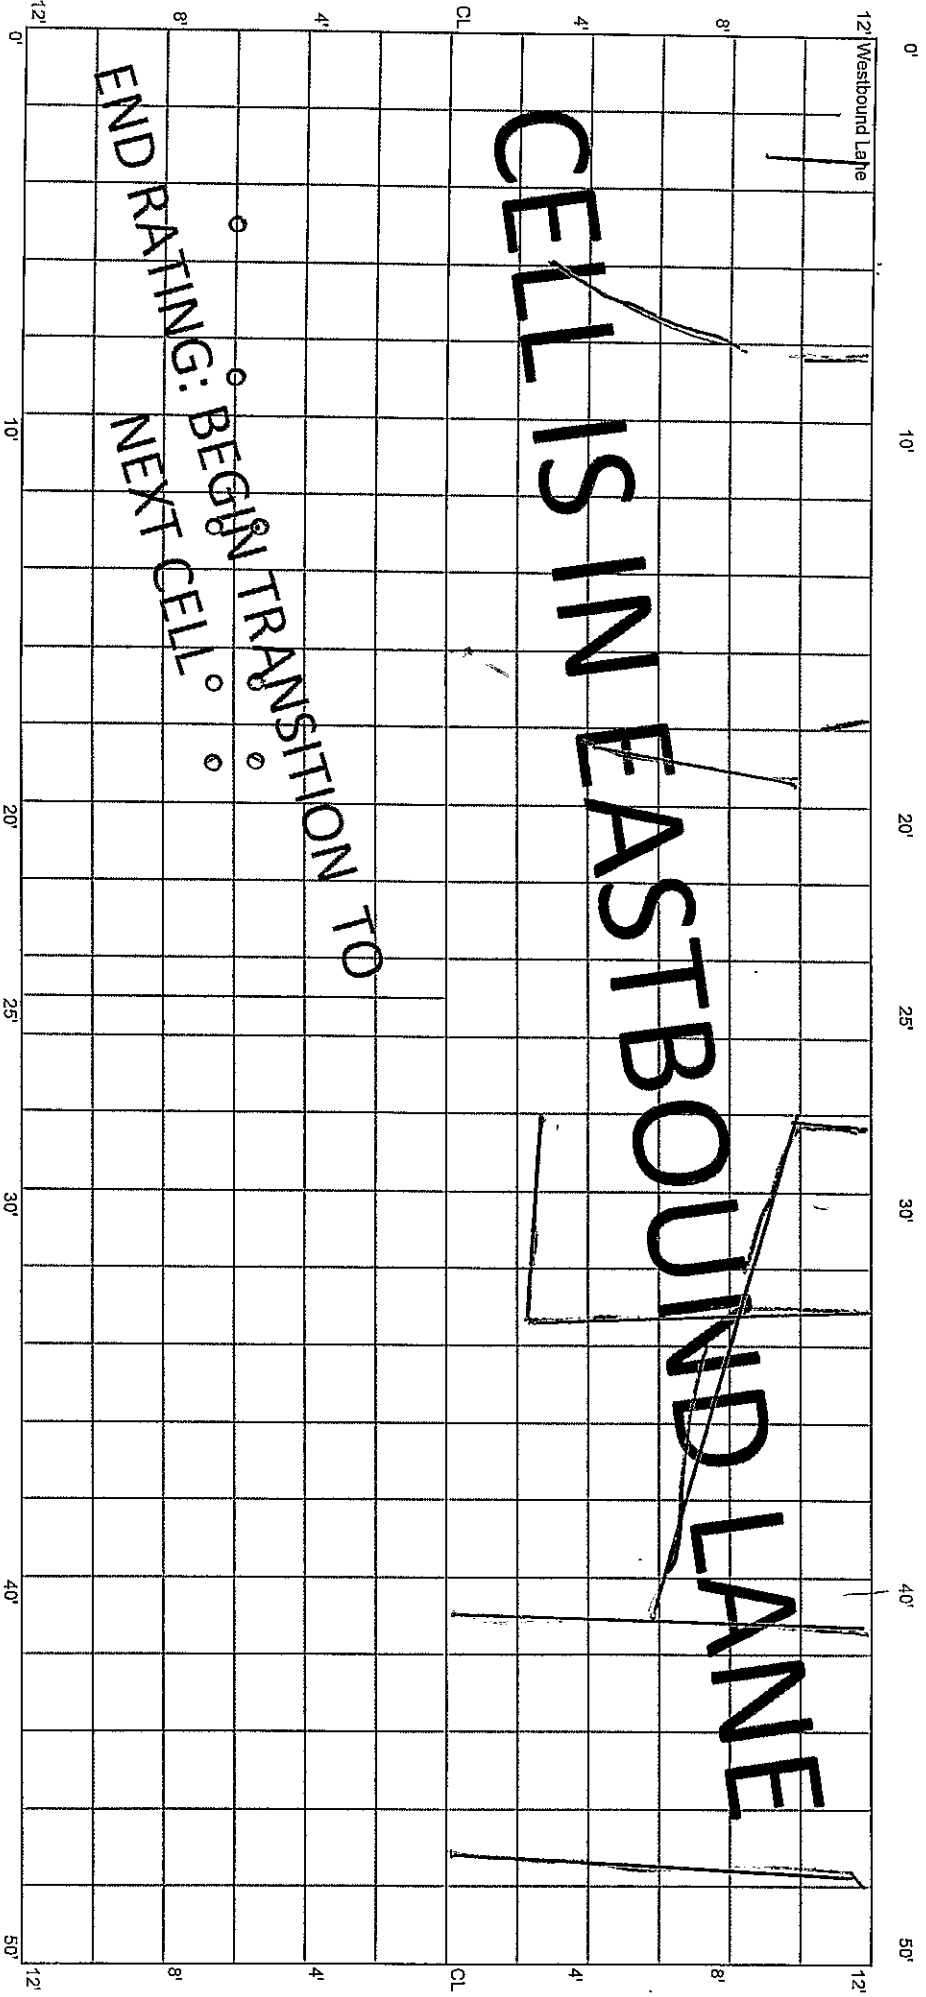

CELLS IN EASTBOUND LANE

END RATING: BEGIN TRANSITION TO
NEXT CELL

(0: Out 20
Cores)

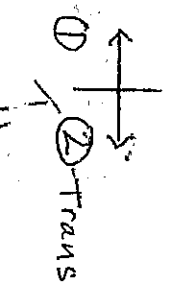

02