

5.28.20 E.T.

10.14.20


10.21.21

FILE 70TH ST

CELL 7001W
0 - 50 ft

5+00

4+50

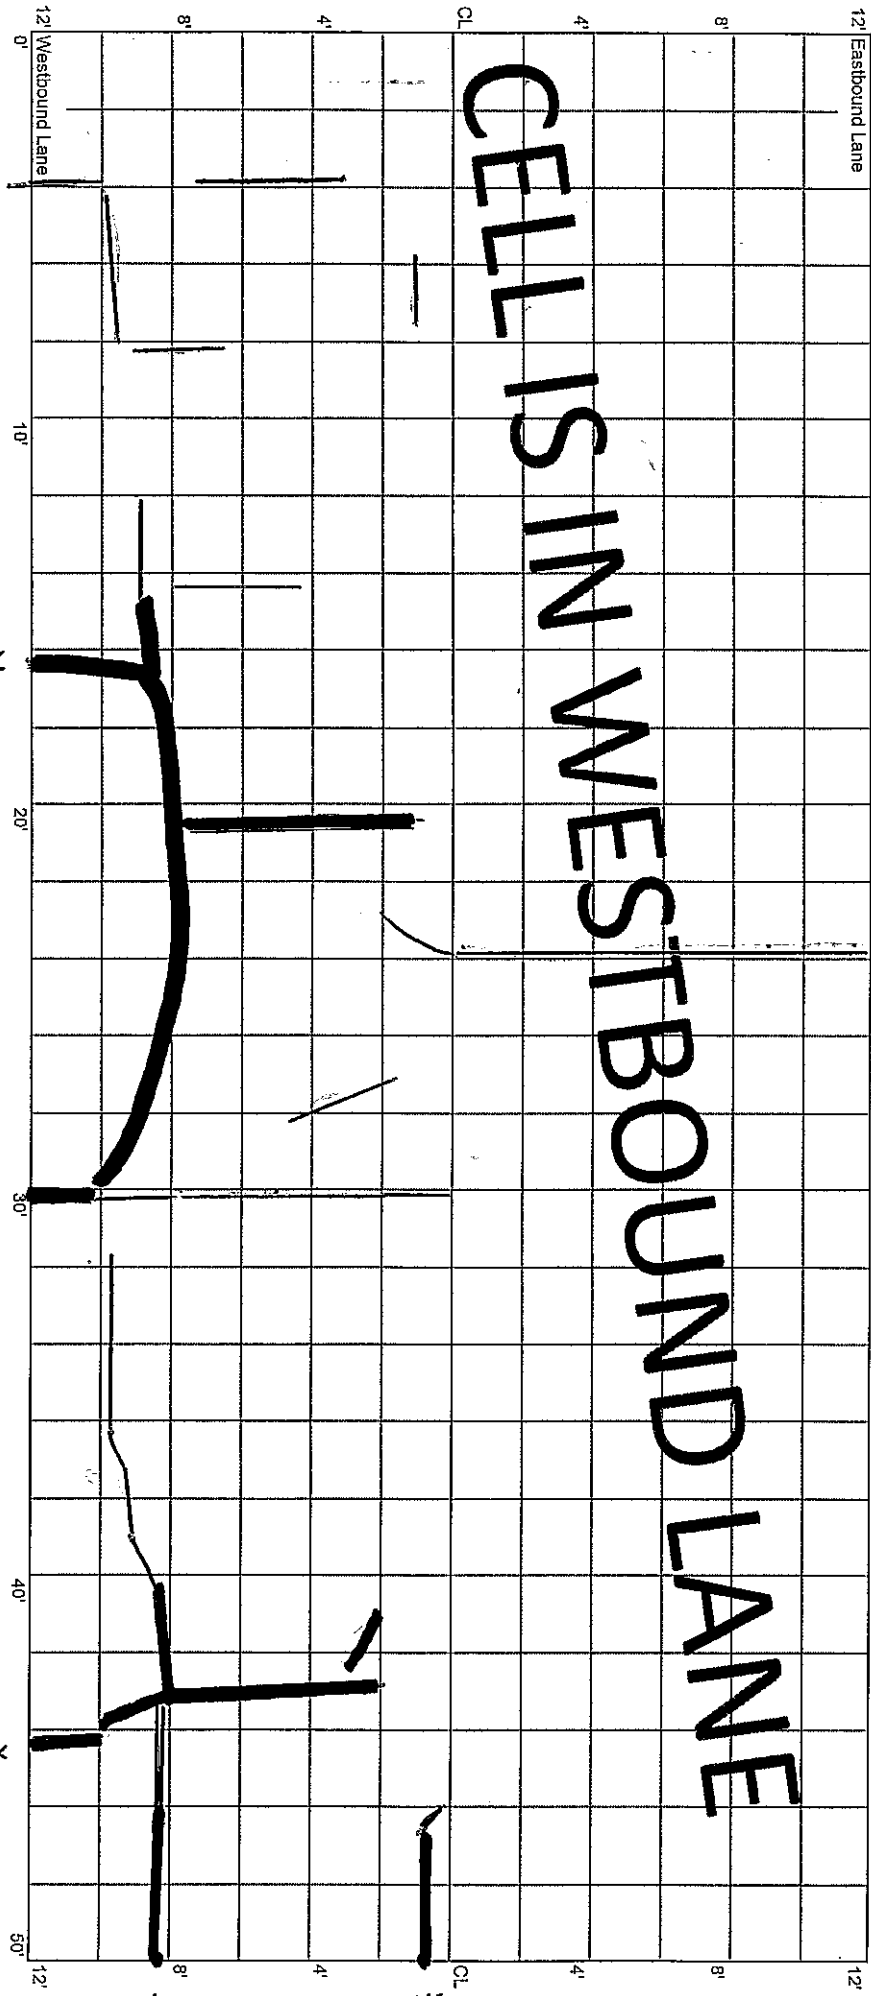

*Port & Seal

F-11k
R1
R2

CELL 7001W
50 - 100 ft

4+50

4+00

12' Eastbound Lane

12'

12' Westbound Lane

12'

0' 10' 20' 30' 40' 50'

CELLS IN WESTBOUND LANE

CL

CL

Block

No Seal


No Seal

M *

M *

*


* *

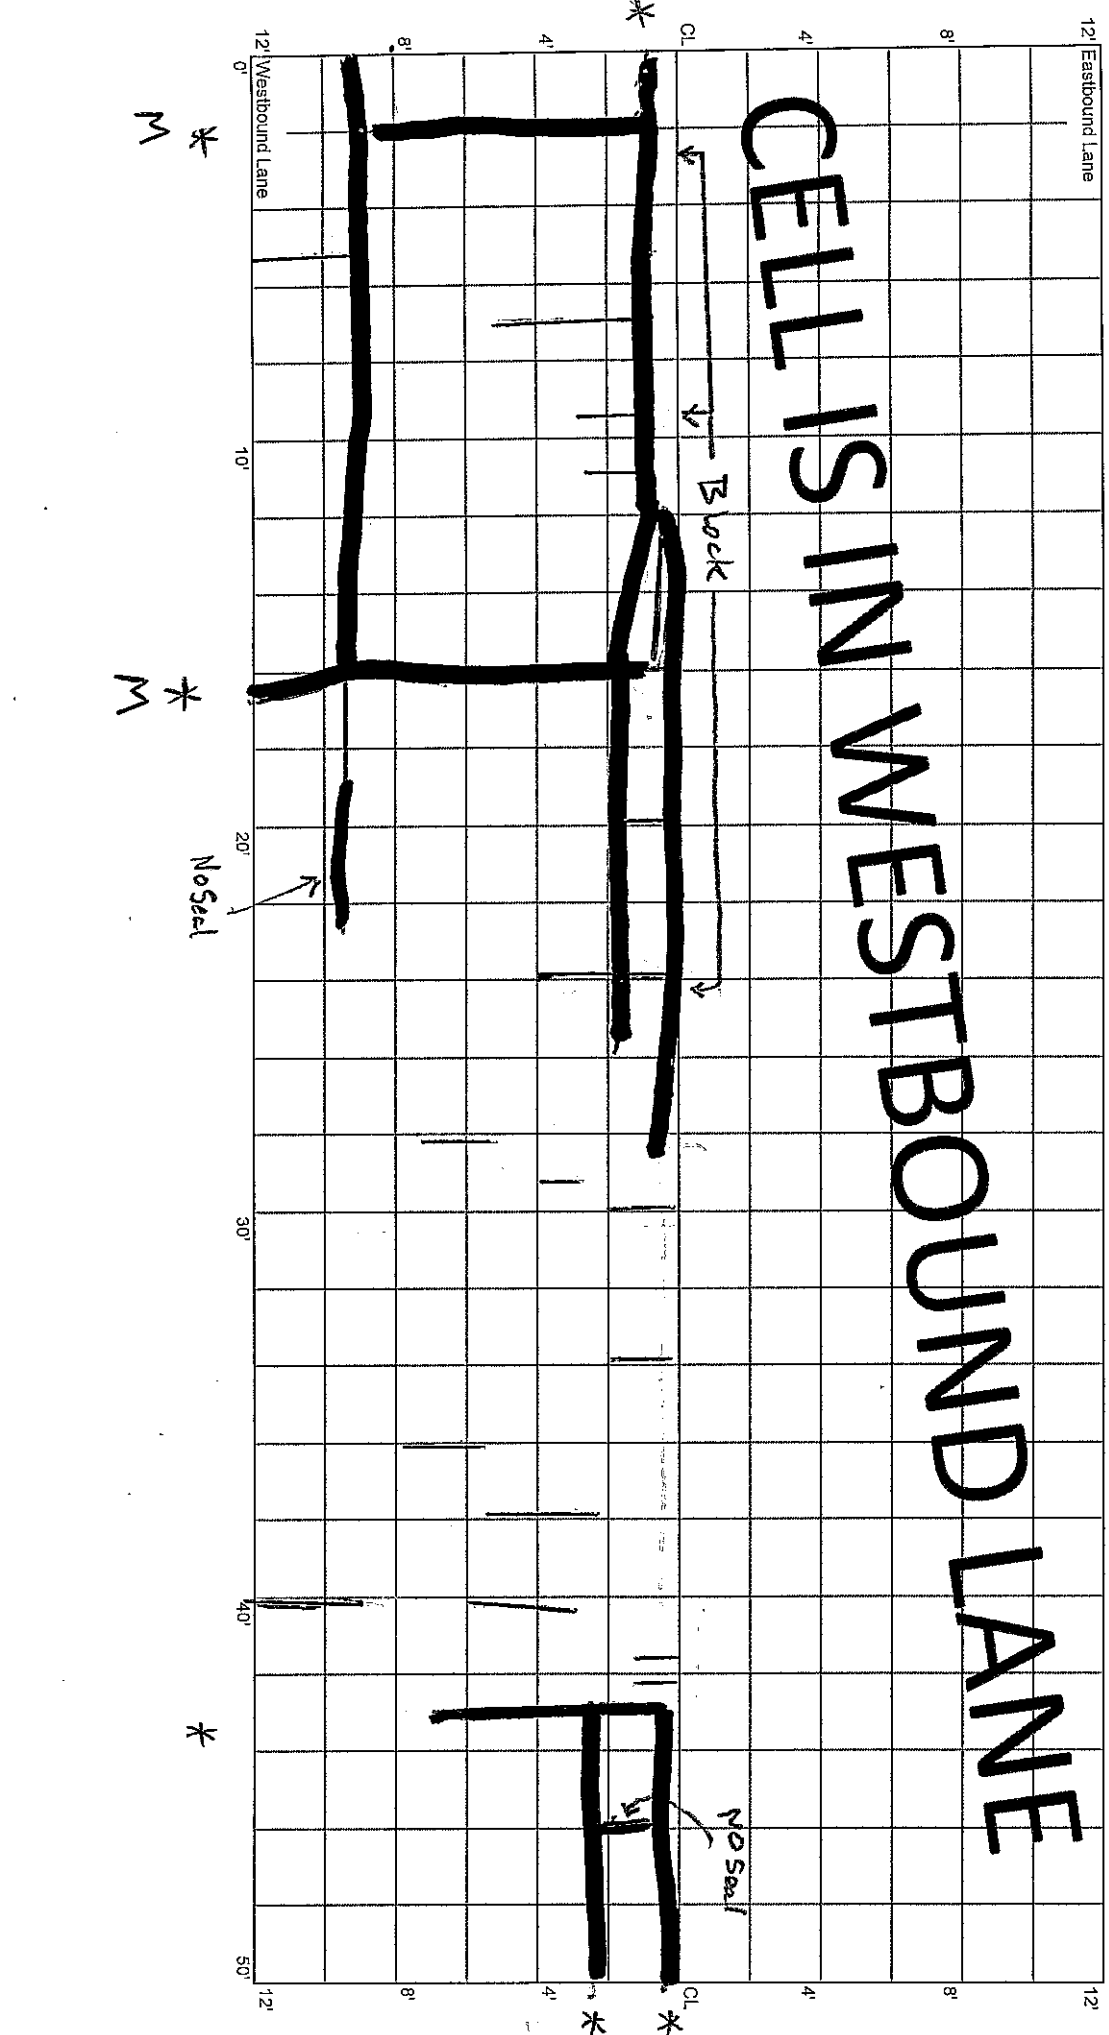

CELL 7001W
100 - 150 ft

4+00


3+50

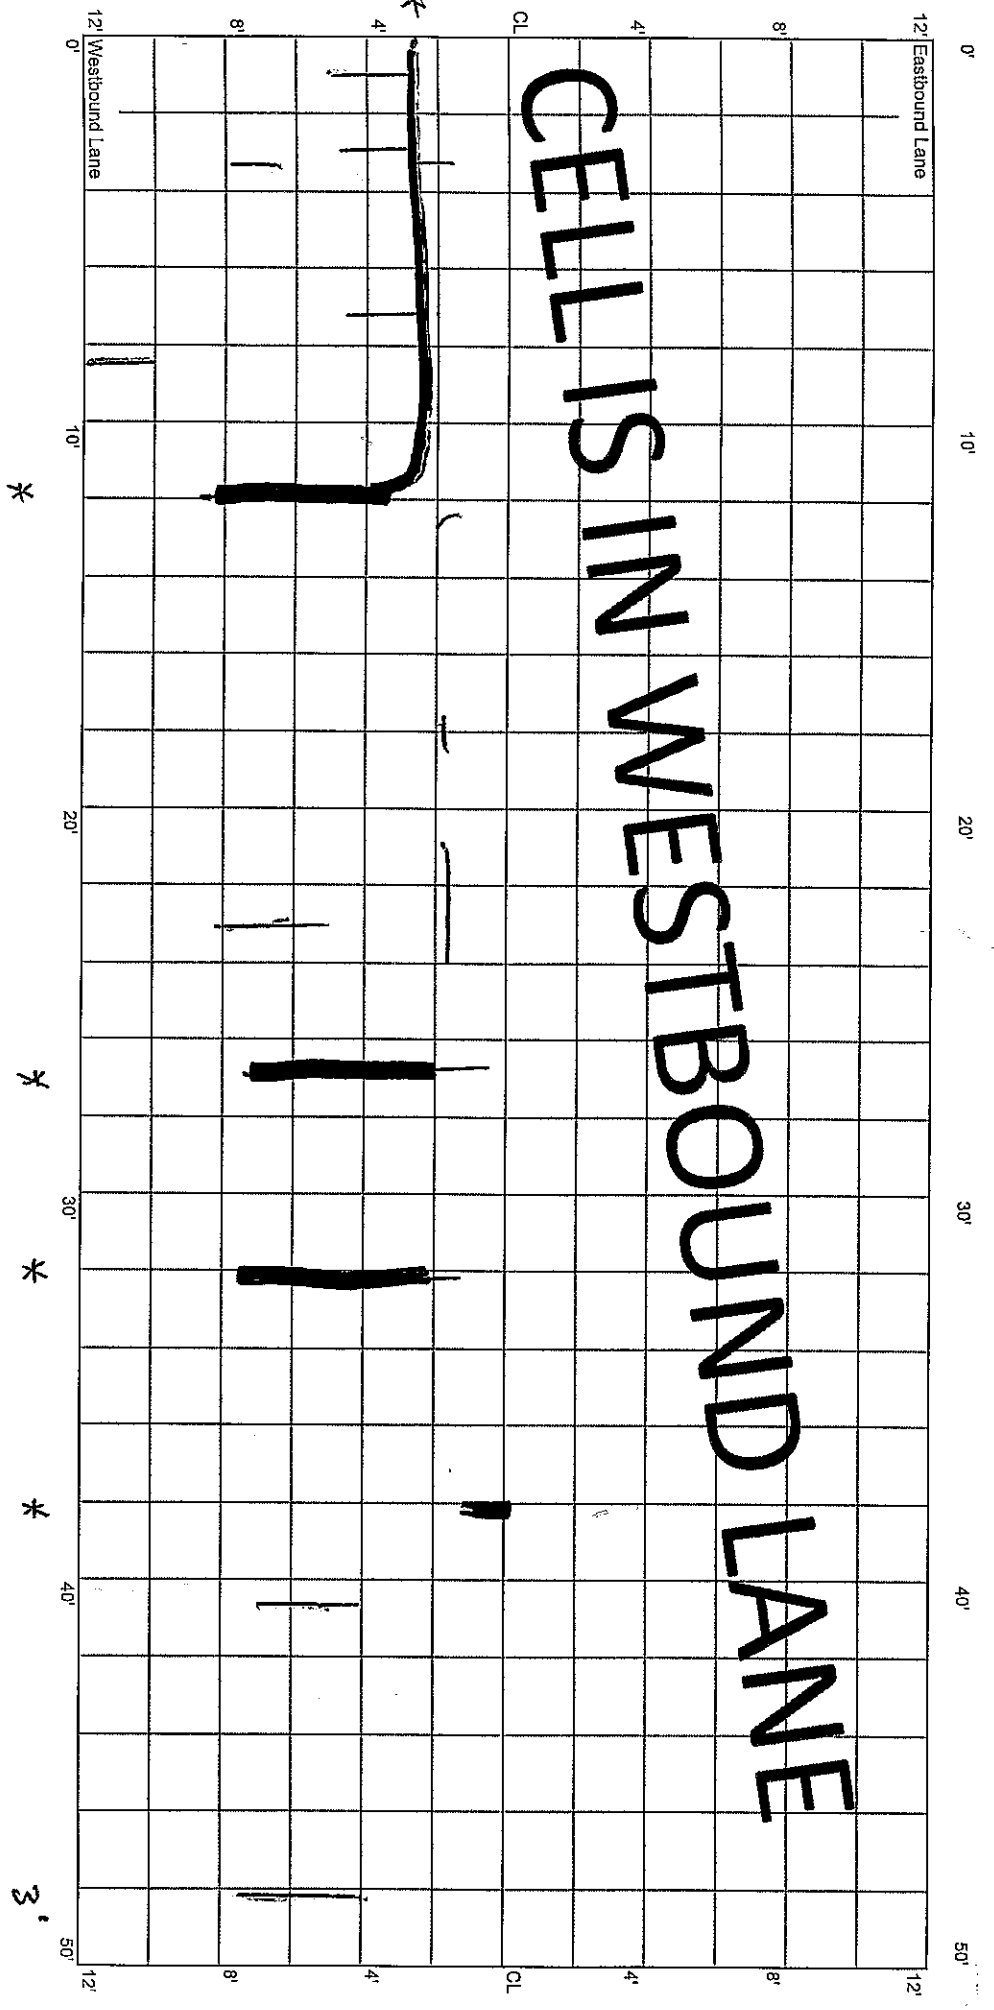

CELL 7001W
150 - 200 ft

3+50

3+00

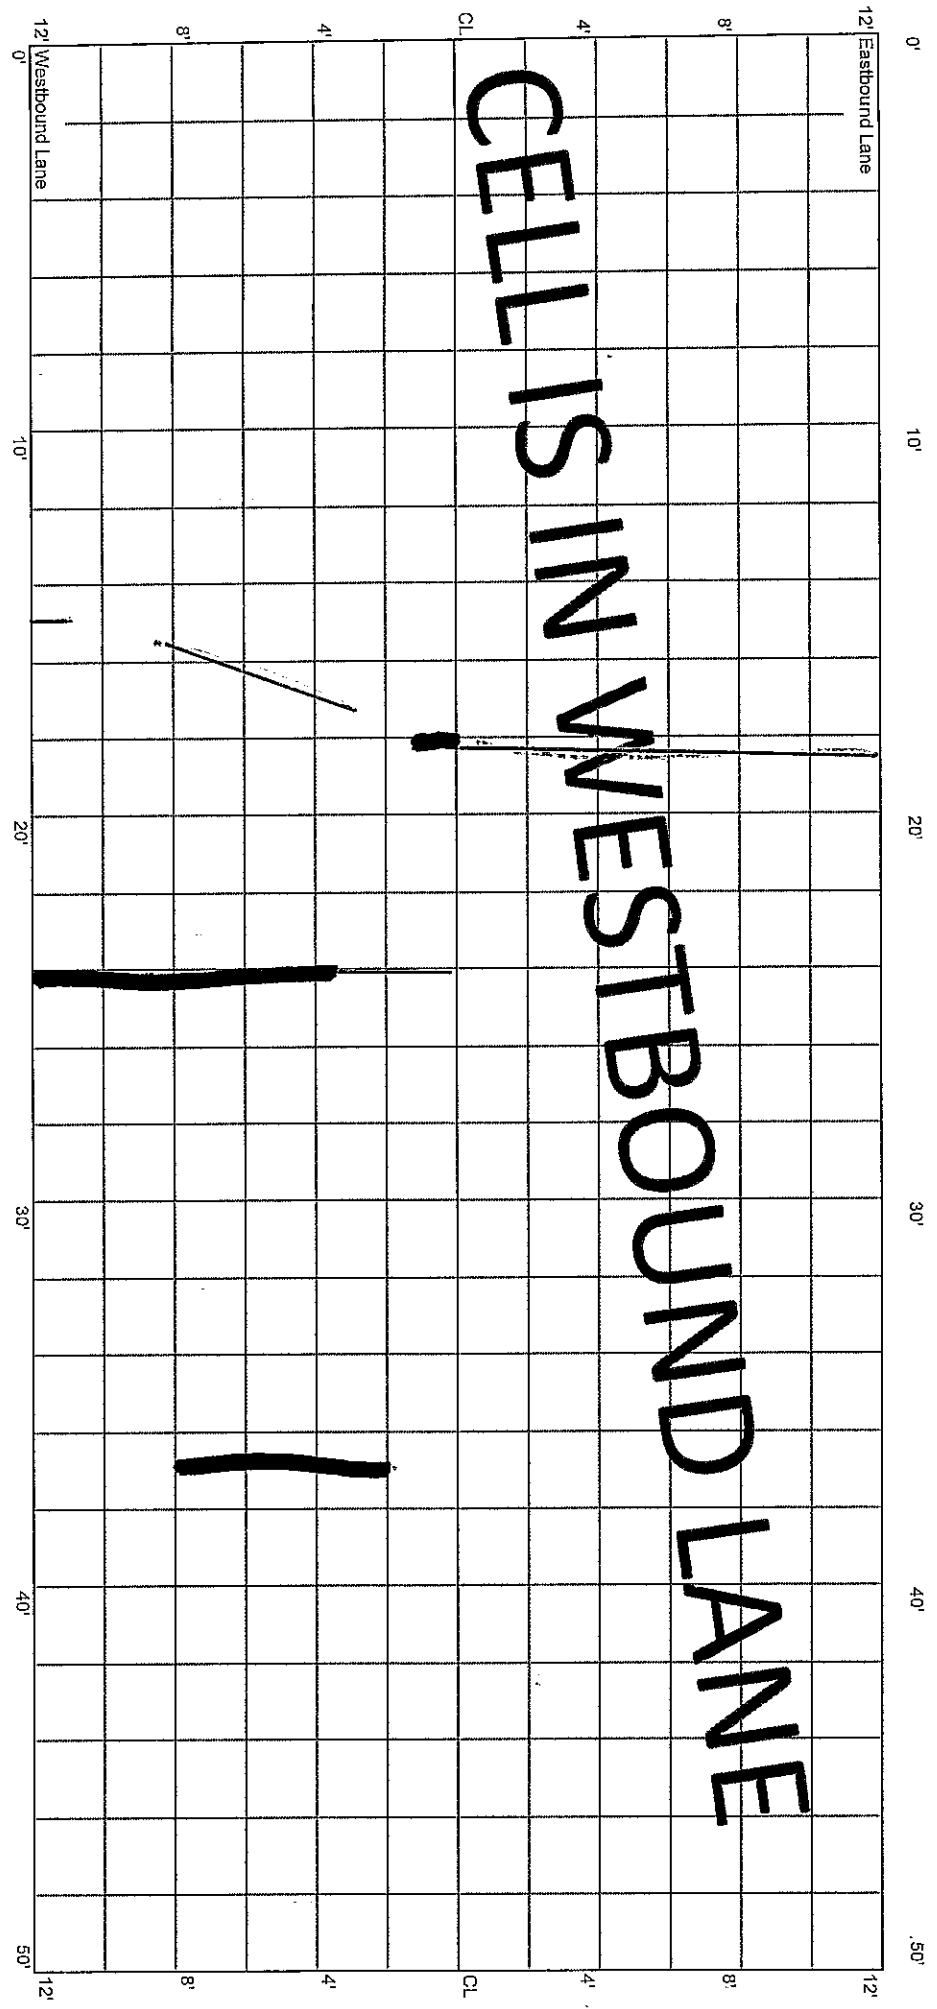

*


*

N.V.

CELL 7001W
200 - 250 ft

3+00


2+50

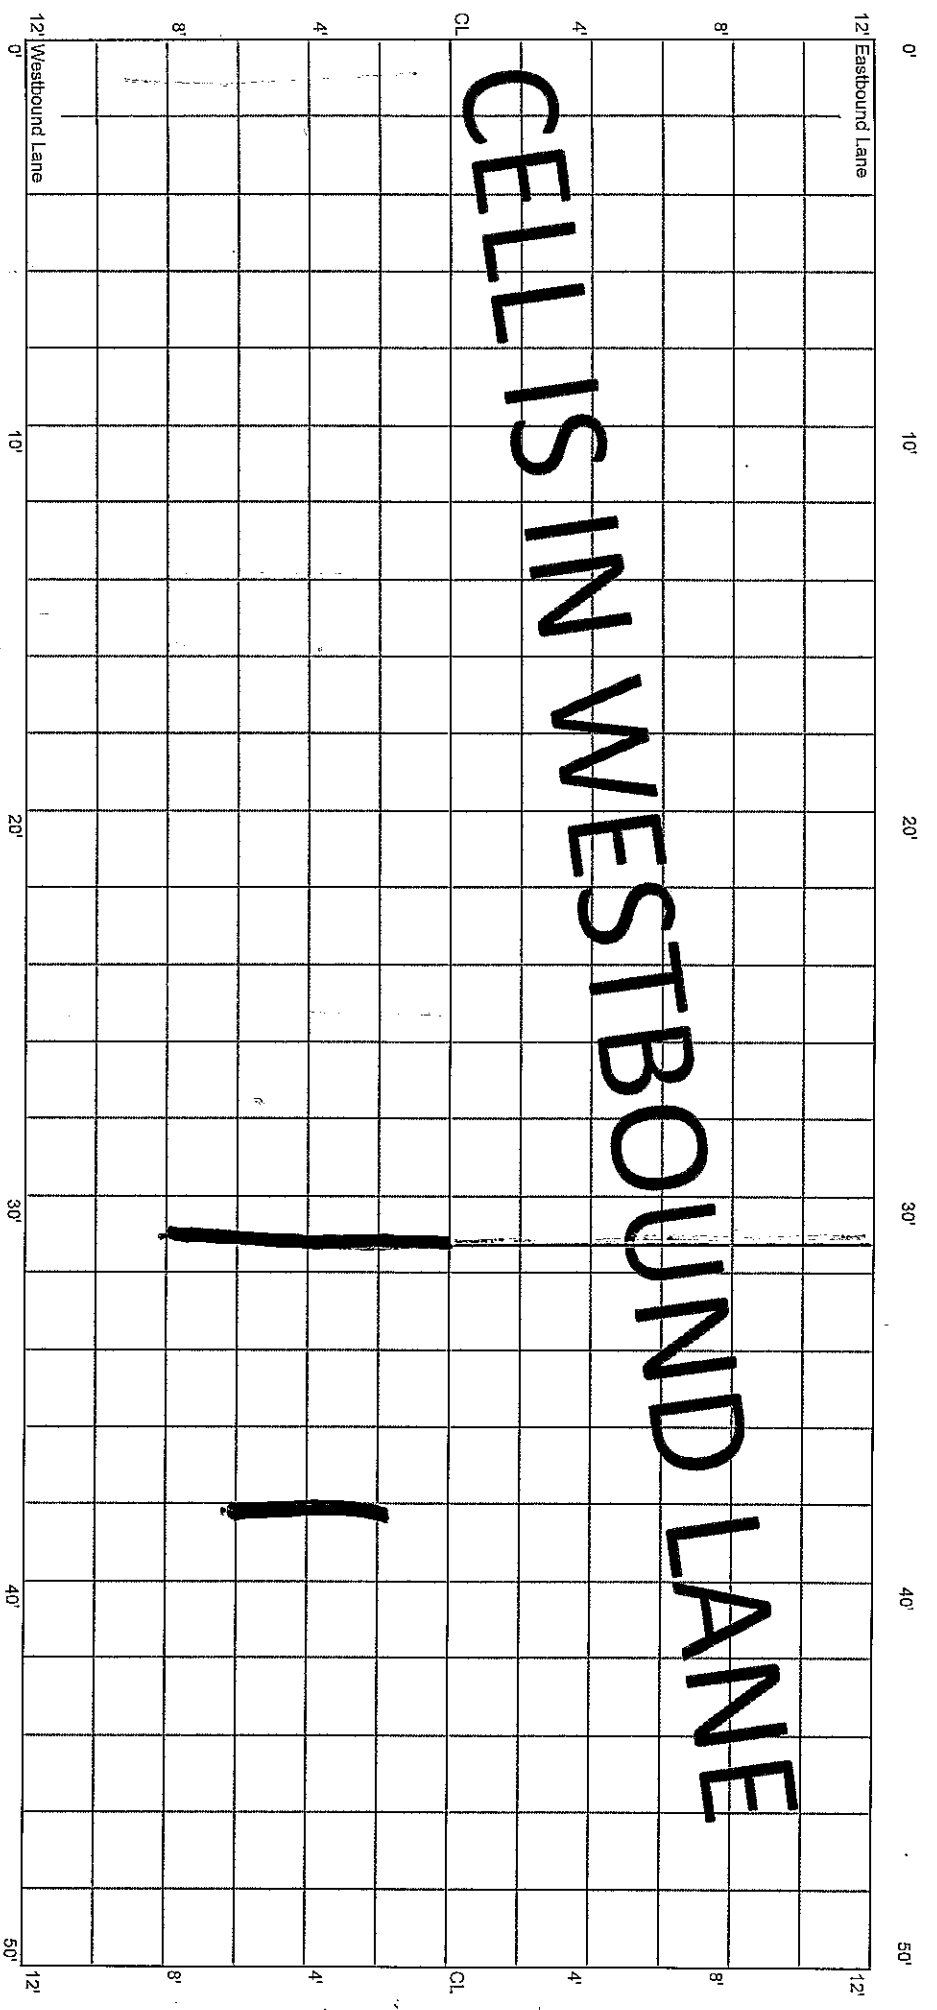

CELL 7001W
250 - 300 ft

2+50

2+00

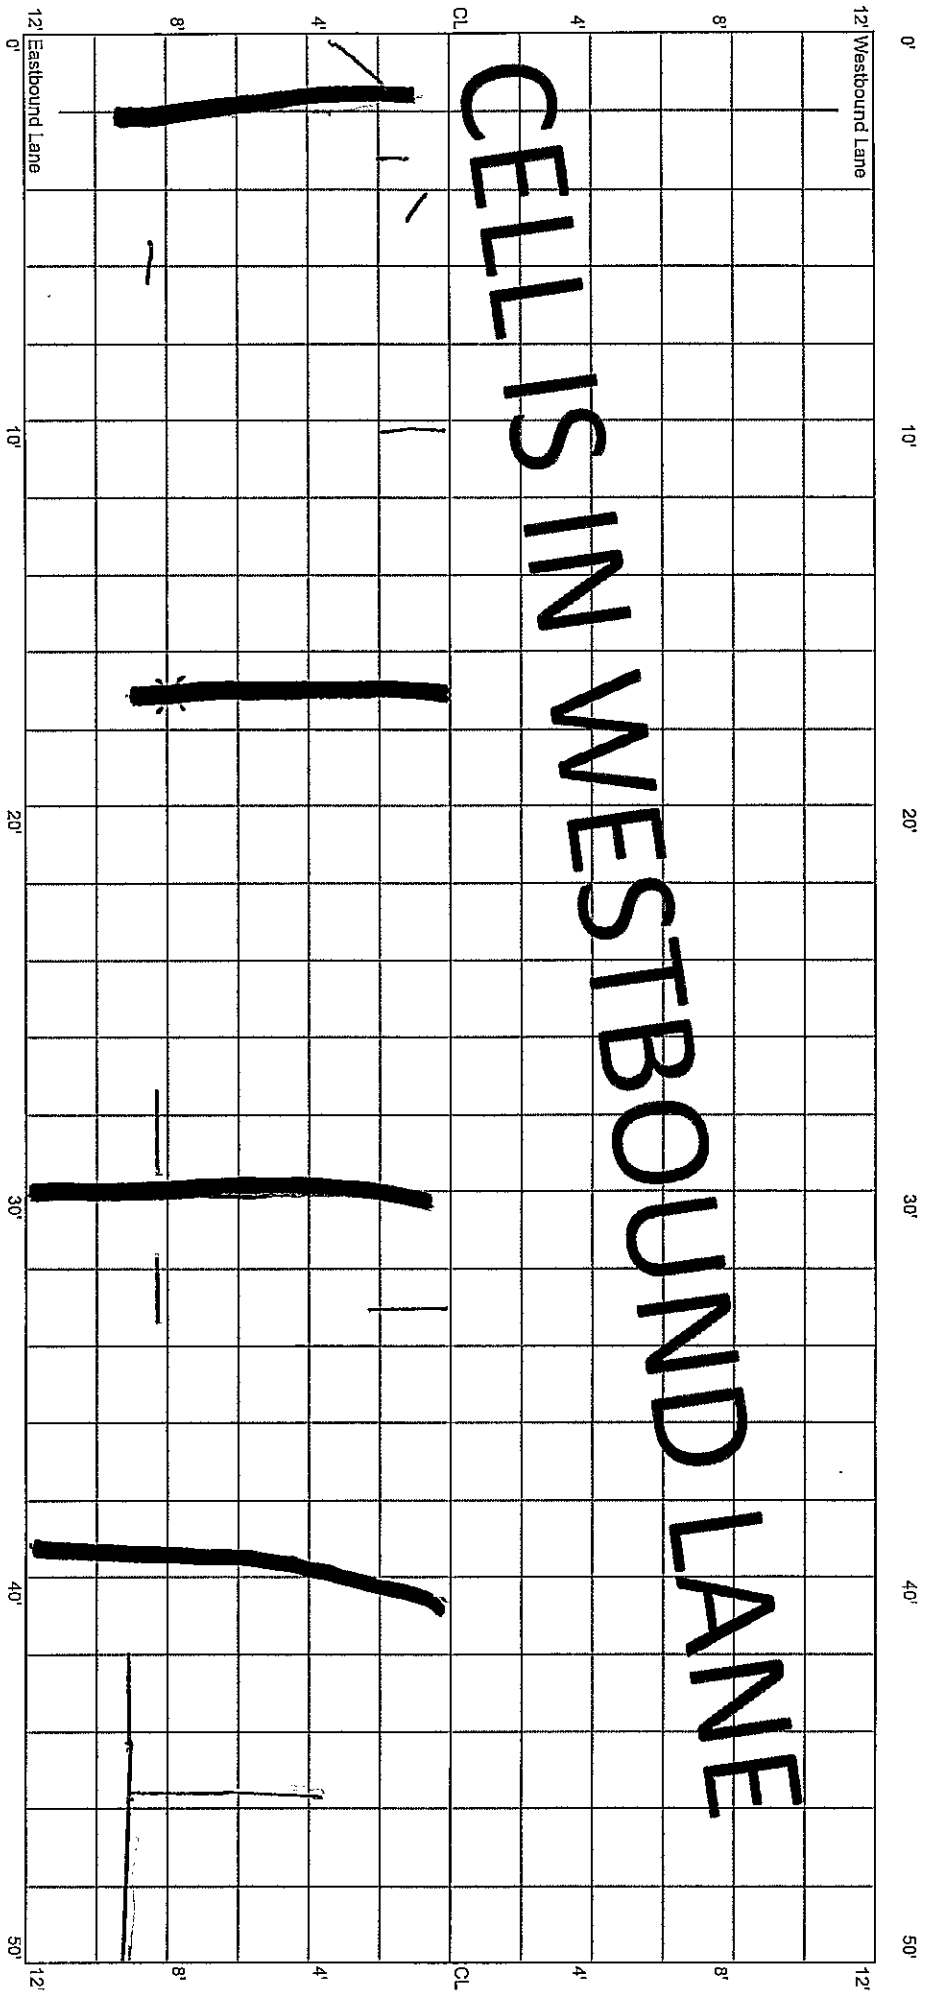

x of seal loss

* M


*

*

CELL 7001W
300 - 350 ft

2+00

1+50

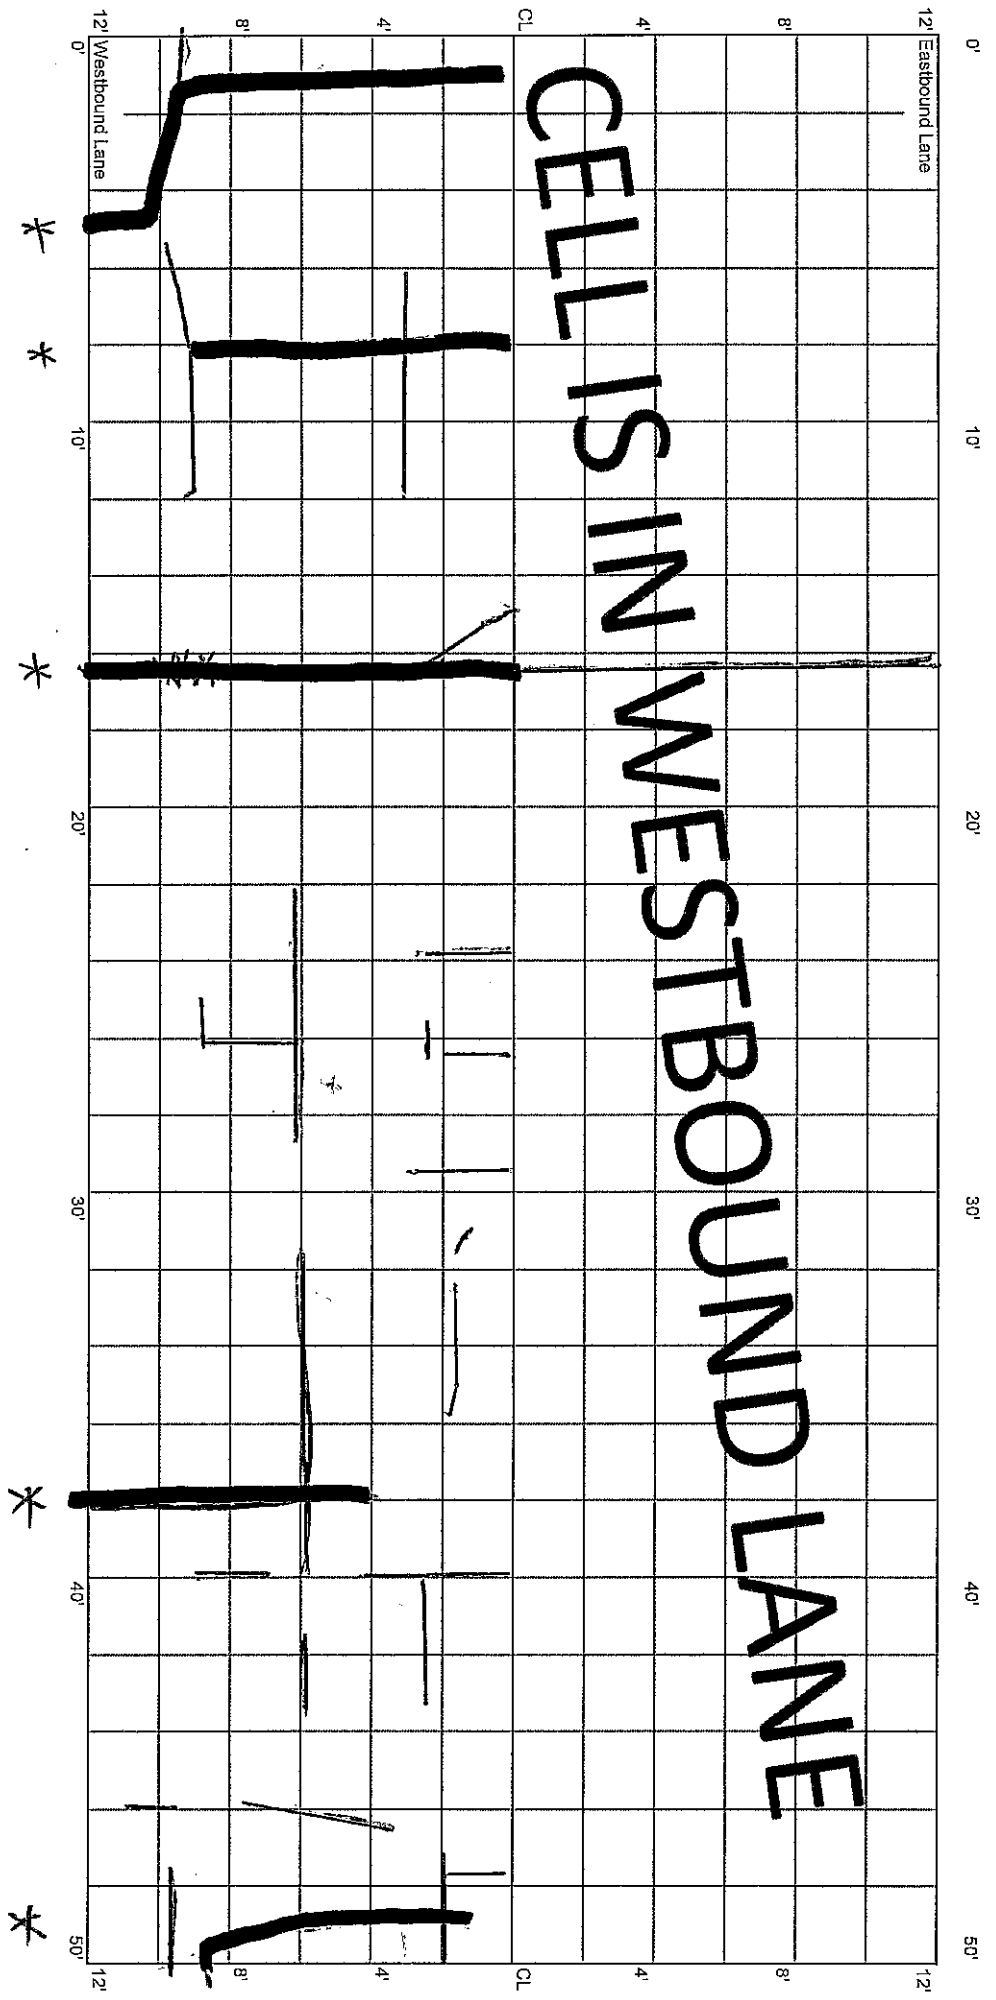


X Dobry/Stowers

CELL 7001W
350 - 400 ft

1+50

1+00

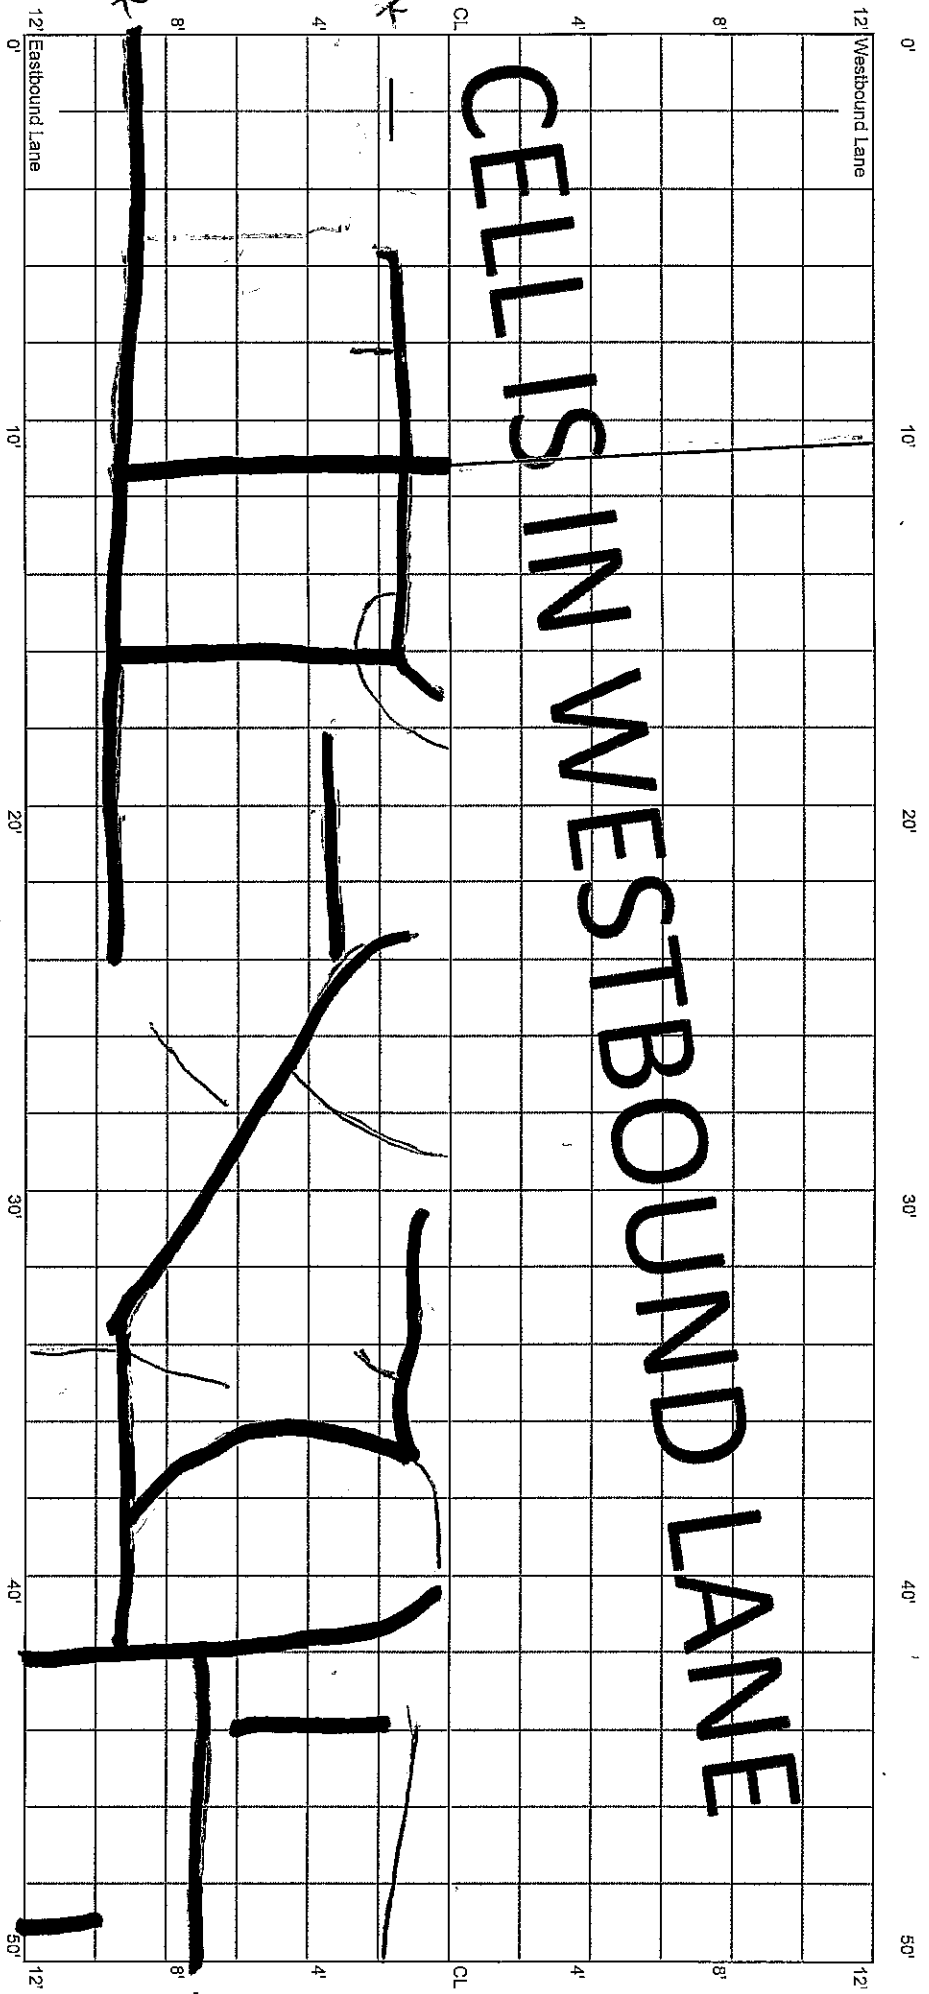

CELLS IN WESTBOUND LANE

* *


* * *

*

CELL 7001W
400 - 450 ft

1+00

0+50

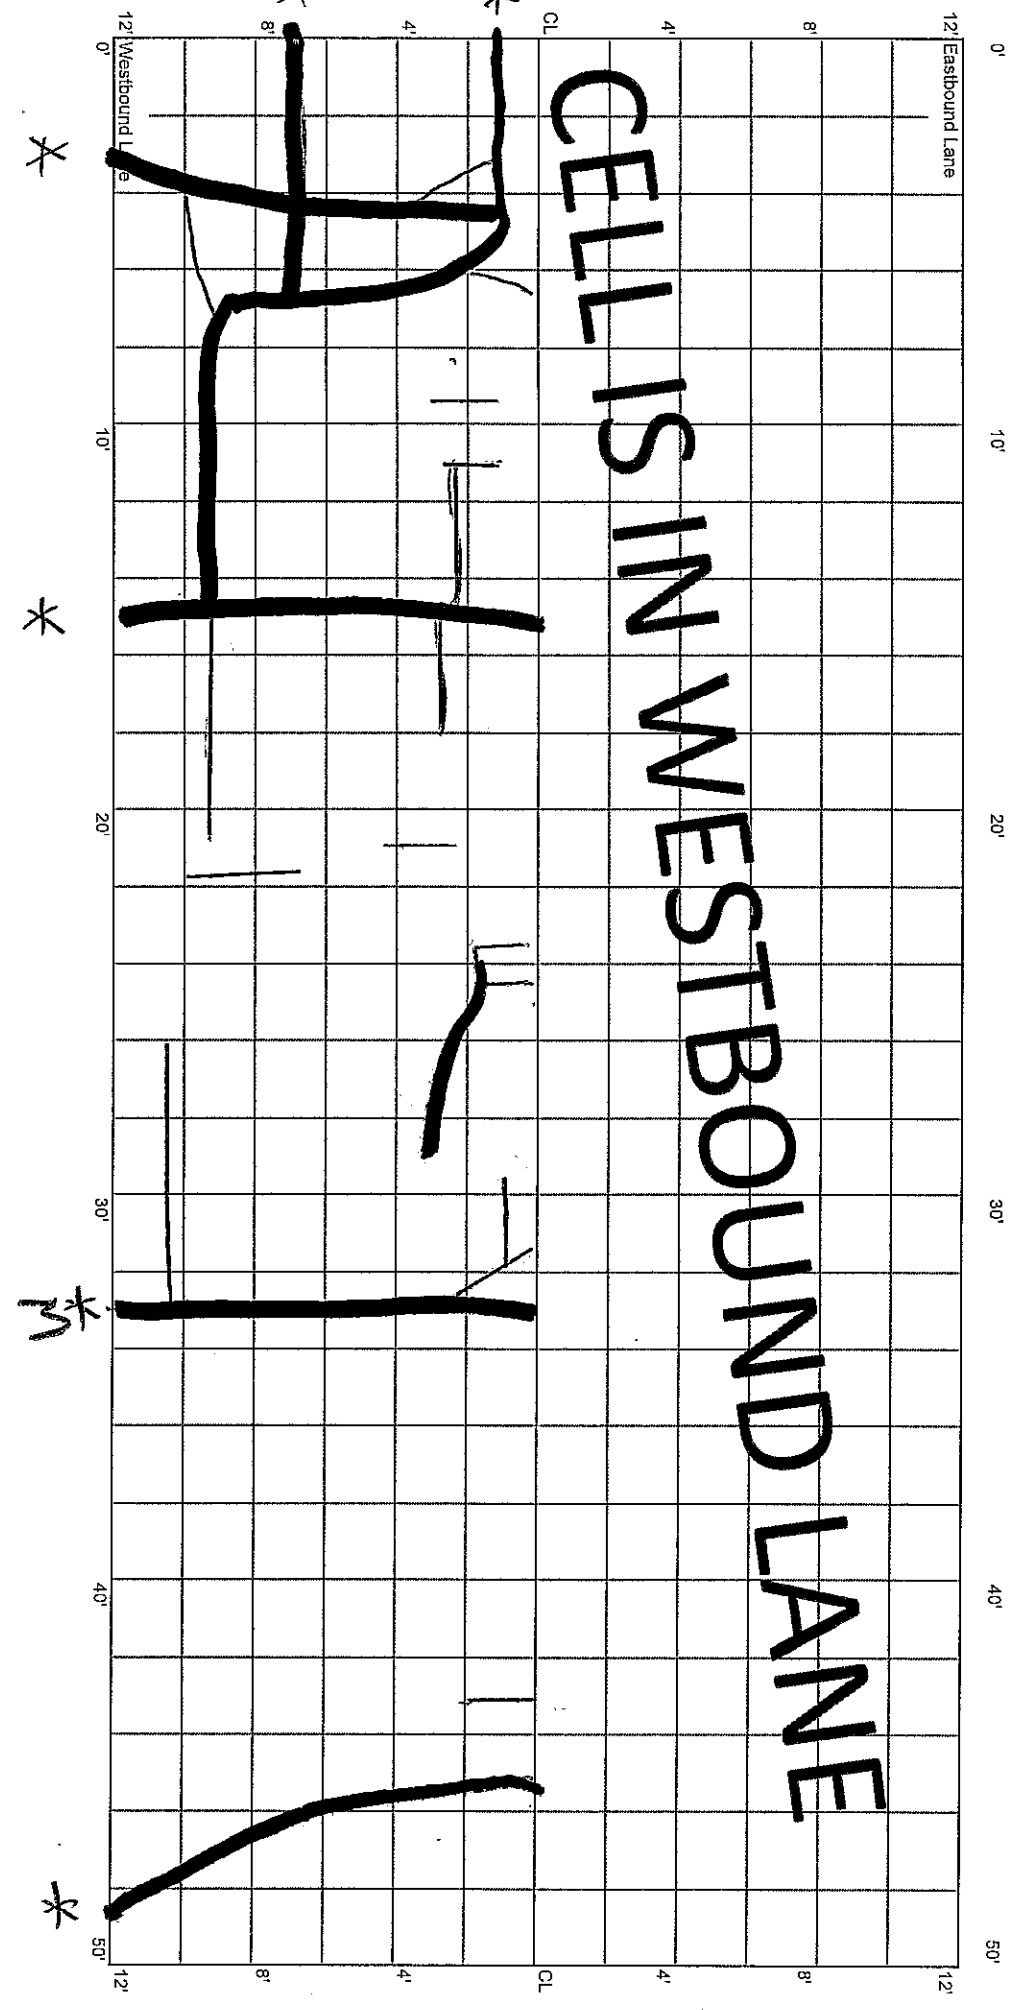


CELL 7001W
450 - 500 ft

End CL Kadler

0+50

0+00

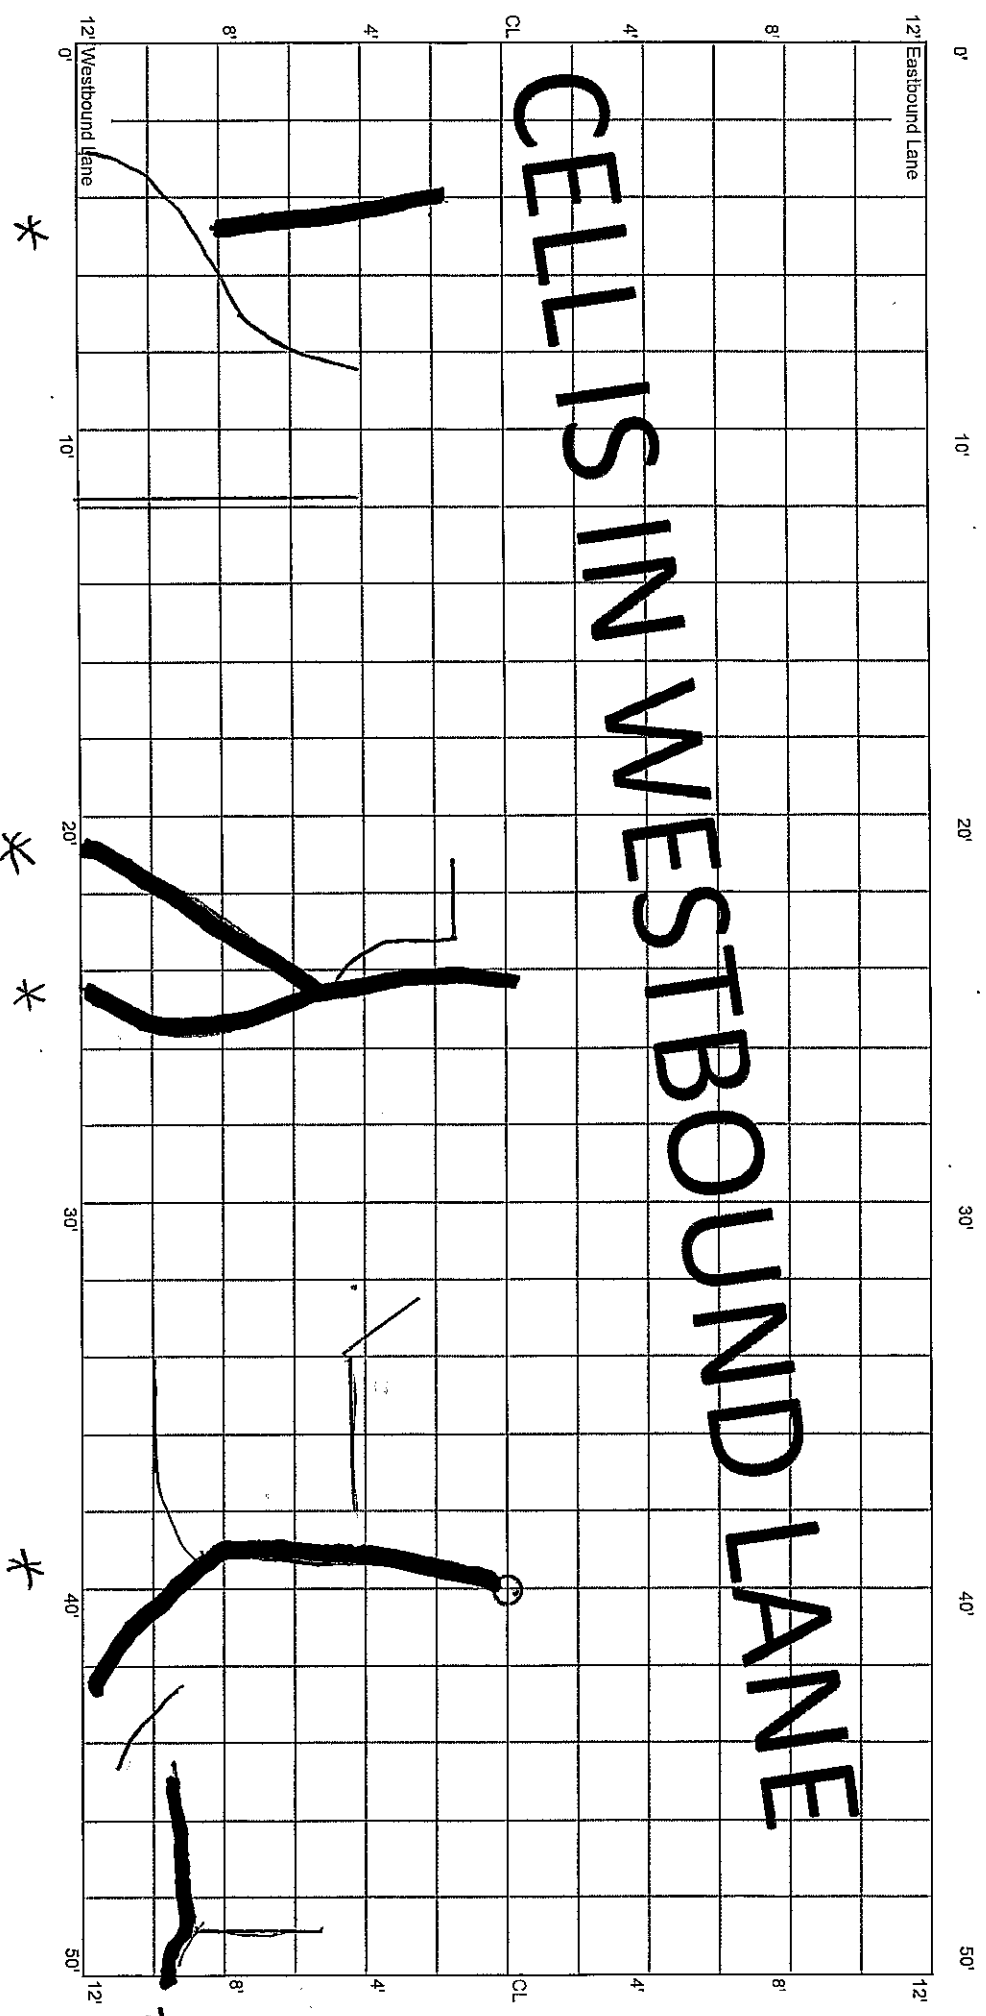

End CL Kadler

CELL 7001W
500 - 550 ft

0+00

-0+23

0'

-10'

-20'

-23'

12' Eastbound Lane

12'

8'

8'

4'

4'

CL

CL

CELLS IN WESTBOUND LANE

END RATING: CL KADLER

12' Westbound Lane

12'

0'

-10'

-20'

-23'