


5.28.20 E.J.
10.14.20
11.4.21
File 70TH ST

CELL 7005E
0 - 50 ft

22+00

22+50

Ruton outside of Fogline

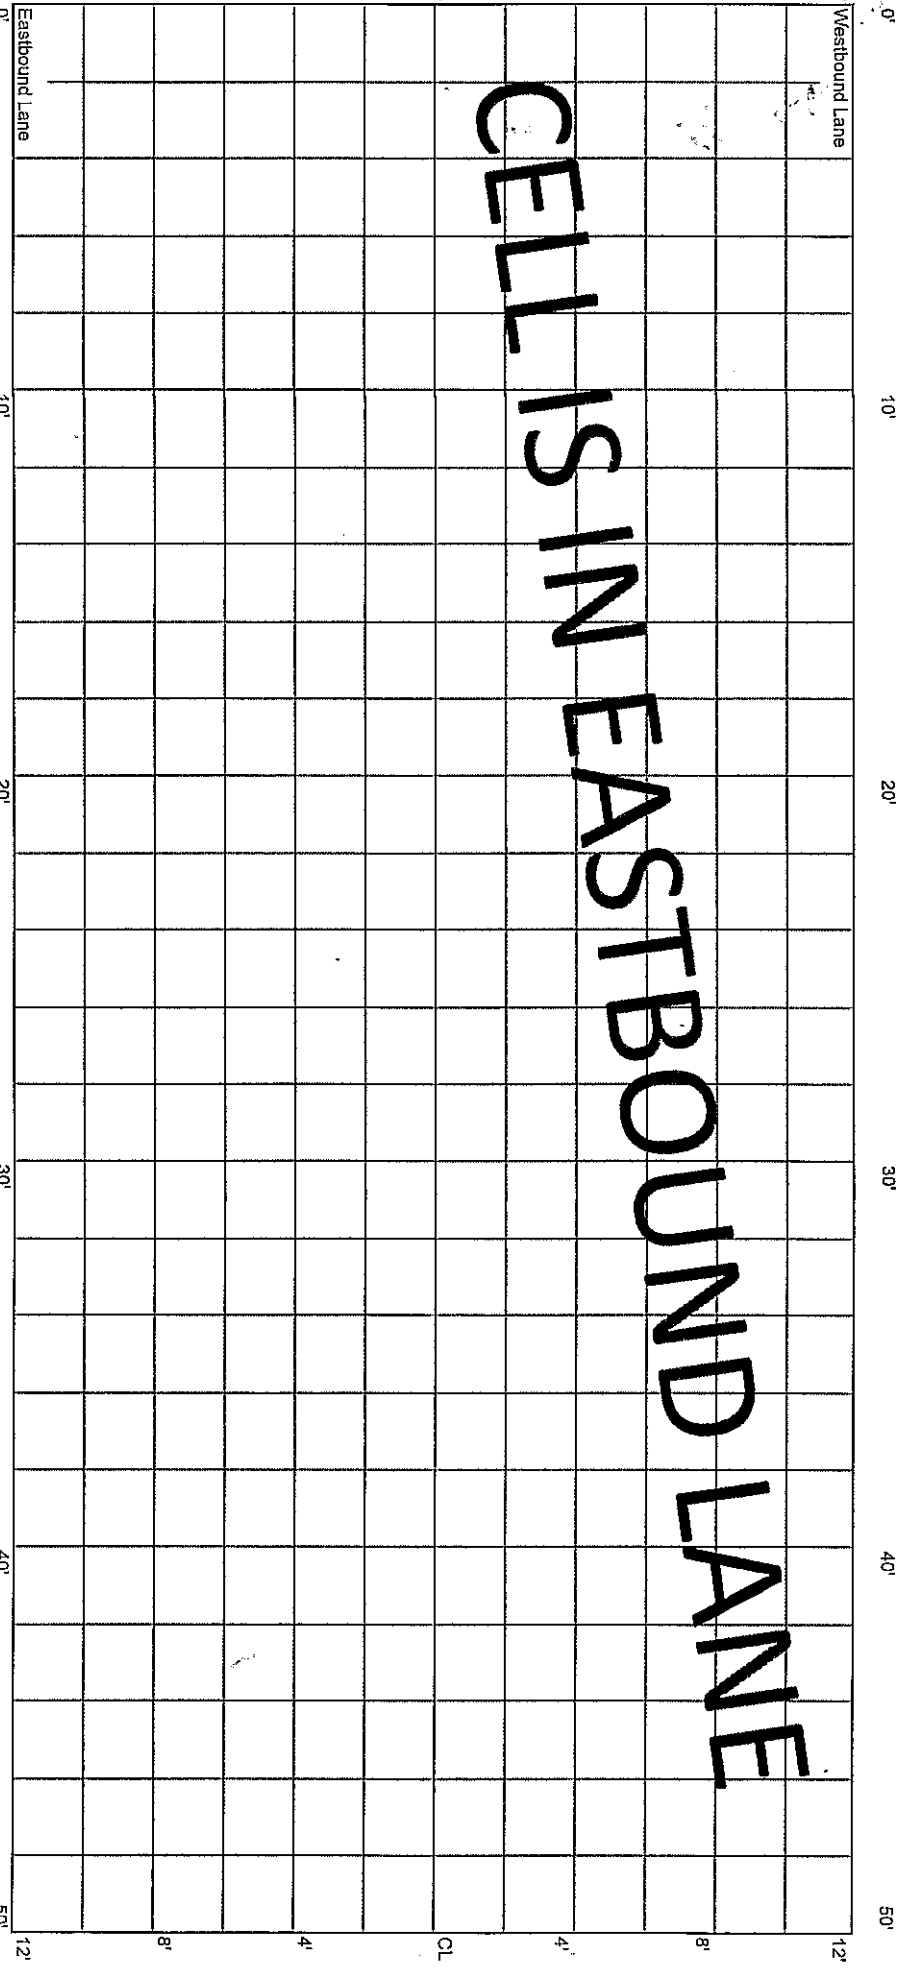


* Rutd Seal

CELL 7005E
50 - 100 ft

22+50


23+00

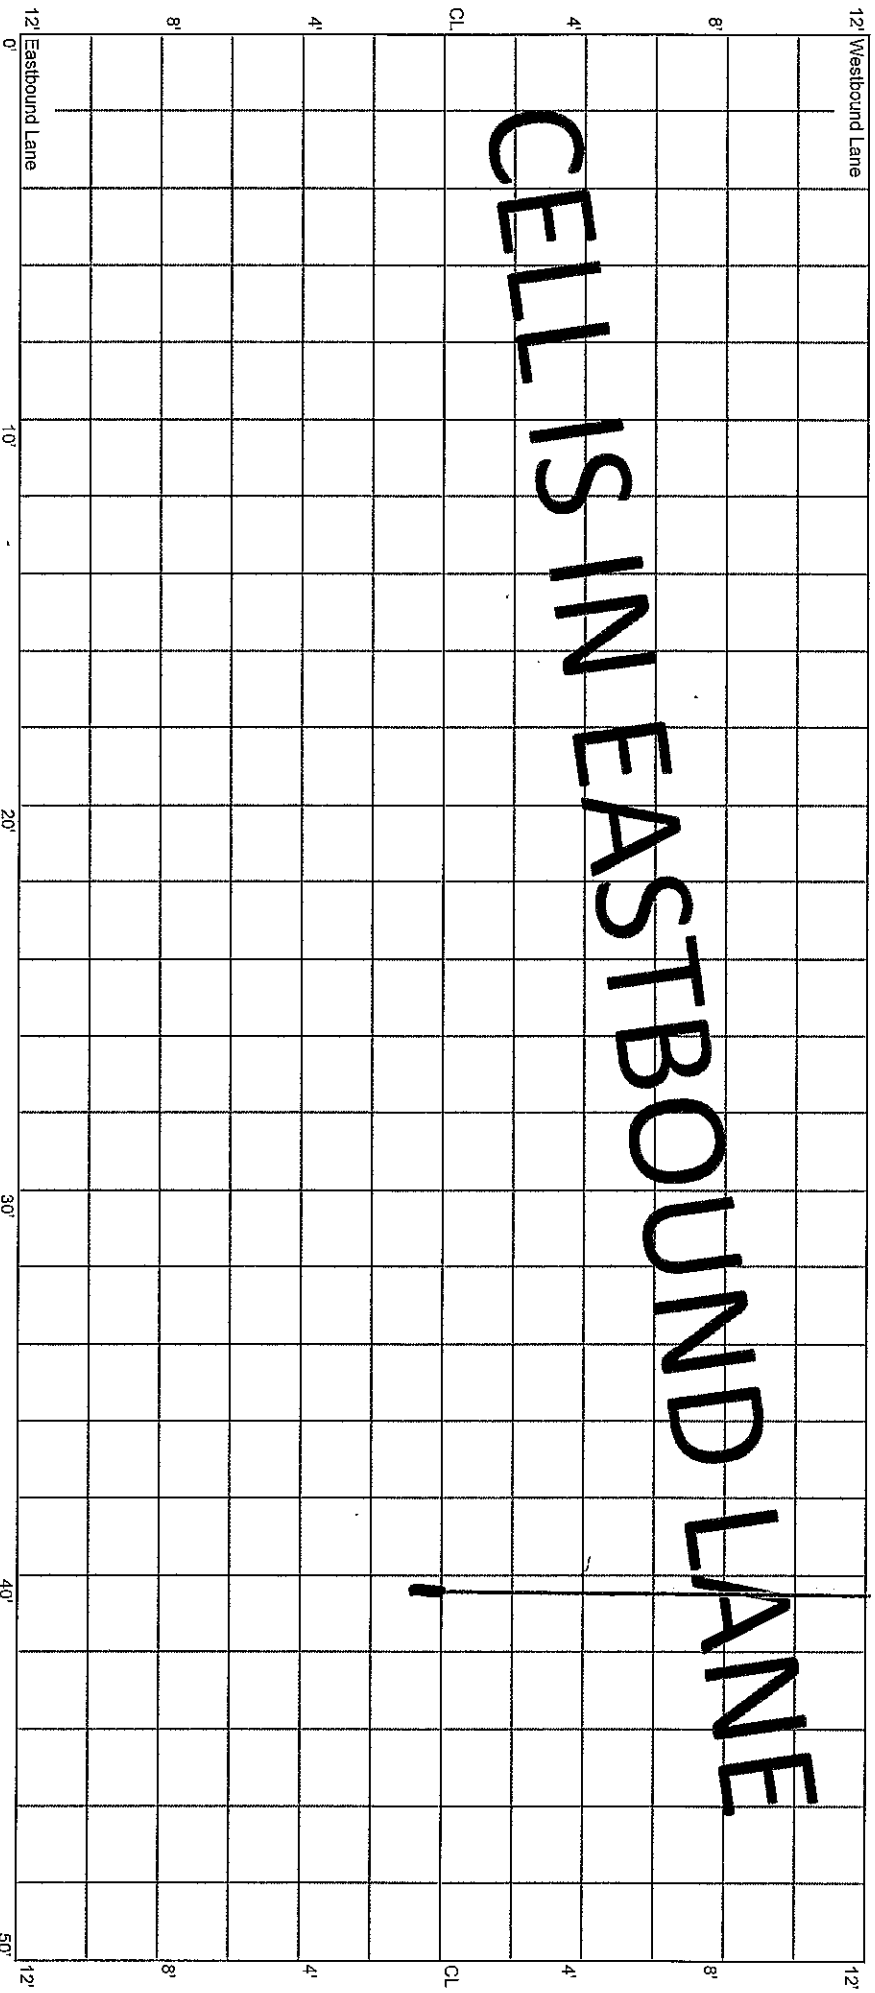

CELL 7005E
100 - 150 ft

23+00


23+50

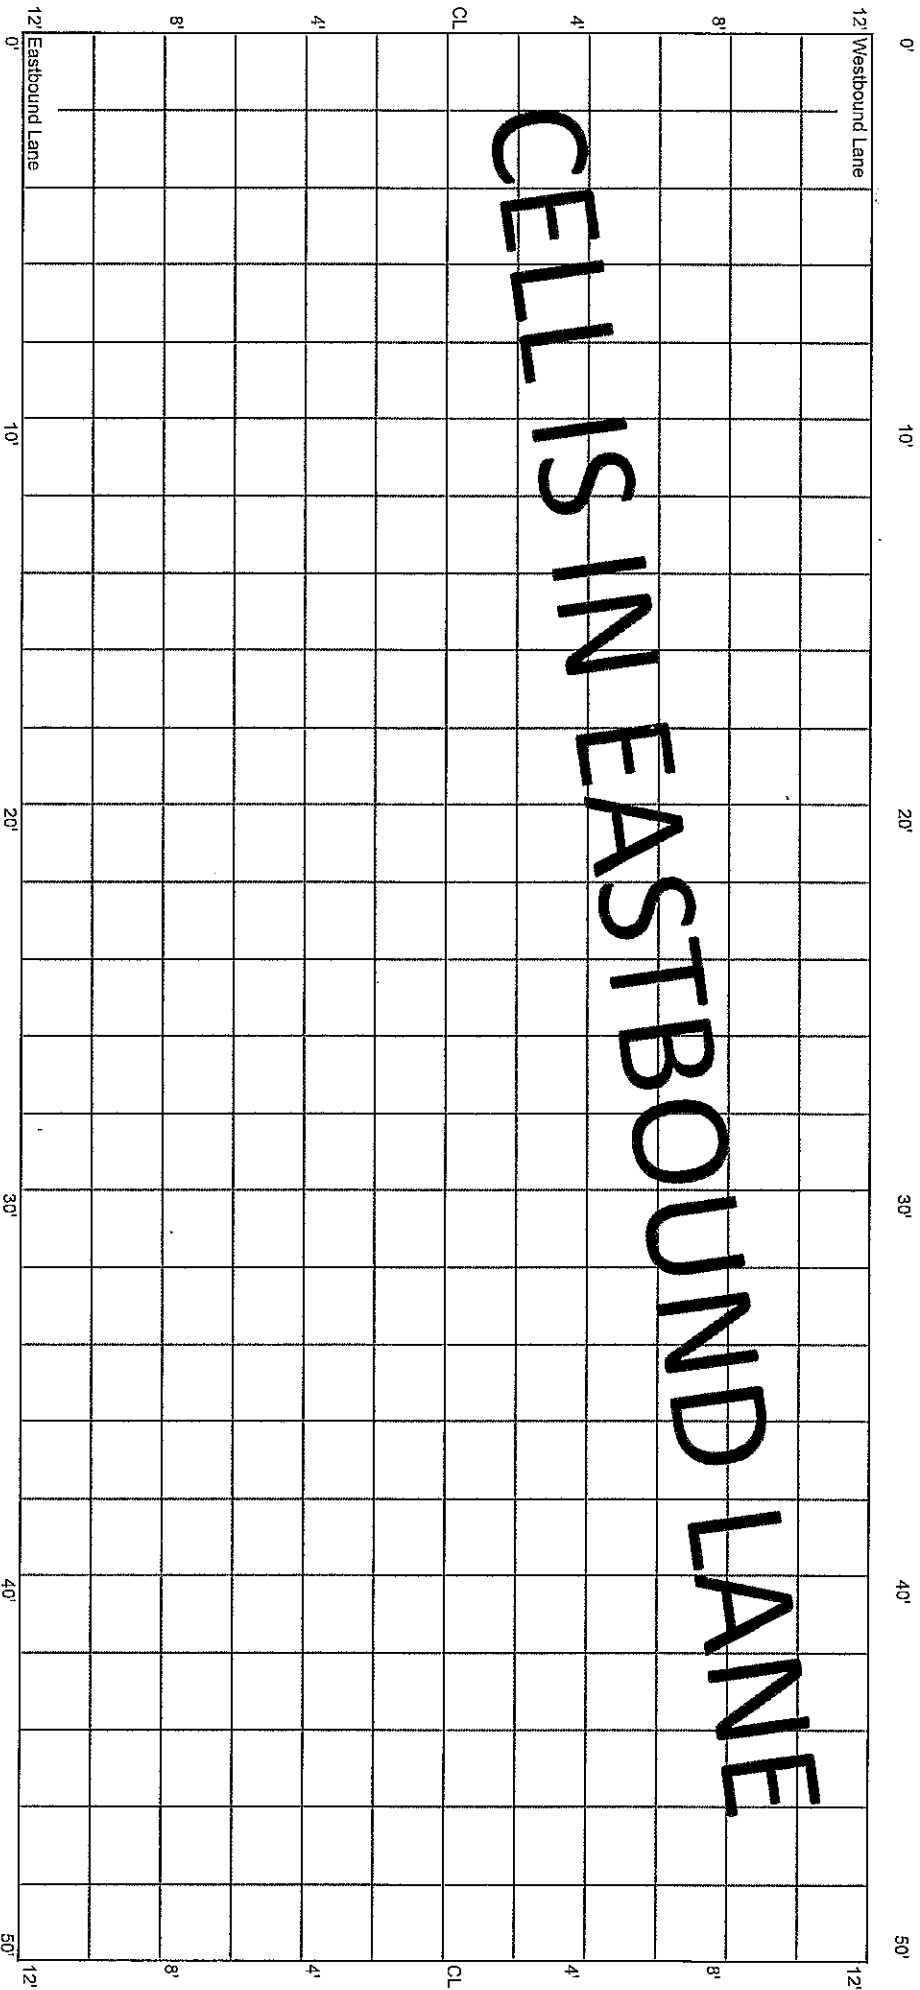

CELL 7005E
150 - 200 ft

23+50


24+00

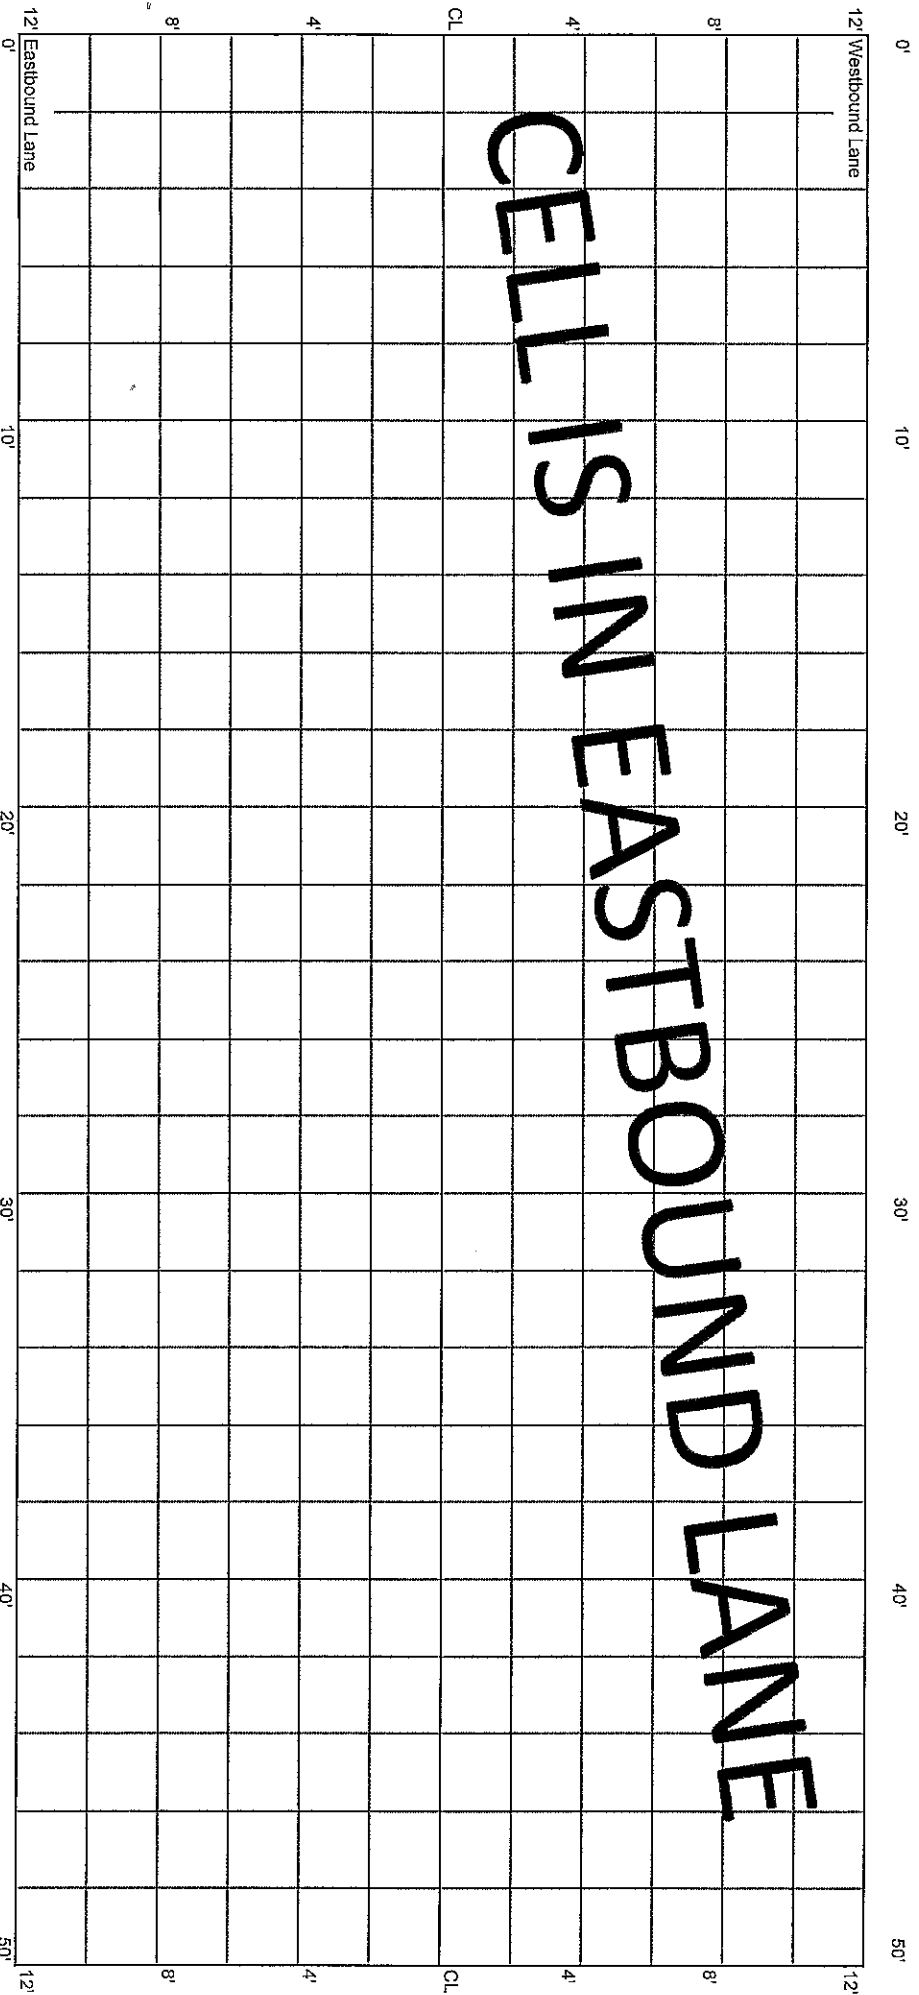

CELL 7005E
200 - 250 ft


24+00

24+50

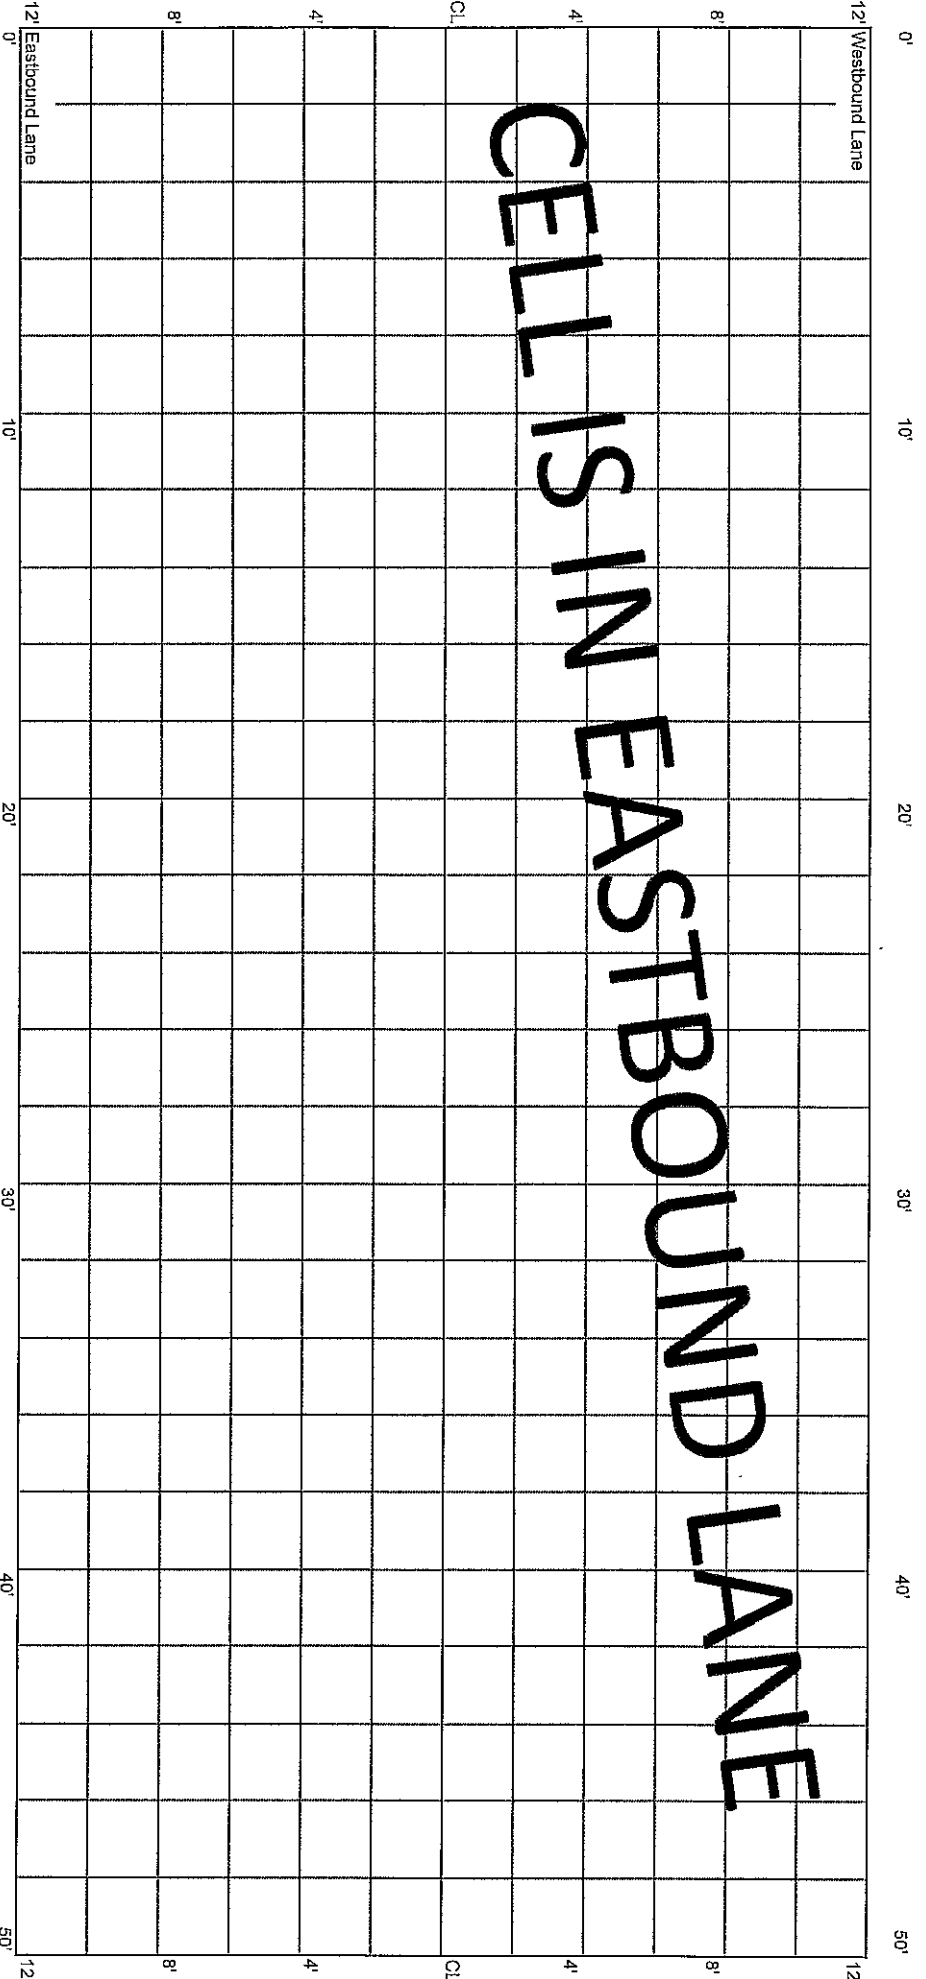

200-227
Sub/Edge OK


CELL 7005E
250 - 300 ft

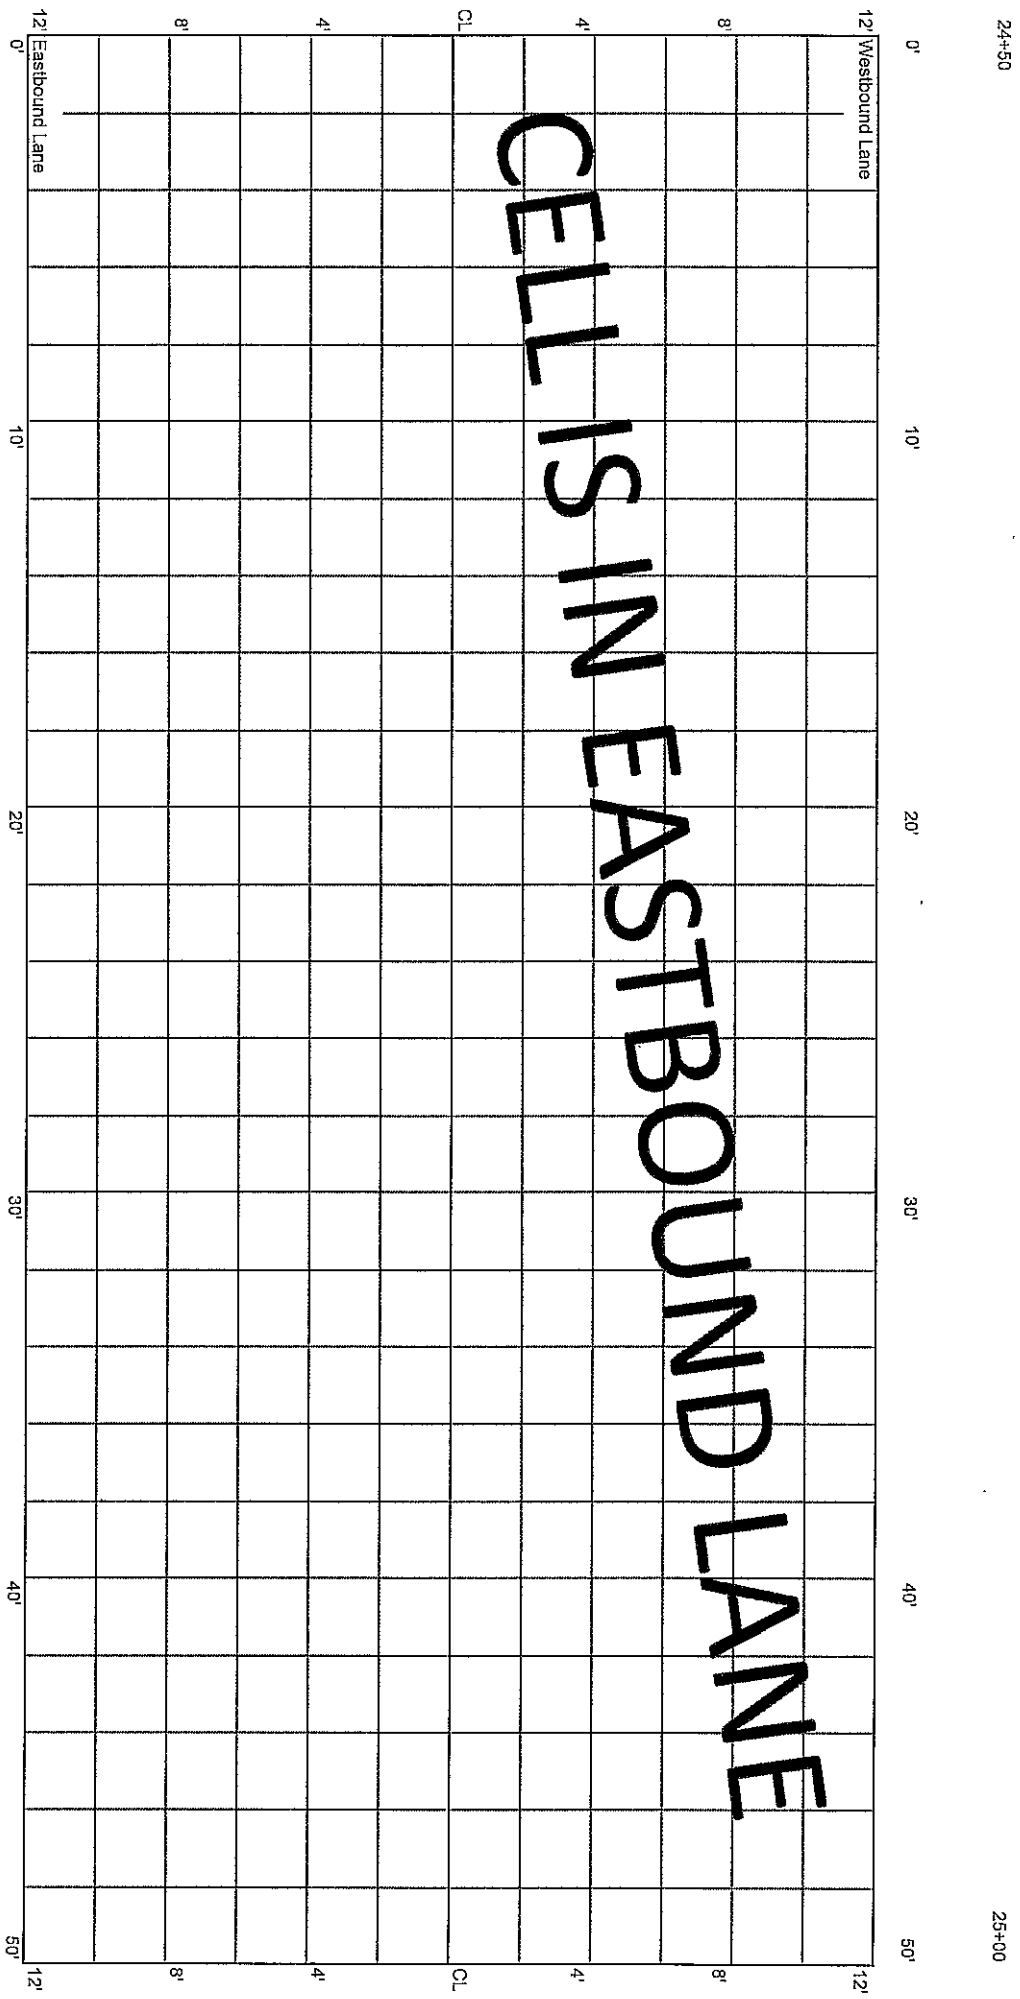

CELL 7005E
300 - 350 ft

25+00


25+50

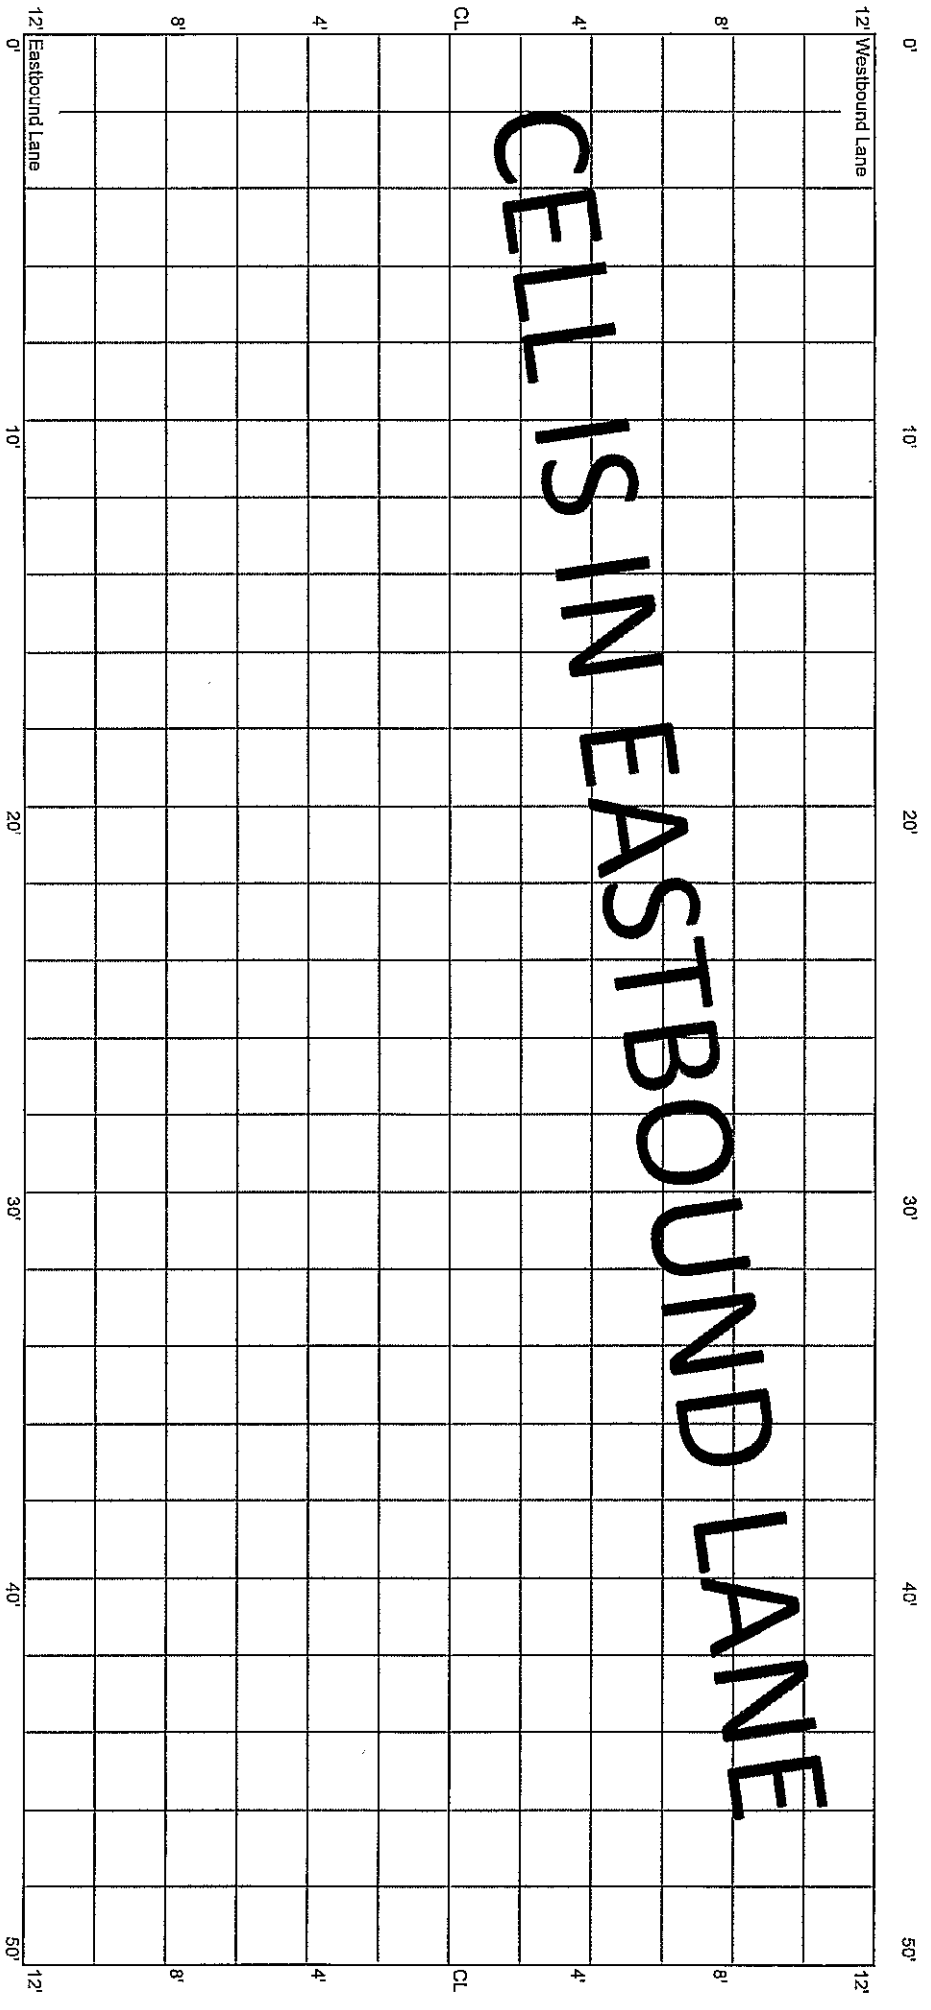

CELL 7005E
350 - 400 ft

25+50


26+00

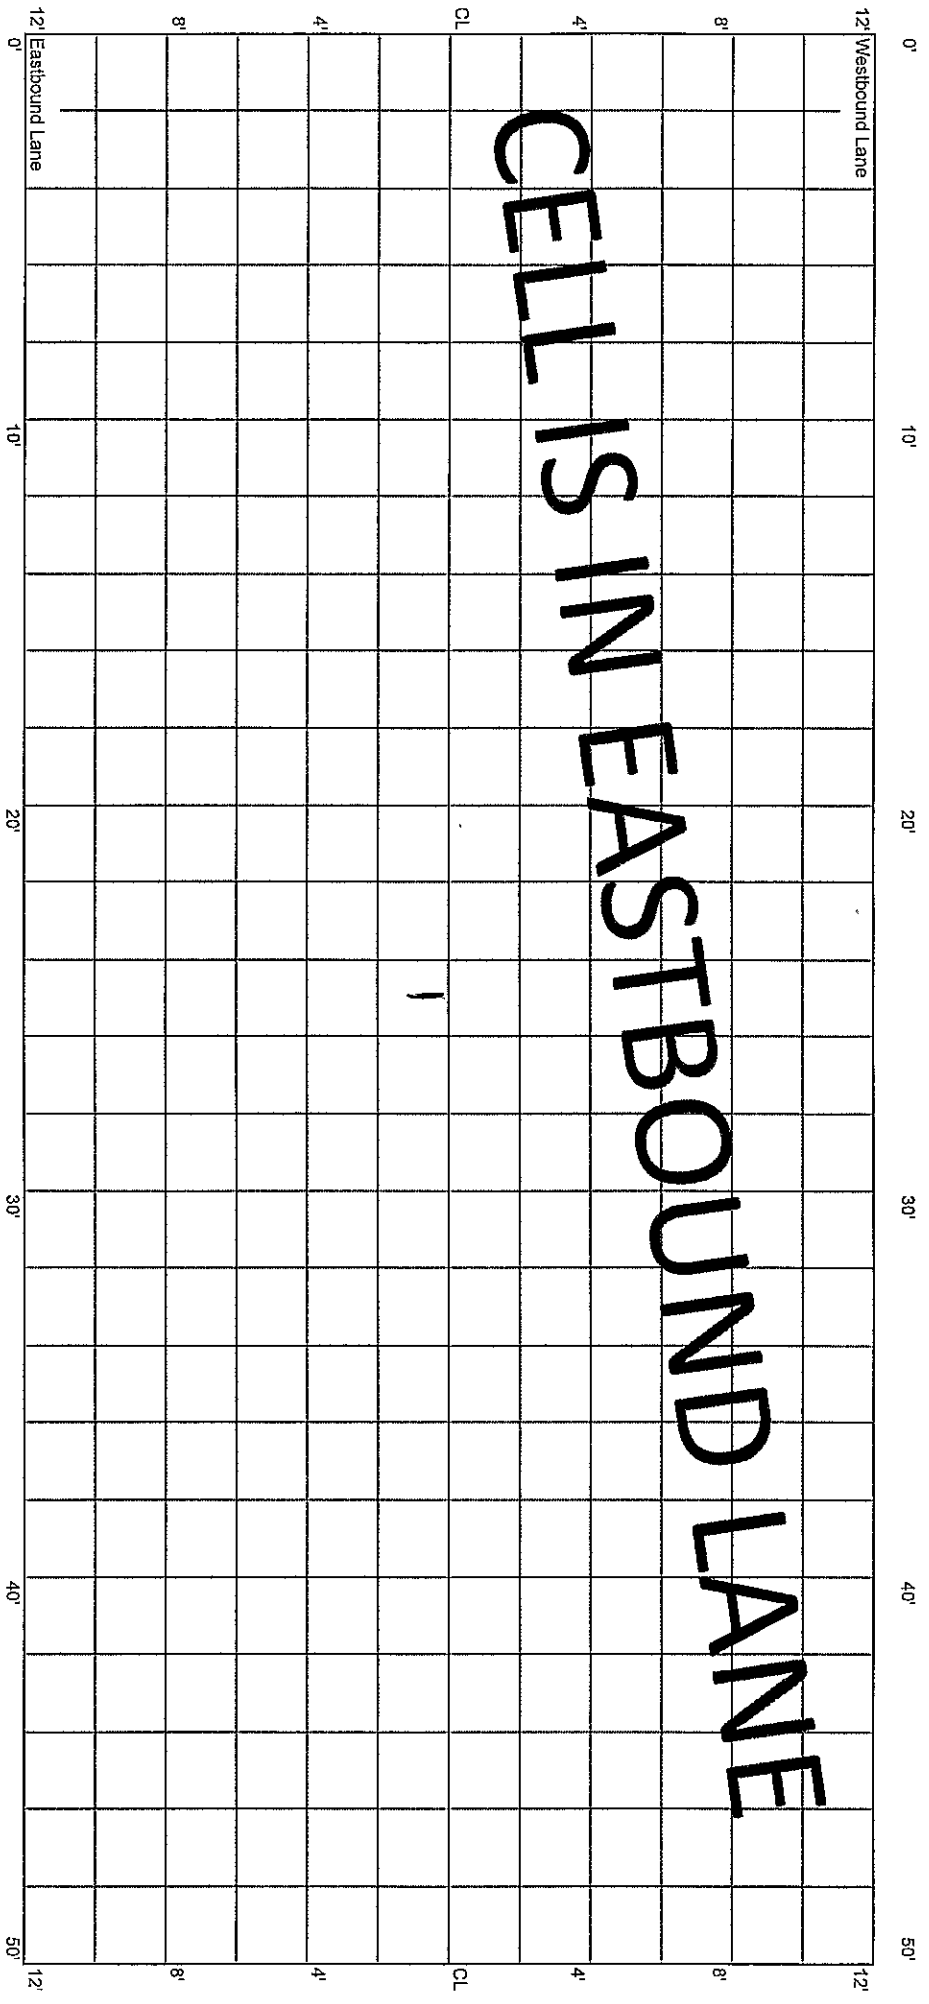

CELL 7005E
400 - 450 ft

26+00

26+50

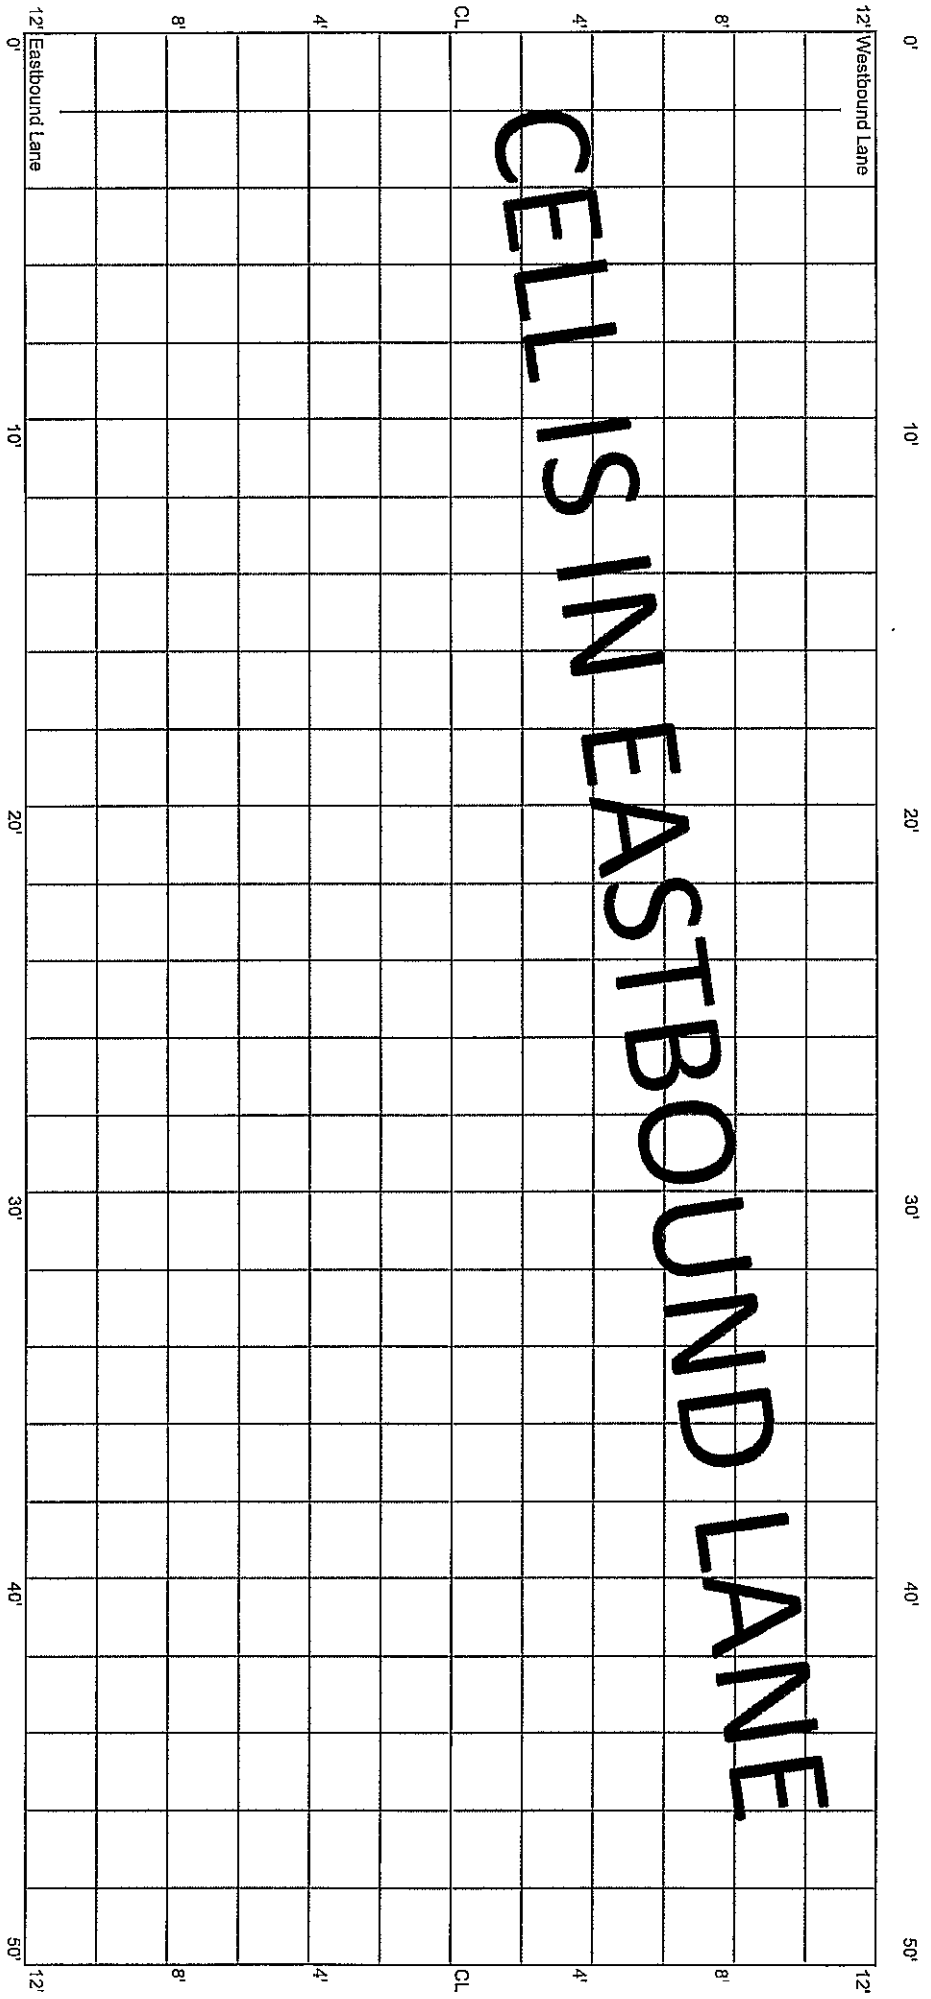

CELL 7005E
450 - 500 ft

26+50
26+58
CL KITTRIDGE

0' 10' 20' 30' 40' 50'

12' Westbound Lane 0' 10' 20' 30' 40' 50' 12' Eastbound Lane

CELLS IN EASTBOUND LANE



Wright Co
Survey Marker

CELL 7005E
500 - 550 ft

27+00

16+25

27+50

