


5,28,20 EST. - No Distress
10.14.20 - No Distress
1.14.21 - No Distress

CELL 7006W
0 - 50 ft

32+50


32+00

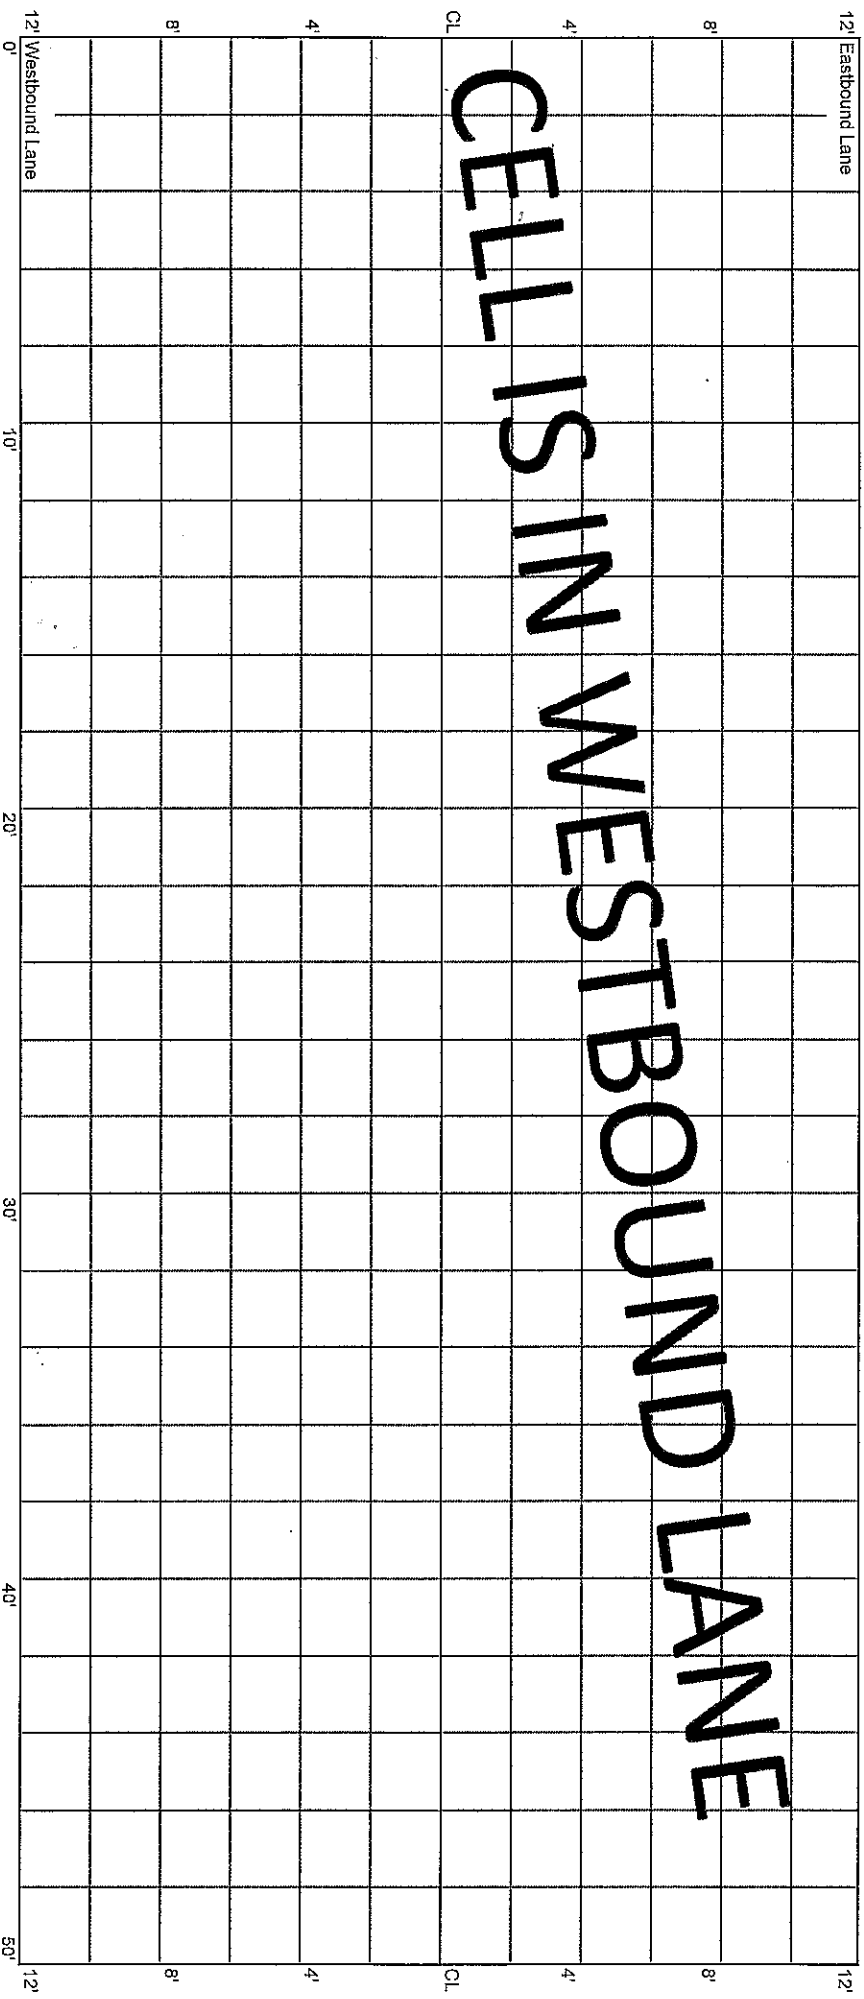

CELL 7006W
50 - 100 ft

32+00


31+50

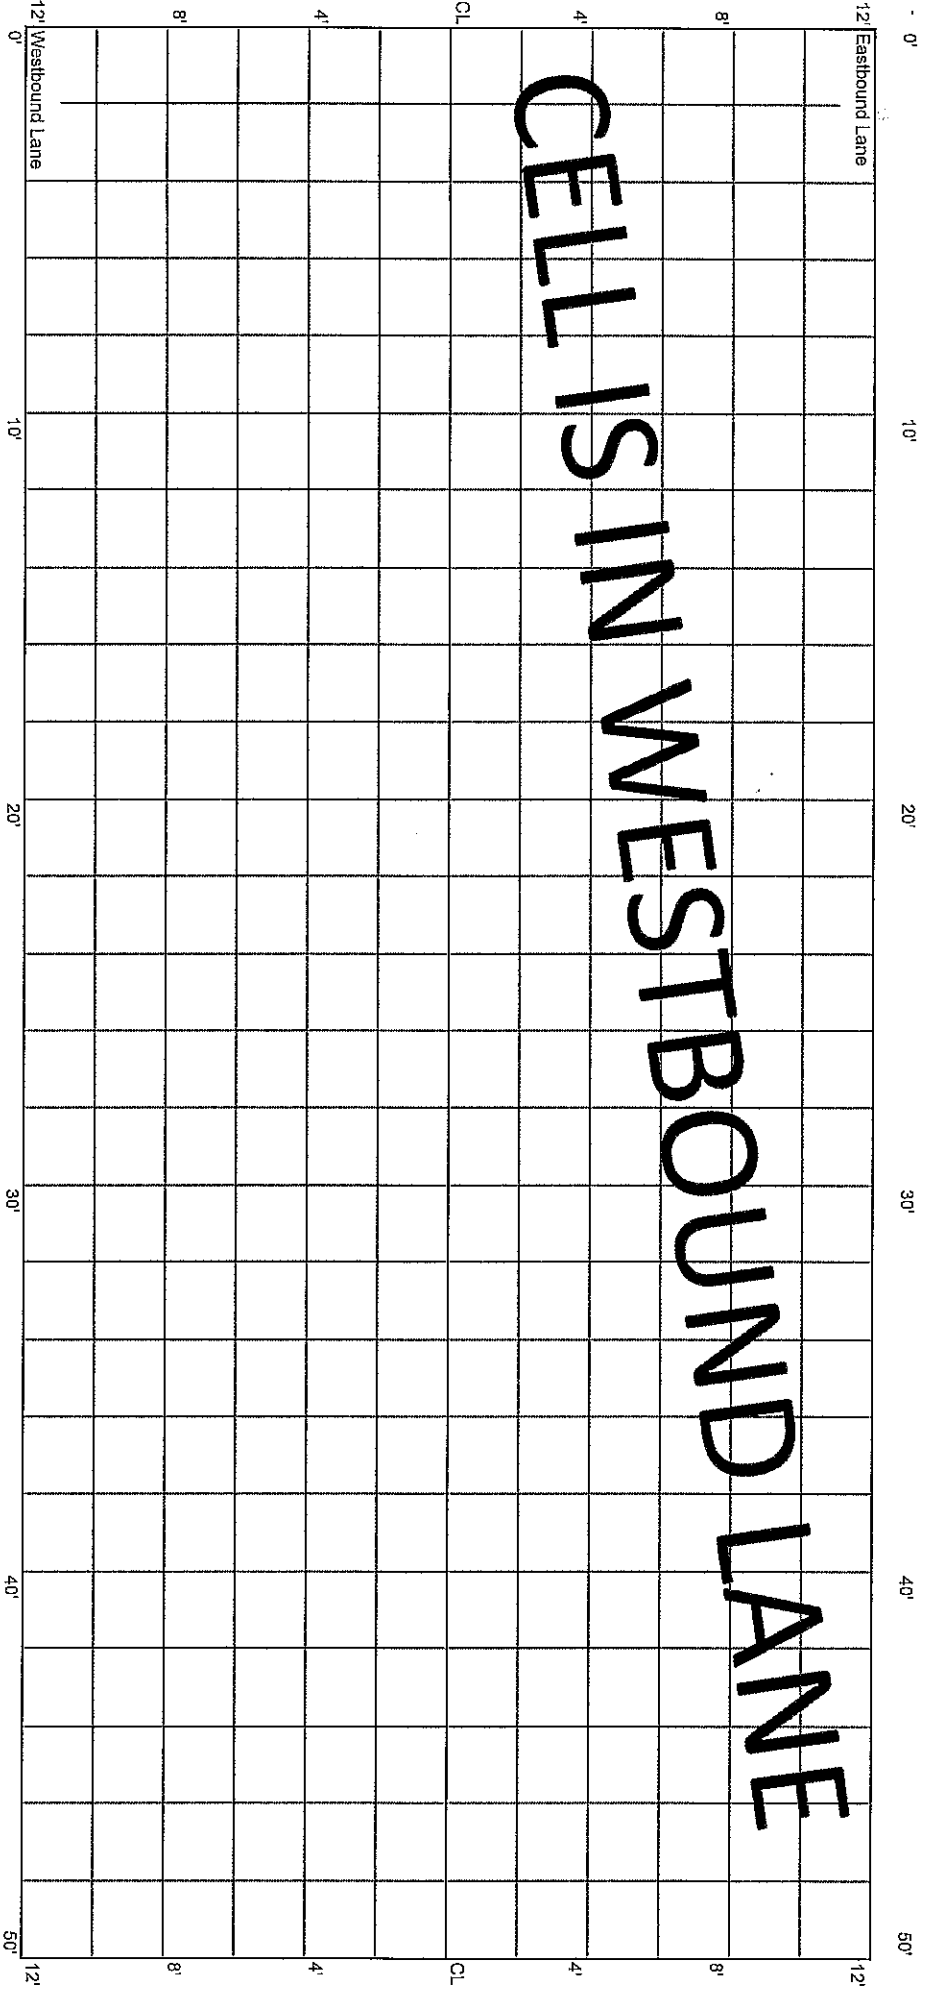

CELL 7006W
100 - 150 ft

31+50


31+00

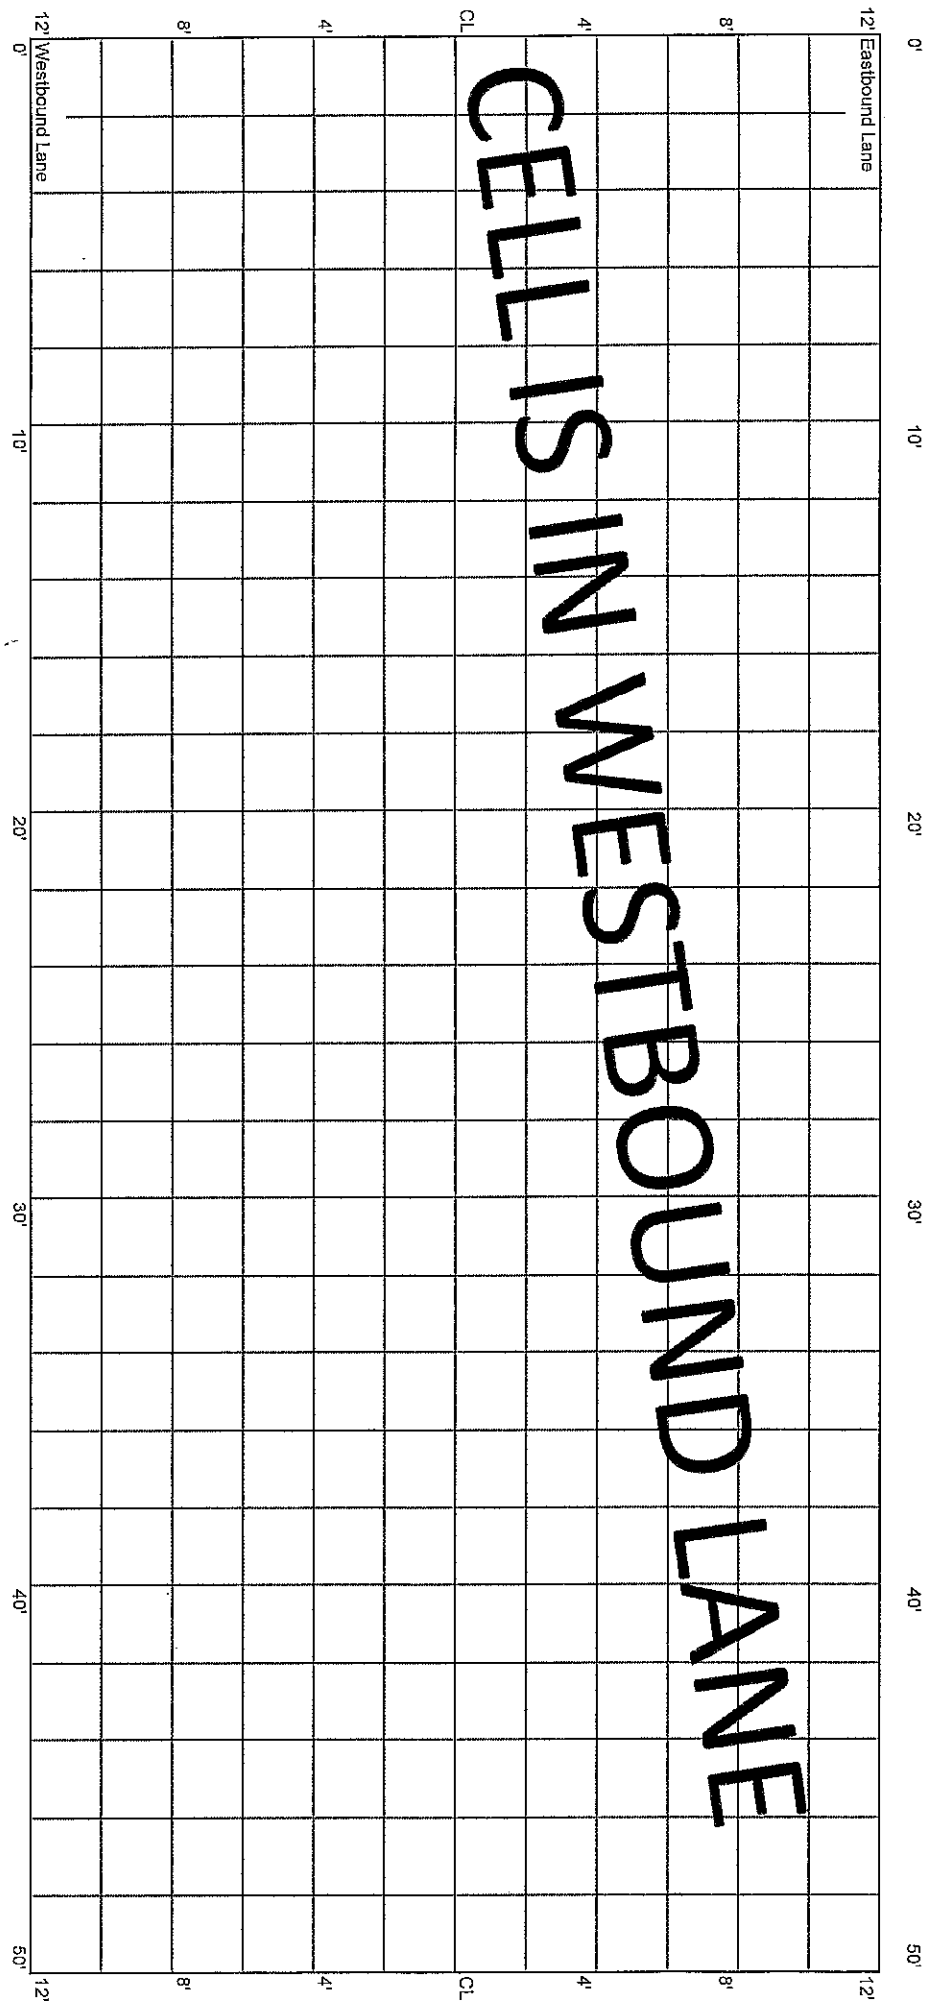

CELL 7006W
150 - 200 ft

31+00


30+50

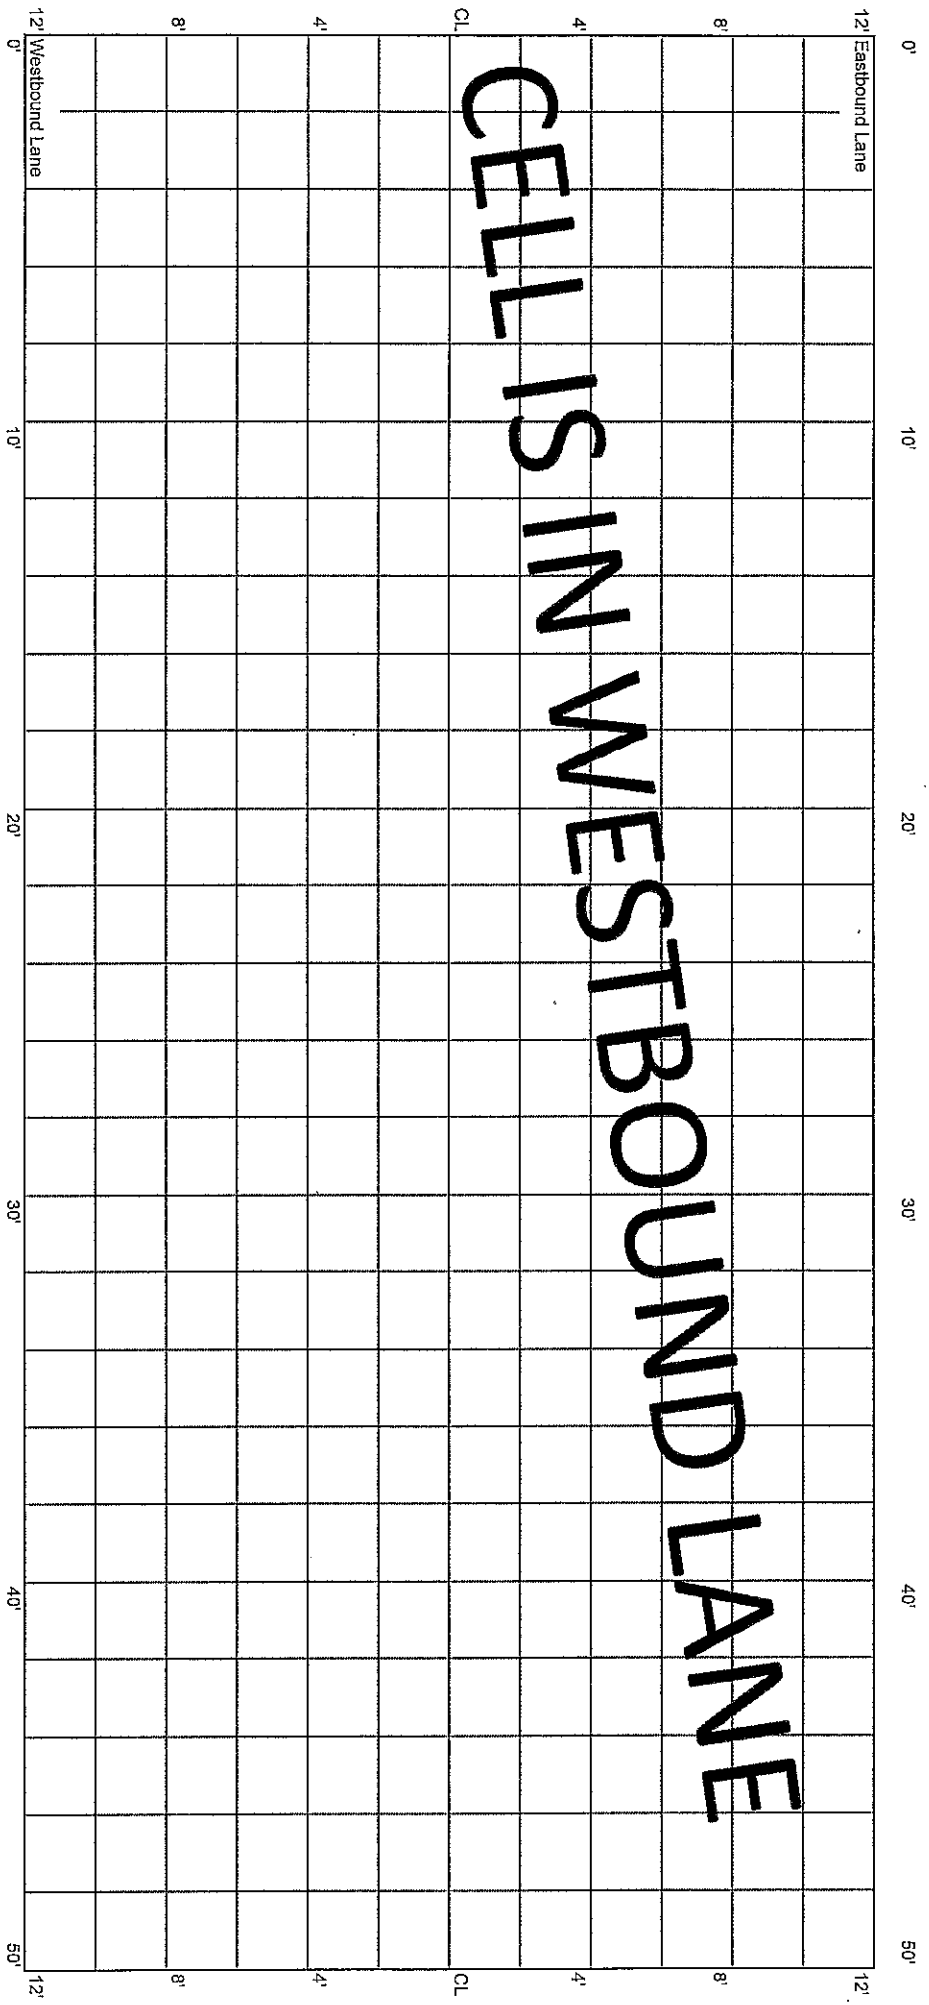

CELL 7006W
200 - 250 ft

30+50


30+00

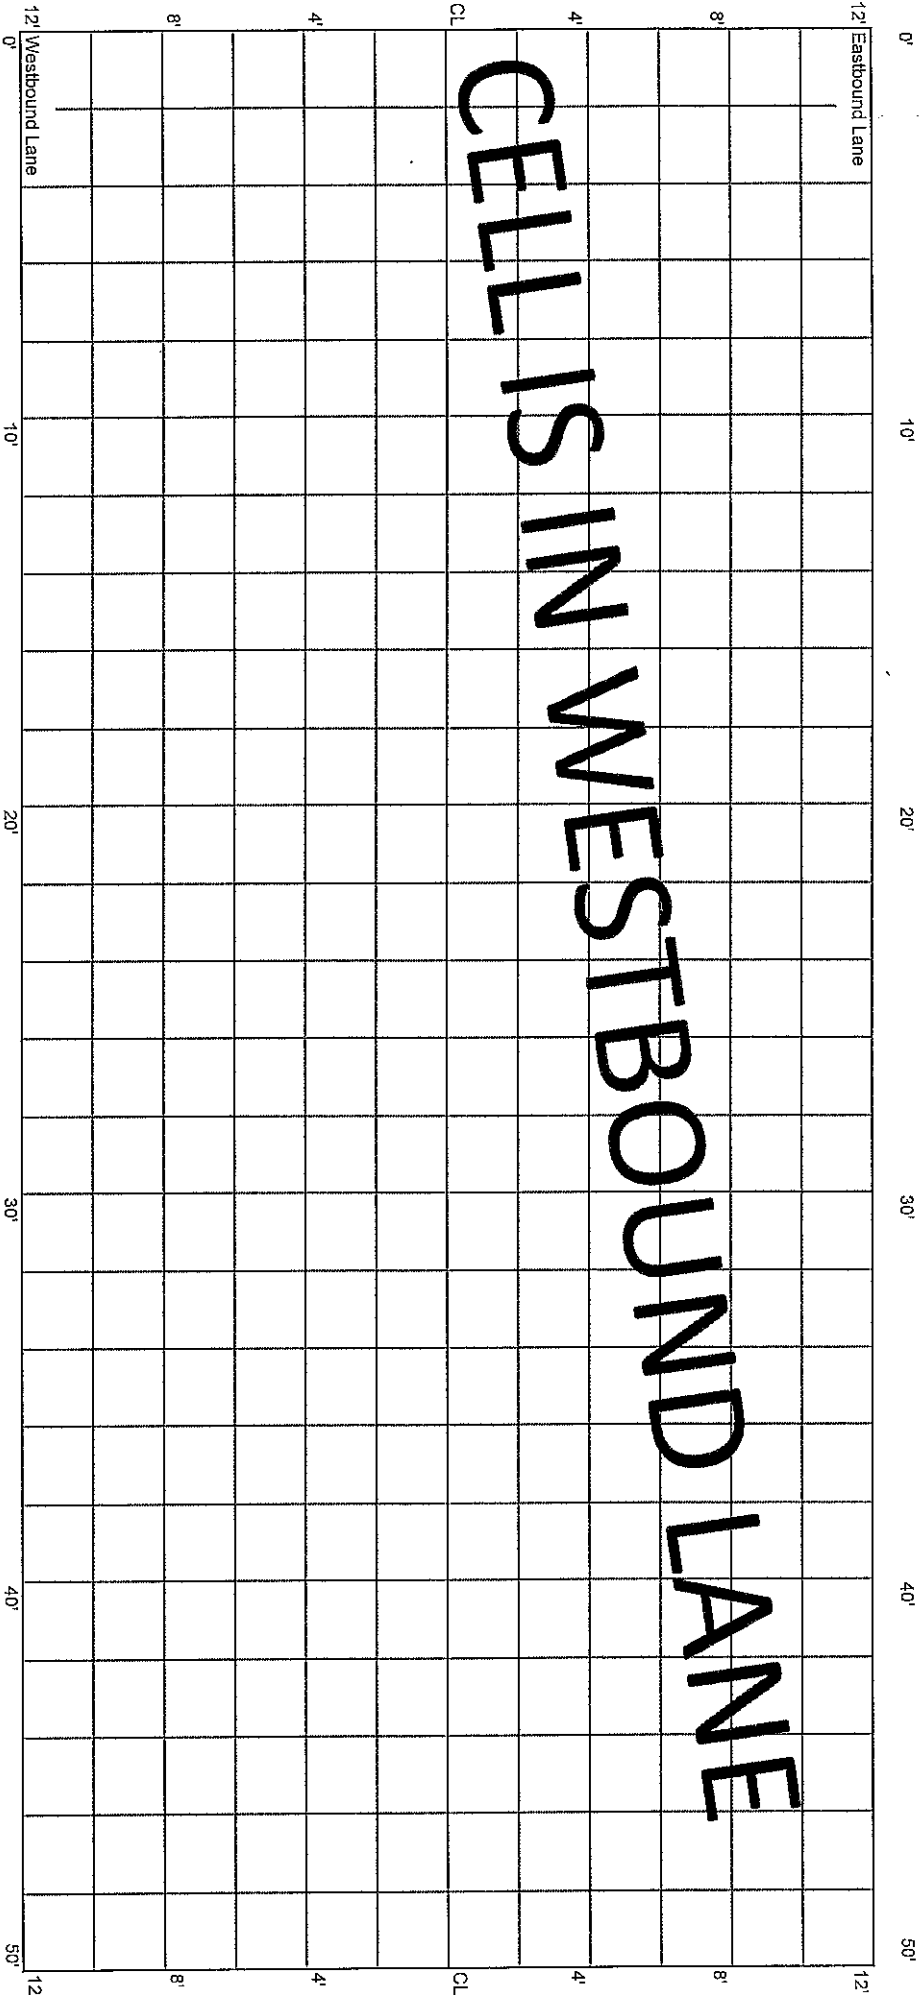

CELL 7006W
250 - 300 ft

30+00


29+50

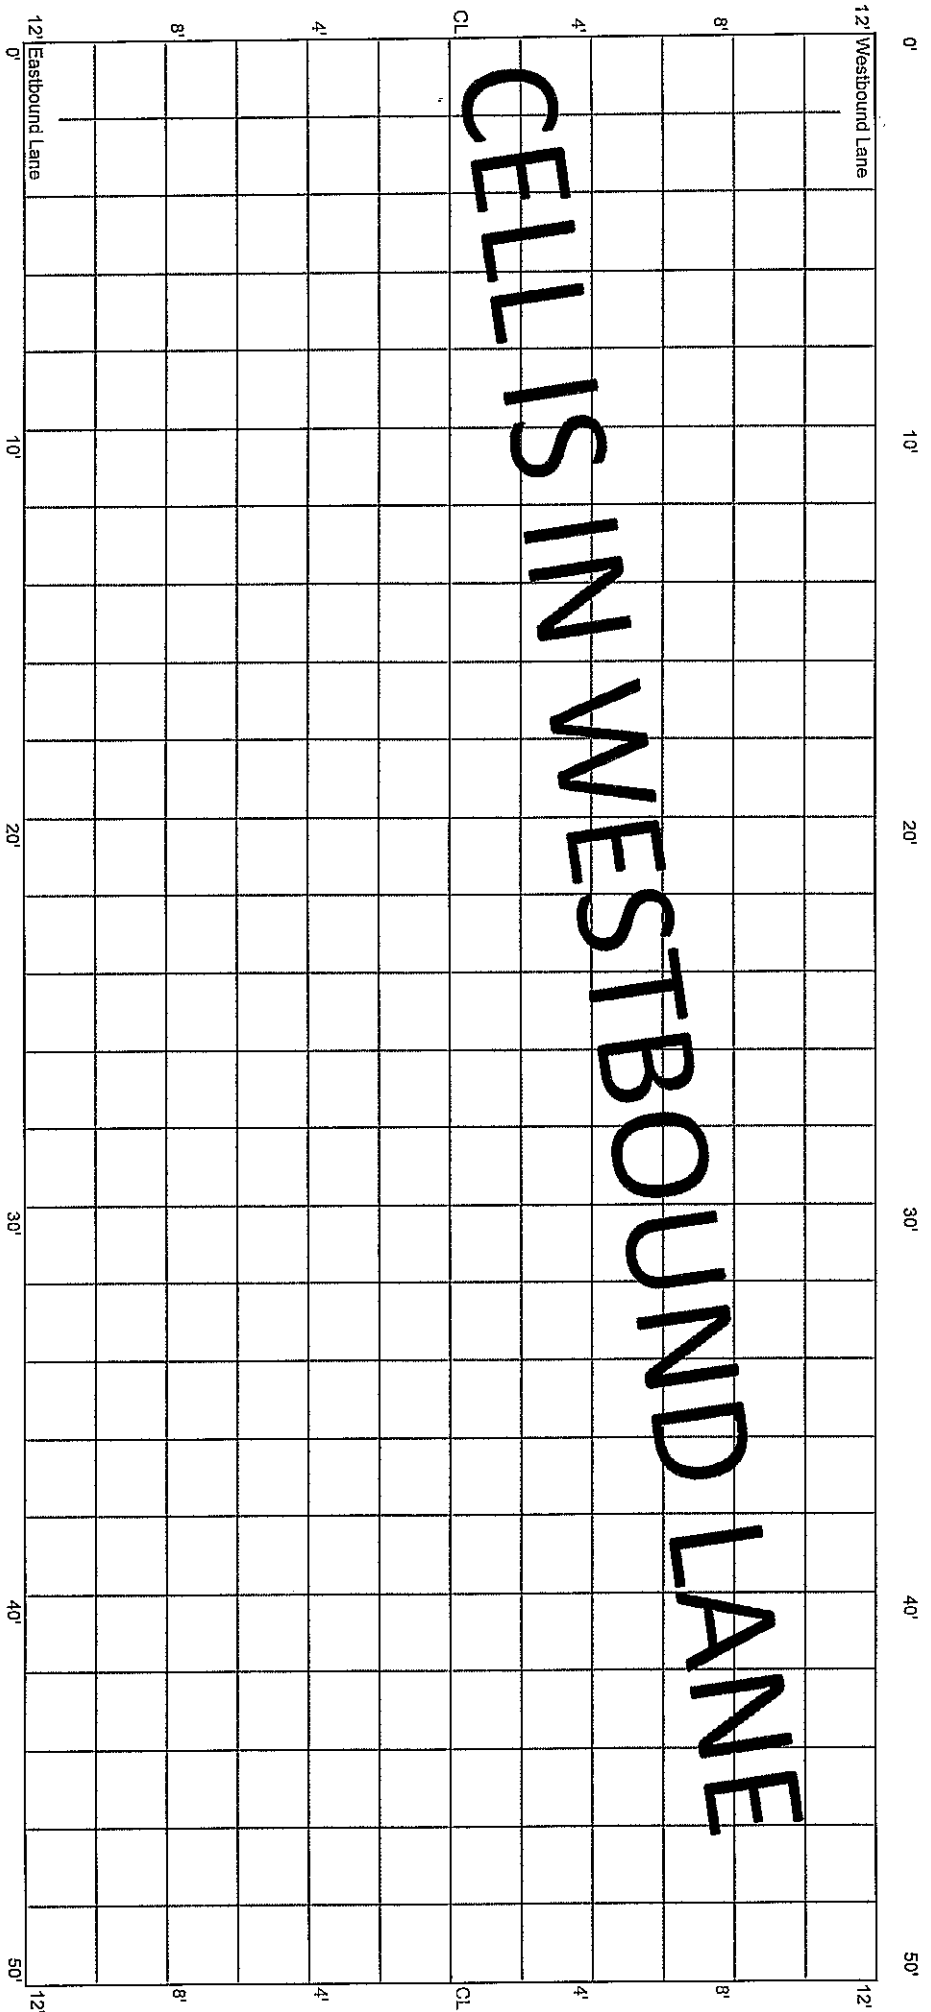

CELL 7006W
300 - 350 ft

29+50


29+00

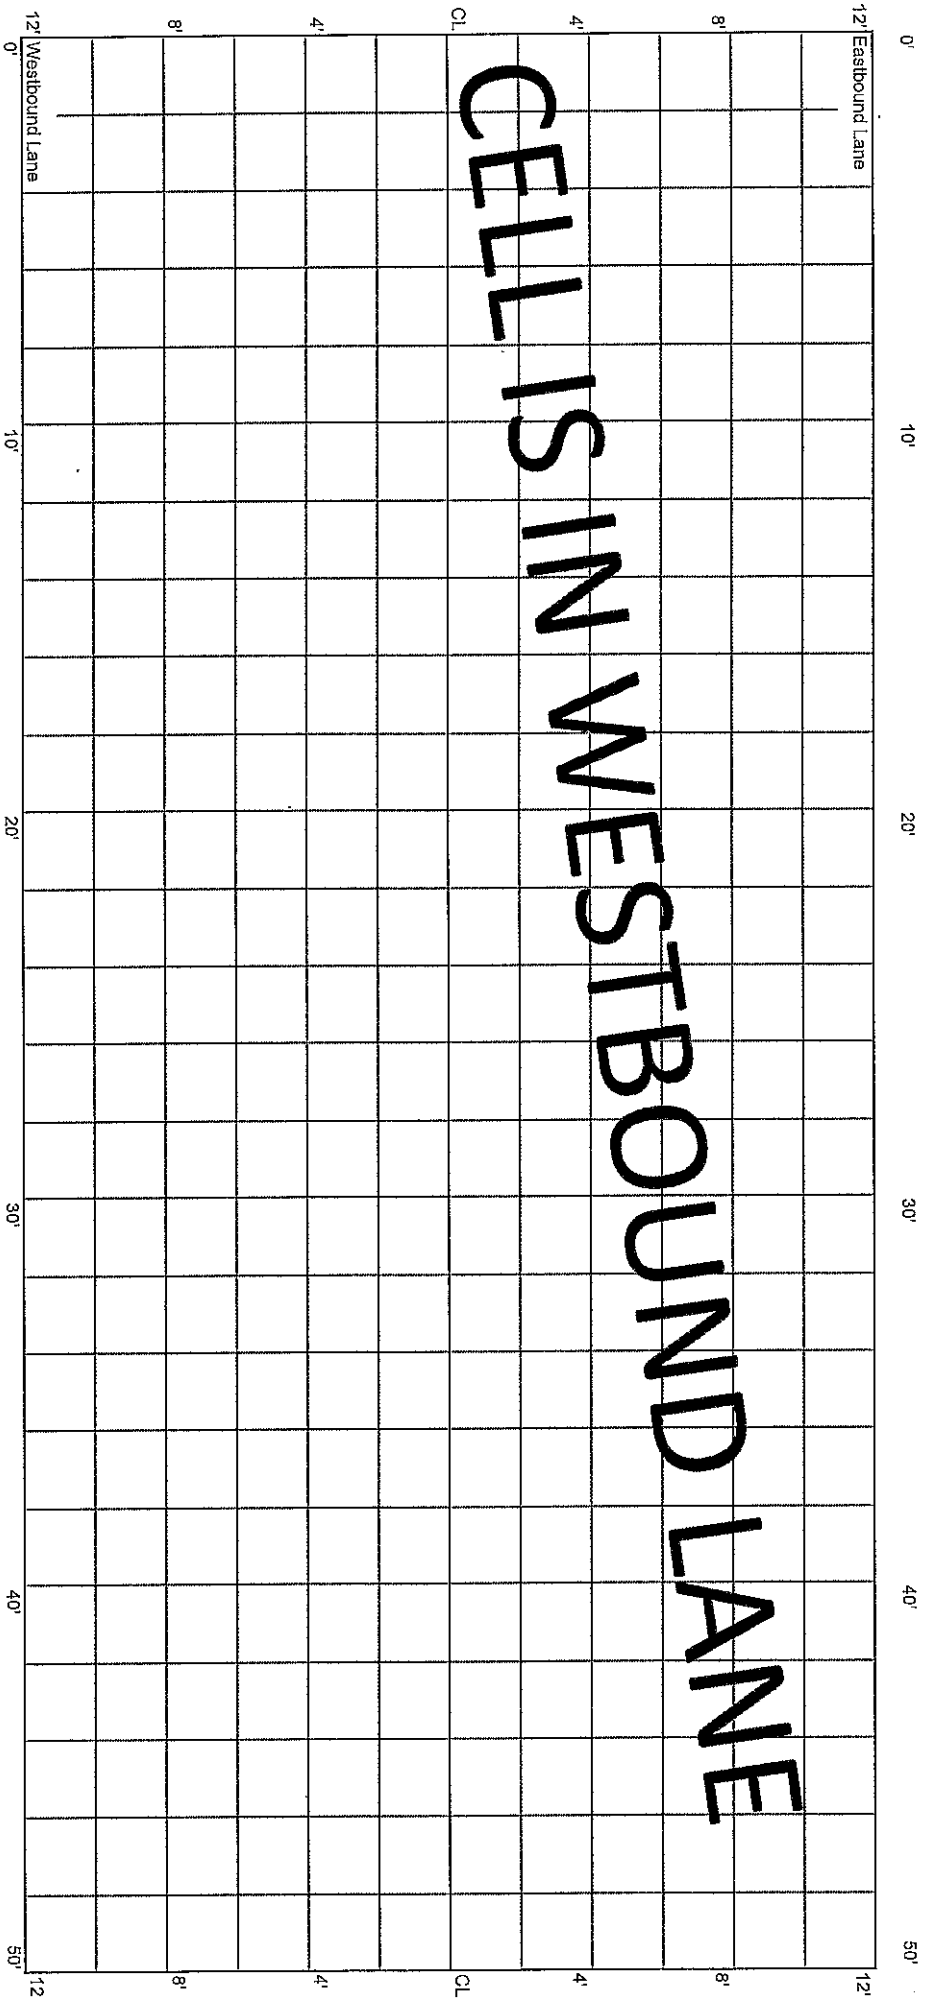

CELL 7006W
350 - 400 ft

29+00


28+50

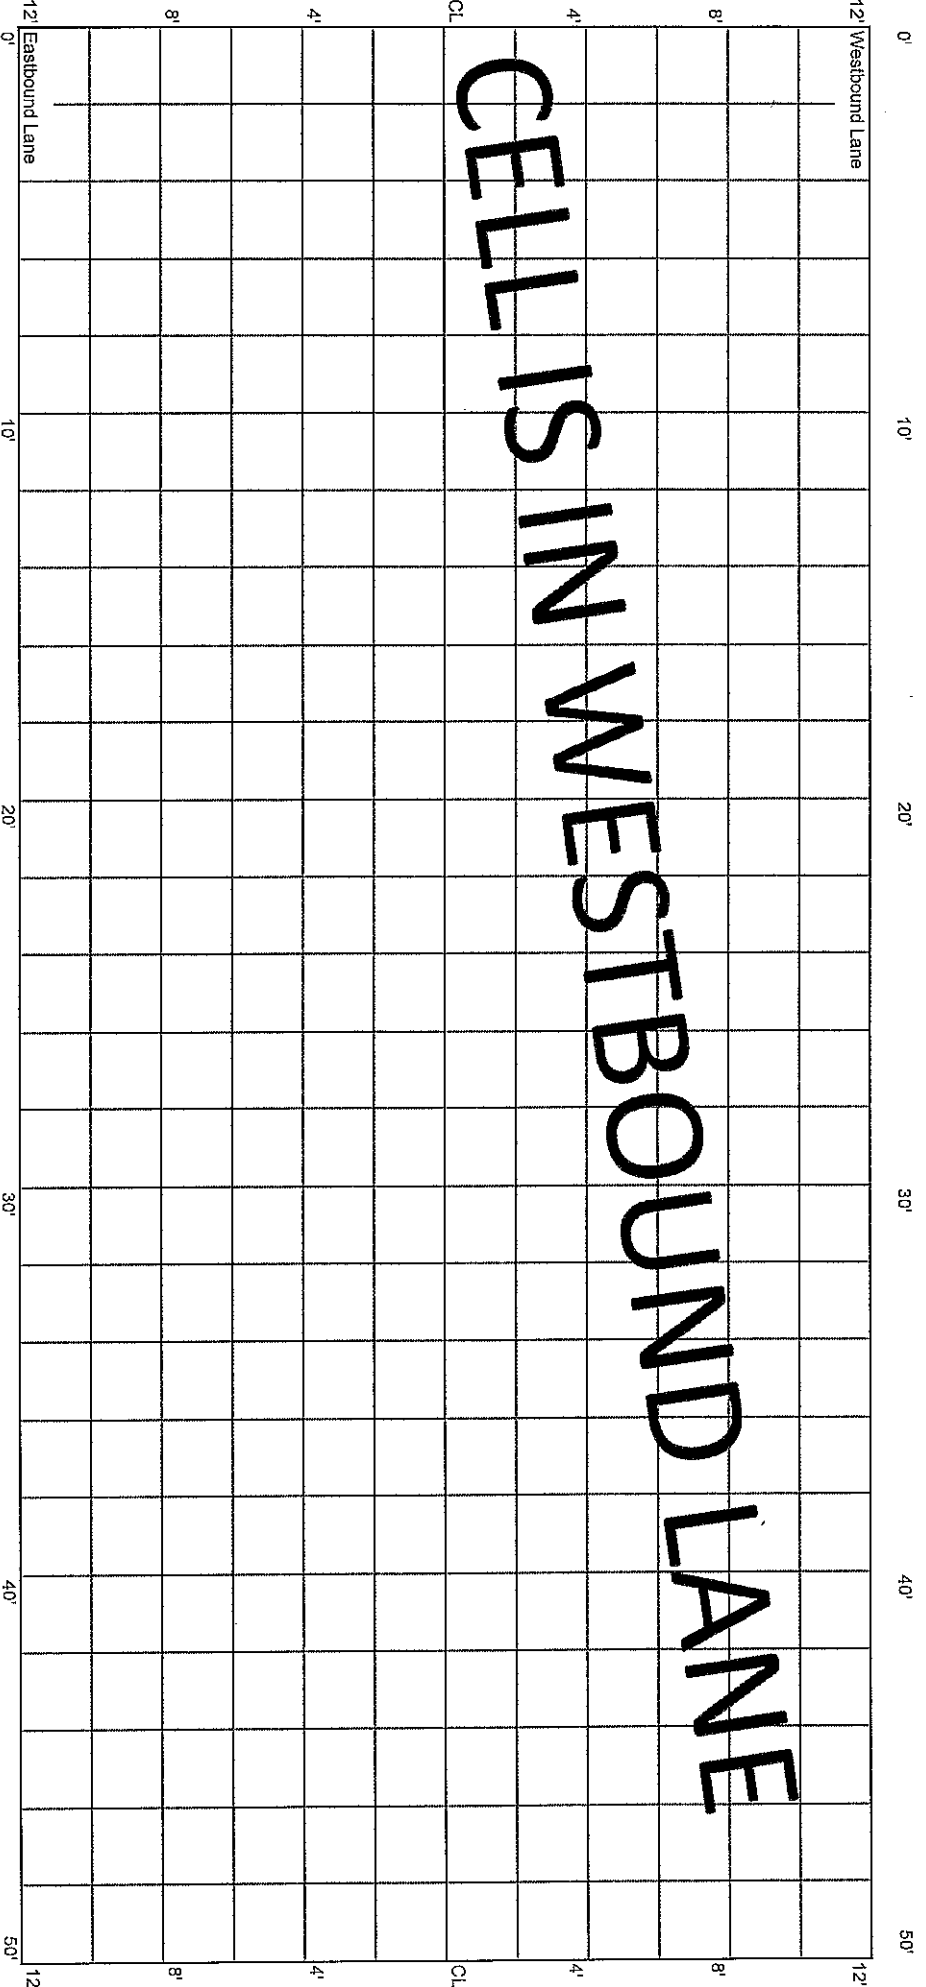

CELL 7006W
400 - 450 ft

28+50


28+00

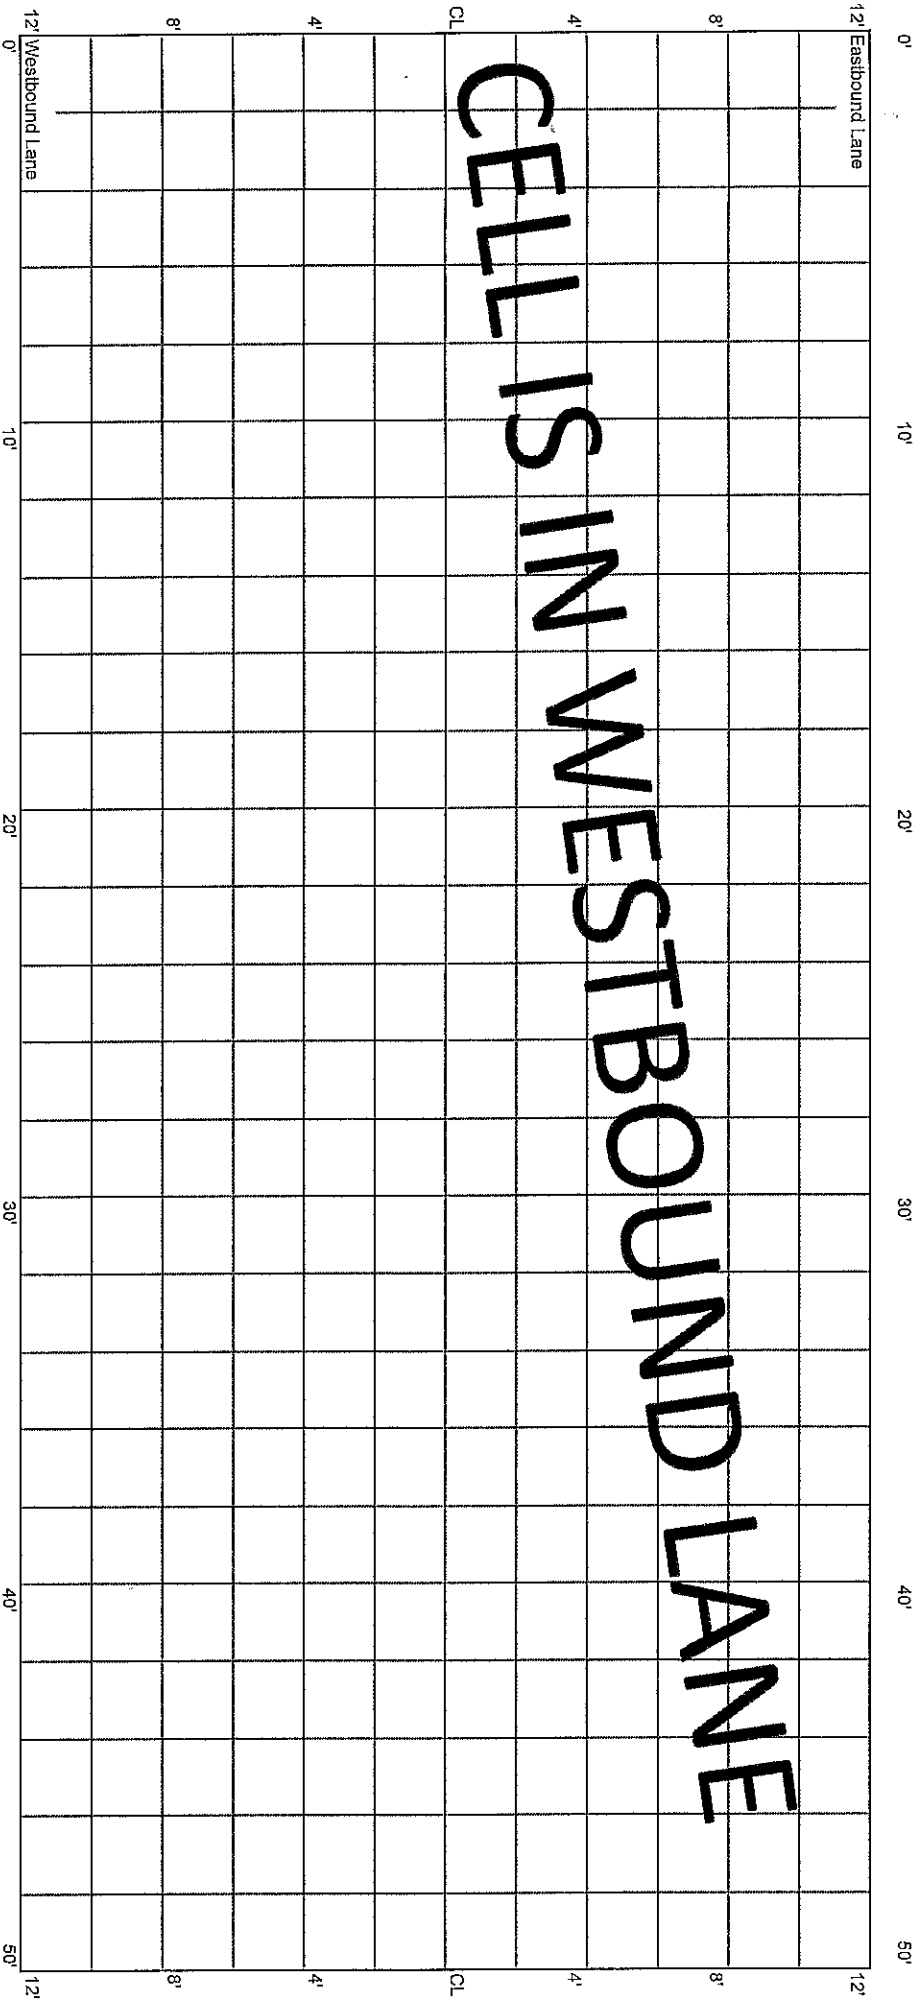

CELL 7006W
450 - 500 ft

28+00

27+50

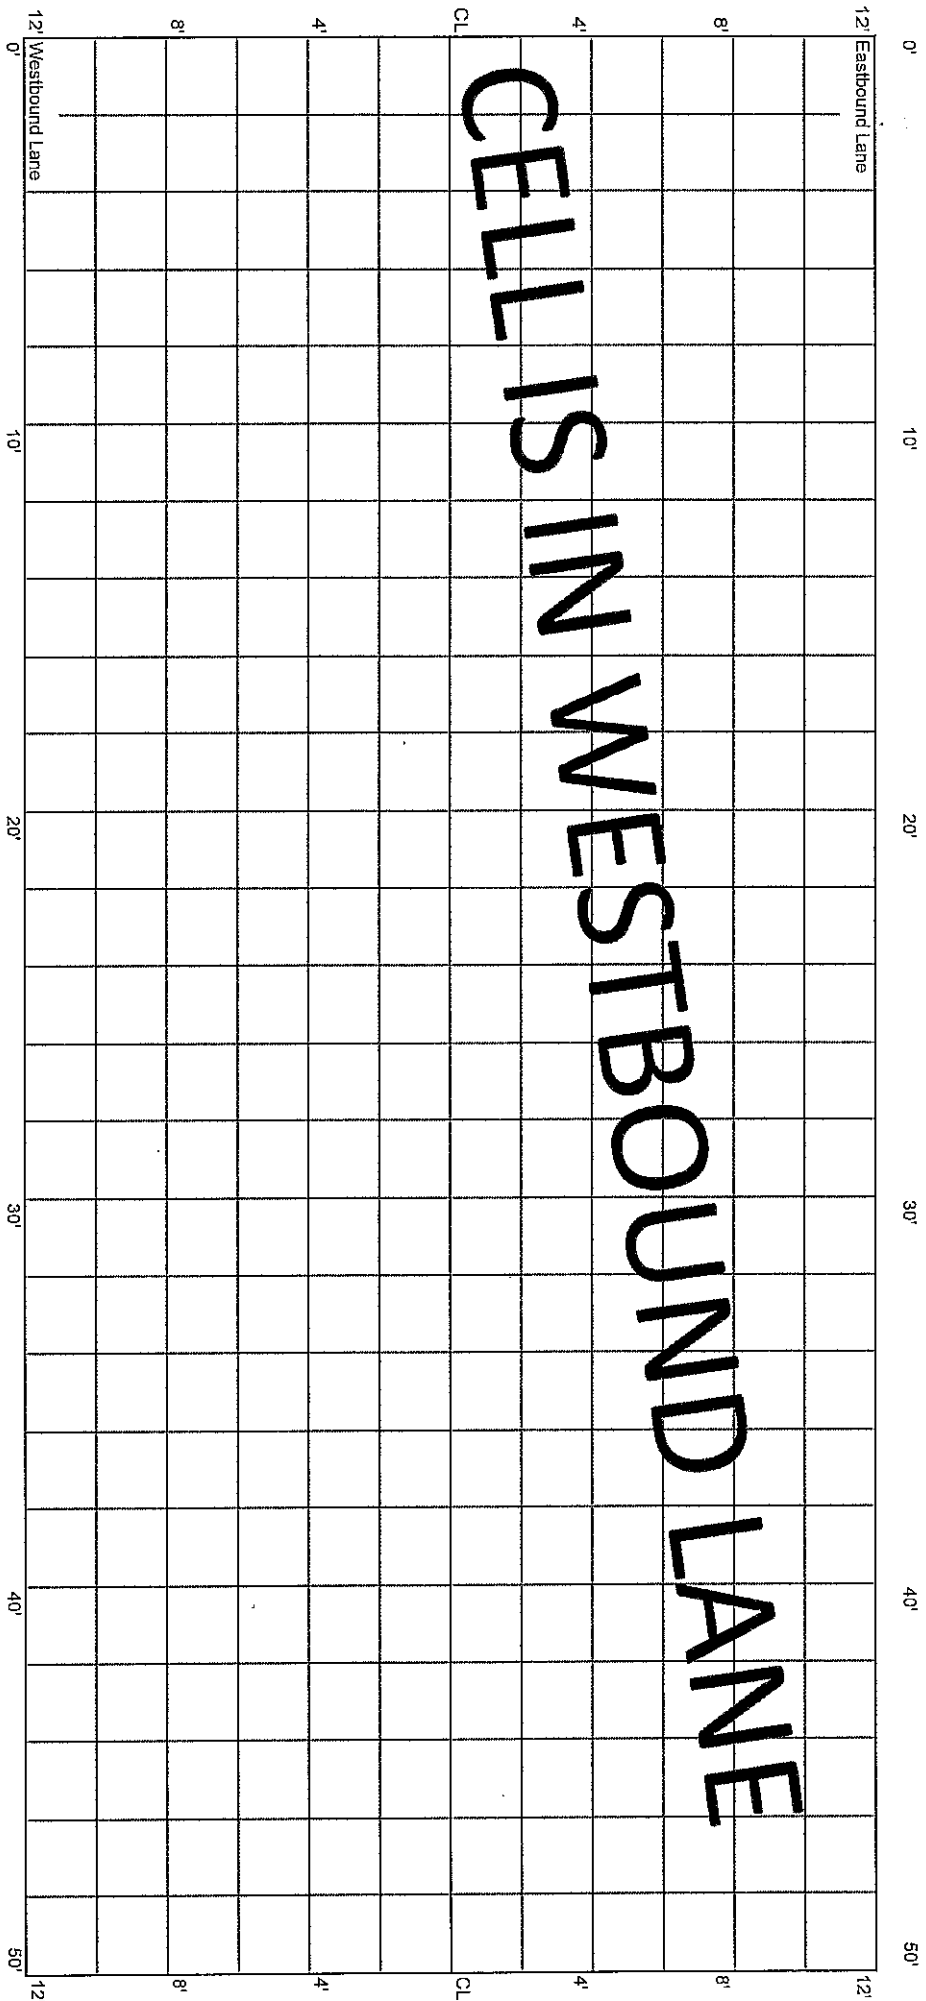

10'

20'

30'

40'

50'

12' Eastbound Lane

12' Westbound Lane

8'

8'

4'

4'

CL

CL

4'

4'

8'

8'

12' Westbound Lane

10'

20'

30'

40'

50'

CELL 7006W
500 - 550 ft

27+50

27+25

27+00

