

5,28.20 - E.S.

10.14.20


1.4.21

File 70TH ST

CELL 7008E  
0 - 50 ft

38+50

39+00

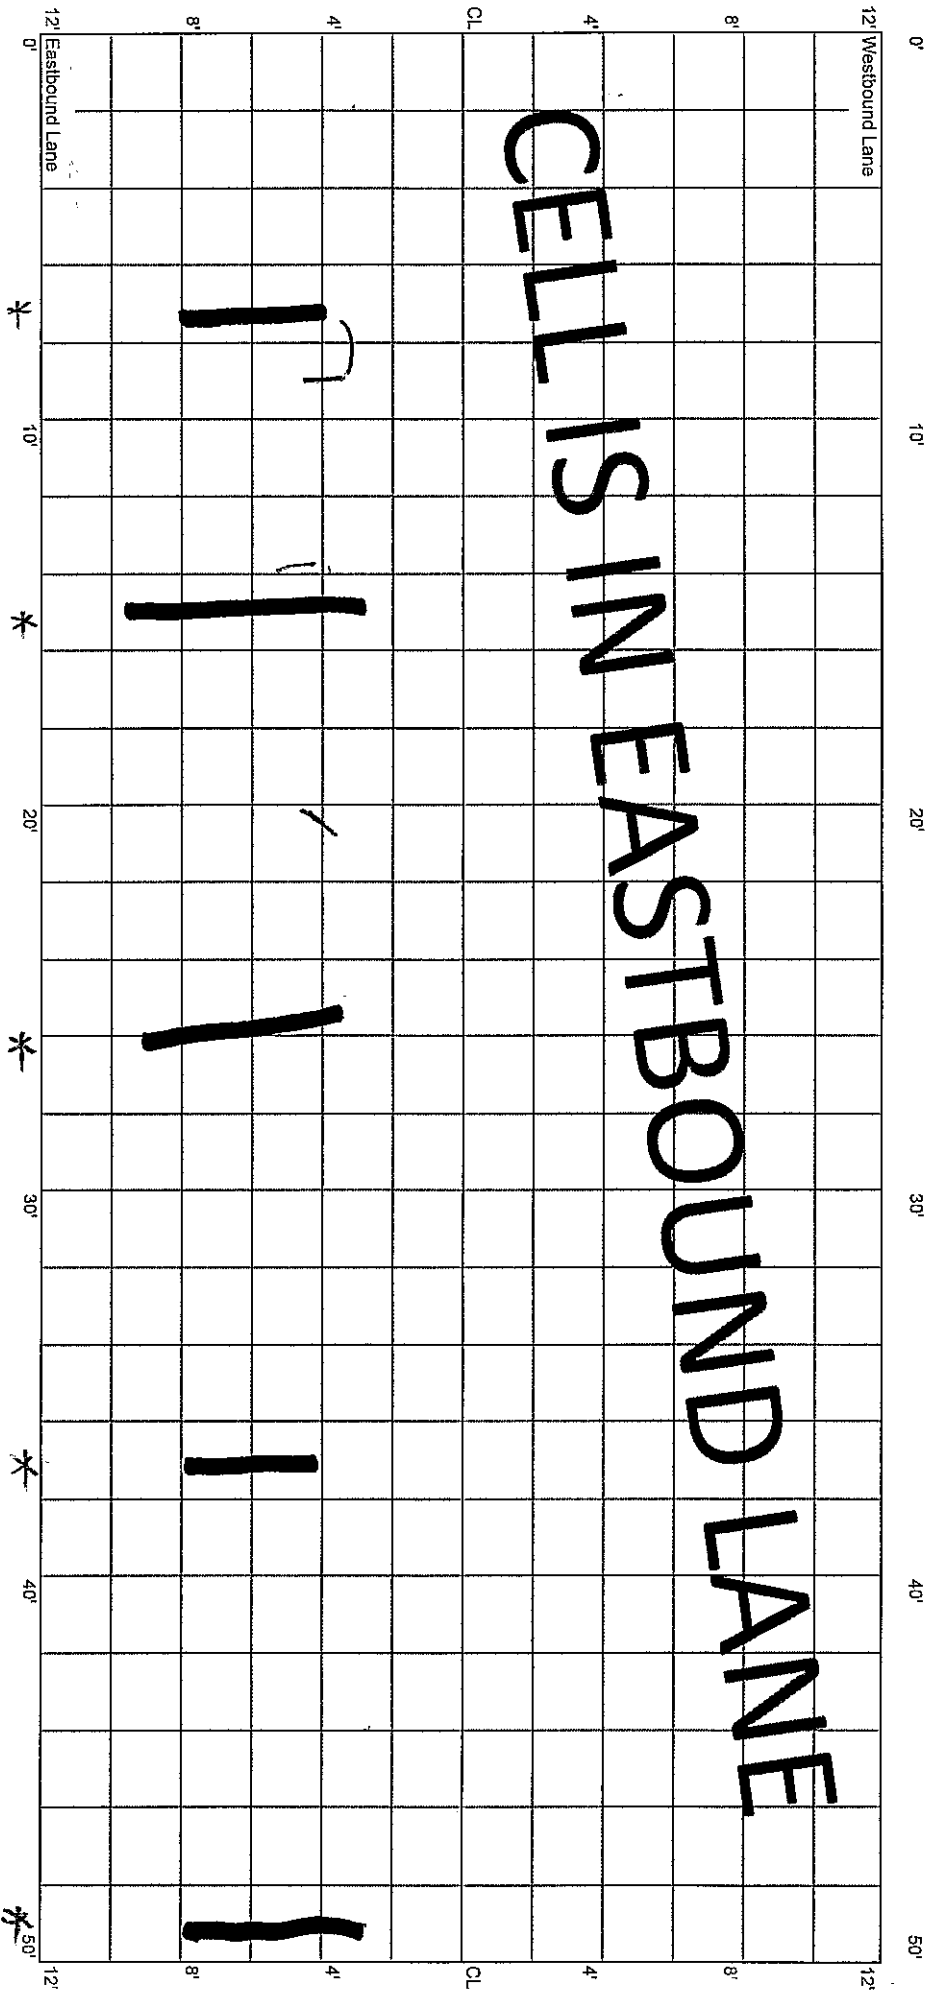


CELLS IN EASTBOUND LANE

\* Root & Seal

CELL 7008E  
50 - 100 ft

39+00

39+50

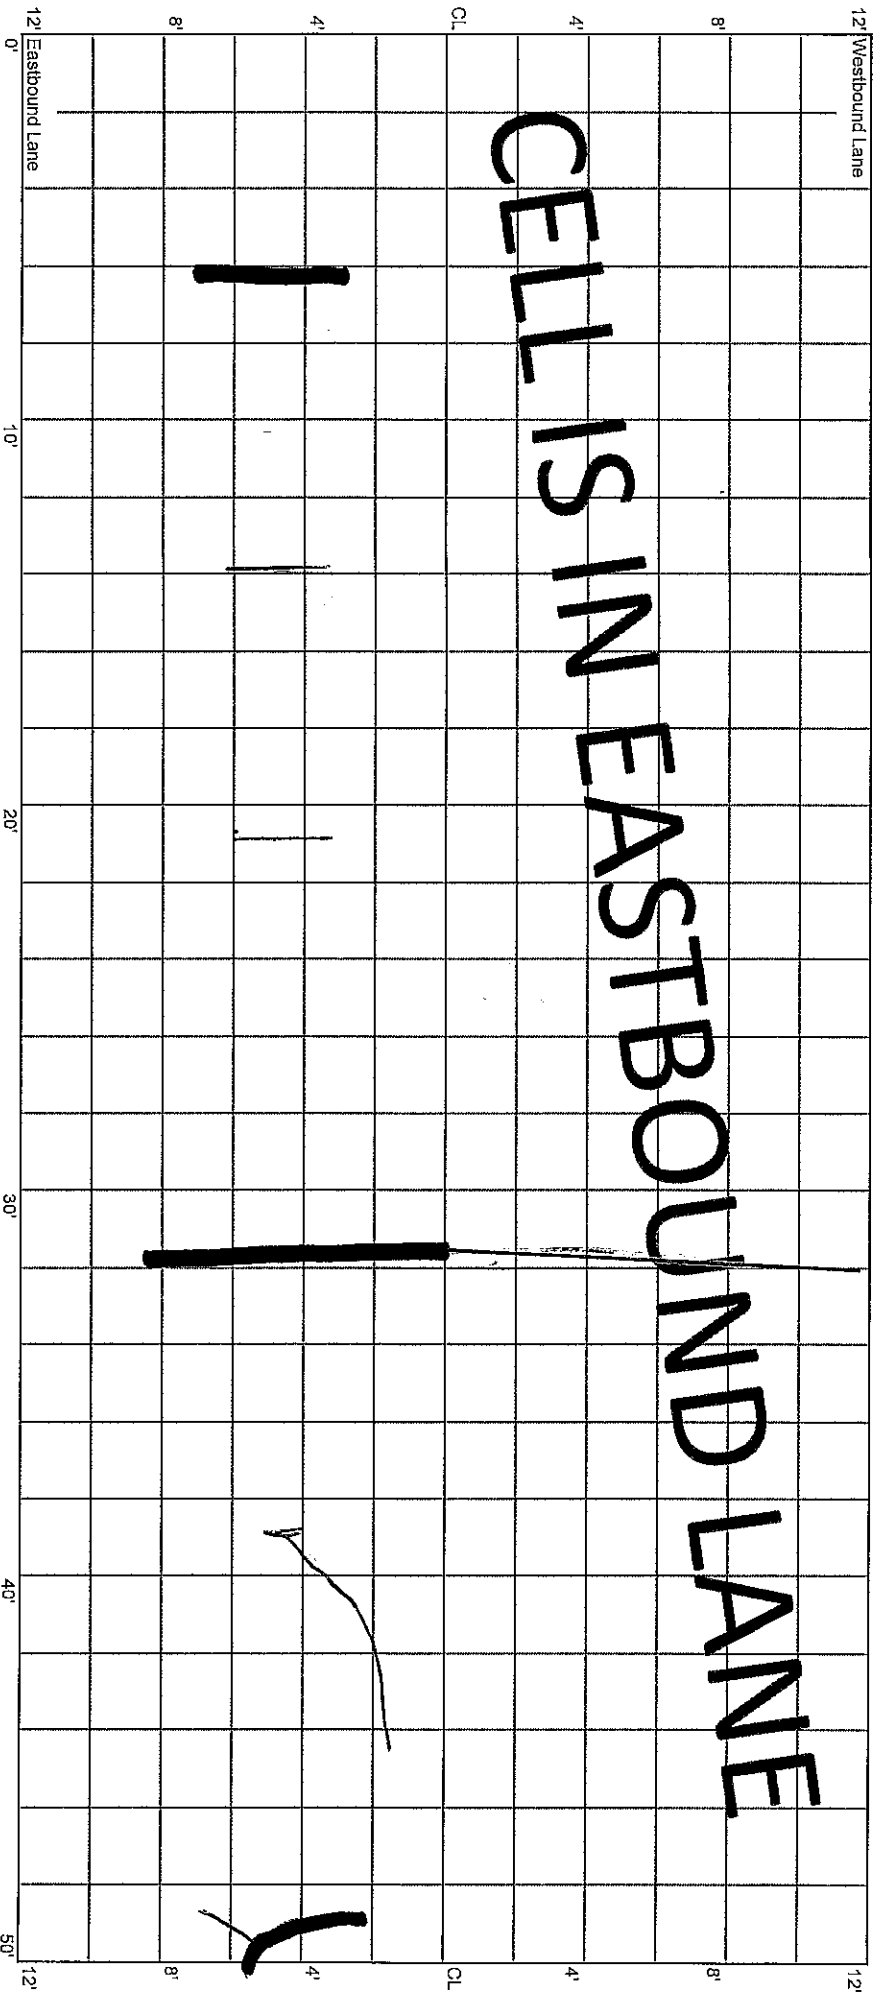




1  
2  
3

CELL 7008E  
150 - 200 ft

40+00

40+50

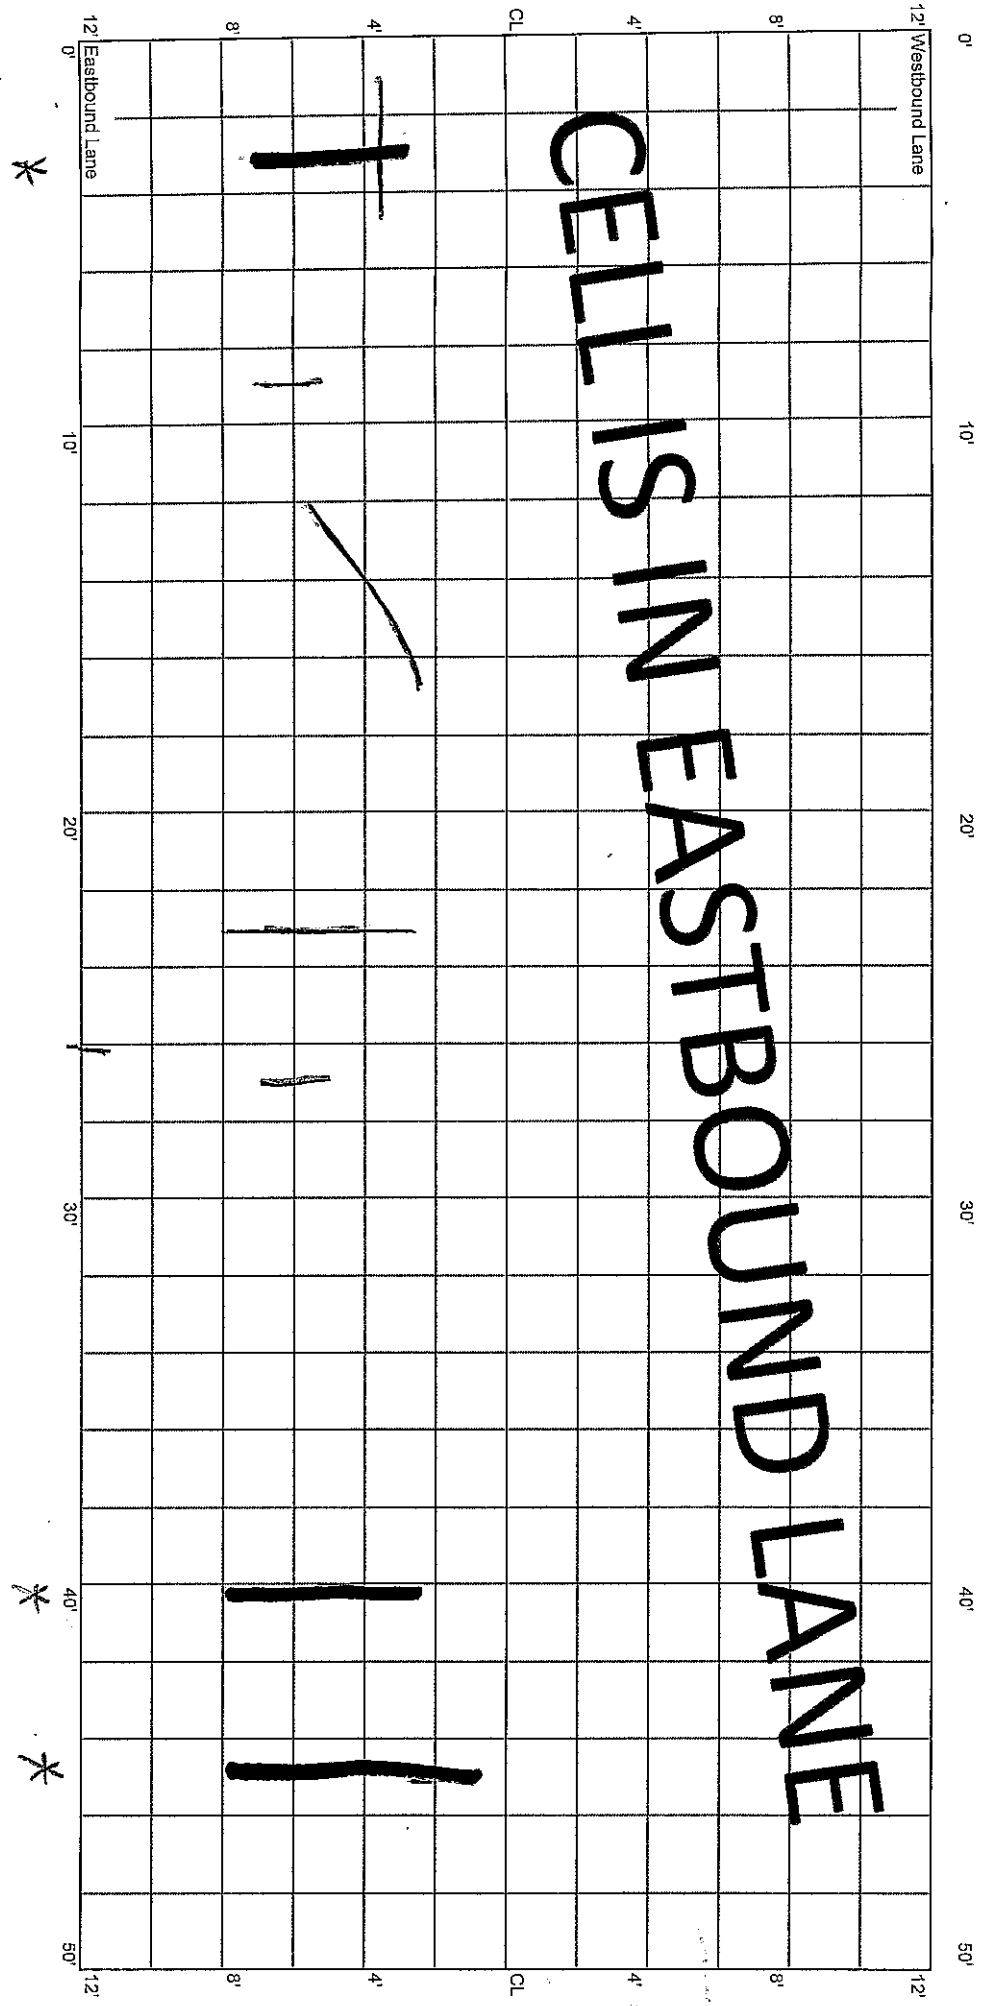

12' Westbound Lane

12' Eastbound Lane

CL

CL

8'

8'

4'

4'

4'

4'

8'

8'

\*


\*

\*

CELL 7008E  
200 - 250 ft

40+50


41+00

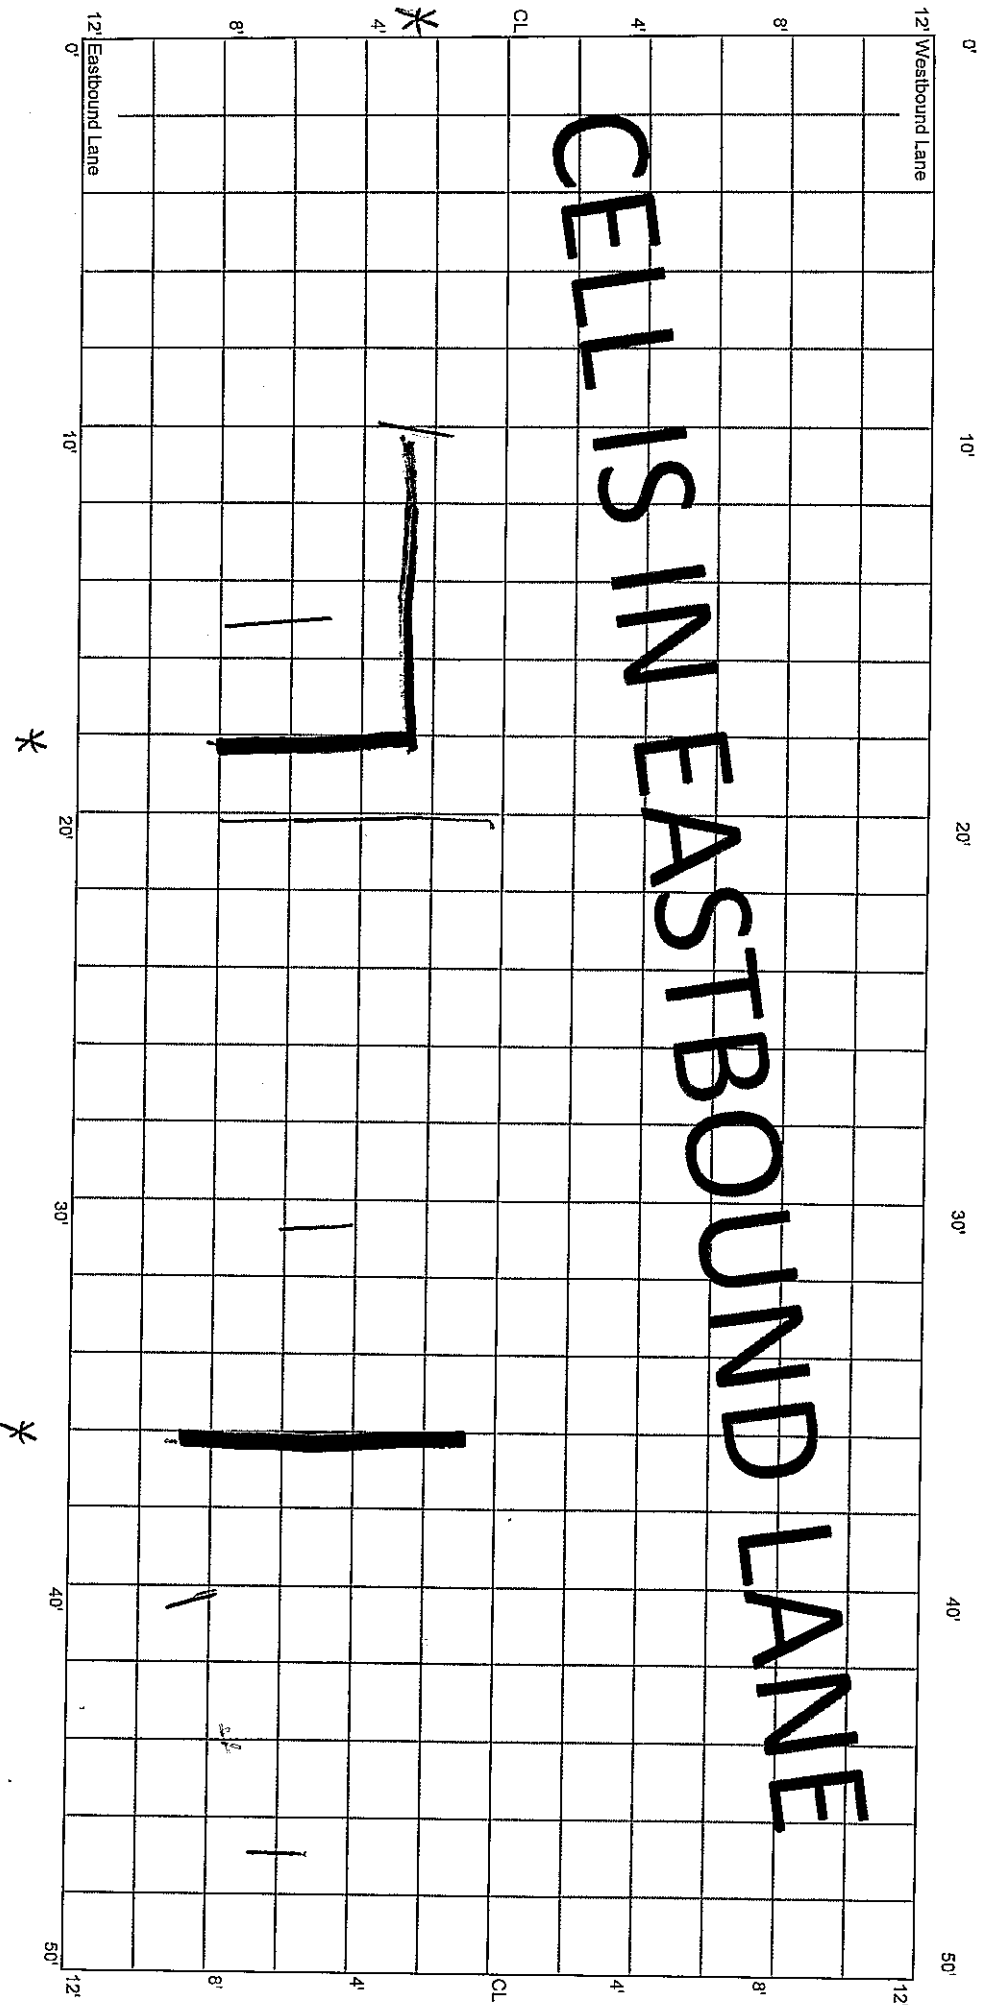

CELL 7008E  
250 - 300 ft

41+00


41+50

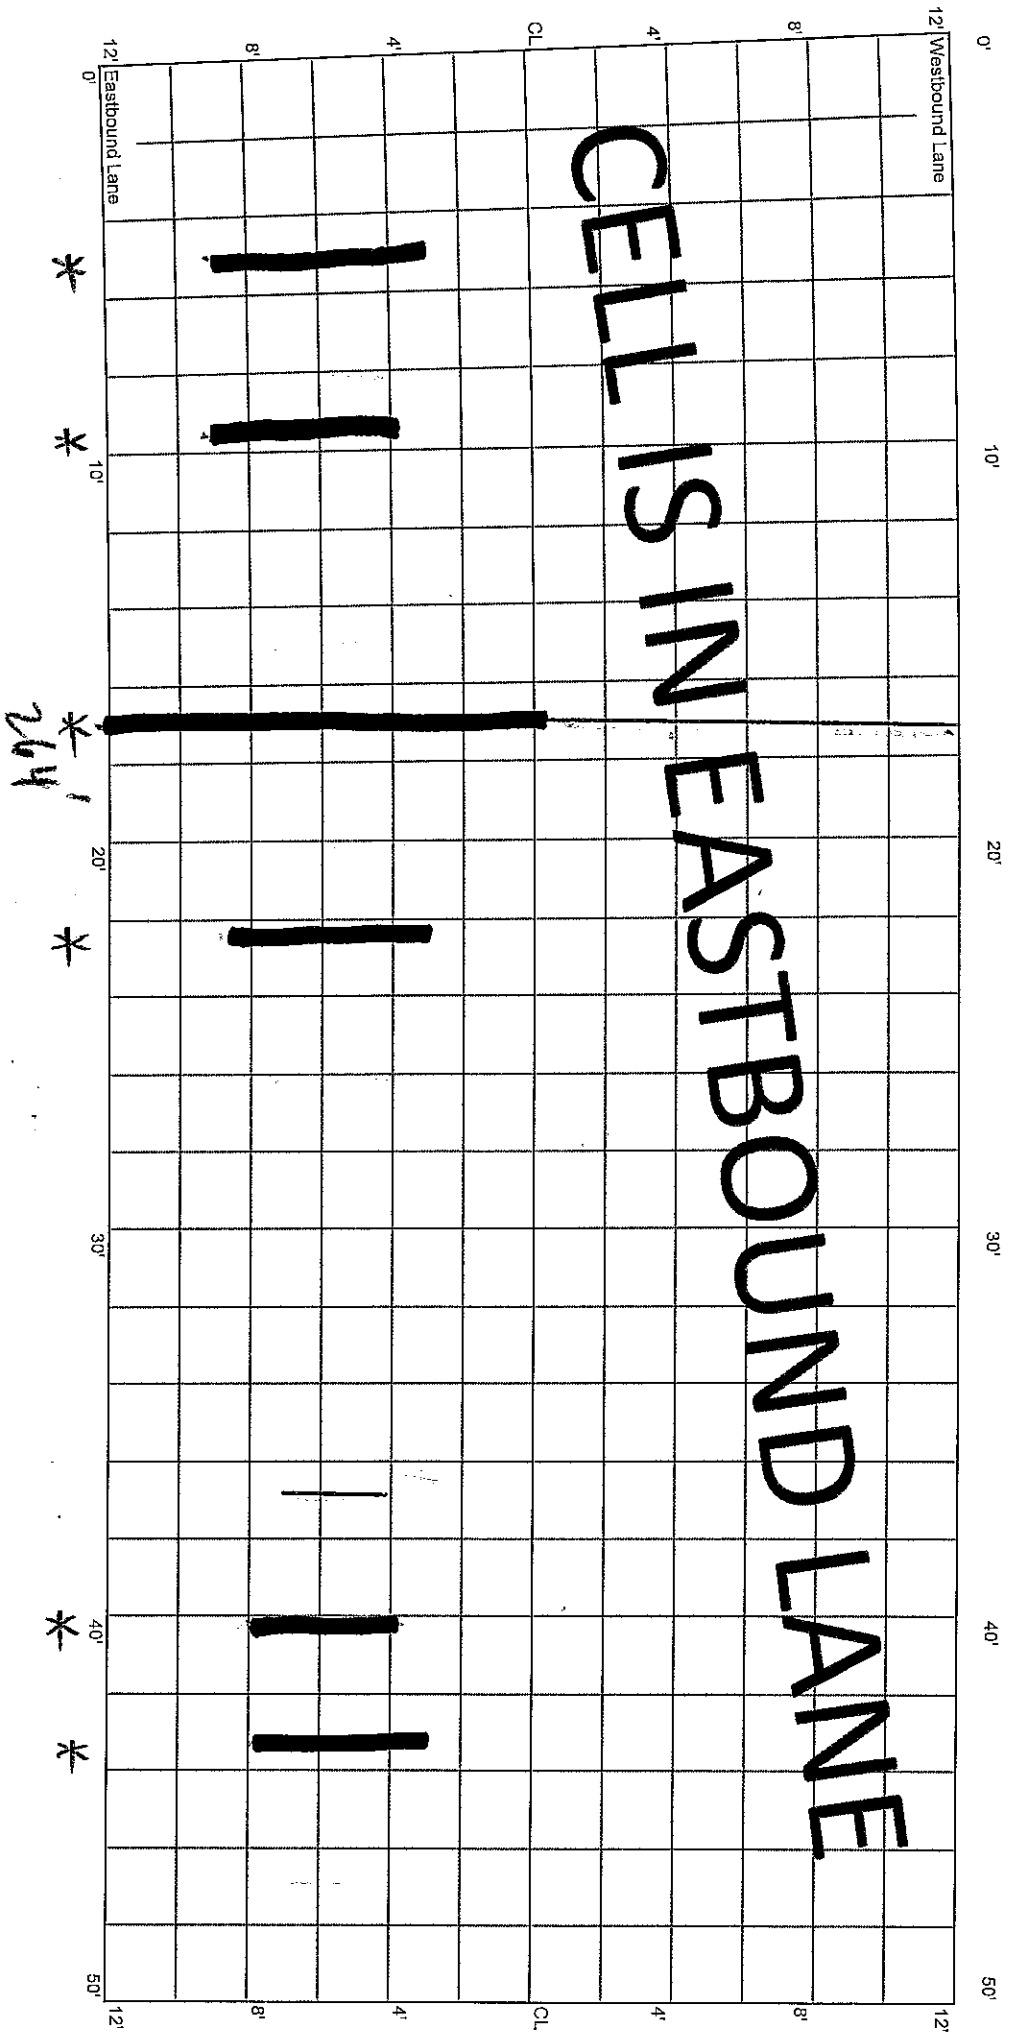

CELL 7008E  
300 - 350 ft

41+50


42+00

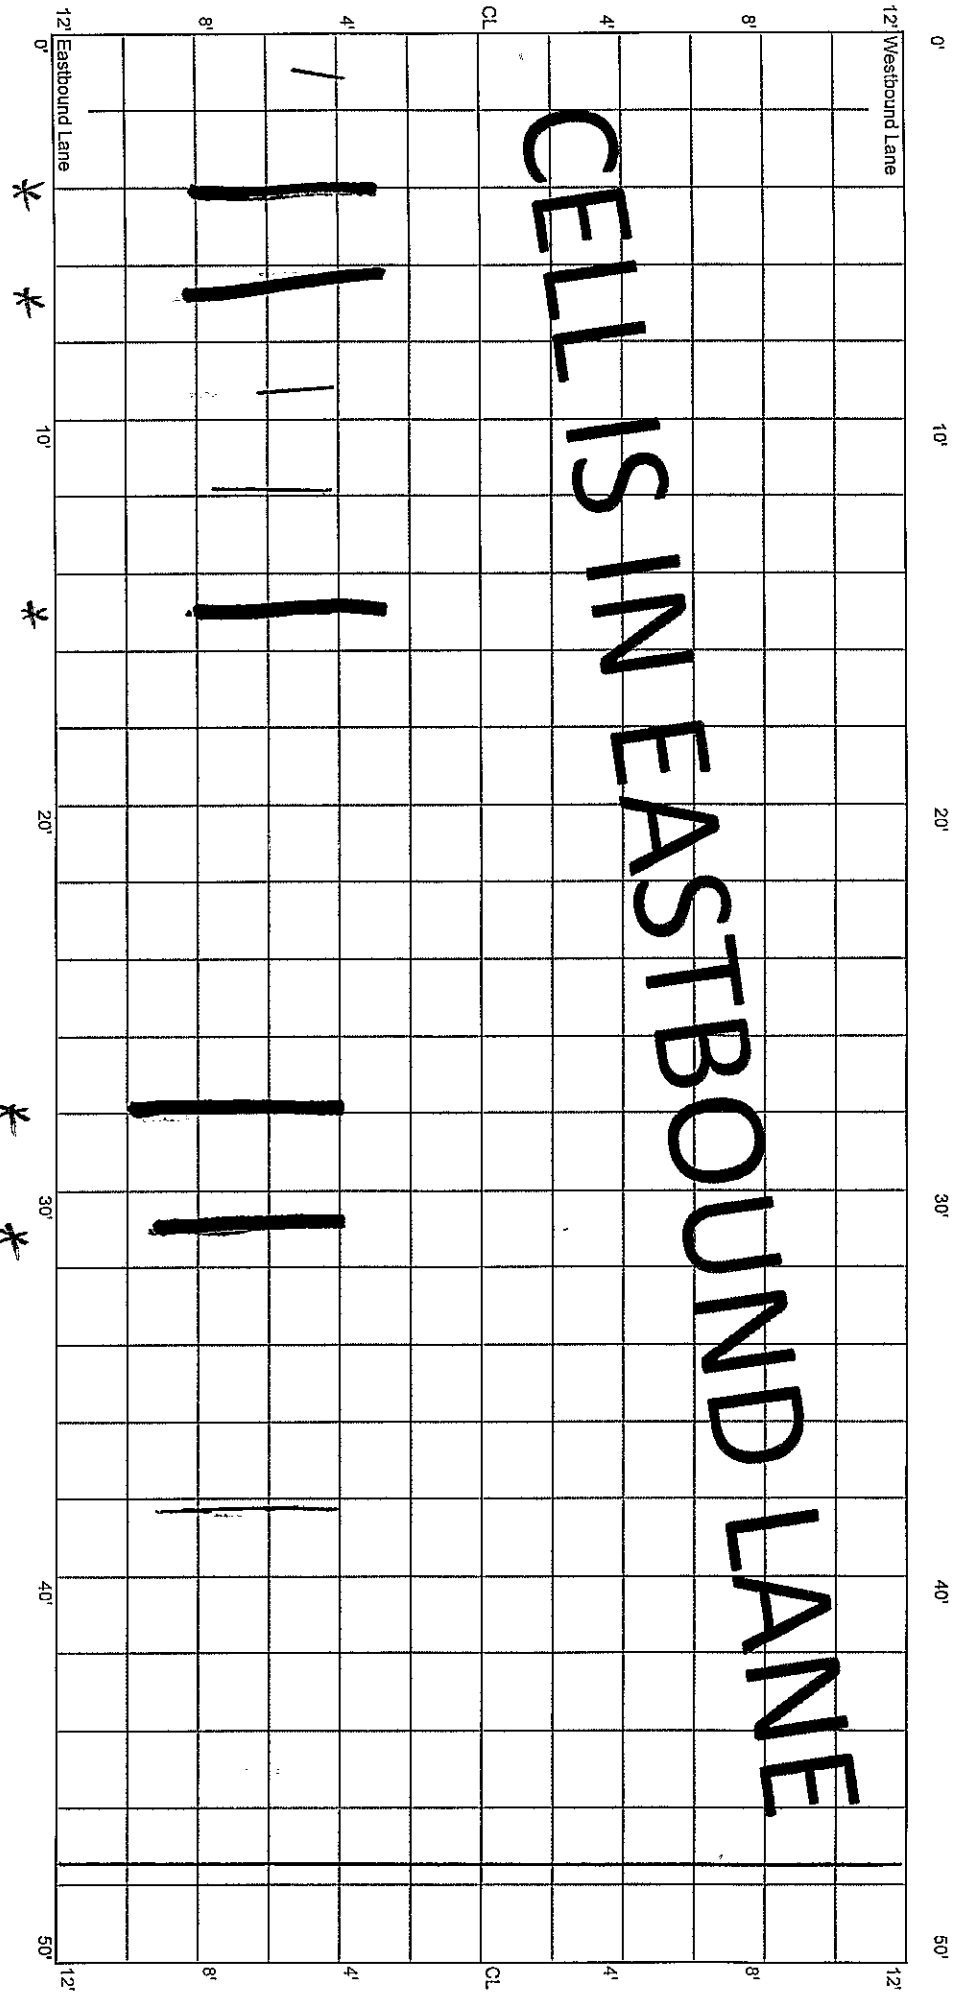

CELL 7008E  
350 - 400 ft

42+00

42+50

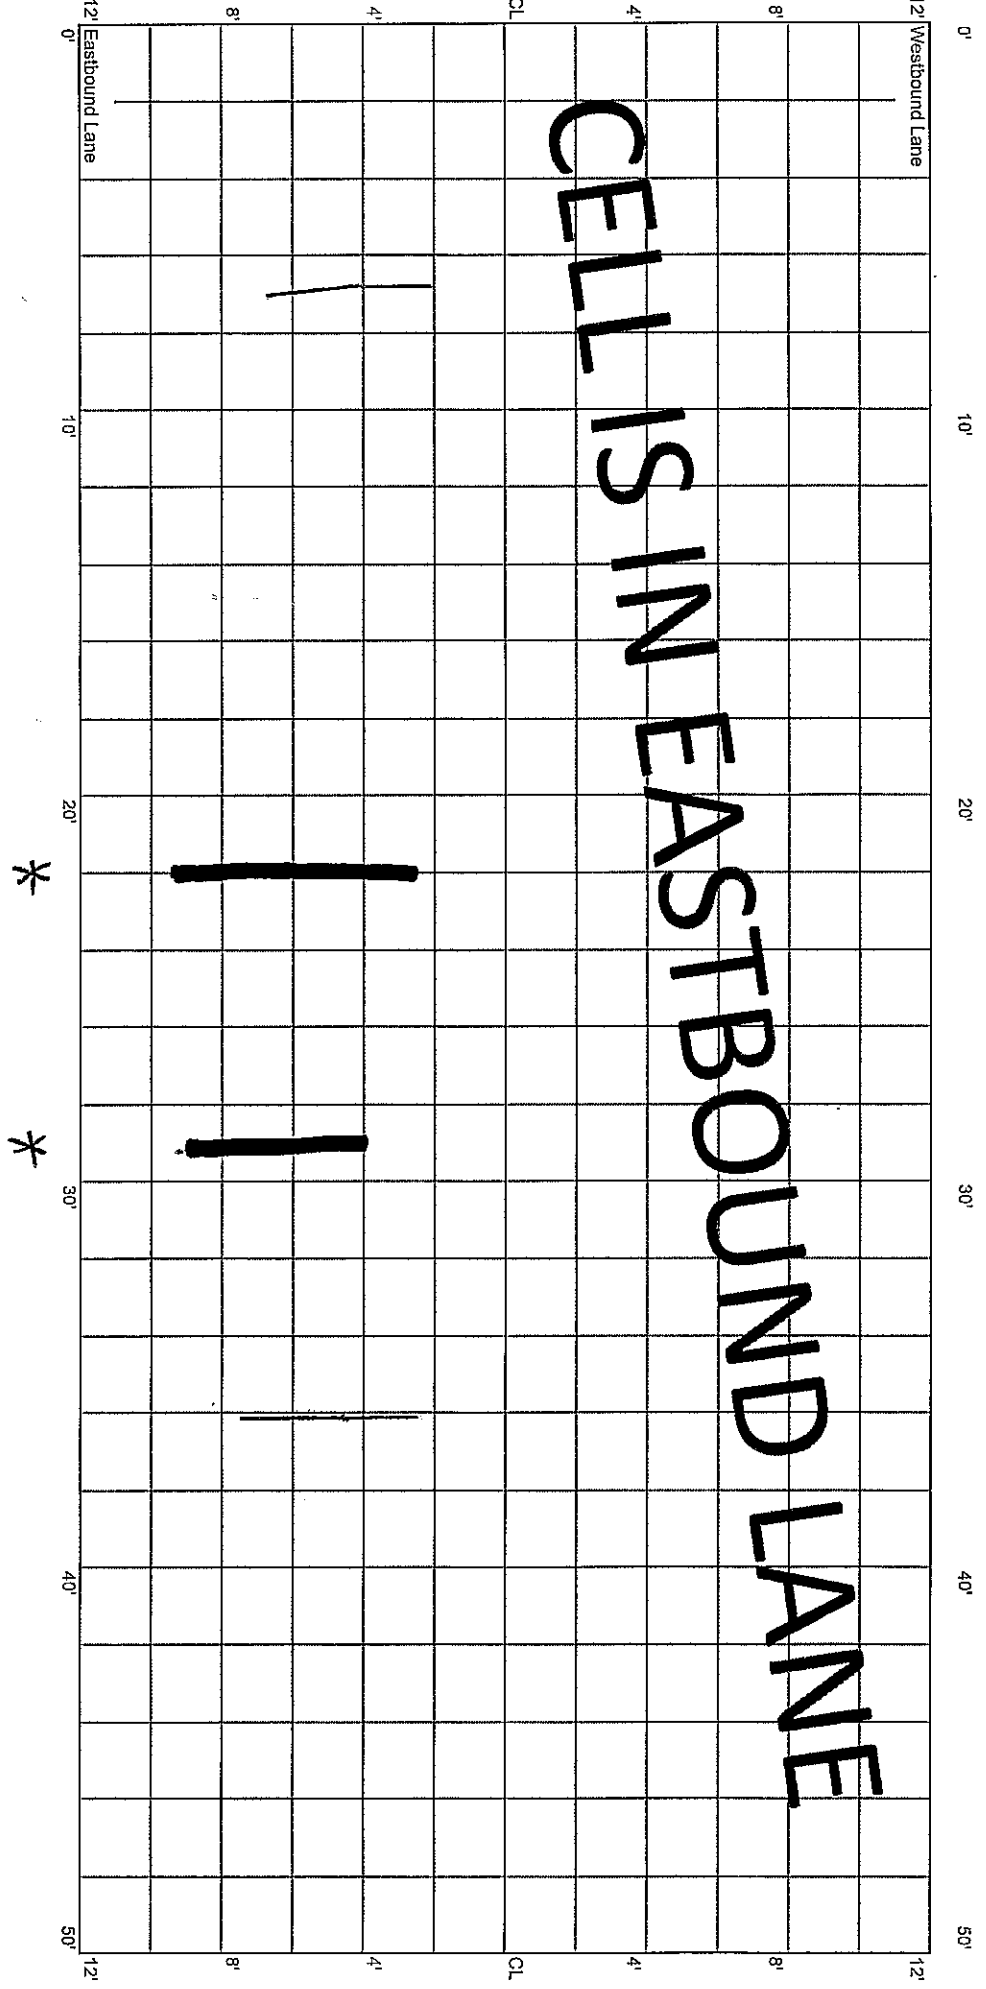




CELL 7008E  
400 - 450 ft

42+50


43+00

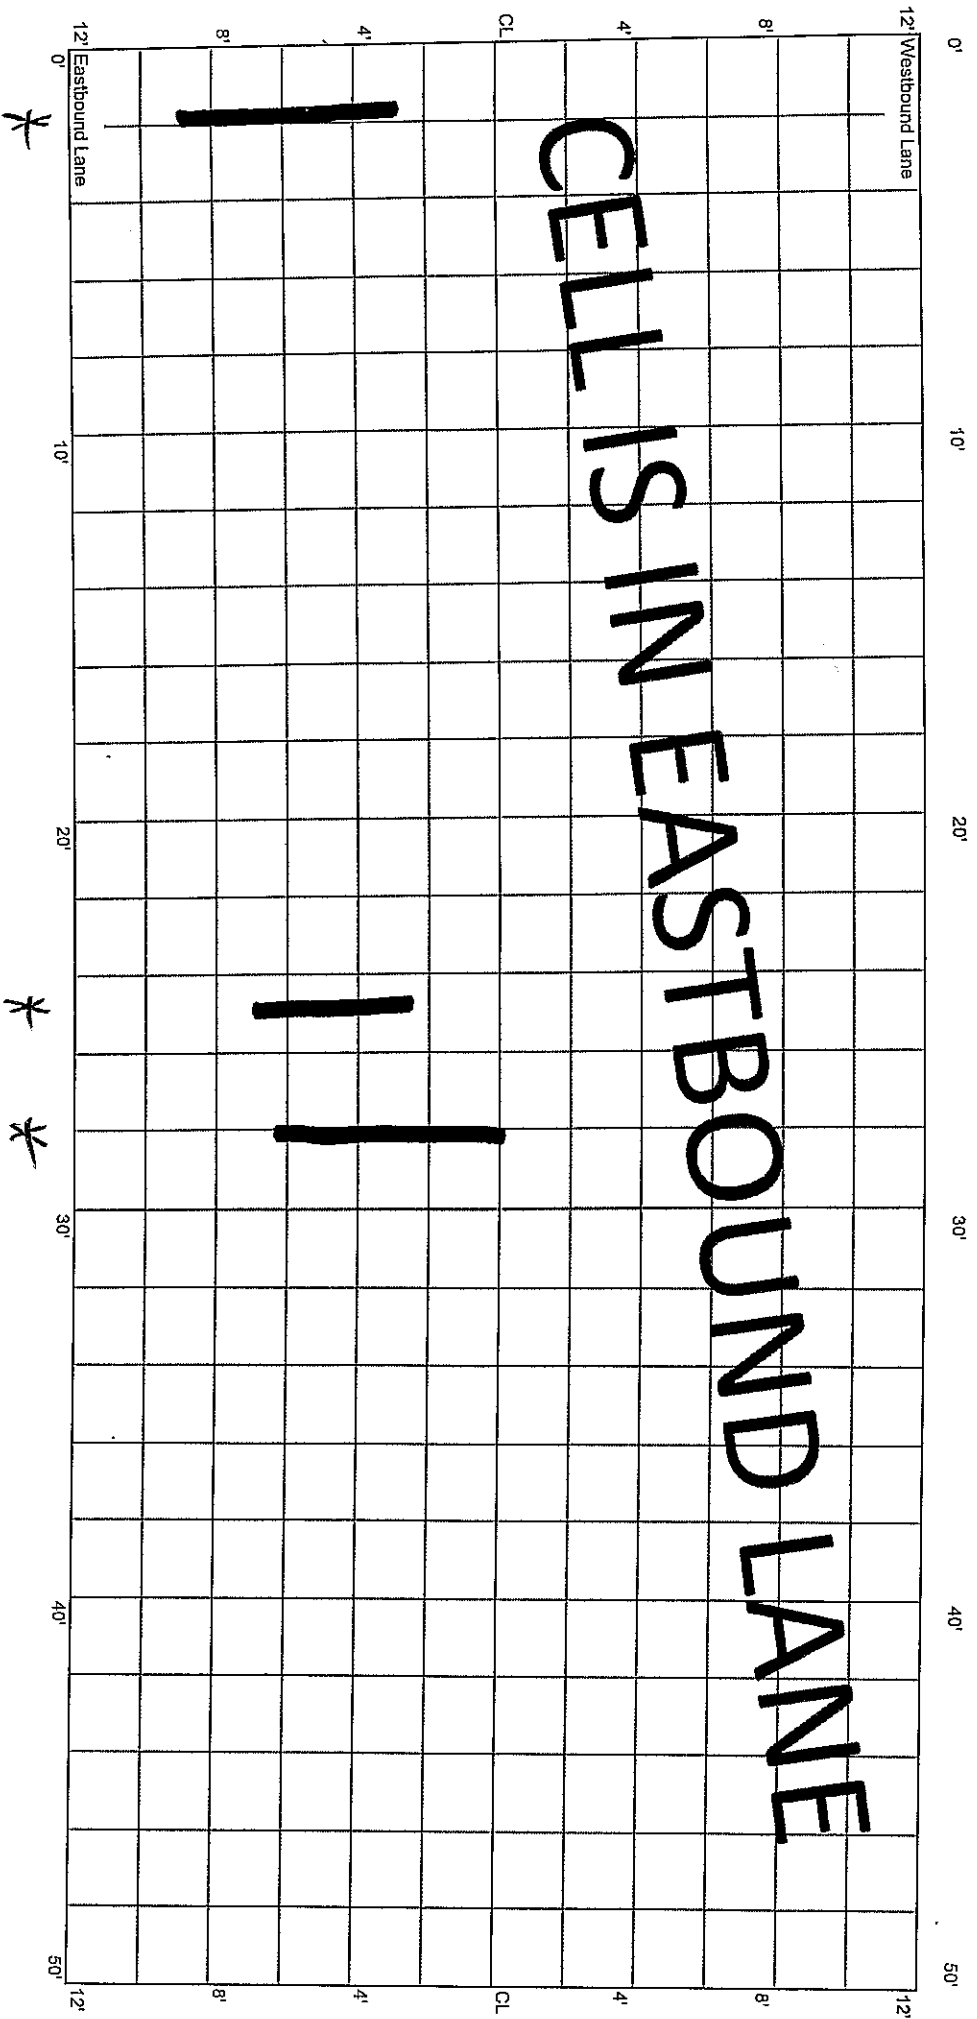

CELL 7008E  
450 - 500 ft

43+00

43+50

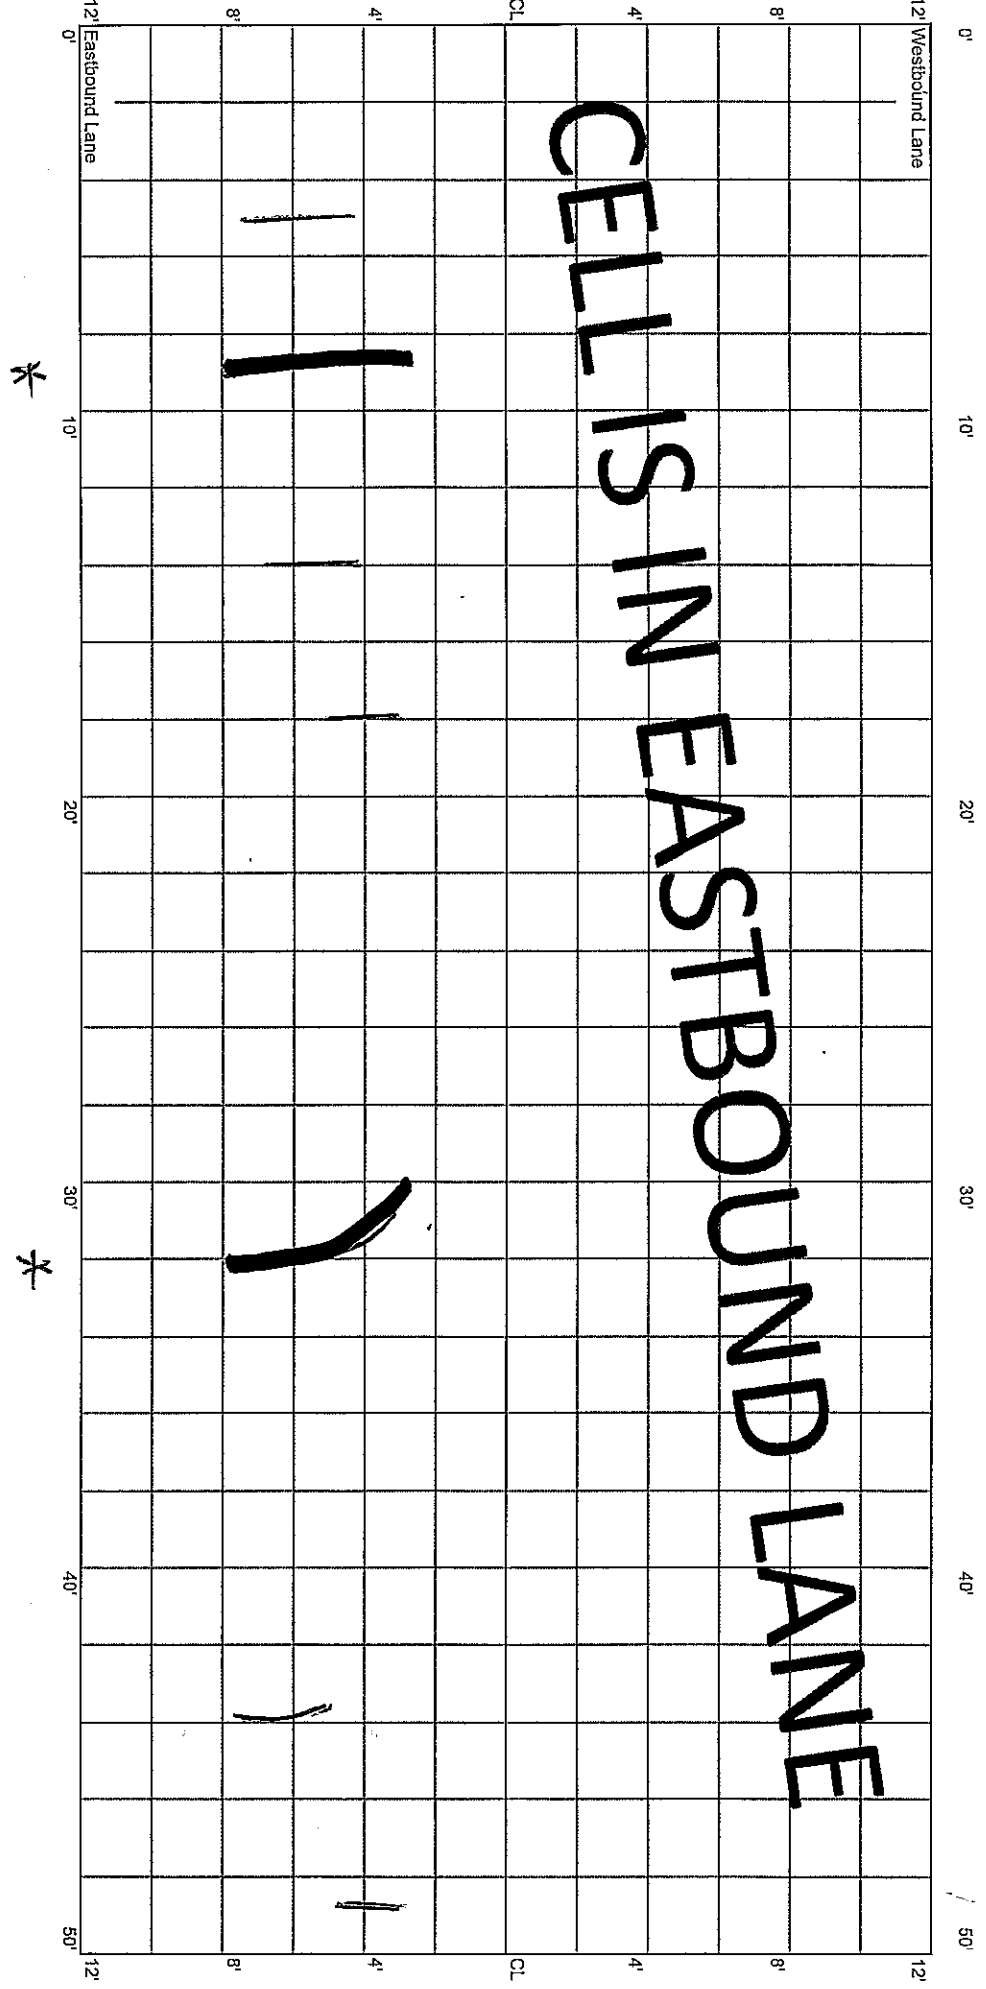


CELL 7008E  
500 - 842 ft

43+50

46+92


0'

342'

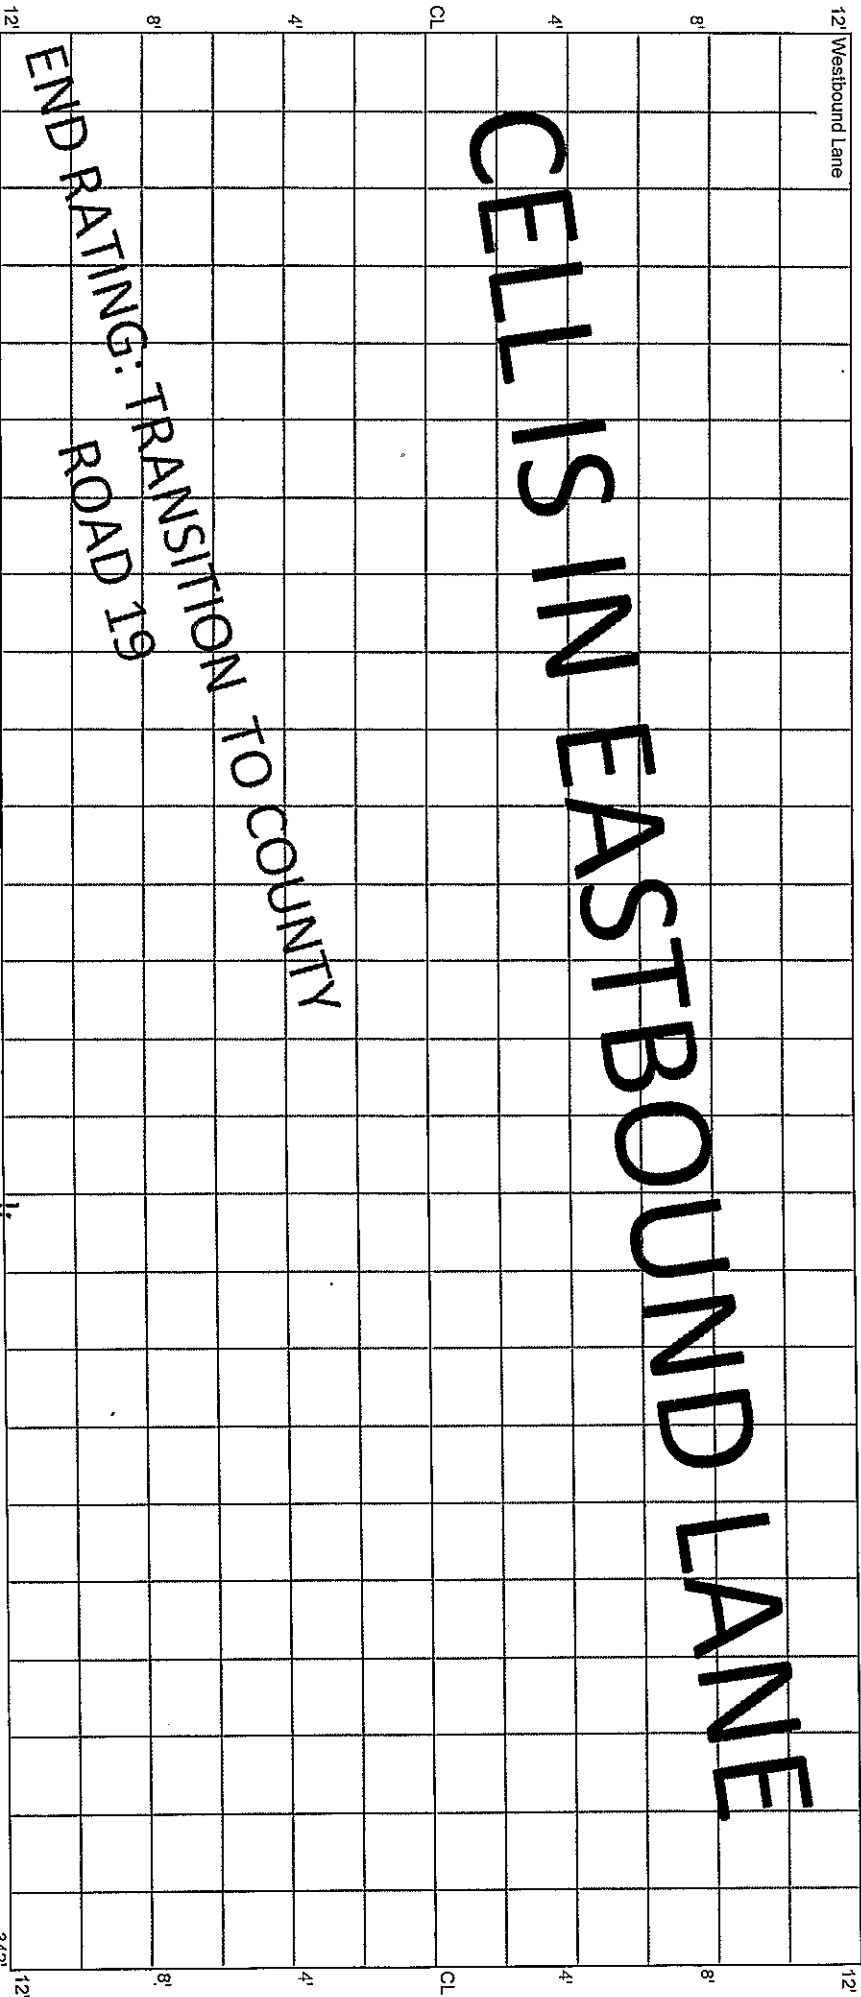


END RATING: TRANSITION TO COUNTY ROAD 19

CELL IS IN EASTBOUND LANE

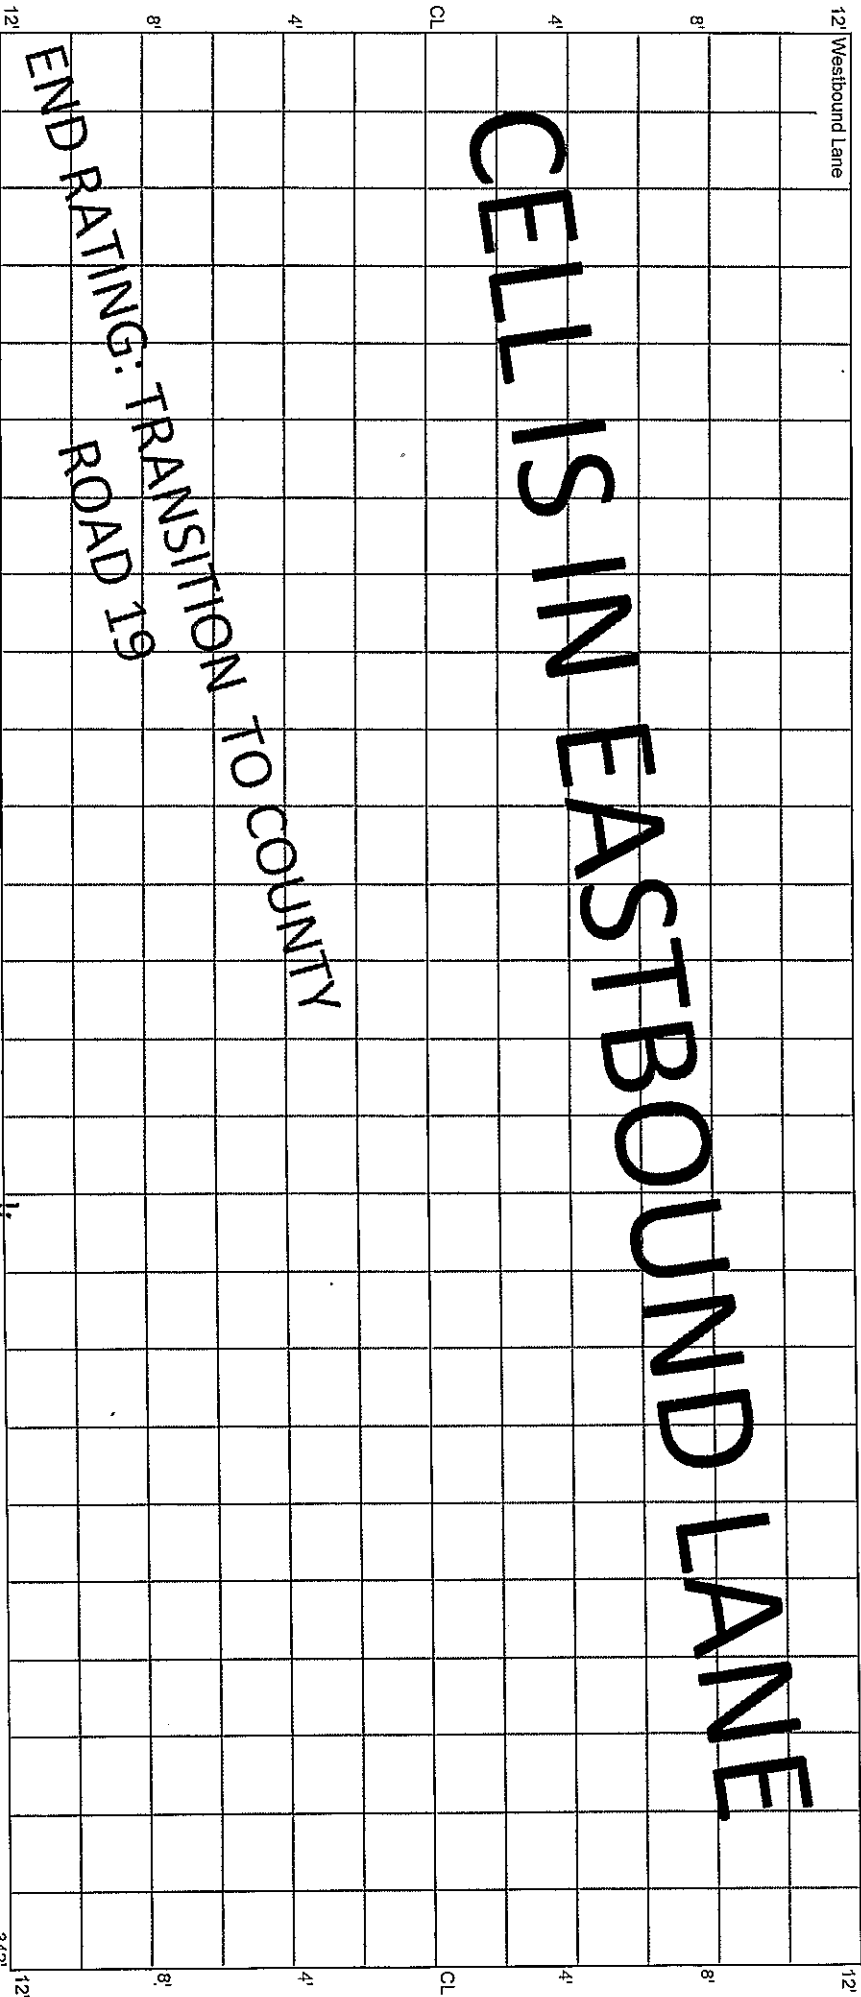

END RATING: TRANSITION TO COUNTY ROAD 19

CELL IS IN EASTBOUND LANE

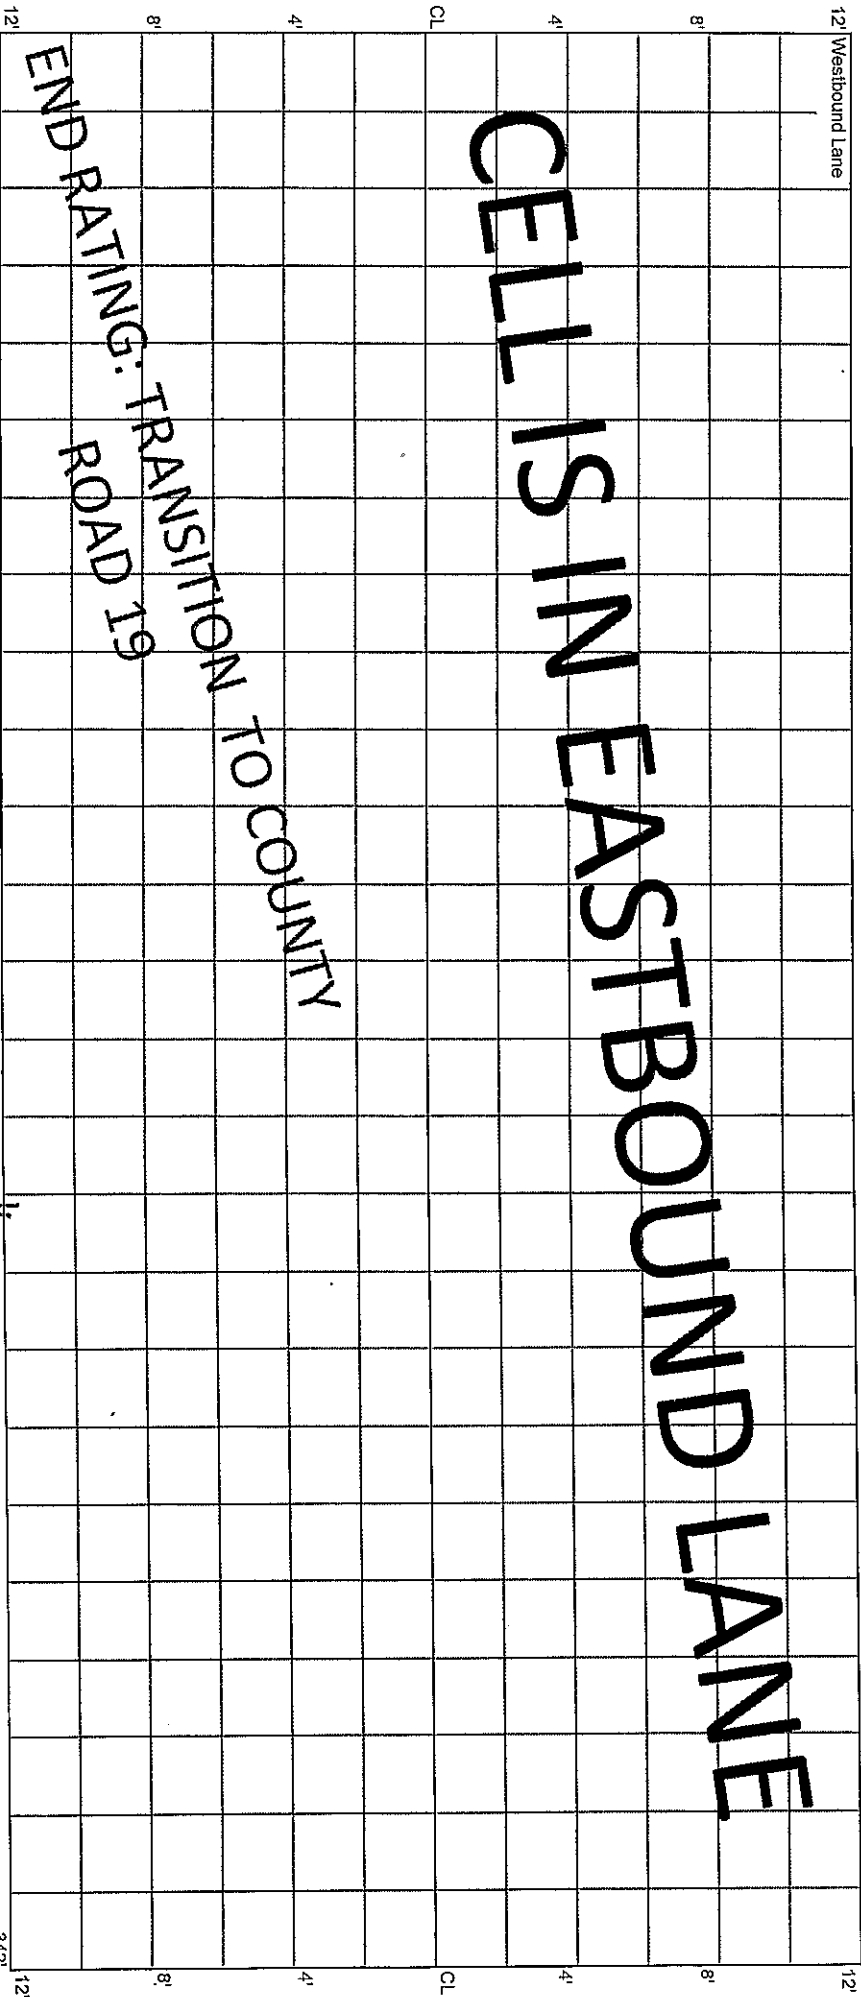

END RATING: TRANSITION TO COUNTY ROAD 19

CELL IS IN EASTBOUND LANE