

5:28.30 E.T.

10.14.20 | 1.13.22

1.4.21 | 8.30.22

8.25.21 | 1.26.23


File 70TH ST

Begin CL Kadler

0+00

CELL 7001E  
0 - 50 ft

0+50

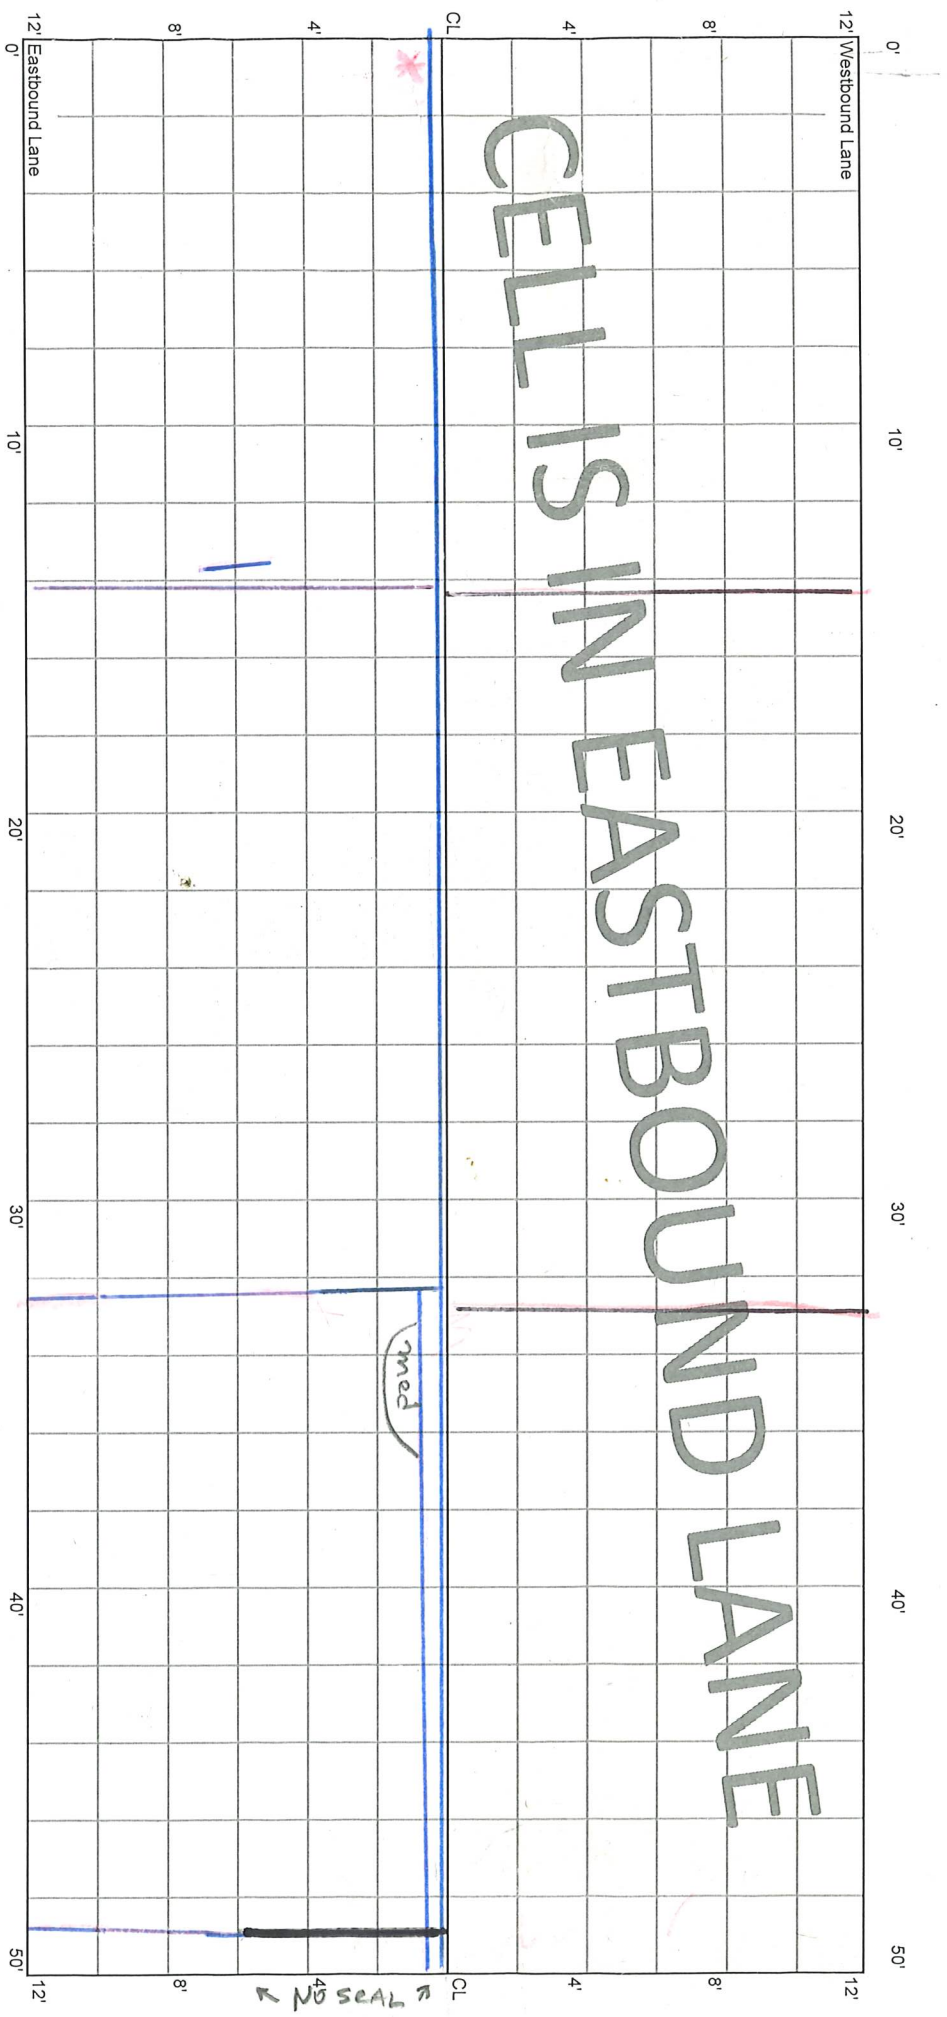

\* Rout & Seal  
8/2022 - "M" Due to multiple cracks


8/22 - Sealant + debris & many stones on mat.  
\* AF

CELL 7001E  
50 - 100 ft

0+50

1+00

CELL IS IN EASTBOUND LANE

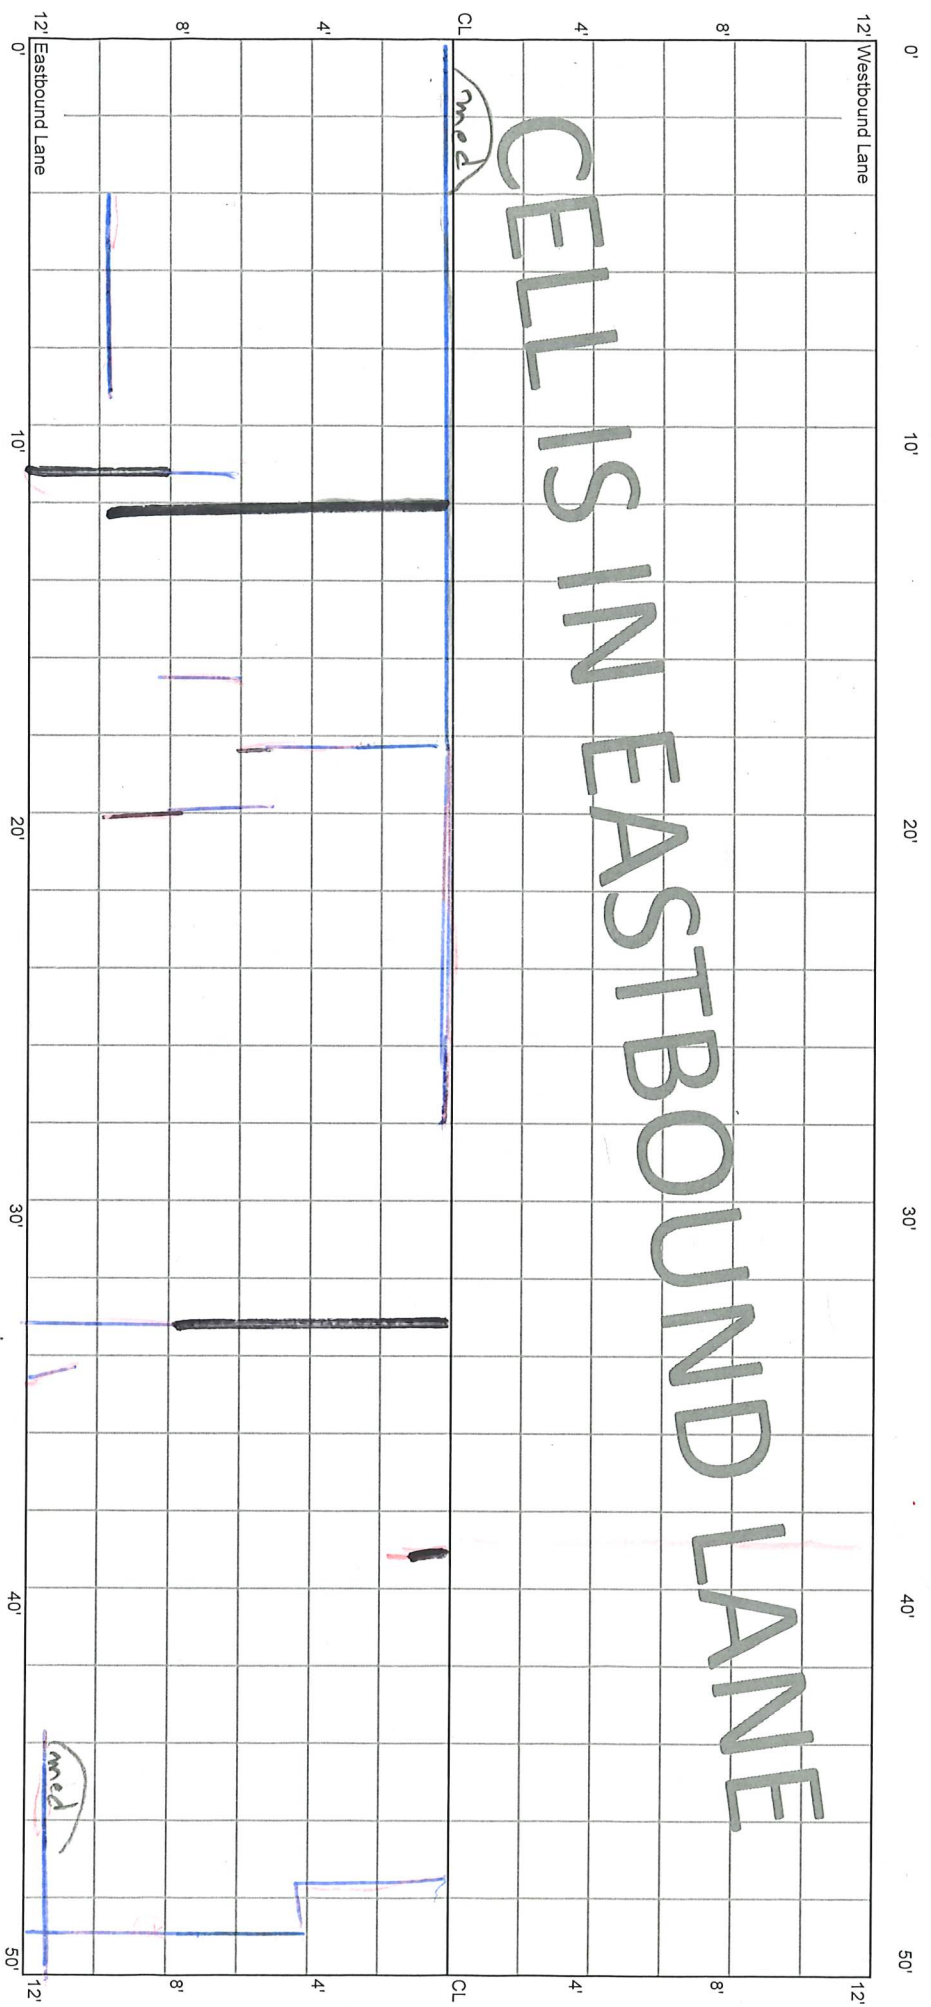

\*  
M  
AF  
No seal

\*  
M  
AF, SP


M

CELL 7001E  
100 - 150 ft

1+00

1+50

CELL IS IN EASTBOUND LANE

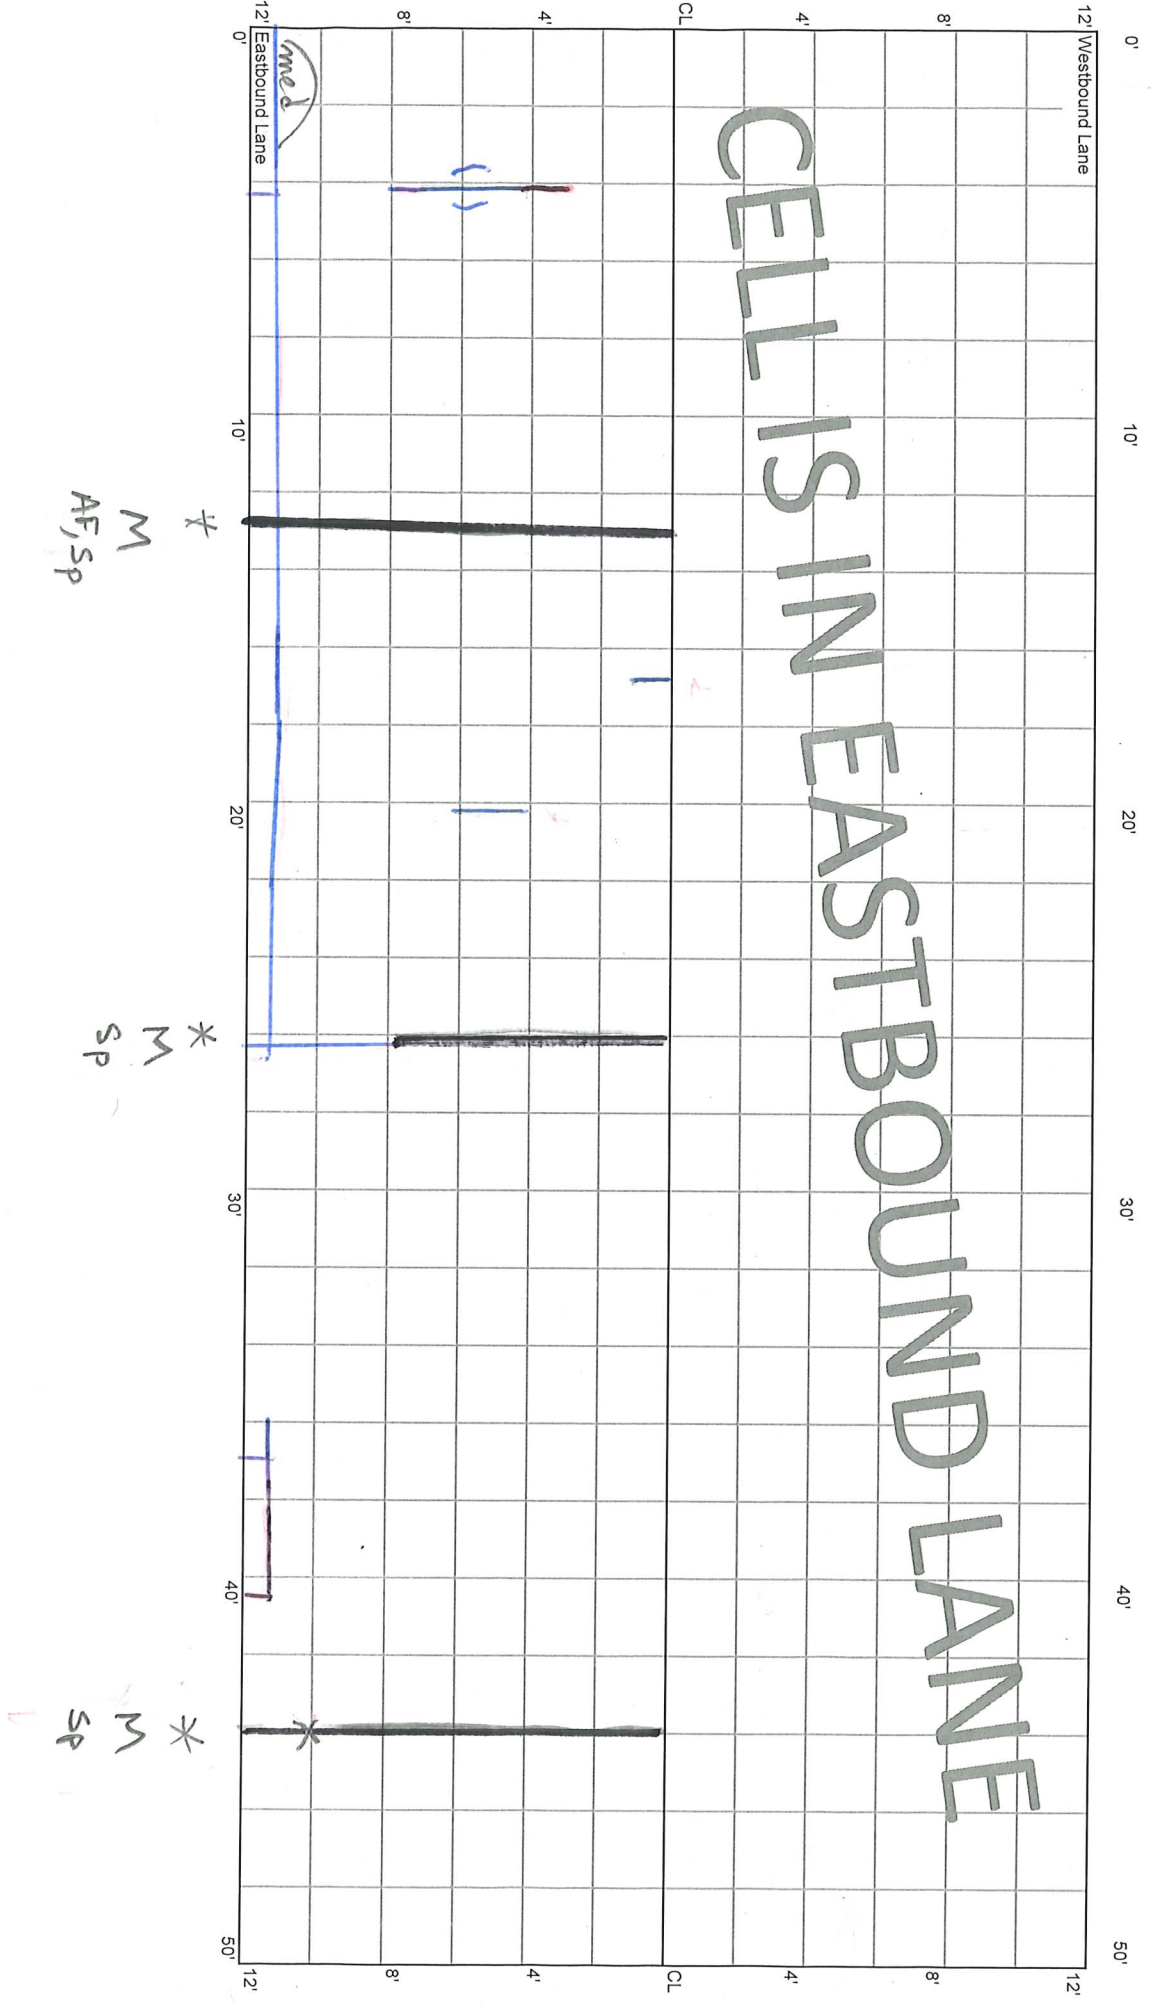

med

M  
AF, SP


M  
SP

M  
SP

CELL 7001E  
150 - 200 ft

1+50

2+00

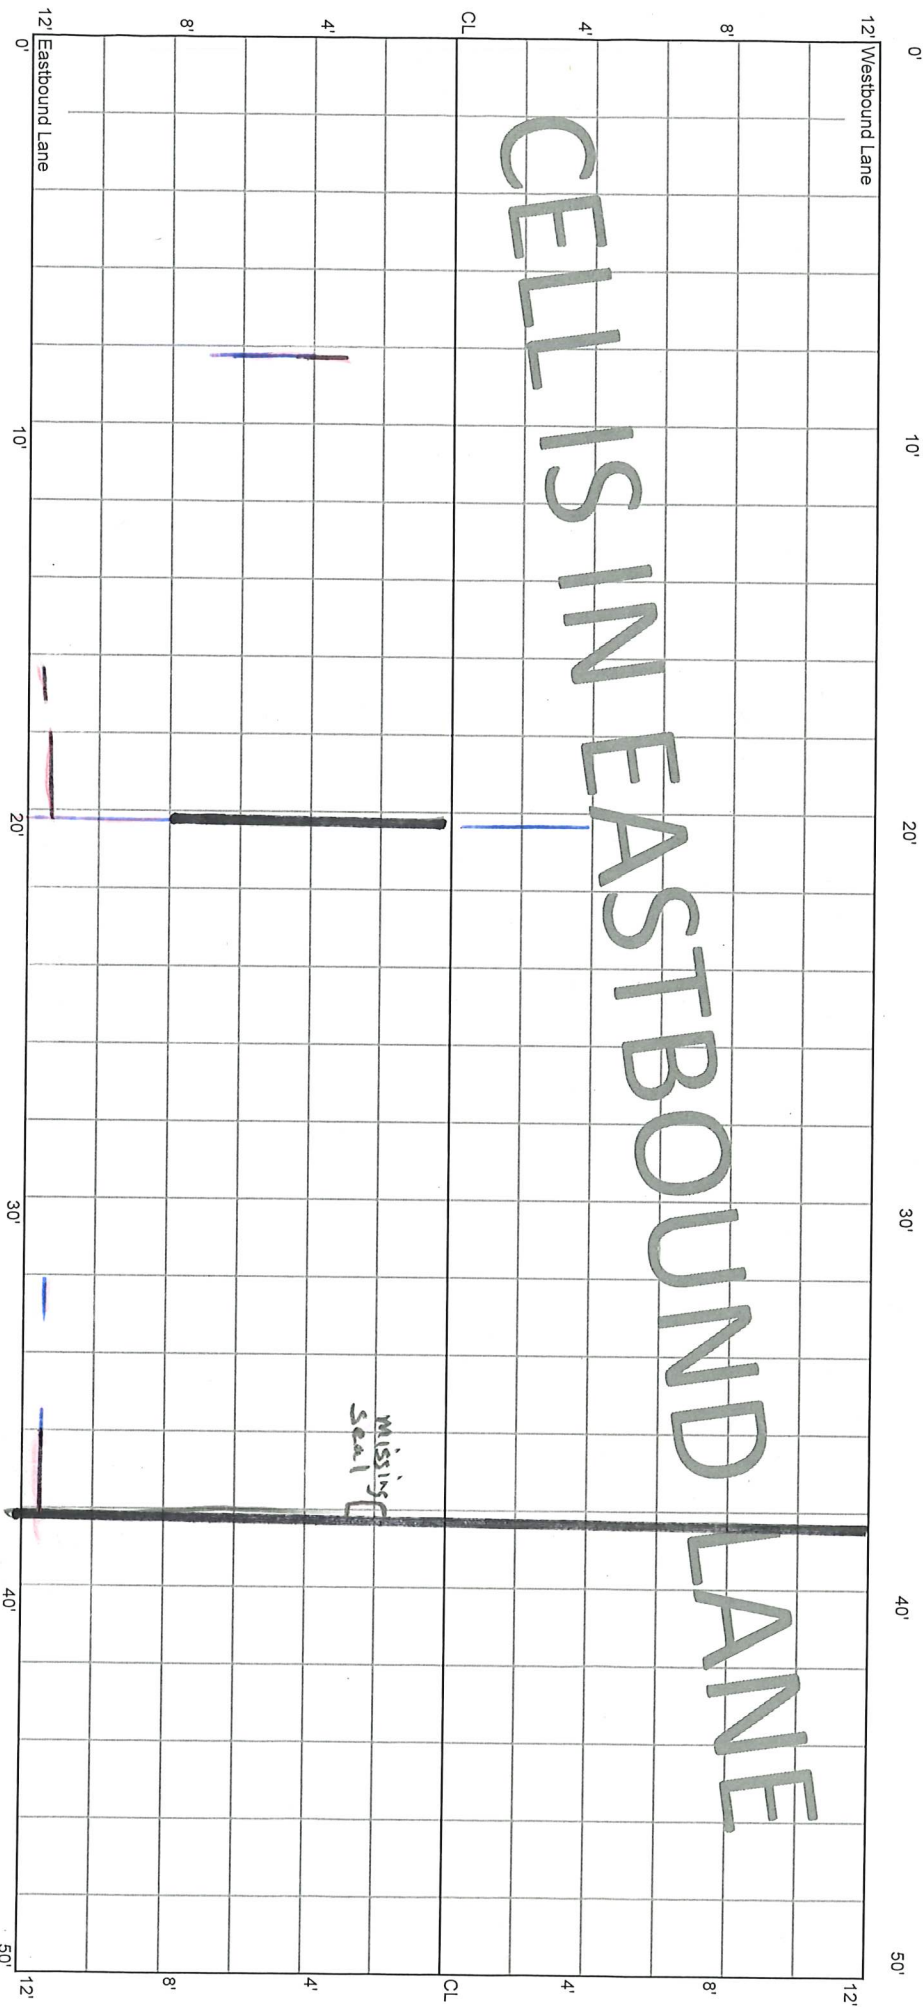

CELL IS IN EASTBOUND LANE

\* M  
8' seal  
SP

MISSING  
seal

\* M




CELL 7001E  
200 - 250 ft

2+00

2+50

CELL IS IN EASTBOUND LANE

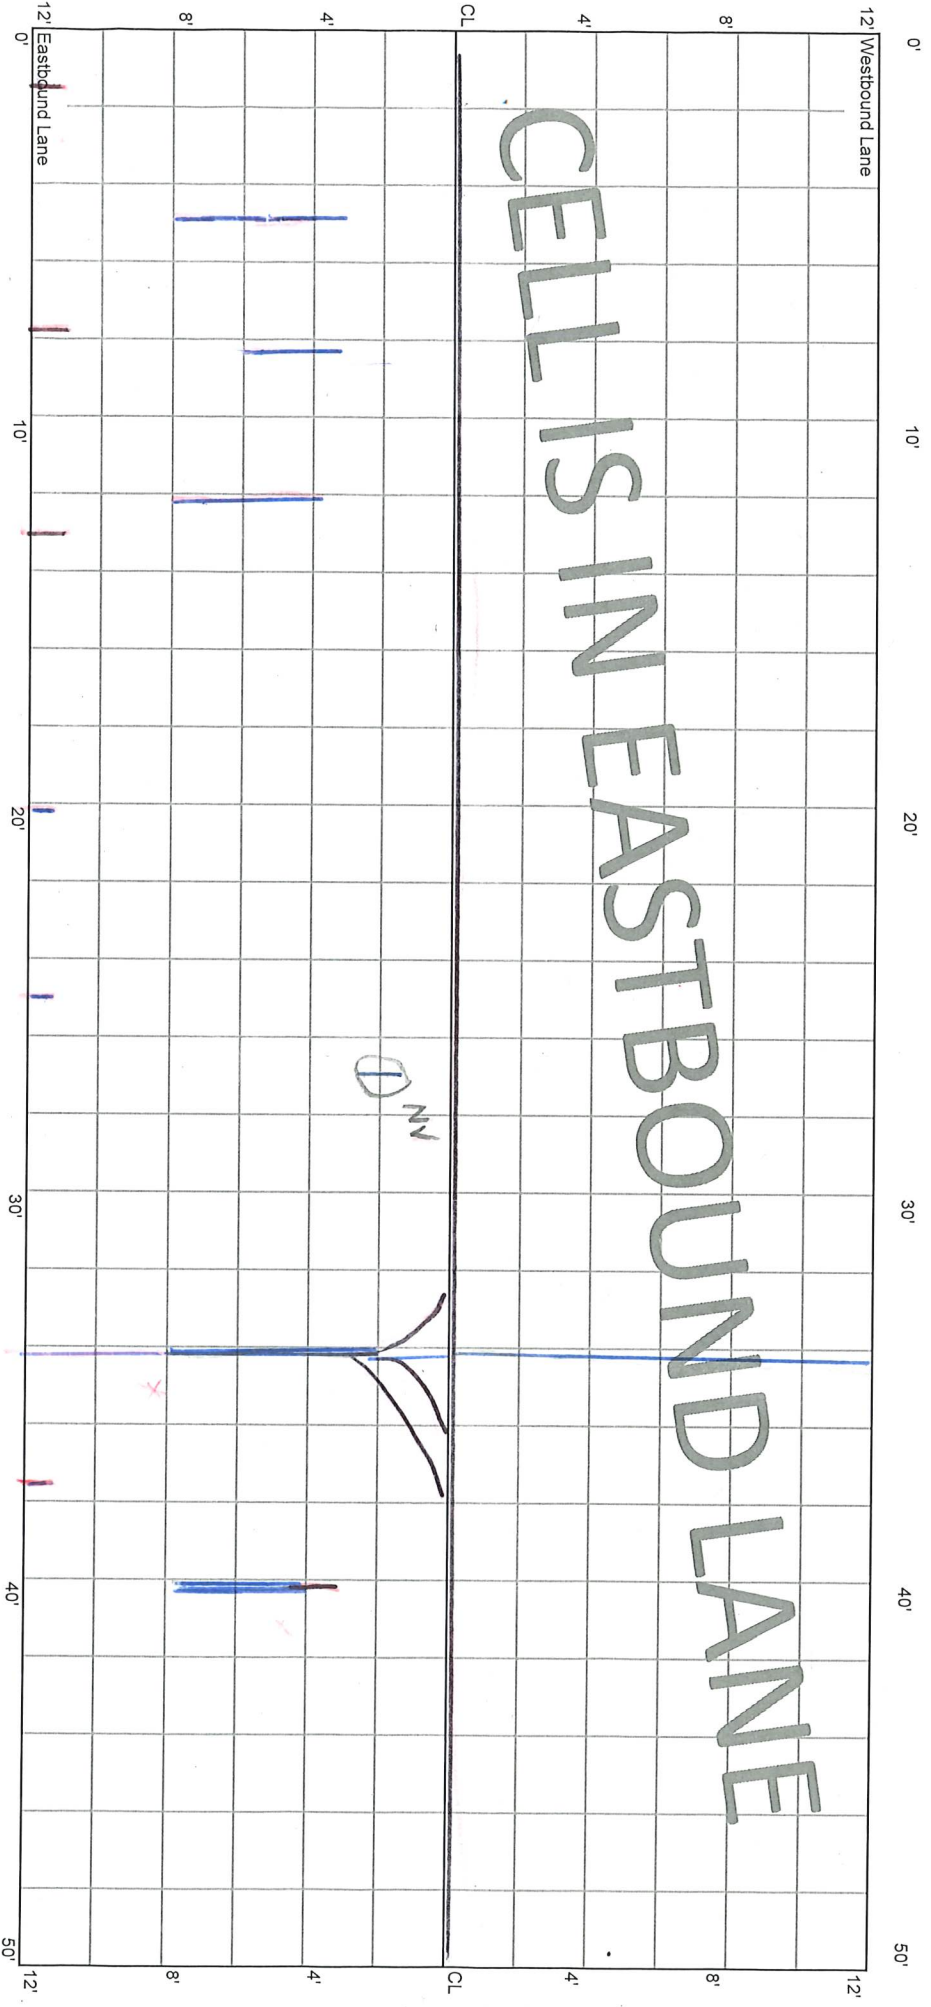

S  
M  
Debris

CELL 7001E  
250 - 300 ft


2+50

3+00

12' Westbound Lane

12' Eastbound Lane

CELL IS IN EASTBOUND LANE

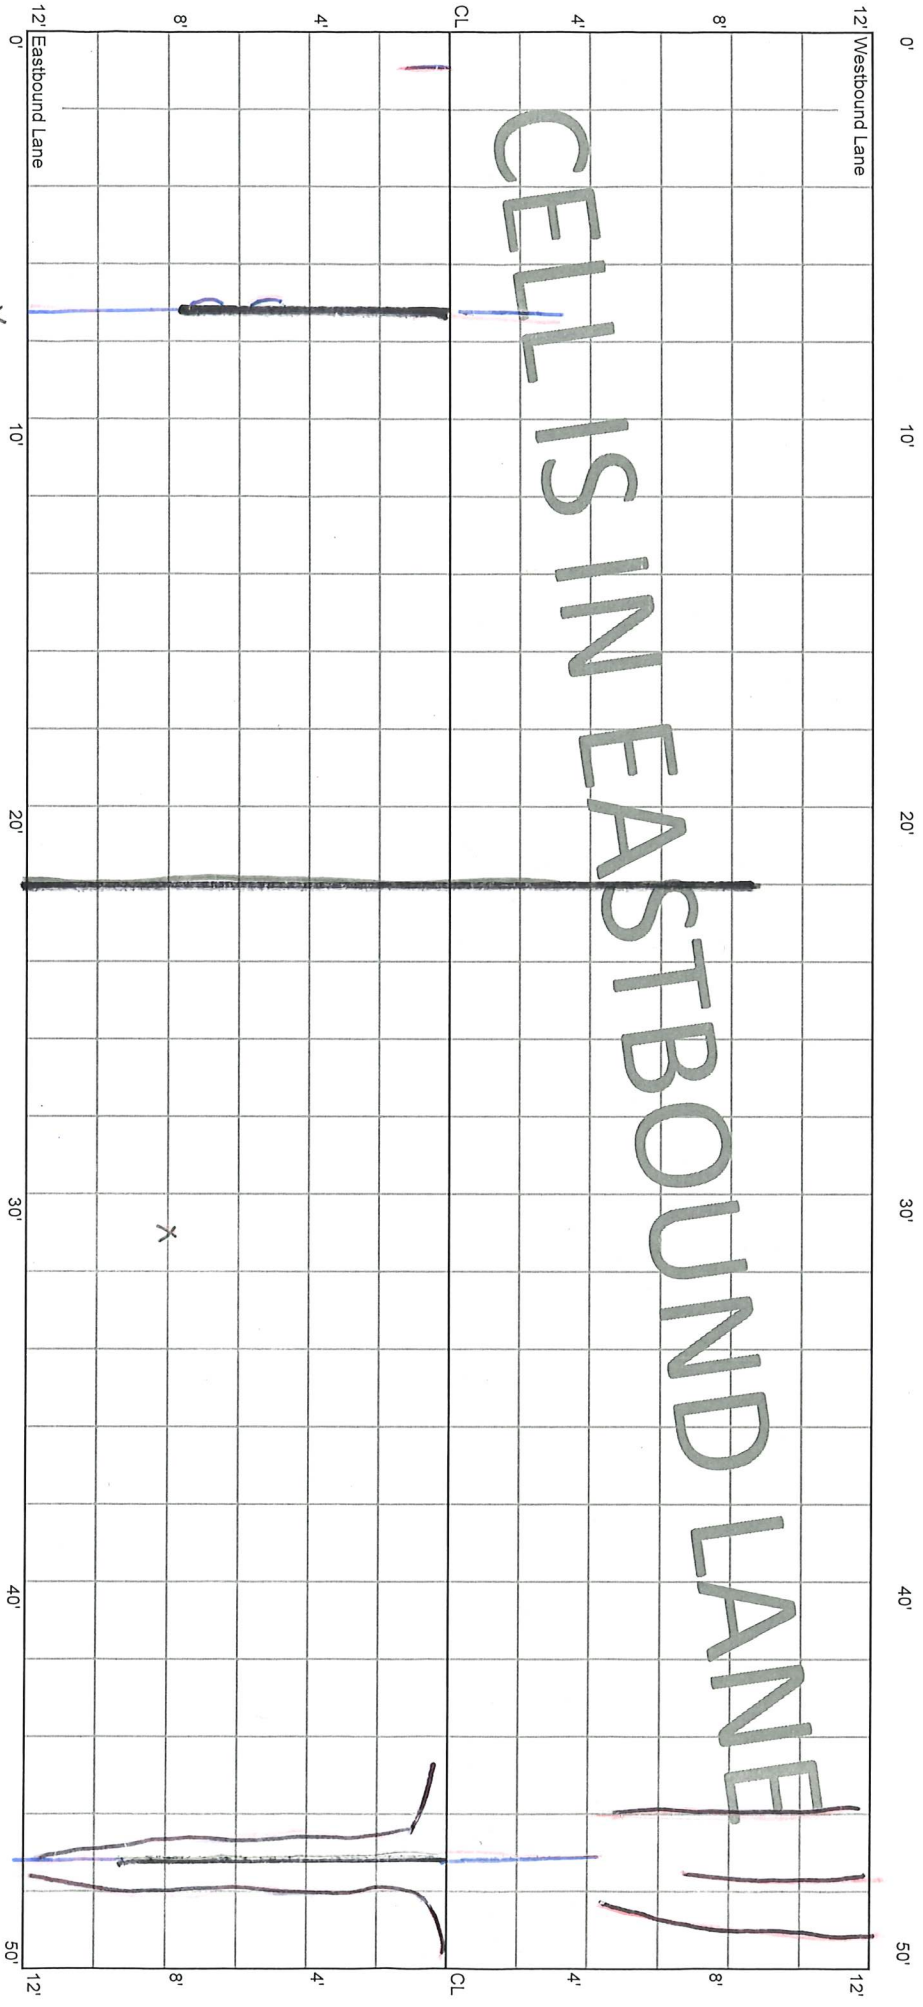

M  
8 in AF, SP

M

X

X popout


H  
SP

CELL 7001E  
300 - 350 ft

3+00

3+50

CELL IS IN EASTBOUND LANE

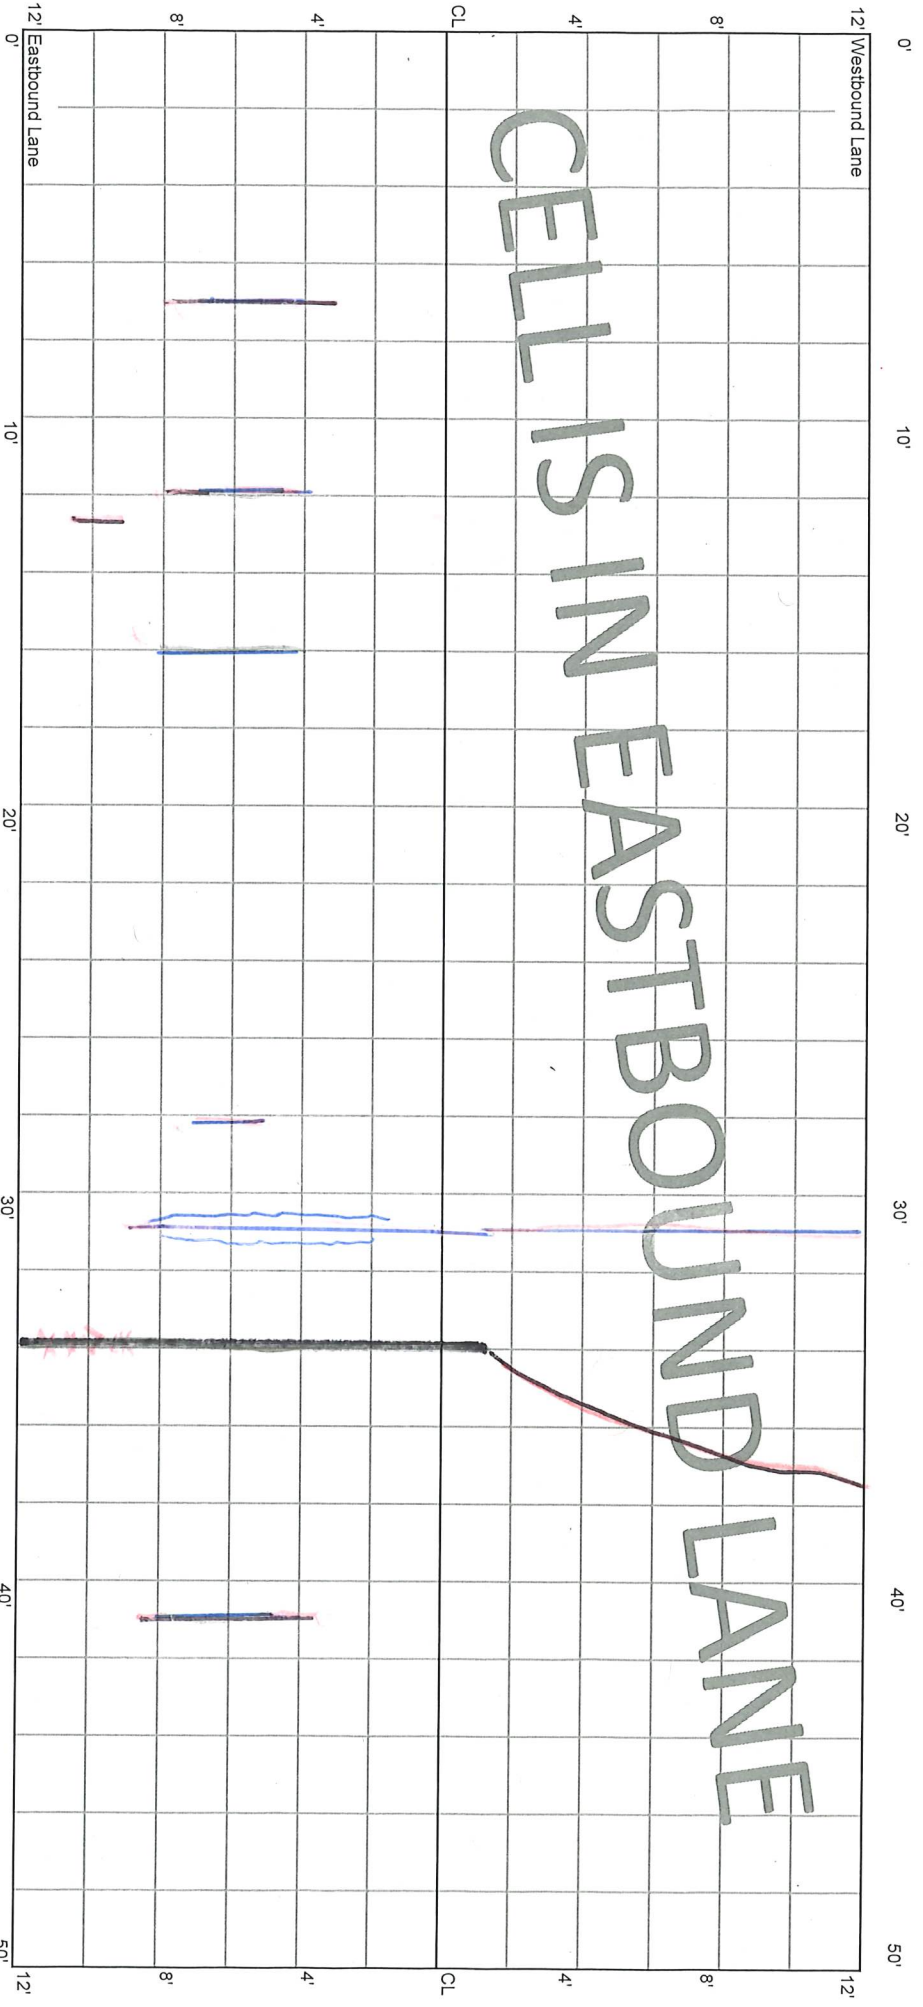

M M

\* M


M S'

P 319

CELL 7001E  
350 - 400 ft

3+50

4+00

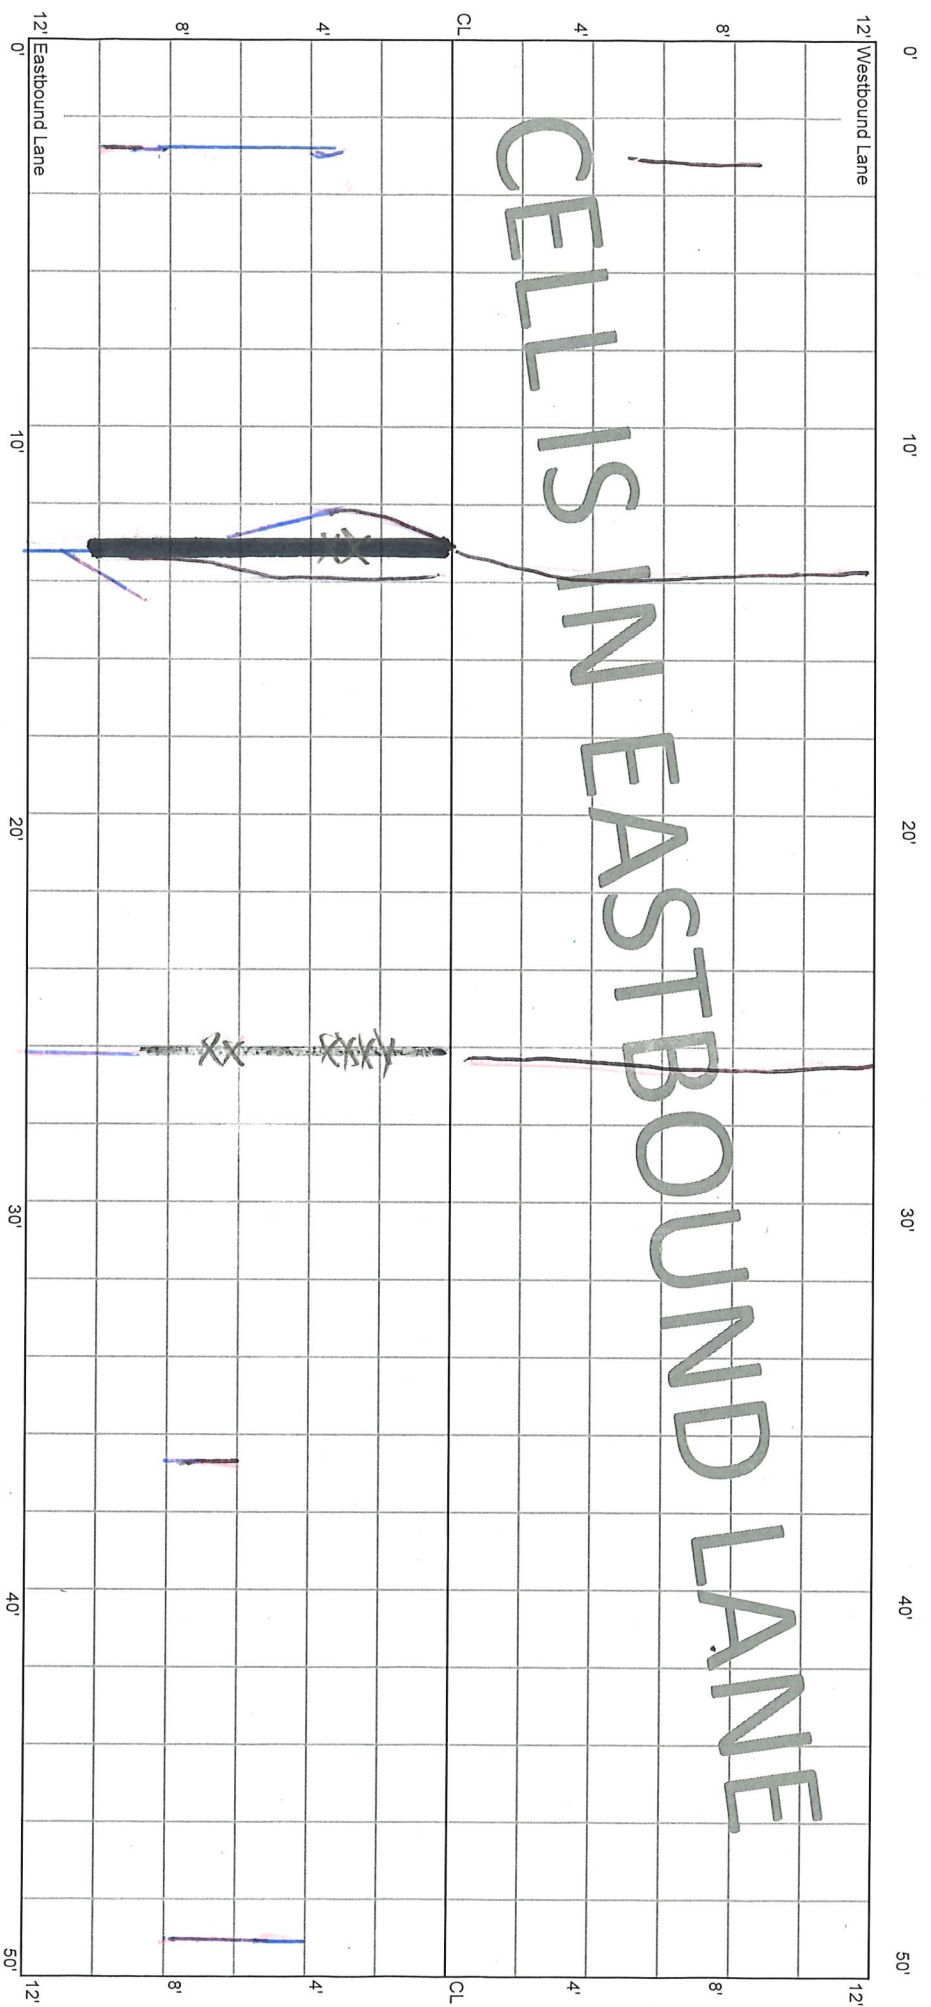




CELL 7001E  
400 - 450 ft

4+00

4+50

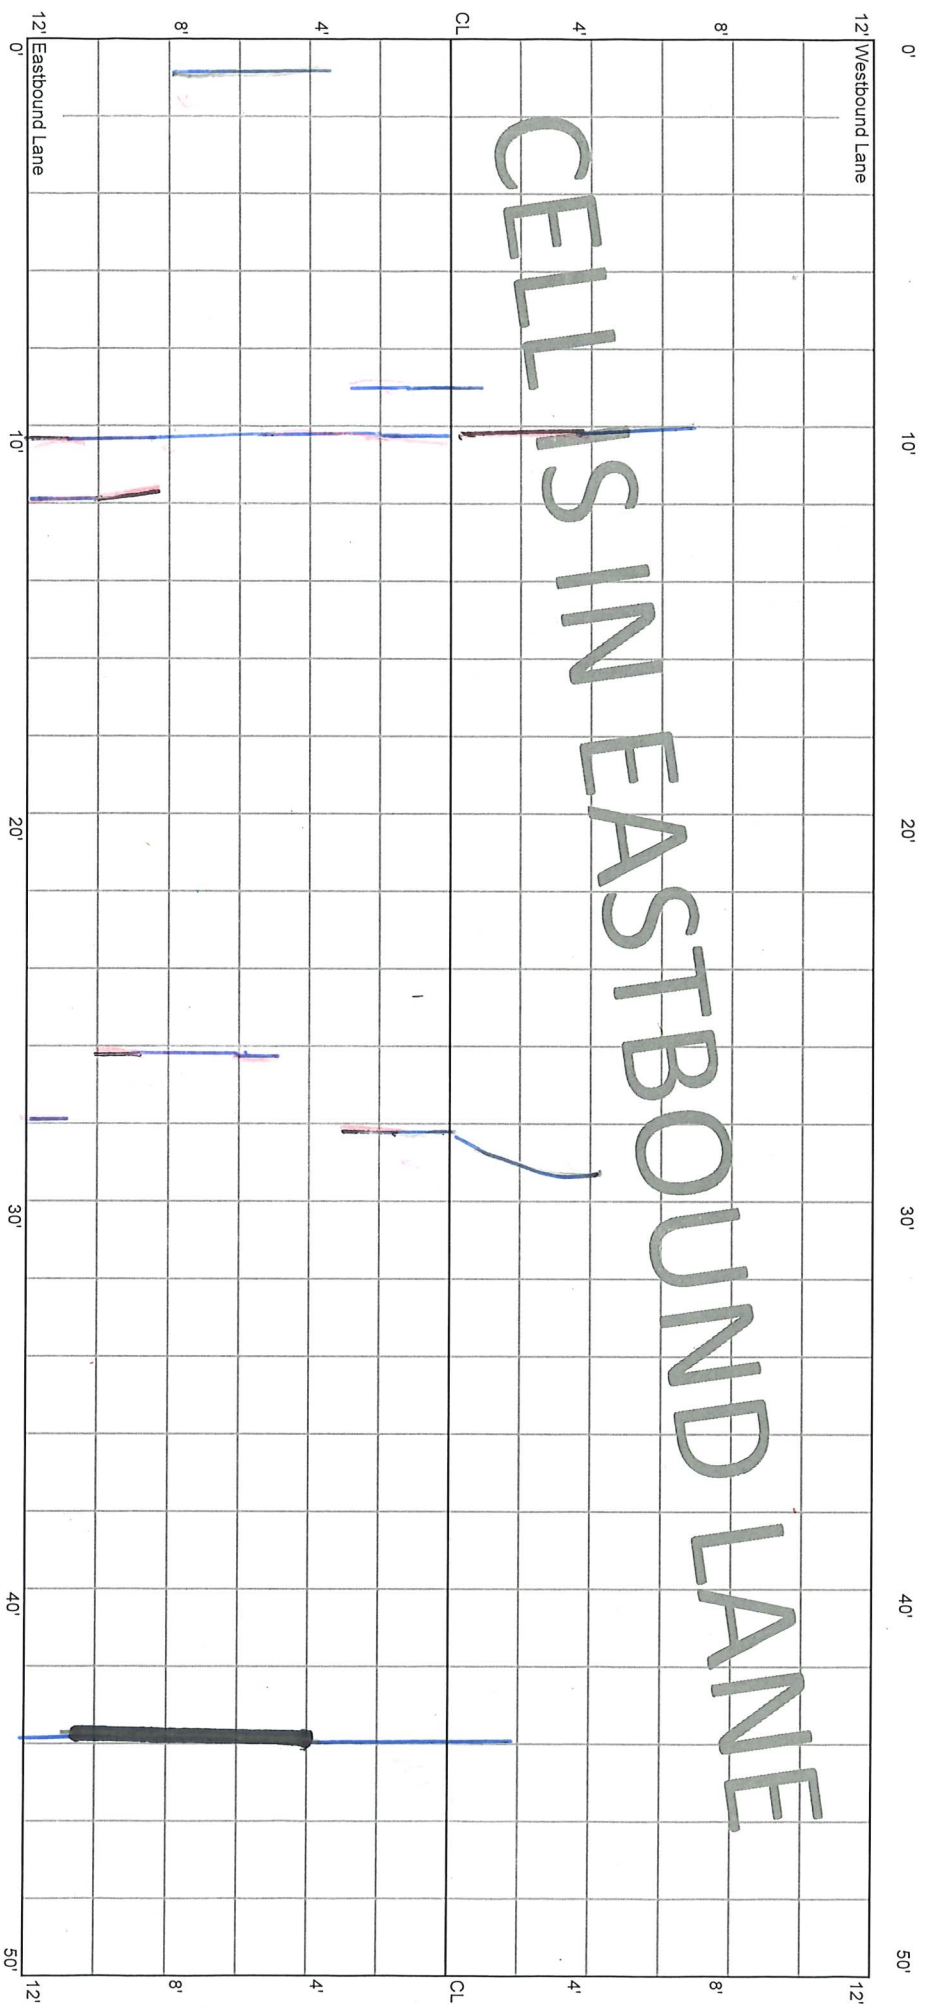

CELL IS IN EASTBOUND LANE

12' Westbound Lane

12' Eastbound Lane

CL

1st M

12' M

1/4" = 1'


1/2" S.P., 1/2" A.F.

7'-ft (S.S. 21)

CELL 7001E  
450 - 500 ft

4+50

5+00

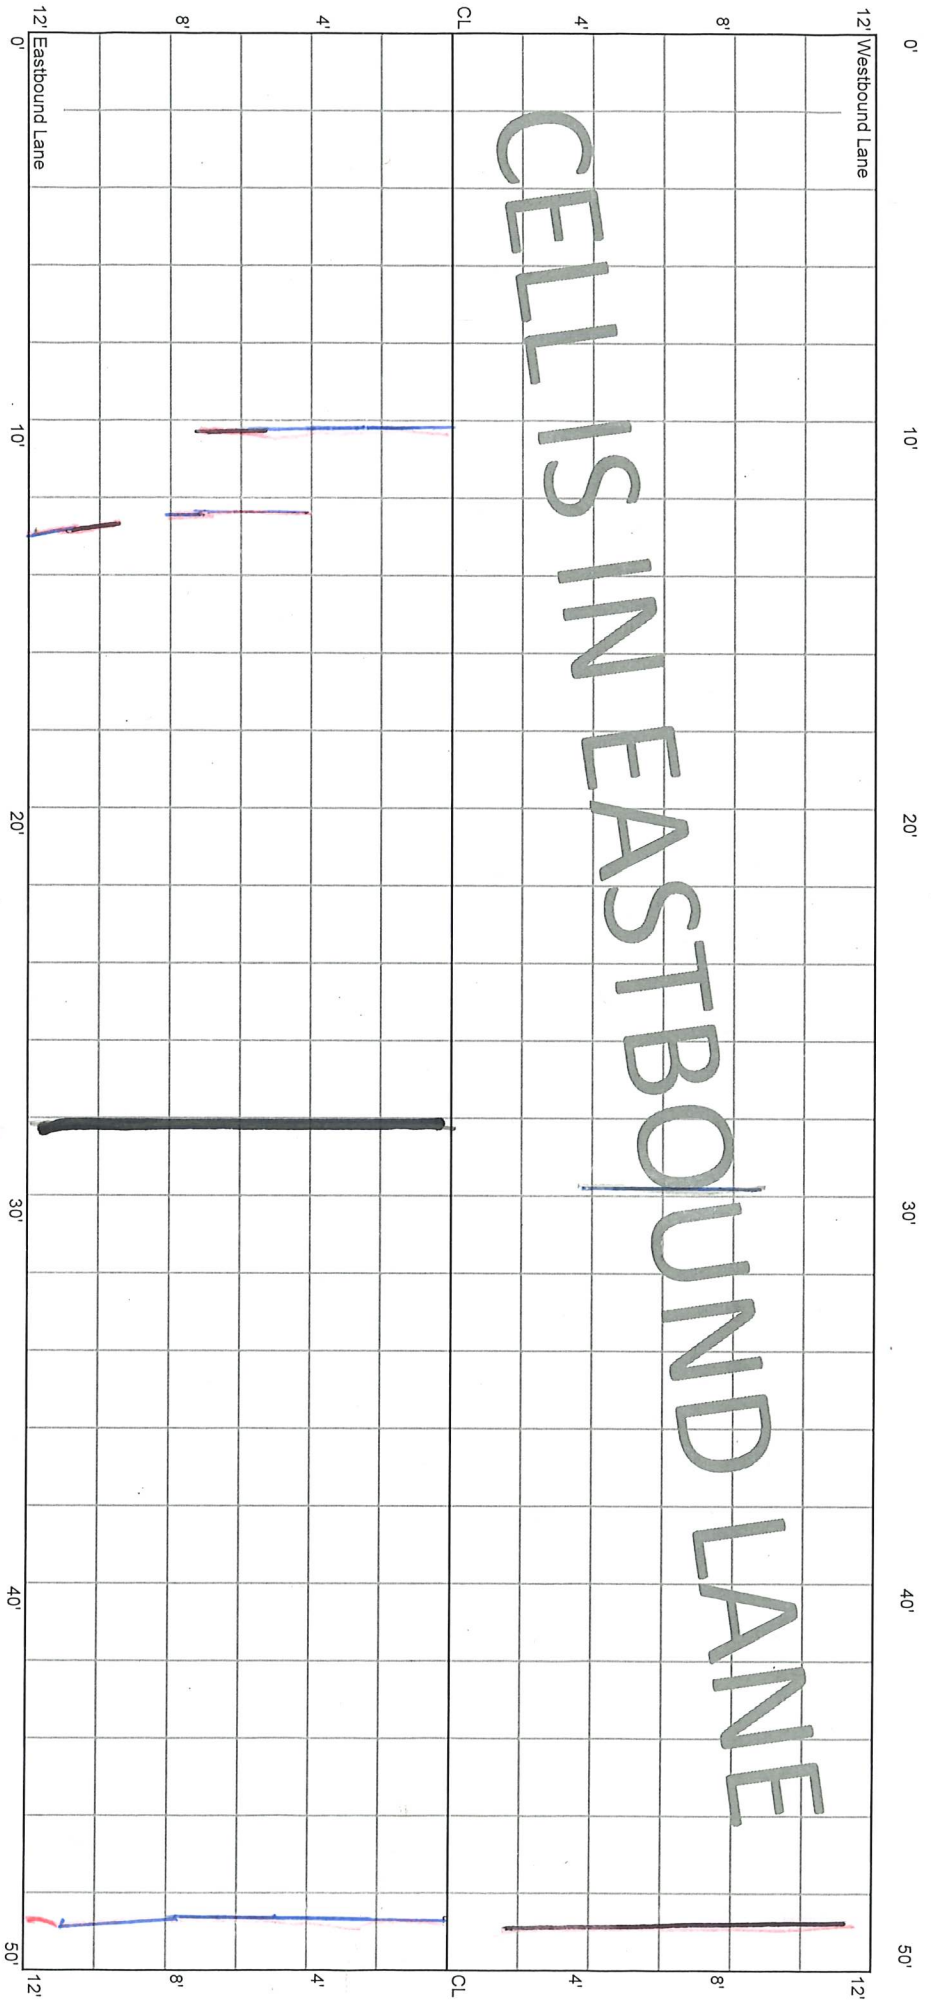


CELL IS IN EASTBOUND LANE

M

(AF, SP) - 2++

CELL 7001E  
500 - 550 ft

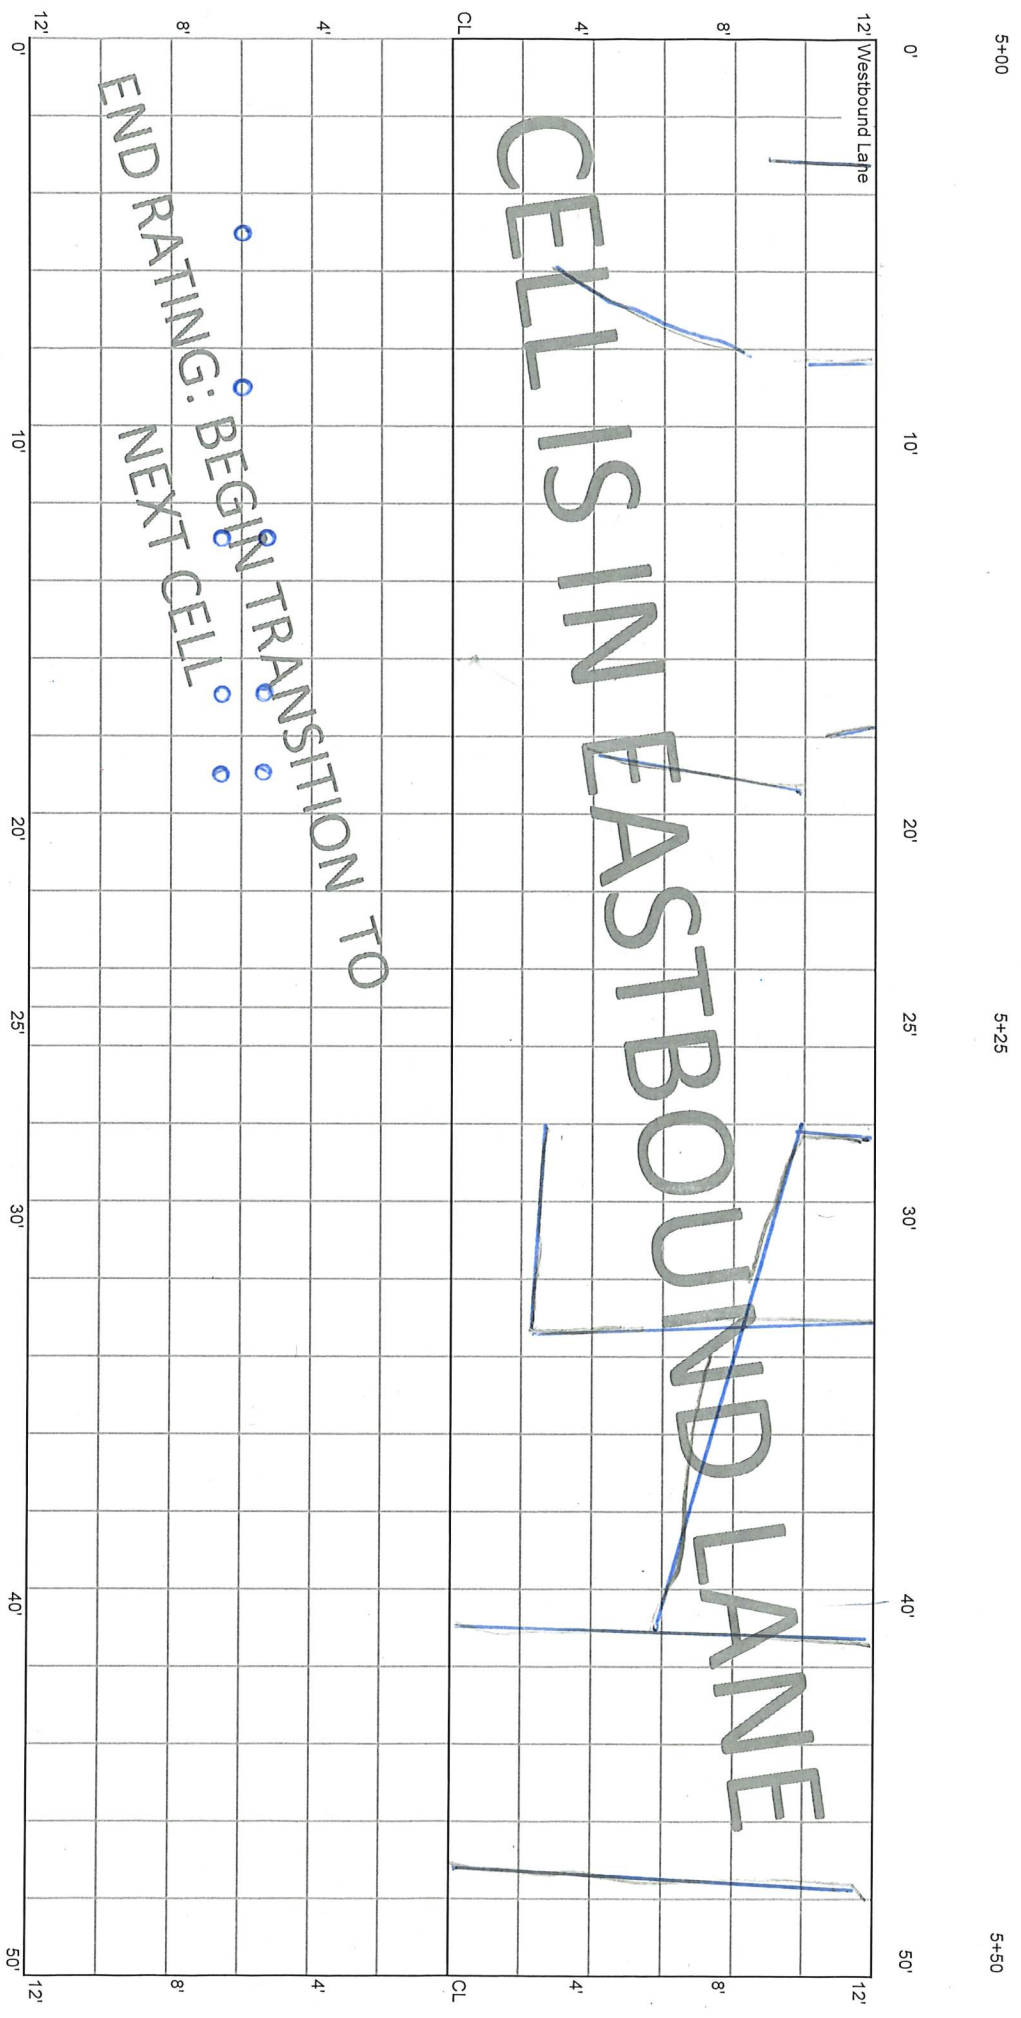

(0: out 20  
cores)

END RATING: BEGIN TRANSITION TO  
NEXT CELL

CELL IS IN EASTBOUND LANE



2