

5.28.20 E.T.

10.14.20

1.4.21


File 70TH ST

8.5.21

CELL 7002E
0 - 50 ft

5+50

6+00

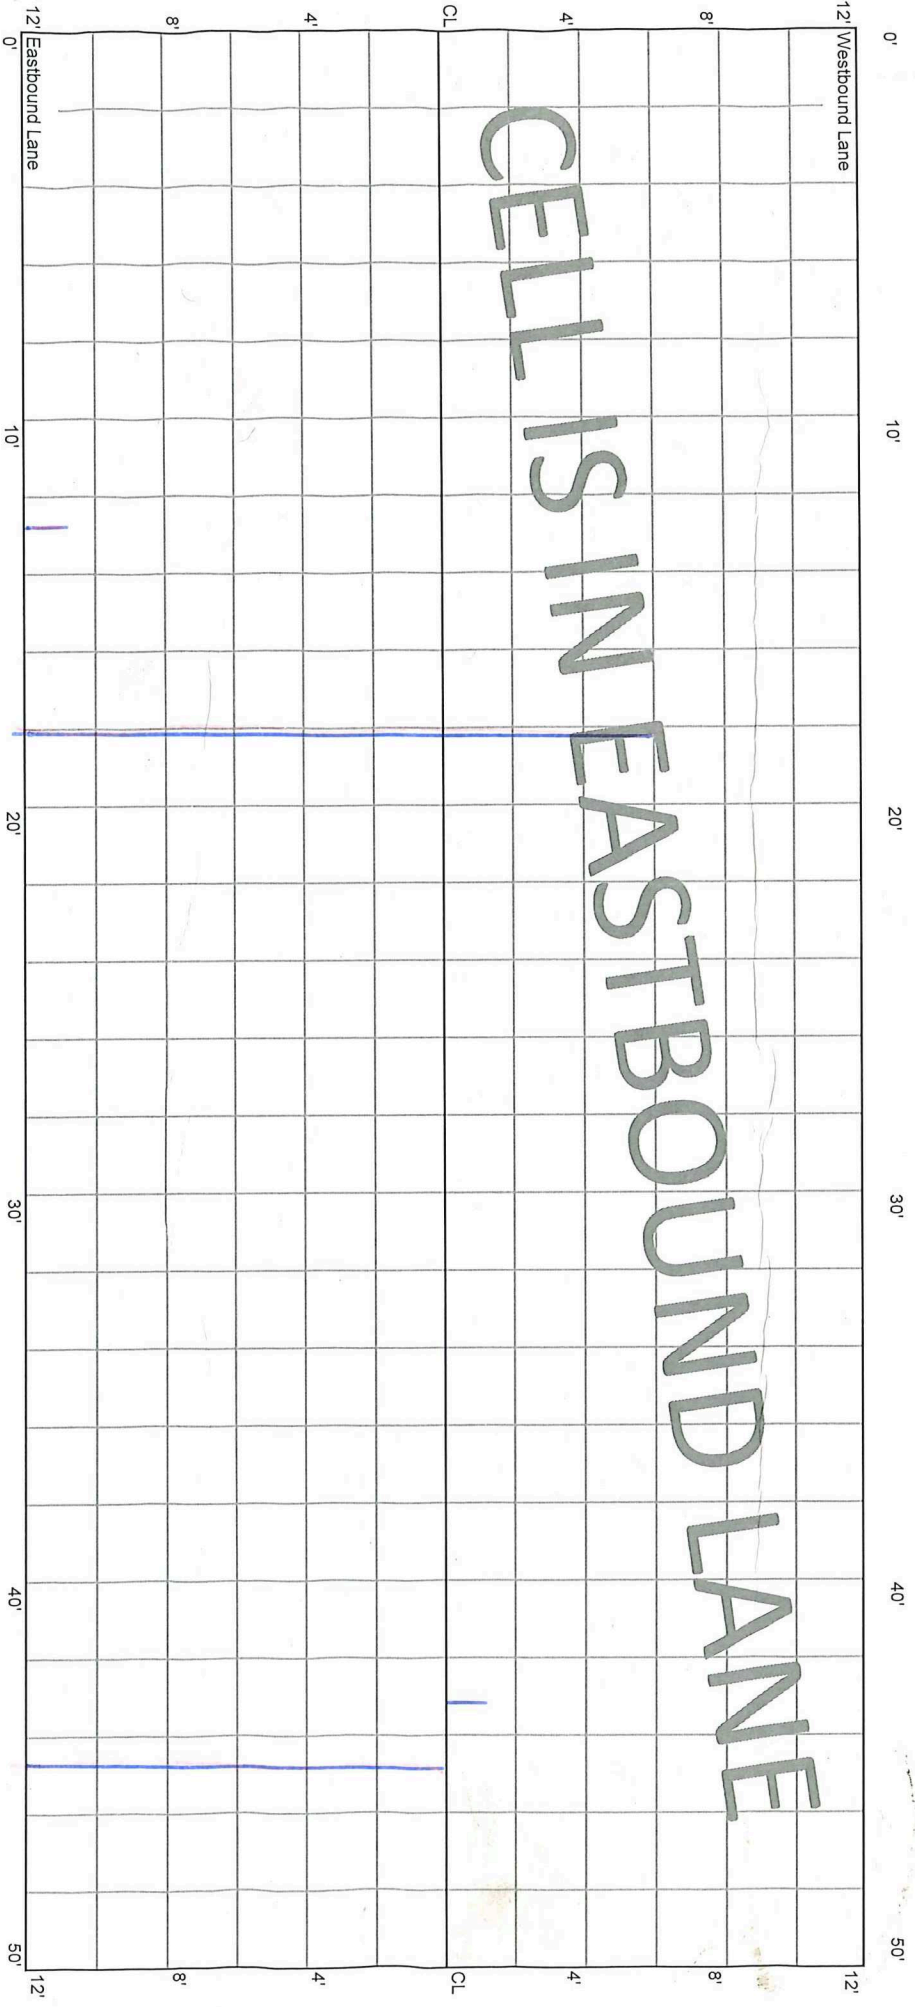


* Rout & Seal


CELL 7002E
50 - 100 ft

6+00

6+50

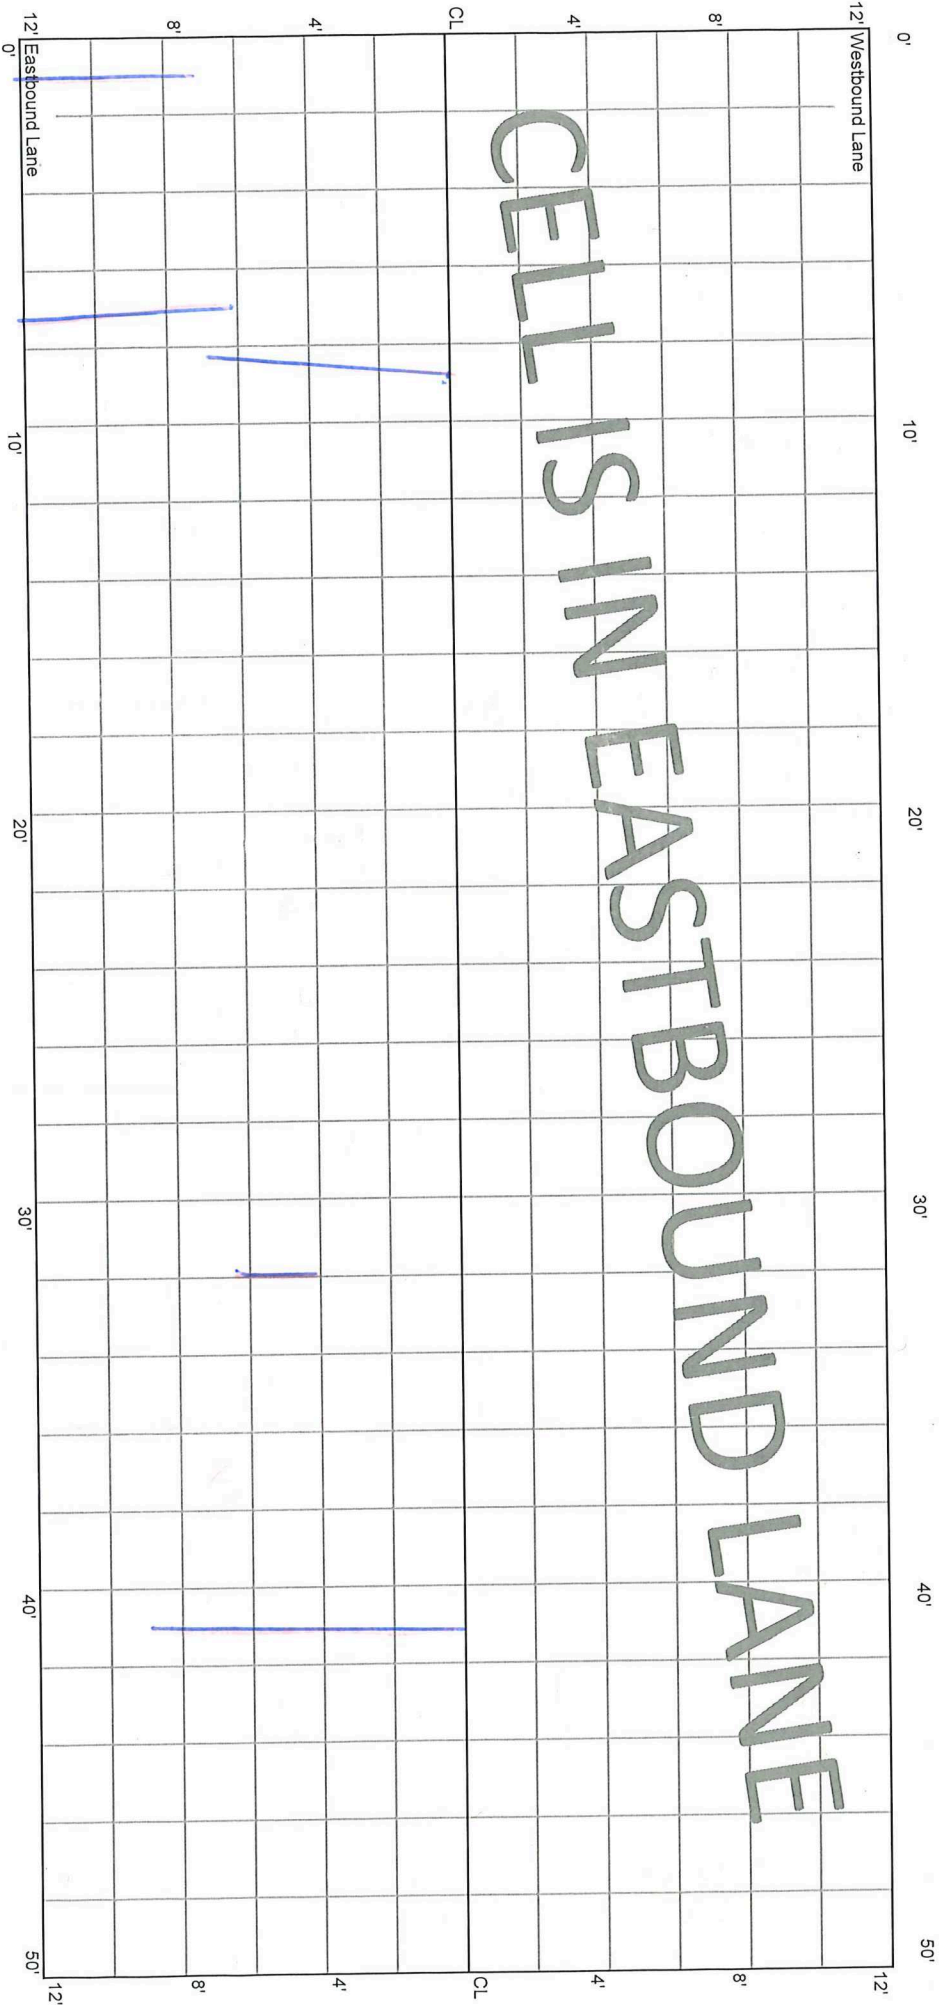

CELL 7002E
100 - 150 ft

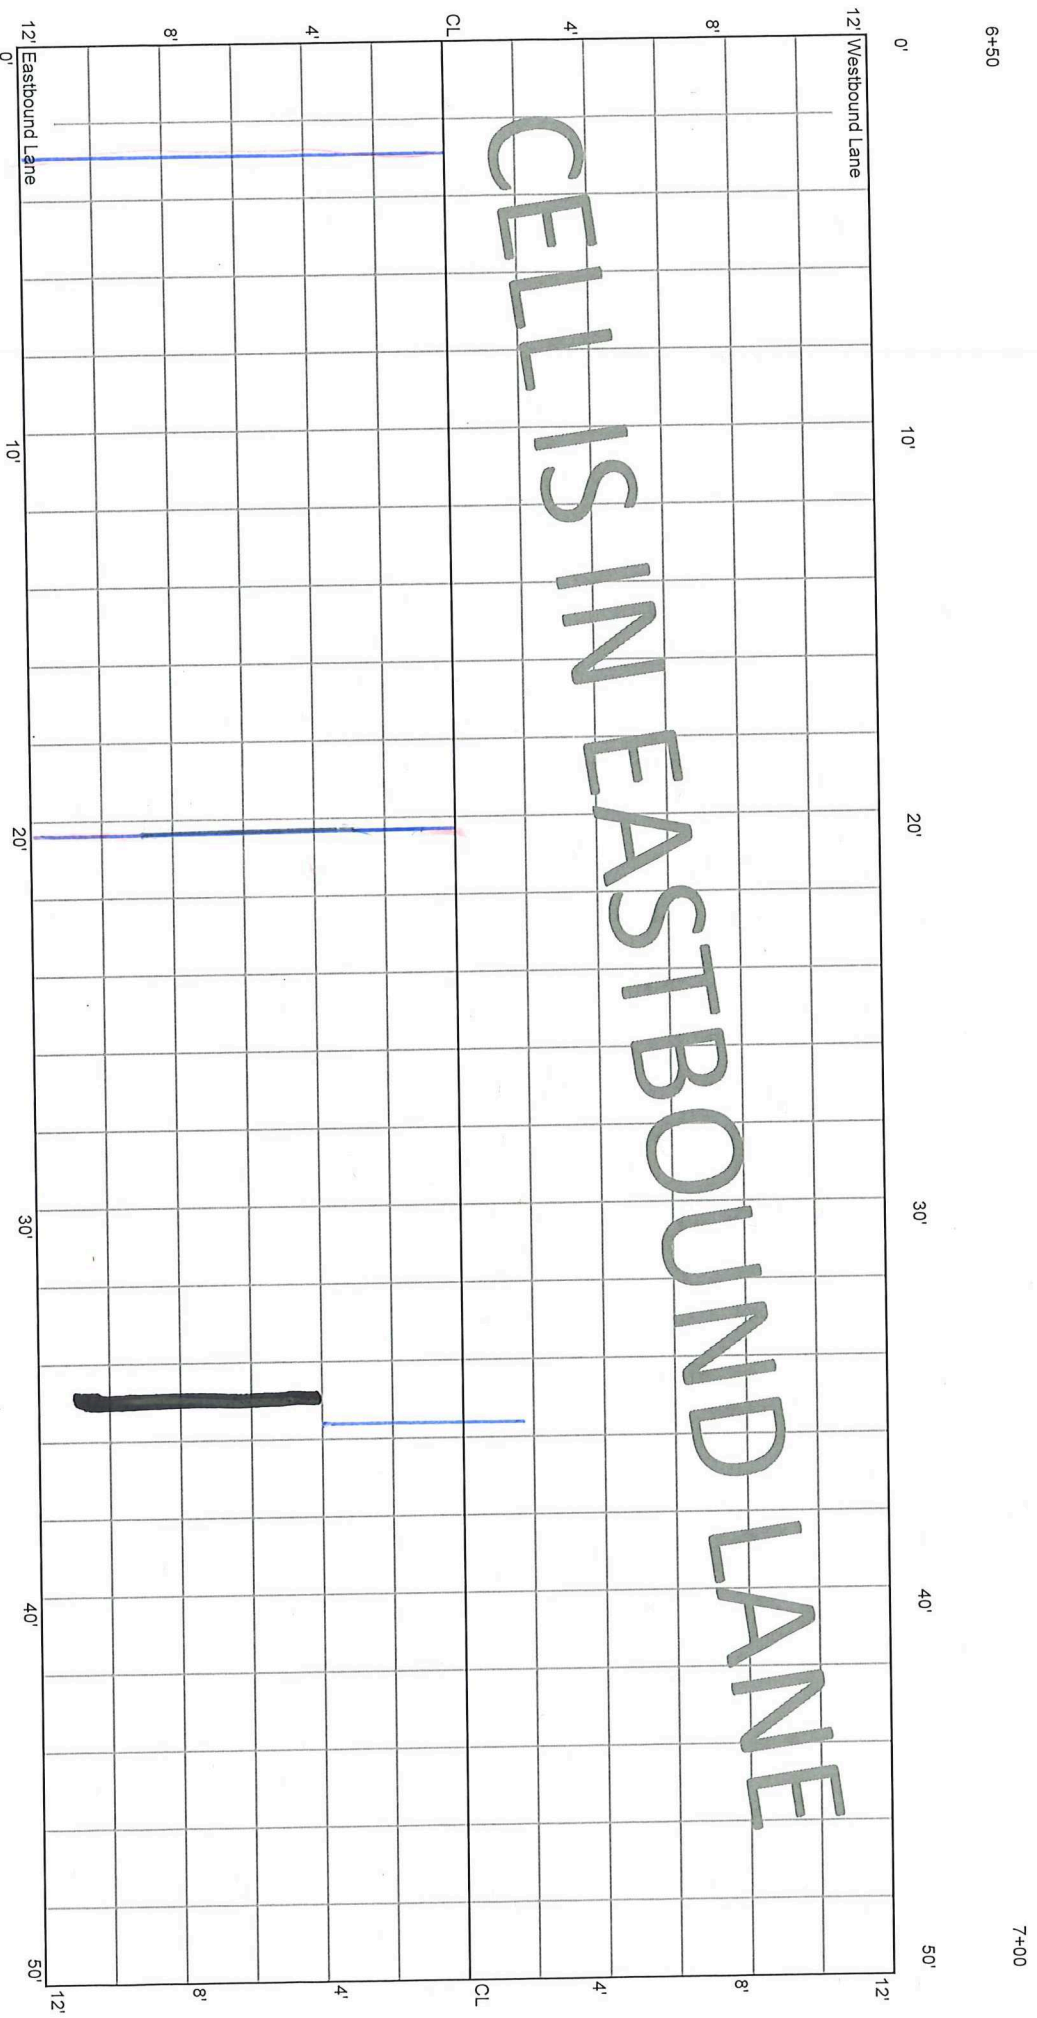

6+50


7+00

*

CELL 7002E
150 - 200 ft

7+00


7+50

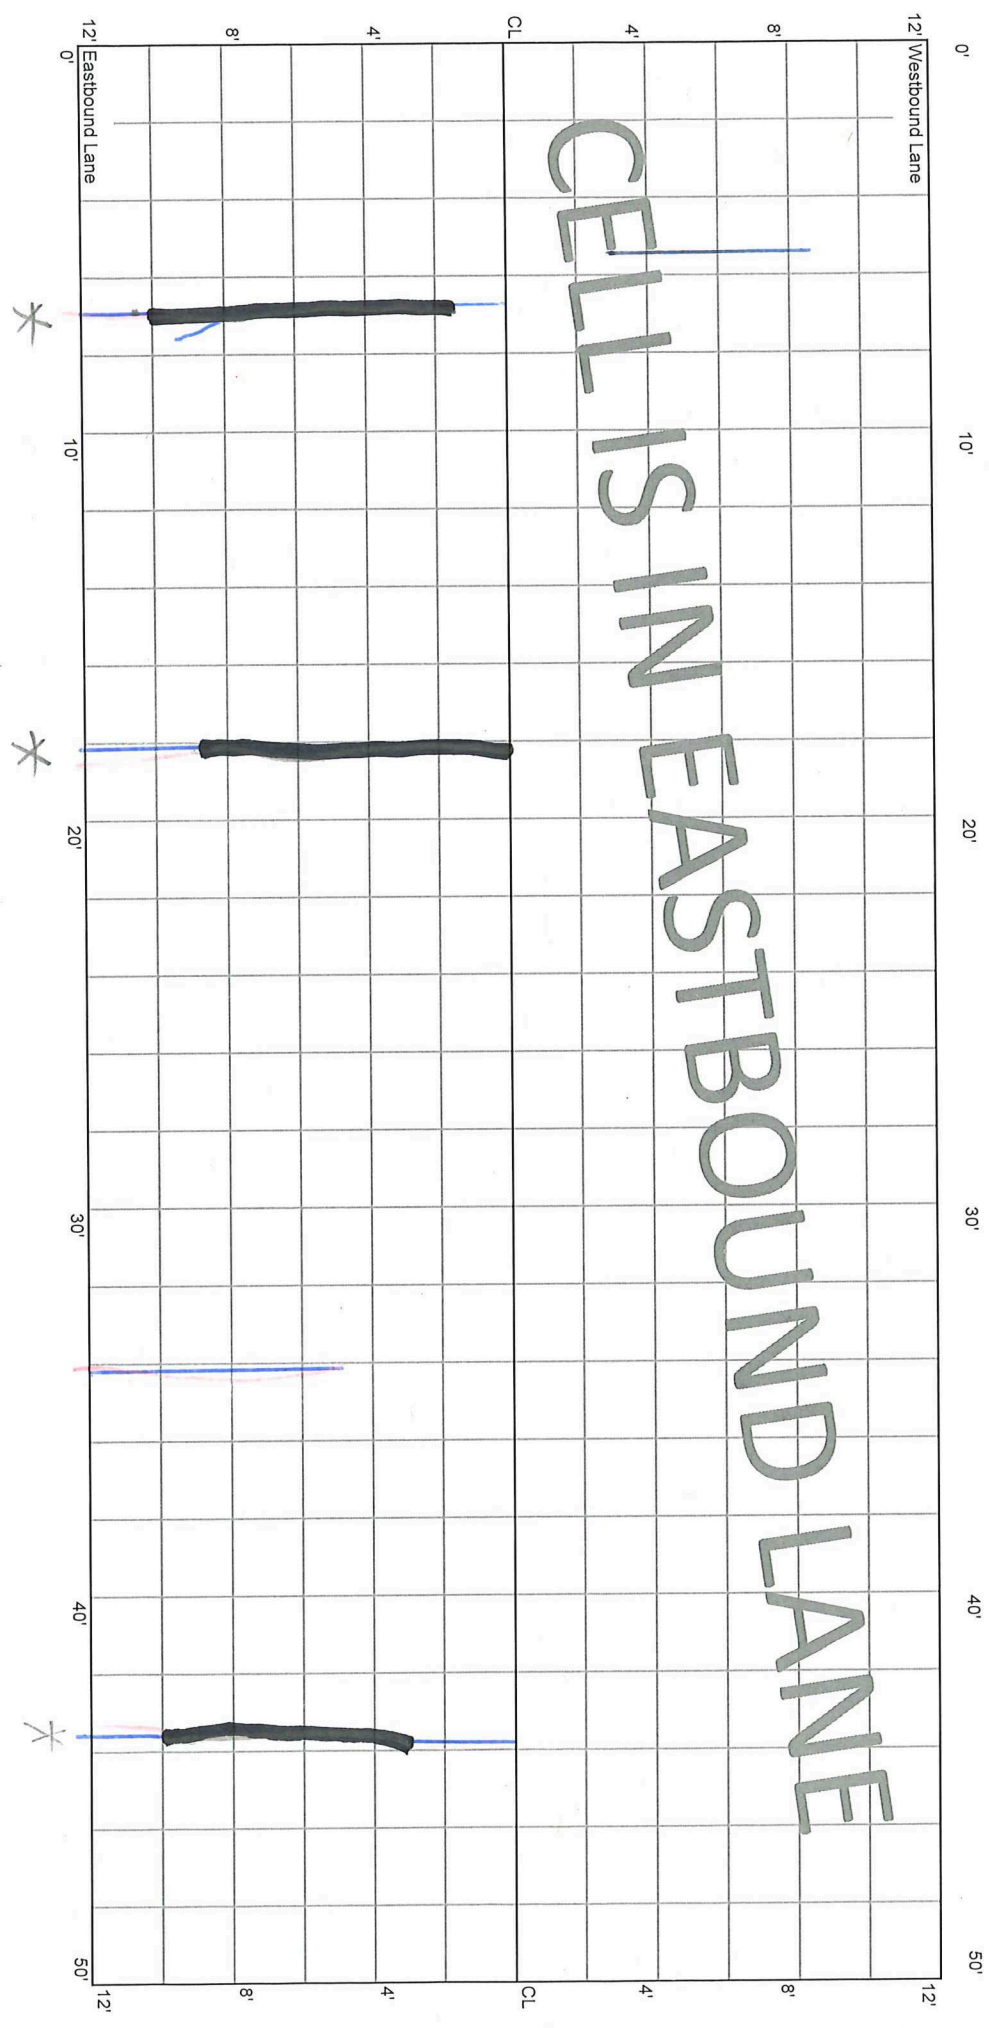

CELL 7002E
200 - 250 ft

7+50

8+00

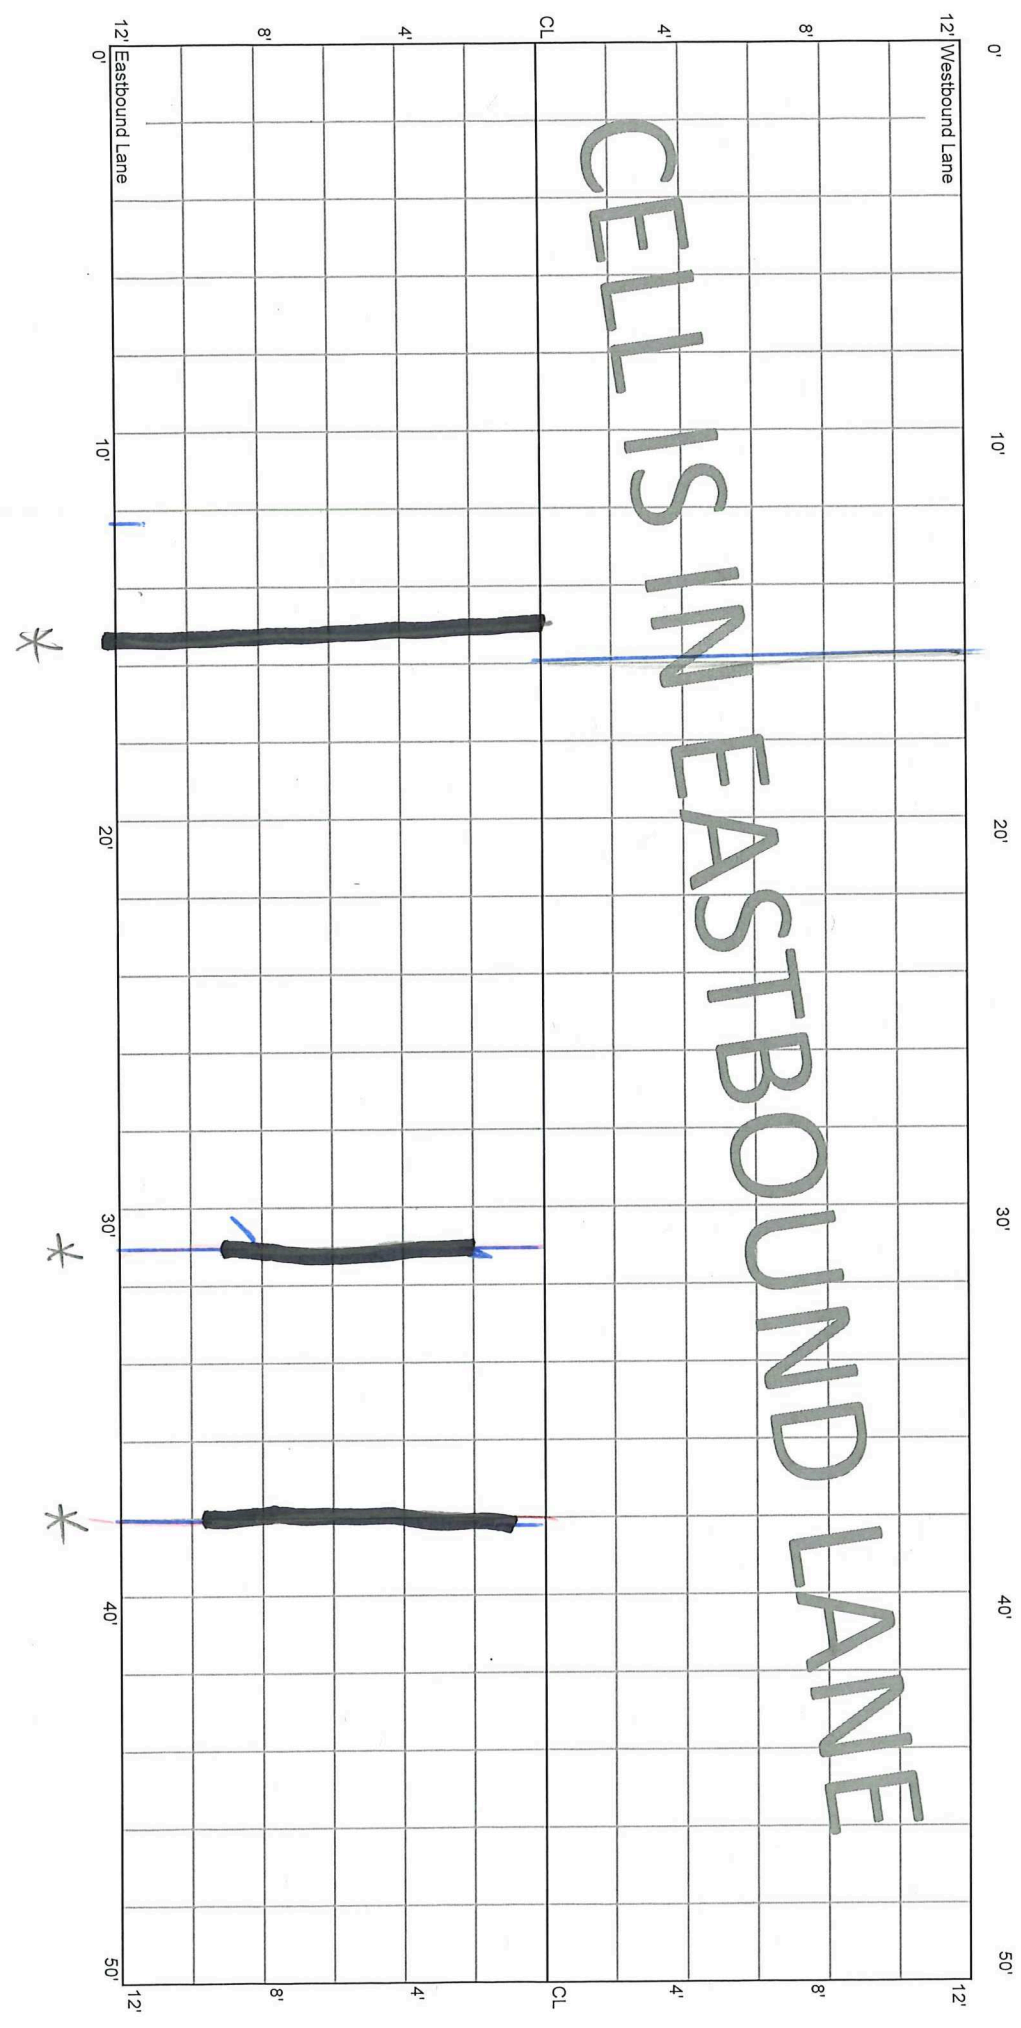


CELL 7002E
250 - 300 ft

8+00

8+50

CELLS IN EASTBOUND LANE

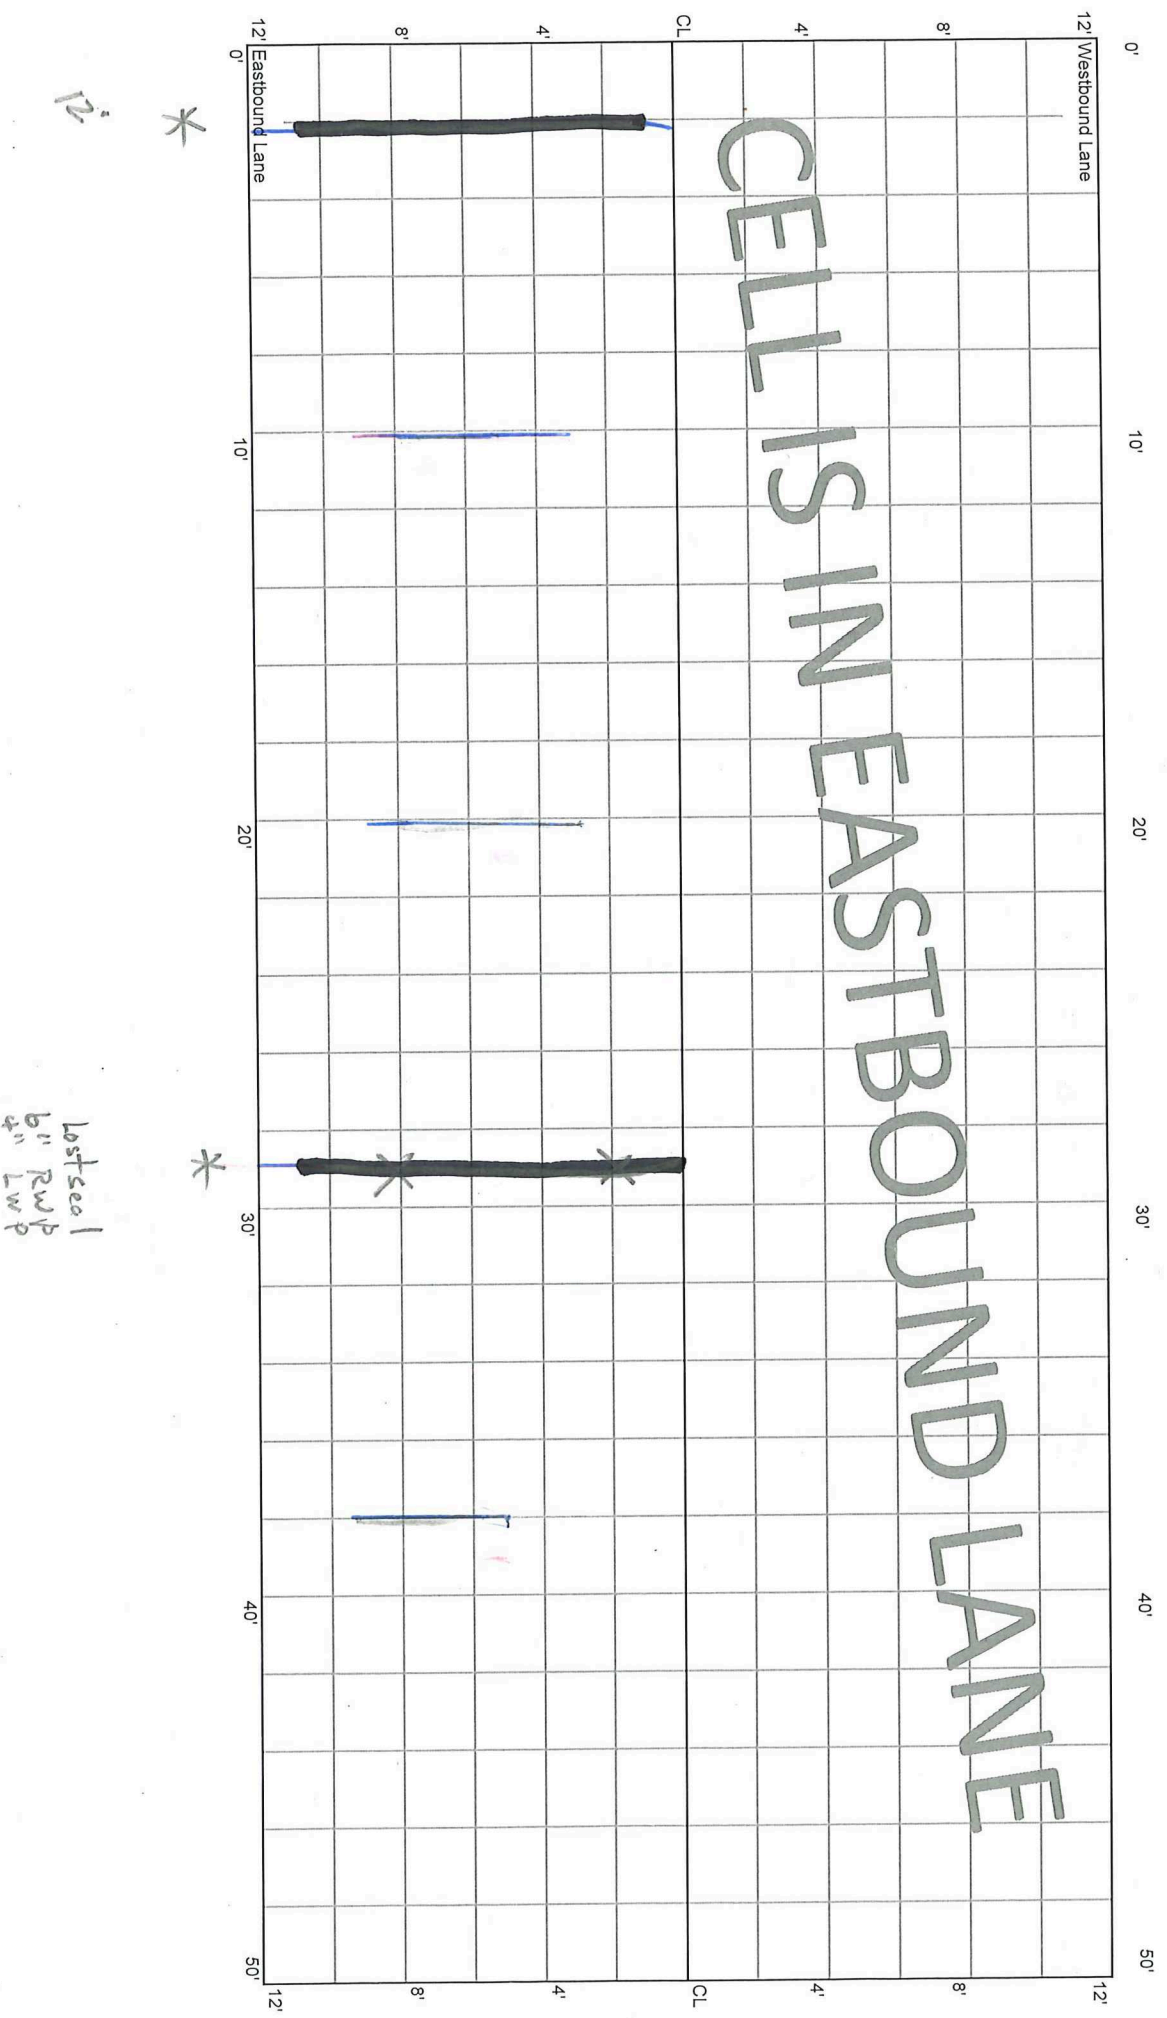


Lost seal
6" RW/P
4" LW/P

CELL 7002E
300 - 350 ft

8+50

9+00

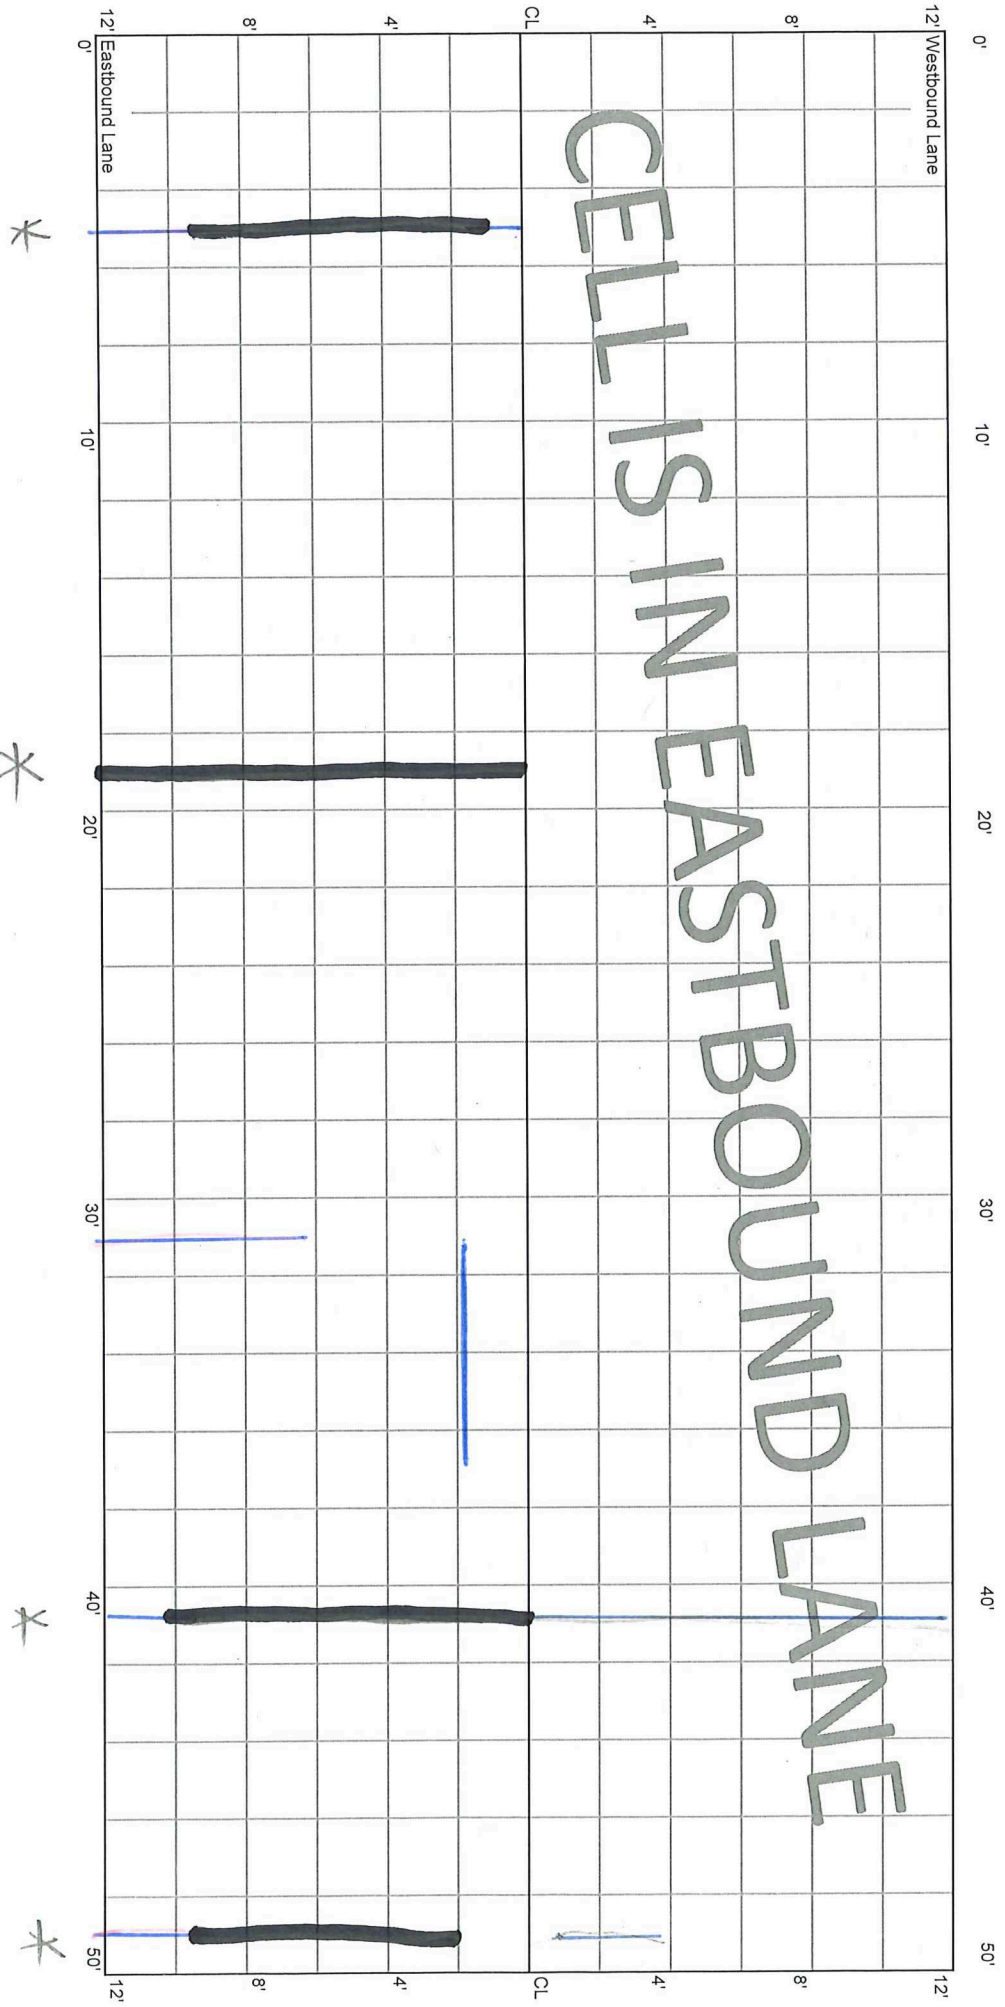


LS. 6th Sup

CELL 7002E
350 - 400 ft

9+00

9+50

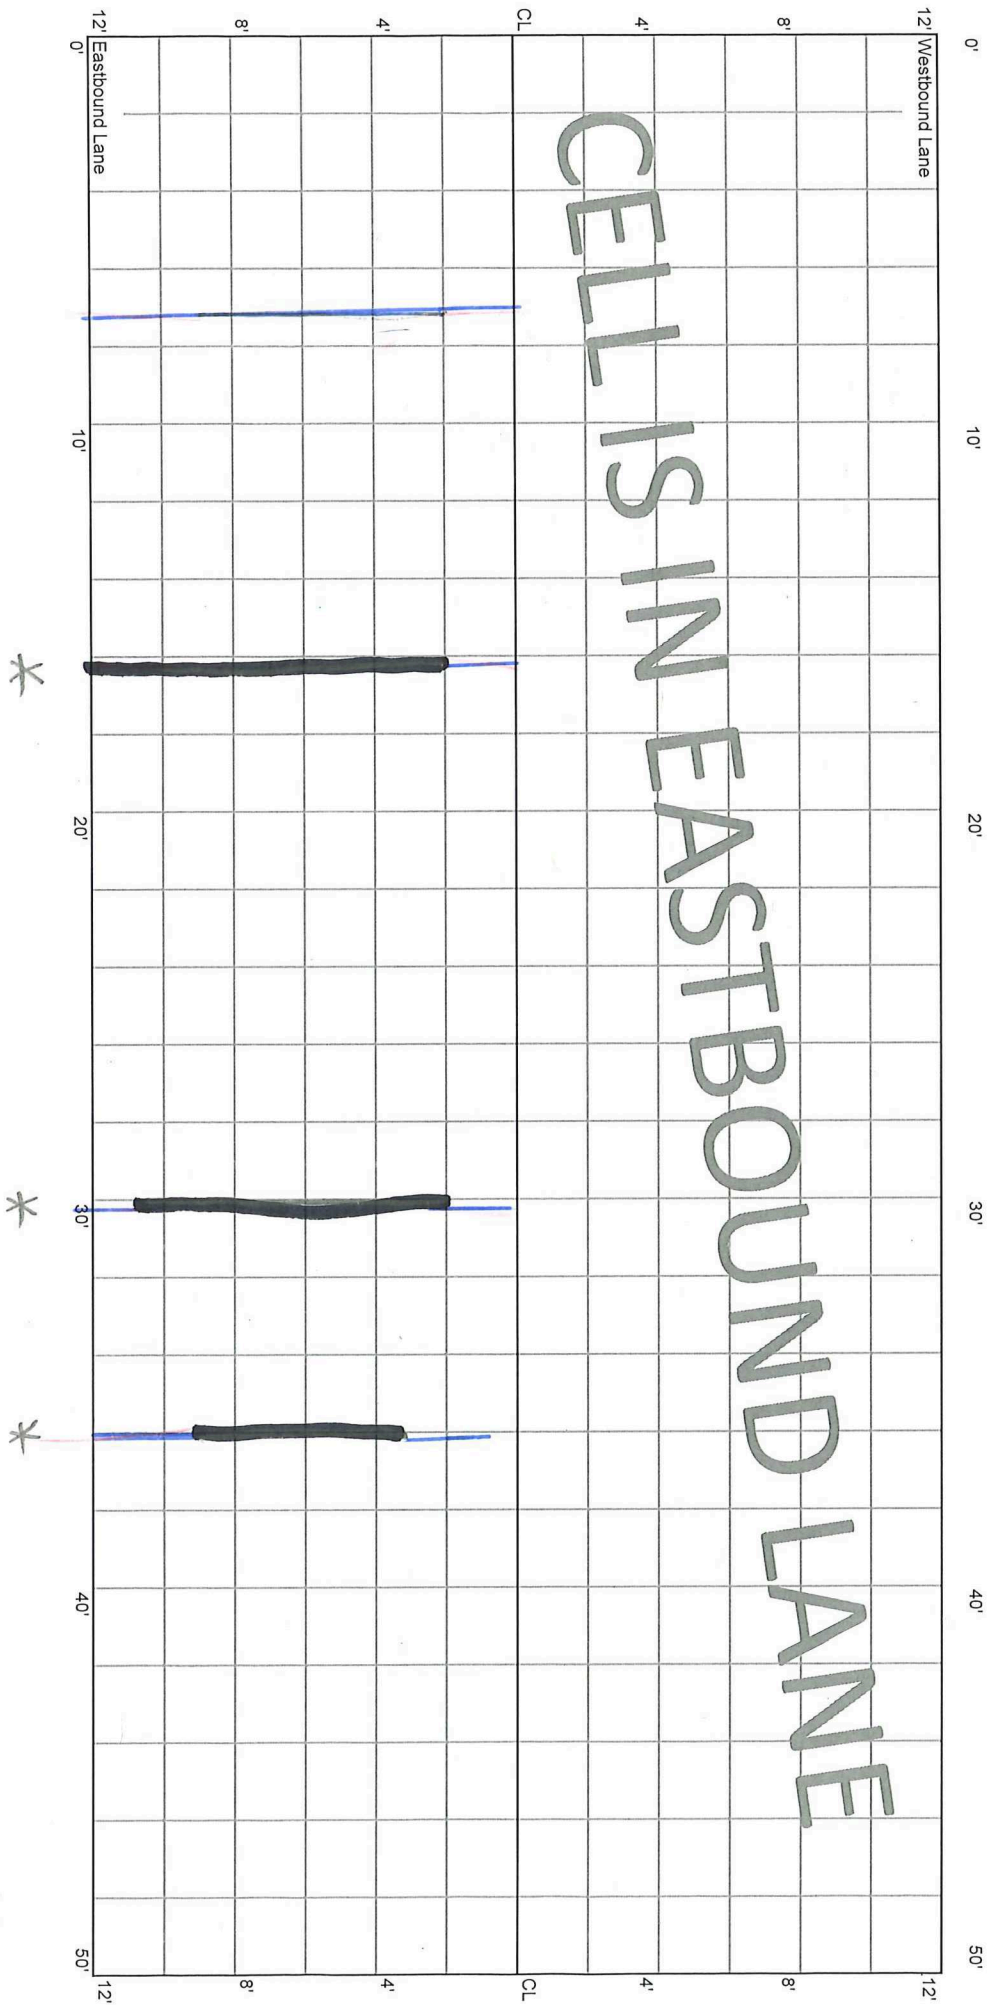

CELL 7002E
450 - 500 ft

10+00

10+50

12' Westbound Lane

12'


CL

CL

12' Eastbound Lane

12'

CELL IS IN EASTBOUND LANE

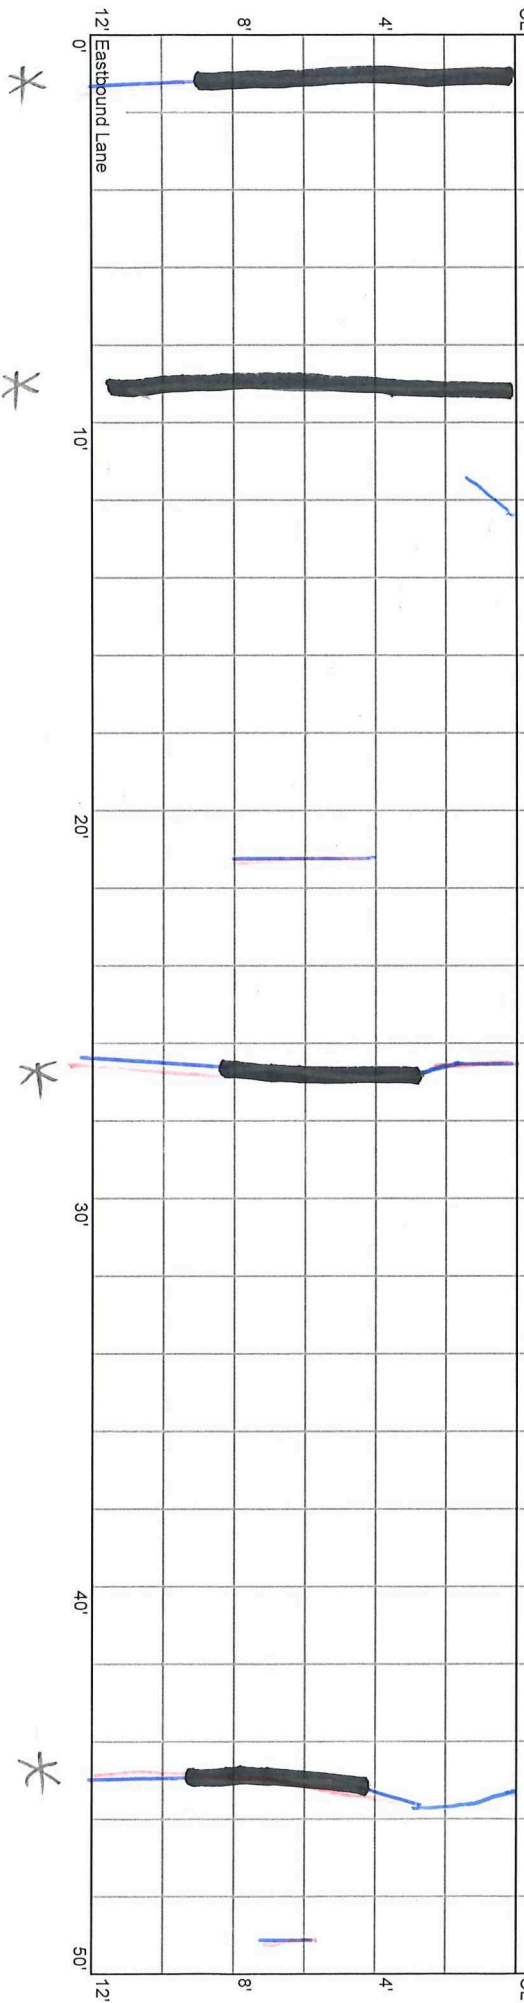


Not Sealed

CELL 7002E
500 - 550 ft

10+50

10+75

11+00

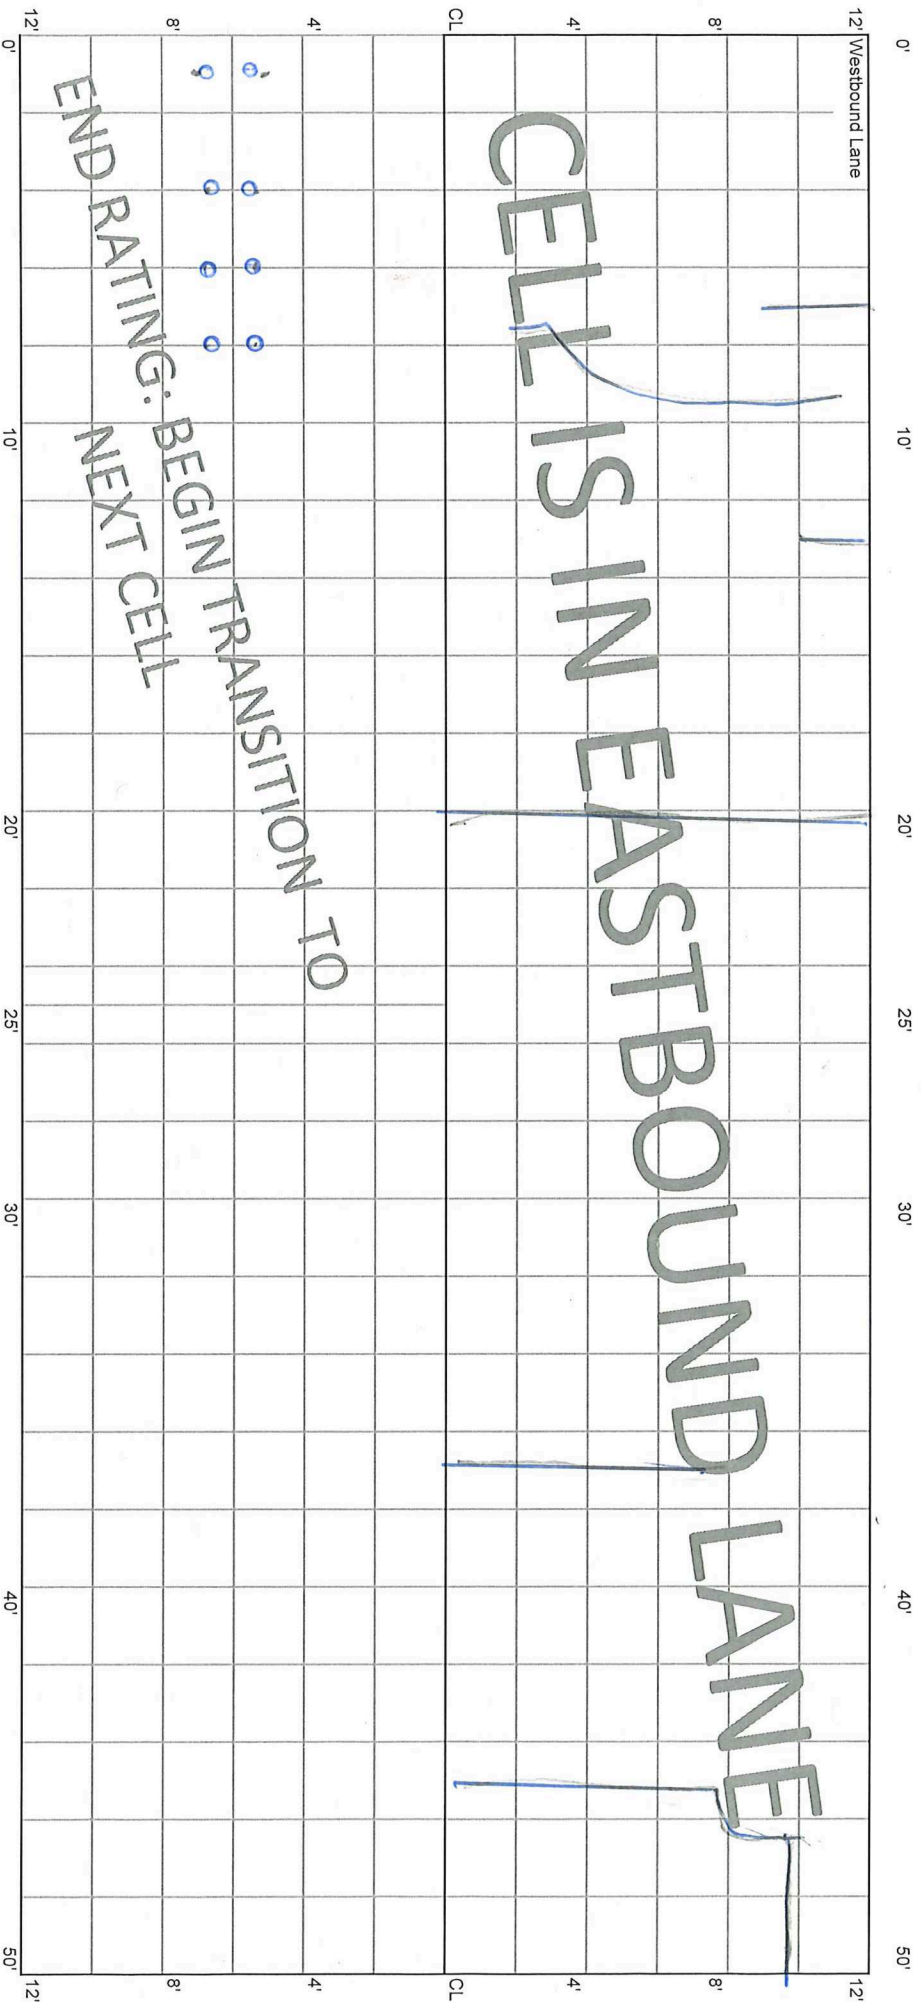

(0:10:10
CORSES)