


5.28.20 E.T.
10.14.20 1.3.22
1.4.21
File 70TH ST
8.5.21

CELL 7002E
0 - 50 ft


5+50

6+00

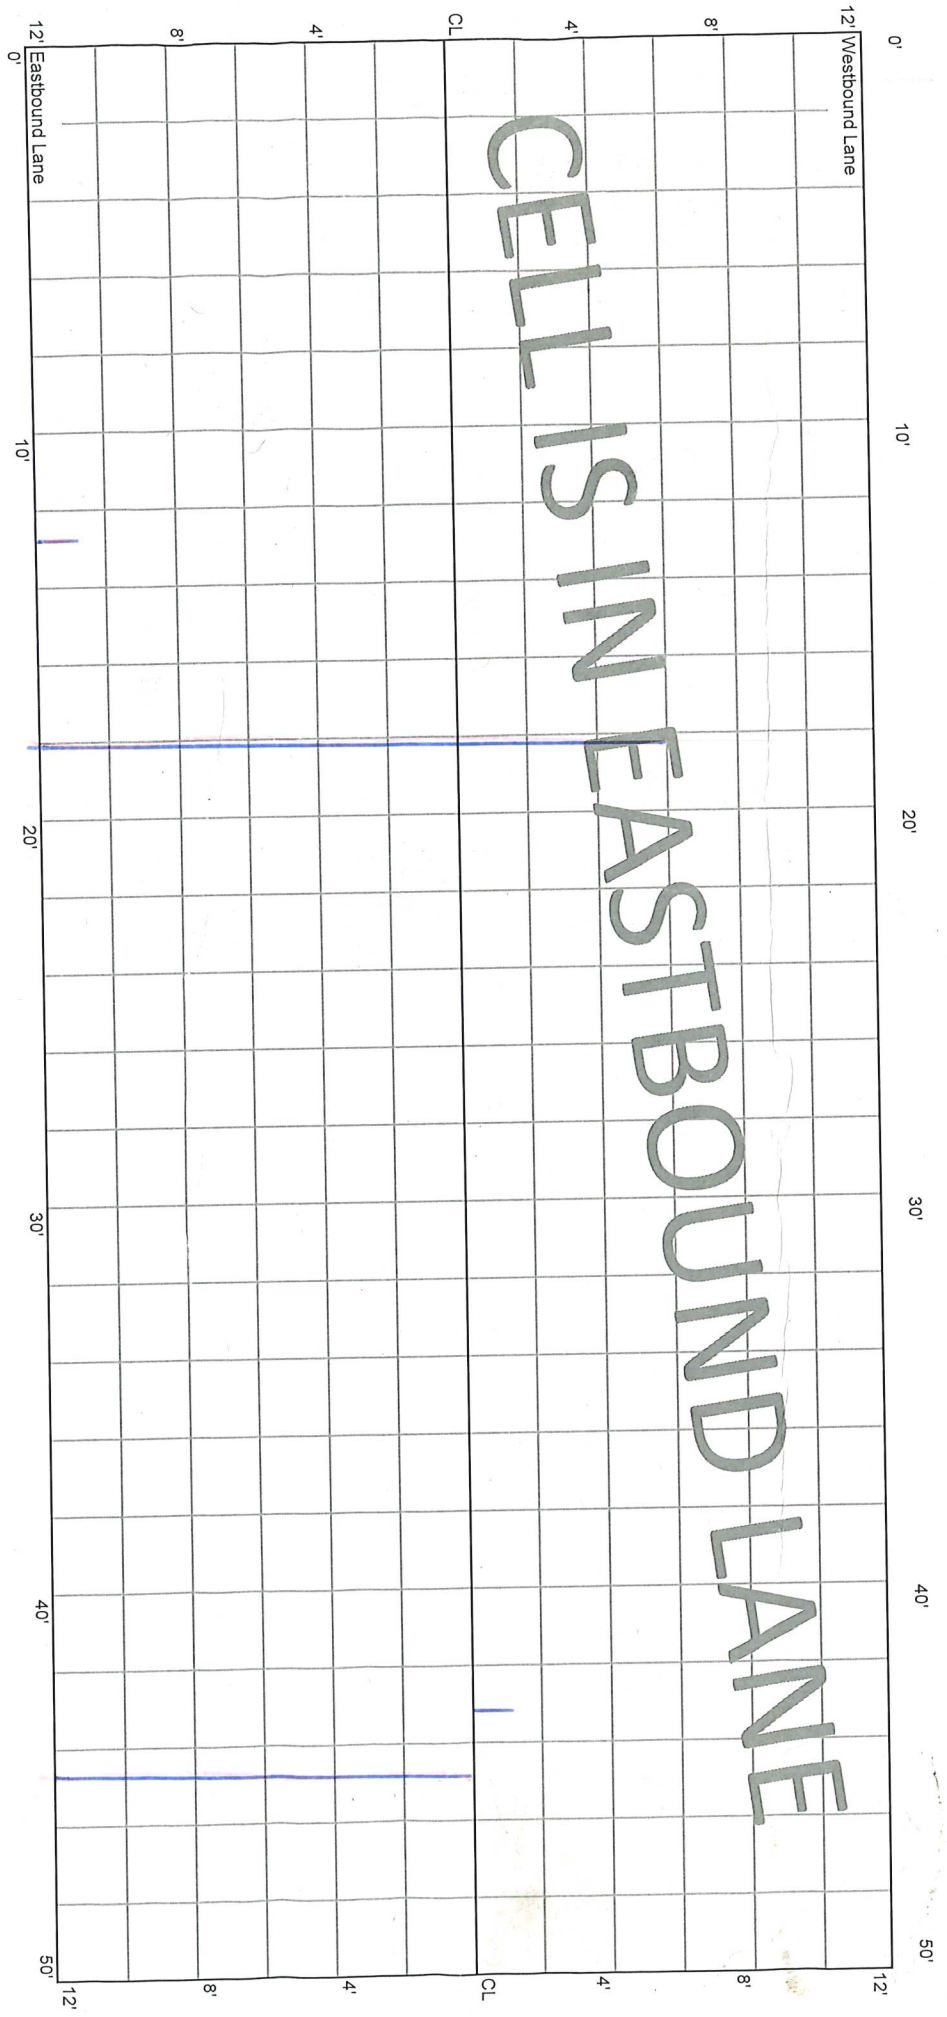

* Rout & Seal


CELL 7002E
50 - 100 ft

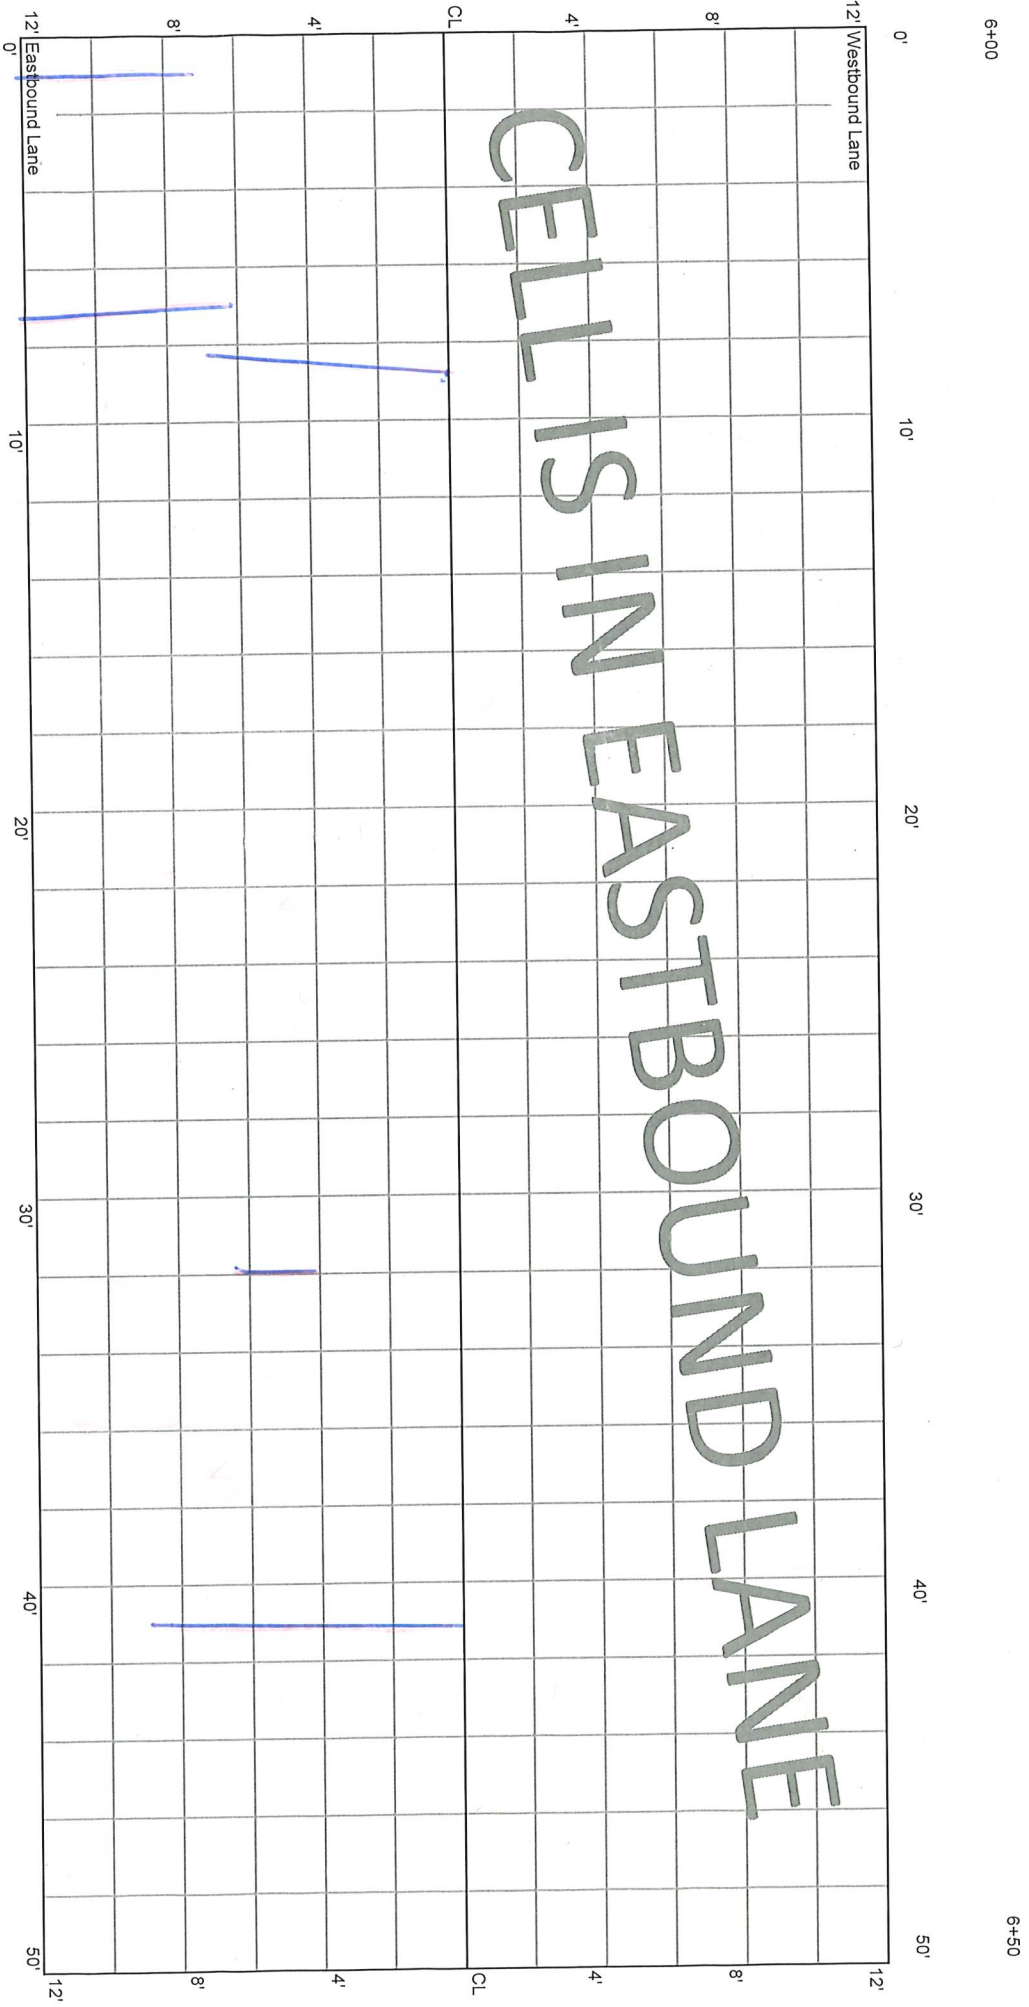

CELL 7002E
100 - 150 ft

6+50

7+00

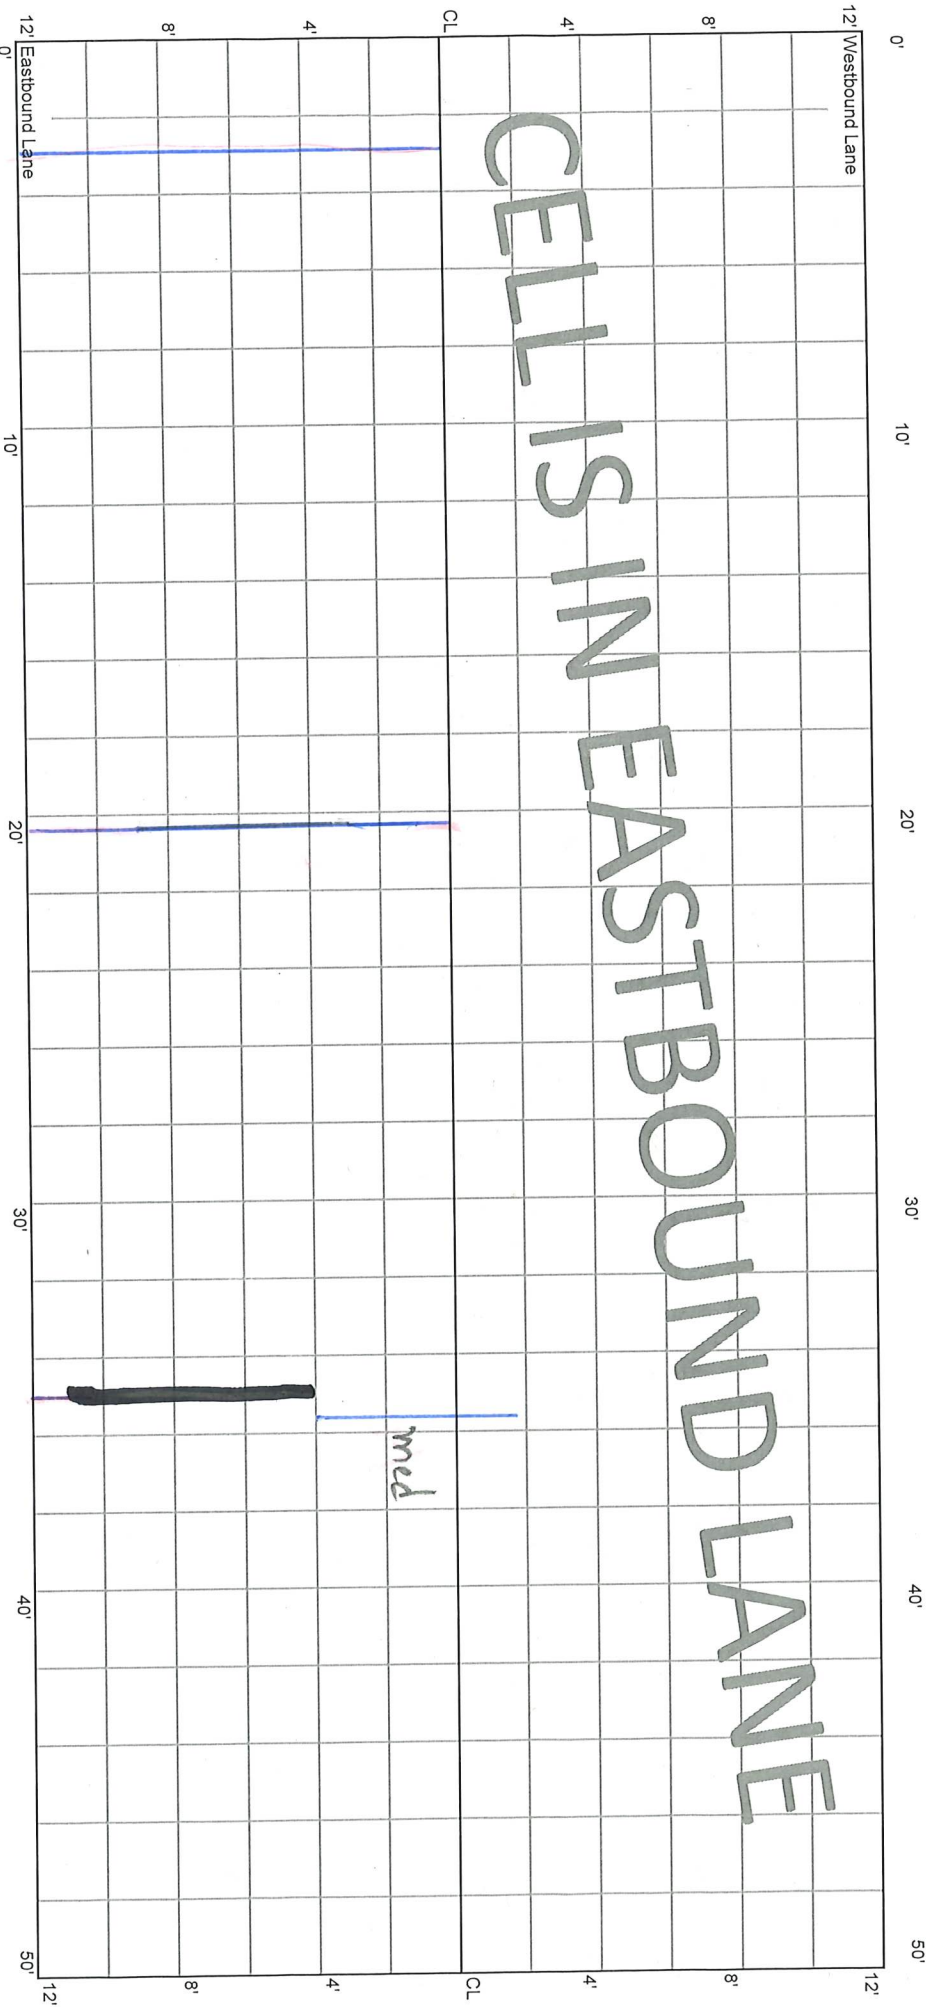

CELL IS IN EASTBOUND LANE


*
AK

CELL 7002E
150 - 200 ft

7+00

7+50

CELL IS IN EASTBOUND LANE

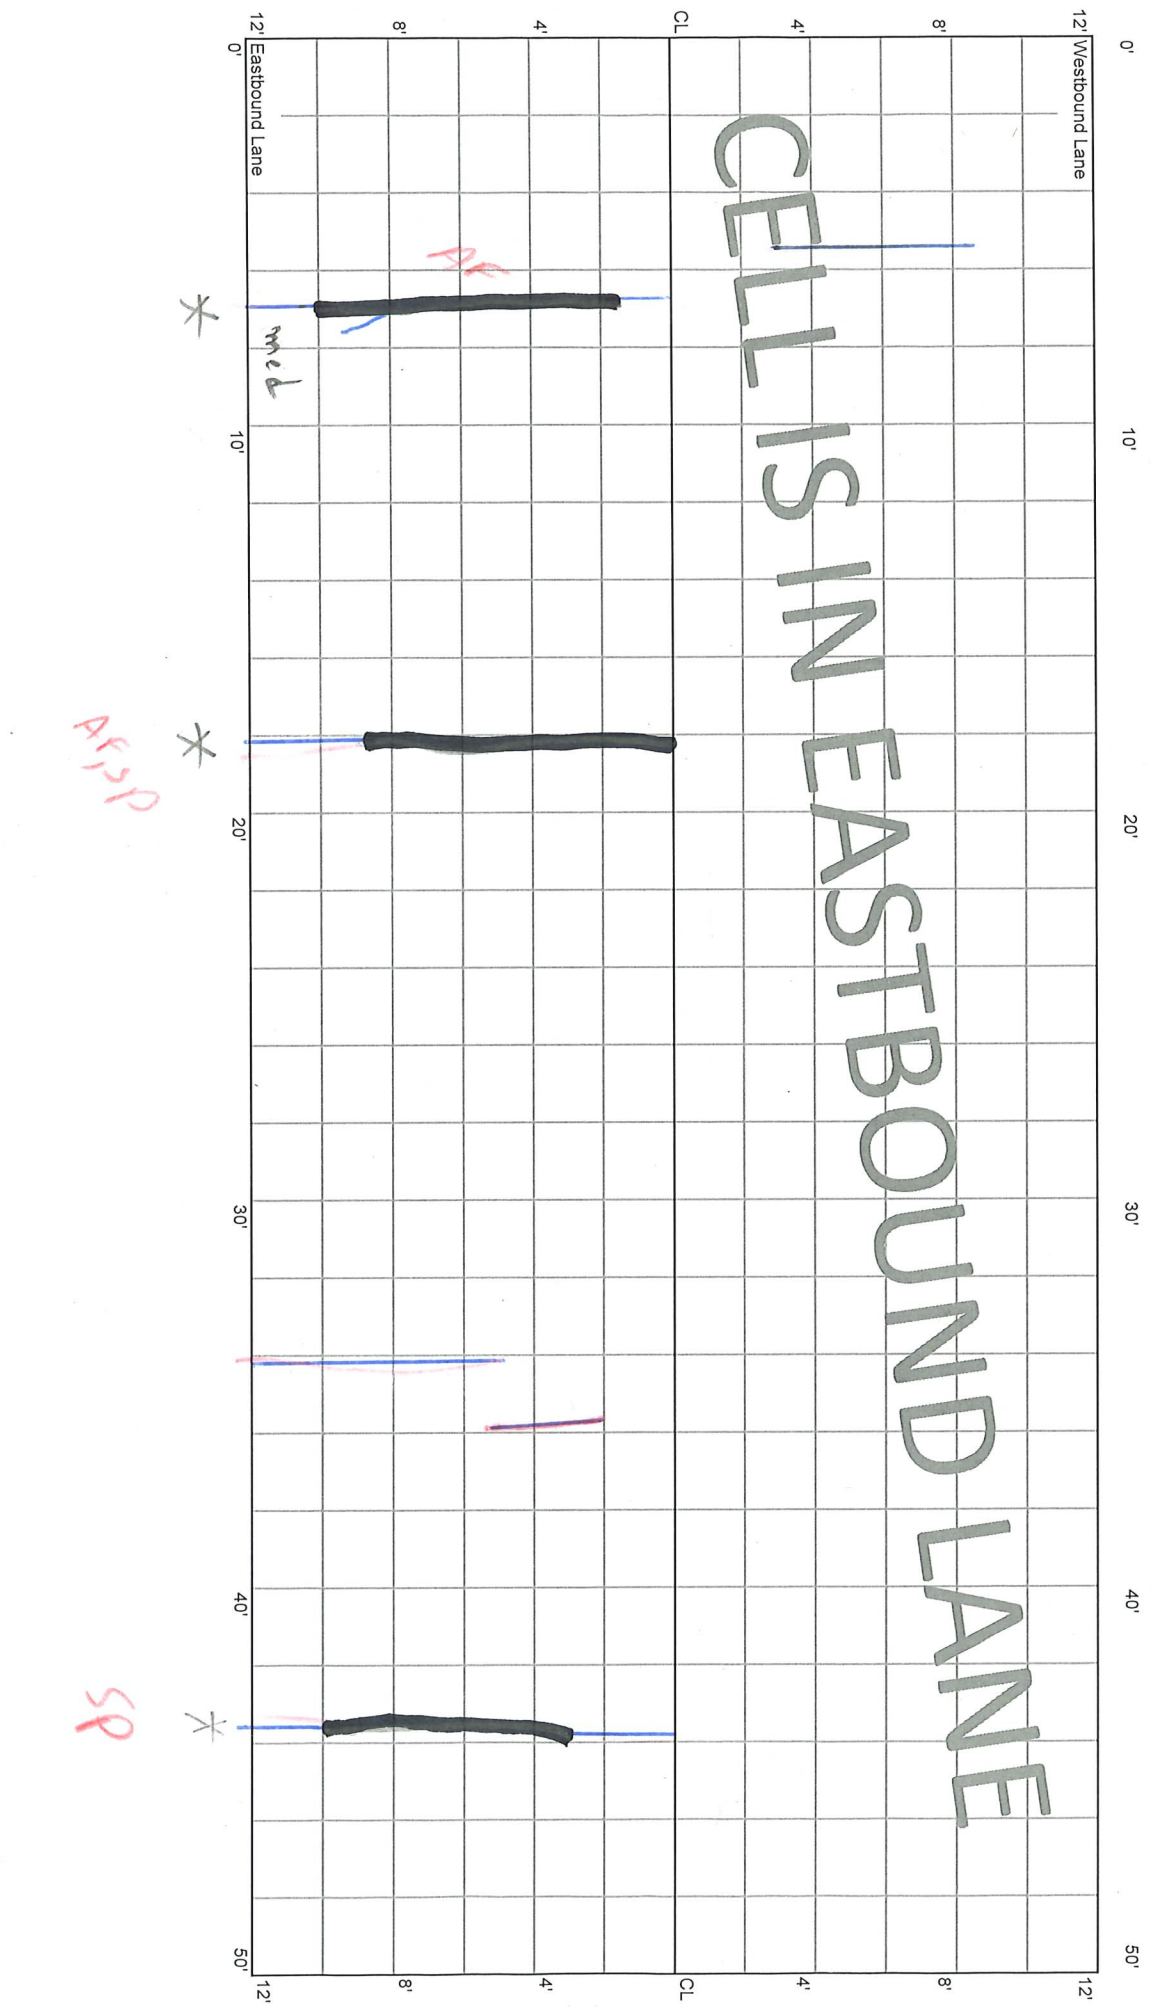


CELL 7002E
200 - 250 ft

7+50

8+00

CELLS IN EASTBOUND LANE

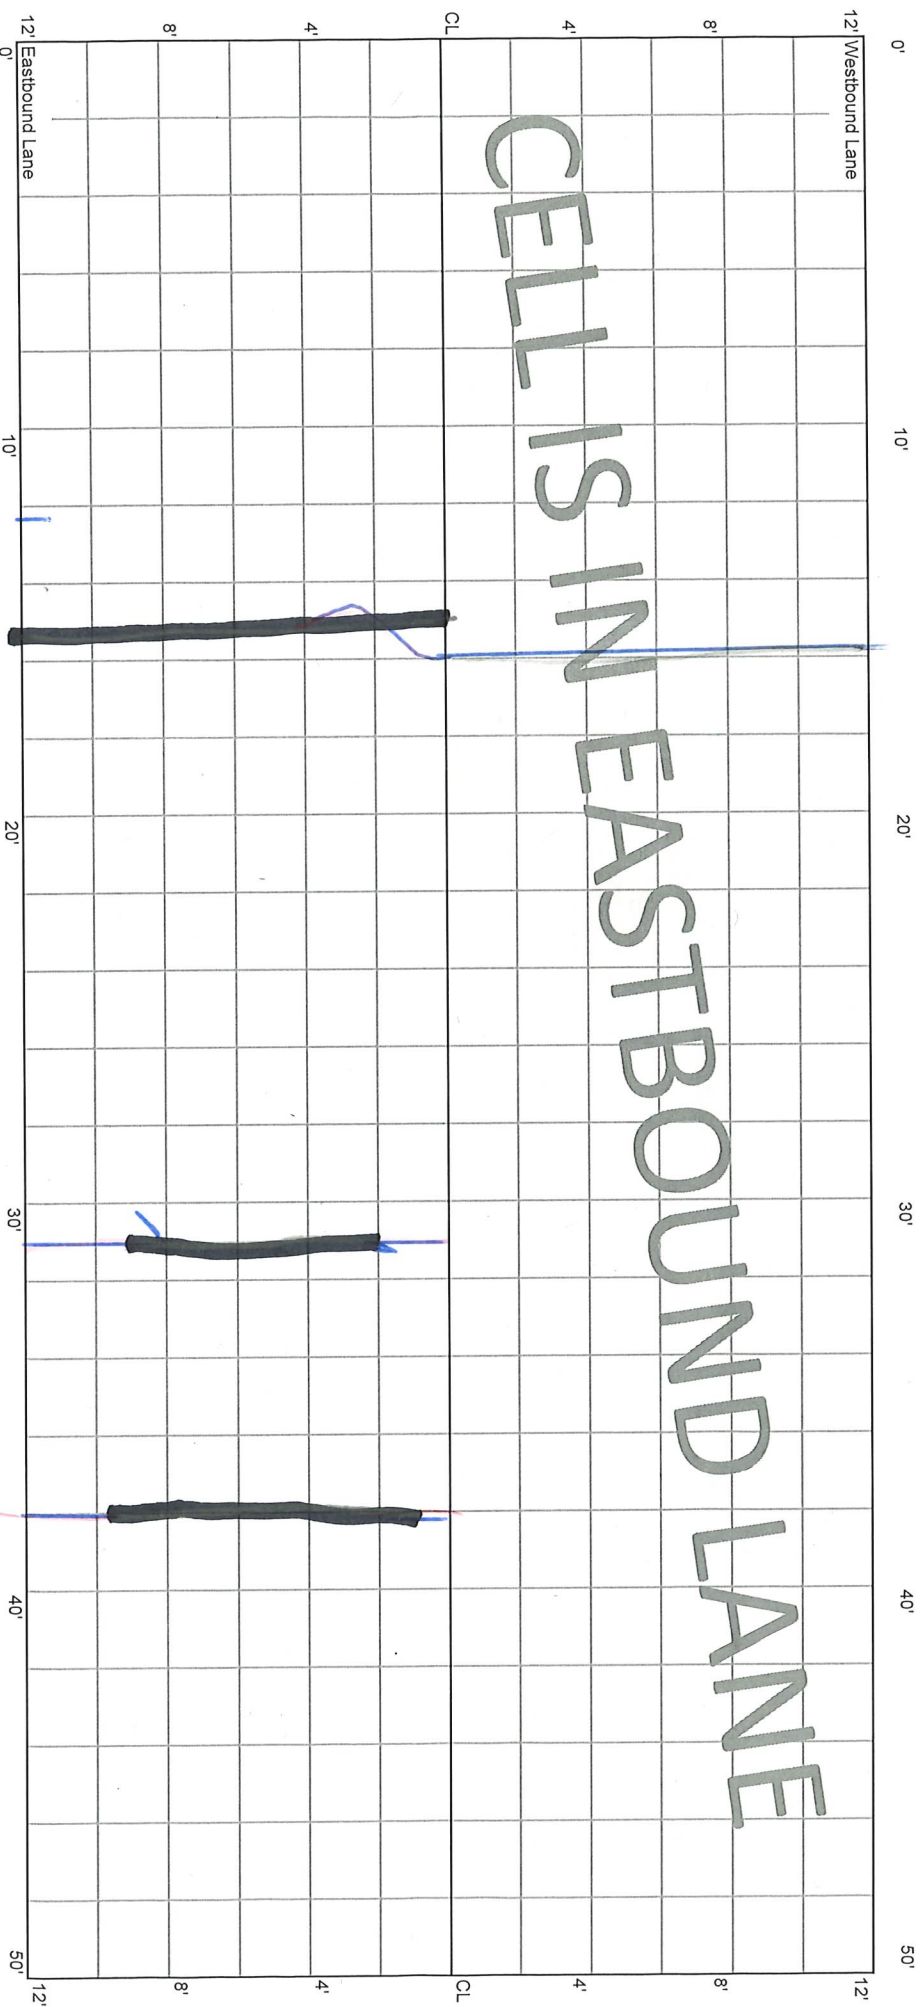

AS *

SP *

CELL 7002E
250 - 300 ft

8+00

8+50

12' Westbound Lane

12'

0'

10'

20'

30'

40'

50'

8'

8'

4'

4'

CL

CL

4'

4'

8'

8'

12' Eastbound Lane

12'

0'

10'

20'

30'

40'

50'

CELL IS IN EASTBOUND LANE



*
SR


Lost seal
6" RW/P
4" LW/P

*
SR

CELL 7002E
300 - 350 ft

8+50

9+00

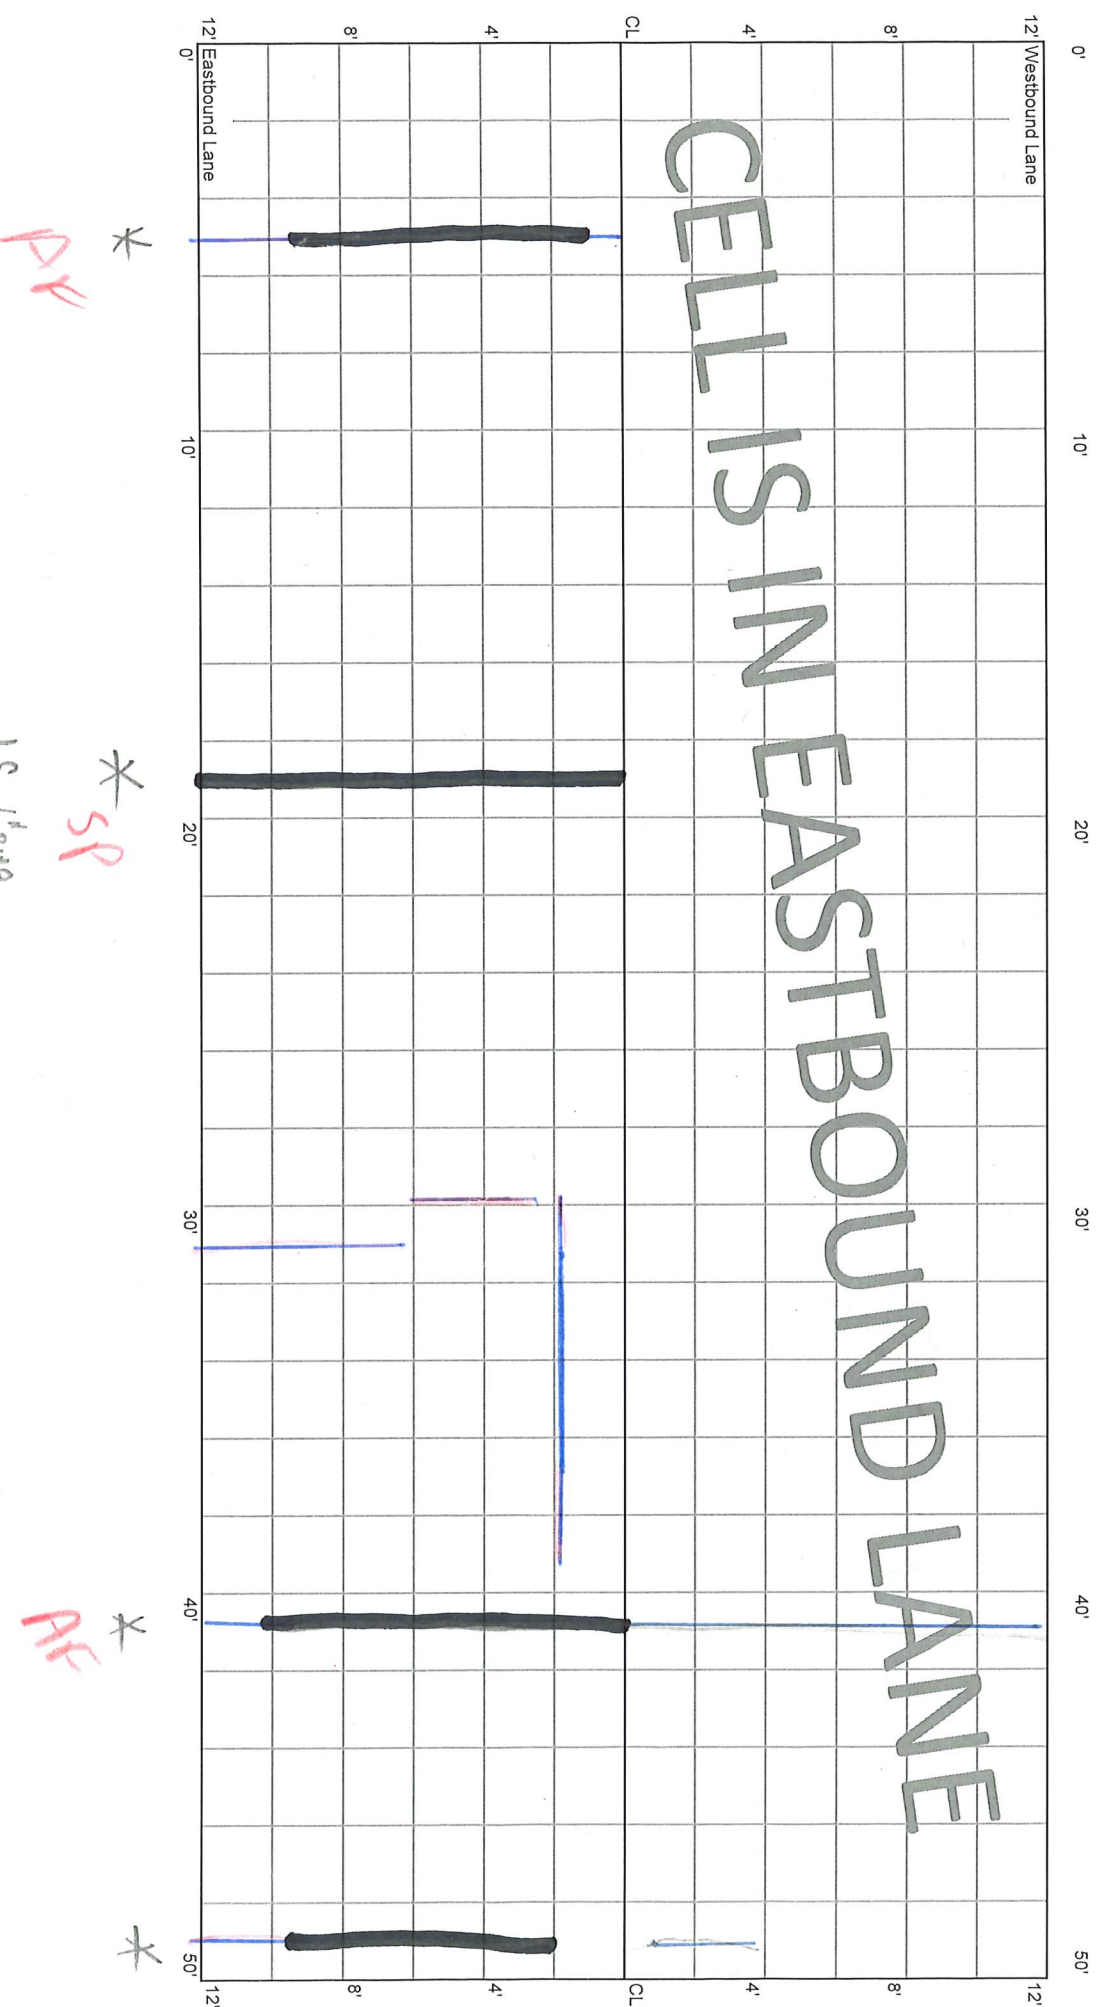

CELLS IN EASTBOUND LANE

12' Westbound Lane

12' Eastbound Lane

CL

*

PR

* SR

LS. 6' bump


*

AR

*

CELL 7002E
350 - 400 ft

CELLS IN EASTBOUND LANE

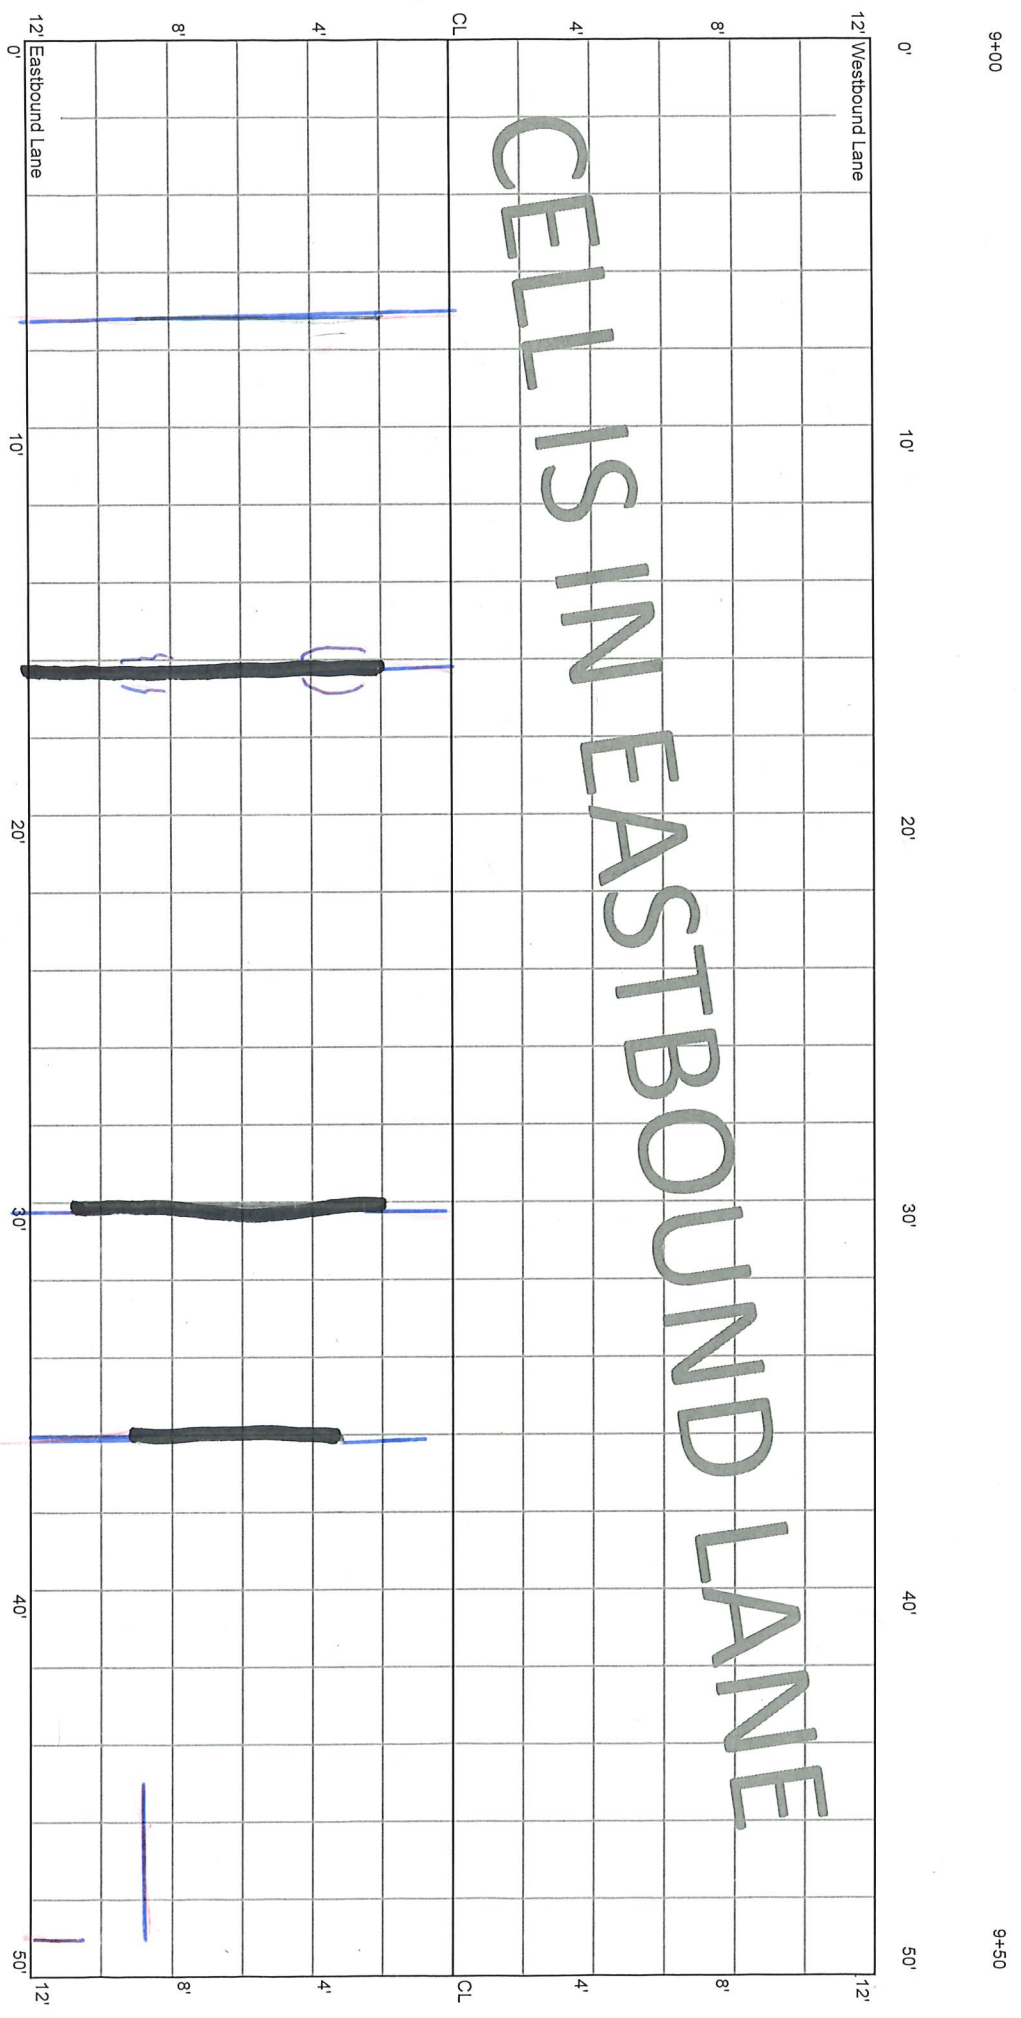

AK *

CELL 7002E
400 - 450 ft

9+50

10+00


12' Westbound Lane

0' 10' 20' 30' 40' 50'

CELLS IN EASTBOUND LANE

12' Eastbound Lane

0' 10' 20' 30' 40' 50'

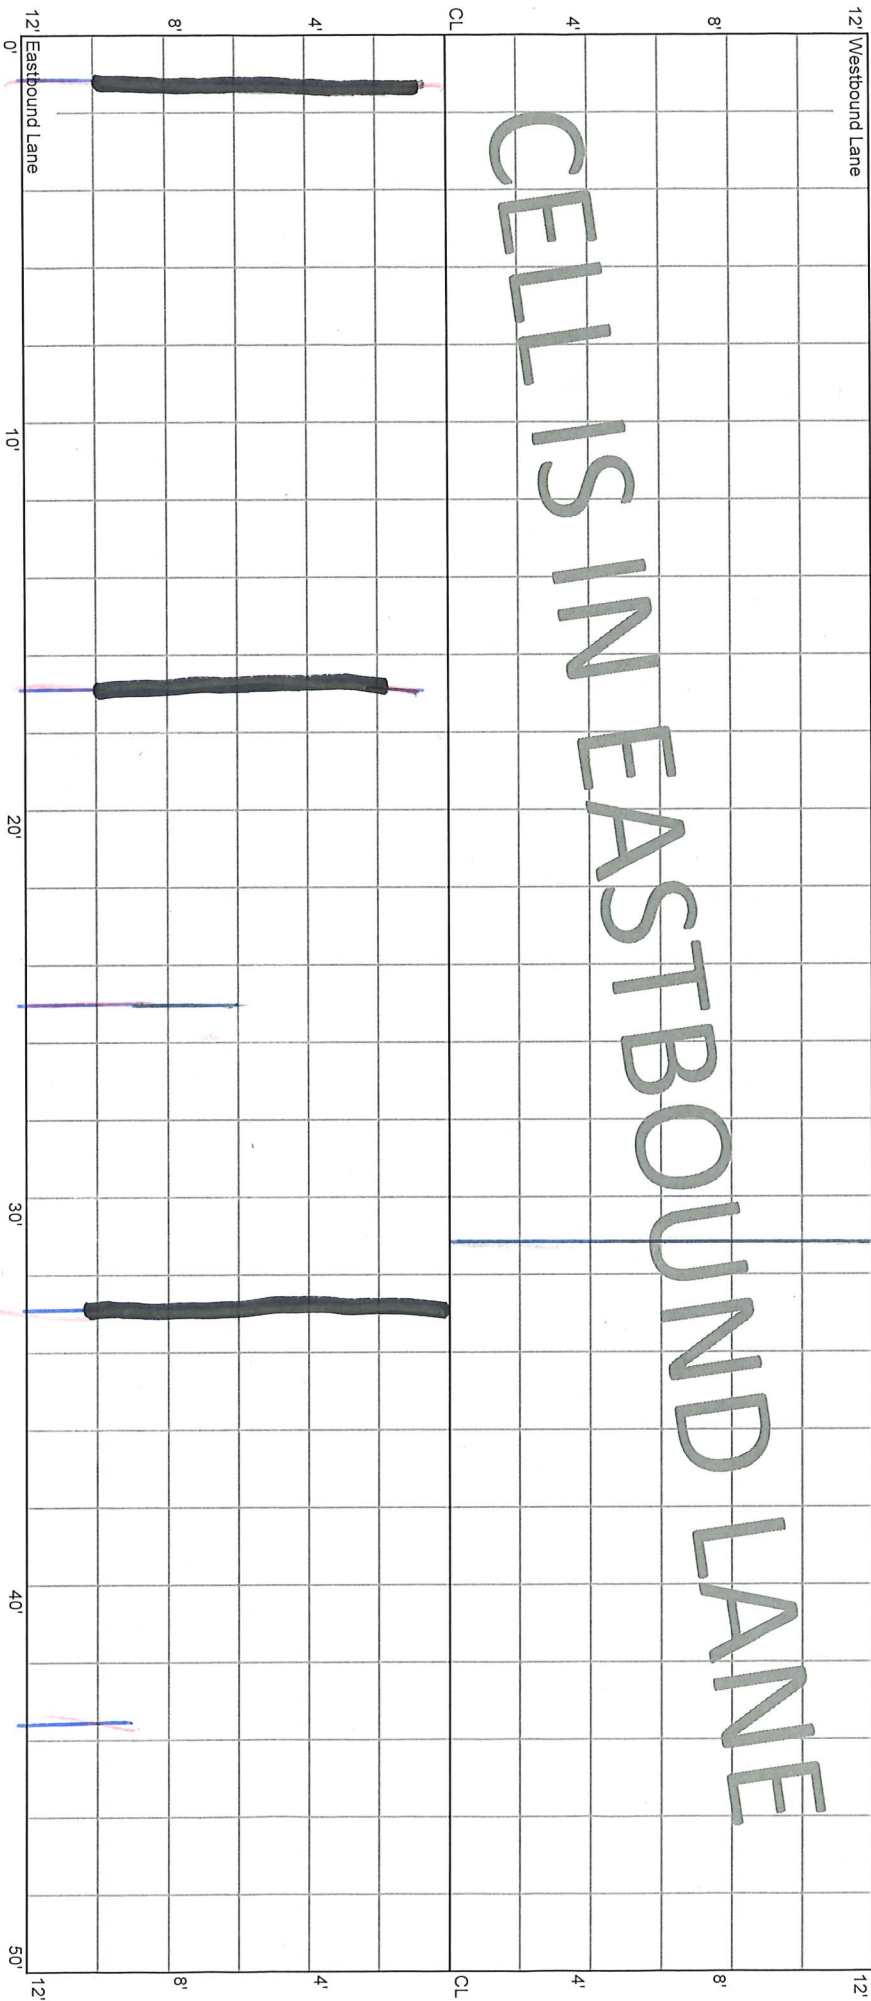

* AF
SR

* SR


L.S. 4' L.V.R.

CELL 7002E
450 - 500 ft

10+00

10+50

CELL IS IN EASTBOUND LANE

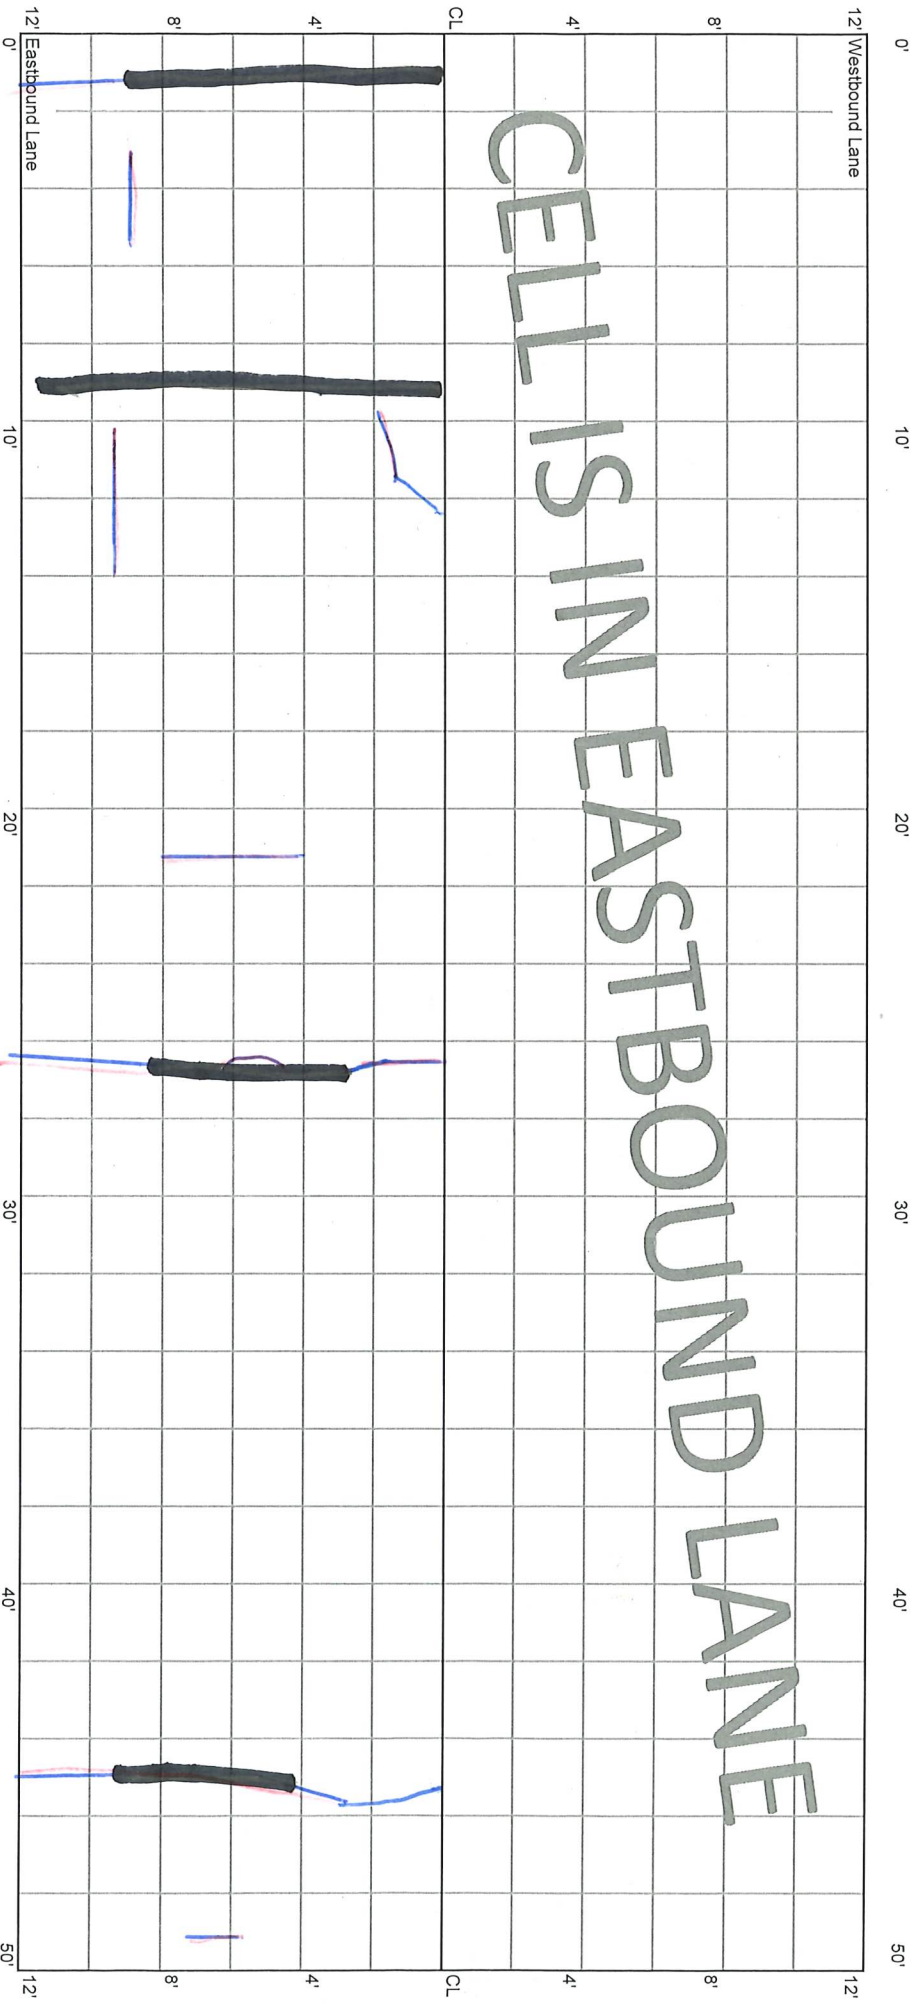


* SR

* AR

* SP

* Not Sealed

CELL 7002E
500 - 550 ft

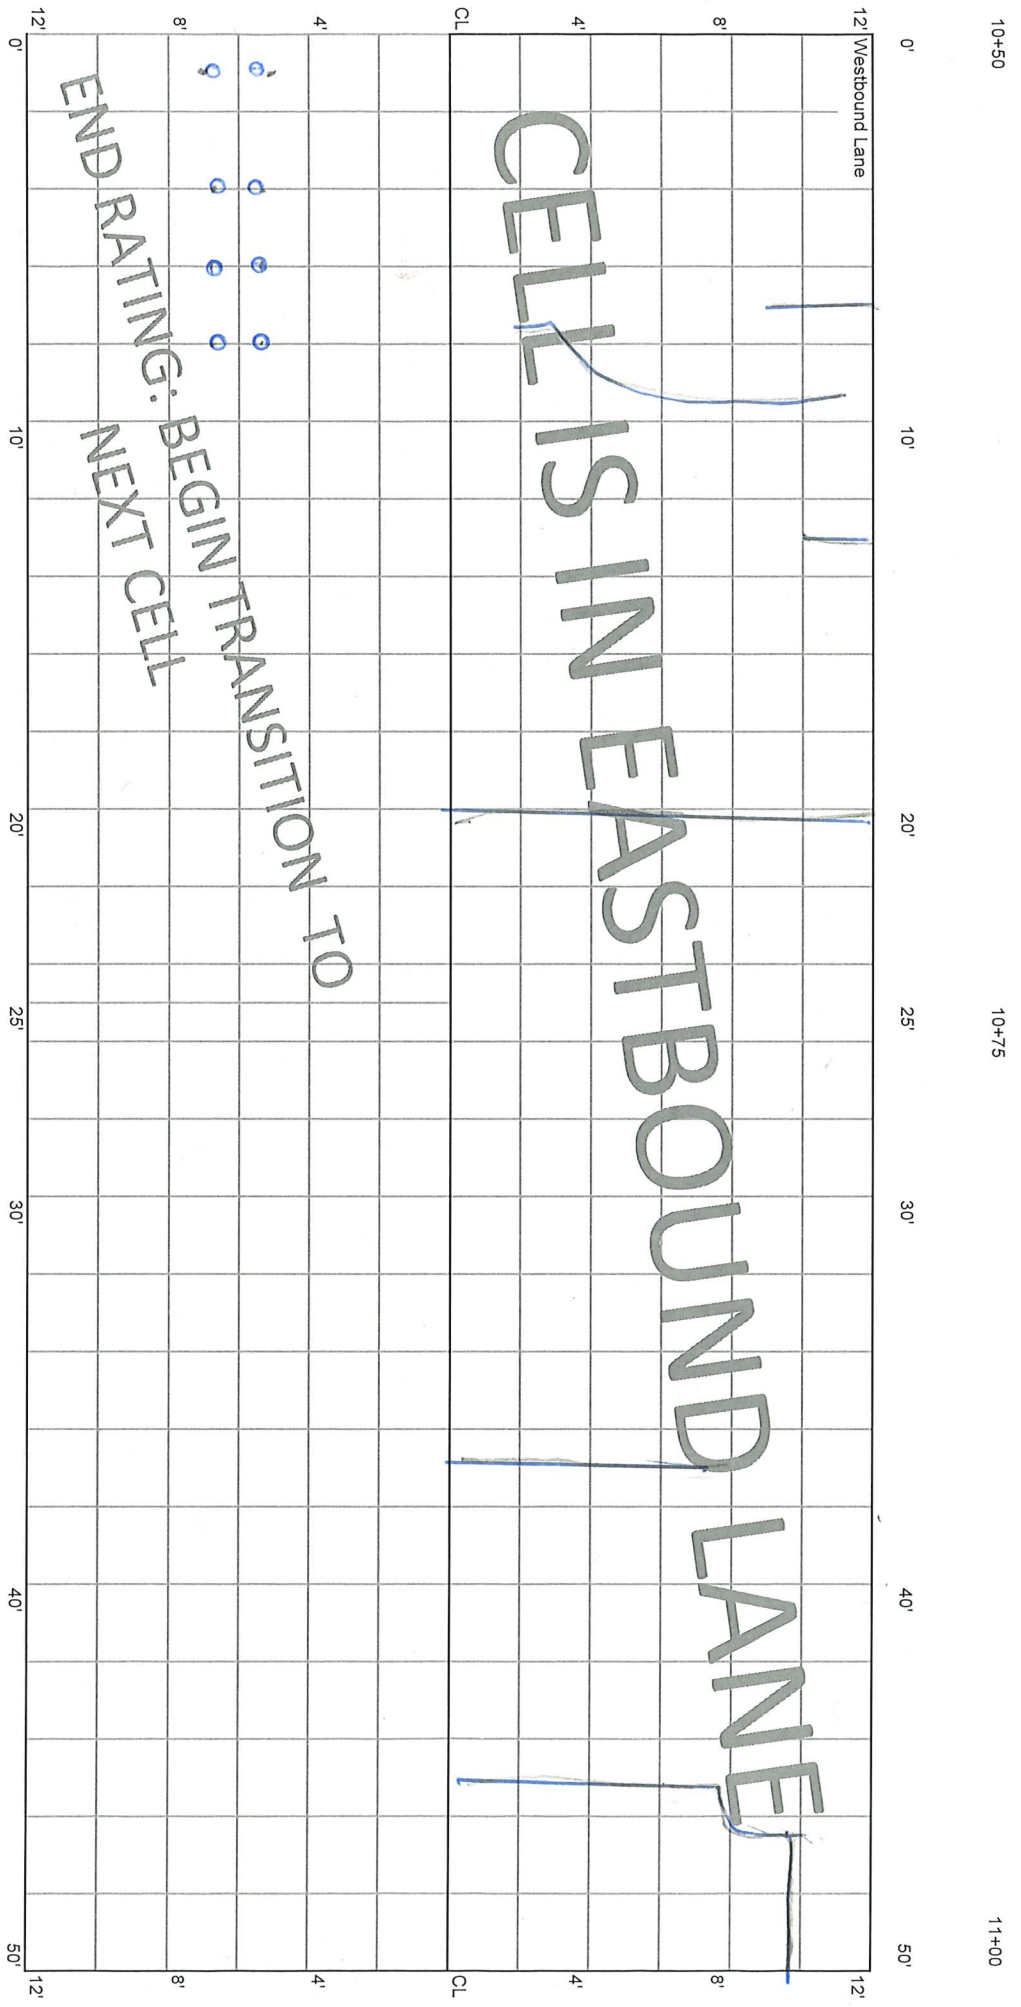

(0:2020
CORES)