


5.28.20 E.T.
10.14.20 1.3.22
1.4.21 8.30.22
File 70TH ST
8.5.21

CELL 7002E
0 - 50 ft

5+50


6+00

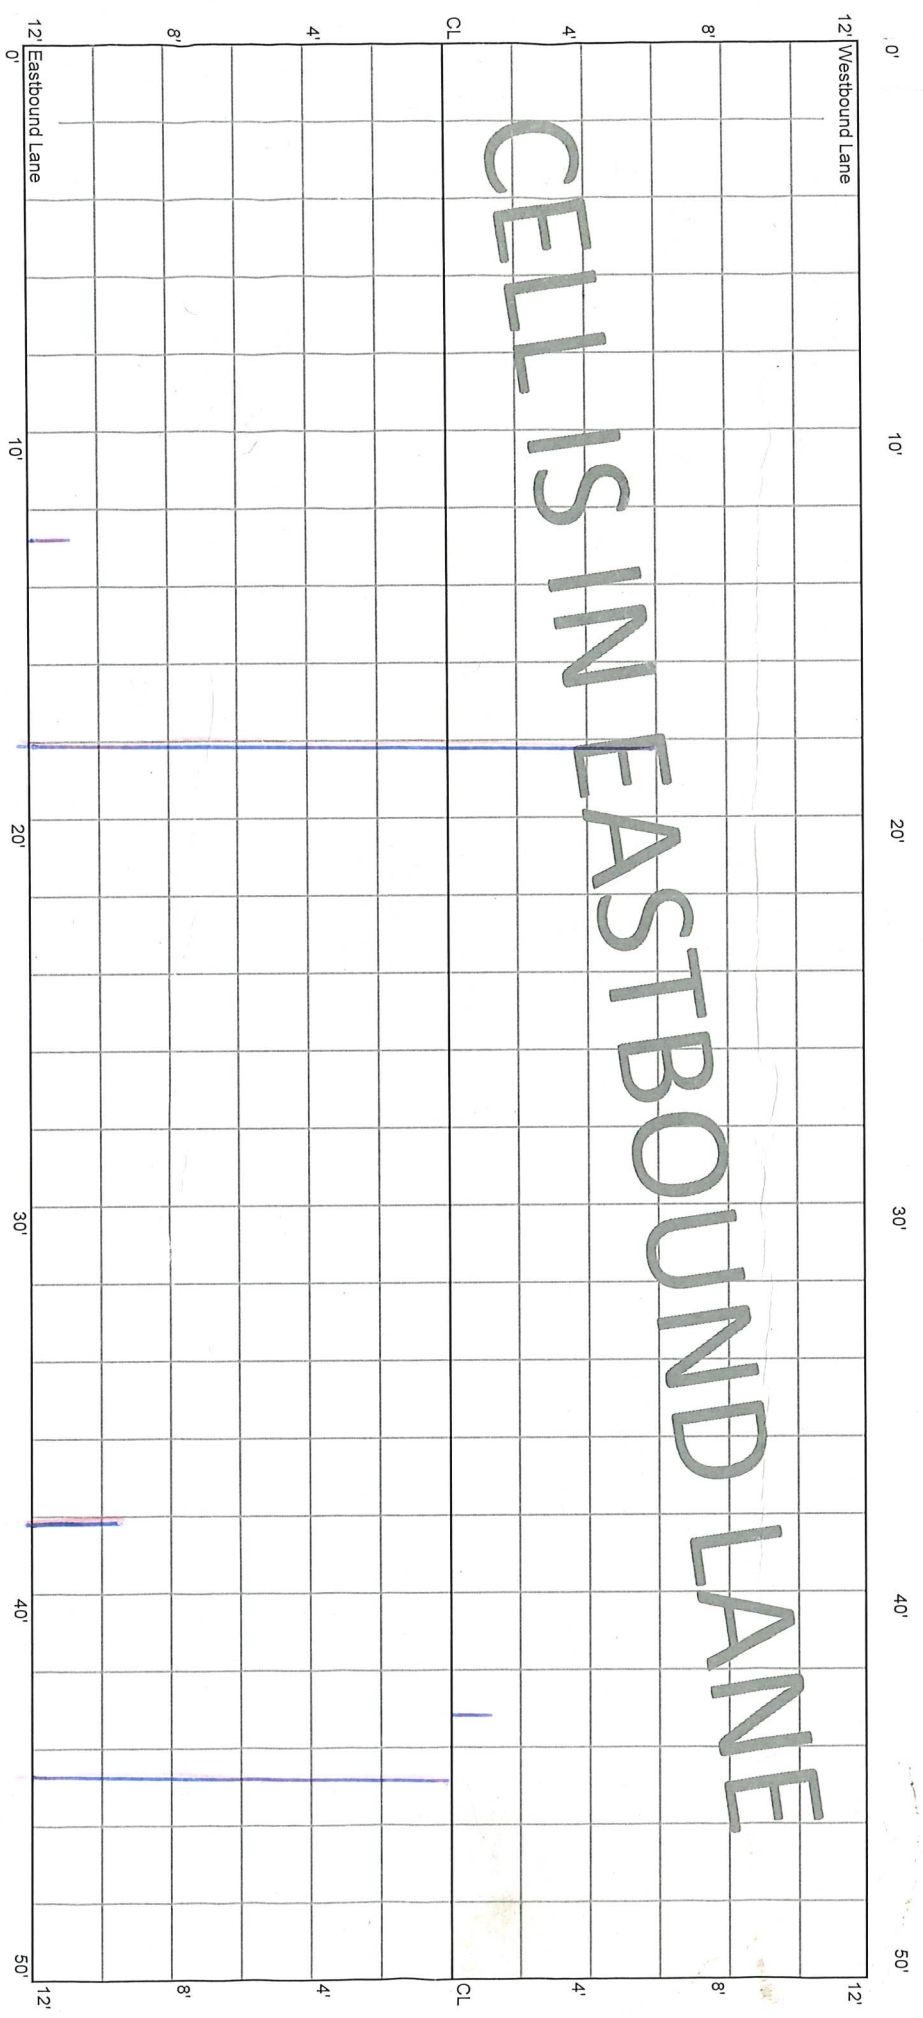

* Pout & Seal

2008 - Stones in Sealant

CELL 7002E
50 - 100 ft

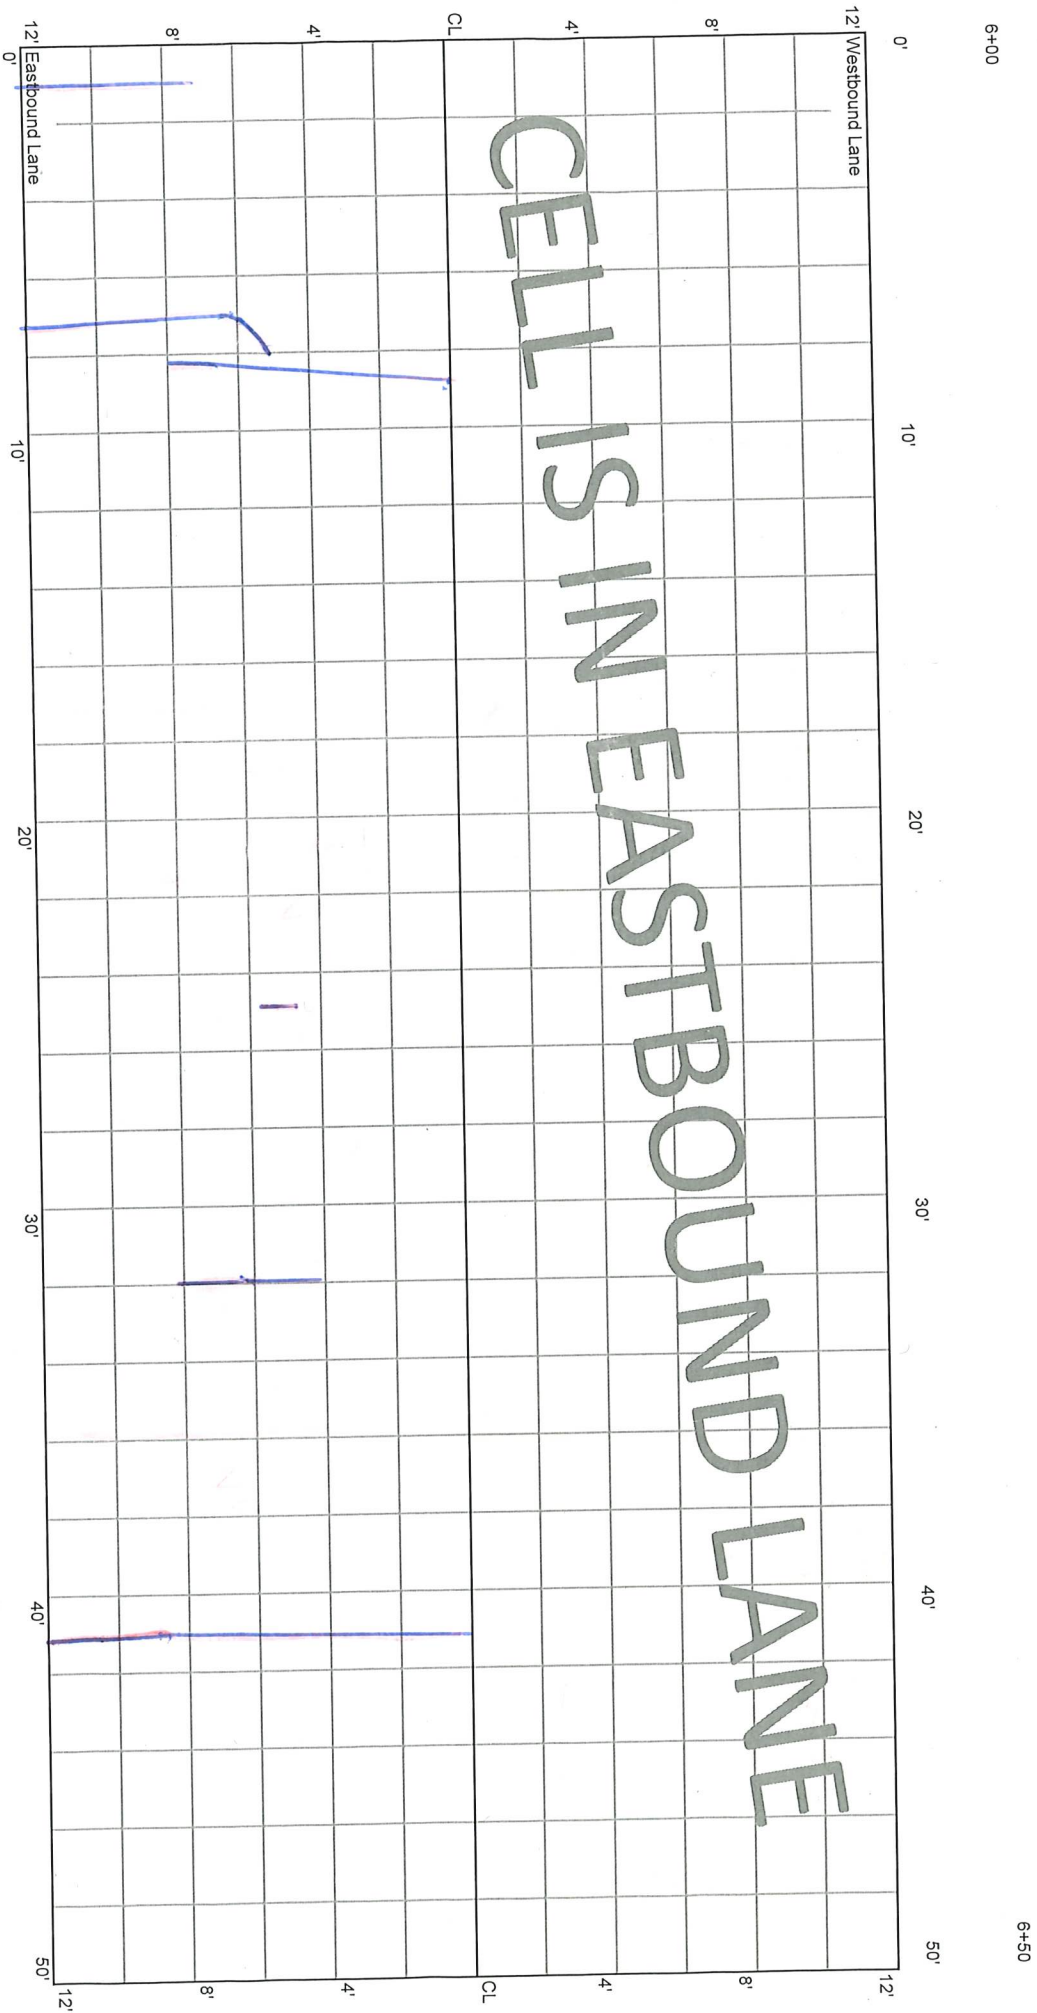


CELL 7002E
100 - 150 ft

6+50

7+00

CELLS IN EASTBOUND LANE

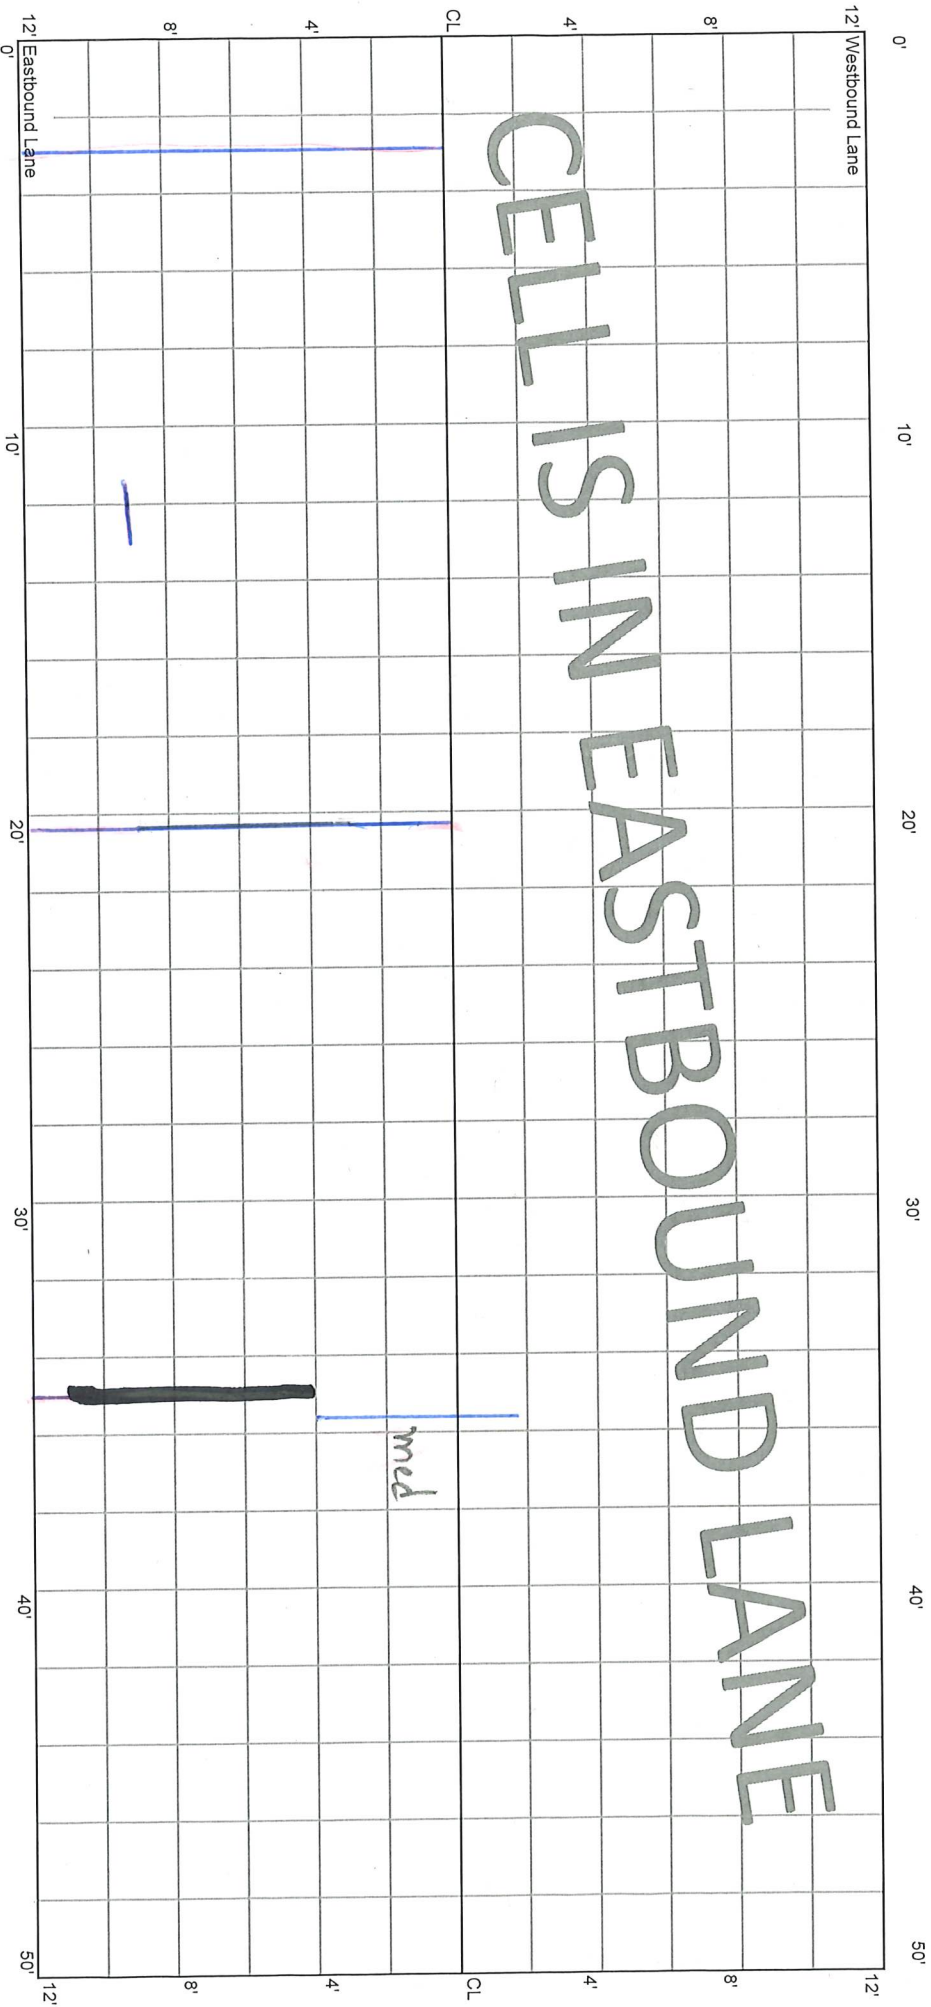

M


1' AF
Debris

CELL 7002E
150 - 200 ft

7+00

7+50

CELLS IN EASTBOUND LANE

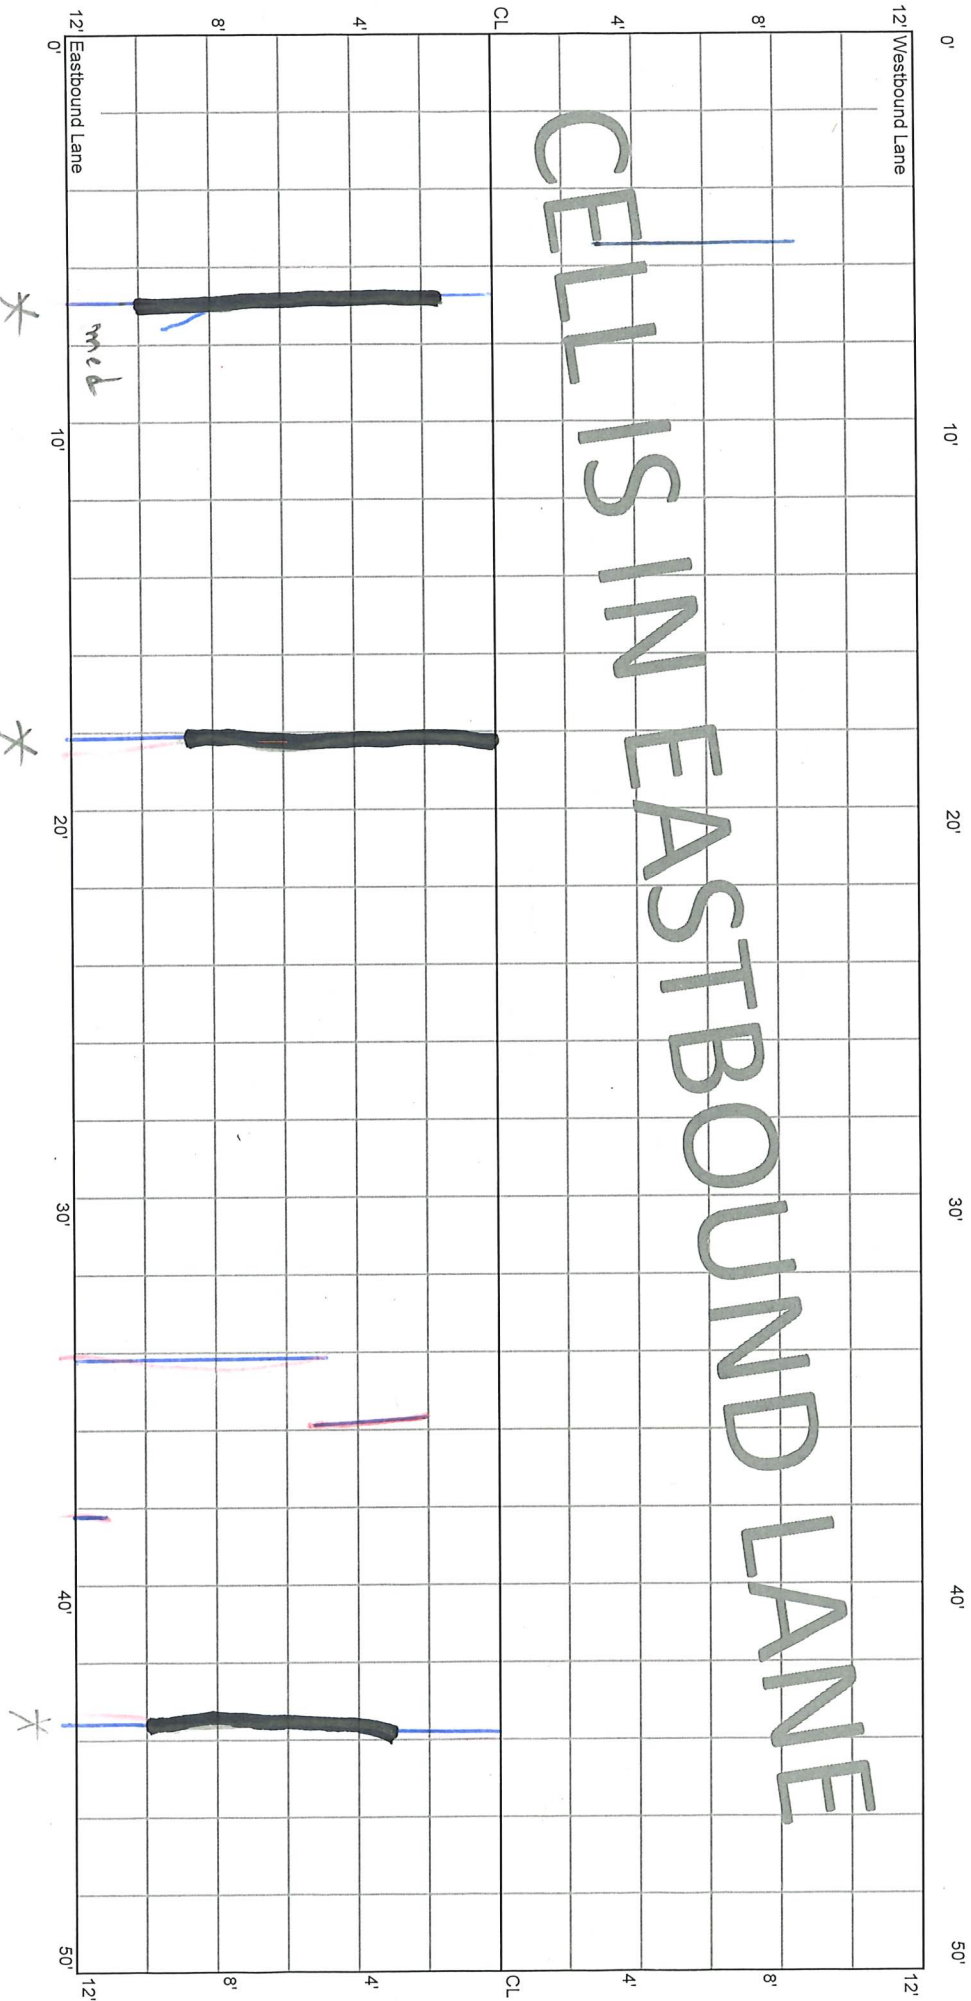

1' AP

AF, SP,
Debris


1/2 SP

CELL 7002E
200 - 250 ft

7+50

8+00

CELL IS IN EASTBOUND LANE

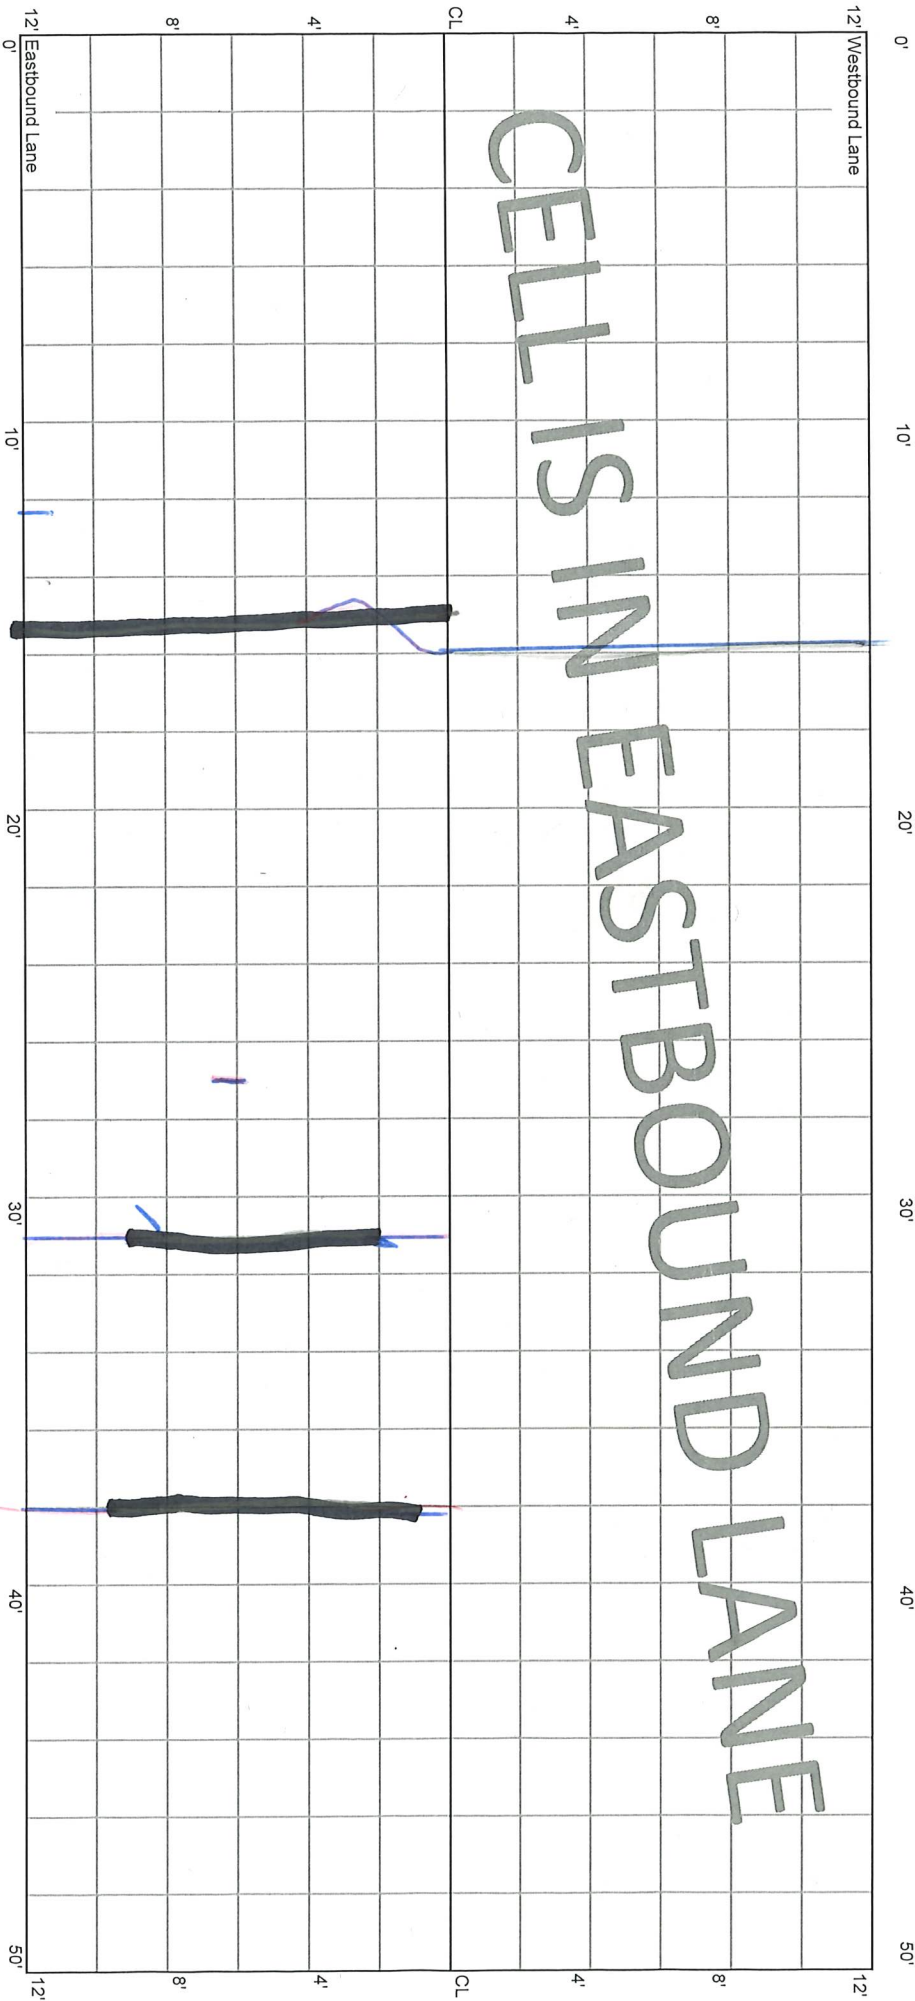

*
M
AF, SP

*
M


*
SP

CELL 7002E
250 - 300 ft

8+00

8+50

CELLS IN EASTBOUND LANE

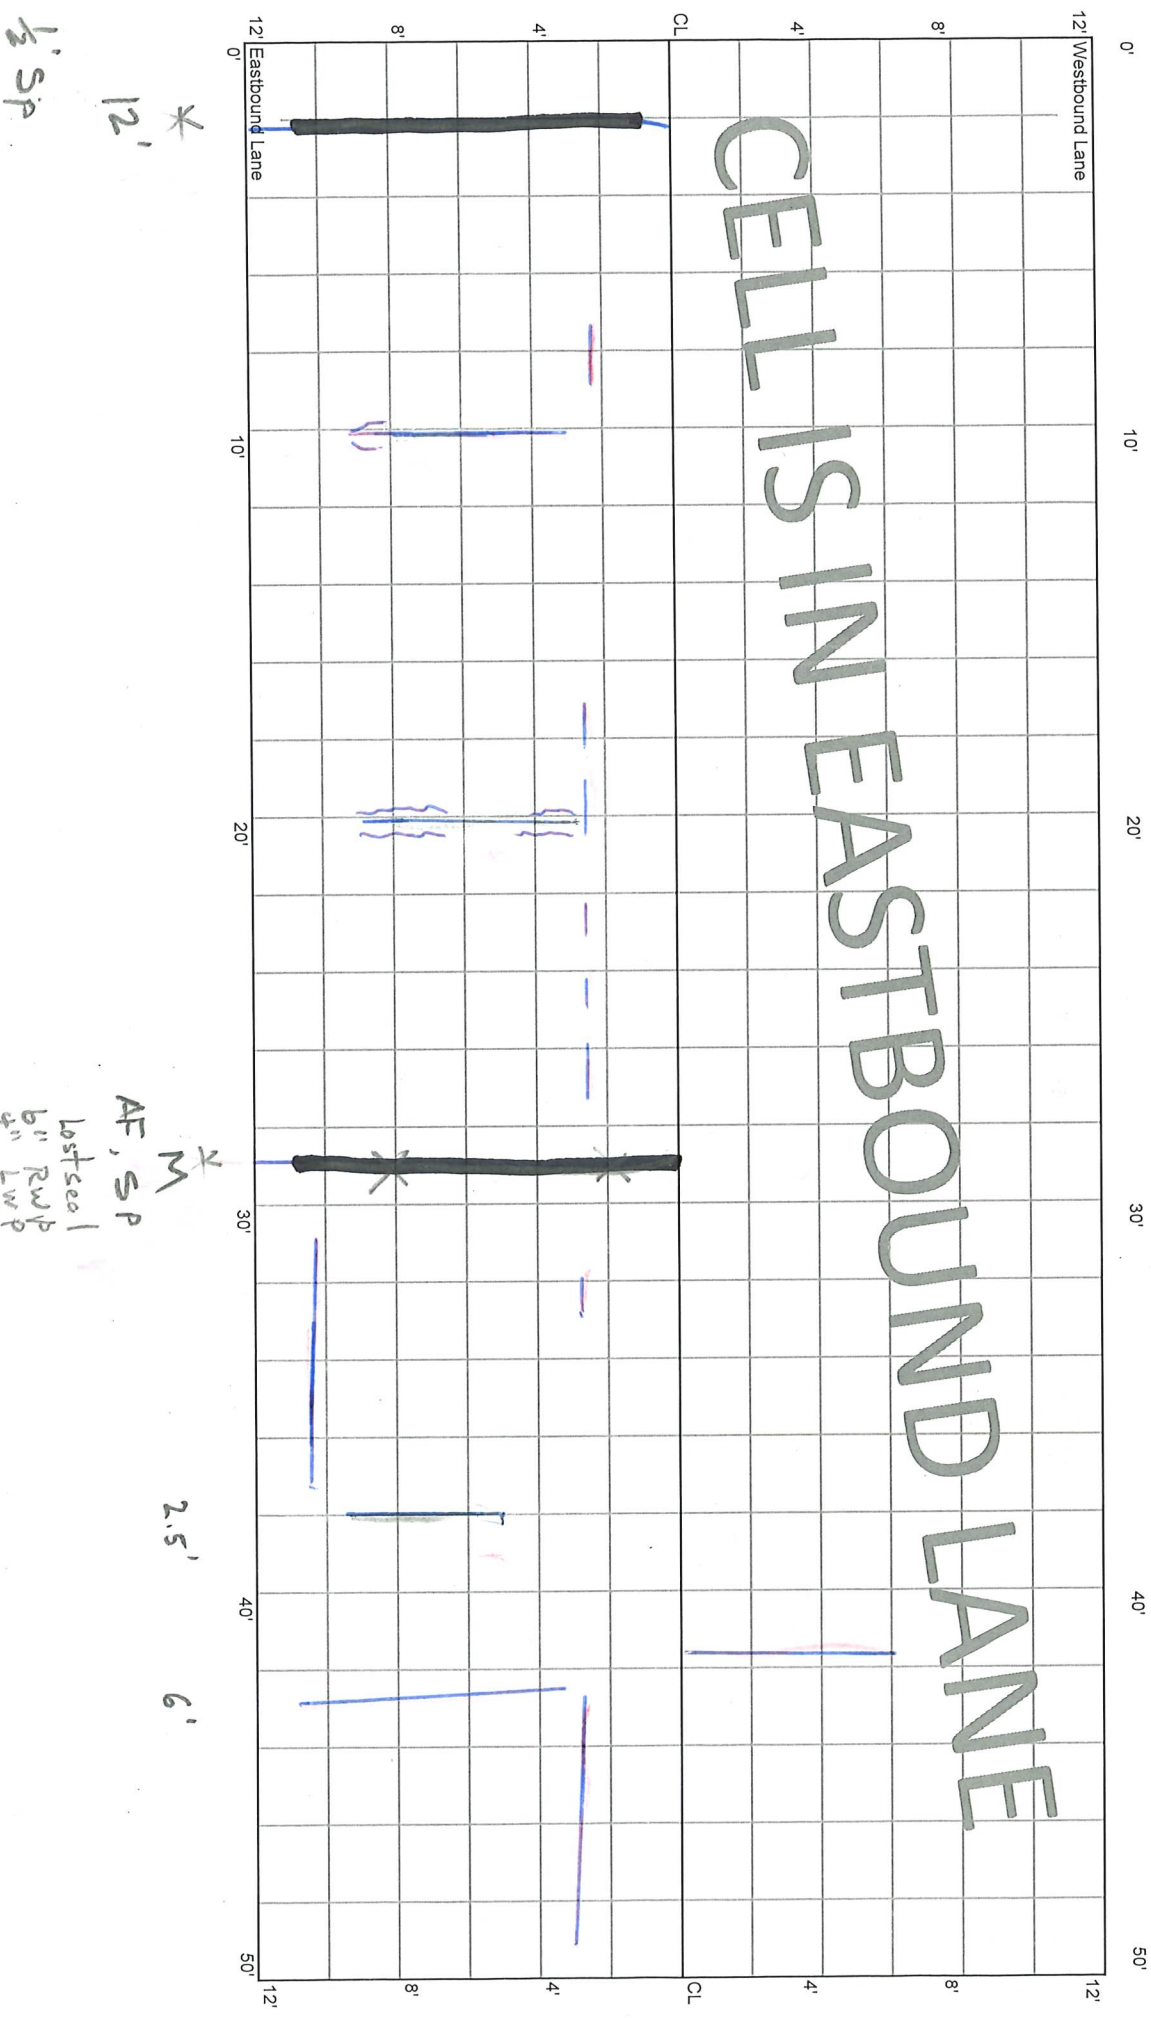

1/2 SP

12' *

AF, SP
Lost see |
6" RW/P
4" LWP


2.5'

6'

CELL 7002E
300 - 350 ft

8+50

9+00

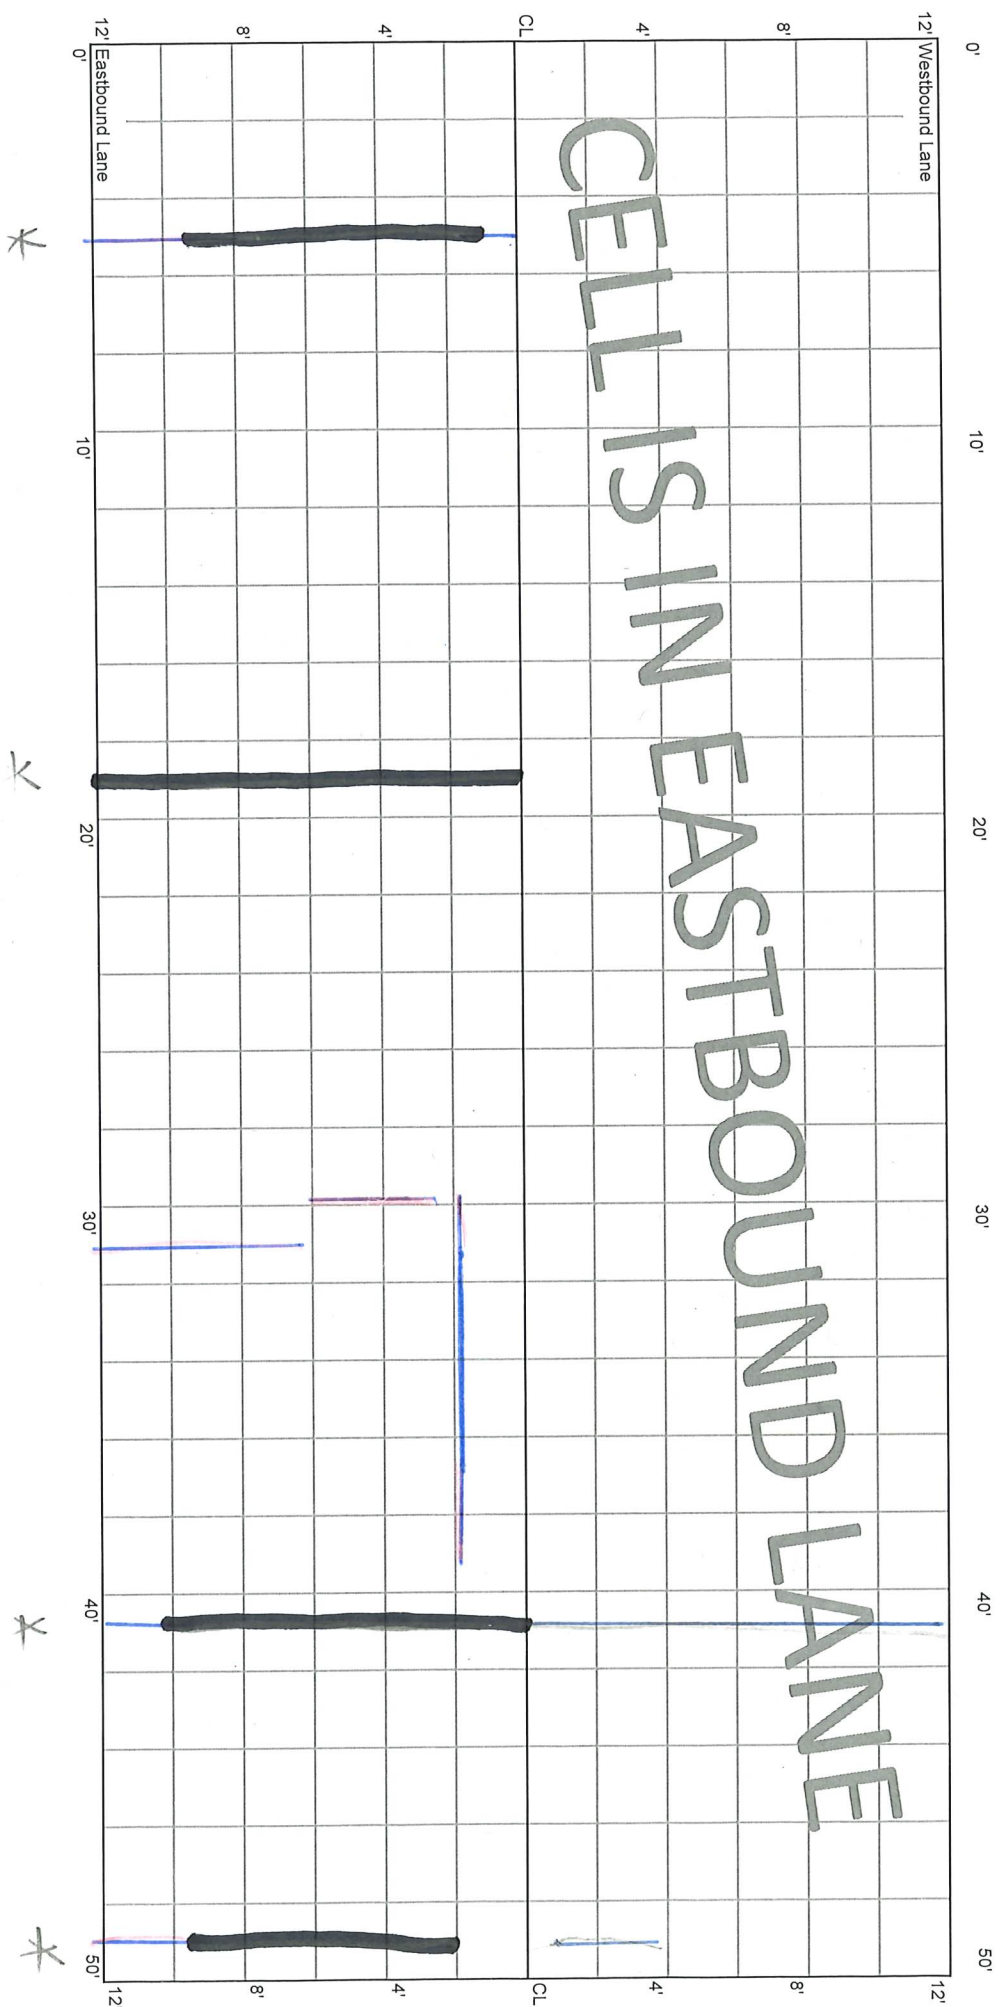

SPK'
LS. 6" bump

M

CELL 7002E
350 - 400 ft

9+00

9+50

12' Westbound Lane

12'

12' Eastbound Lane

12'

CL

CL

4'

4'

8'

8'

0'

10'


20'

30'

40'

50'

CELLS IN EASTBOUND LANE

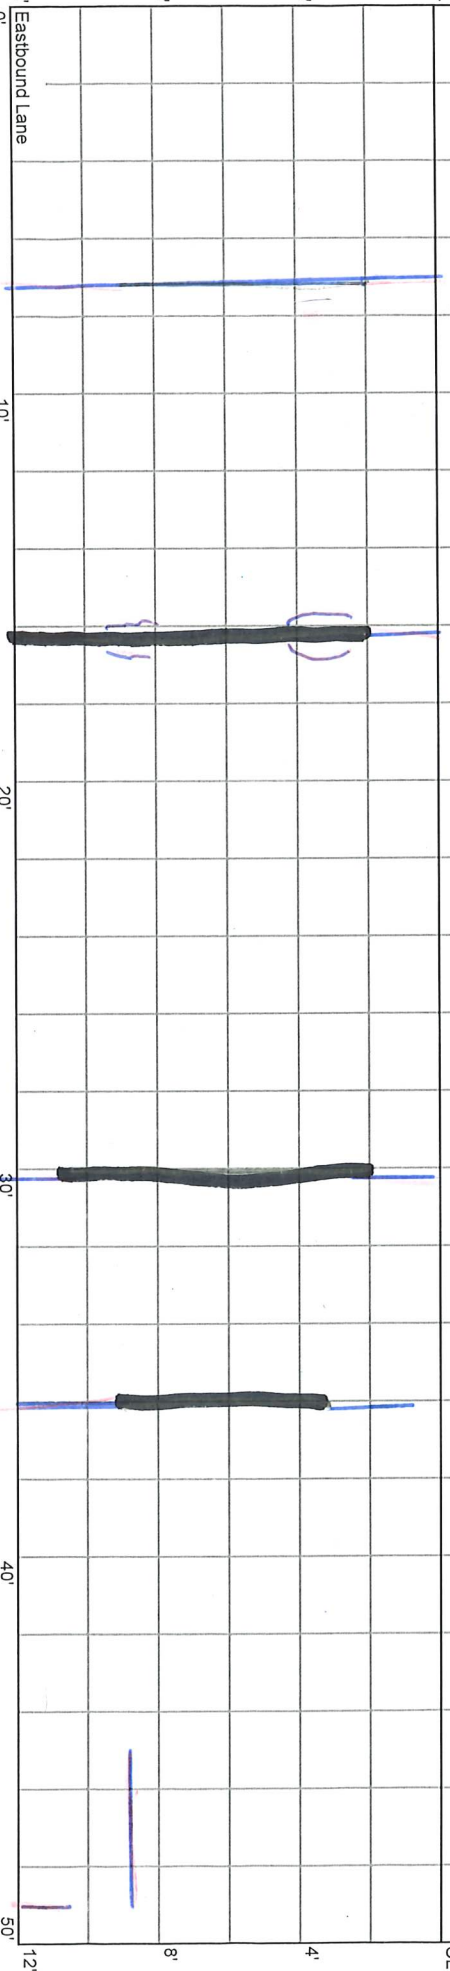

*
3

*

*

CELL 7002E
400 - 450 ft


9+50

10+00

12' Westbound Lane

0' Eastbound Lane

CELLS IN EASTBOUND LANE

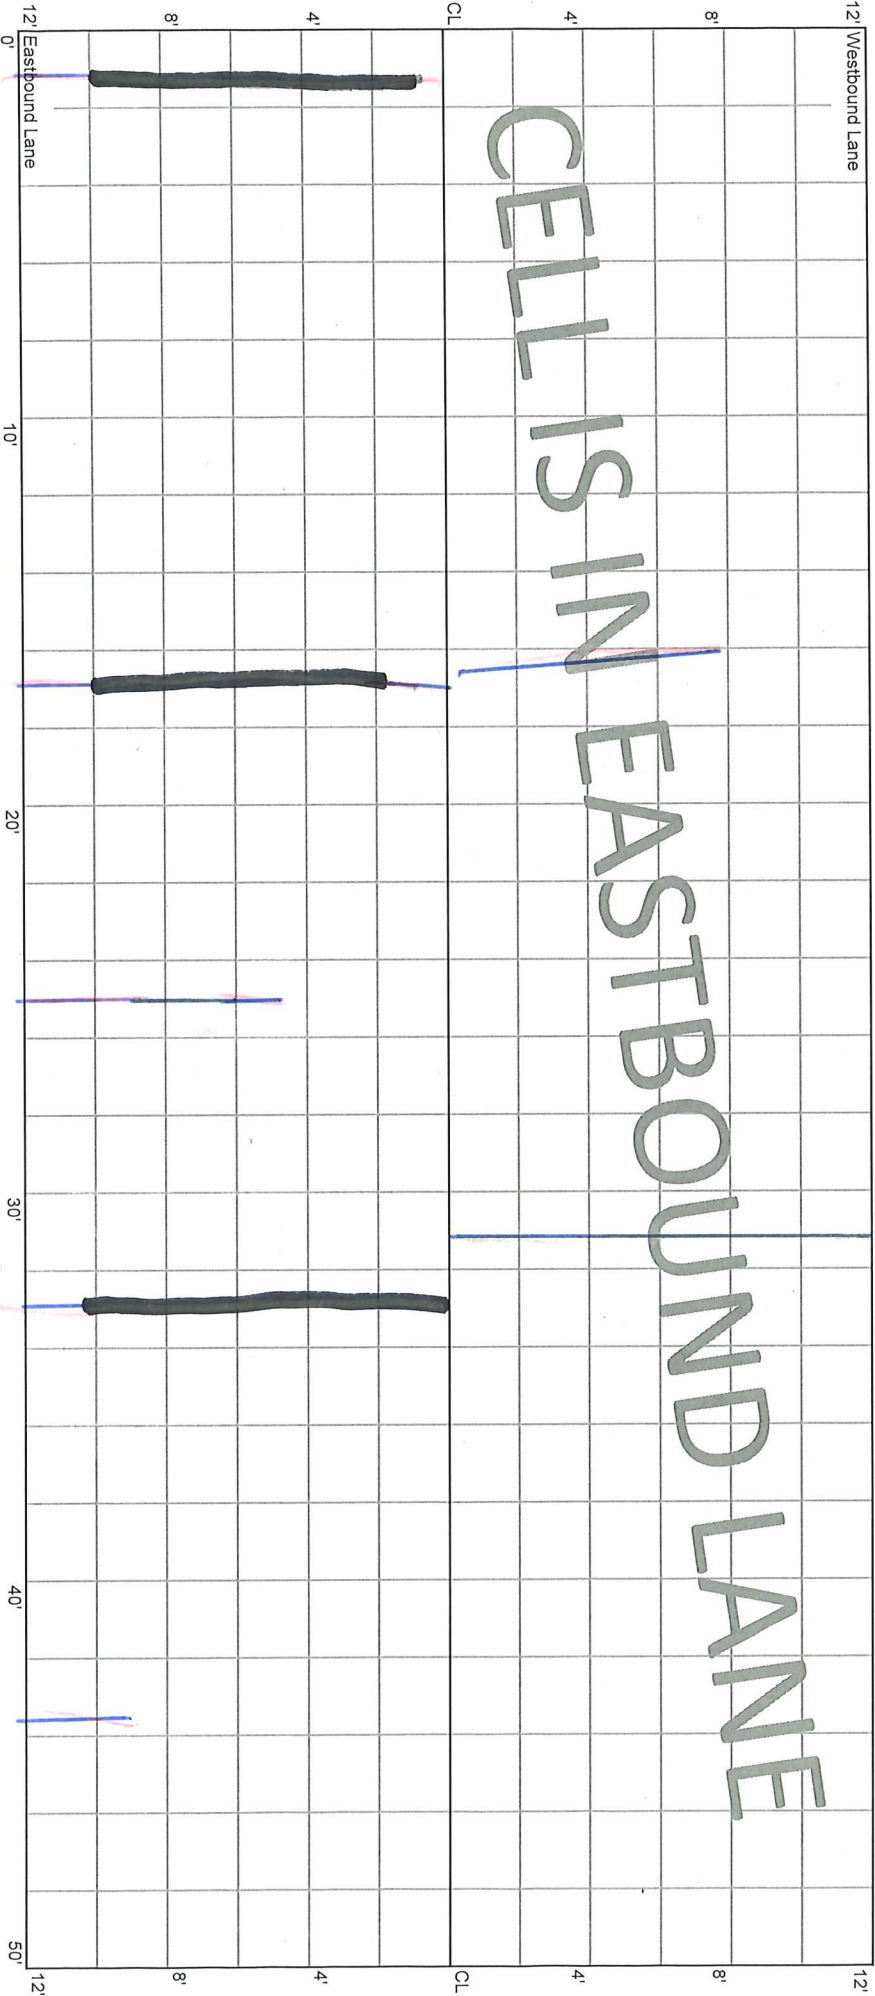

M
SP 1/2'

M
SP 1/2'

CELL 7002E
450 - 500 ft


10+00

10+50

12' Westbound Lane

0' 10' 20' 30' 40' 50'

CELL IS IN EASTBOUND LANE

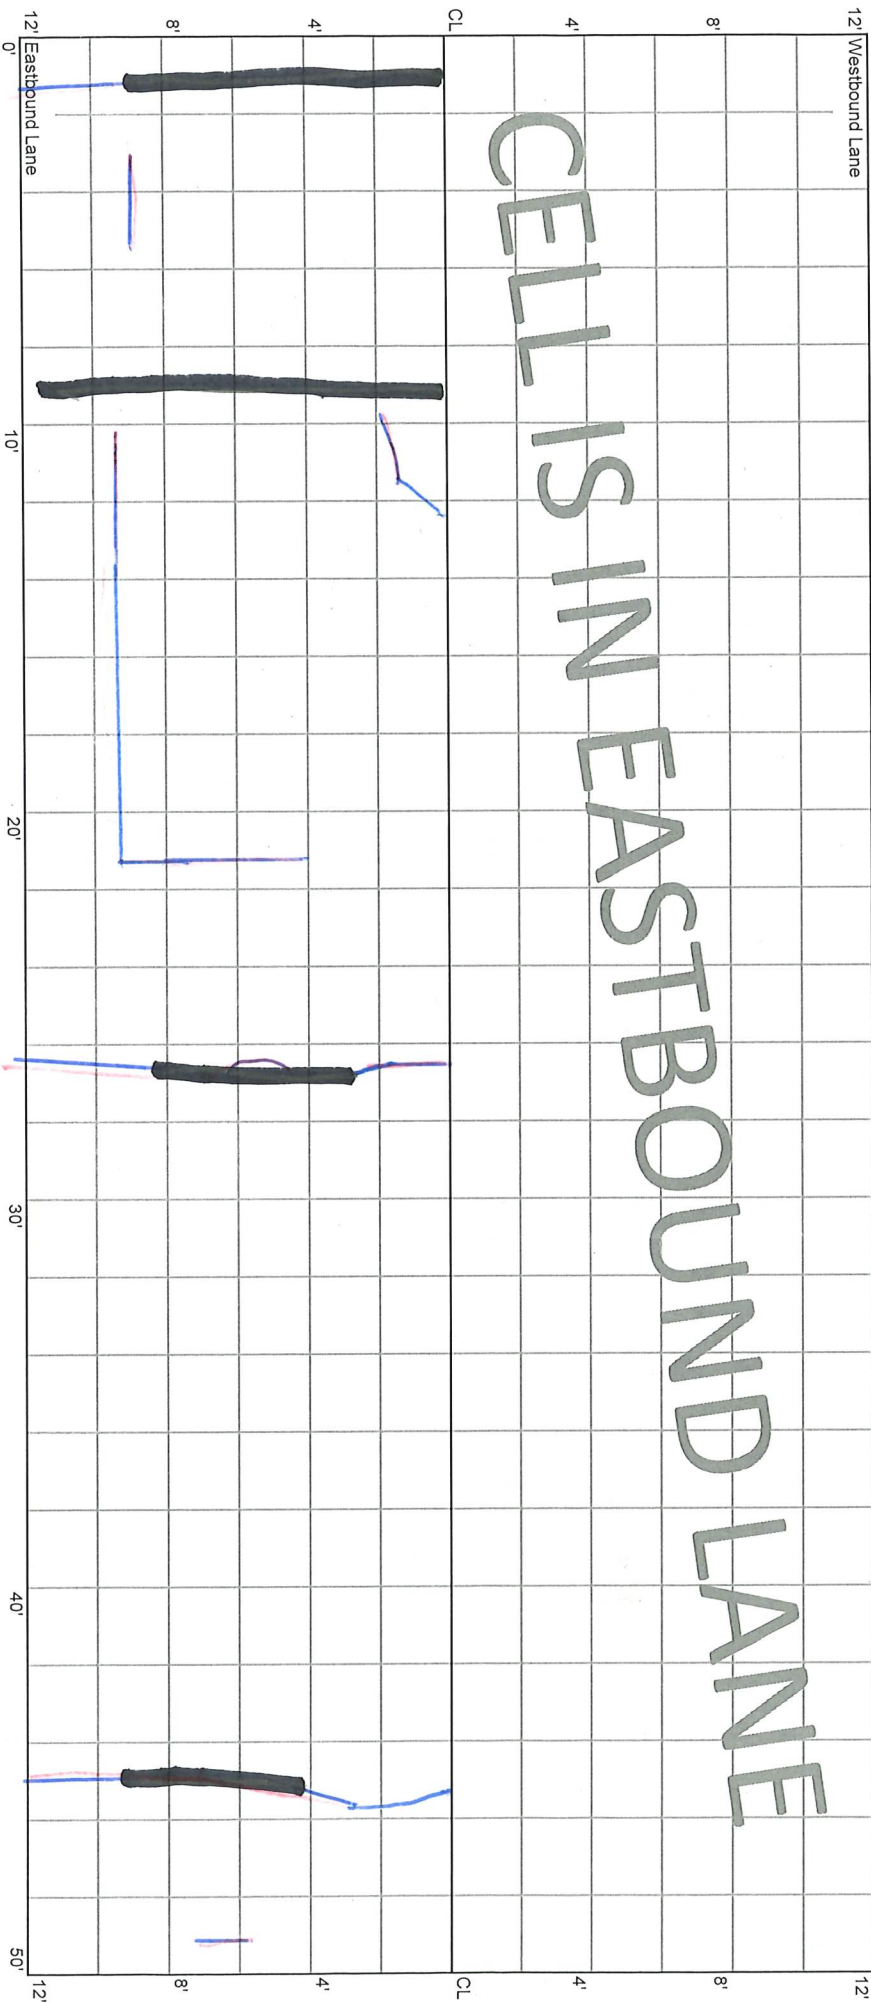

12' Eastbound Lane

12'

*

*


*

*

M
SP 1.5'

M
not
Sealed

CELL 7002E
500 - 550 ft

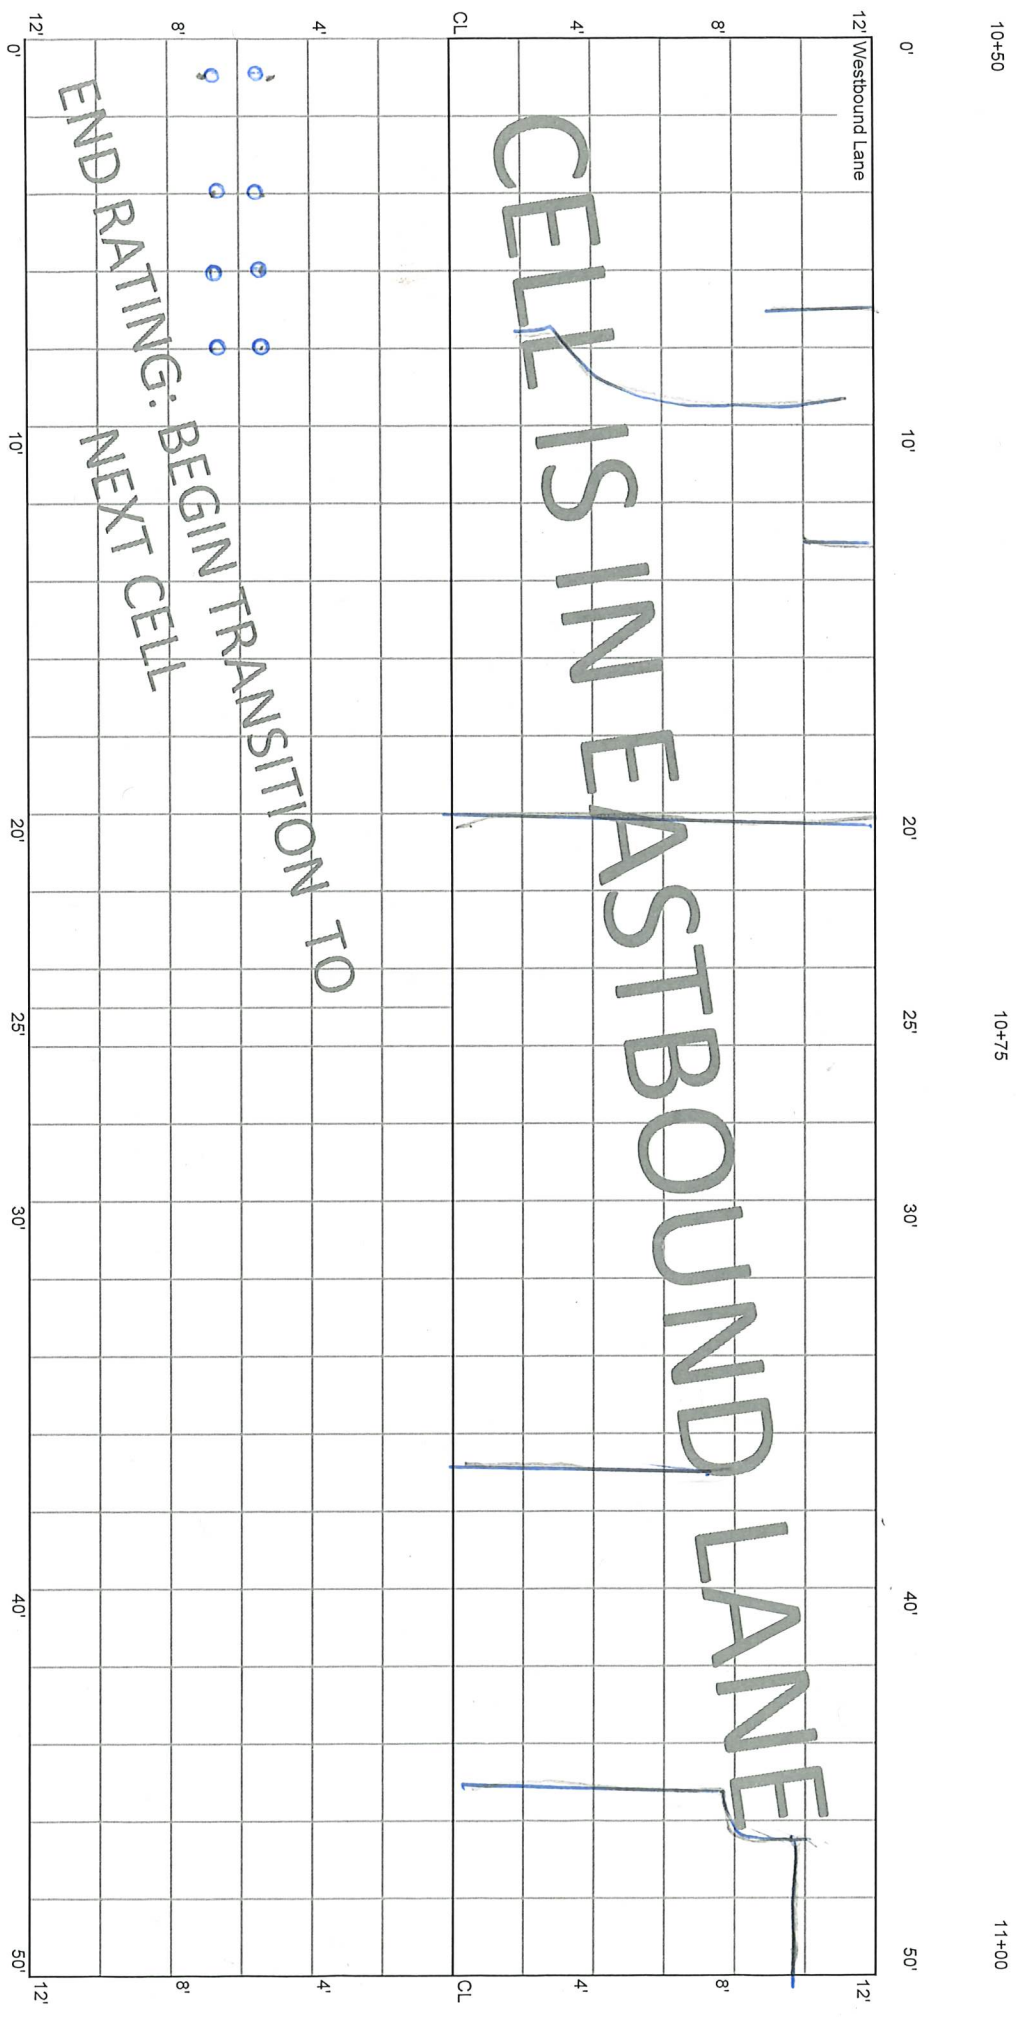

(0:12020
CORES)