

5.28.20 E.J.


10.14.20 1.3.22

1.4.21 8.30.22

8.25.21 1.20.23

CELL 7003E
0 - 50 ft

8/21 > 8 Trans crts outside
Fog line.

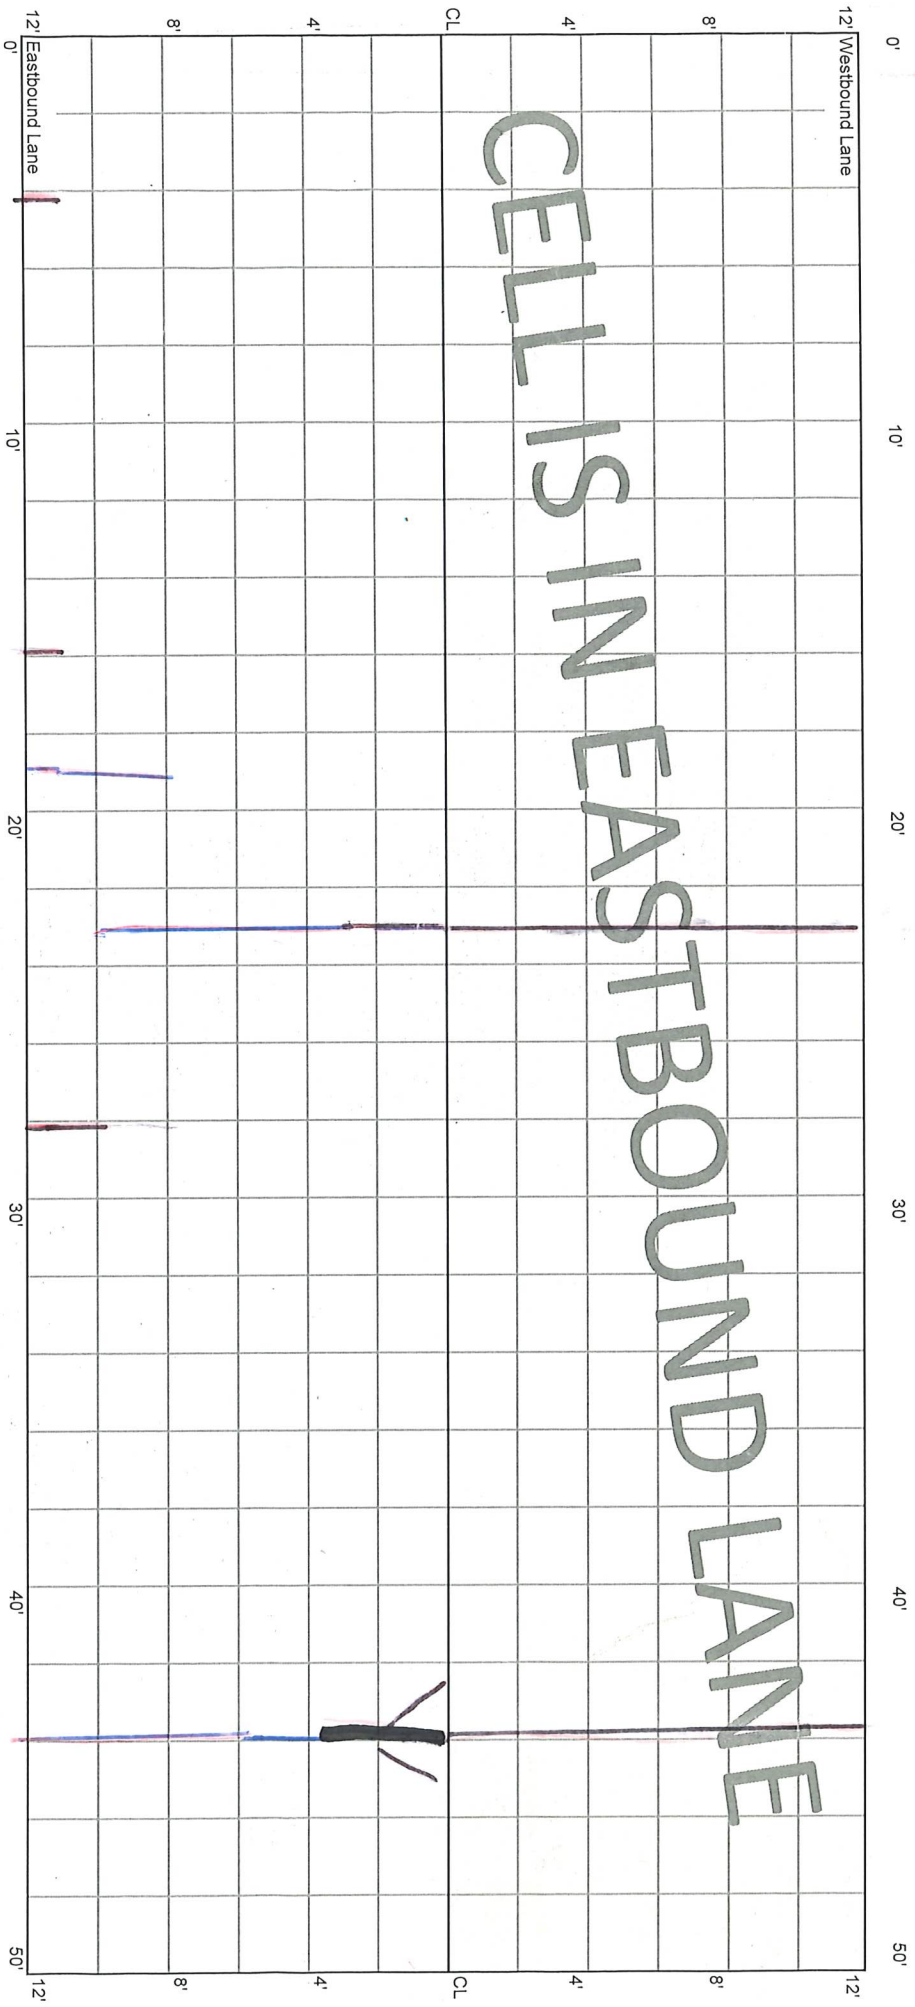


* Route Seal

*


CELL 7003E
50 - 100 ft

11+50

12+00

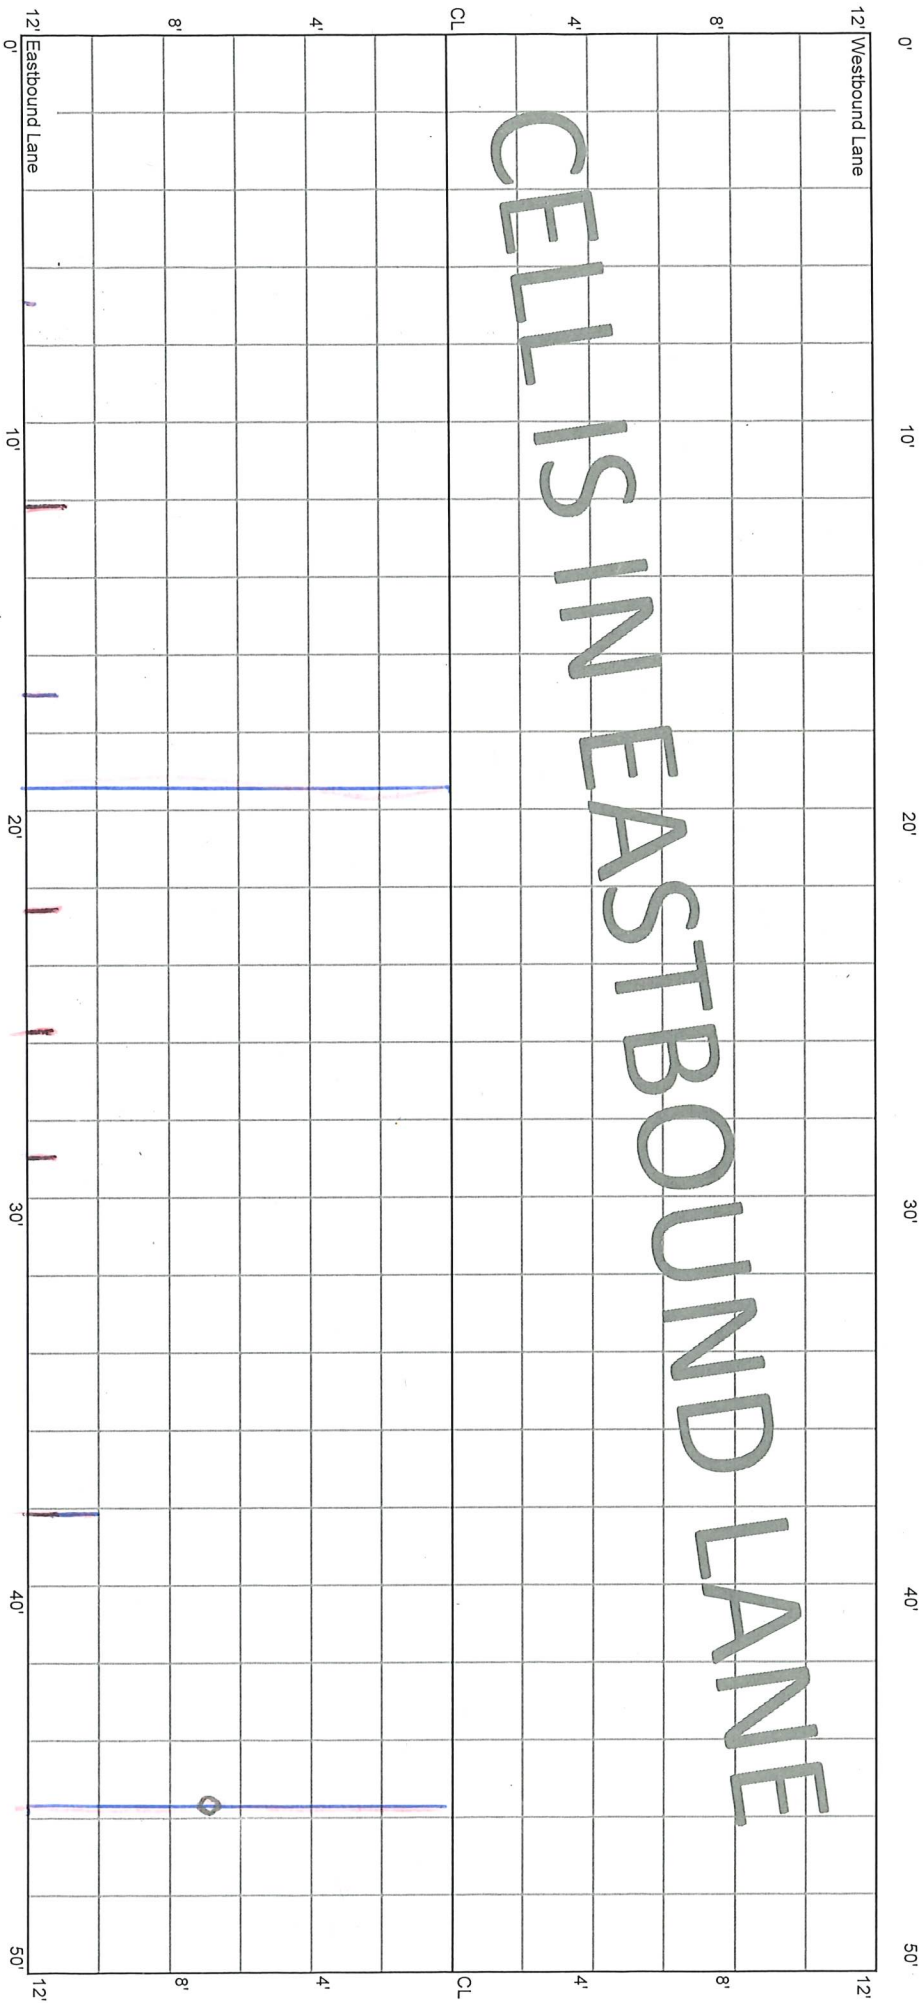


CELL 7003E
100 - 150 ft

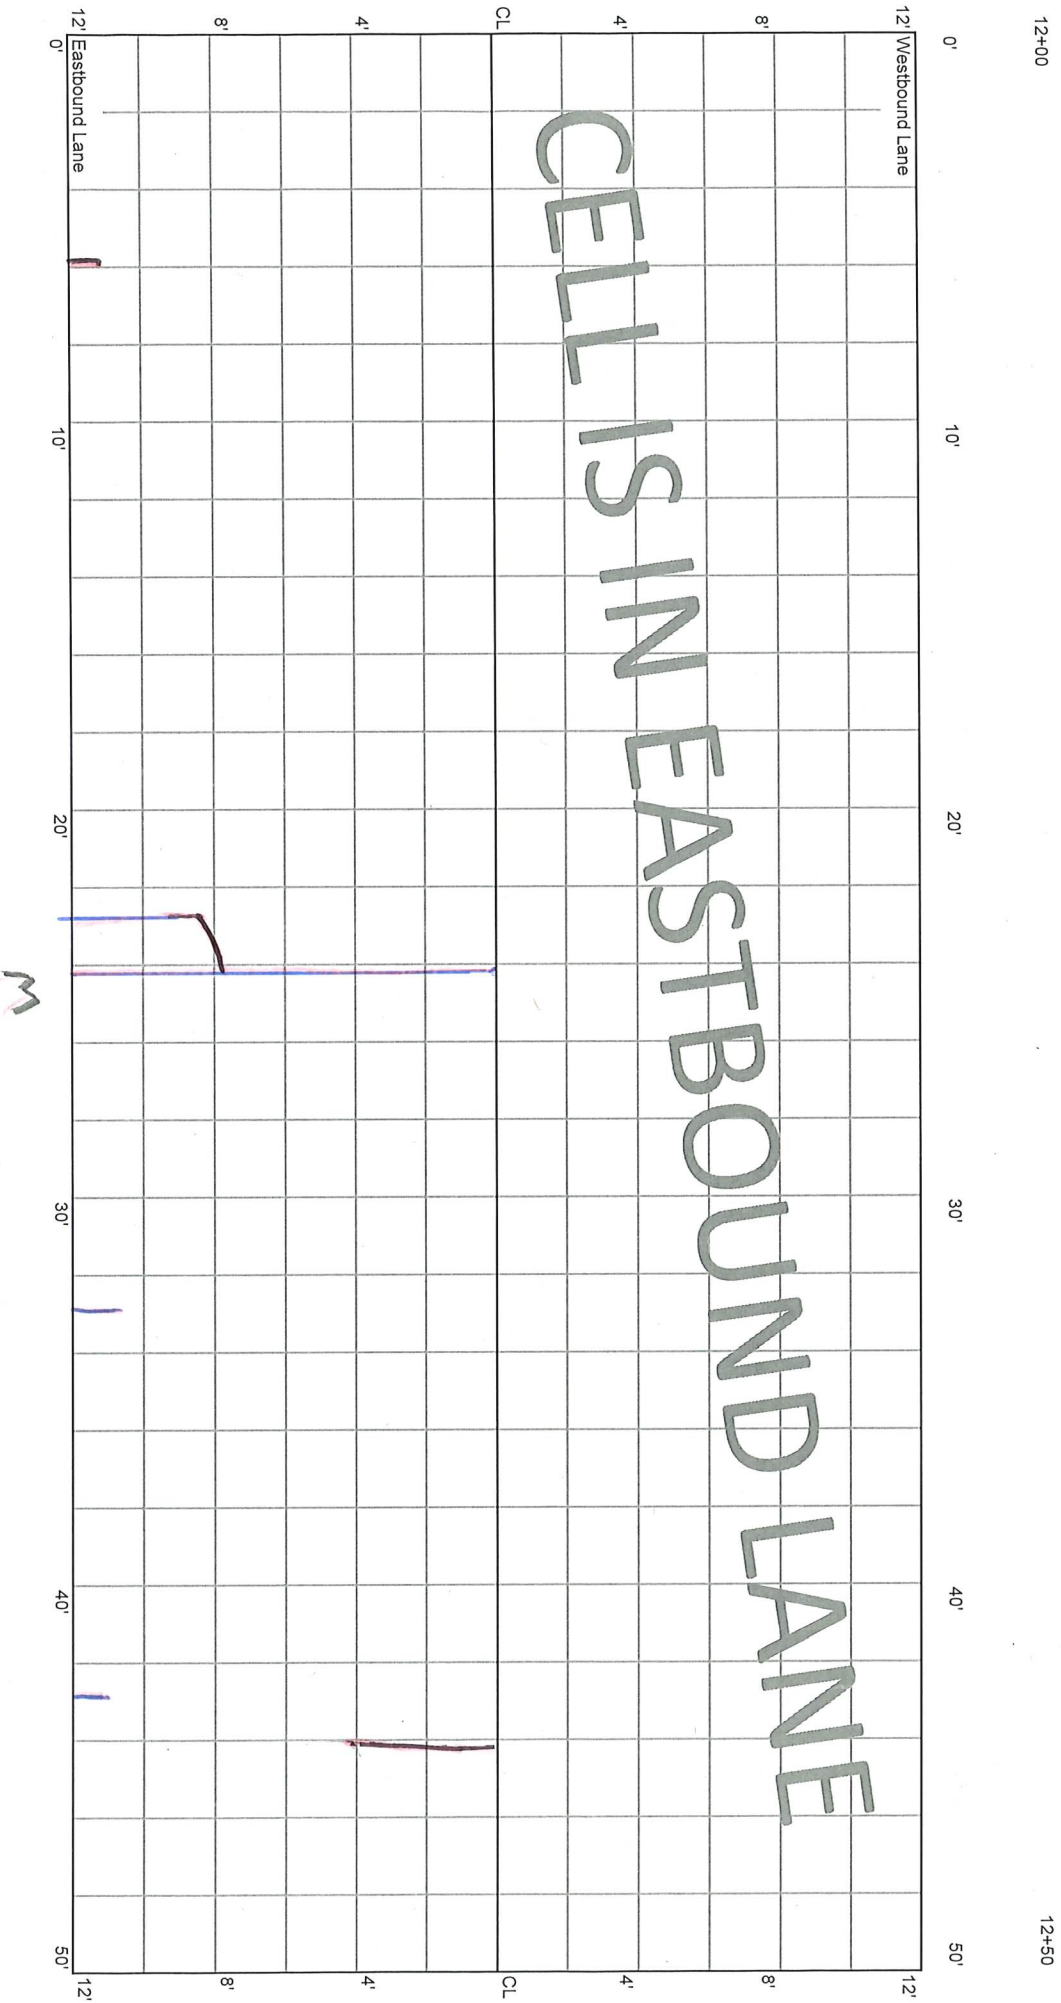

CELL 7003E
150 - 200 ft

12+50

13+00

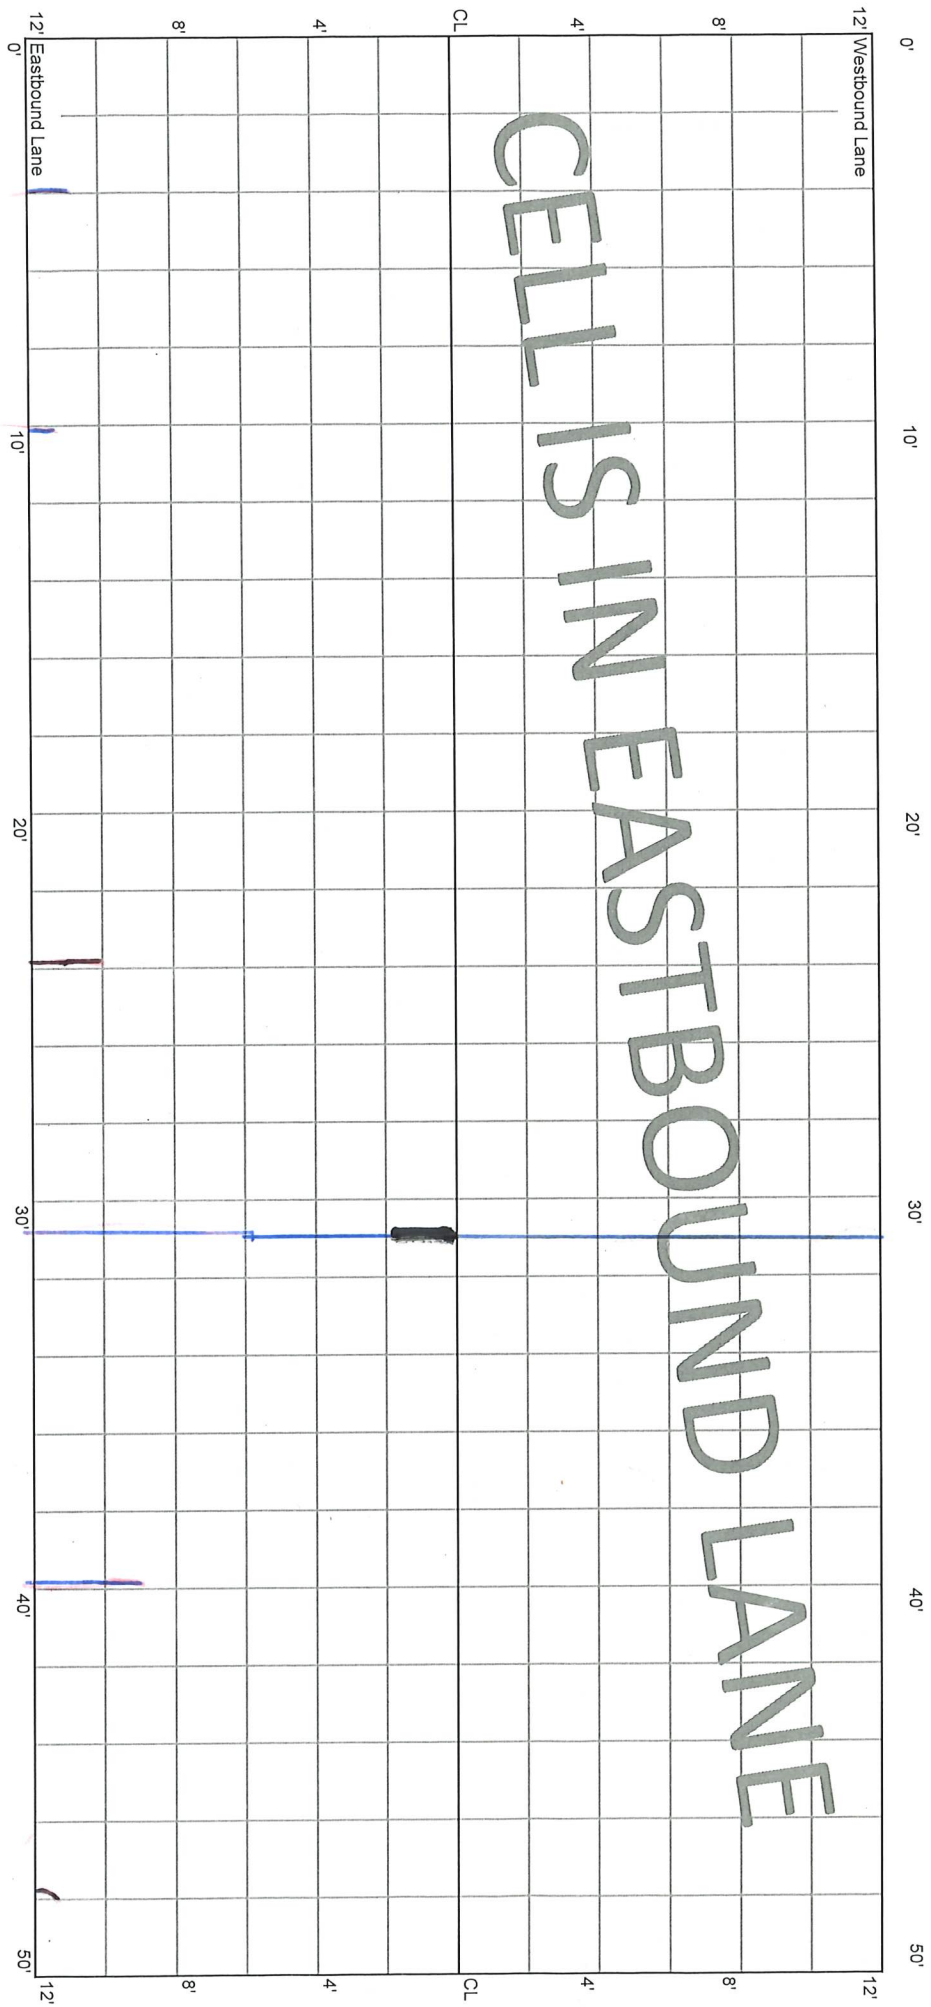


CELL IS IN EASTBOUND LANE

* M

CELL 7003E
200 - 250 ft

13+00

13+50

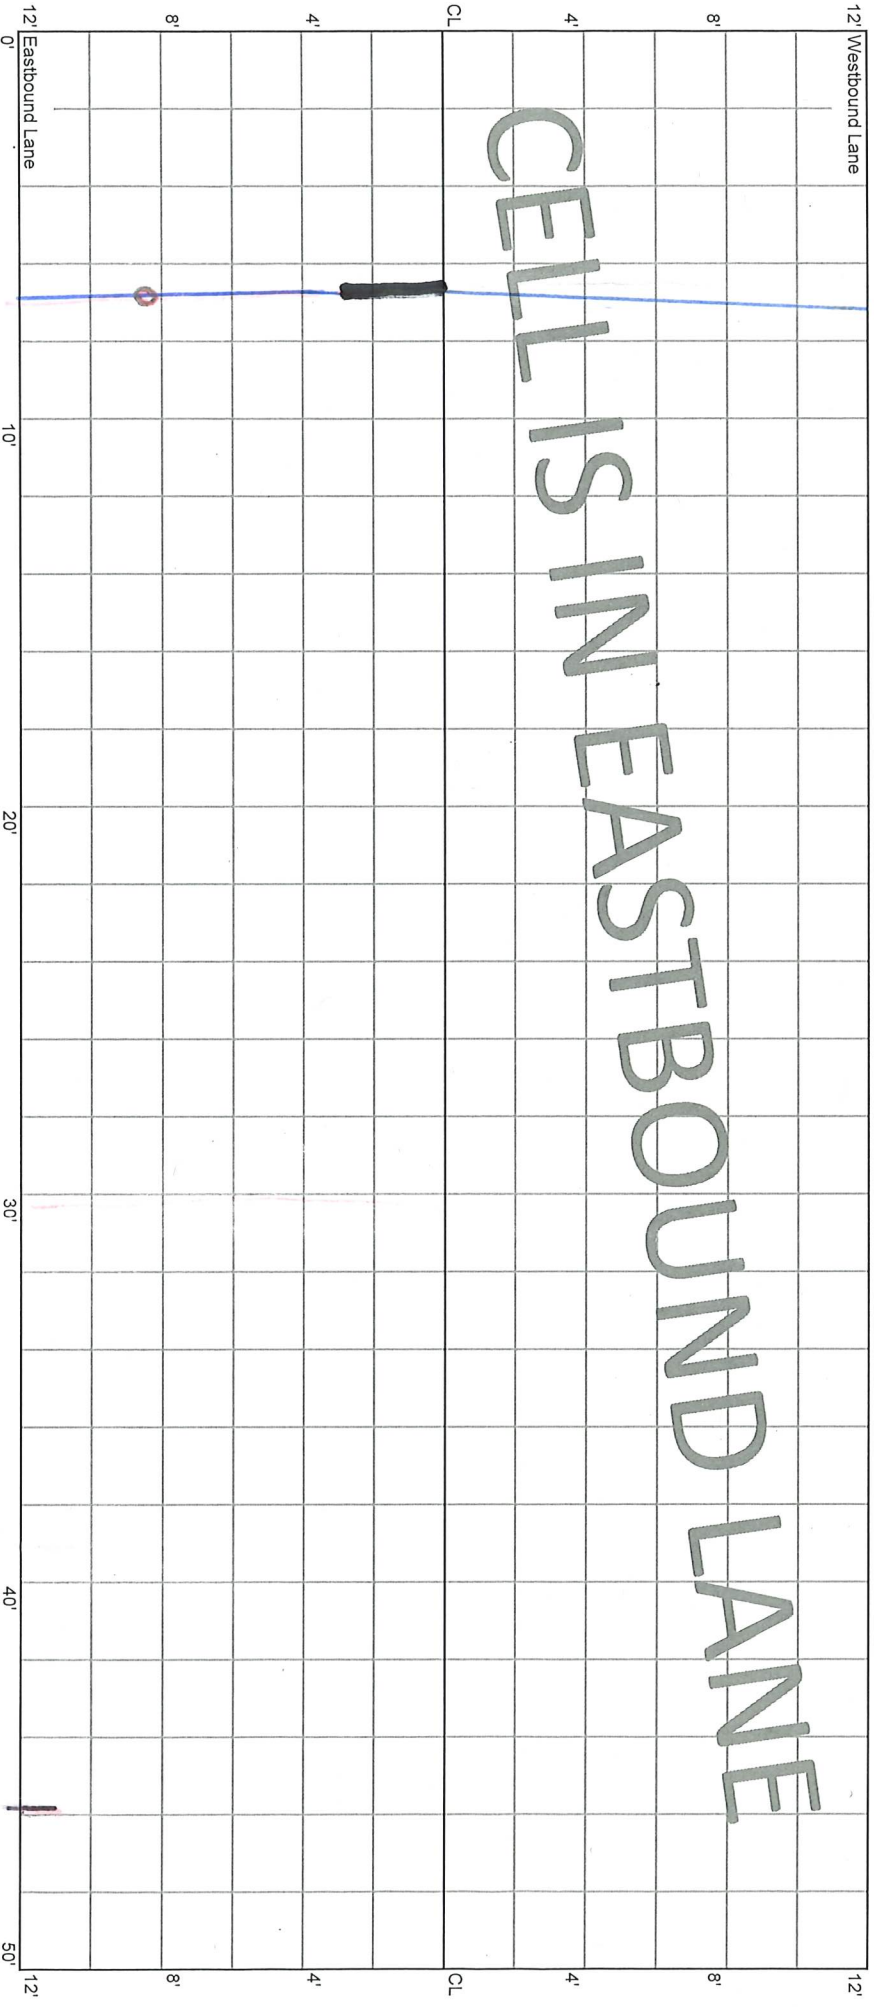

CELL IS IN EASTBOUND LANE


M

A

CELL 7003E
250 - 300 ft

13+50

14+00

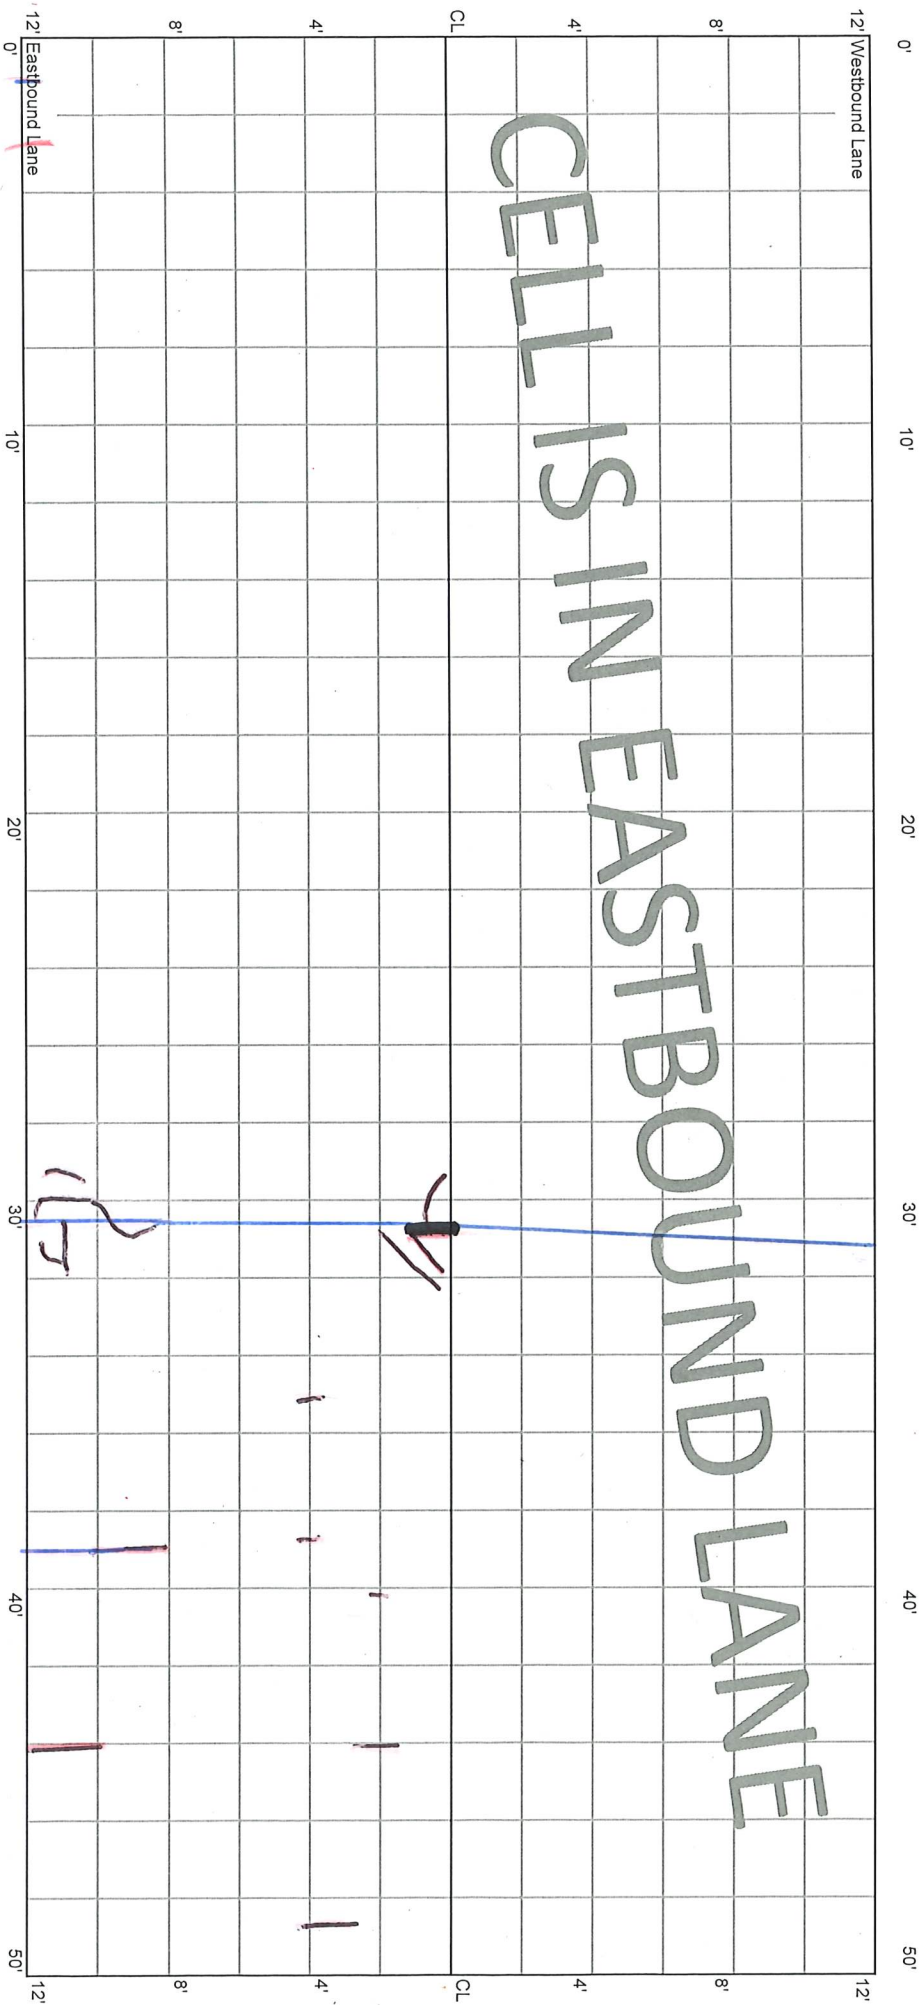


15
*
M

CELL 7003E
300 - 350 ft

14+00

14+50

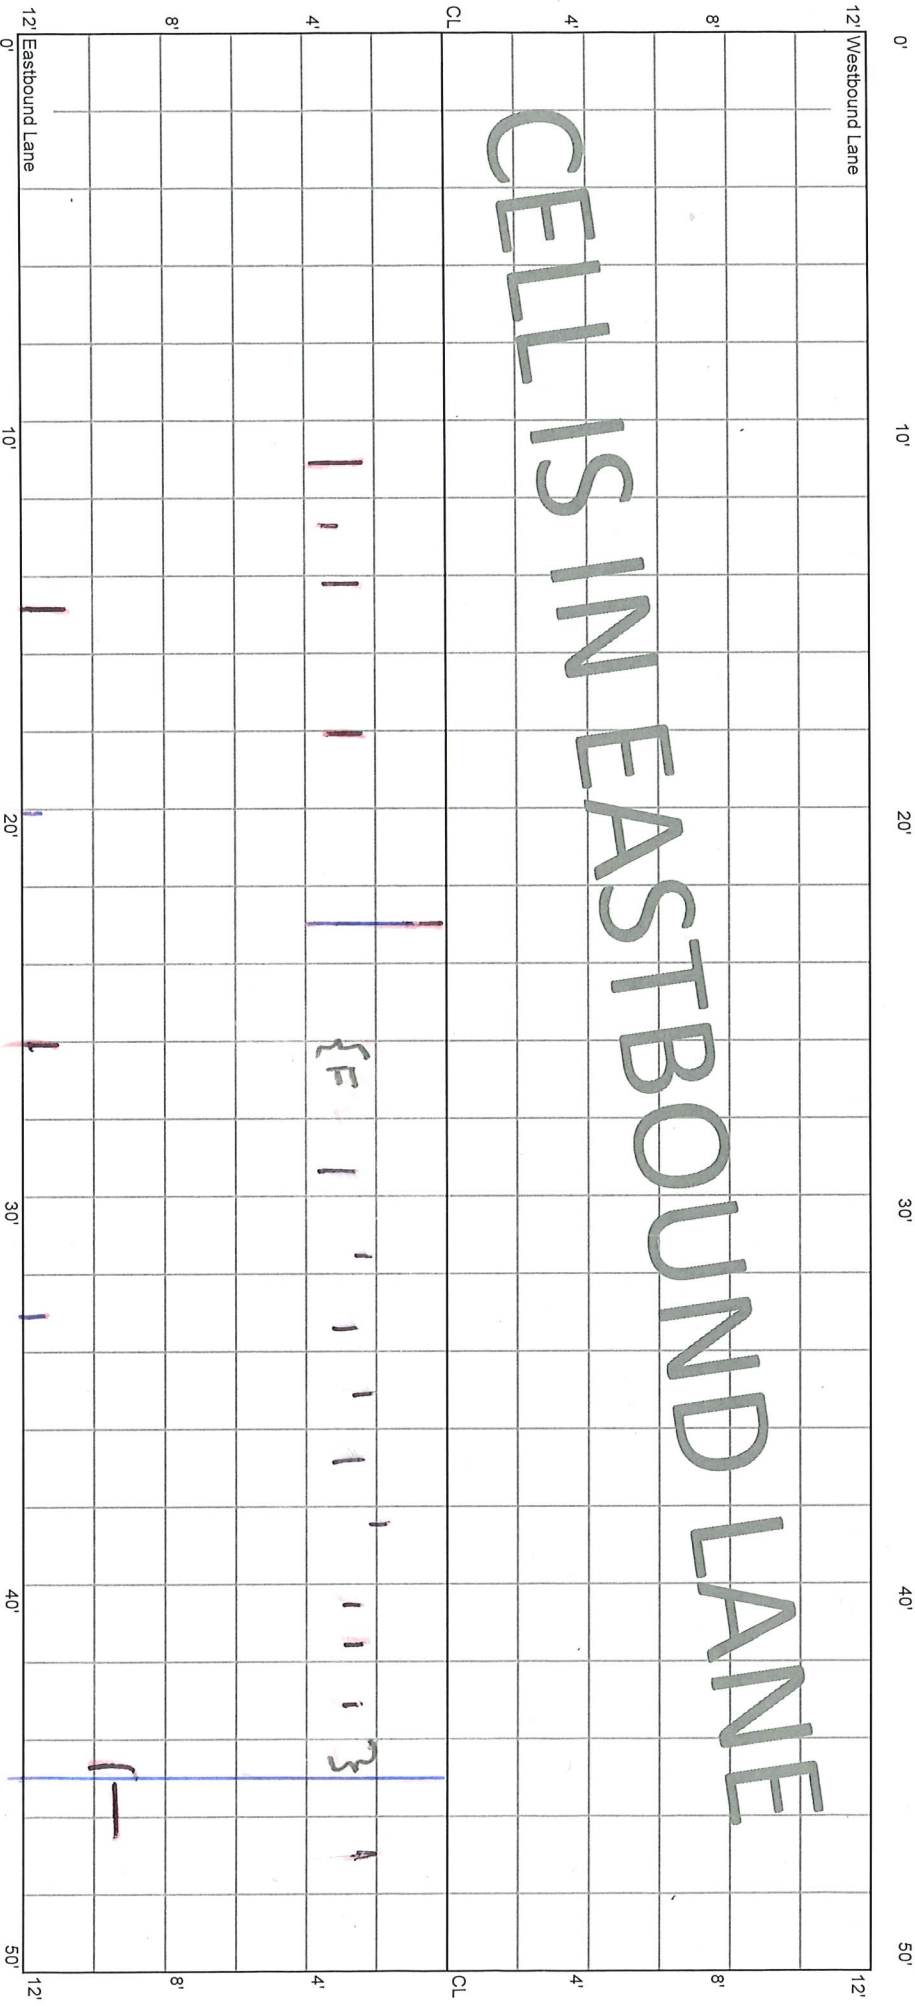

CELLS IN EASTBOUND LANE


M

E

CELL 7003E
350 - 400 ft

14+50

15+00

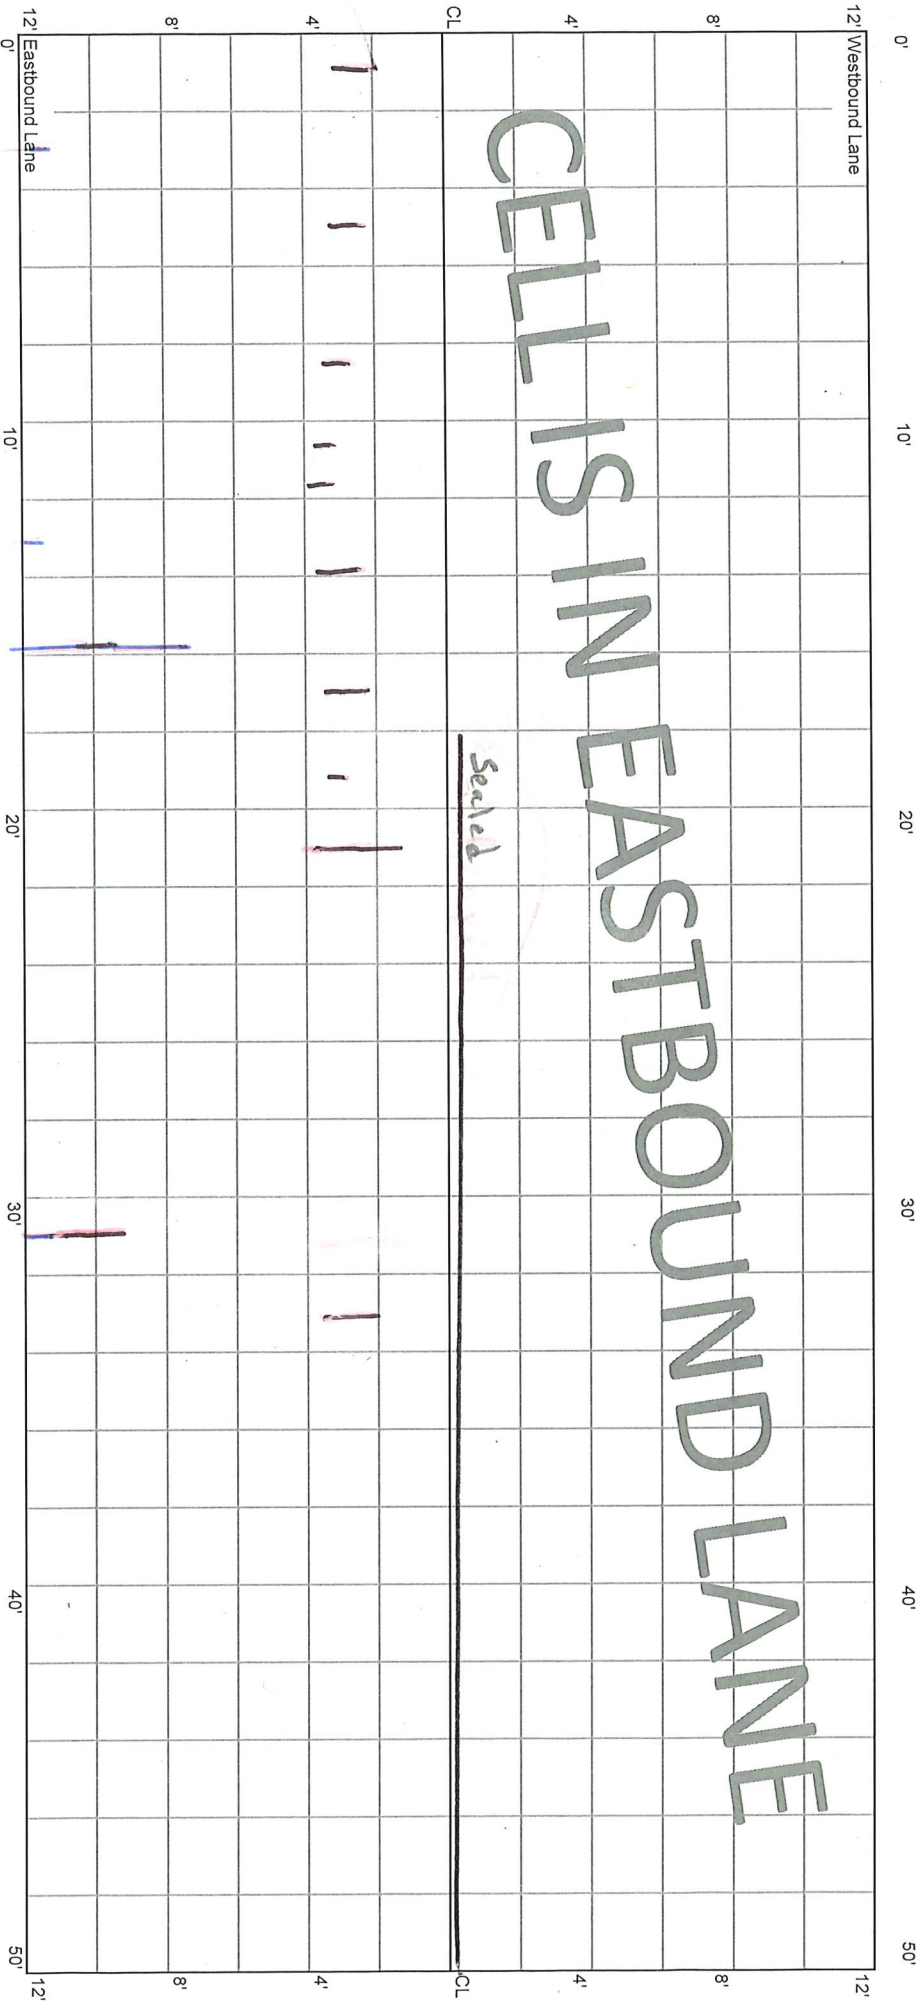


Jan '23 - CL St capped

CELL 7003E
400 - 450 ft


15+00

15+50

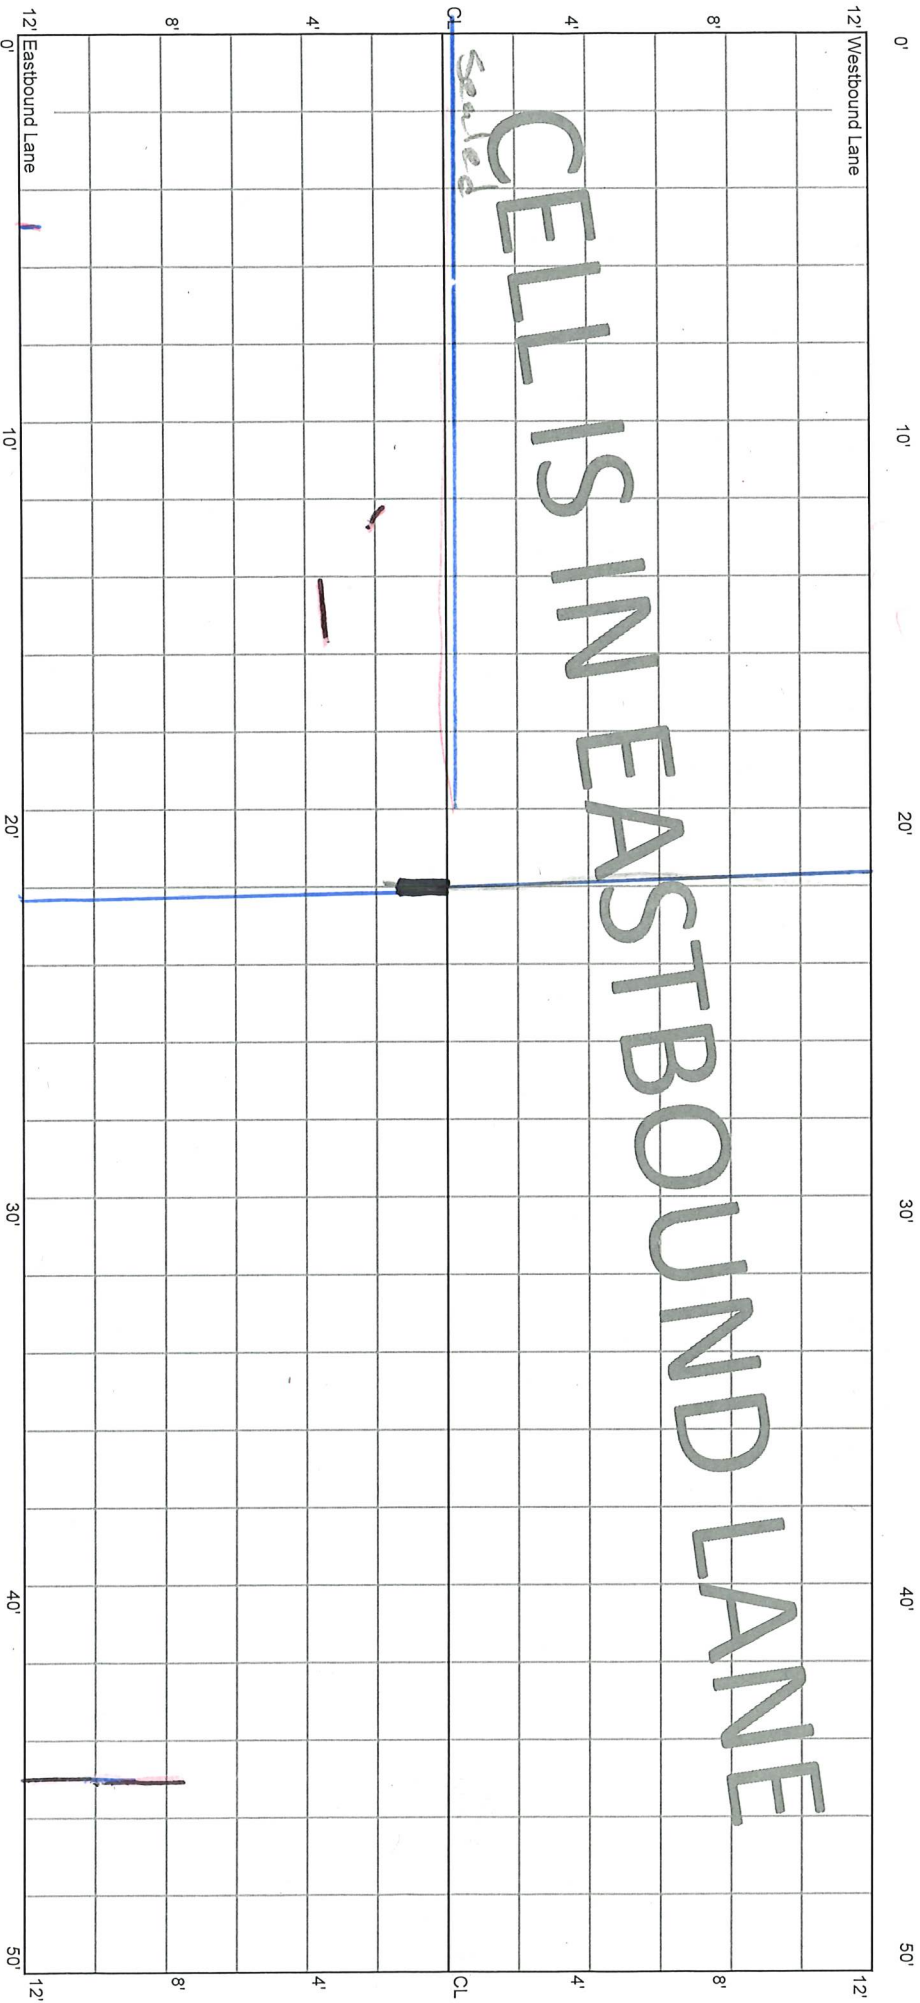

Jan '23 - CL J+ capped

CELL 7003E
450 - 500 ft

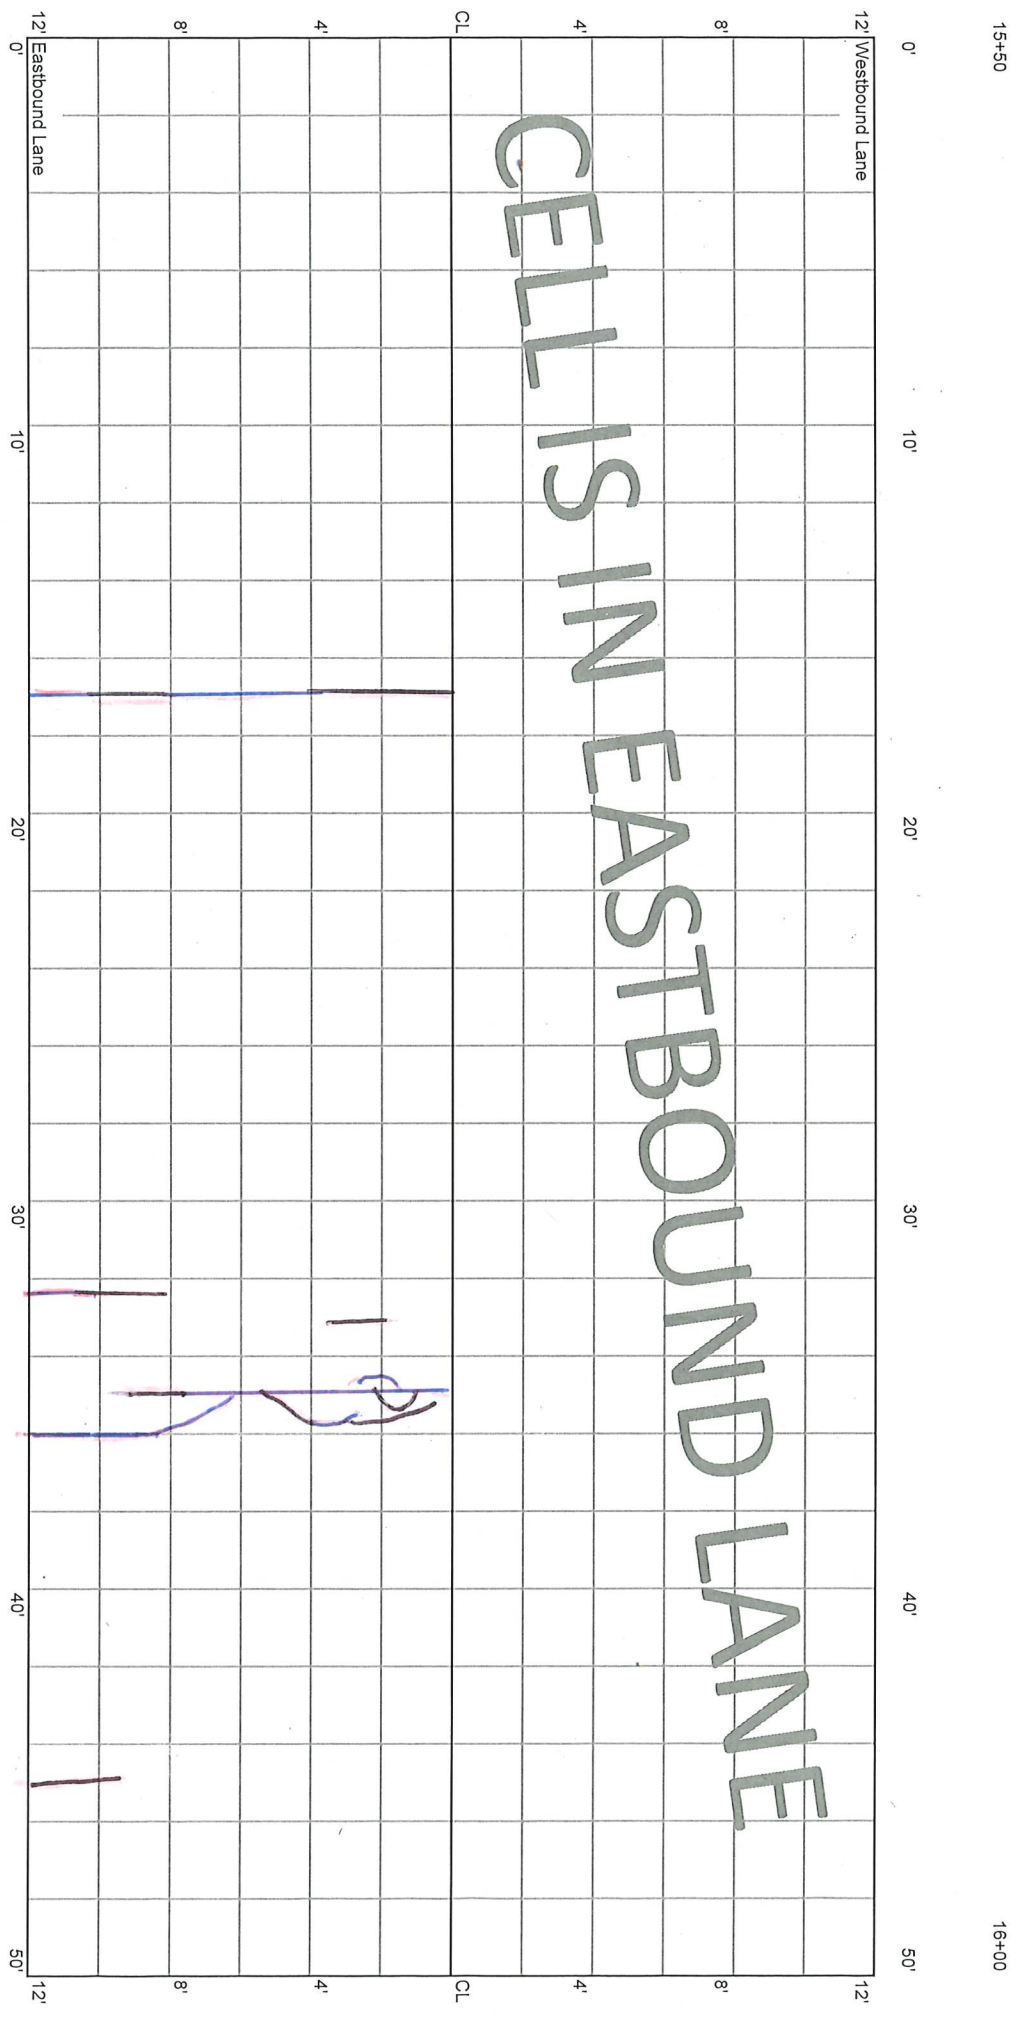

CELL 7003E
500 - 550 ft

16+00


16+25

16+50

12' Westbound Lane

0' 10' 20' 25' 30' 40' 50'

CELLS IN EASTBOUND LANE

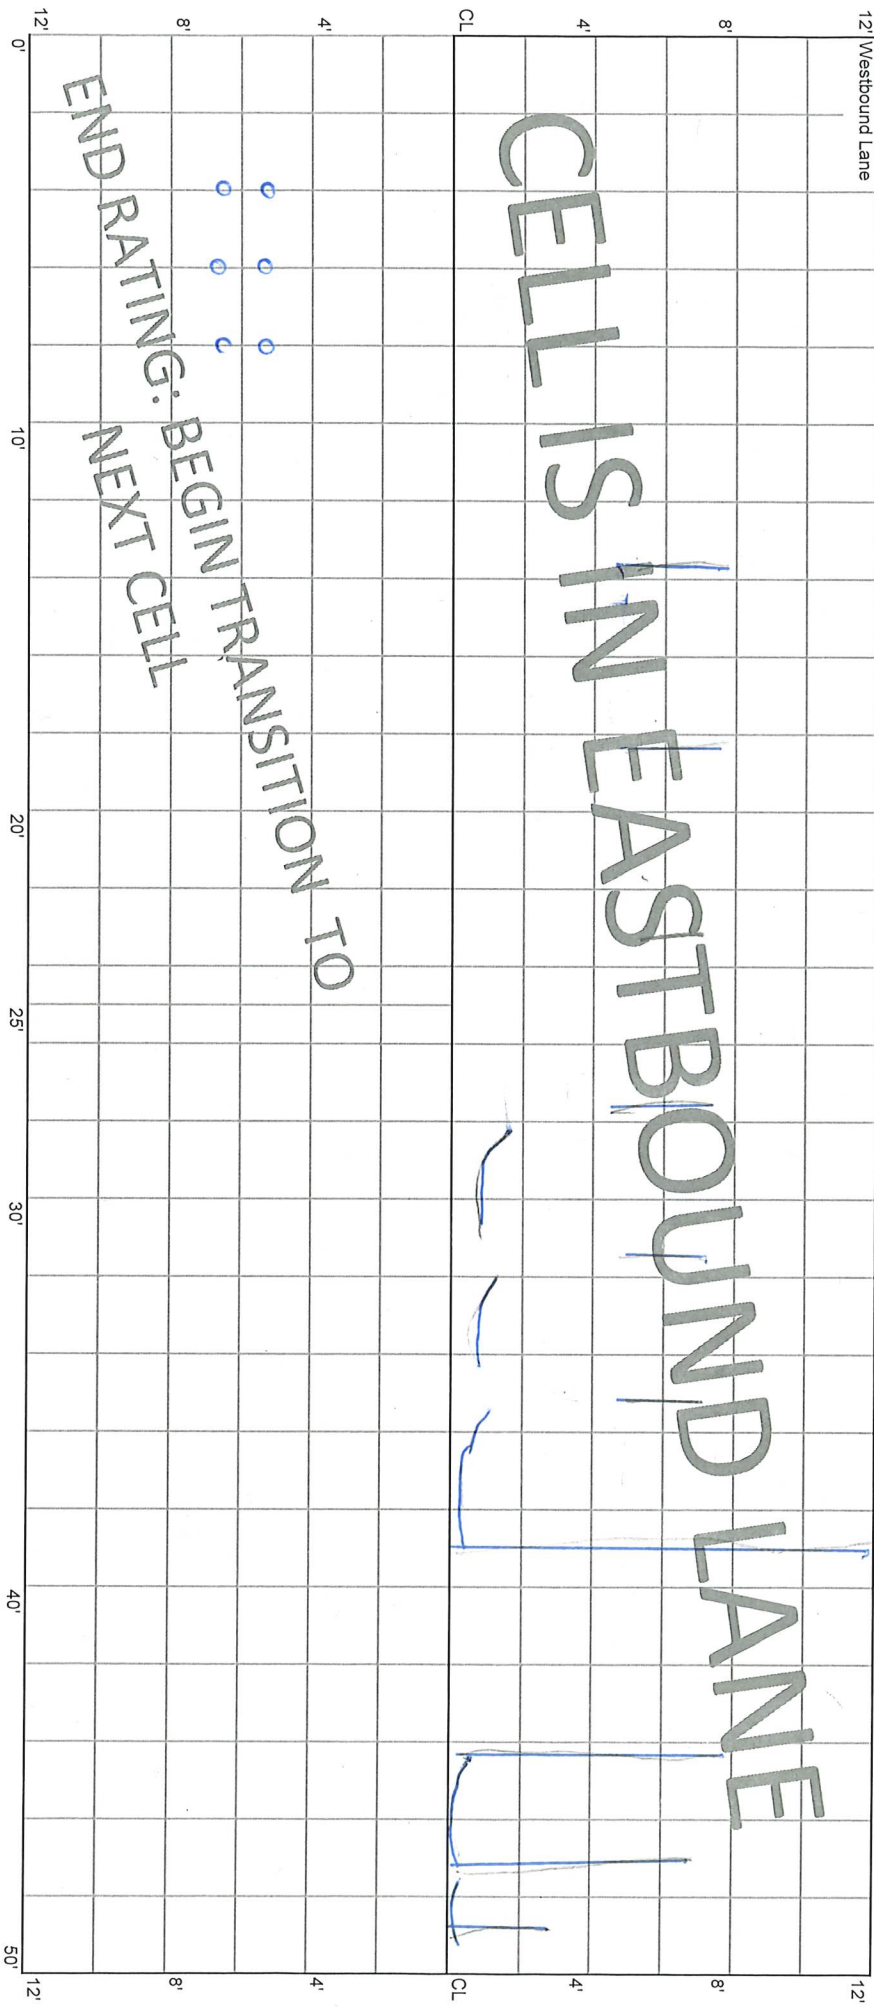

END RATING: BEGIN TRANSITION TO
NEXT CELL

(03 Oct '20)
Cares