

5.28.20 E.J.

10.14.20 | 1.12.22

11.4.21


File 70TH ST

8.25.21

CELL 7004E
0 - 50 ft

8/25/21 ~ 80 Trans cracks
outside of Fog line

Put outside of Fog line for 150'

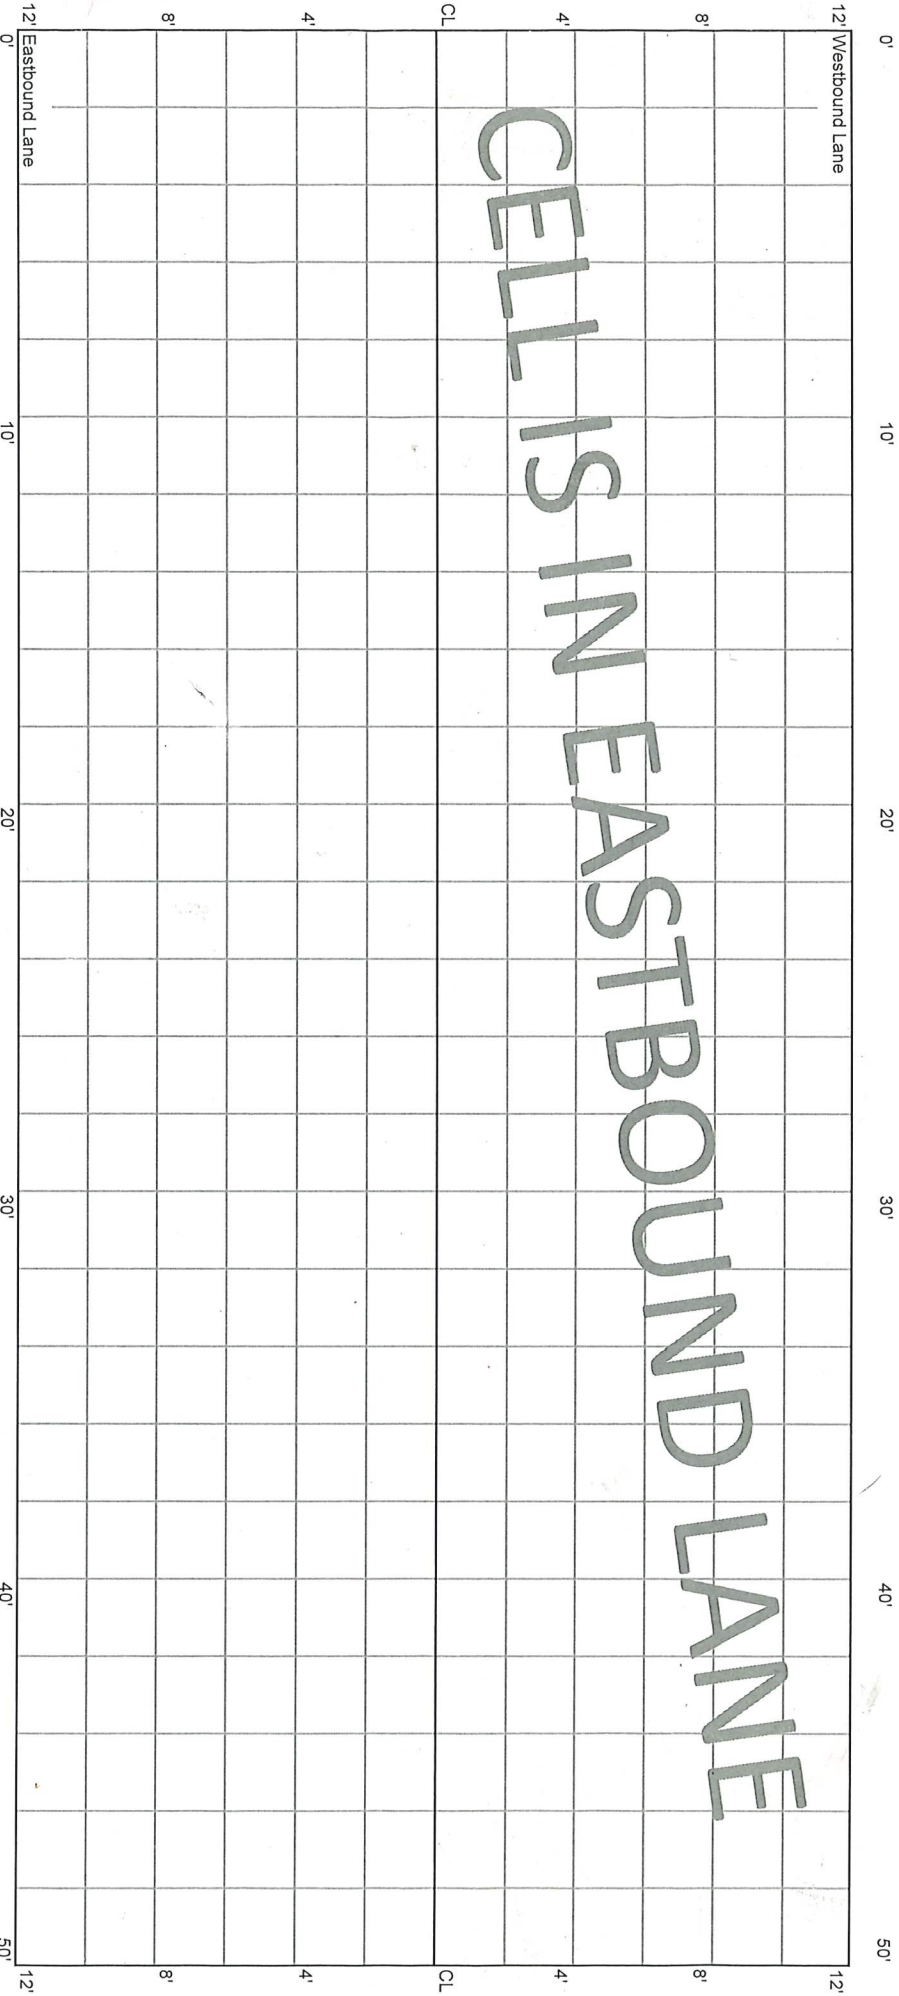


* Rout & Seal

CELL 7004E
50 - 100 ft

17+00

17+50

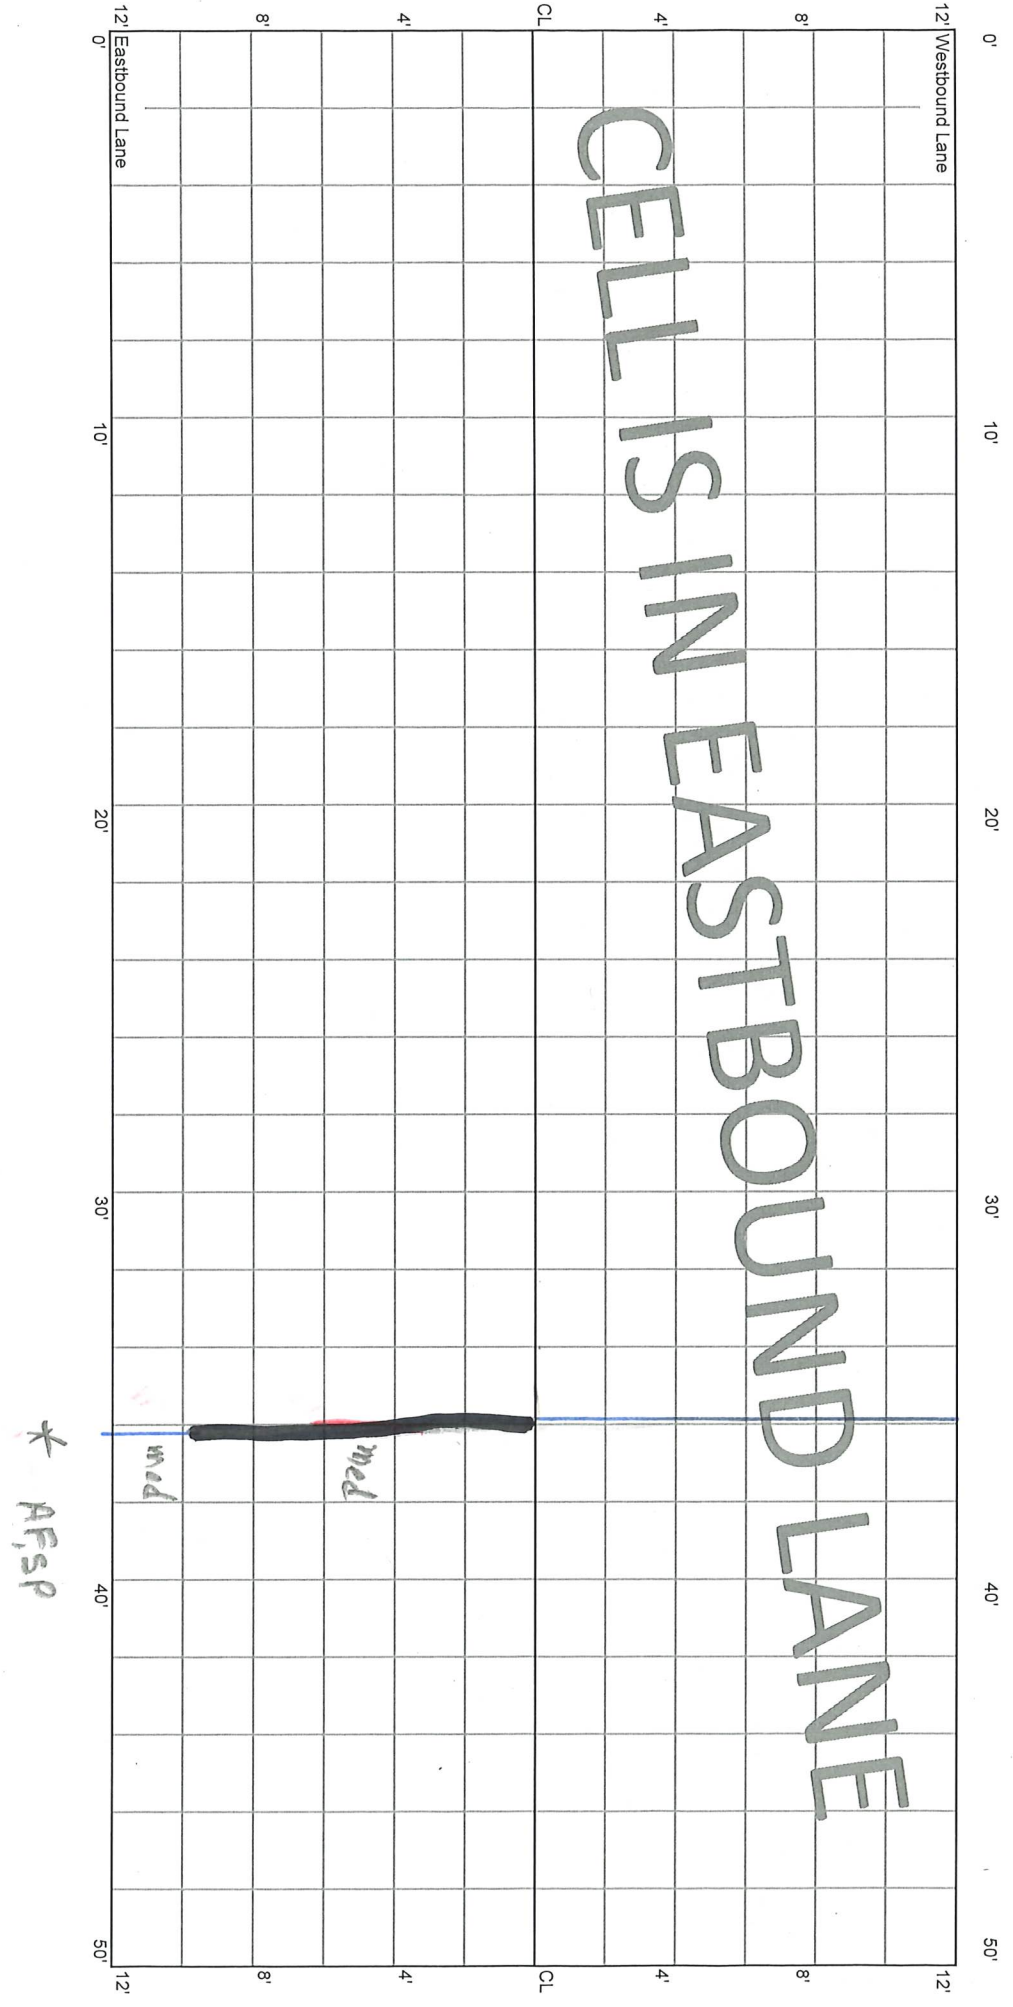


CELLS IN EASTBOUND LANE

* AFSP

CELL 7004E
100 - 150 ft

17+50

18+00

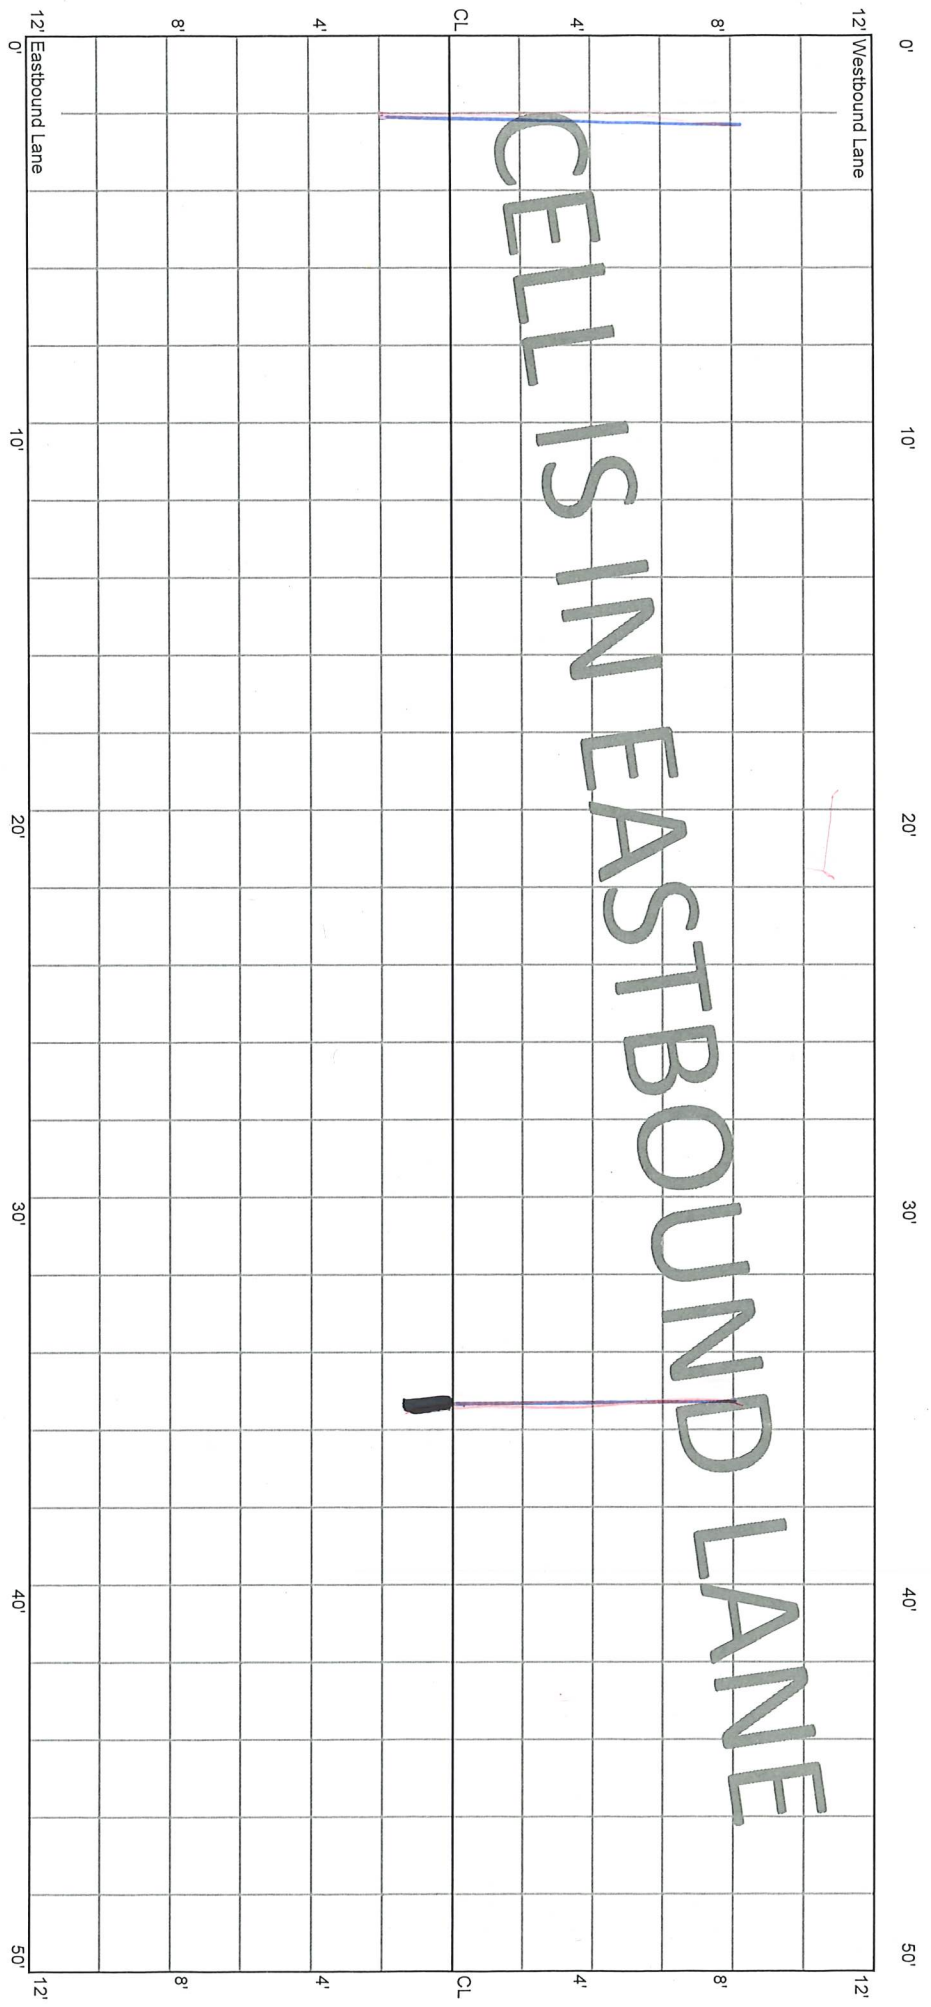


CELL IS IN EASTBOUND LANE

*

CELL 7004E
150 - 200 ft

18+00

18+50

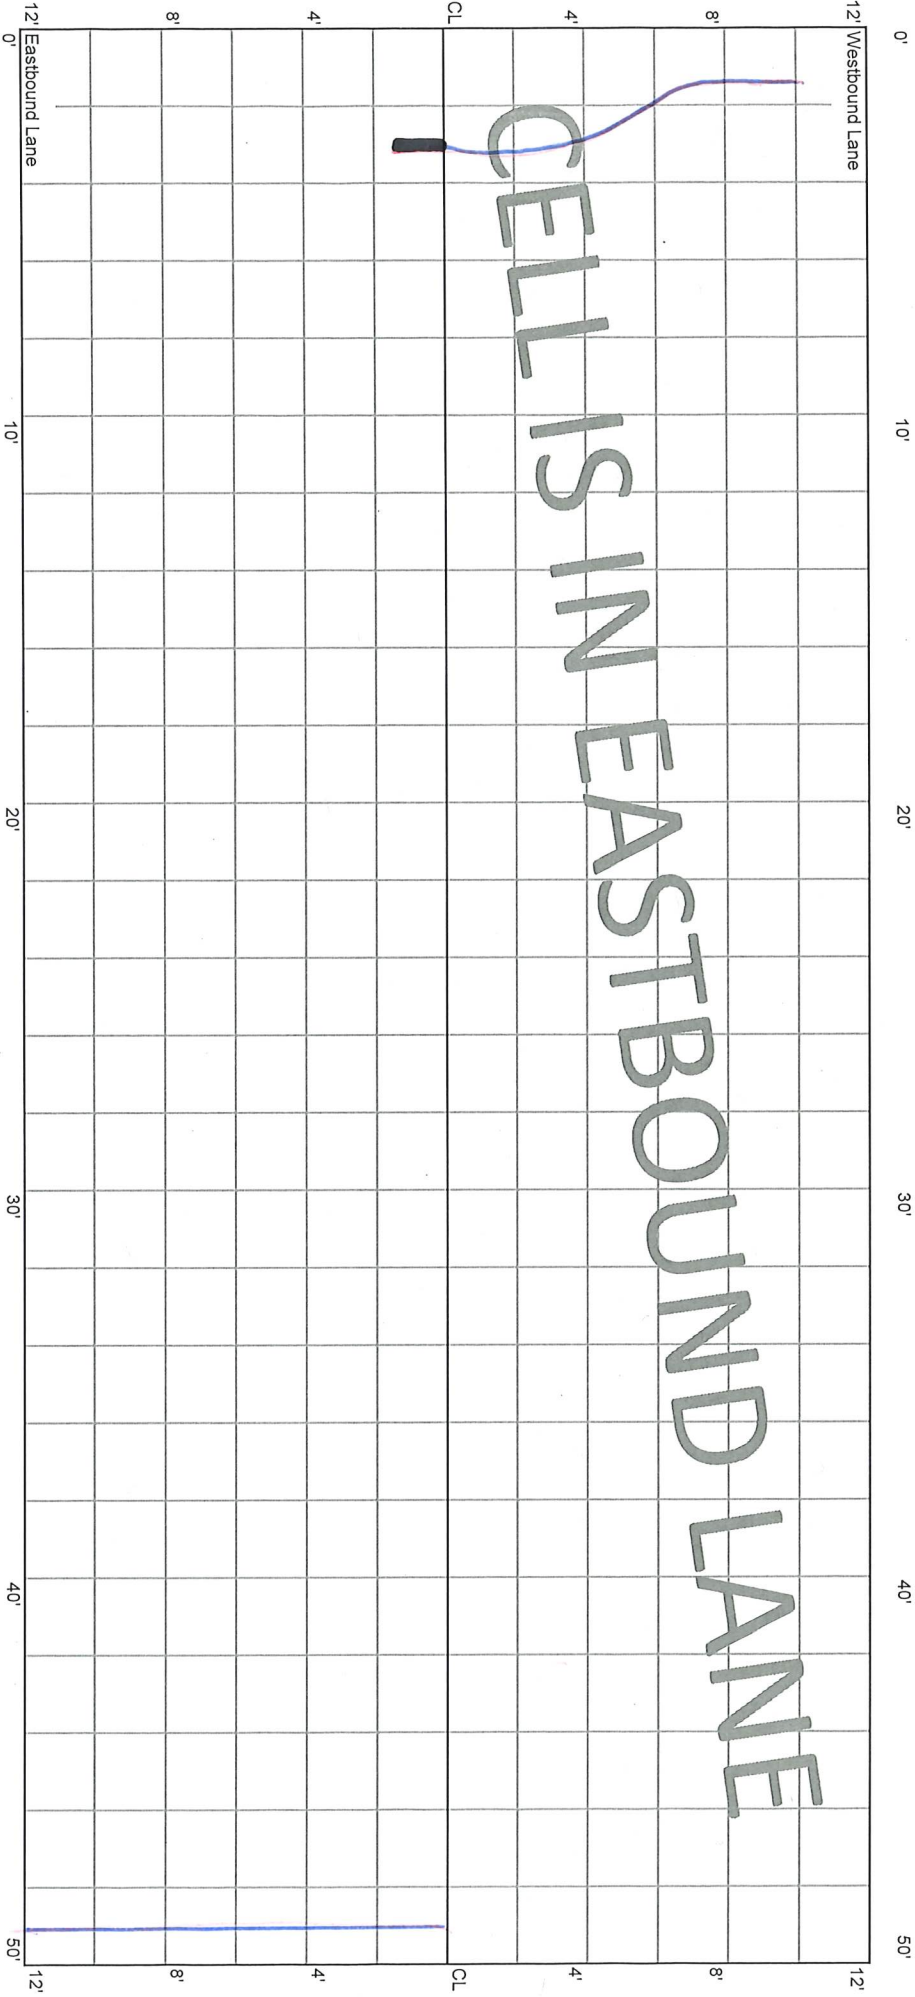


*

M

CELL 7004E
200 - 250 ft

18+50

19+00

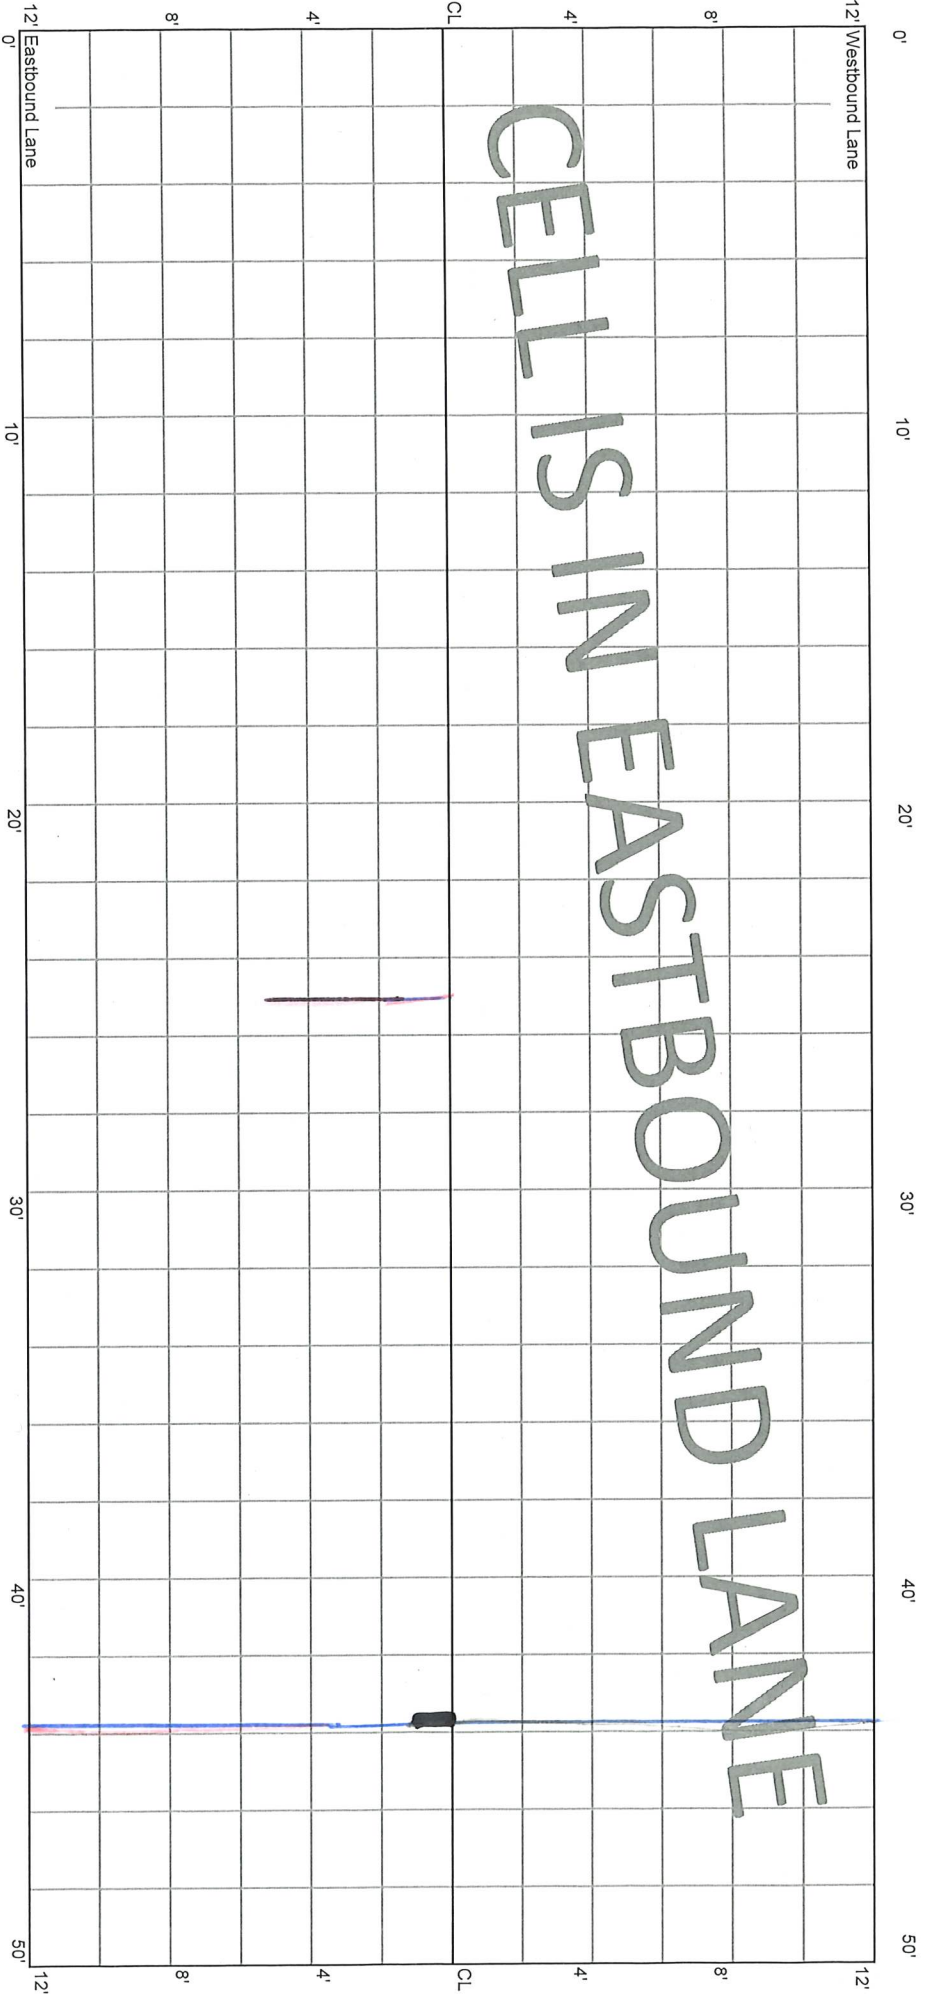


*

CELL 7004E
250 - 300 ft

19+00


19+50

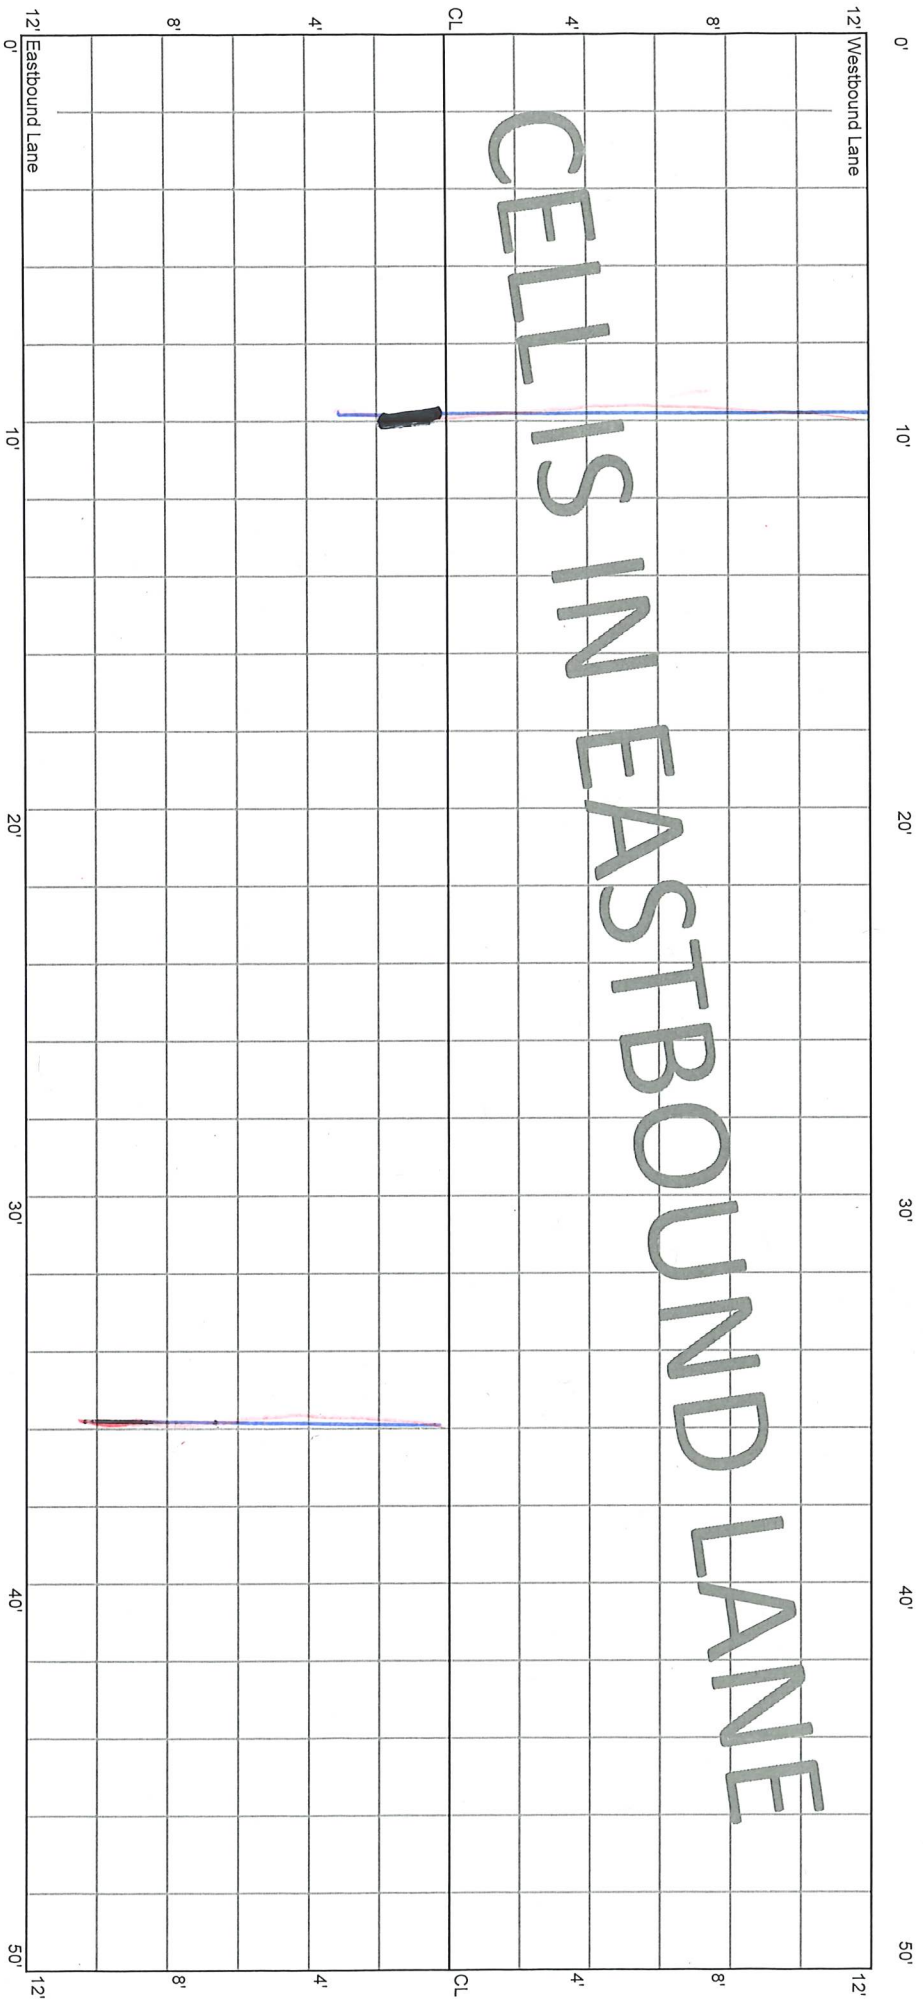

*

CELL 7004E
300 - 350 ft

Put outside Fogline 300 to end

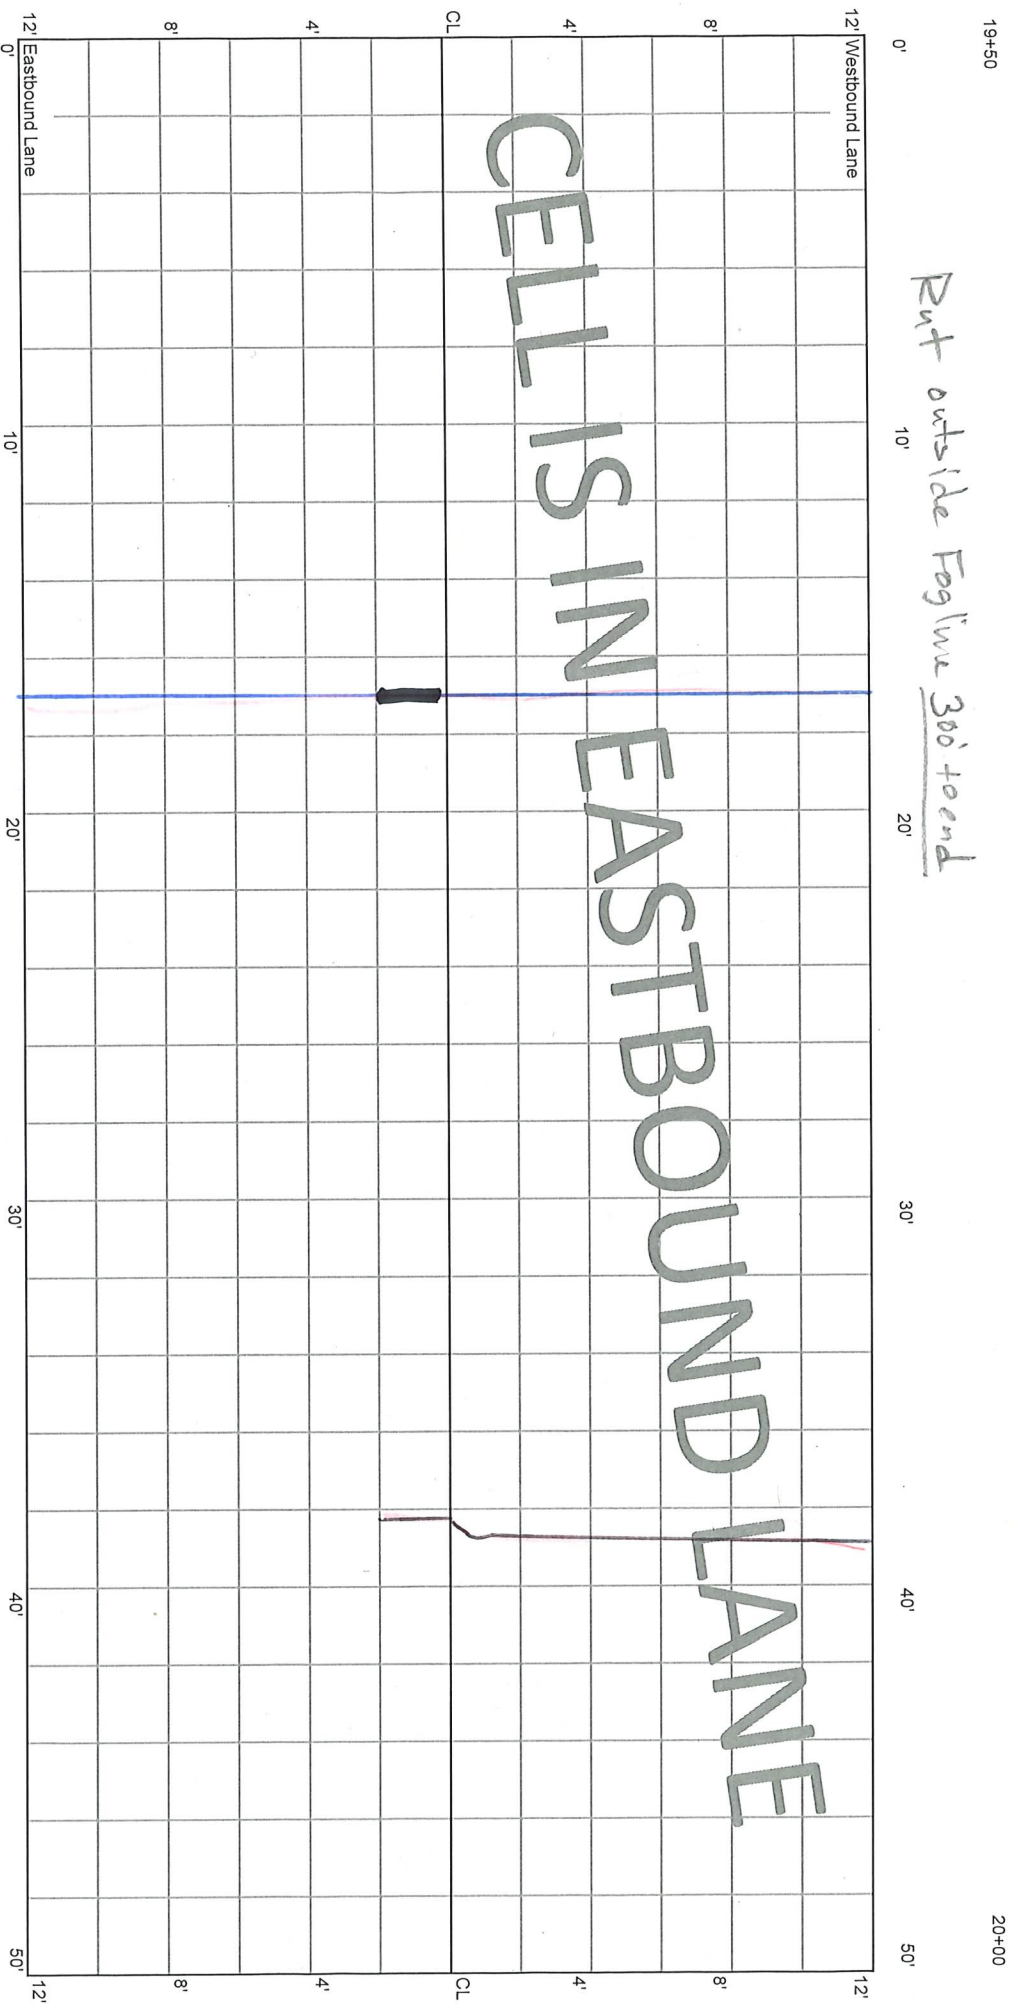

19+50

0'

10'

20'

30'

40'

50'

20+00

12' Westbound Lane

12' Eastbound Lane

CL

CL

CELL 7004E
350 - 400 ft

20+00

20+50

12' Westbound Lane

12'

0' 10' 20' 30' 40' 50'

CELL IS IN EASTBOUND LANE


CL CL

8' 4' 4' 8'


8' 4' 4' 8'

12' Eastbound Lane 0' 10' 20' 30' 40' 50' 12'


* M

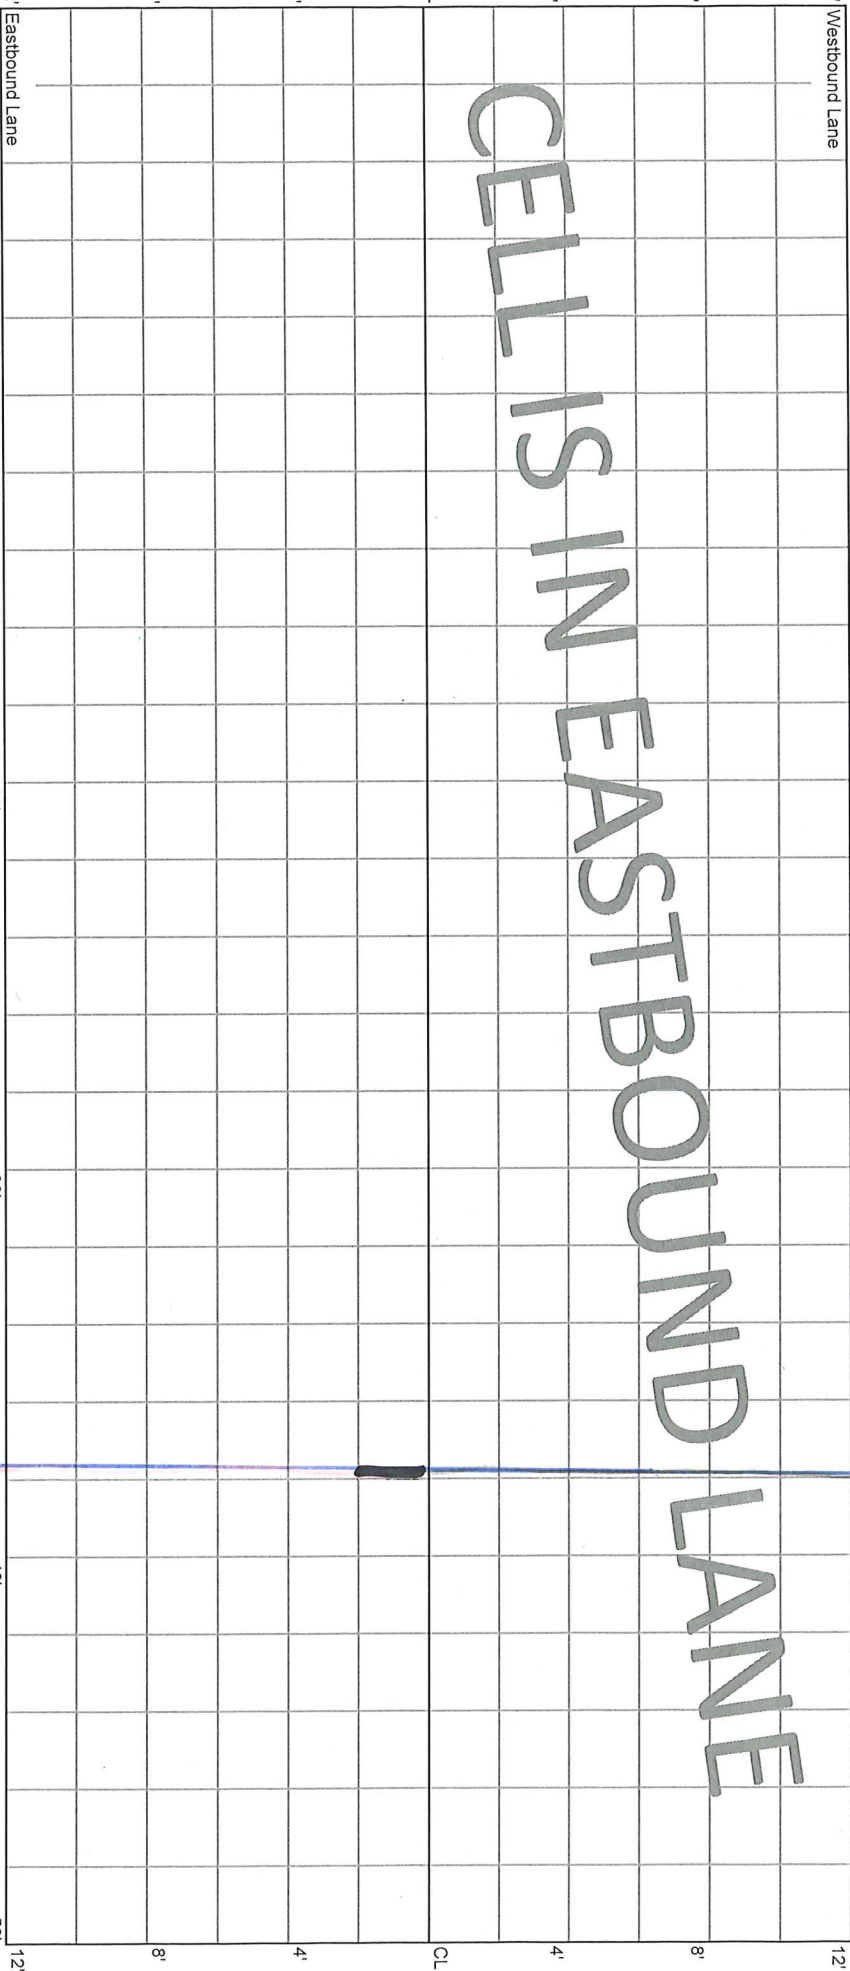

CELL 7004E
400 - 450 ft

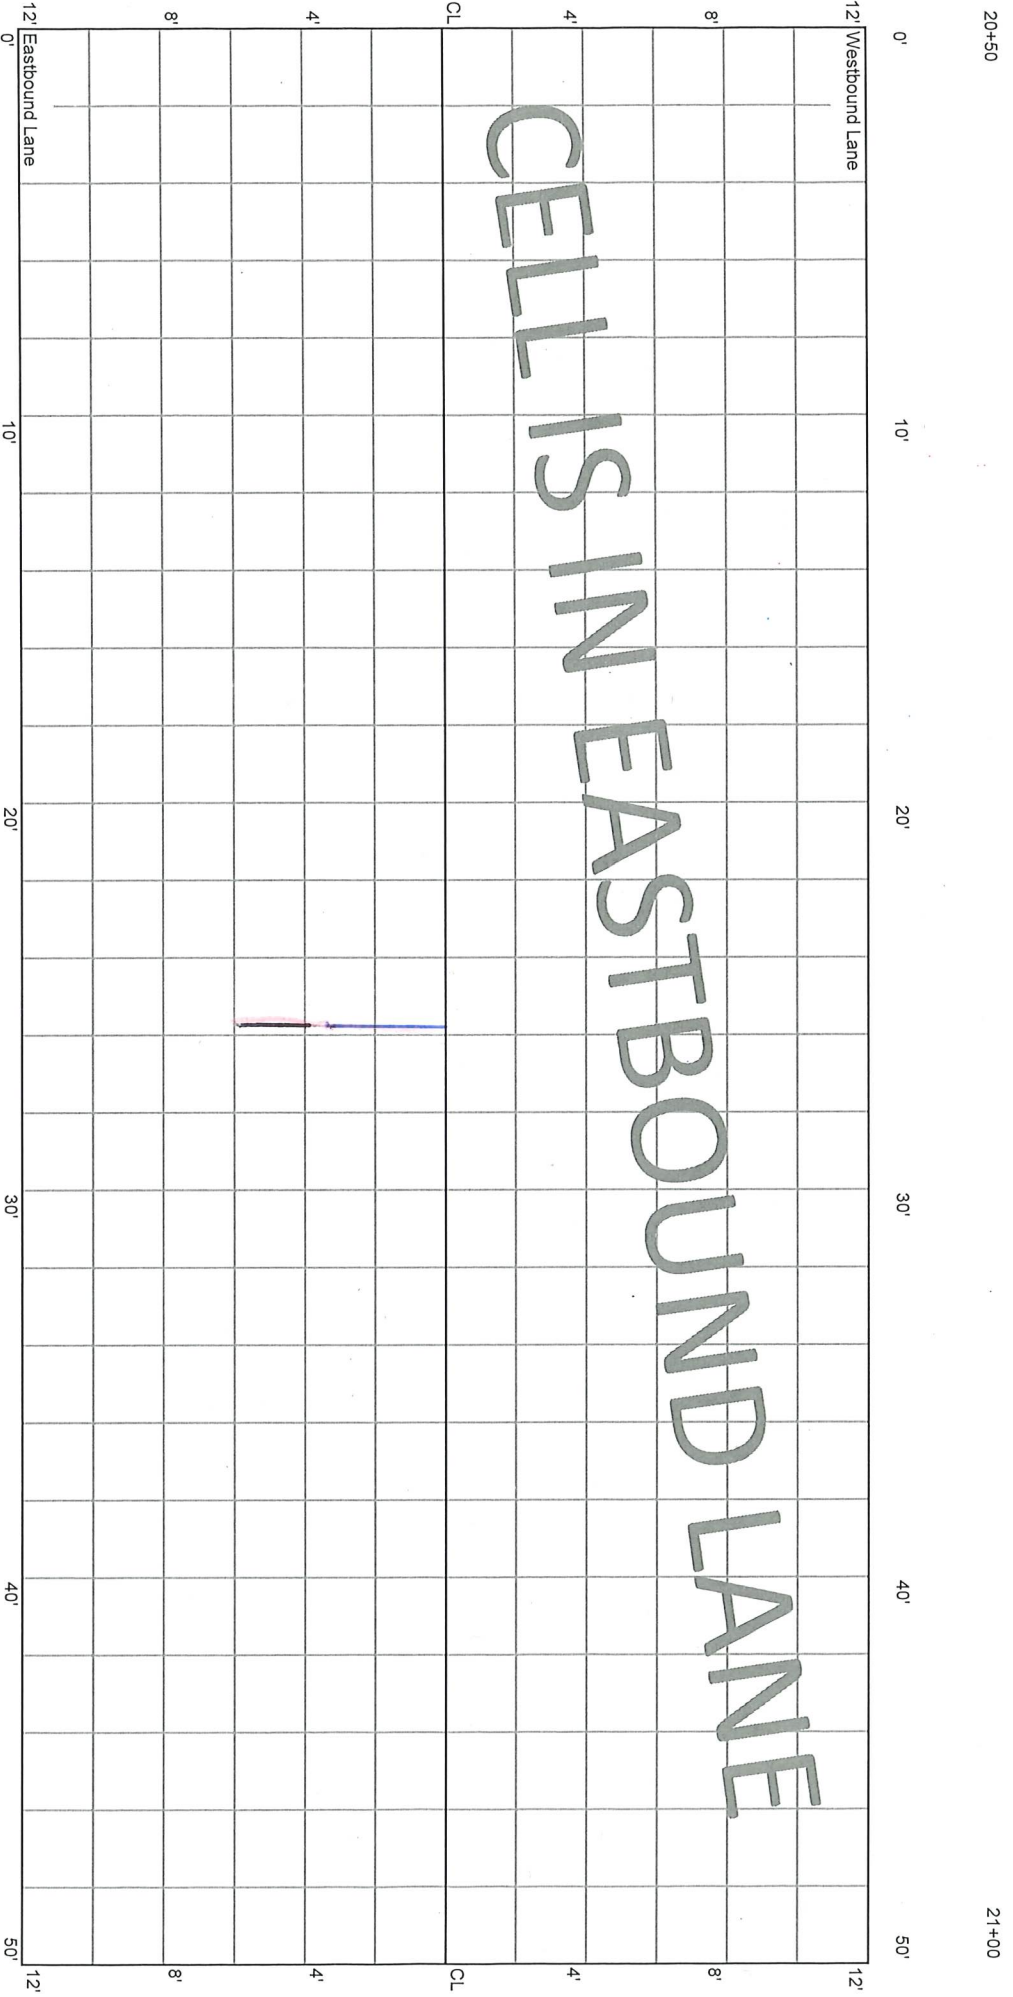

CELL 7004E
450 - 500 ft

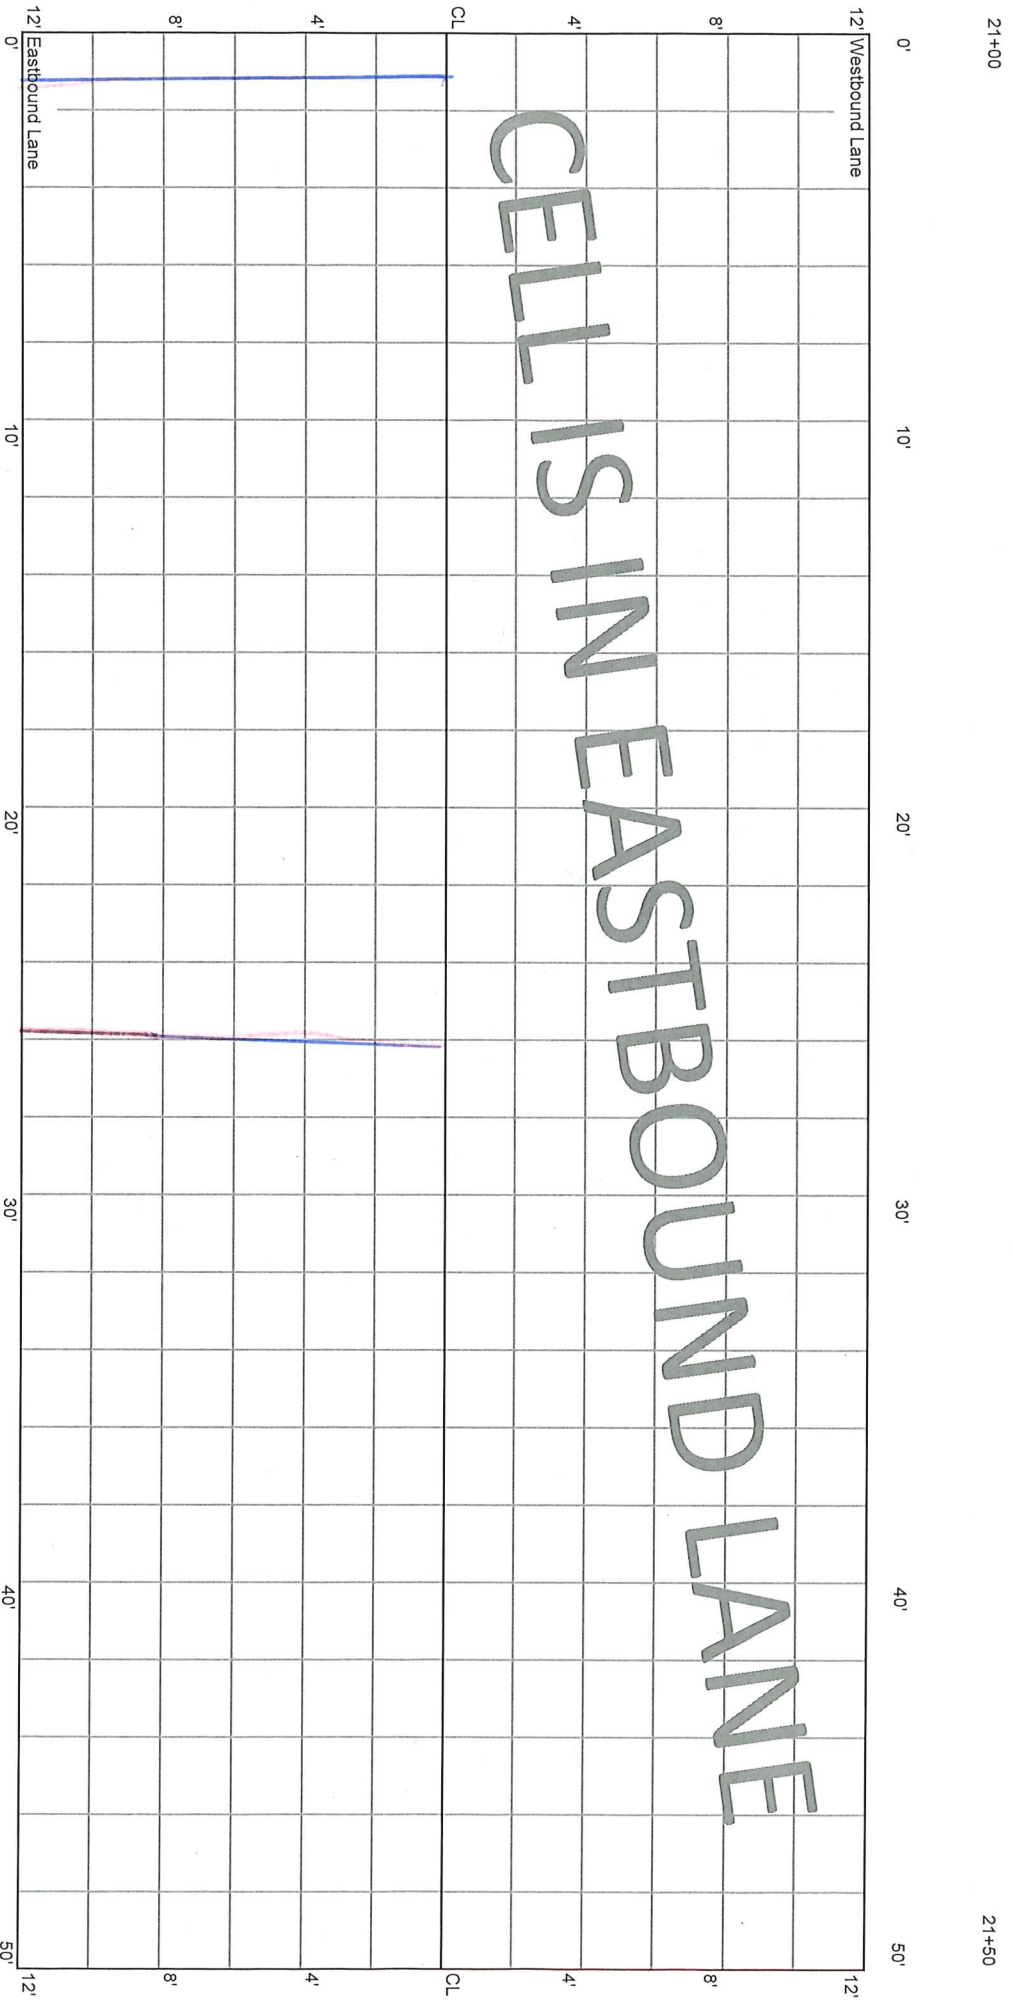

CELL 7004E
500 - 550 ft

21+50

16+25

22+00

12' Westbound Lane

0' 10' 20' 25' 30' 40' 50'

CELL IS IN EASTBOUND LANE

END RATING: BEGIN TRANSITION TO
NEXT CELL

(C: 08'20)
C0107