

5.28.20 E.J.

10.14.20 | 11/2/22  
114,21 | 8.31.22  
File 70TH ST  
8.25.21


CELL 7004E  
0 - 50 ft

8/25/21 ~ 80 Trans cracks  
outside of Fog line

16+50

17+00

Put outside of Fog line for 150'

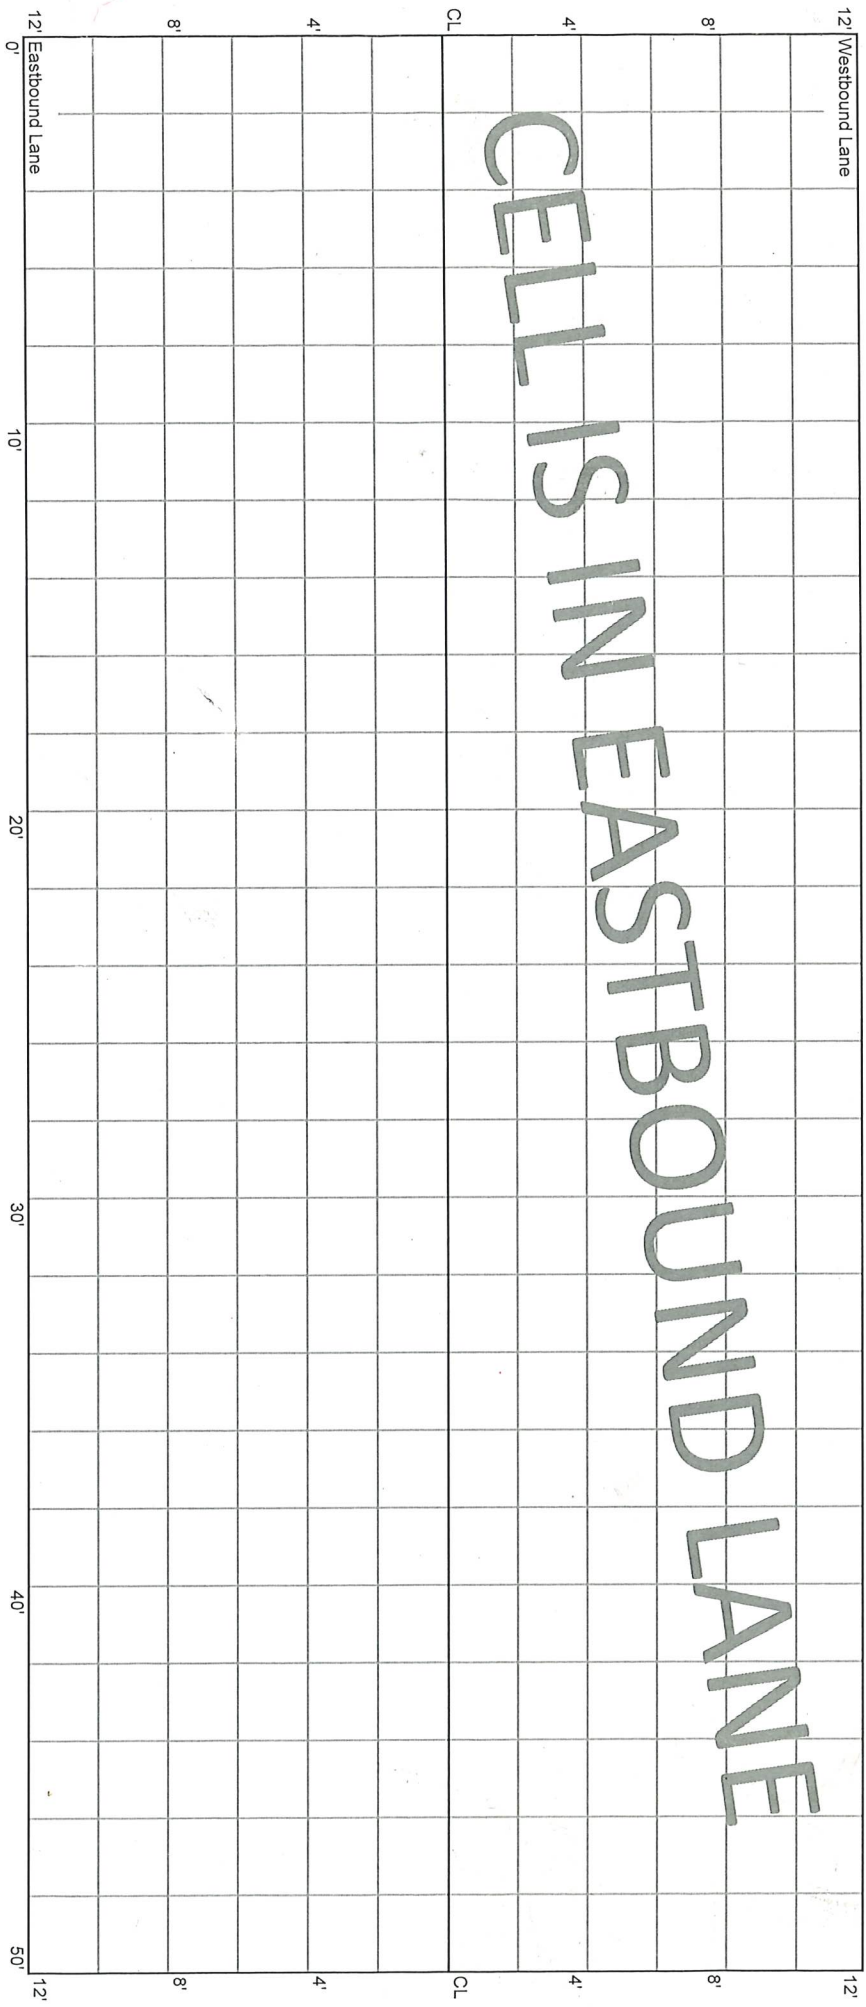


\* Rout & Seal

CELL 7004E  
50 - 100 ft

17+00


17+50

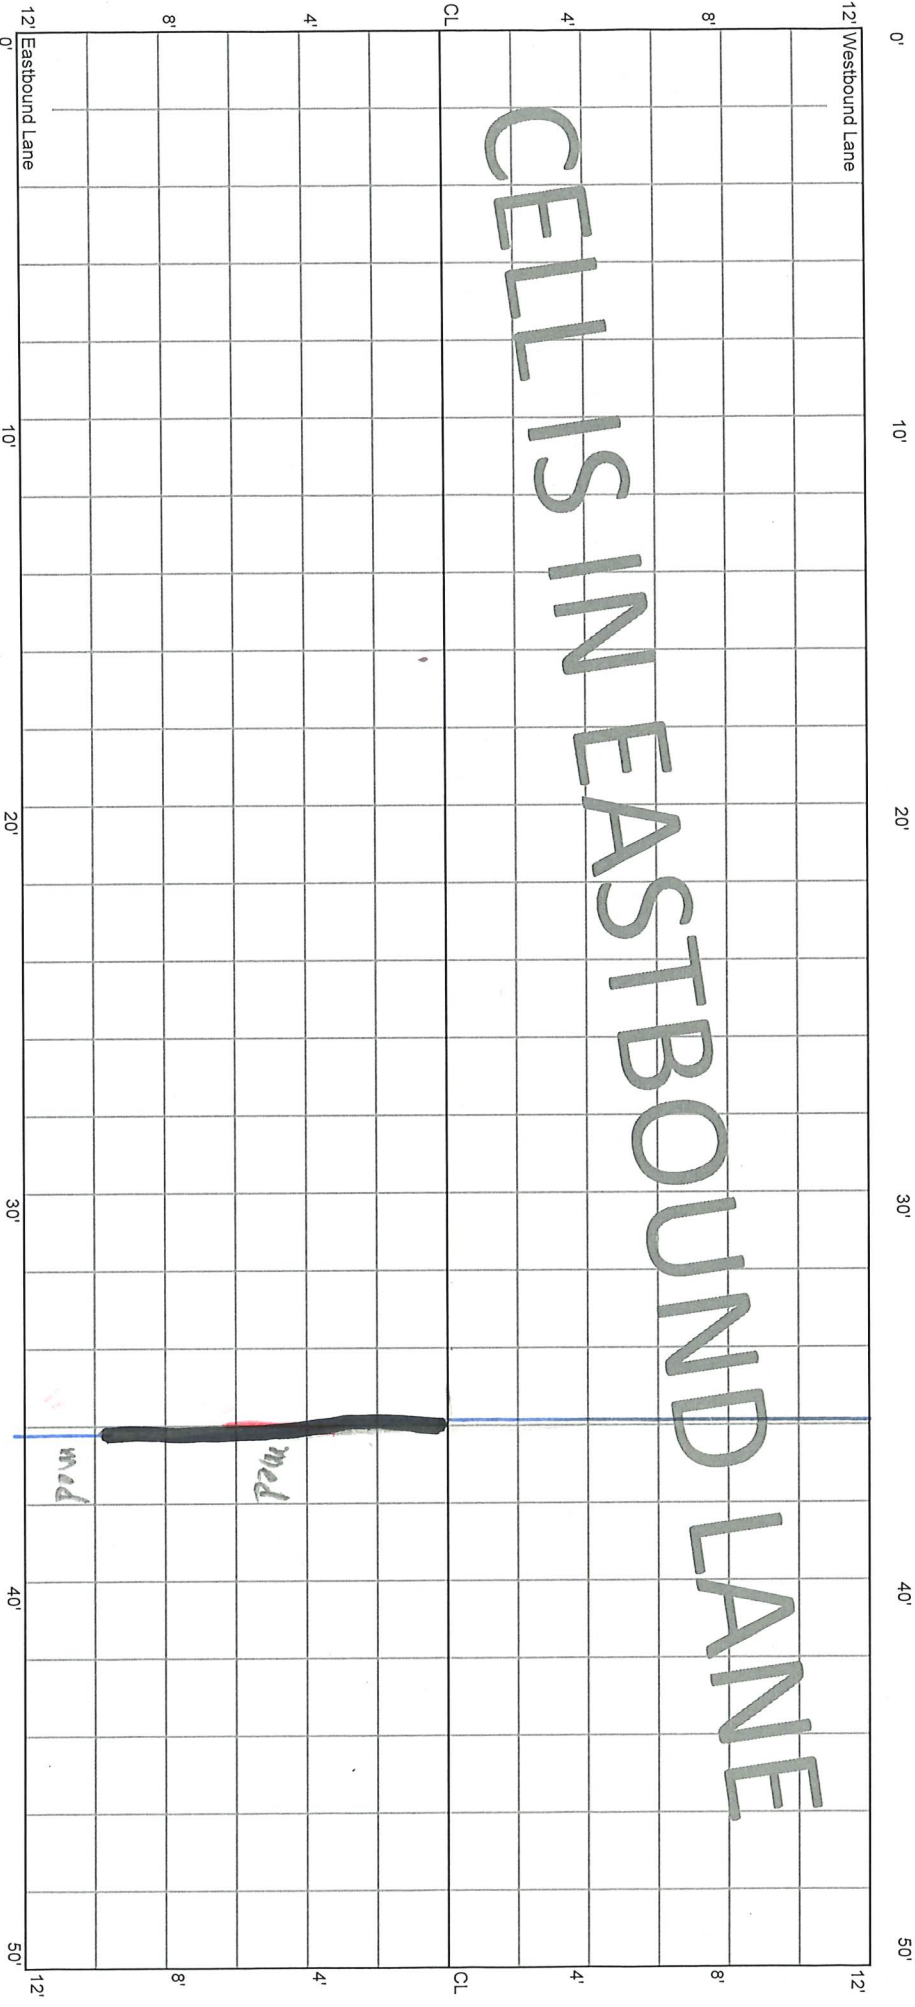

CELL IS IN EASTBOUND LANE

\* AFSP

CELL 7004E  
100 - 150 ft

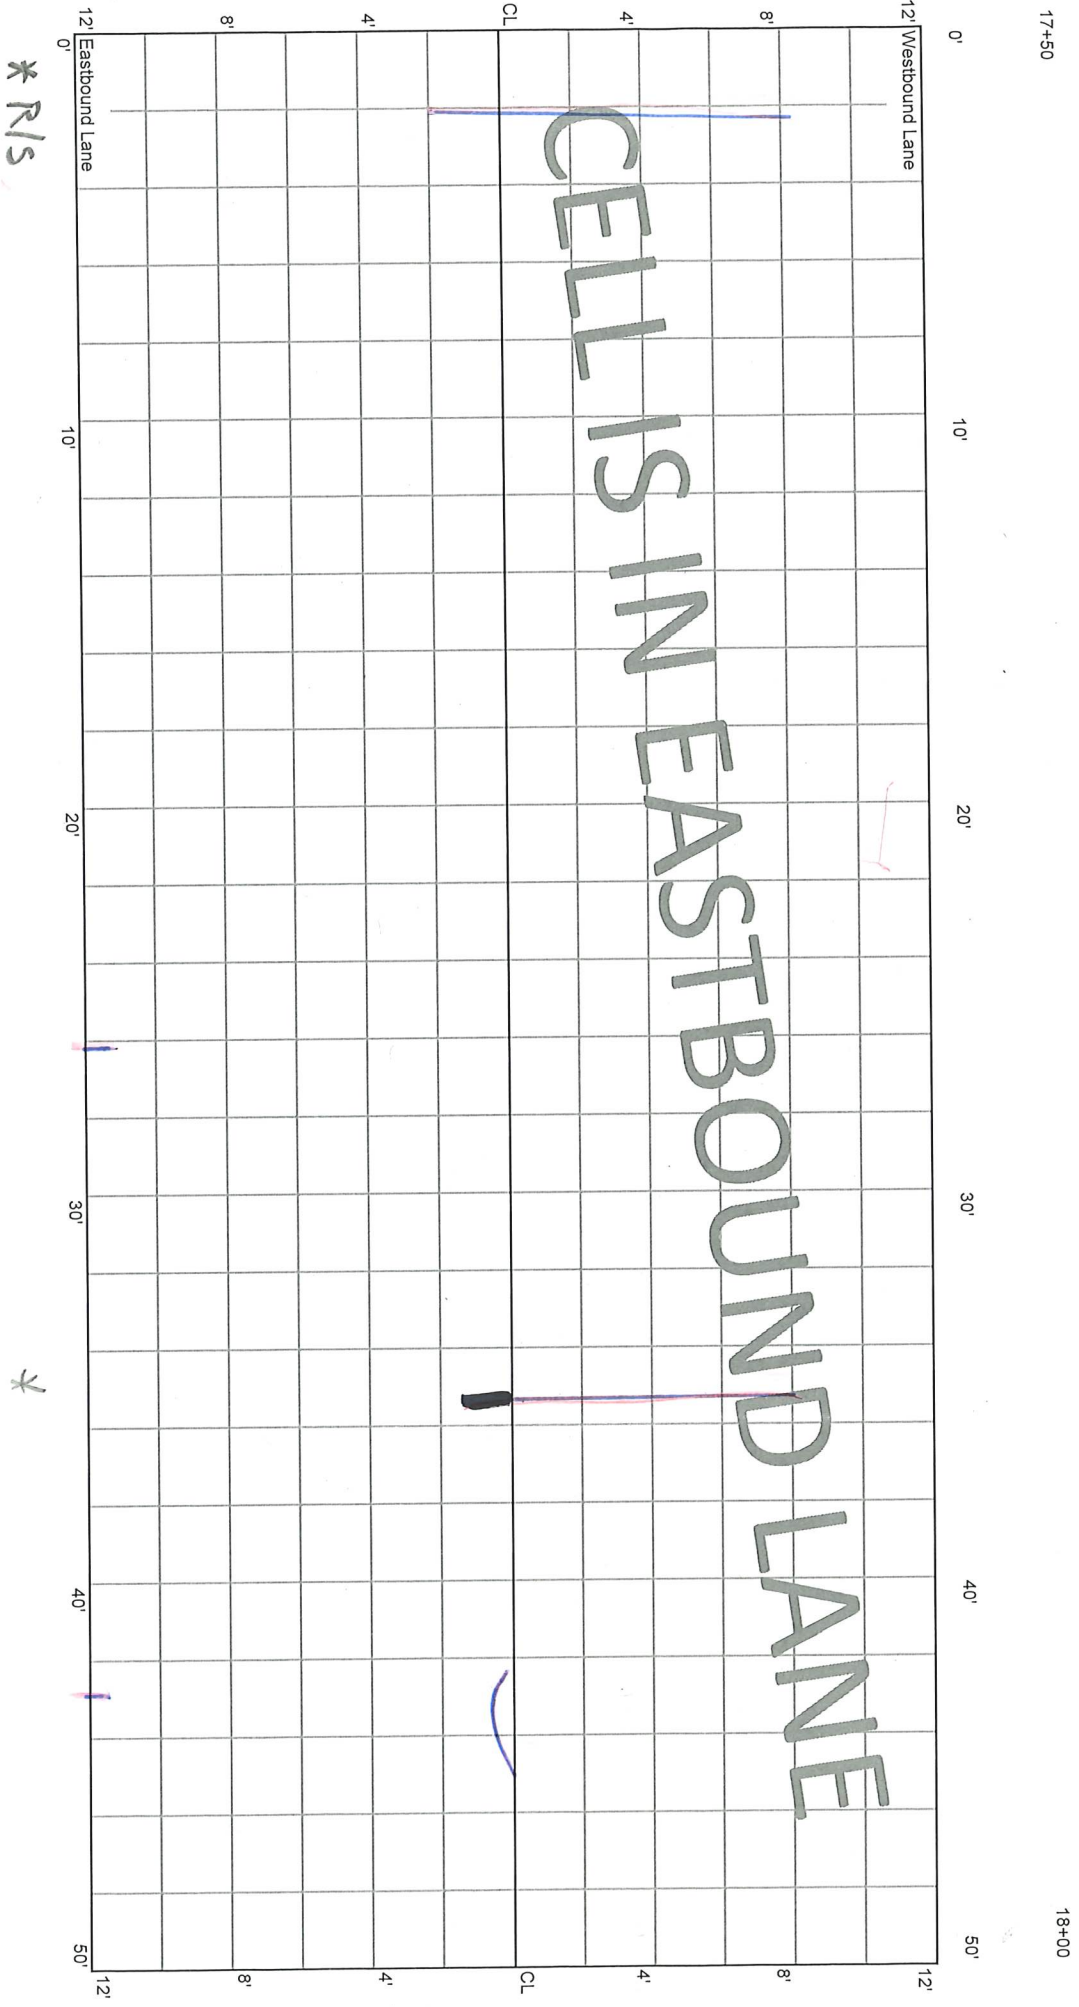

17+50

18+00

12' Westbound Lane

12' Eastbound Lane

CL

CL


\* R/S

\*

CELL 7004E  
150 - 200 ft

18+00

18+50

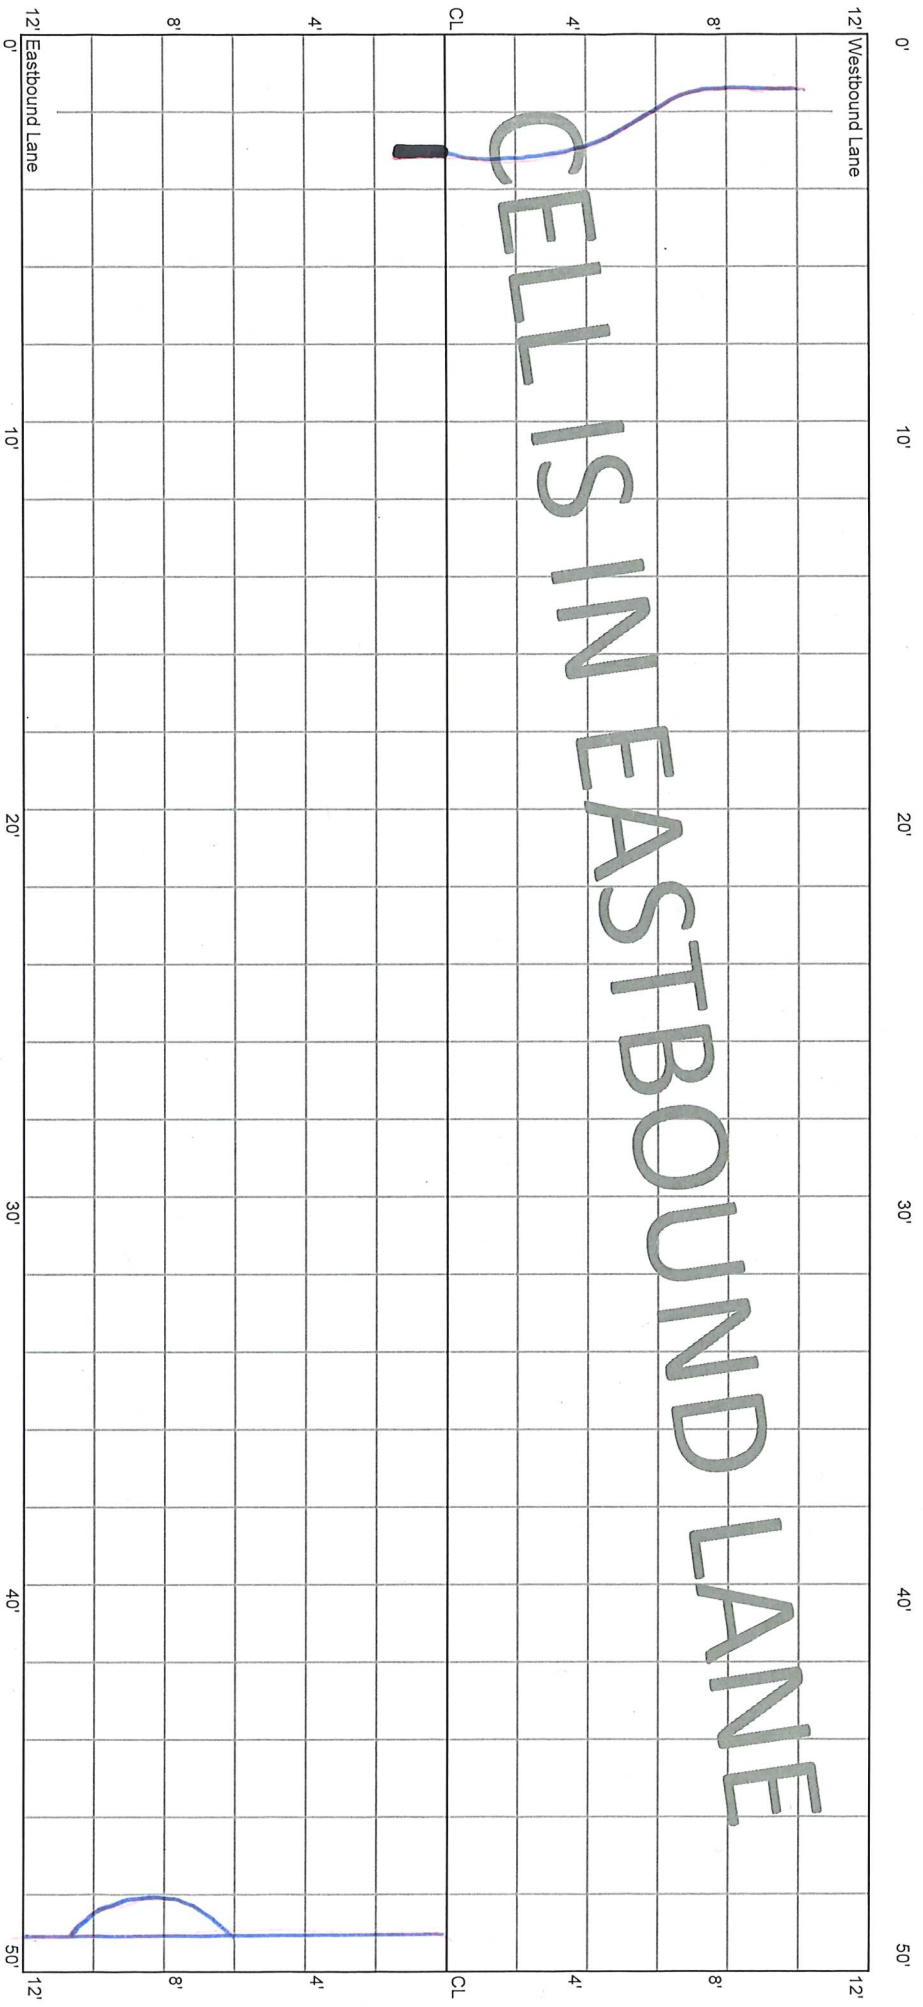


\*

M

CELL 7004E  
200 - 250 ft

18+50

19+00

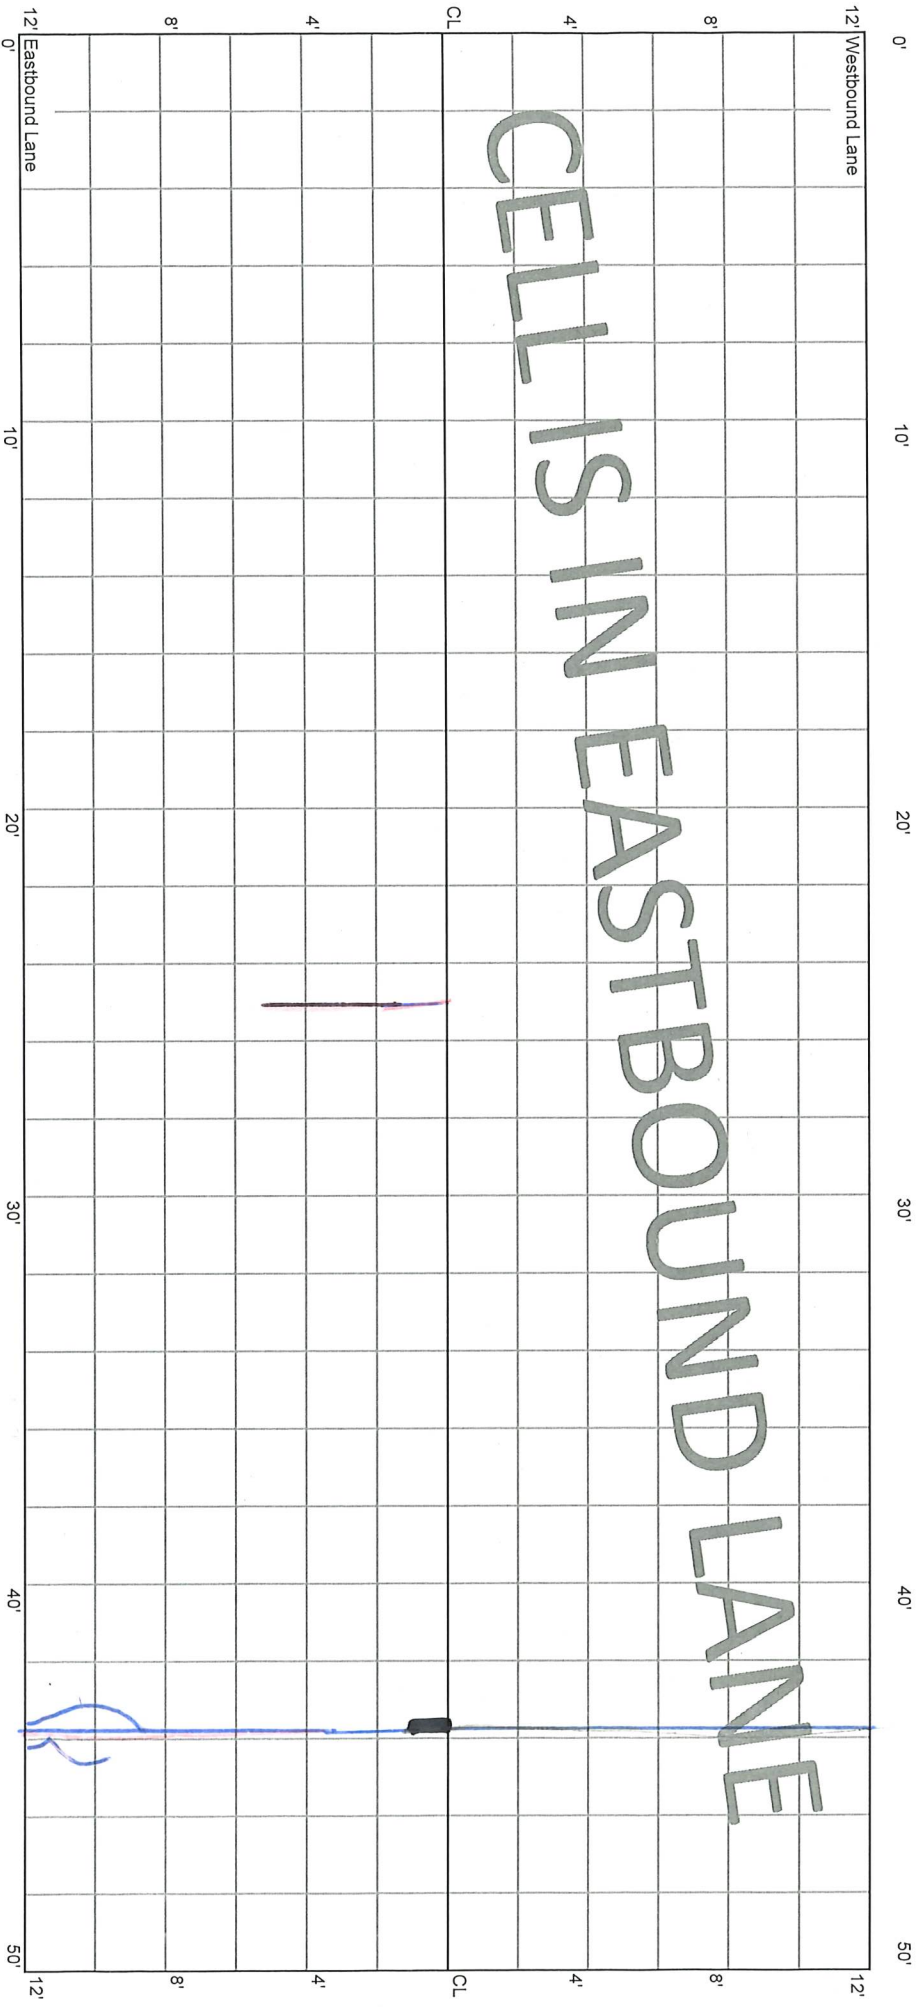


CELLS IN EASTBOUND LANE

\*

CELL 7004E  
250 - 300 ft

19+00

19+50

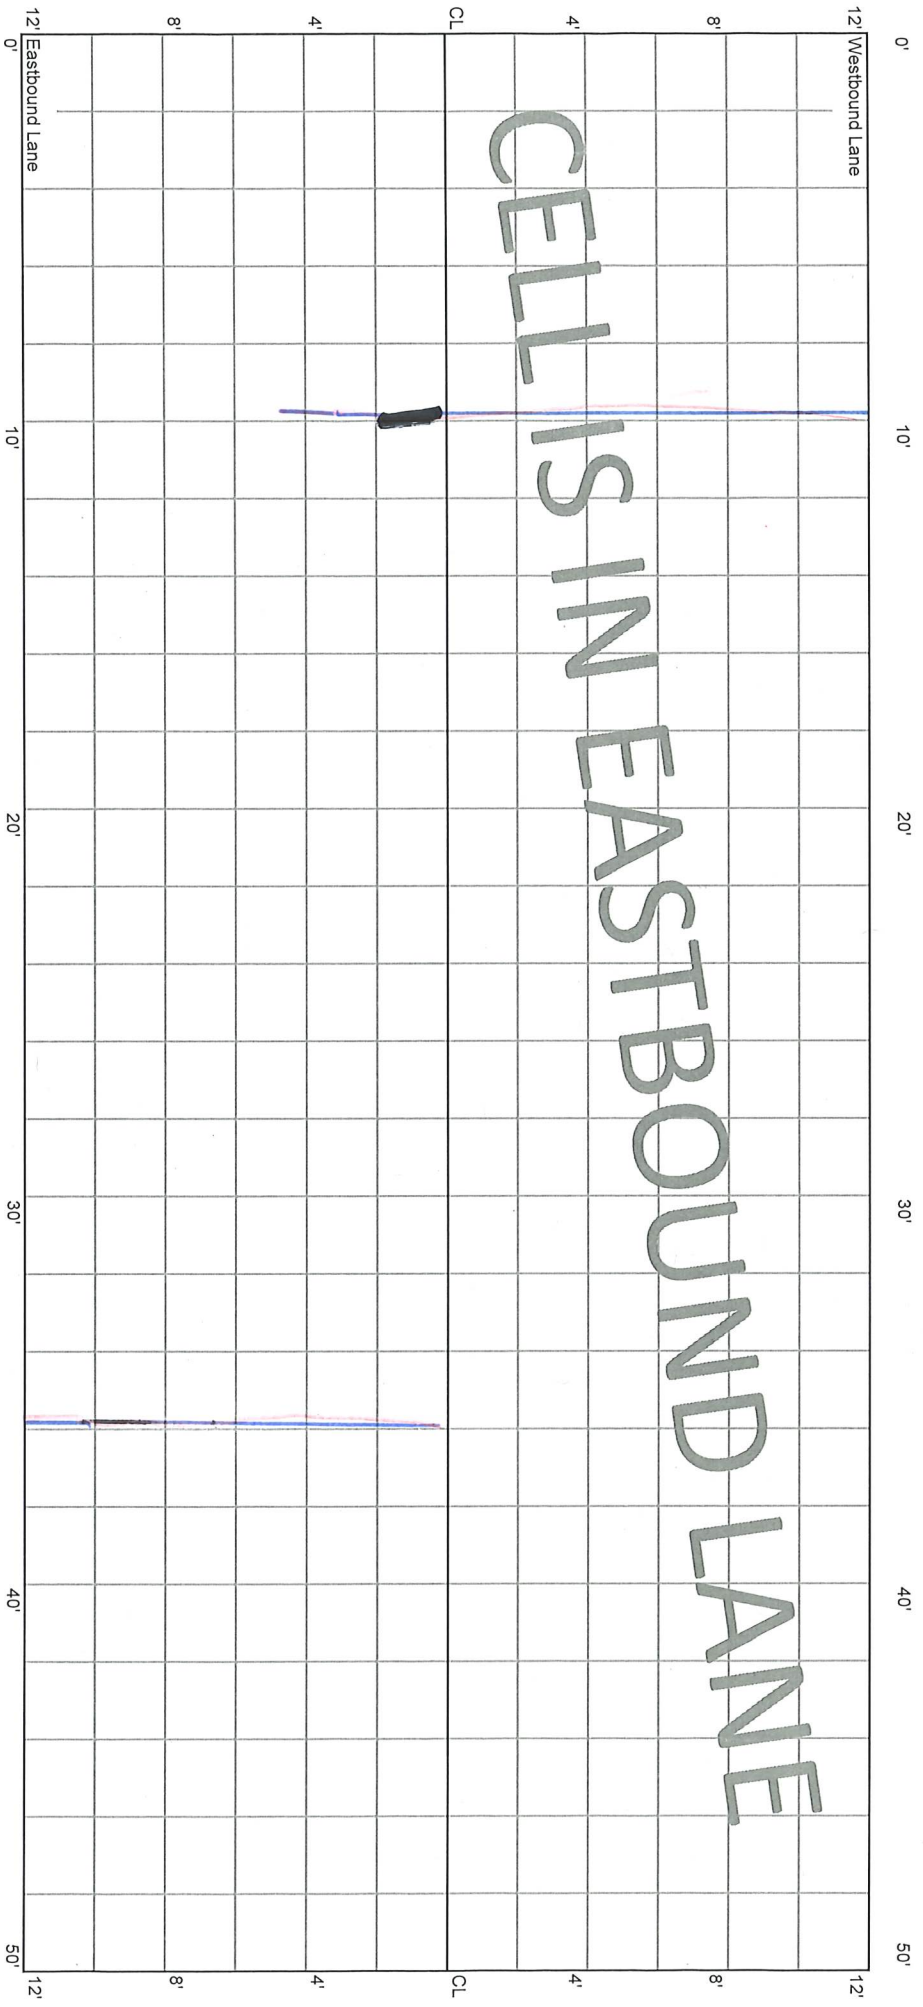

CELLS IN EASTBOUND LANE


\*

CELL 7004E  
300 - 350 ft

19+50

20+00

Put outside Fogline 300' to end

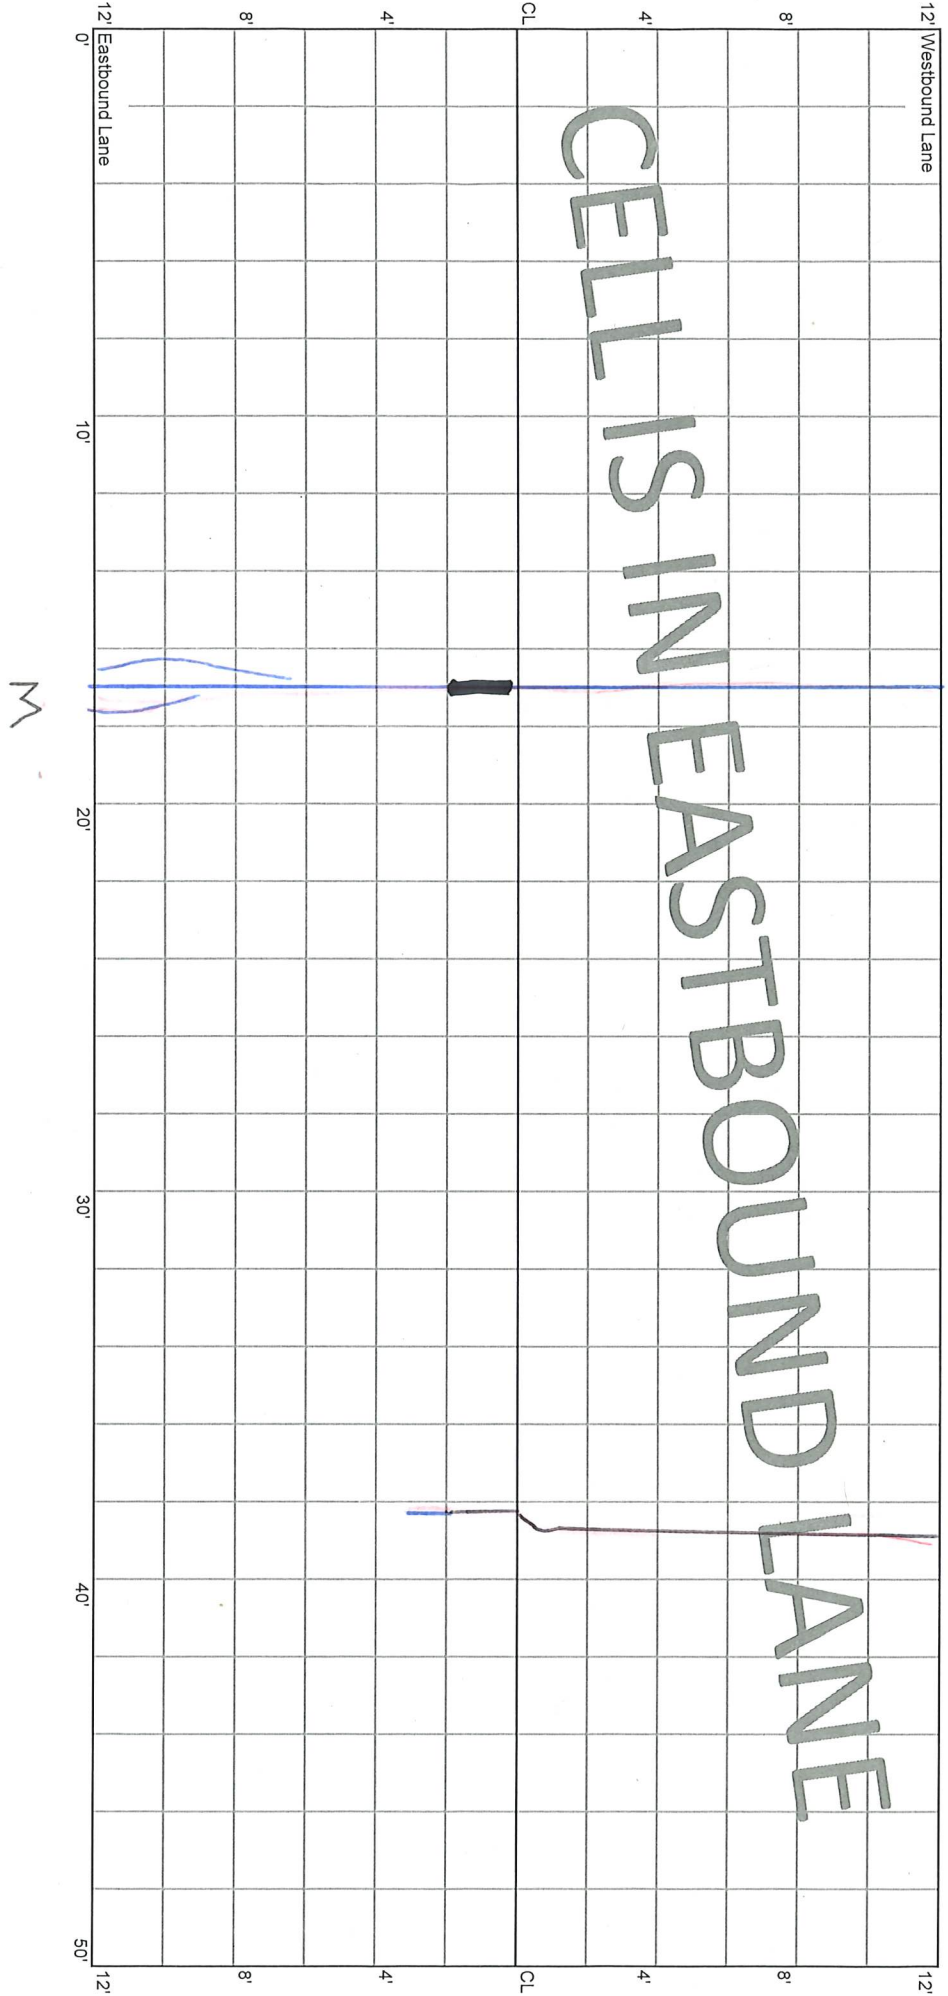

CELL IS IN EASTBOUND LANE

M

CELL 7004E  
350 - 400 ft

20+00

20+50

12' Westbound Lane

12'

0' 10' 20' 30' 40' 50'

CL

CL

4'

4'

8'

8'

8'

8'

4'

4'

0' Eastbound Lane

12'

CELL IS IN EASTBOUND LANE

|

|


\*  
M




CELL 7004E  
400 - 450 ft

20+50

21+00

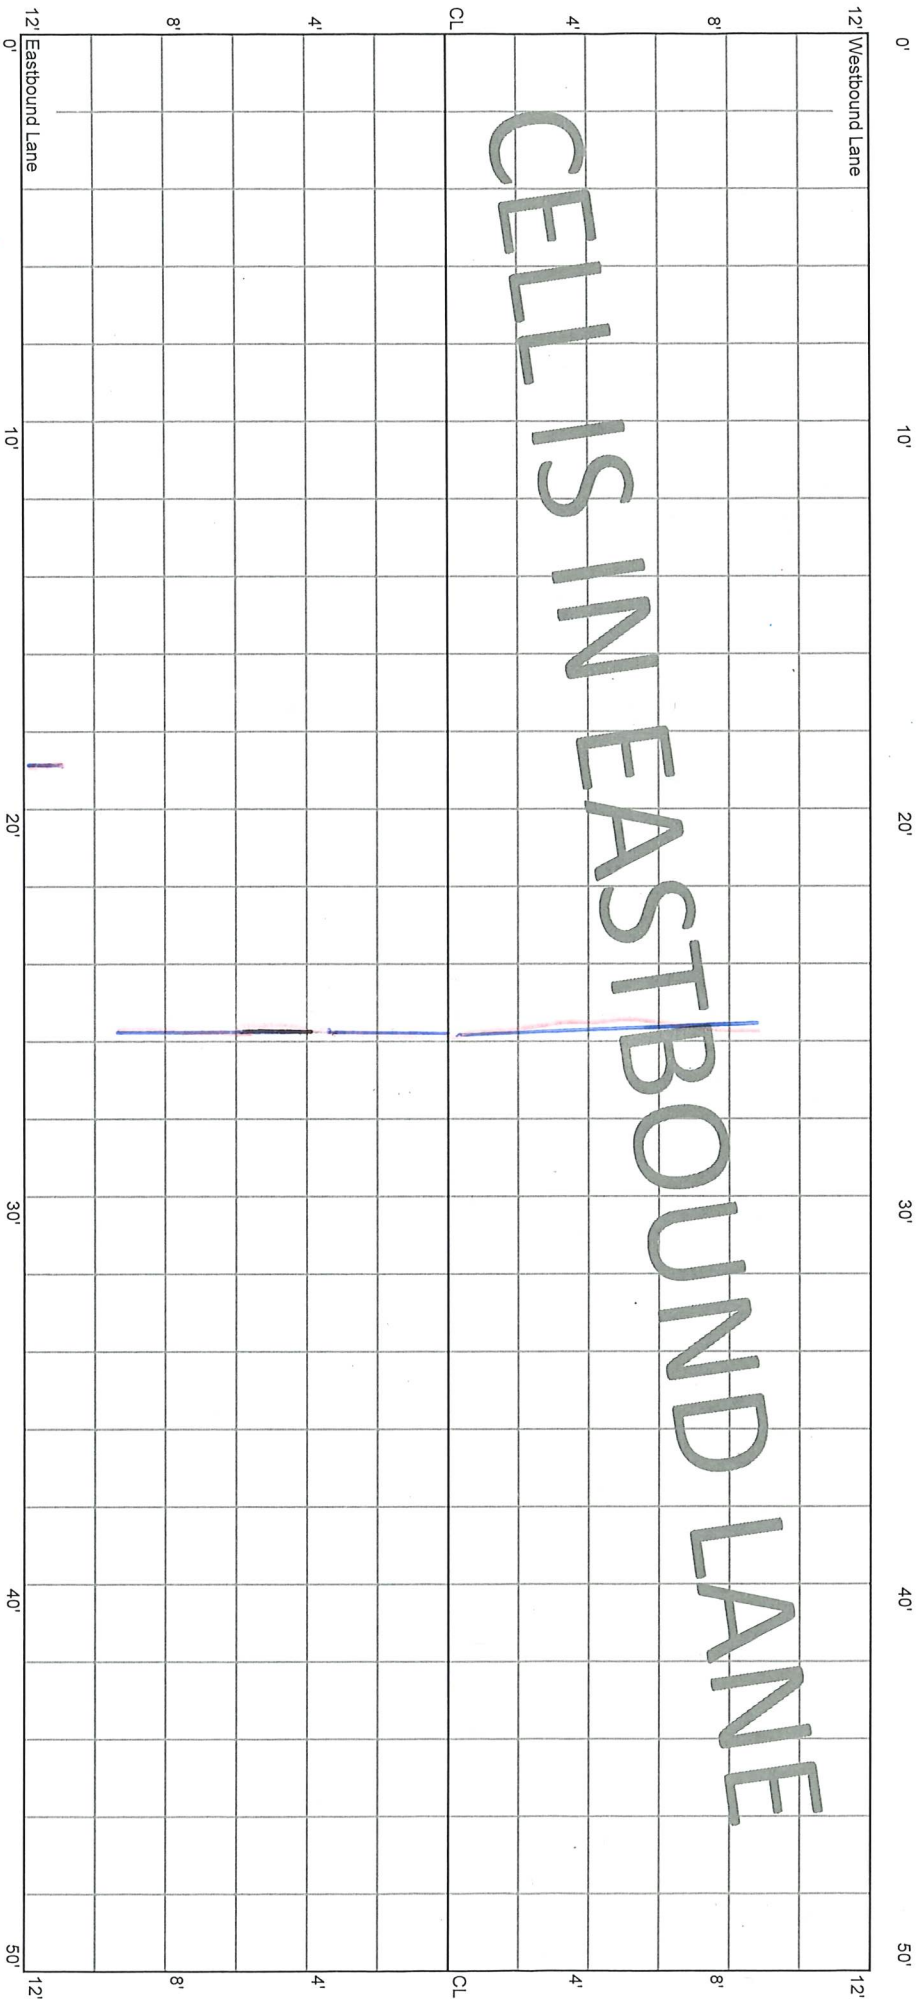

CELL 7004E  
450 - 500 ft

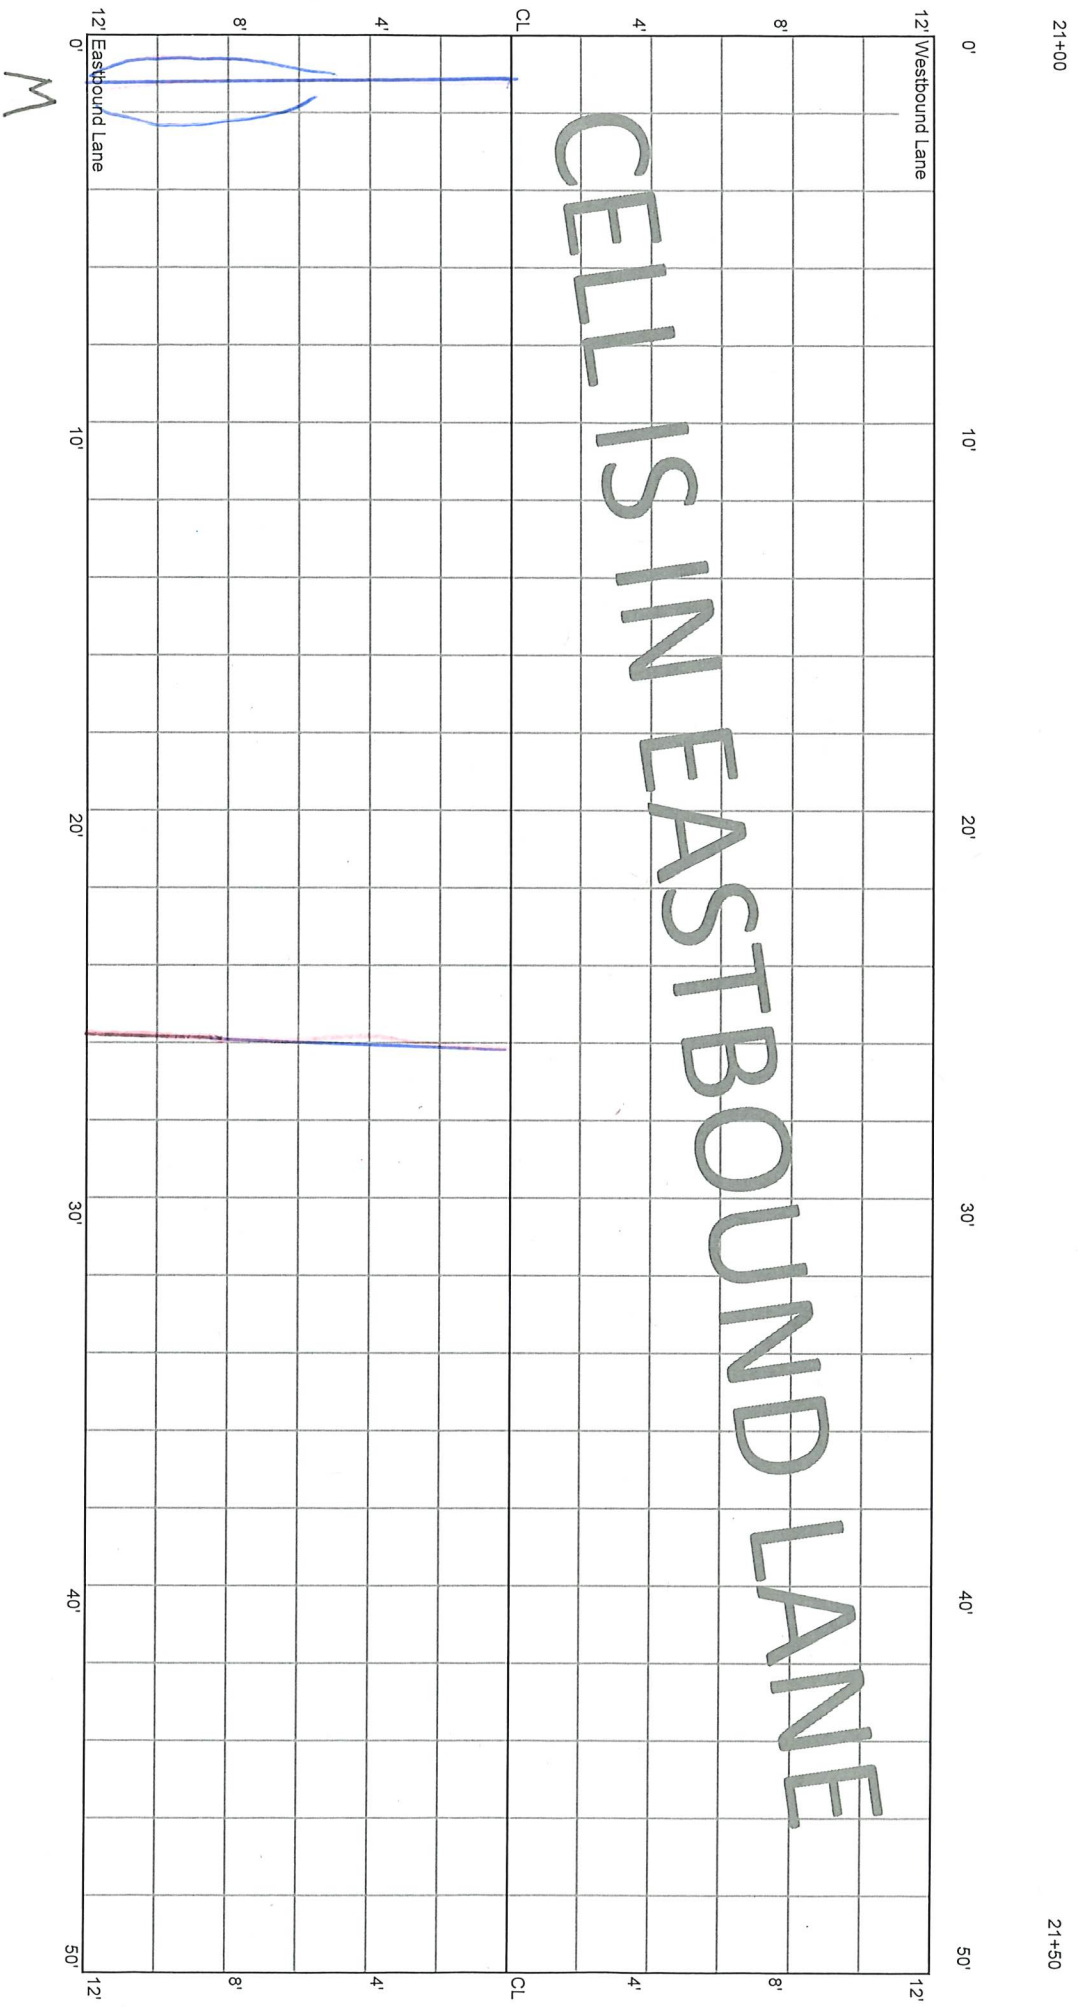


21+00

21+50

500-550

CELL 7004E  
500 - 550 ft

21+50 16+25 22+00

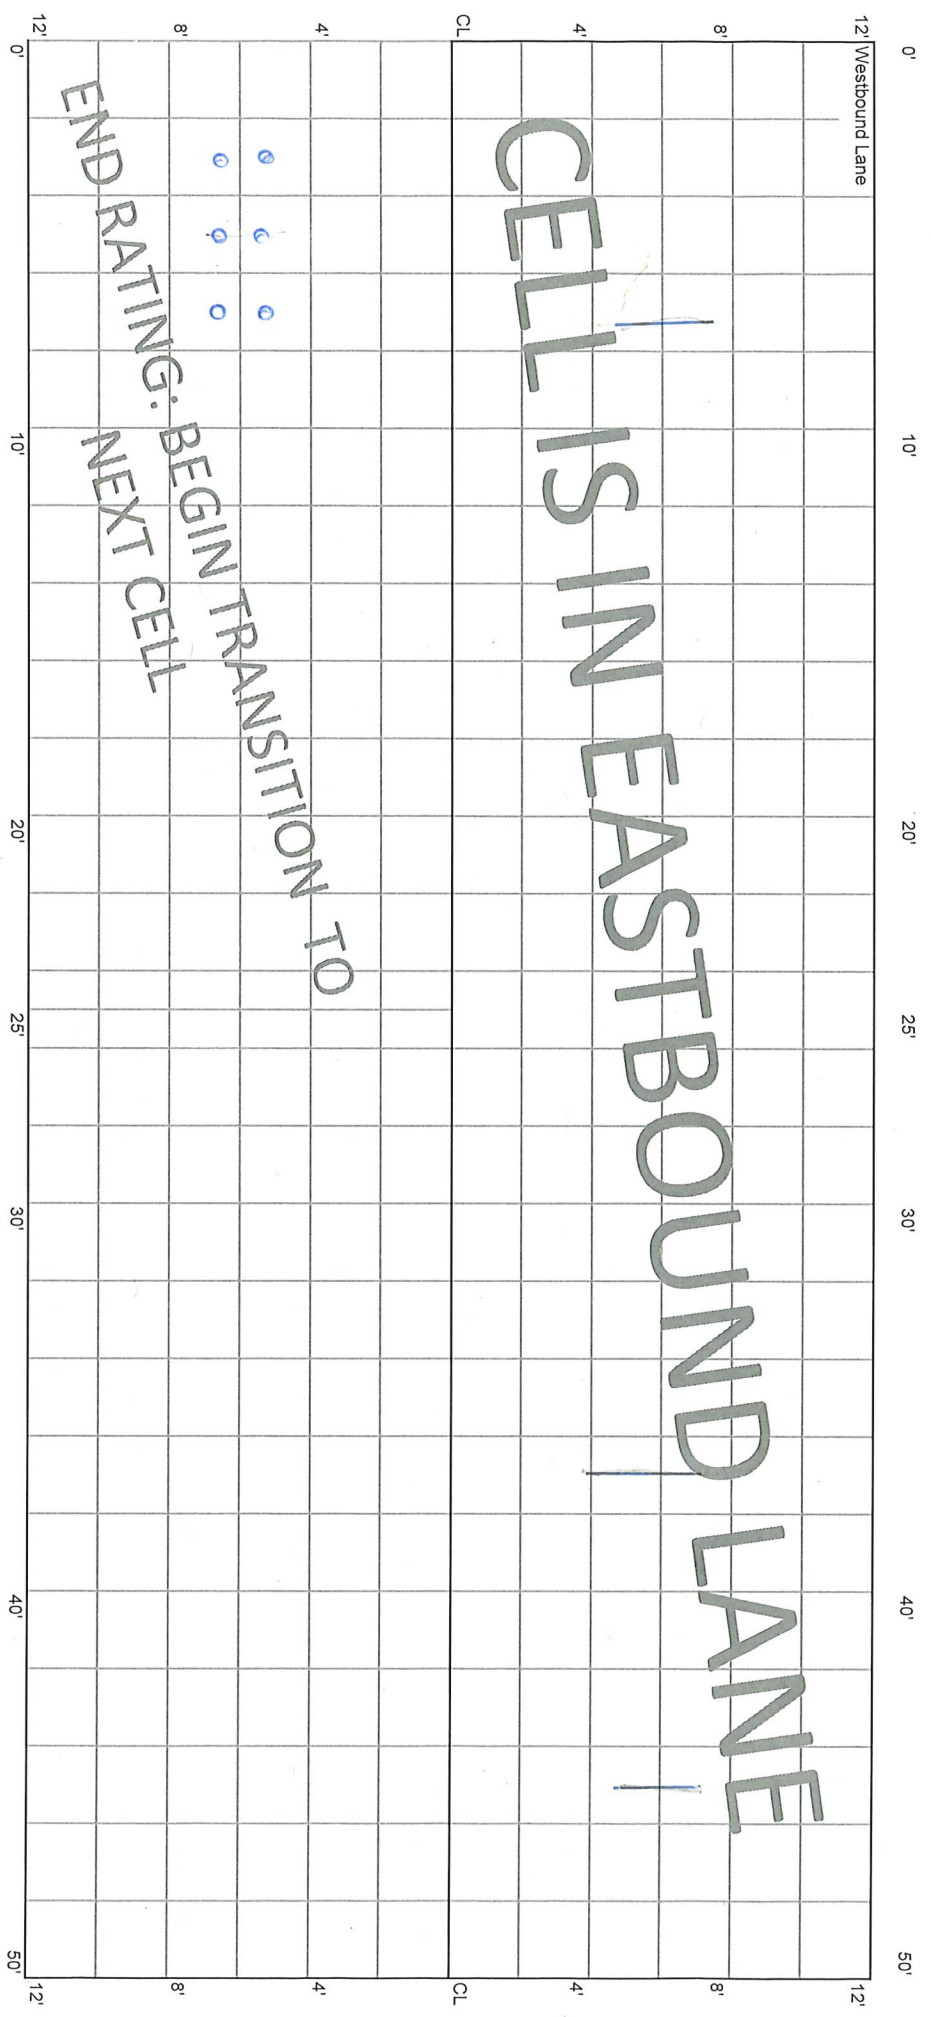

(C: Oct '20)  
C0107