


5.28.20 E.J.

10.14.20 11/2/22
11/4/21 8.31.22
File 70TH ST 1.20.23
8.25.21

CELL 7004E
0 - 50 ft

8/25/21 ~ 80 Trans cracks
outside of Fog line

Rut outside of Fog line for 150'

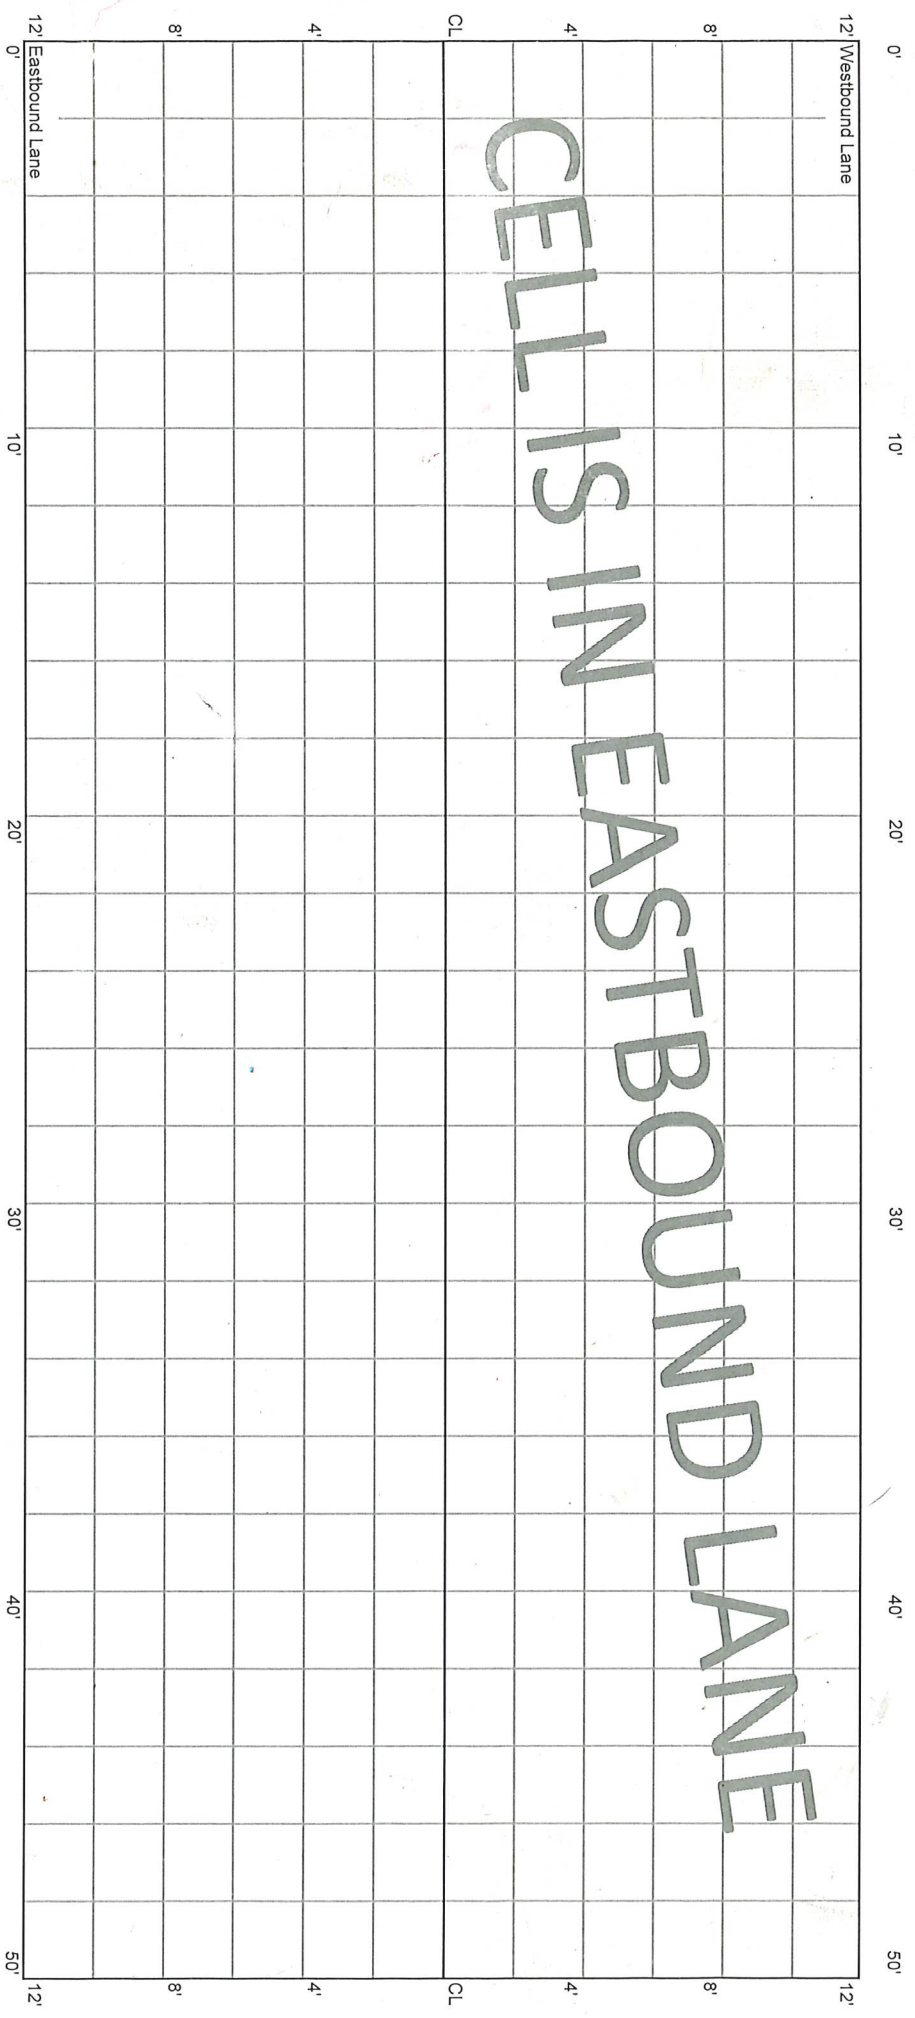

* Rout & Seal

16+50

17+00


5-2-11
C



CELL 7004E
50 - 100 ft

17+00

17+50

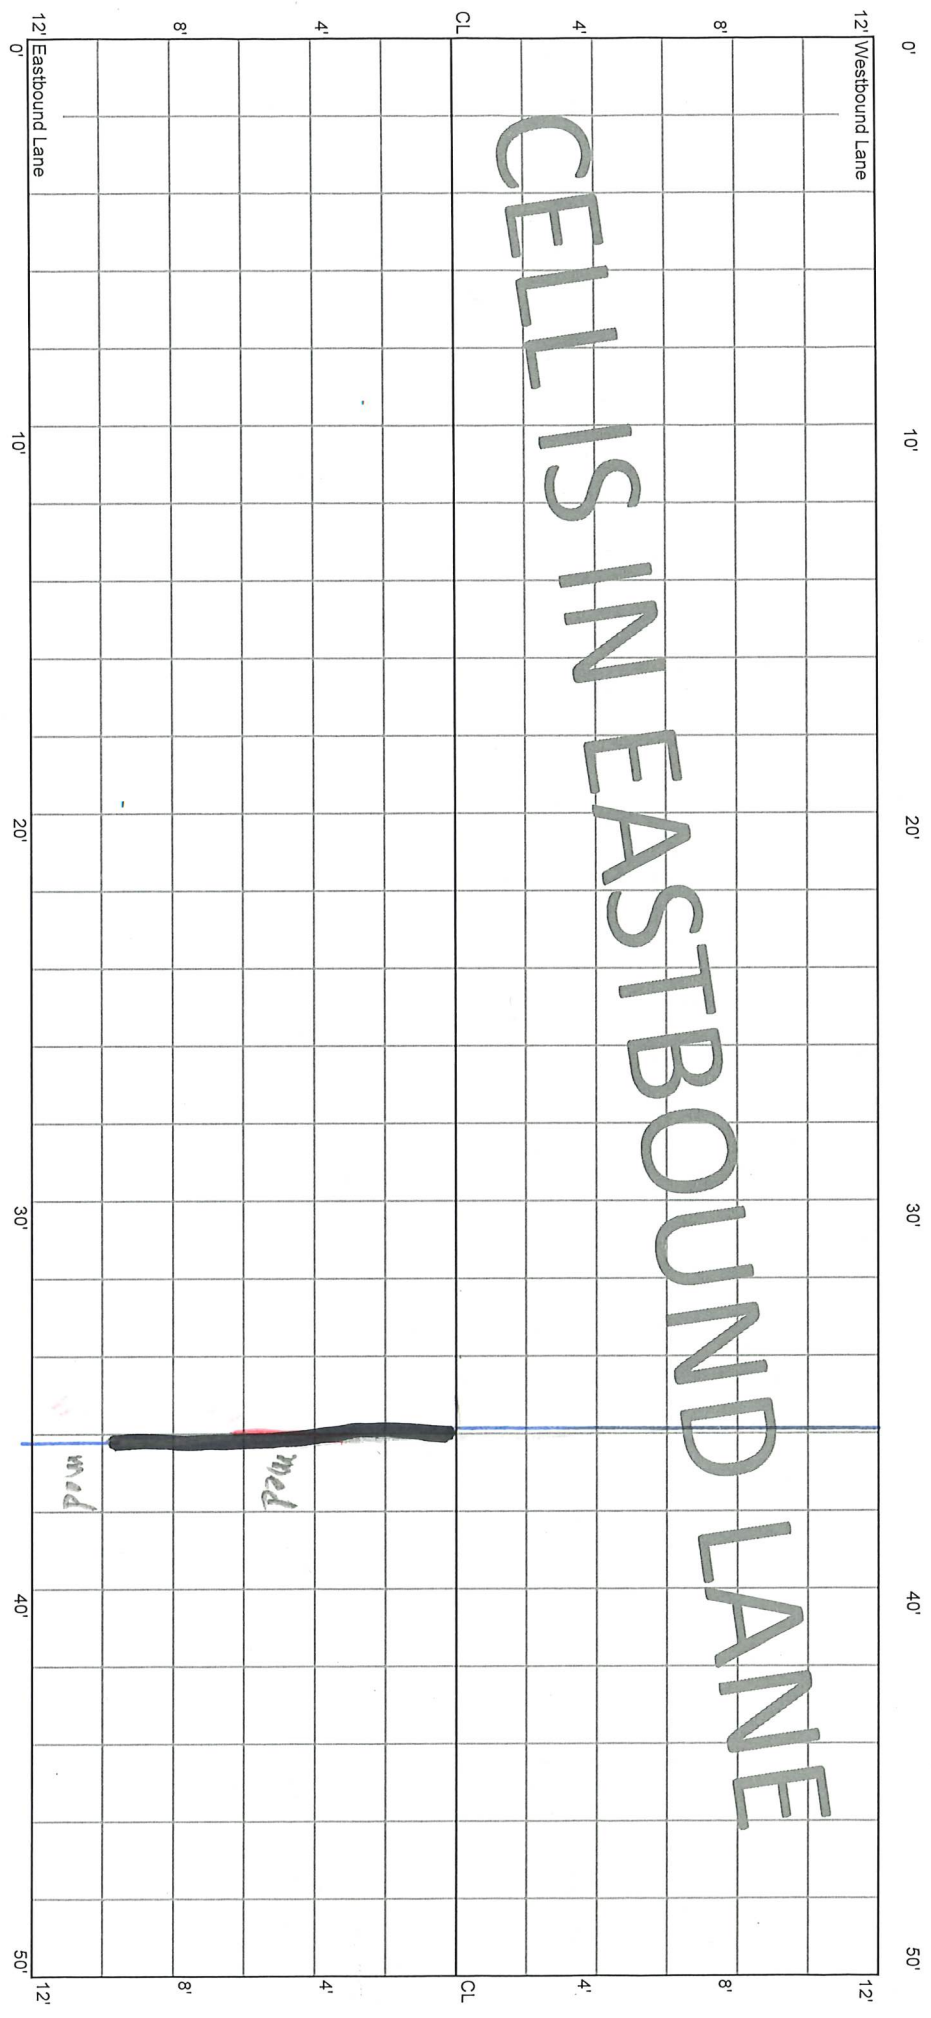


CELL IS IN EASTBOUND LANE

* AFSP

CELL 7004E
100 - 150 ft

17+50


18+00

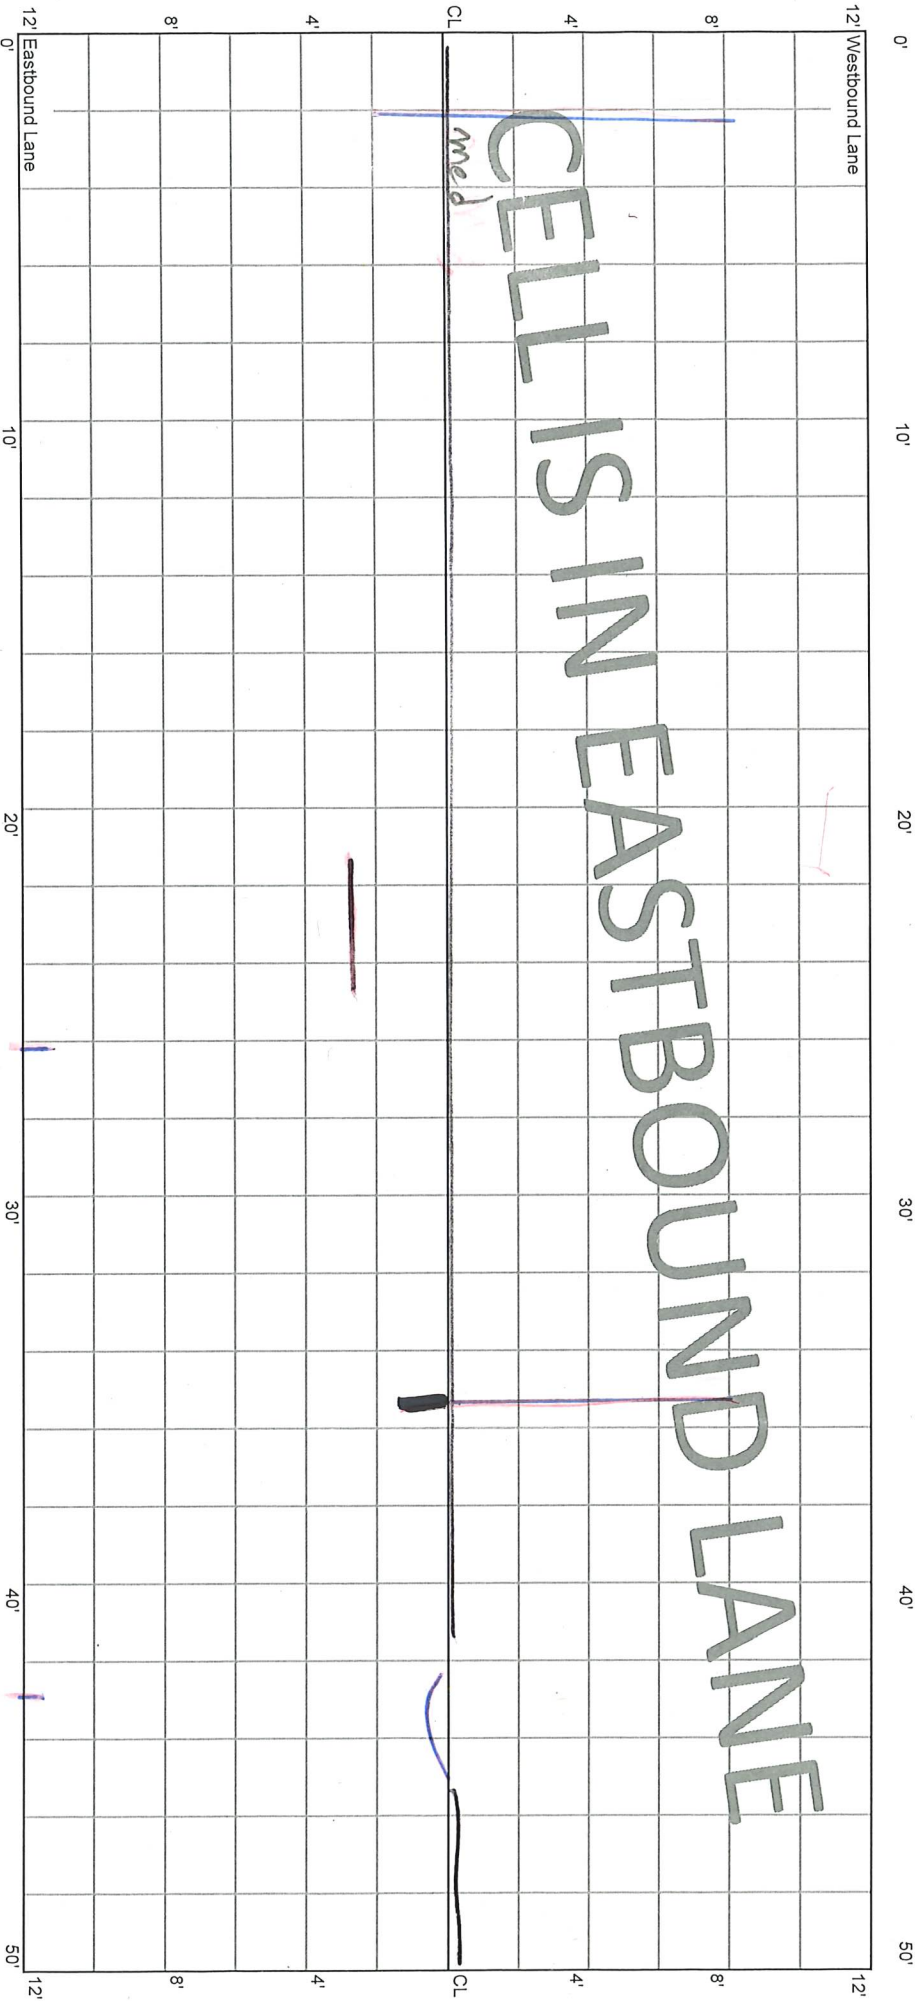

*R/S

*


CELL 7004E
150 - 200 ft

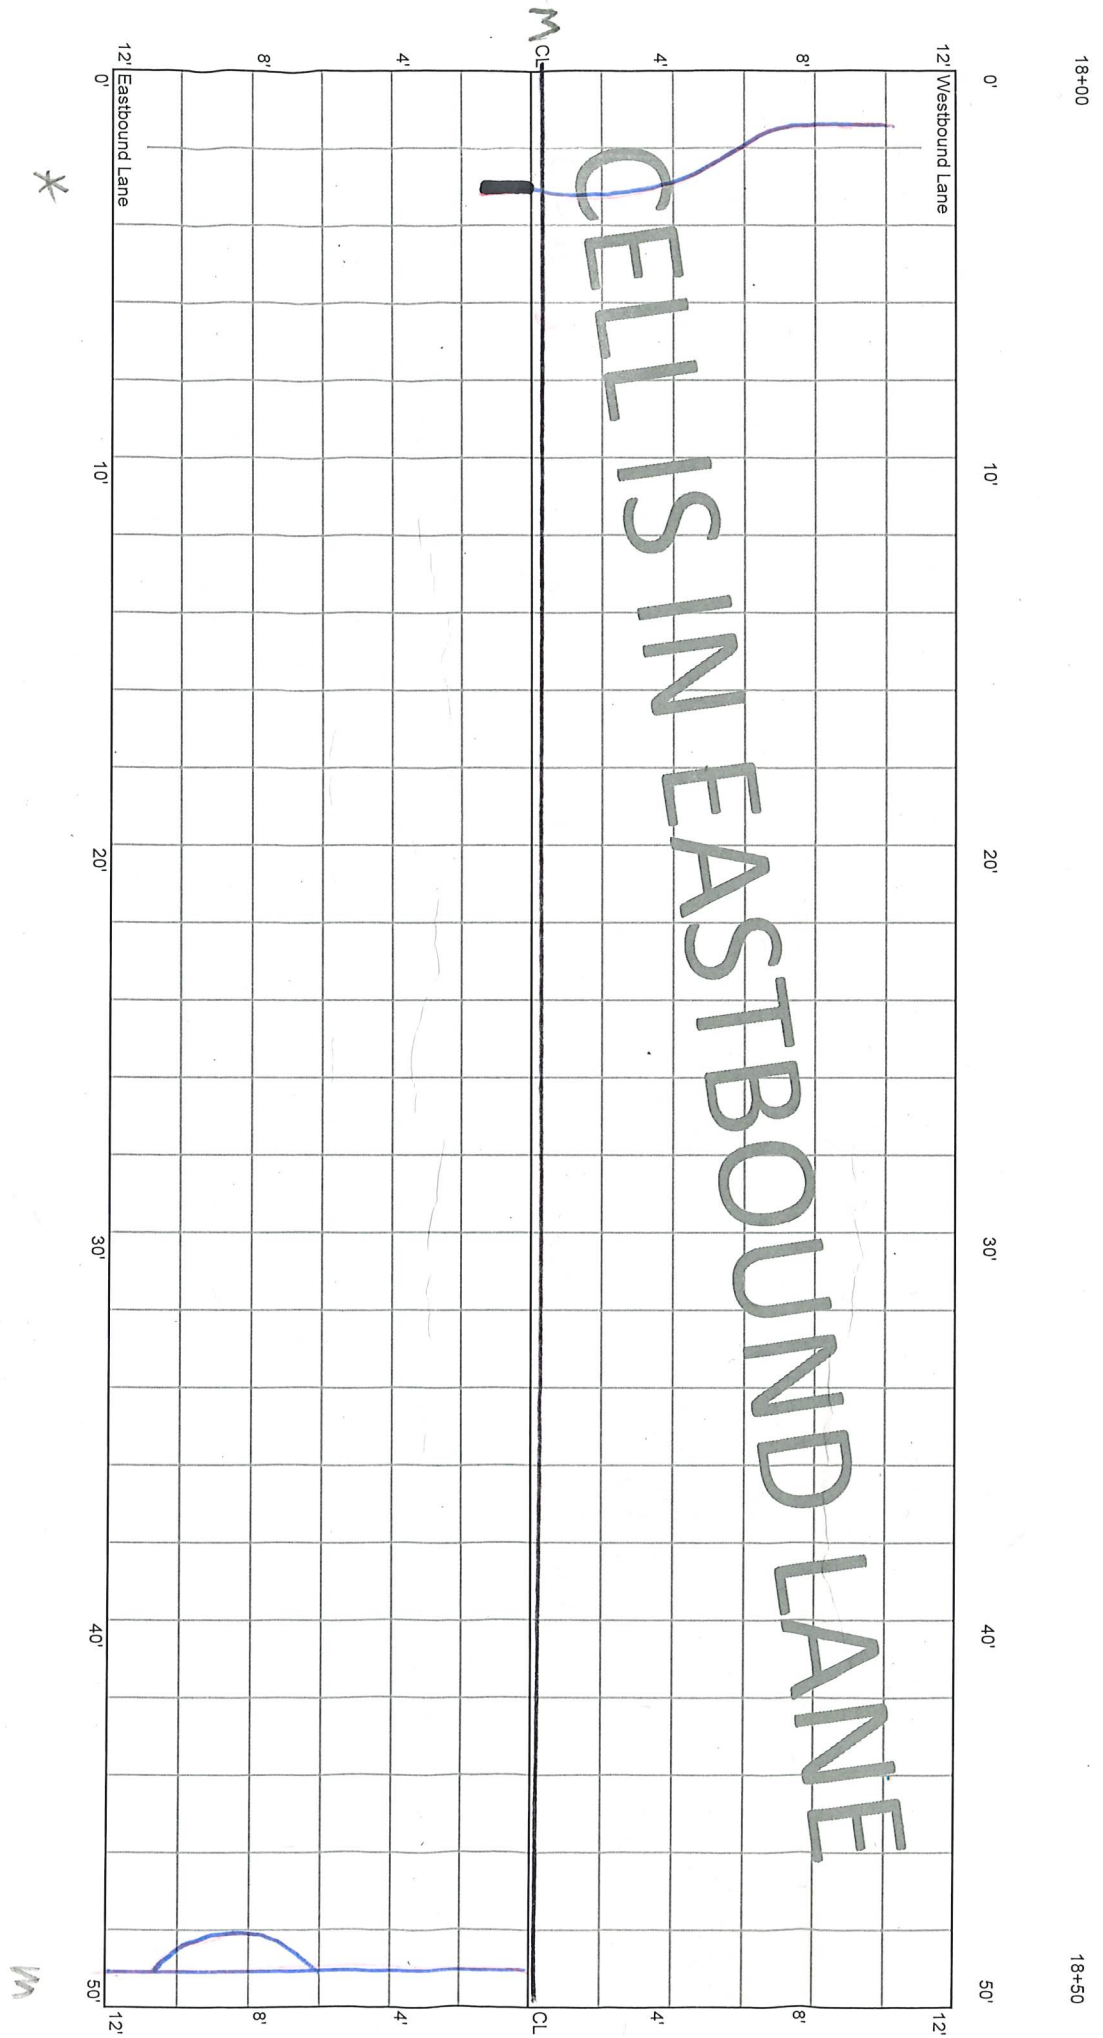

CELL 7004E
200 - 250 ft

18+50

19+00

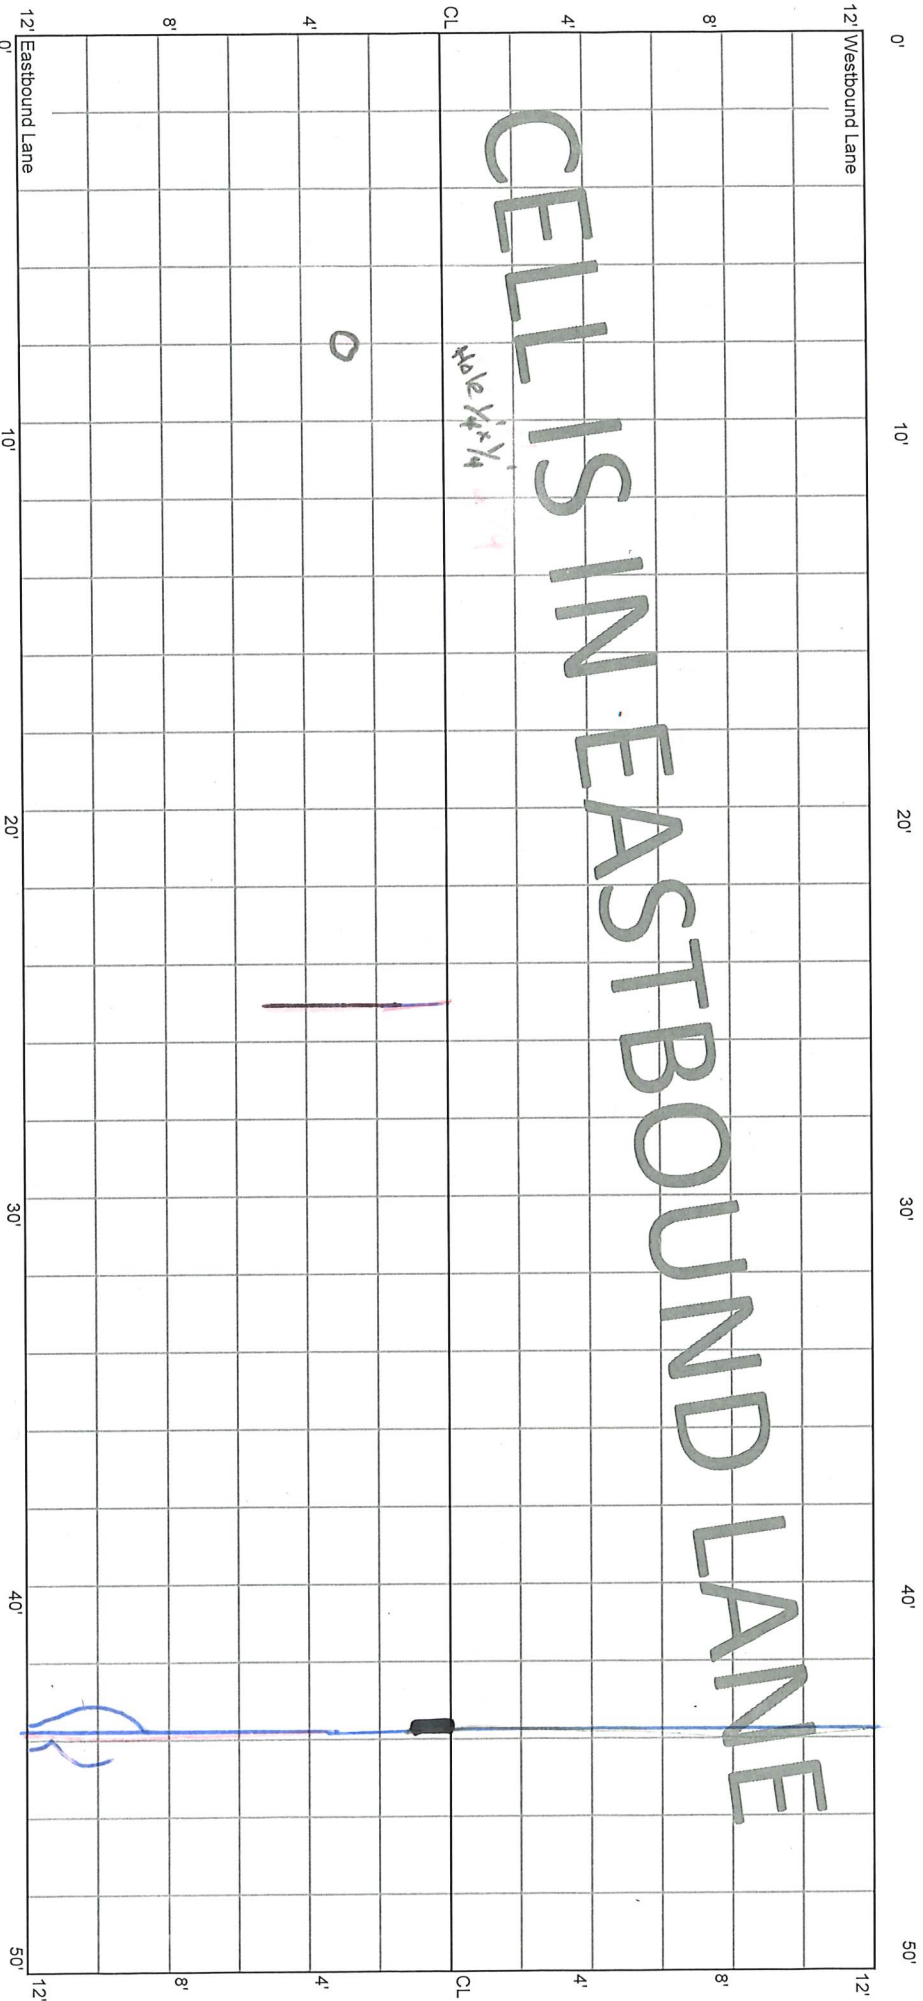


*
M

CELL 7004E
250 - 300 ft

19+00

19+50

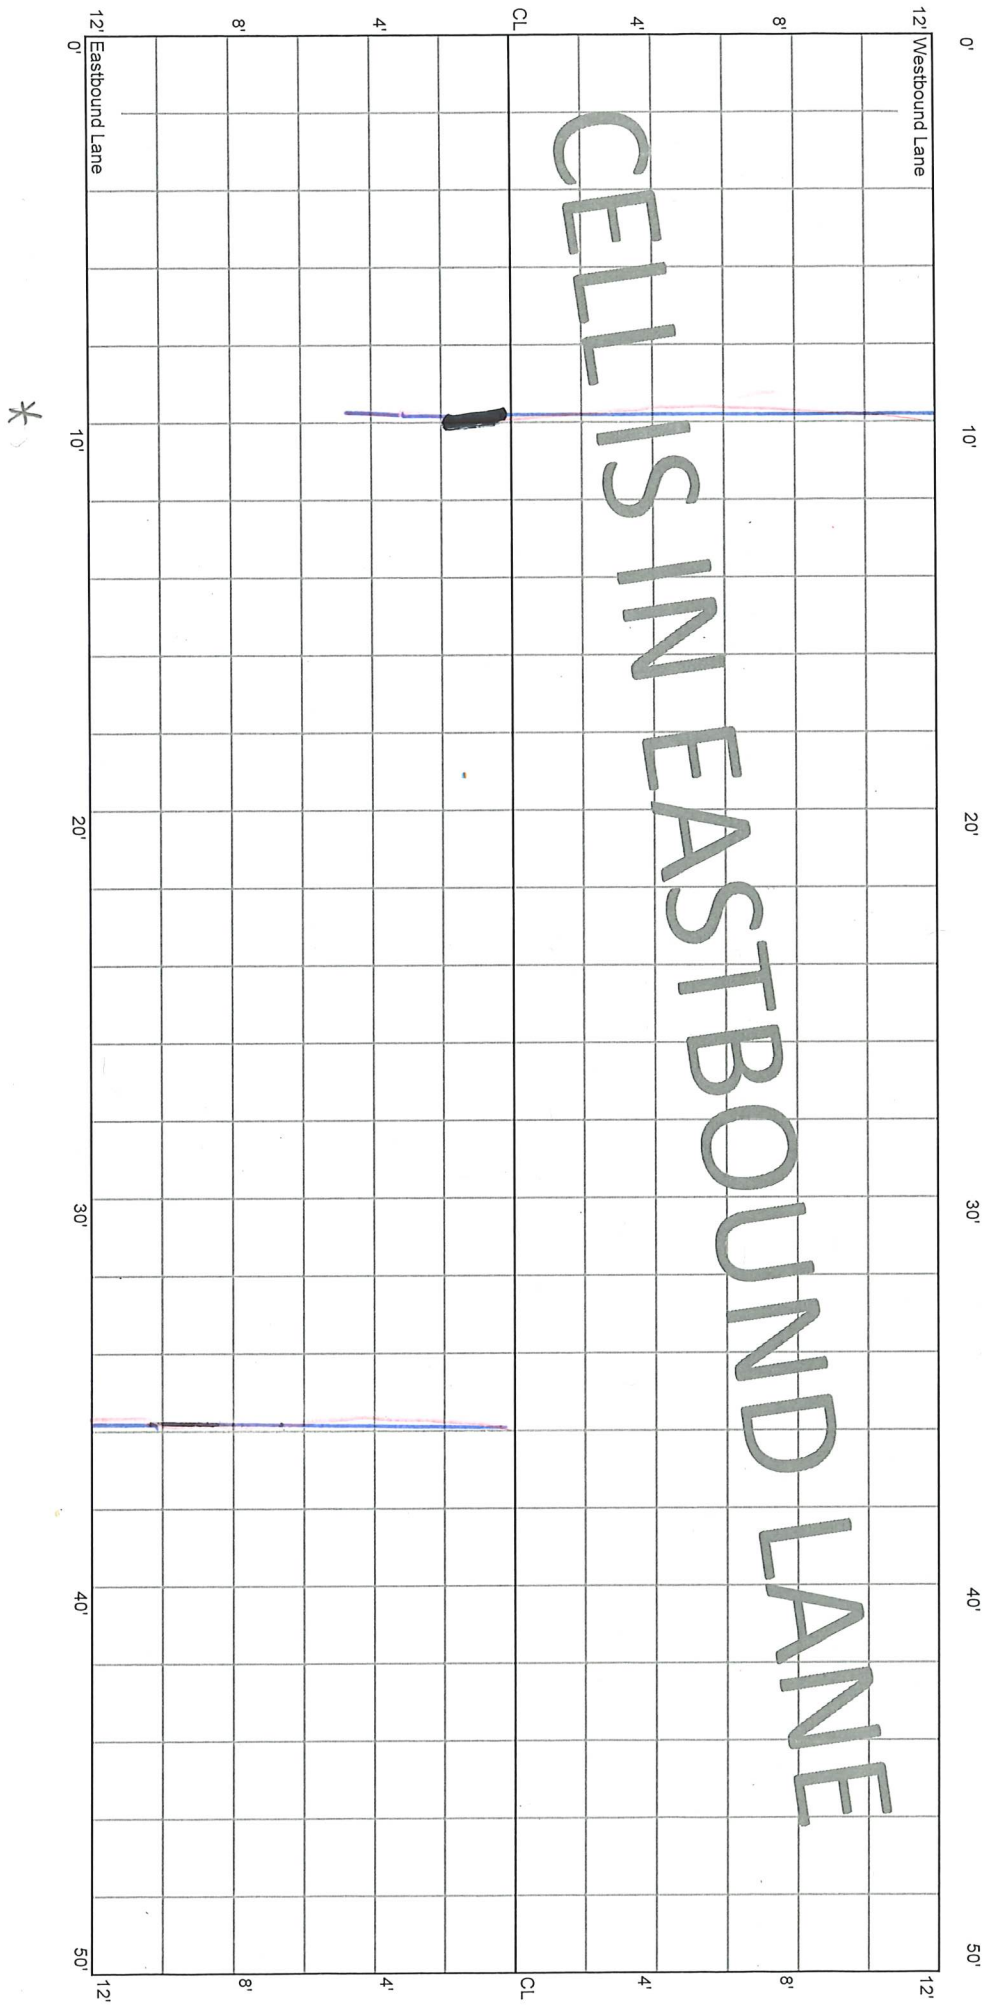

CELLS IN EASTBOUND LANE


*

CELL 7004E
300 - 350 ft

19+50

20+00

Put outside Fog line 300 to end

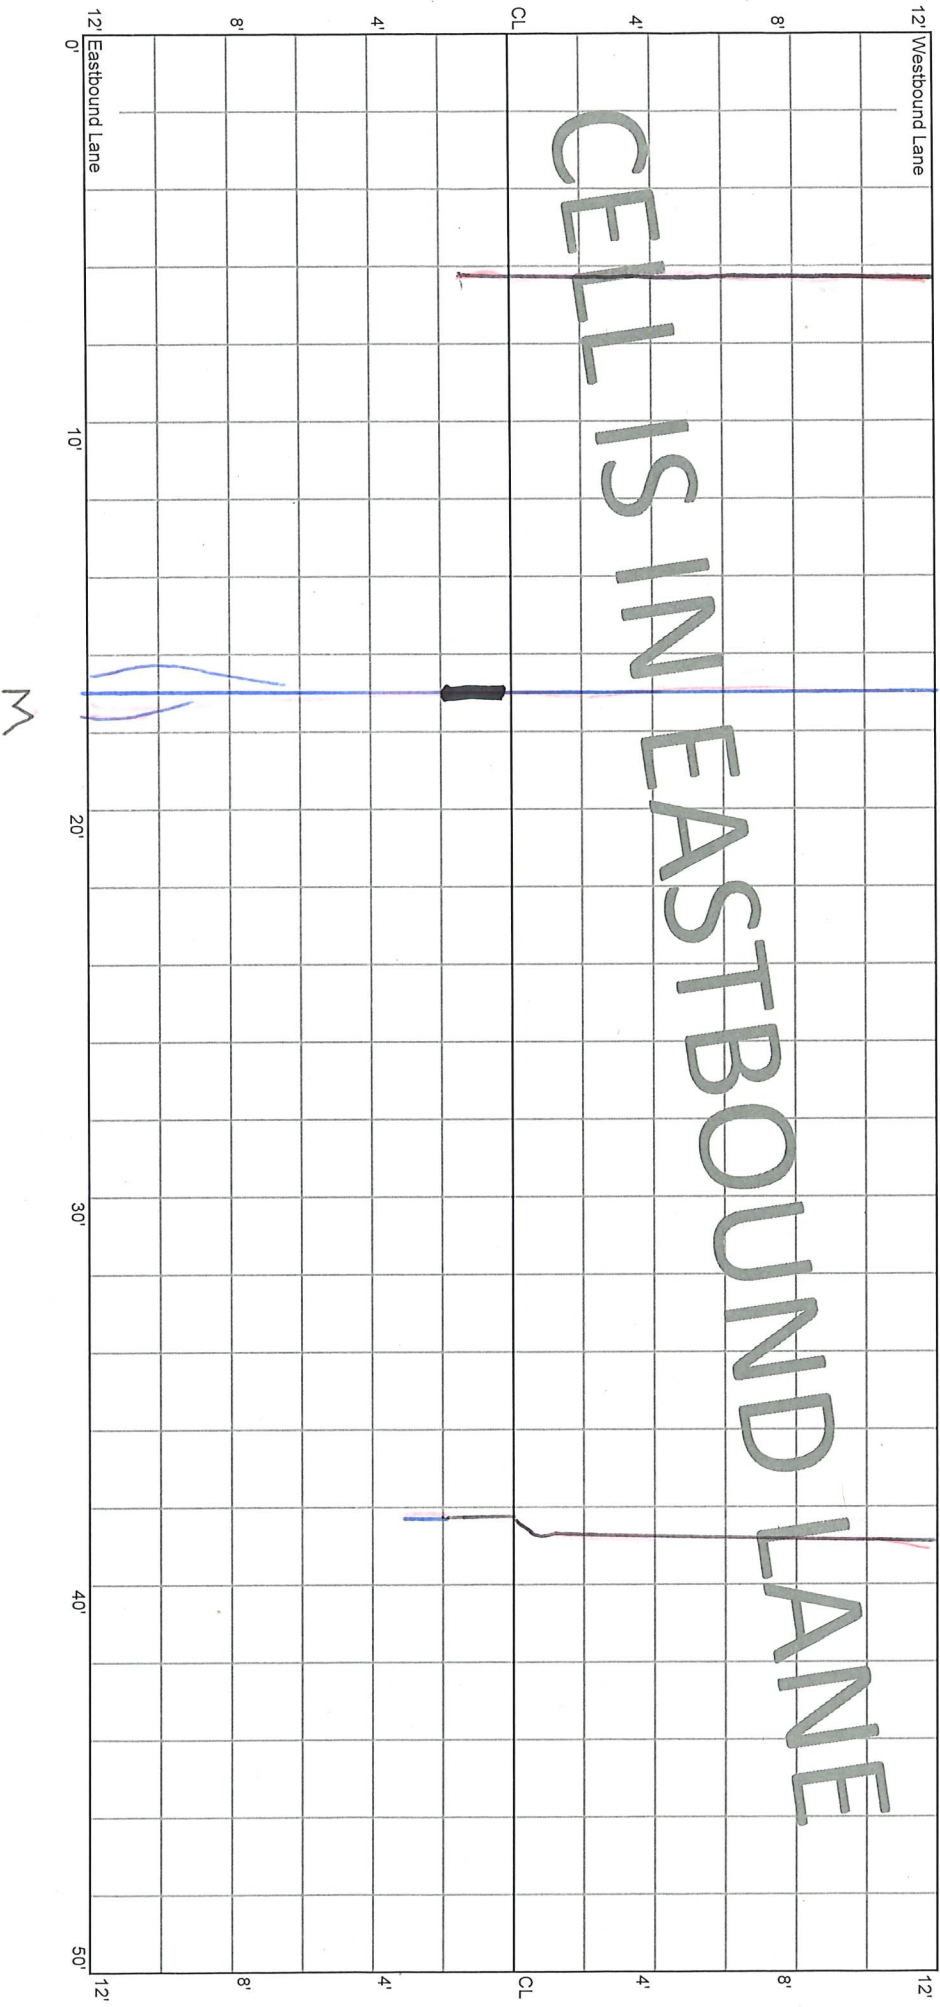

CELL IS IN EASTBOUND LANE

M

CELL 7004E
350 - 400 ft


20+00

20+50

12' Westbound Lane

12' Eastbound Lane

CELL IS IN EASTBOUND LANE

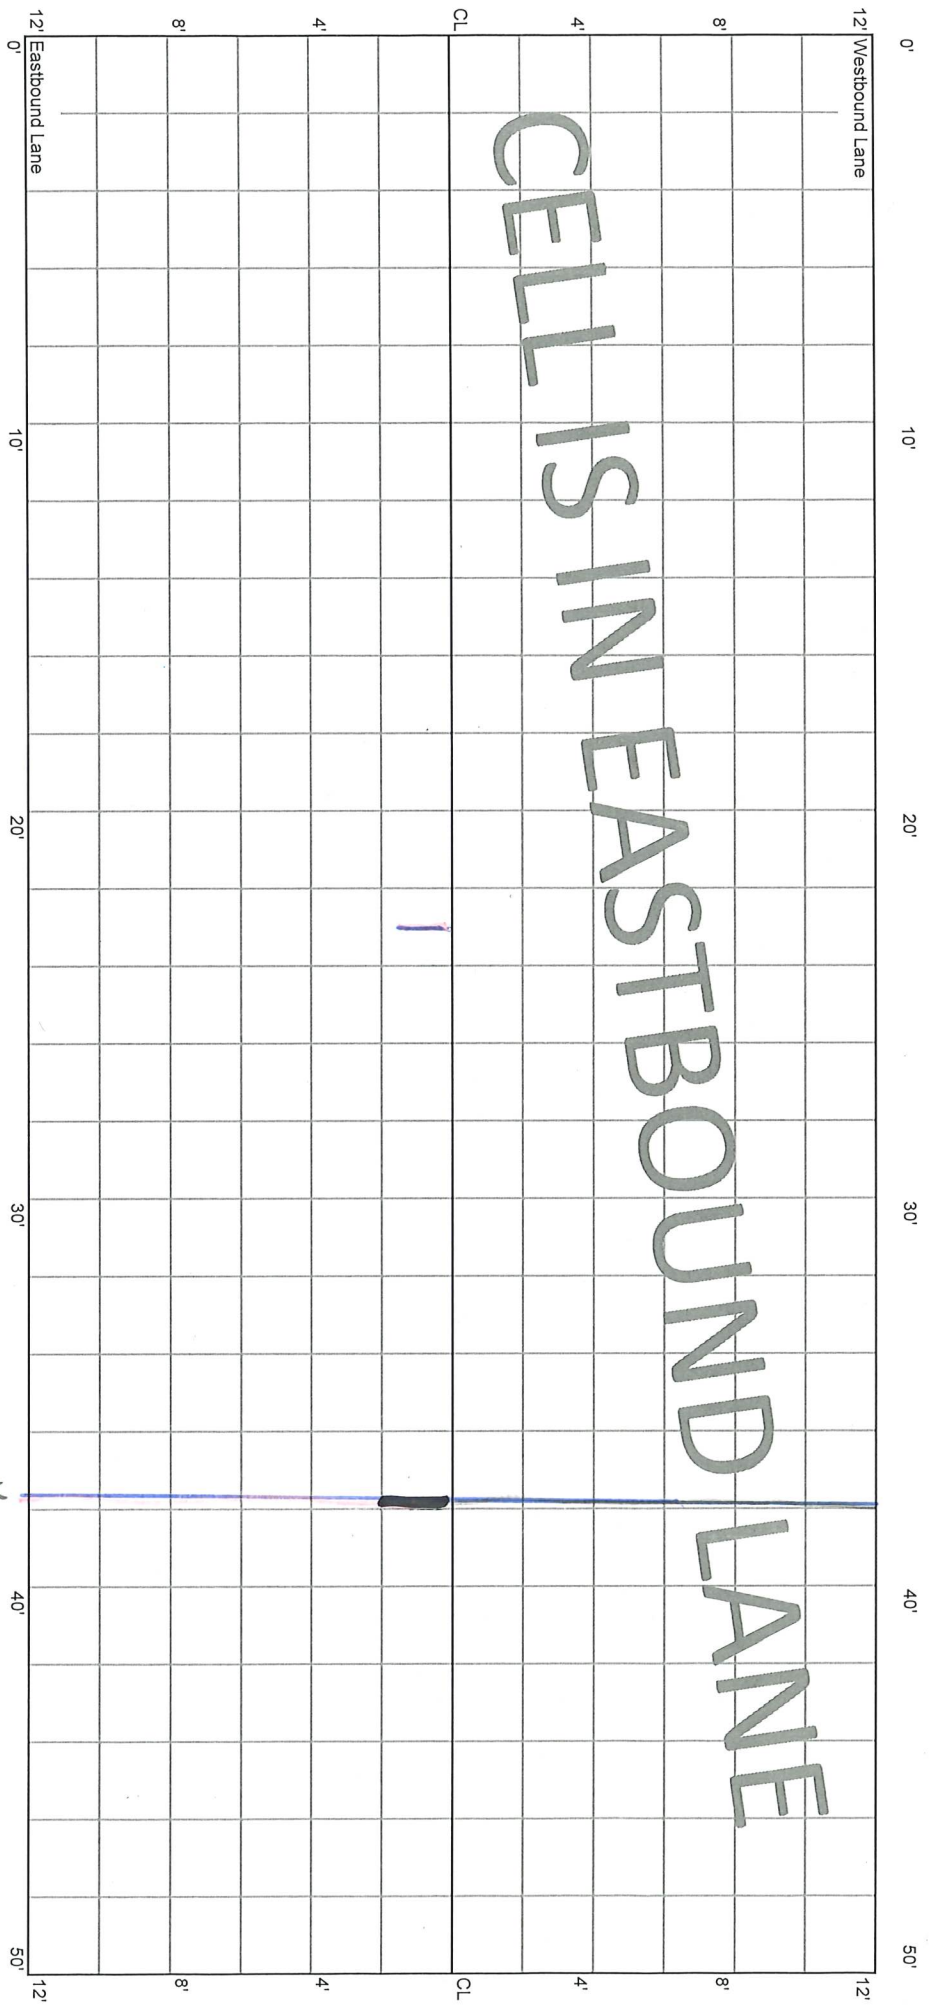


* M

CELL 7004E
400 - 450 ft

20+50

21+00

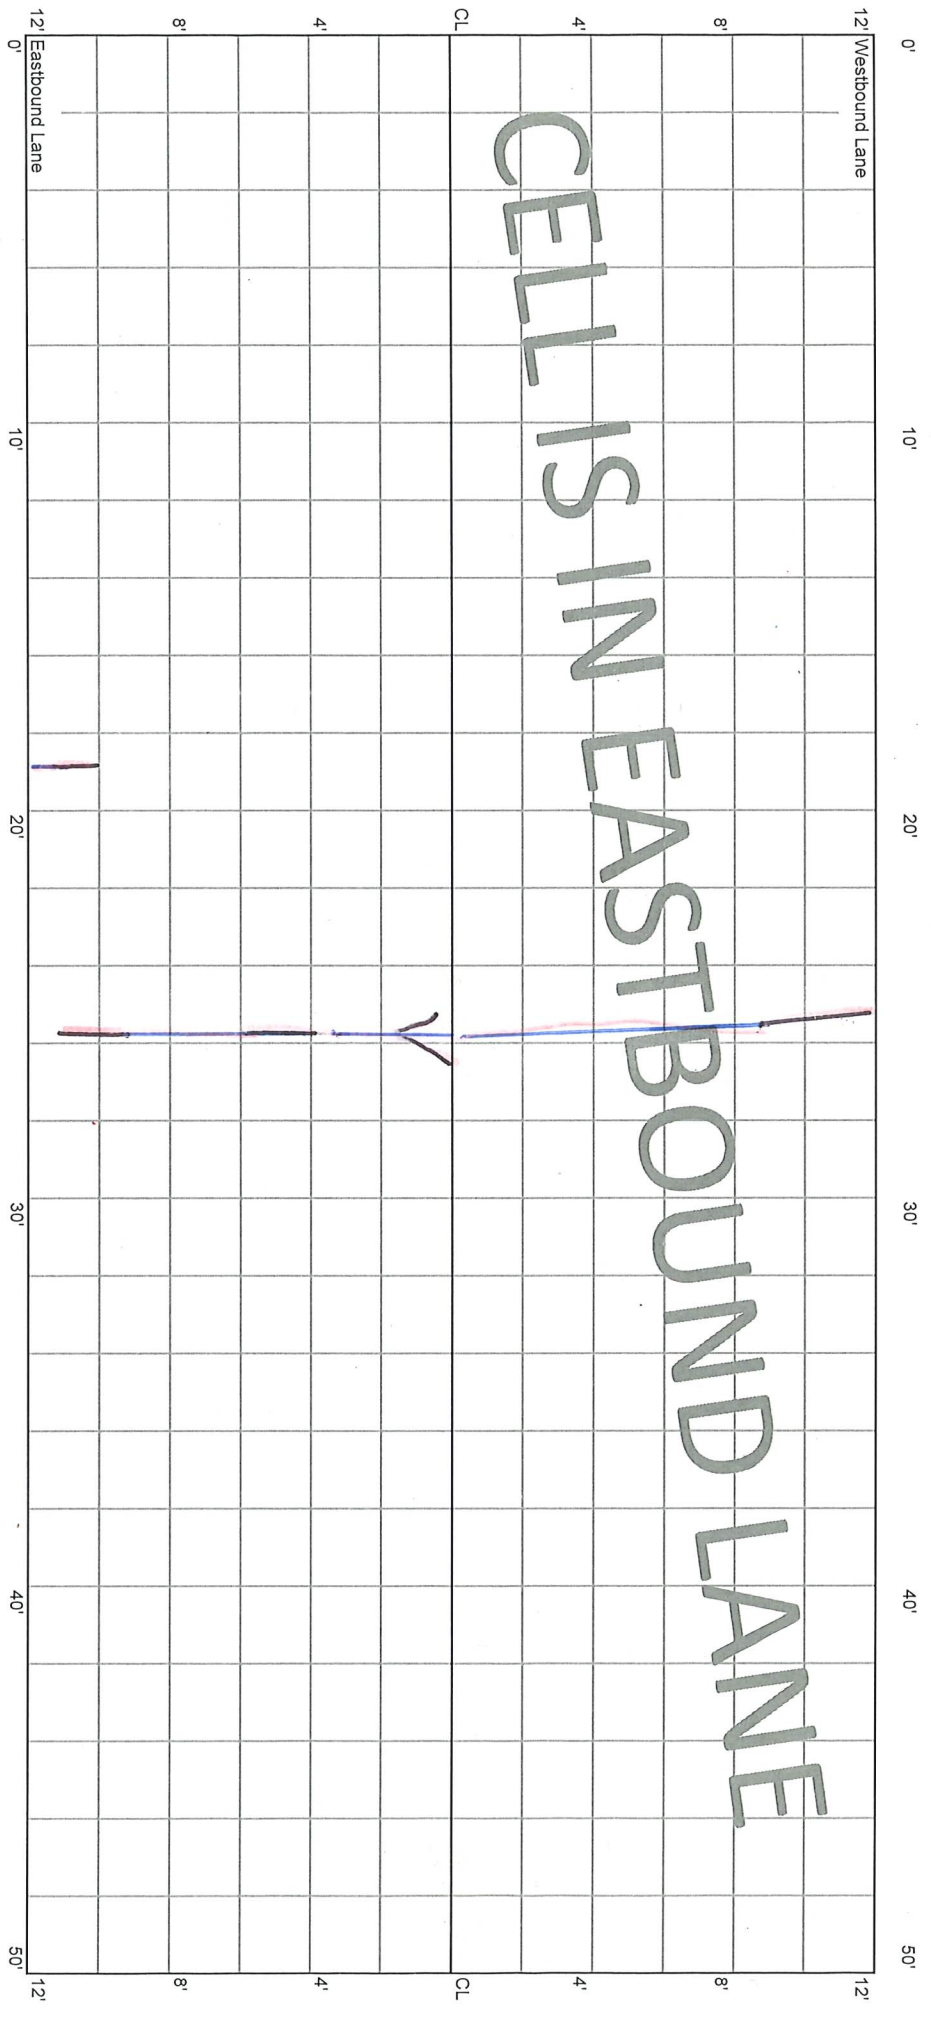


CELL IS IN EASTBOUND LANE

CELL 7004E
450 - 500 ft

21+00

21+50

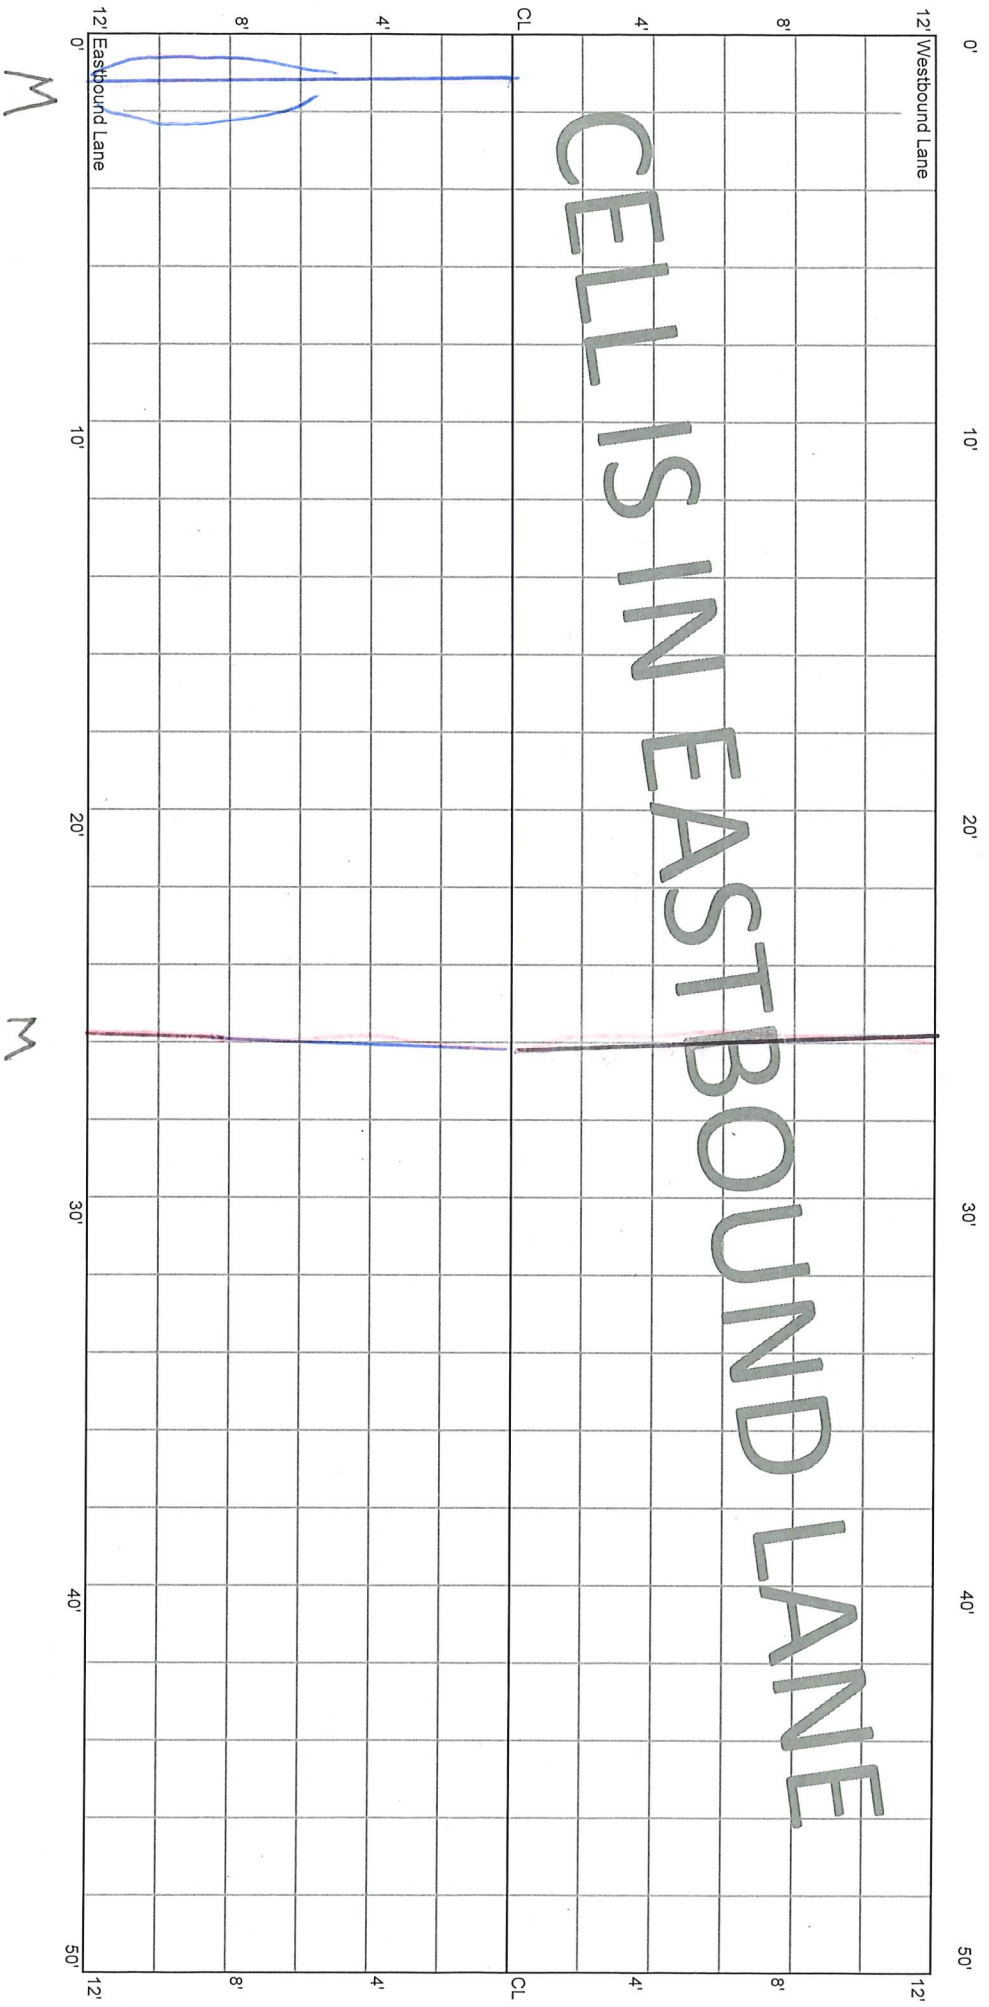

Sheet 2
C-107

CELL 7004E
500 - 550 ft

21+50

19+25

22+00

12' Westbound Lane

0' 10' 20' 25' 30' 40' 50'

CELL IS IN EASTBOUND LANE

END RATING: BEGIN TRANSITION TO
NEXT CELL

12' 0' 10' 20' 25' 30' 40' 50'

(C: Oct 20)
C-107