


8.25-21 - 59 sklar cracks

5.28.20 E.S. - No cracking  
10.14.20 - No Distress  
1.4.21 - No Distress  
1.13.22

CELL 7007E  
0 - 50 ft

File 707H ST  
8.25.21  
1.13.22  
33+00

33+50

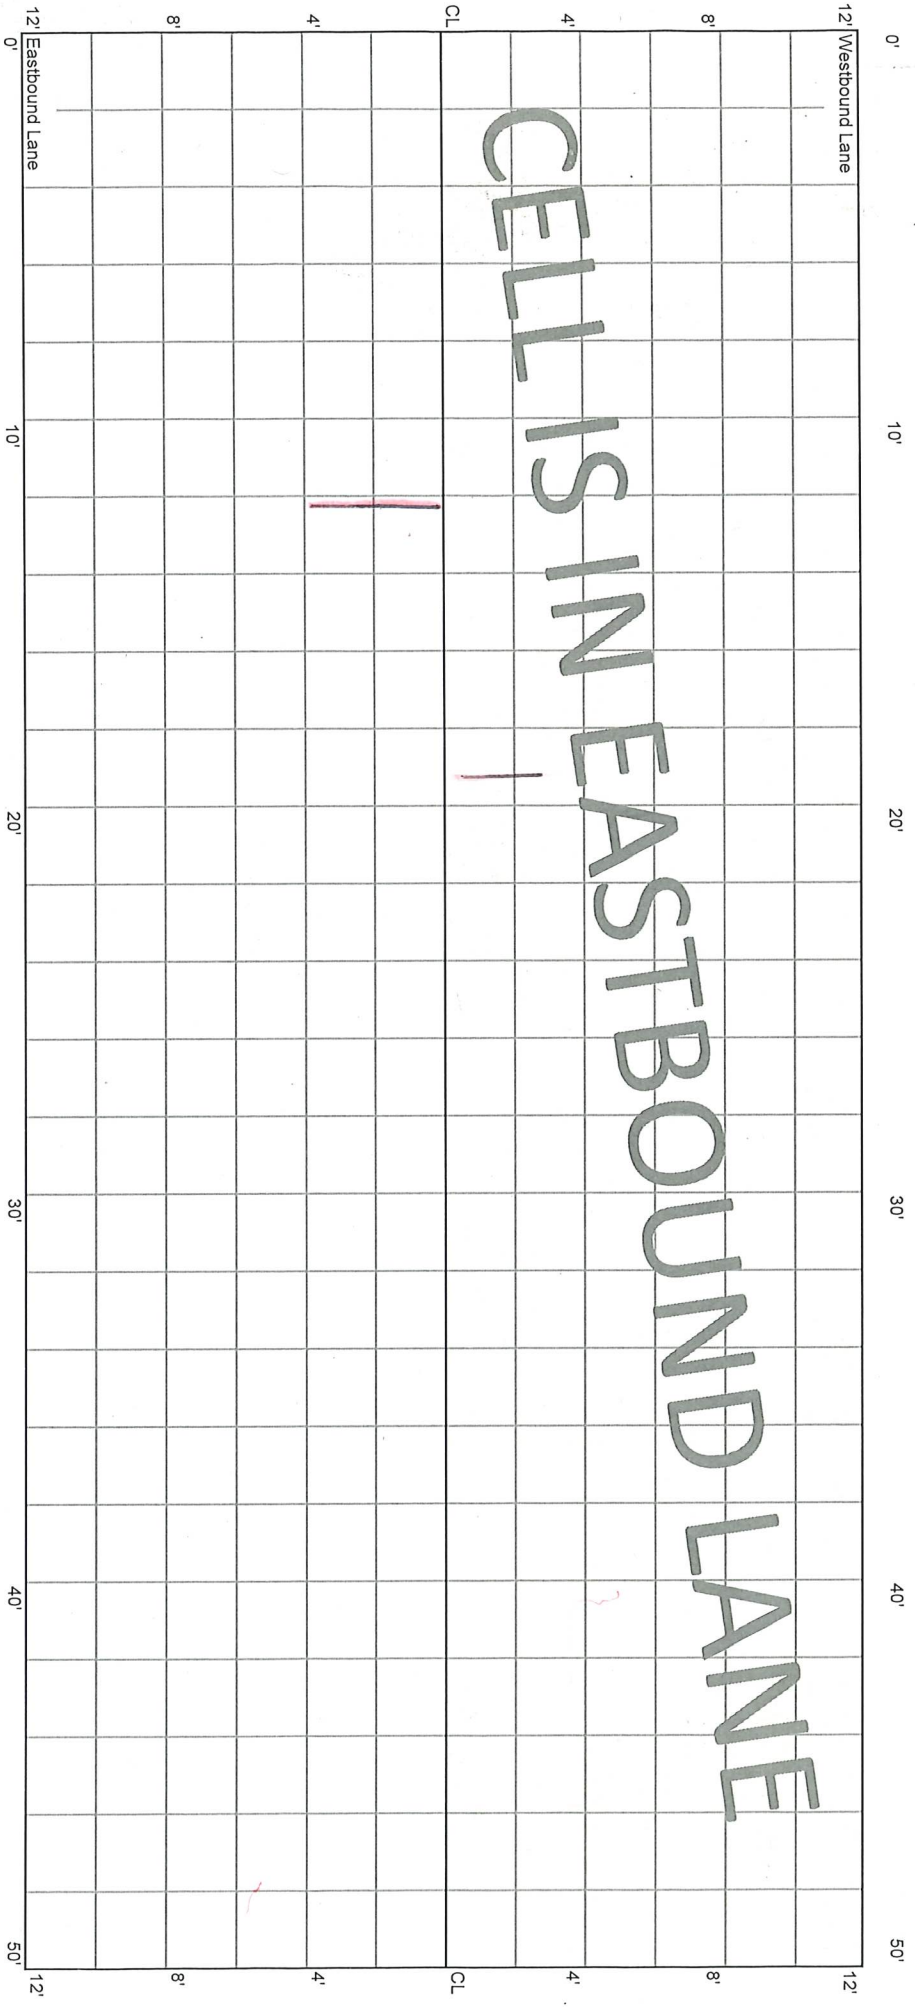


CELLS IN EASTBOUND LANE

12' Westbound Lane  
0'  
12' Eastbound Lane  
0'

CELL 7007E  
50 - 100 ft

33+50


34+00

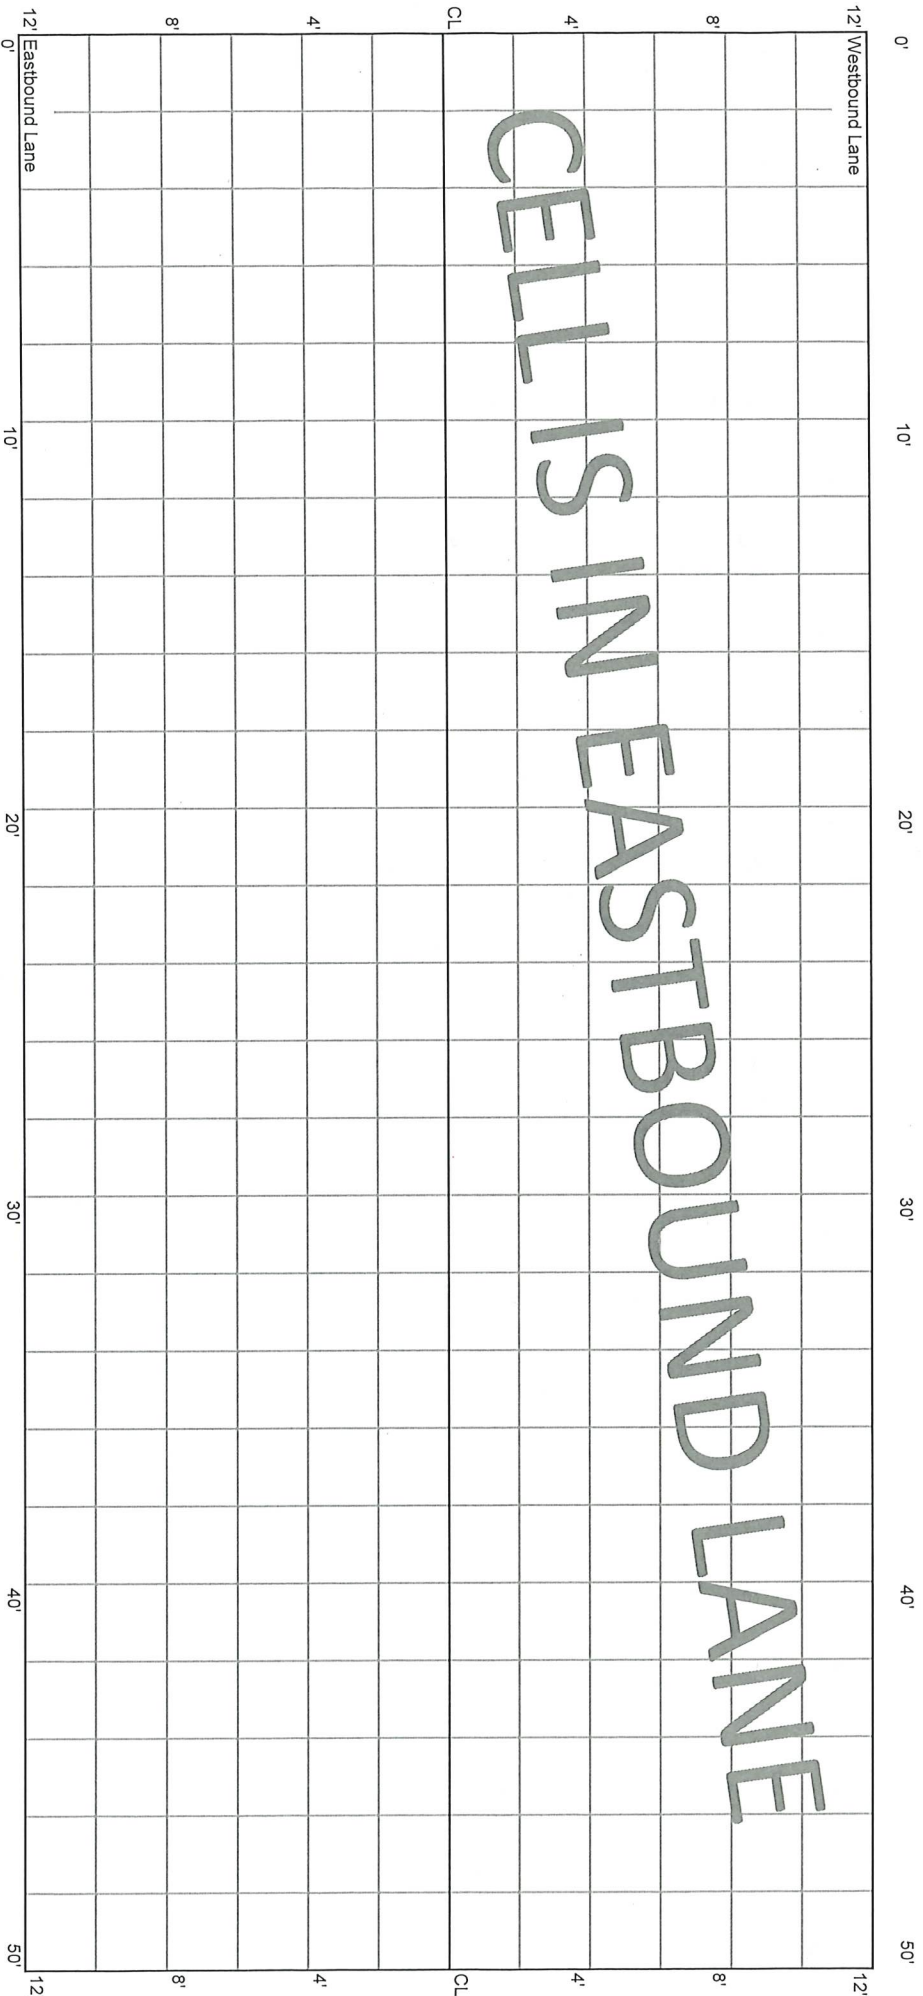

CELL 7007E  
100 - 150 ft

34+00

34+50

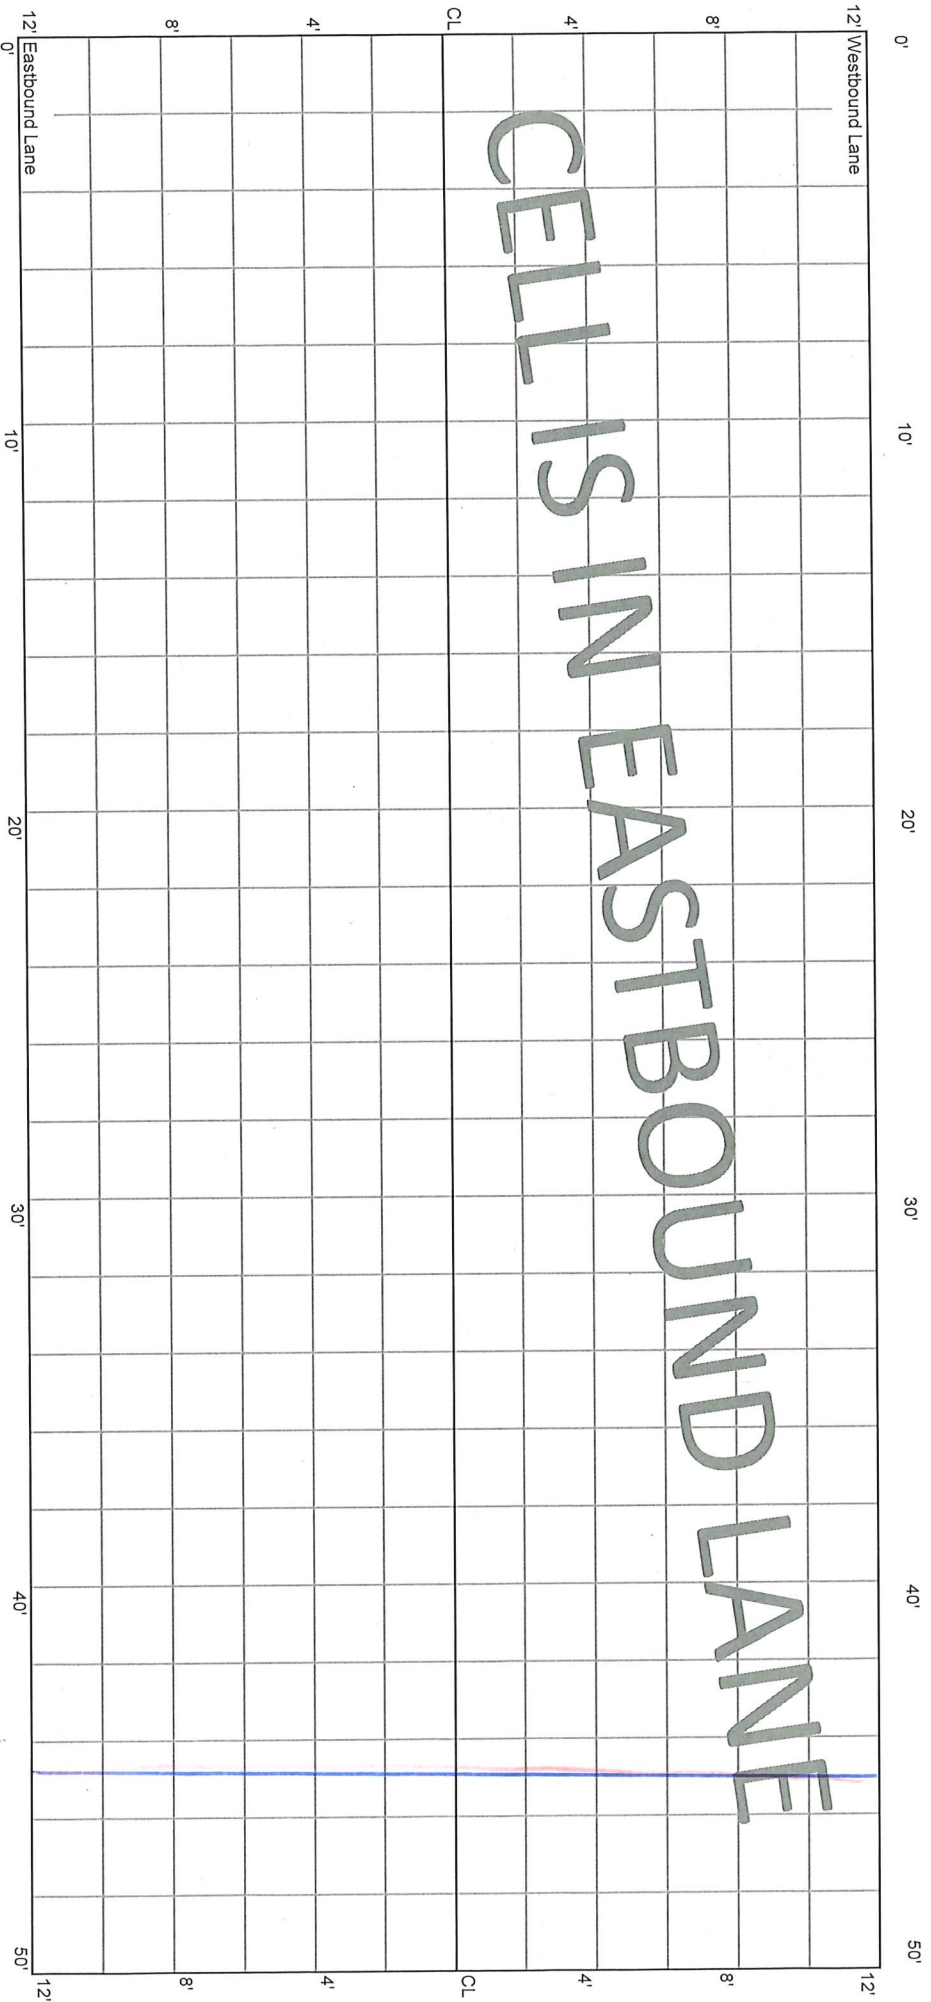


M

CELL 7007E  
150 - 200 ft

34+50

35+00


0' 10' 20' 30' 40' 50'

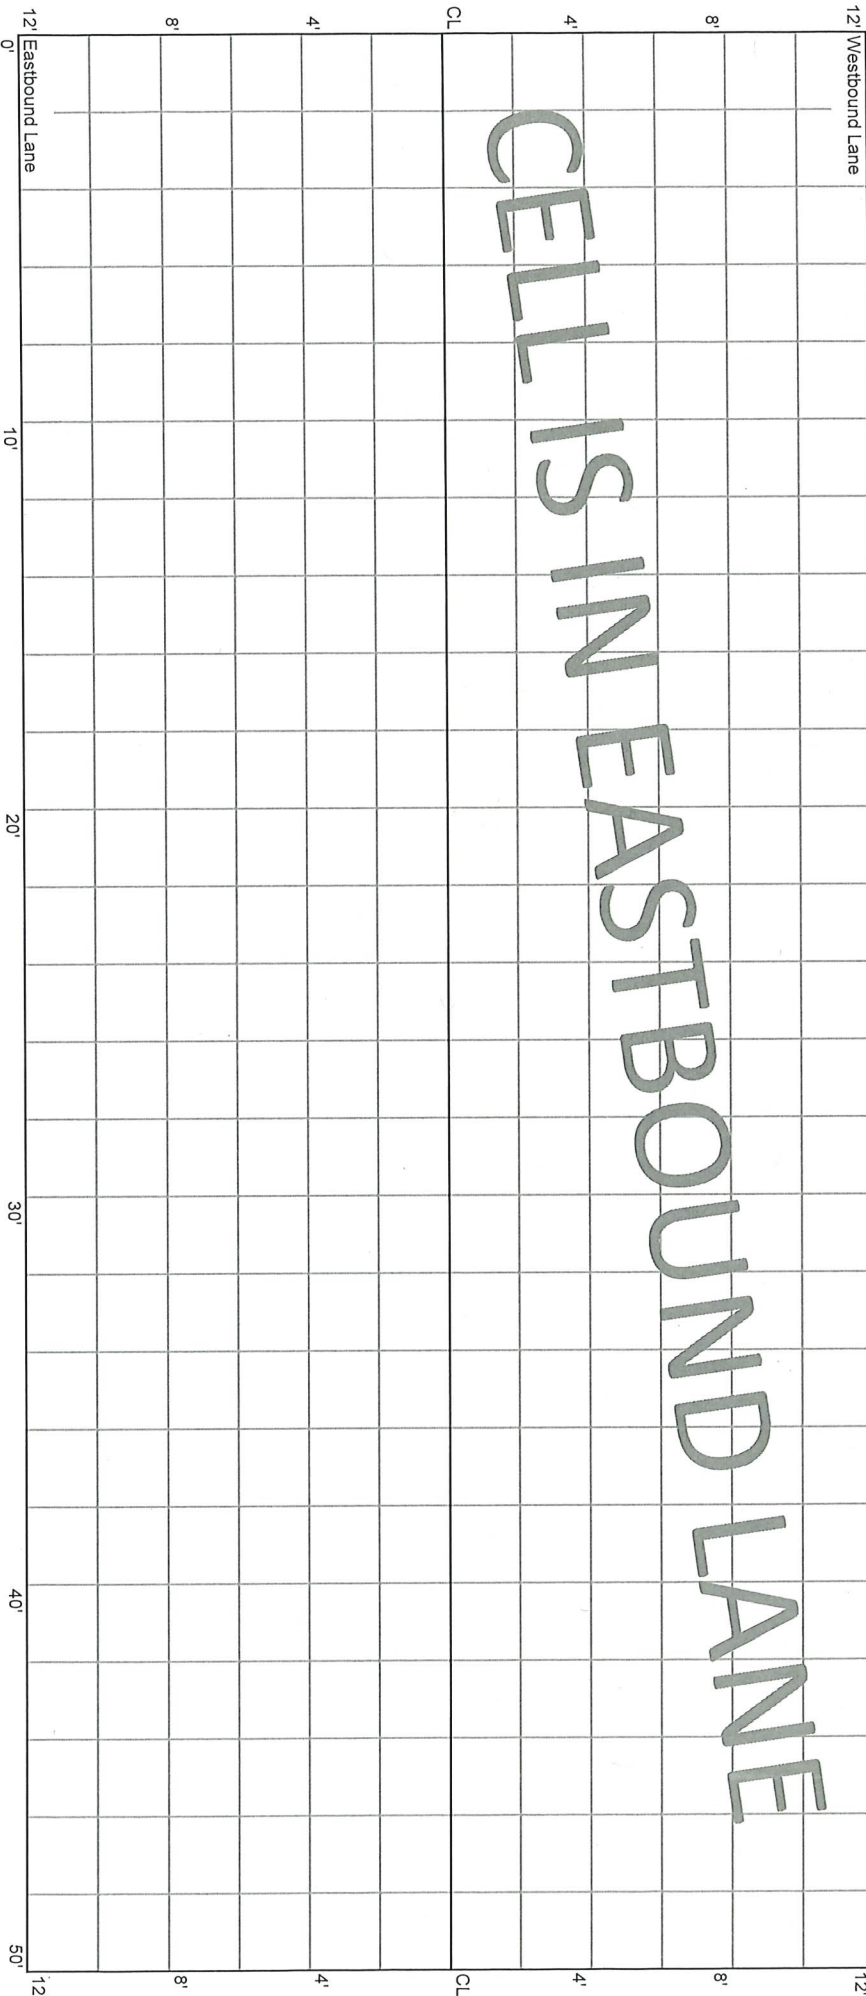

CELL 7007E  
200 - 250 ft

35+30  
CL KALLAND


35+50

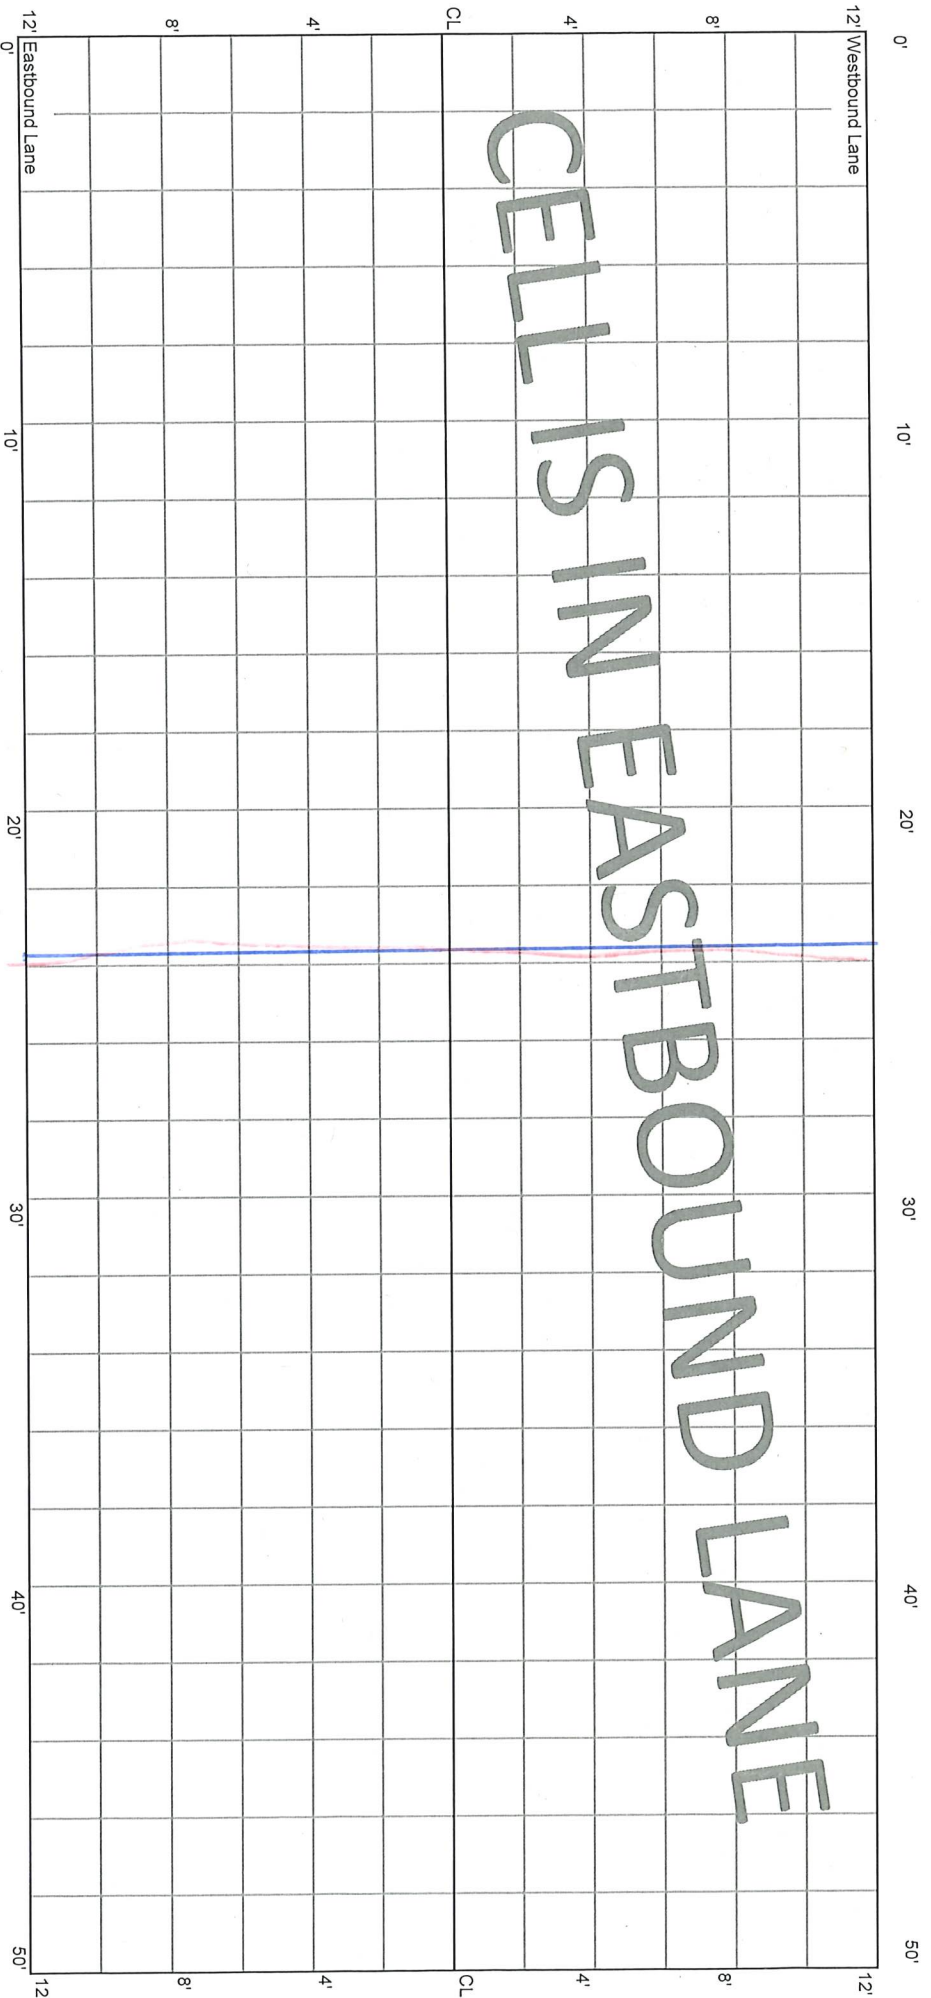

CELL 7007E  
250 - 300 ft

35+50


36+00

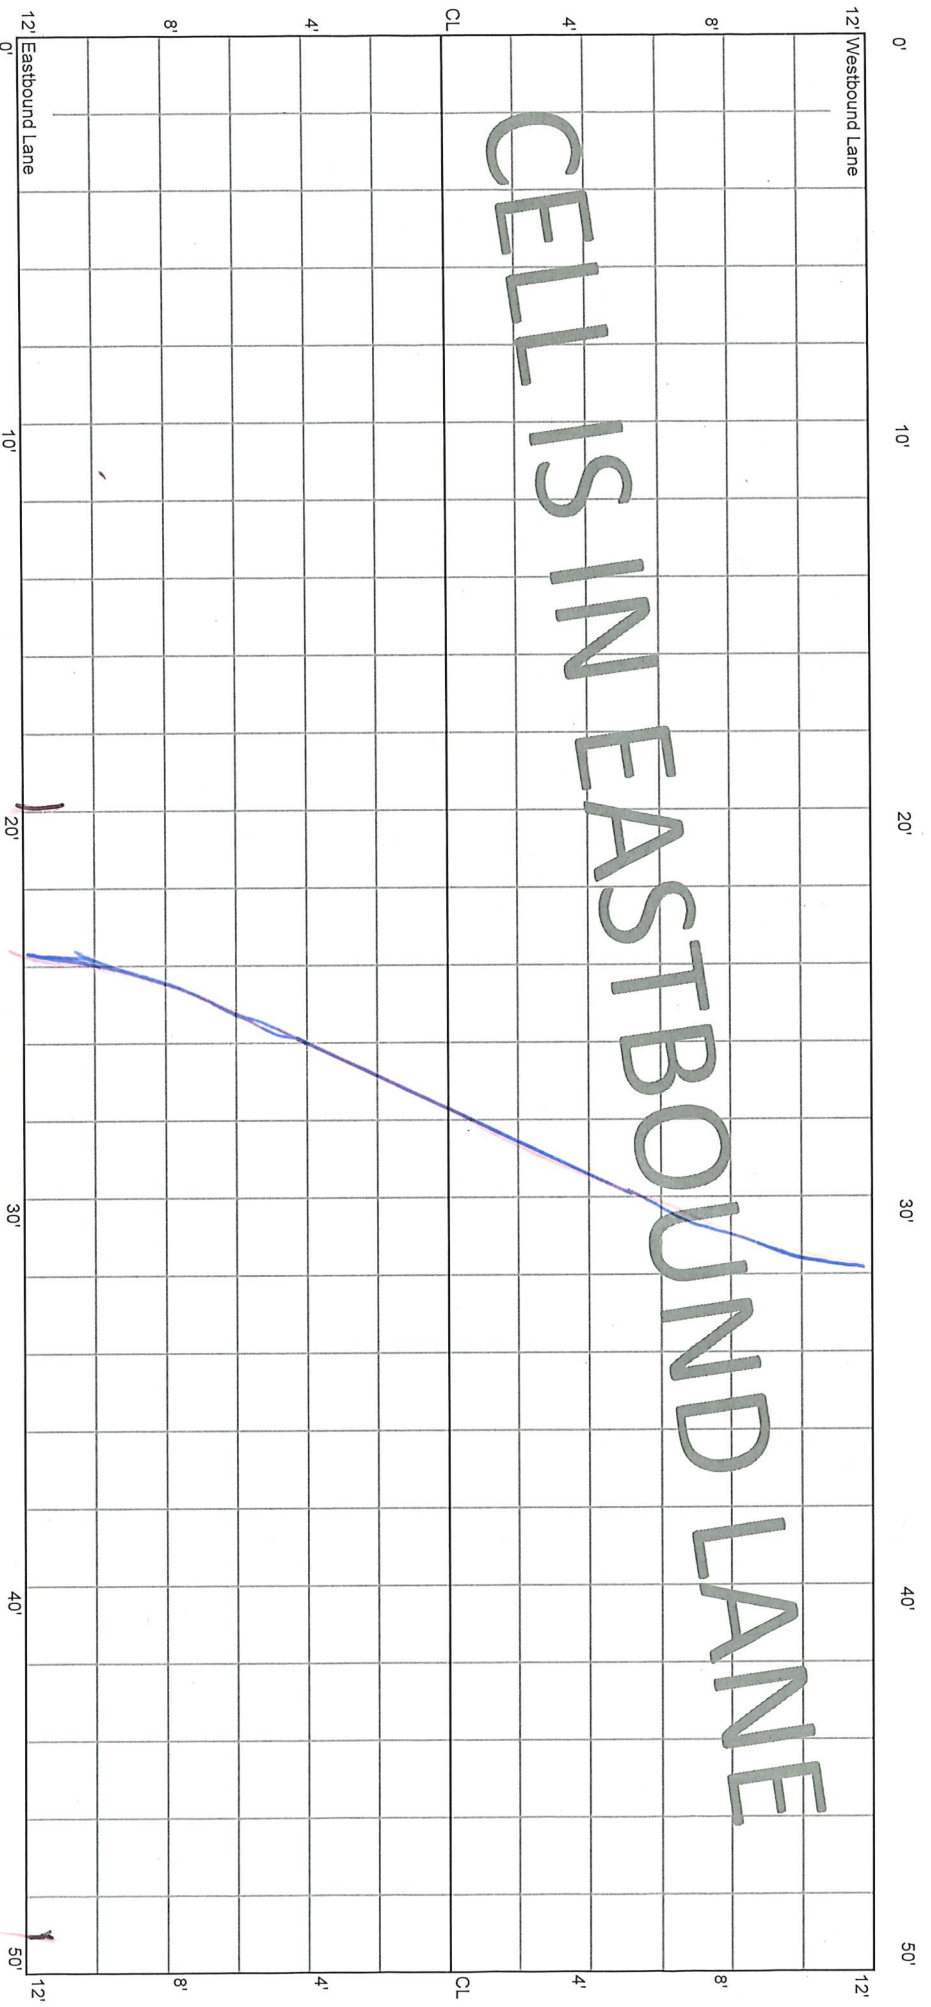

CELL 7007E  
300 - 350 ft

36+00


36+50

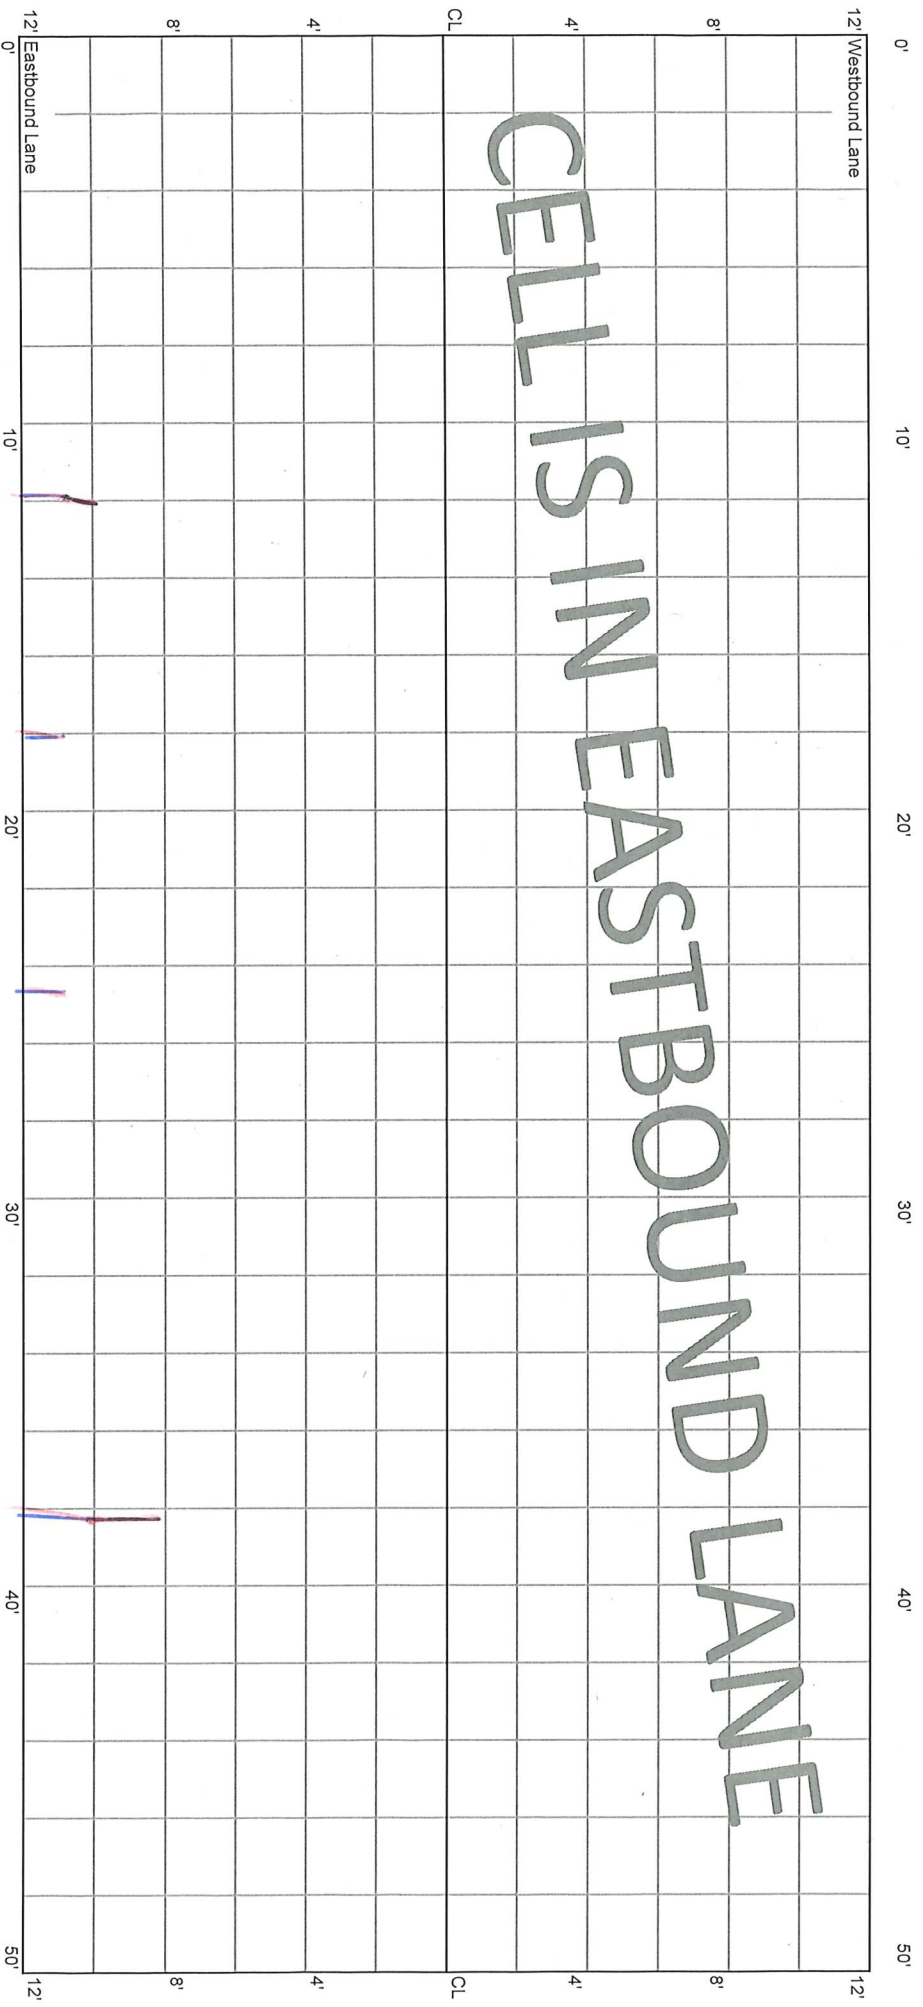

CELL 7007E  
350 - 400 ft

36+50

37+00

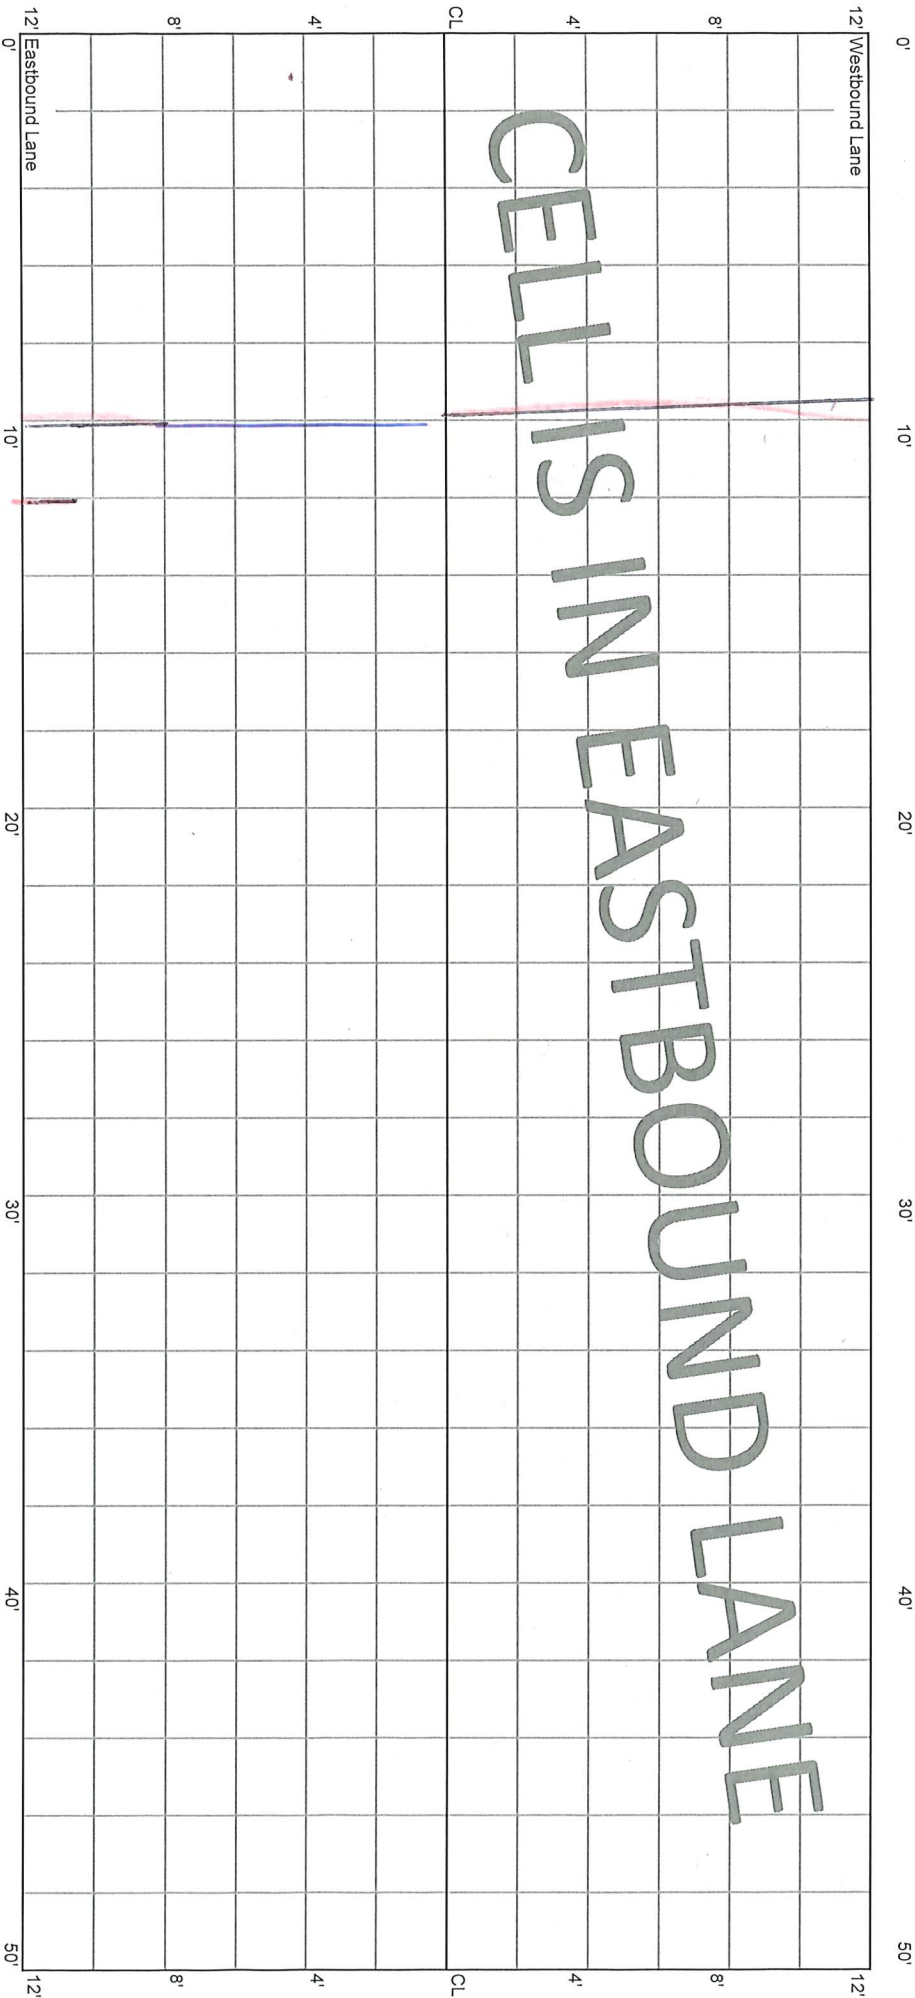


*5/10/00  
Shirley Ruffin  
outside F.L.  
2964 - 380*



CELL 7007E  
400 - 450 ft

37+00


37+50

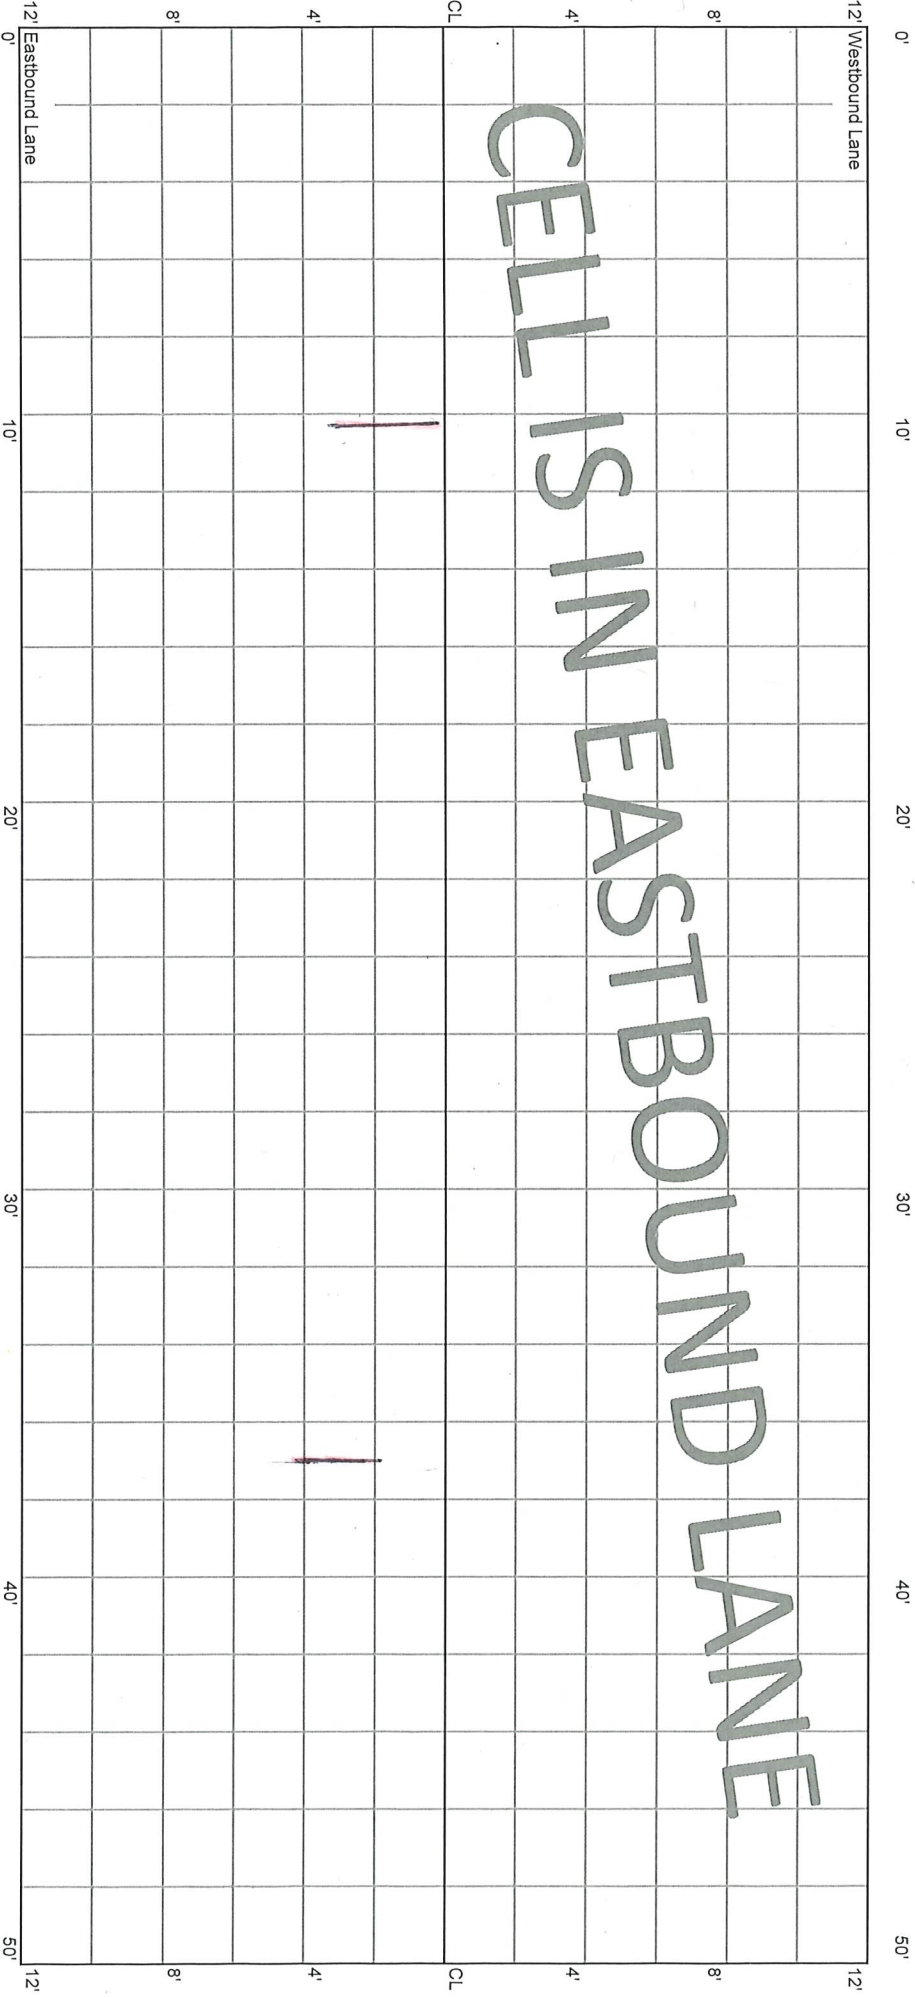

CELL 7007E  
450 - 500 ft

37+50

38+00

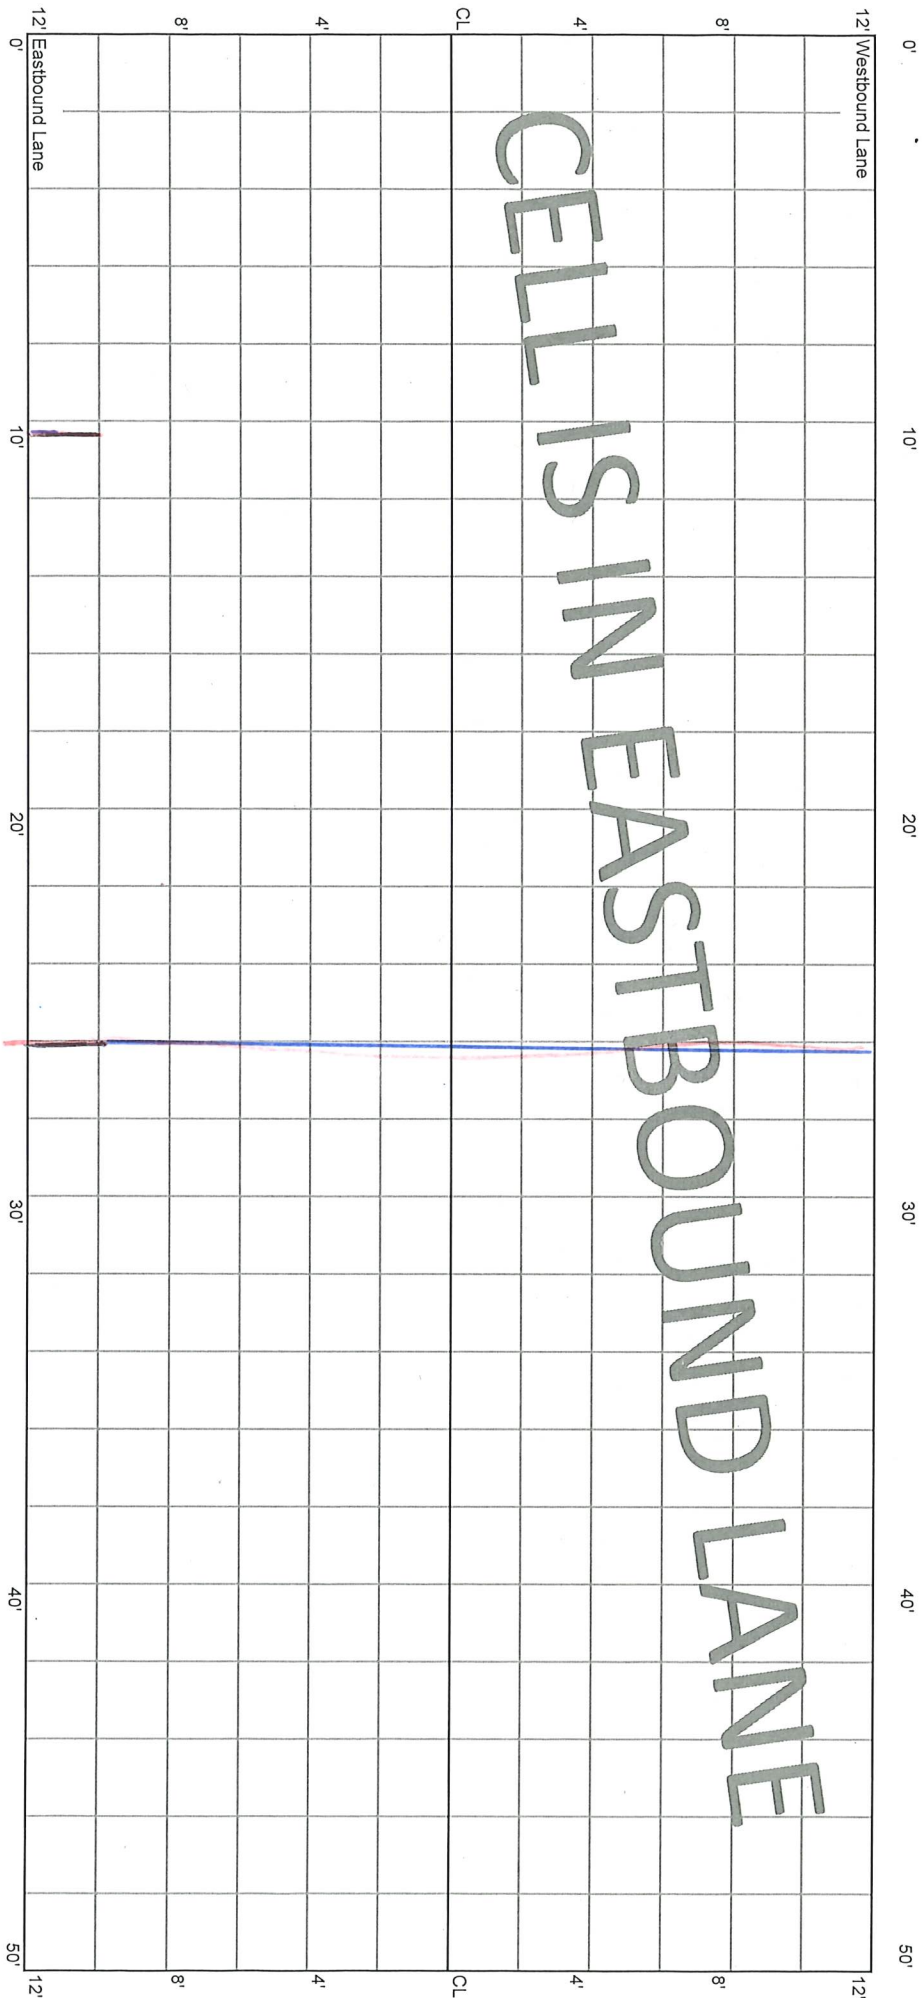


245

CELL 7007E  
500 - 550 ft

38+00

16+25

38+50

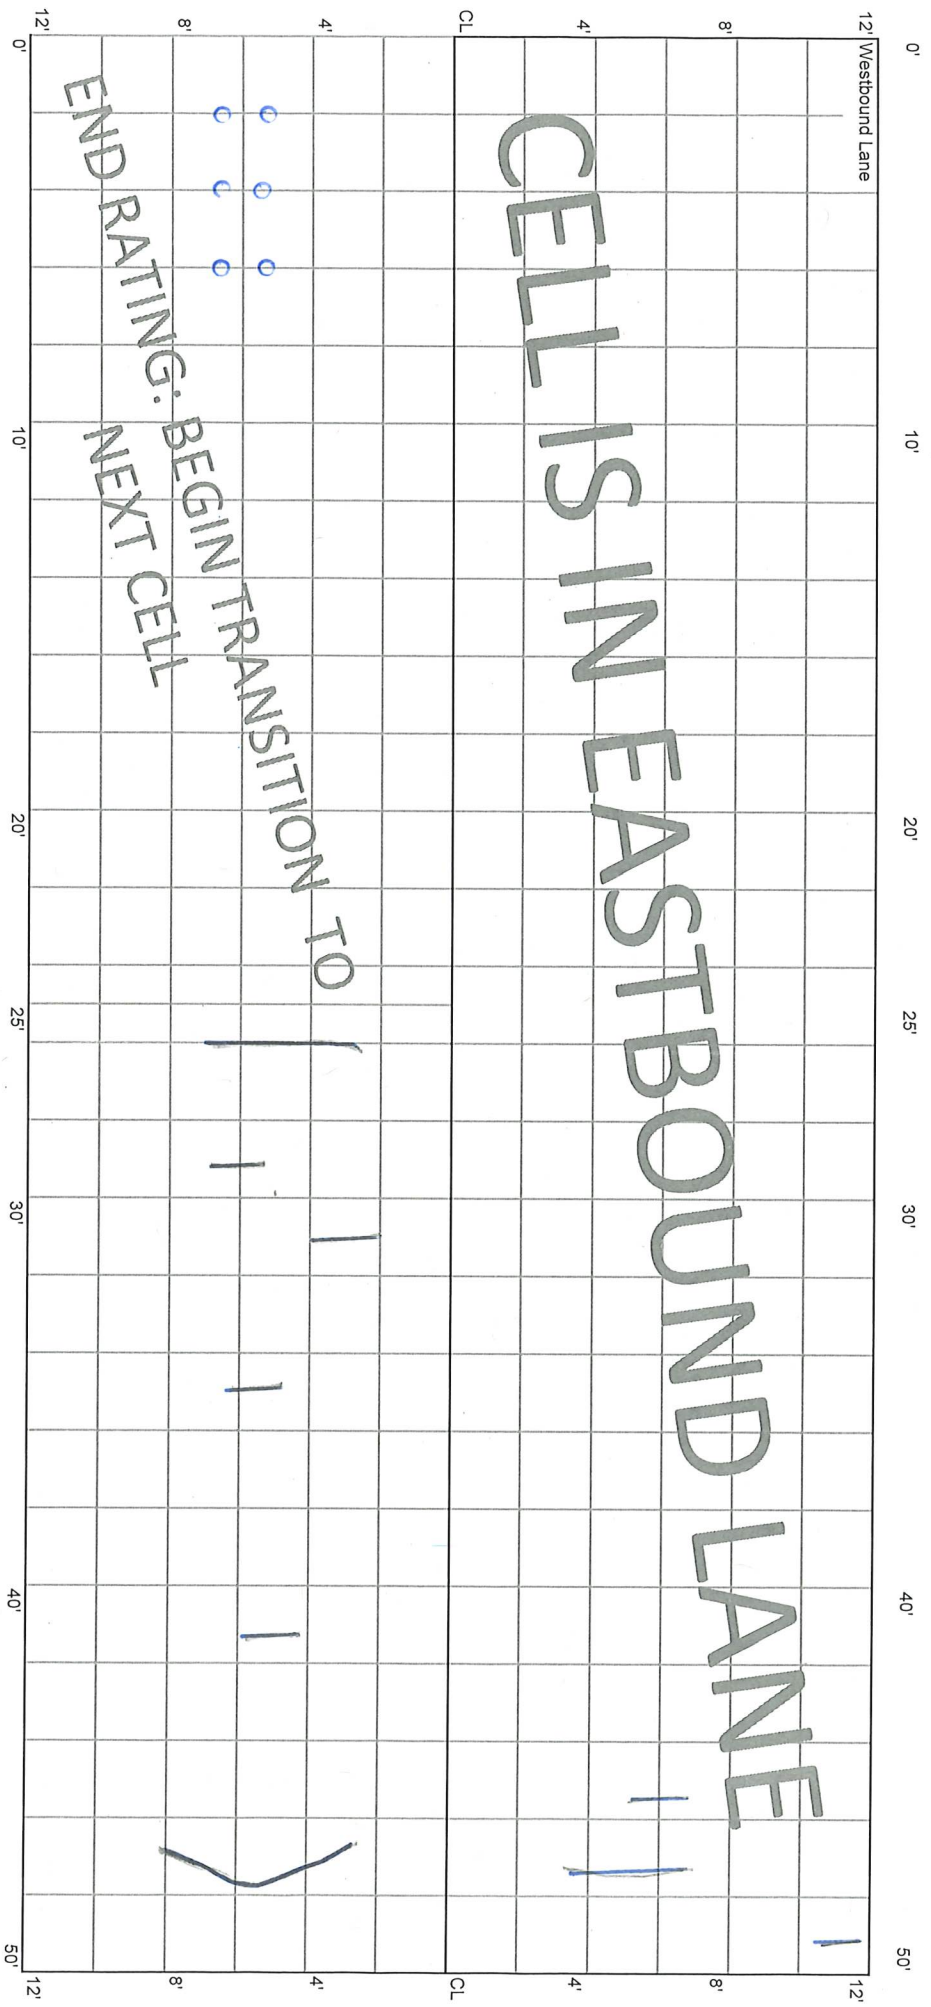

CELLS IN EASTBOUND LANE

END RATING: BEGIN TRANSITION TO NEXT CELL